


Released for Permit  
07/08/2019 1:11:29 PM  
brent  
ENUMERATION

**DISAPPROVED  
Plan Review**

07/10/2019 10:22:51 AM  
dsdyounger

EPC Planning & Community  
Development Department

**EXISTING STRUCTURES MUST  
ACCURATELY DEPICT CURRENT  
STRUCTURES ON THE PARCEL.  
SHOW DIMENSIONS OF EACH  
STRUCTURE AS WELL AS IDENTIFY  
THEIR USE, DIMENSIONS TO  
PROPERTY LINE AND OBTAIN A  
BUILDING PERMIT FOR EACH  
STRUCTURE IF ANY OF THE  
STRUCTURES ARE OVER 200 SQFT.**

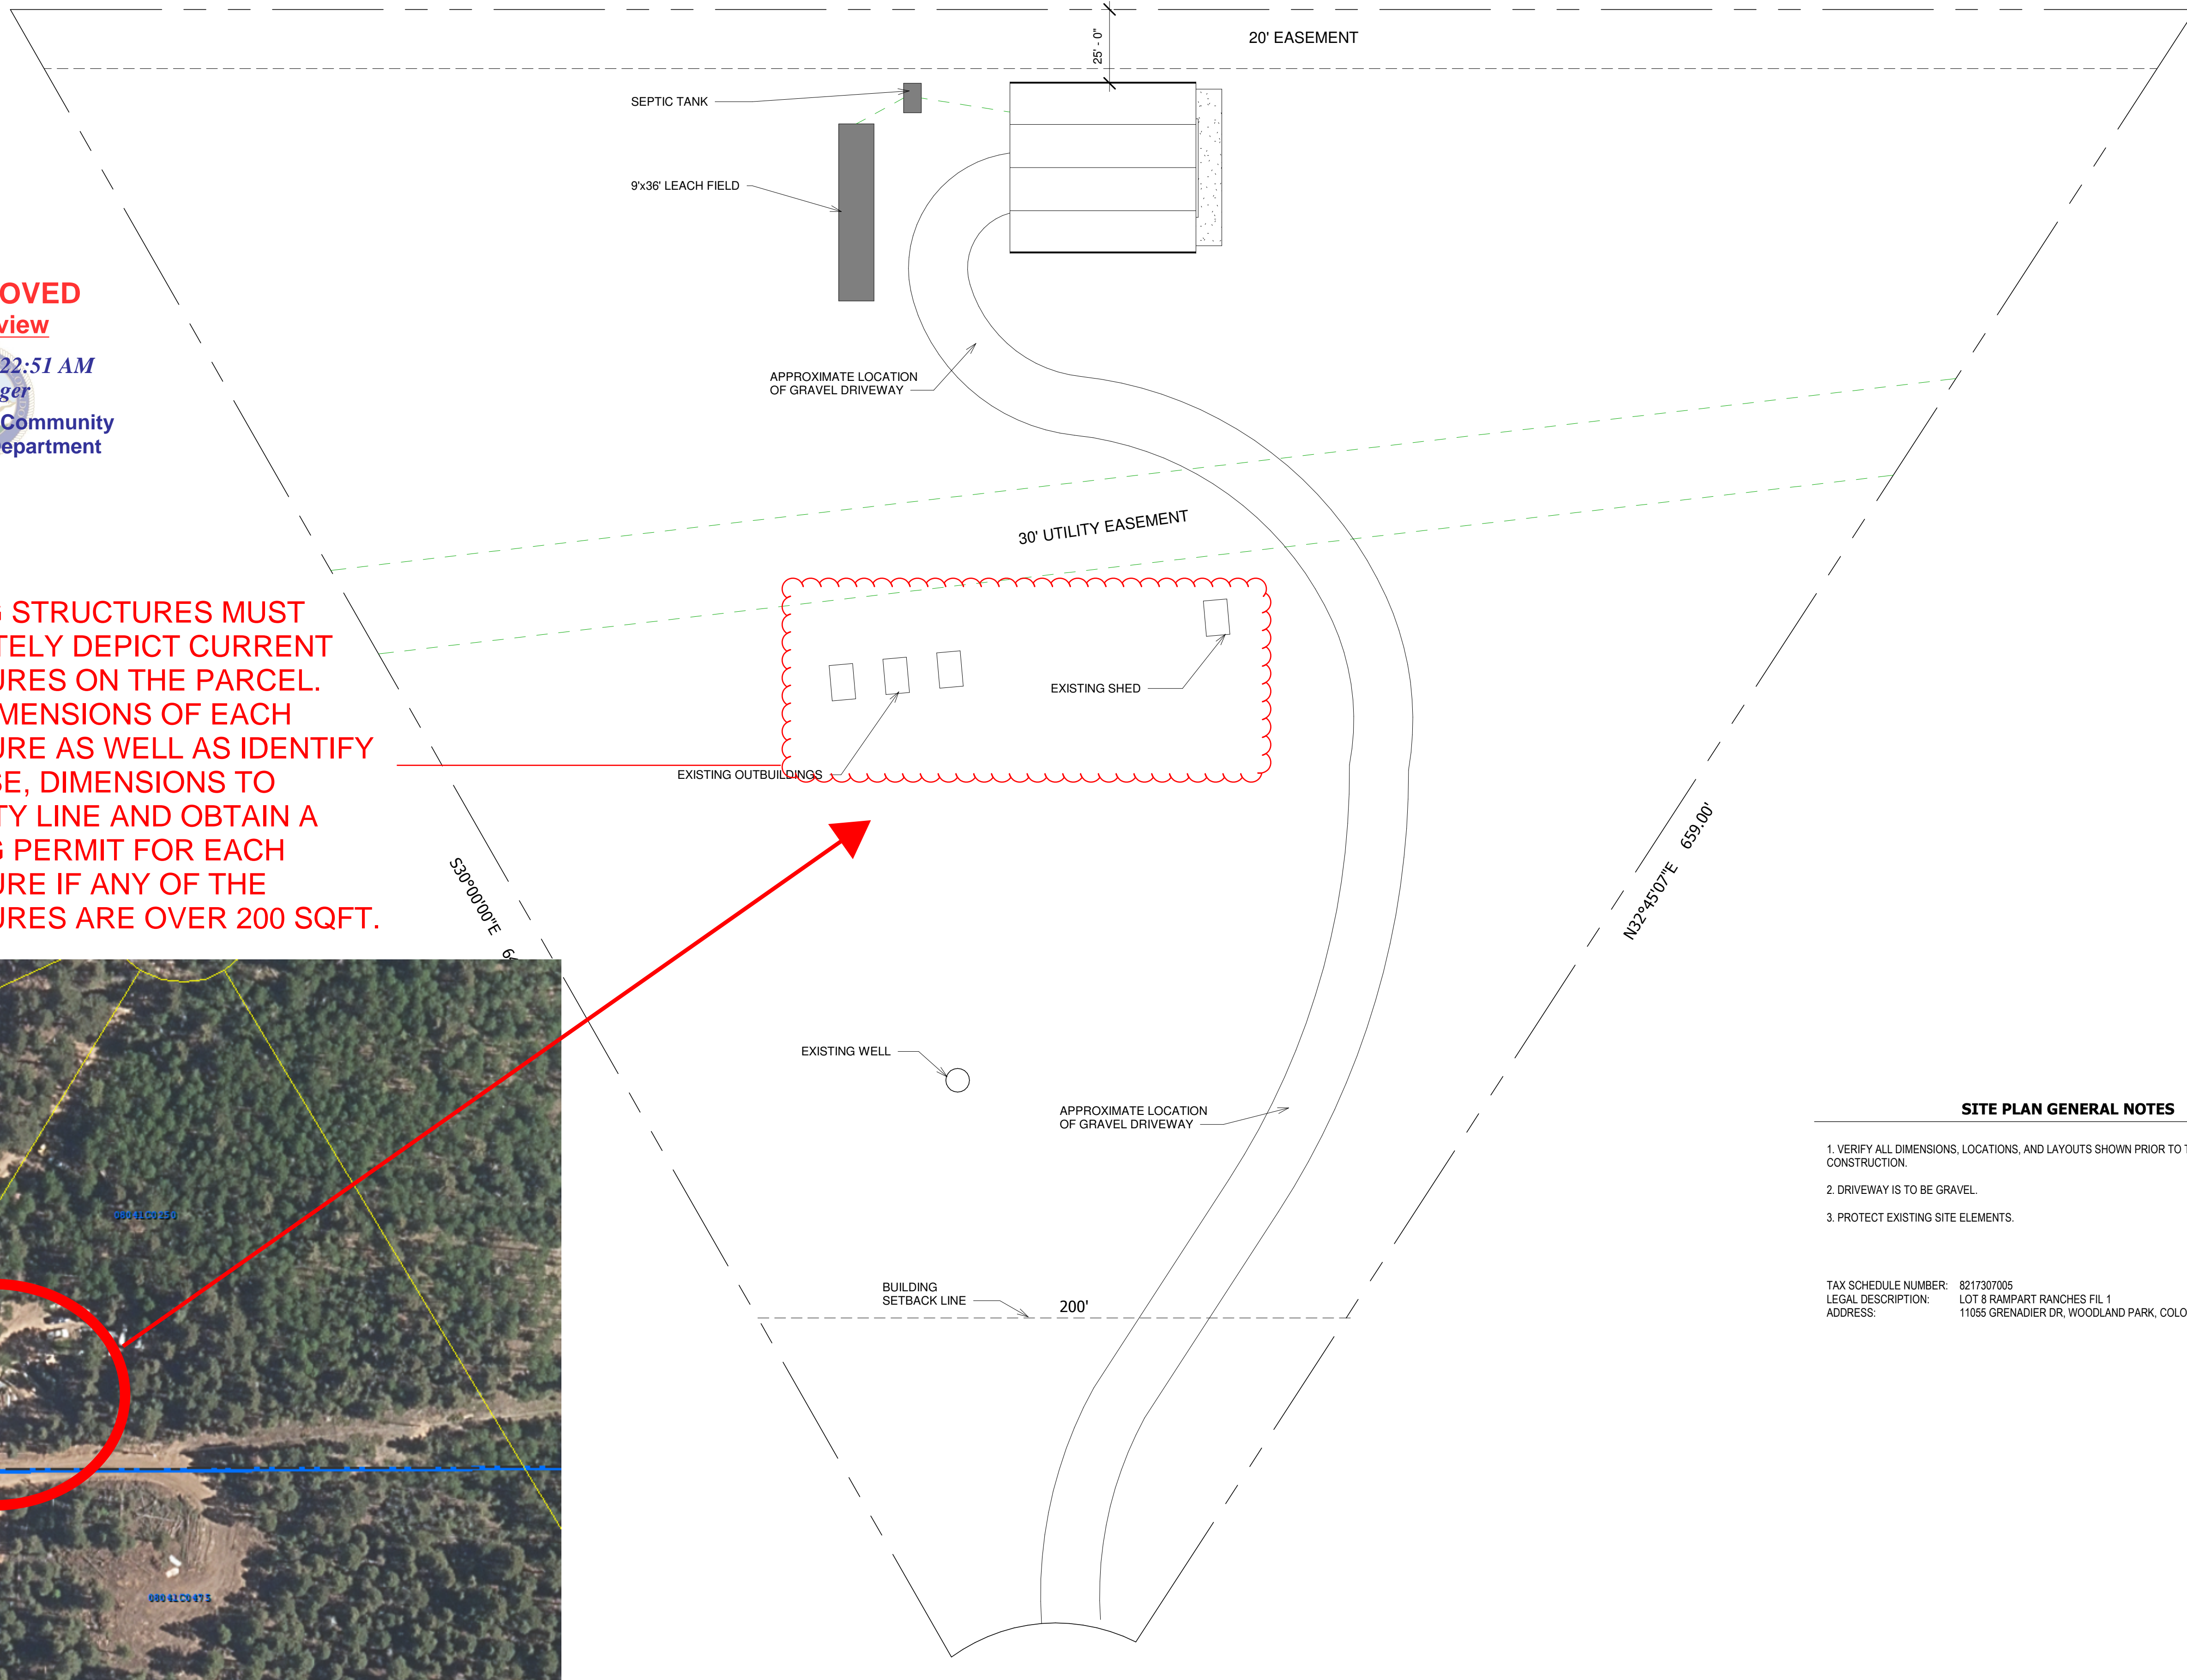

**SITE PLAN GENERAL NOTES**

1. VERIFY ALL DIMENSIONS, LOCATIONS, AND LAYOUTS SHOWN PRIOR TO THE START OF CONSTRUCTION.
2. DRIVEWAY IS TO BE GRAVEL.
3. PROTECT EXISTING SITE ELEMENTS.

TAX SCHEDULE NUMBER: 8217307005  
LEGAL DESCRIPTION: LOT 8 RAMPART RANCHES FIL 1  
ADDRESS: 11055 GRENADIER DR, WOODLAND PARK, COLORADO, 80863

**CHILLINO RESIDENCE  
NEW HOME**

11055 GRENADIER DRIVE, WOODLAND PARK, CO 80863

REVISIONS:	DATE
#	DESCRIPTION

PROJECT #: -  
ISSUE DATE: AUG 20, 2018  
ISSUED FOR: PERMIT  
DRAWN BY: Author  
CHECKED BY: Checker  
COPYRIGHT © 2017

SHEET TITLE:  
**SITE PLAN**

SHEET #:  
**C1**

ALL DRAWINGS, SPECIFICATIONS AND COPIES THEREOF ARE AND SHALL REMAIN THE PROPERTY OF THE ARCHITECT. THEY ARE TO BE USED ONLY WITH RESPECT TO THIS PROJECT AND ARE NOT TO BE USED ON ANY OTHER PROJECT OR EXTENSIONS TO THIS PROJECT, EXCEPT BY WRITTEN AGREEMENT AND APPROPRIATE COMPENSATION TO THE ARCHITECT. SUCH DOCUMENTS ARE TO BE RETURNED OR SUITABLY ACCOUNTED FOR BY THE ARCHITECT ON REQUEST AT THE COMPLETION OF WORK.