

Monument Hill CM, LLC

1864 Woodmoor Drive – Suite 100
Monument, Colorado 80132
719-476-0800 | admin@Monumenthillcm.com

July 12, 2022

Mr. Charlie Williams
Winsome, LLC
1864 Woodmoor Drive, Suite 100
Monument, CO 80132

RE: Winsome Filing No 1 – Detention Pond Certification

Dear Mr. Williams:

The drainage facilities, including water quality ponds B, C, & D and detention pond 3 were installed in conformance with the construction documents for Winsome Filing No 1 approved by El Paso County 12/29/2020. This certification is based on periodic site visits and as-built surveys performed by Edward James Surveying dated 11/08/2021. The results are as follows:

Volume (AF)	Design	Asbuilt	Comment
Pond B	0.462	0.447	new model
Pond C	1.037	1.091	revised plate
Pond D	1.329	3.405	revised plate
Pond 3	10.237	9.922	new model


Pond B was short on volume, so we ran a new model using asbuilt conditions which shows the pond is adequate. Pond C orifice plate was revised to match asbuilt conditions (7/16" diameter holes at 0.70' spacing). Pond D orifice plate was revised to match asbuilt conditions (11/16" diameter holes at 0.50' spacing). Pond 3 was short on volume, so we ran a new model using asbuilt conditions which shows the pond is adequate.

The pond bottoms were graded to be approximately 3" below the trickle channel curbs, to trap additional sediment. If the trickle channels are compromised at time of Final Acceptance, the County will not accept the ponds until the trickle channels have been repaired and pond bottom(s) raised to meet the top of trickle channel curb.


Please let me know if you have any questions or need further assistance.

Sincerely,


Joseph W. DesJardin, PE
Director of Entitlements
Monument Hill CM, LLC

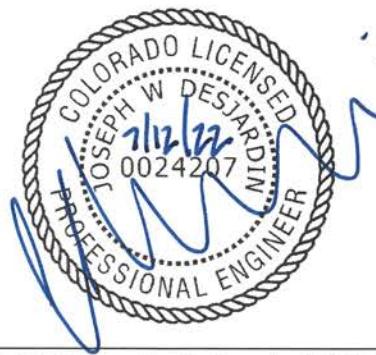

Joseph W. DesJardin, Colorado PE 24207

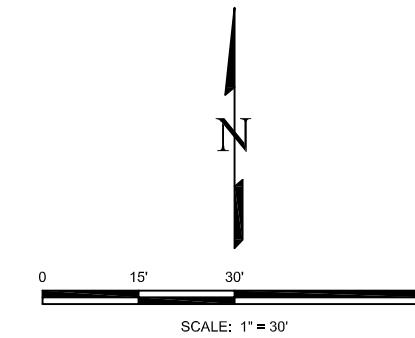


Winsome Filing 1
Pond B Asbuilt 11-05-21

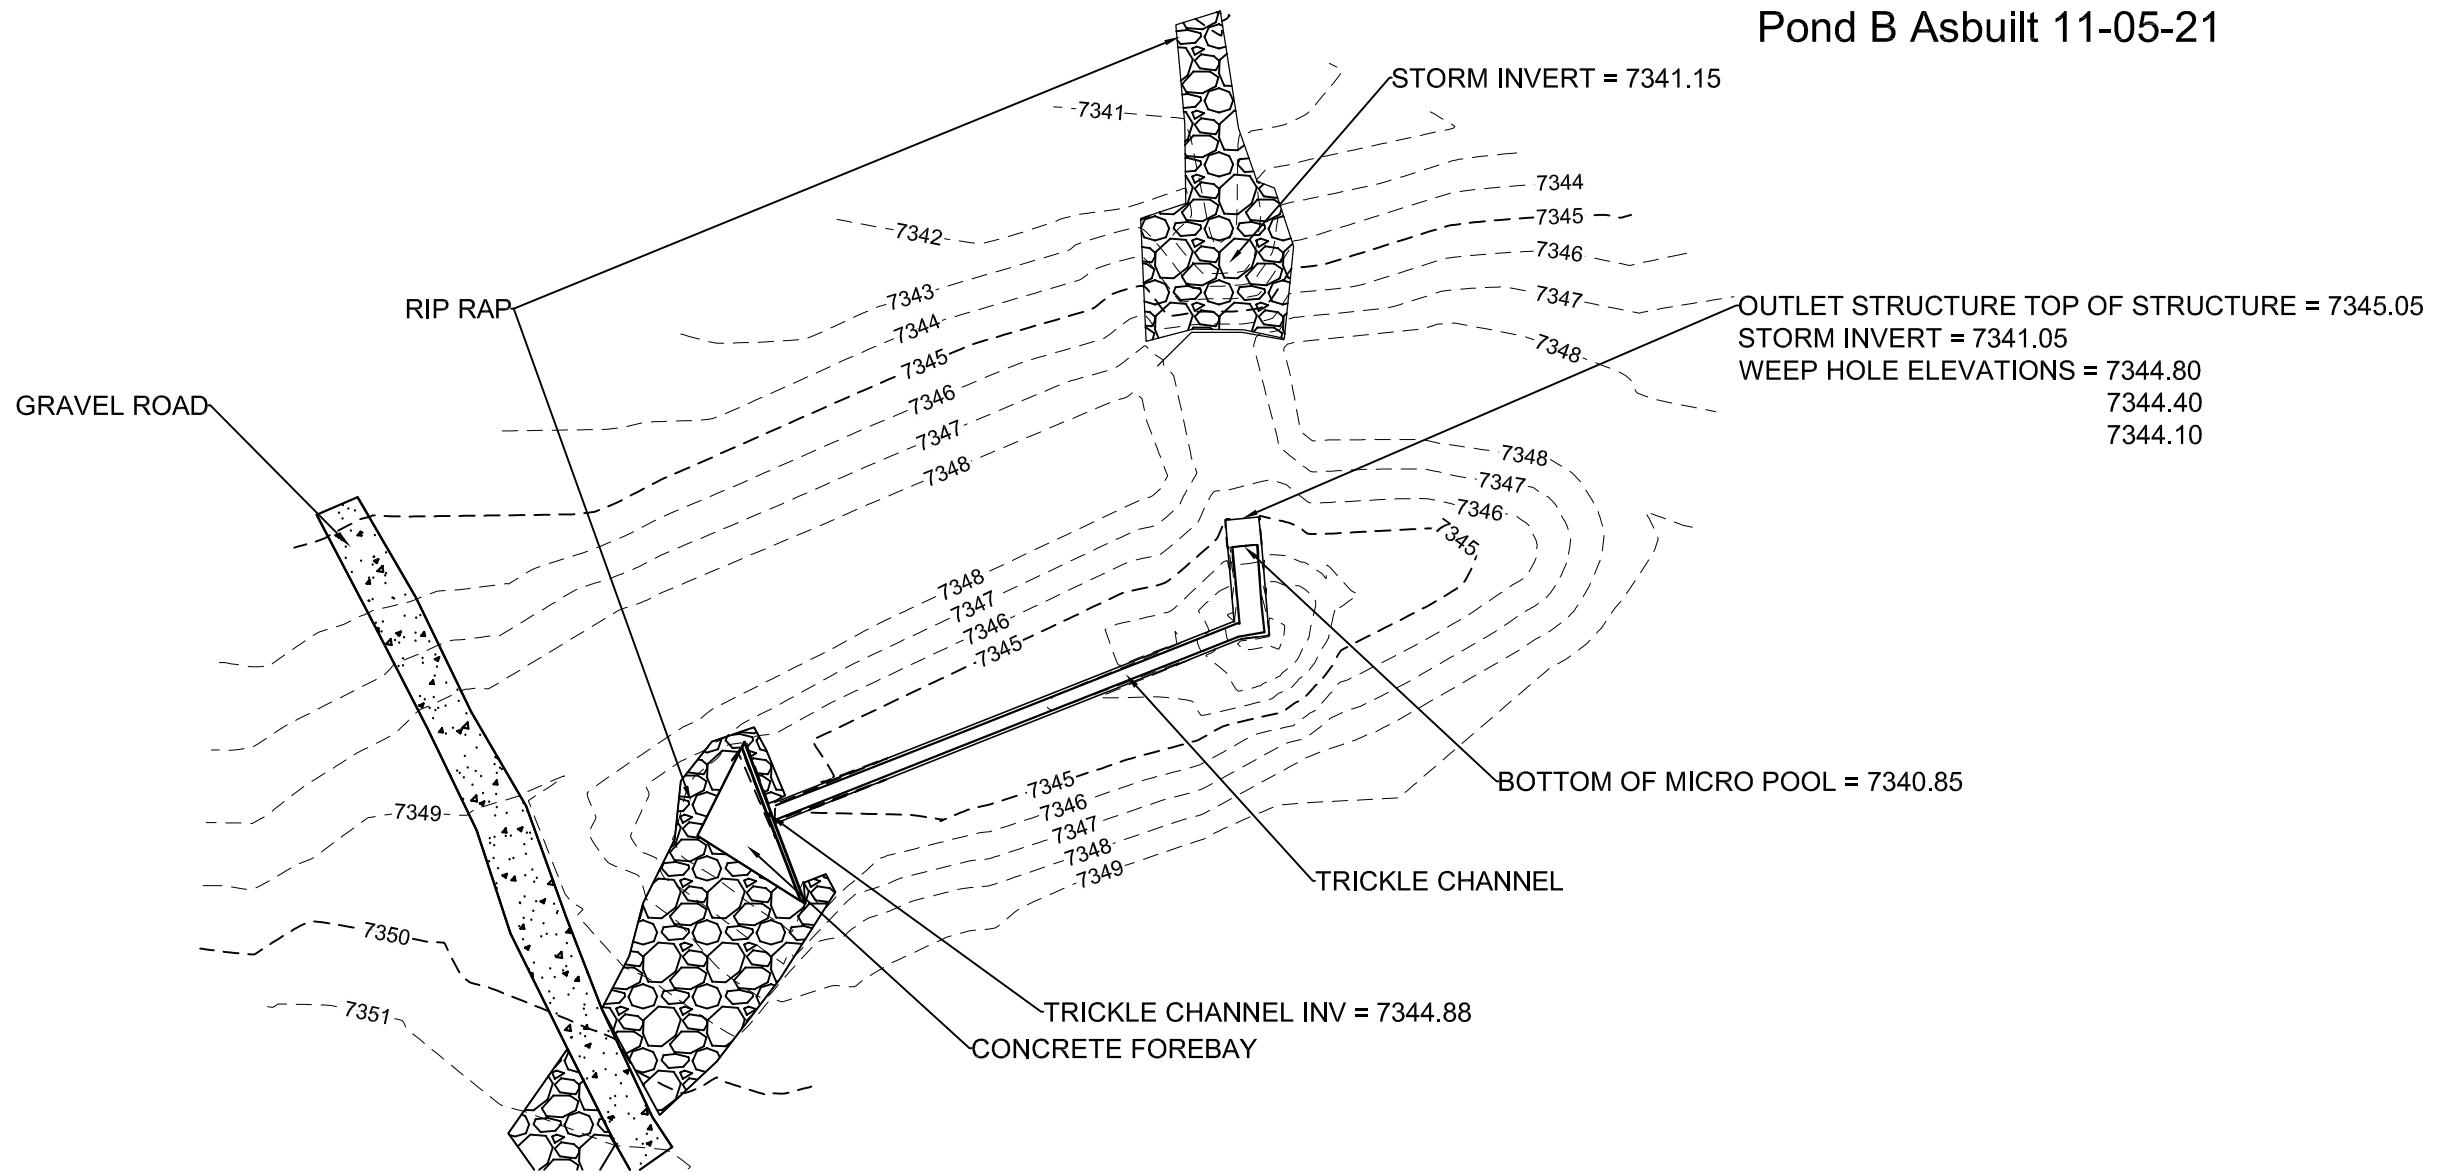


N


0 15' 30' 60'
SCALE: 1" = 30'

Winsome Filing 1
Pond C Asbuilt 8-05-21

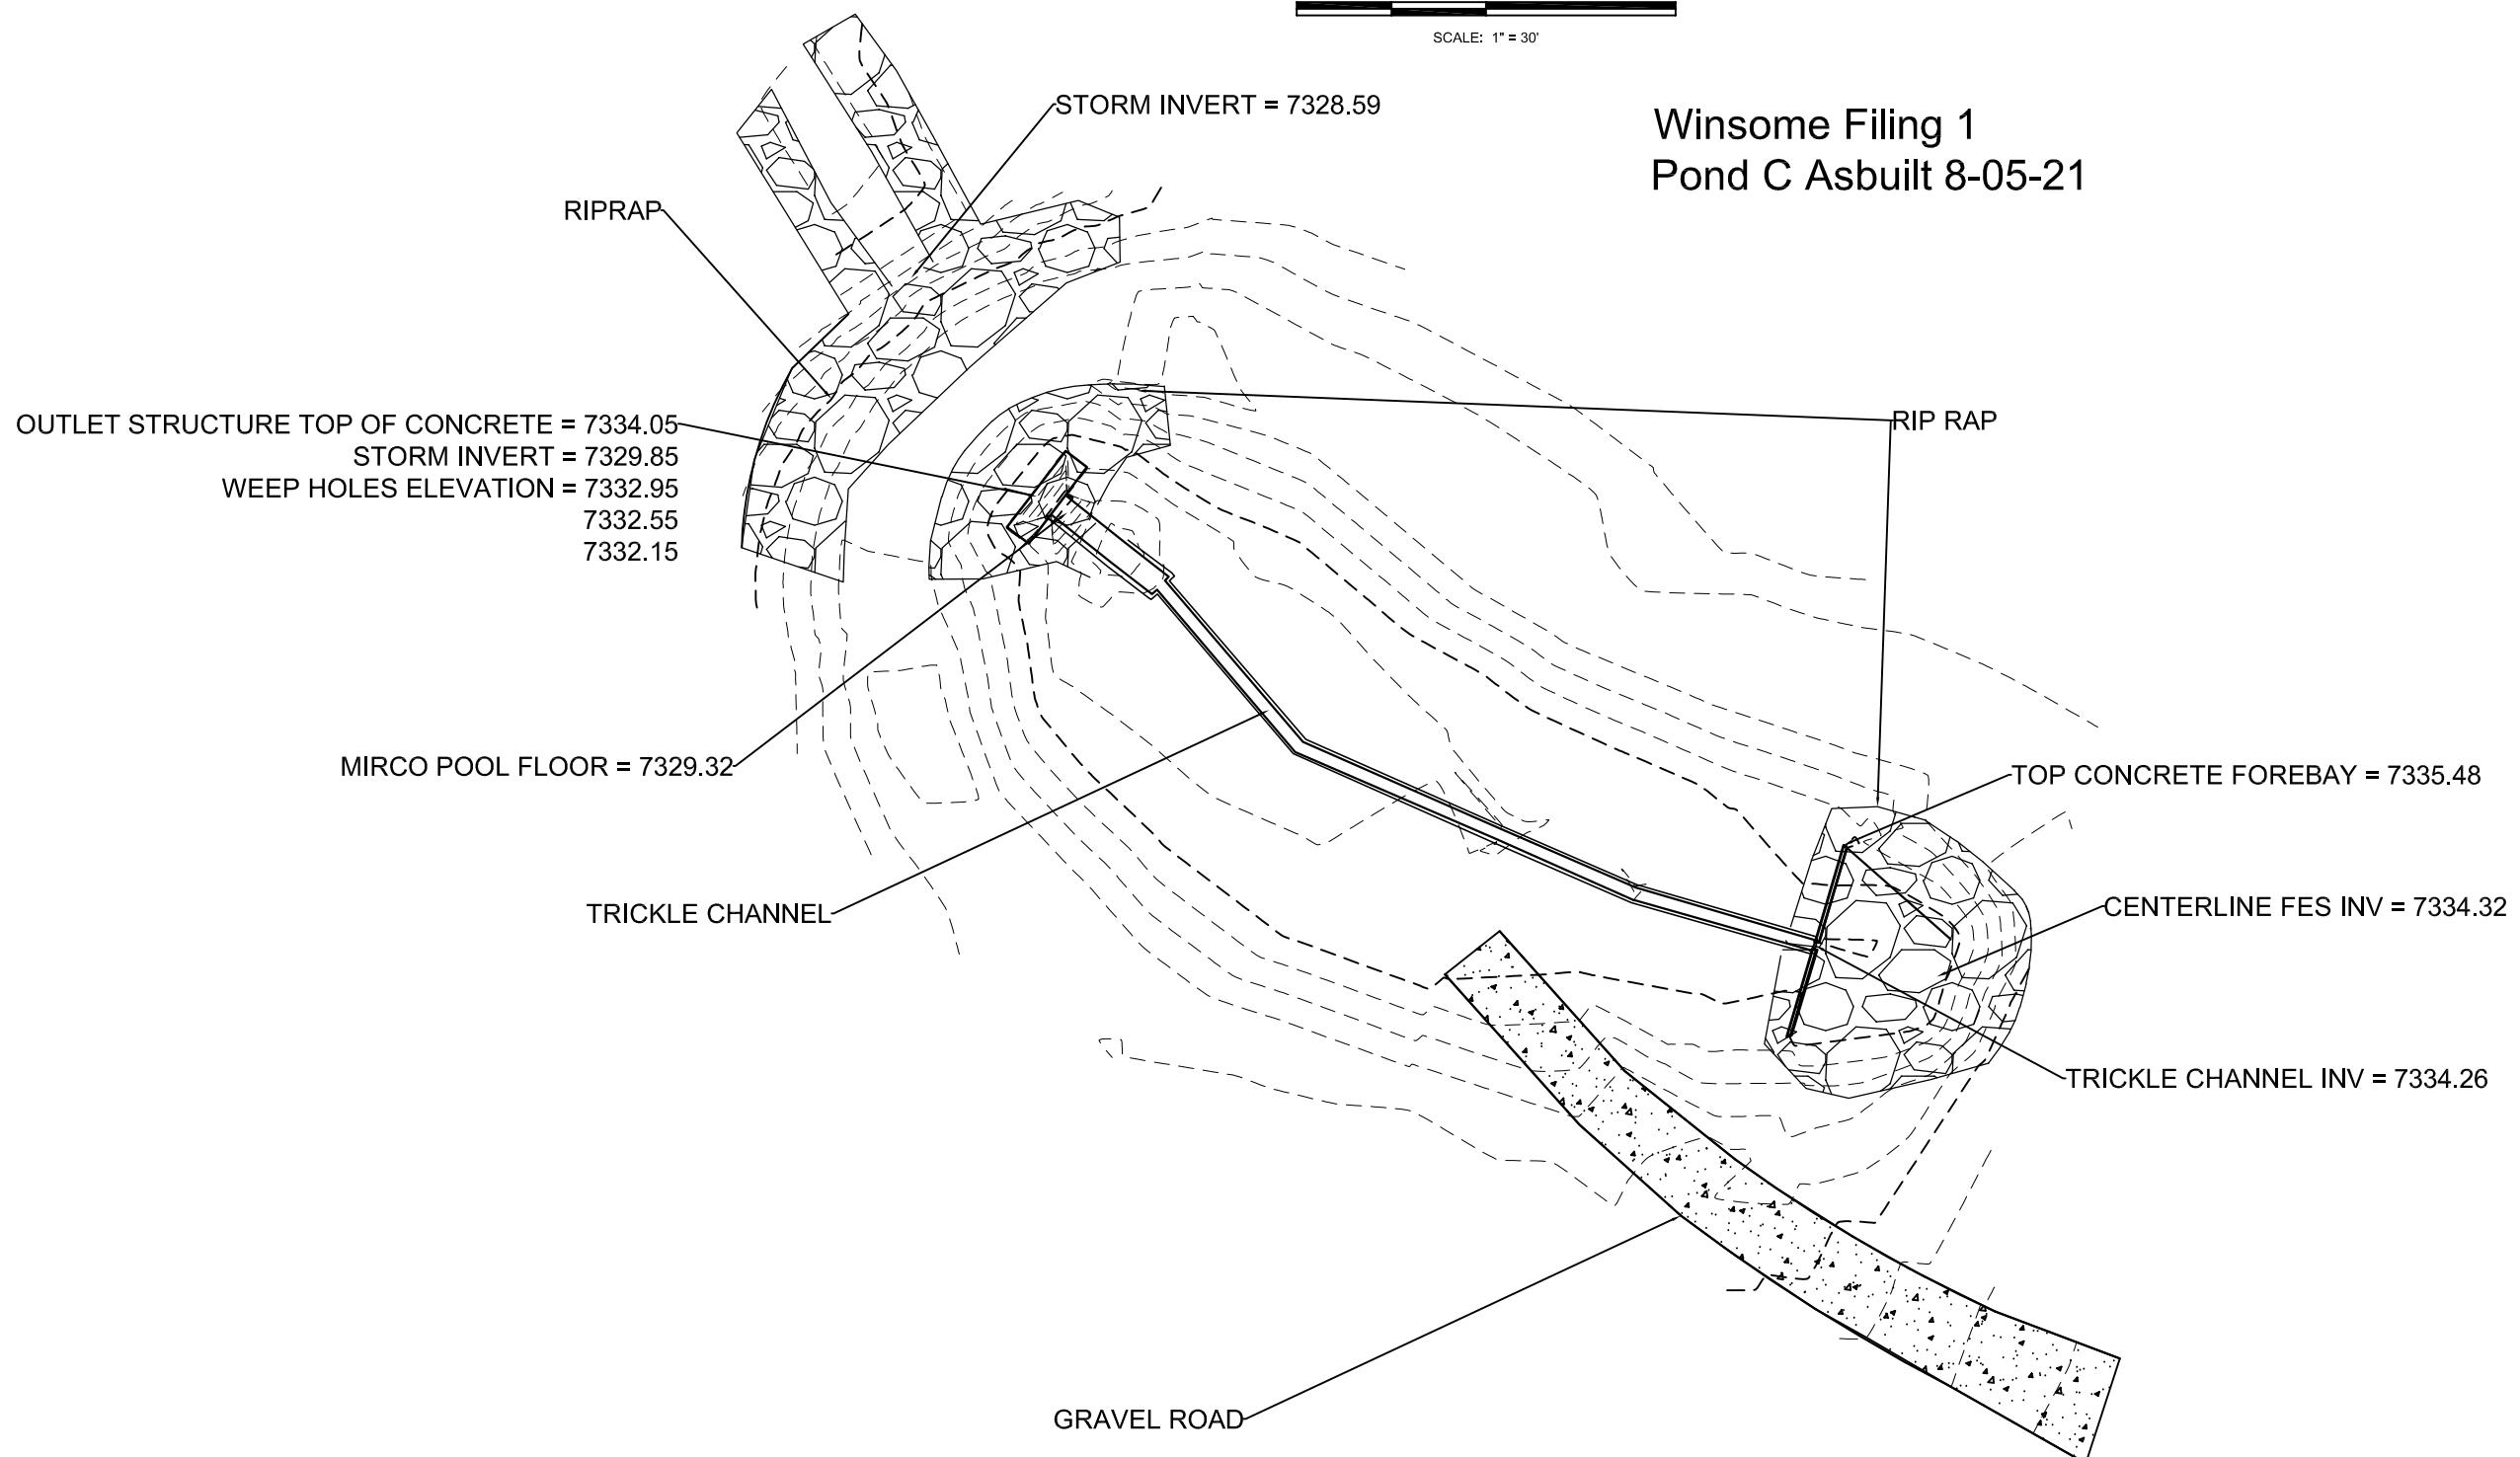

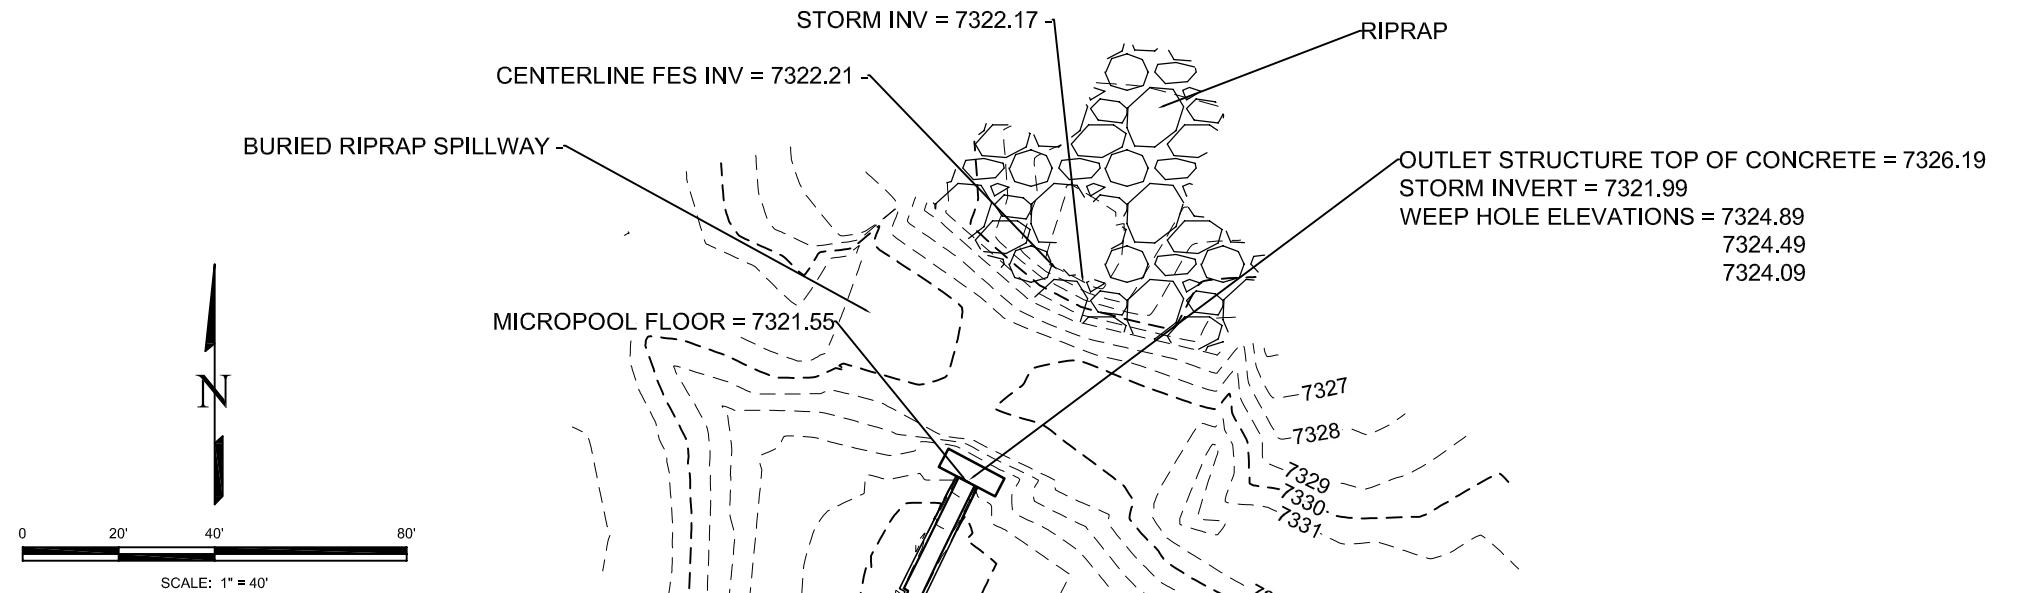


Winsome Filing 1
Pond D Asbuilt 11-08-21

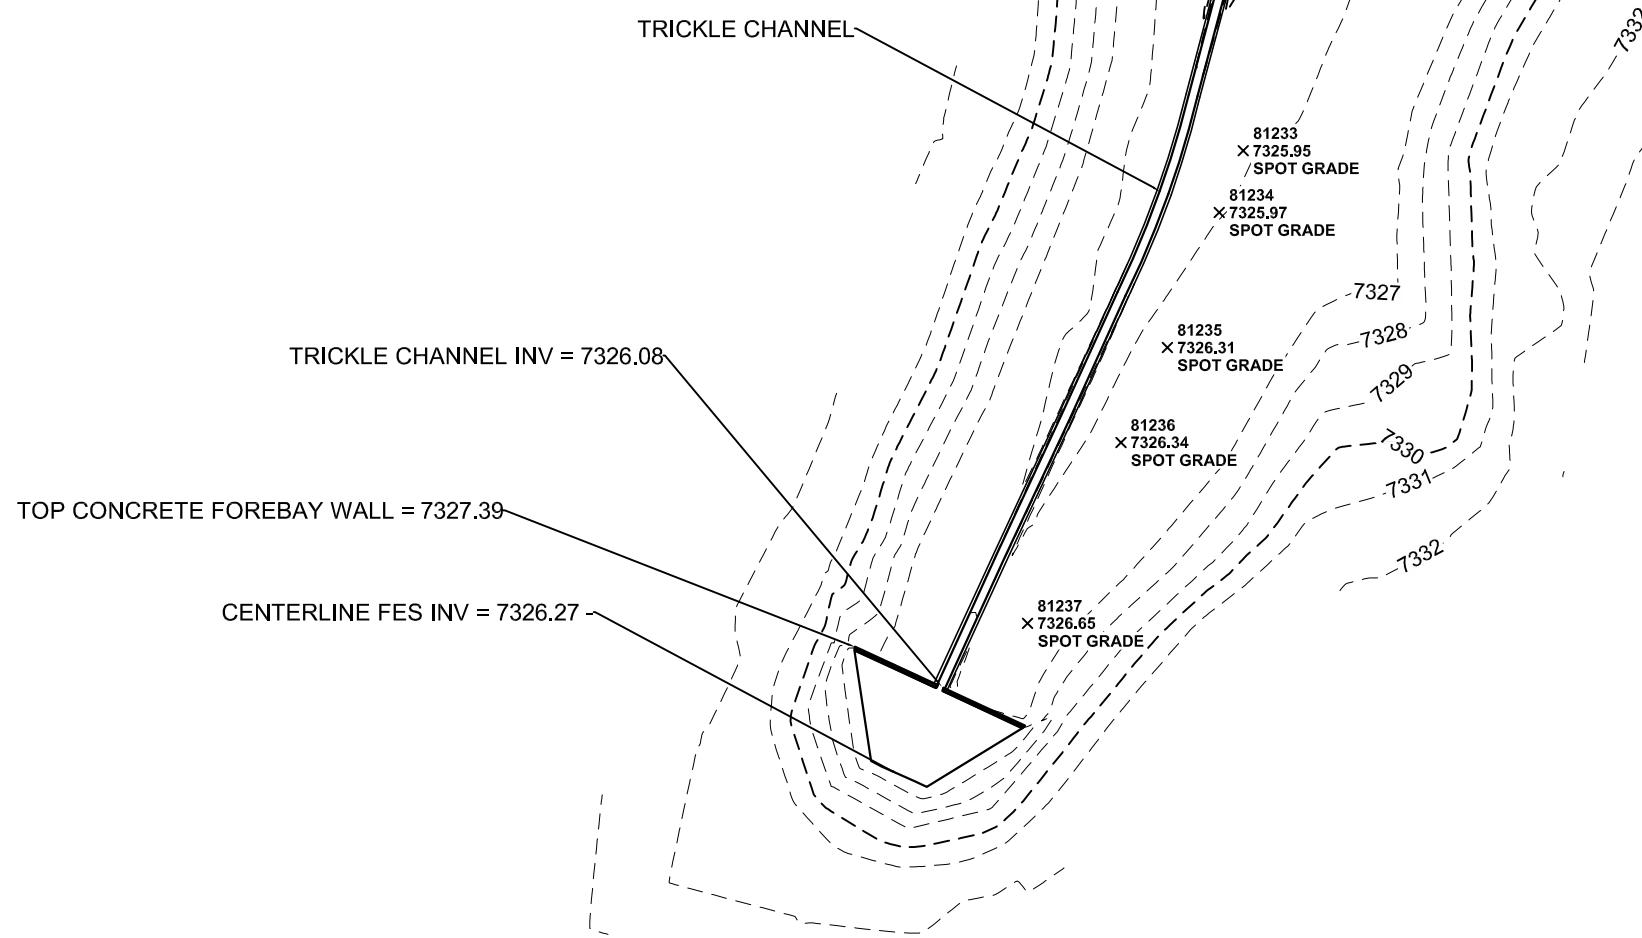

Winsome Filing 1


Pond 3 Asbuilt 11-08-21

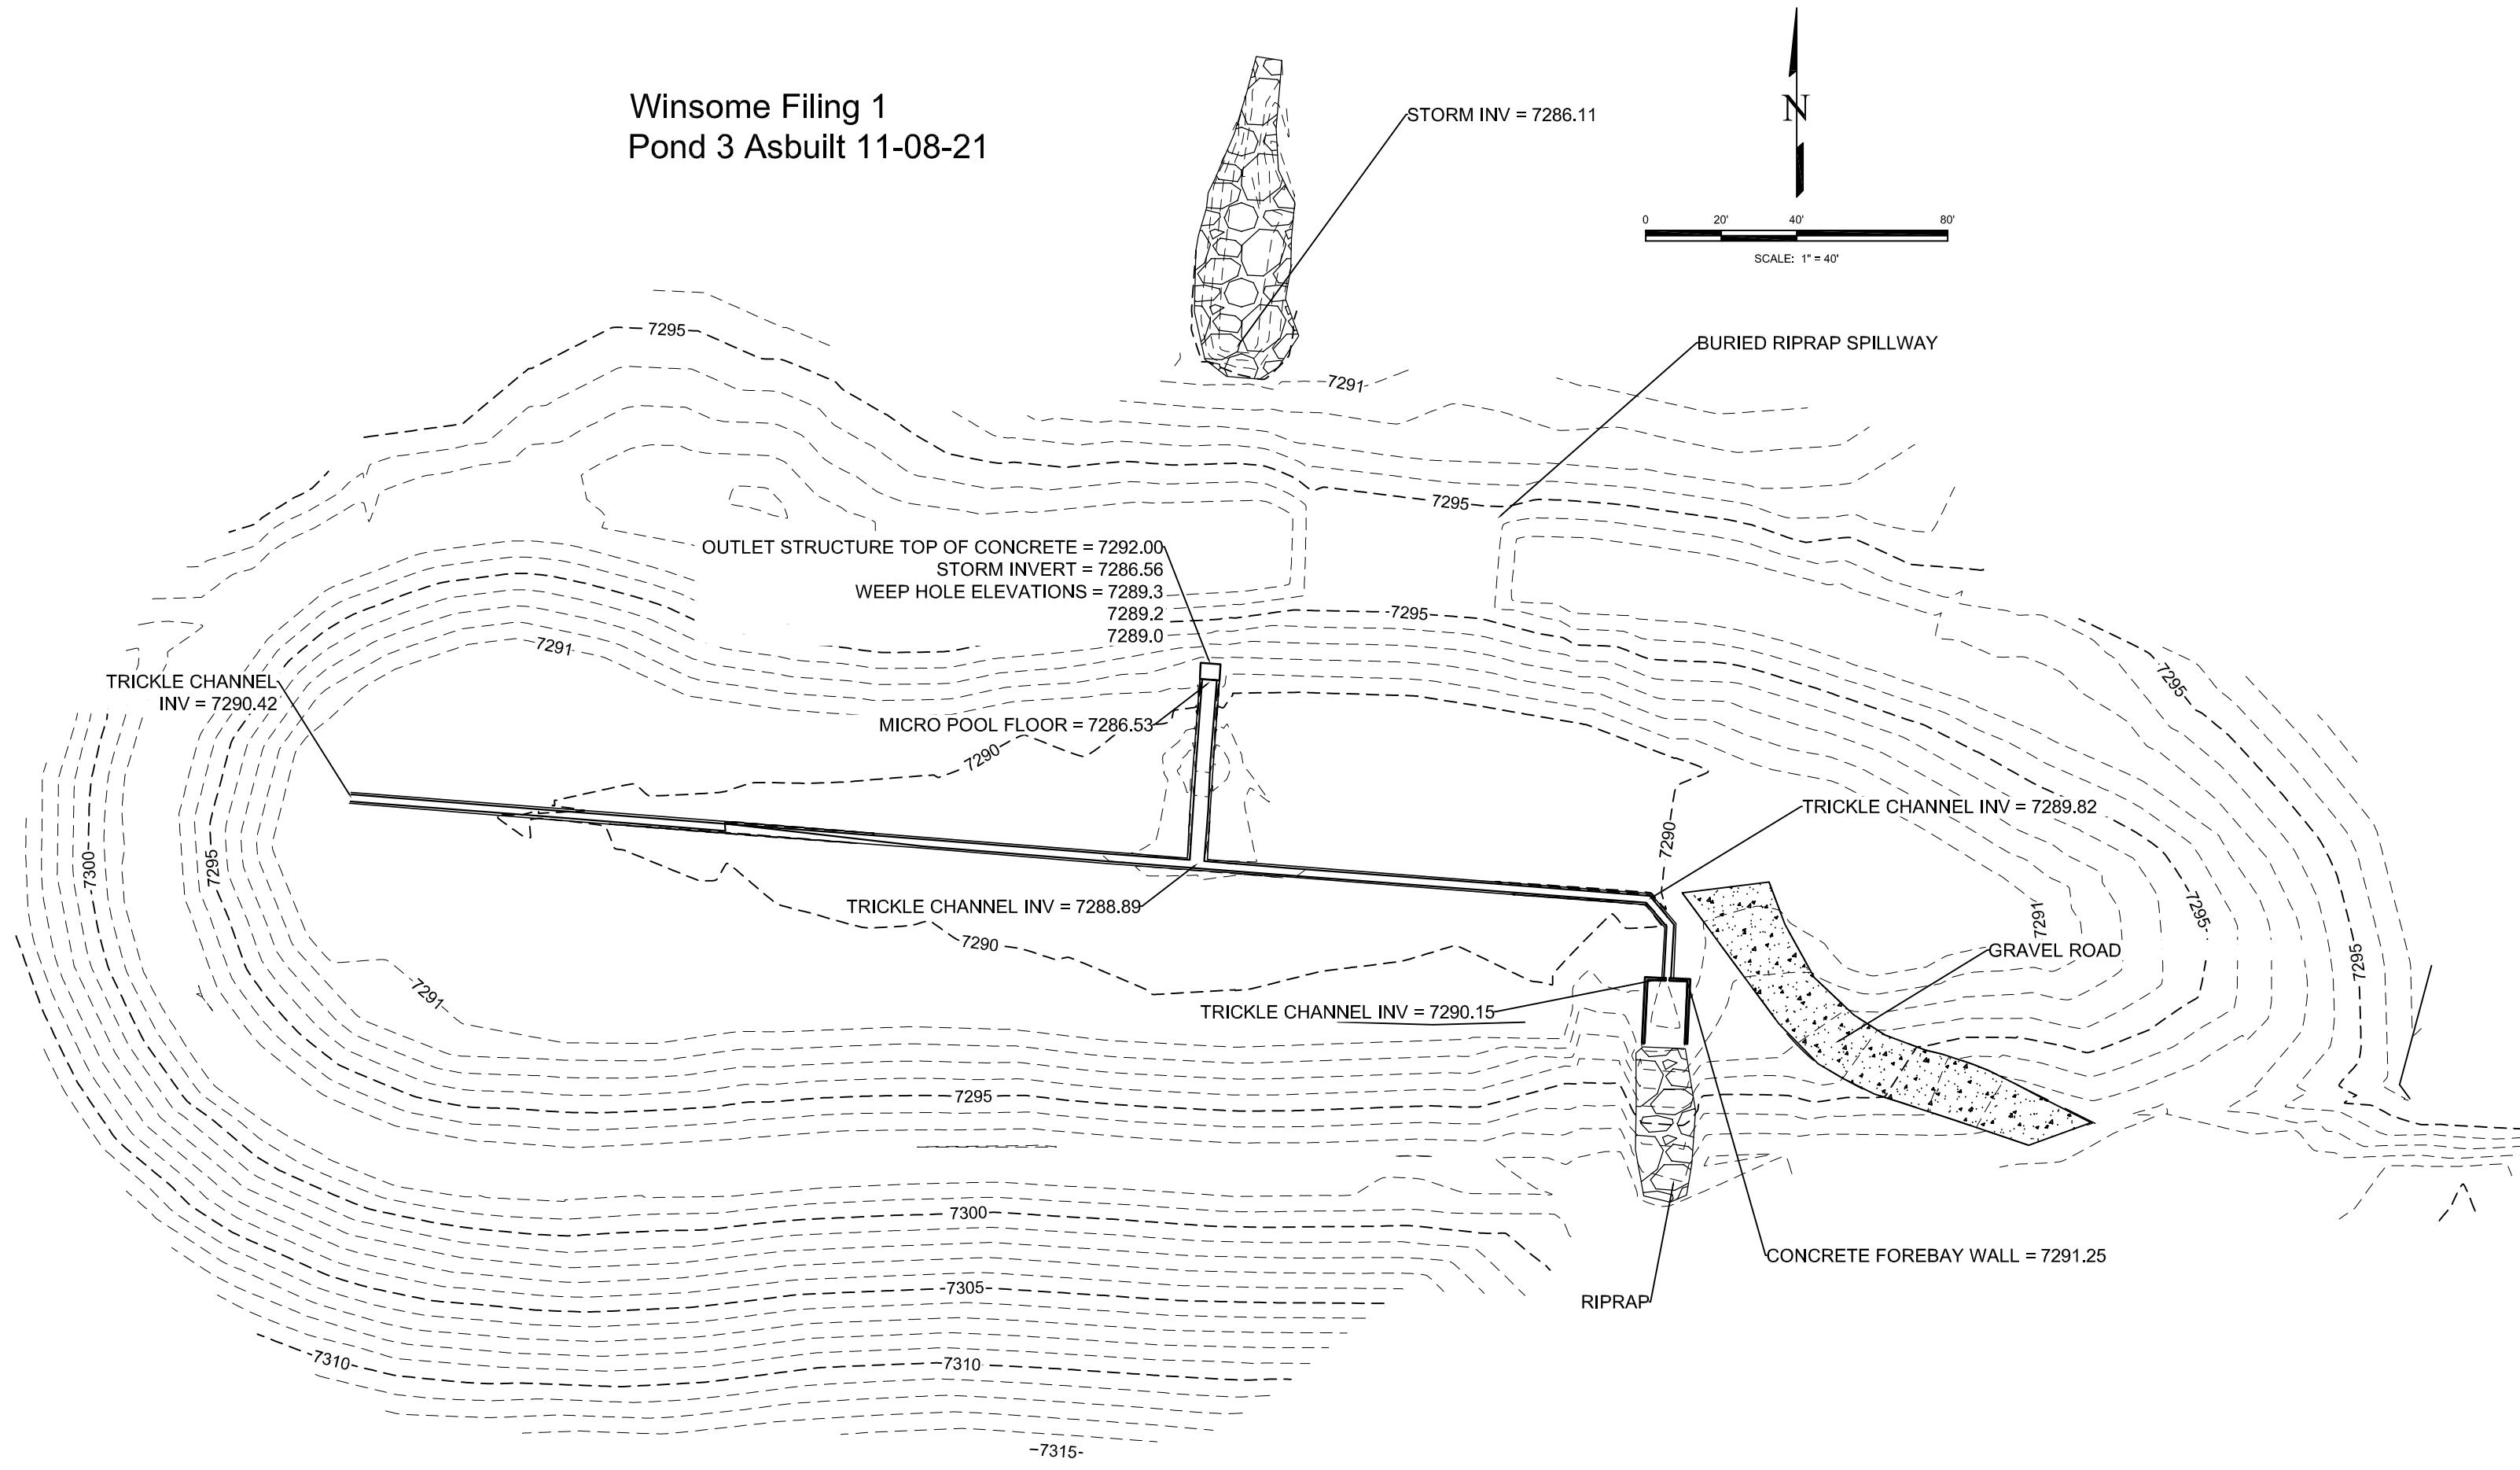

VERTEX®

2420 W. 26th AVE, SUITE 100-D
DENVER, COLORADO 80211
PH. (303) 623-9116
FAX (303) 623-9118

JOB WINDOMS FLOOR No 1
SHEET NO. _____
CALCULATED BY _____ DATE 11/11/21
CHECKED BY POND C DATE _____
SCALE _____

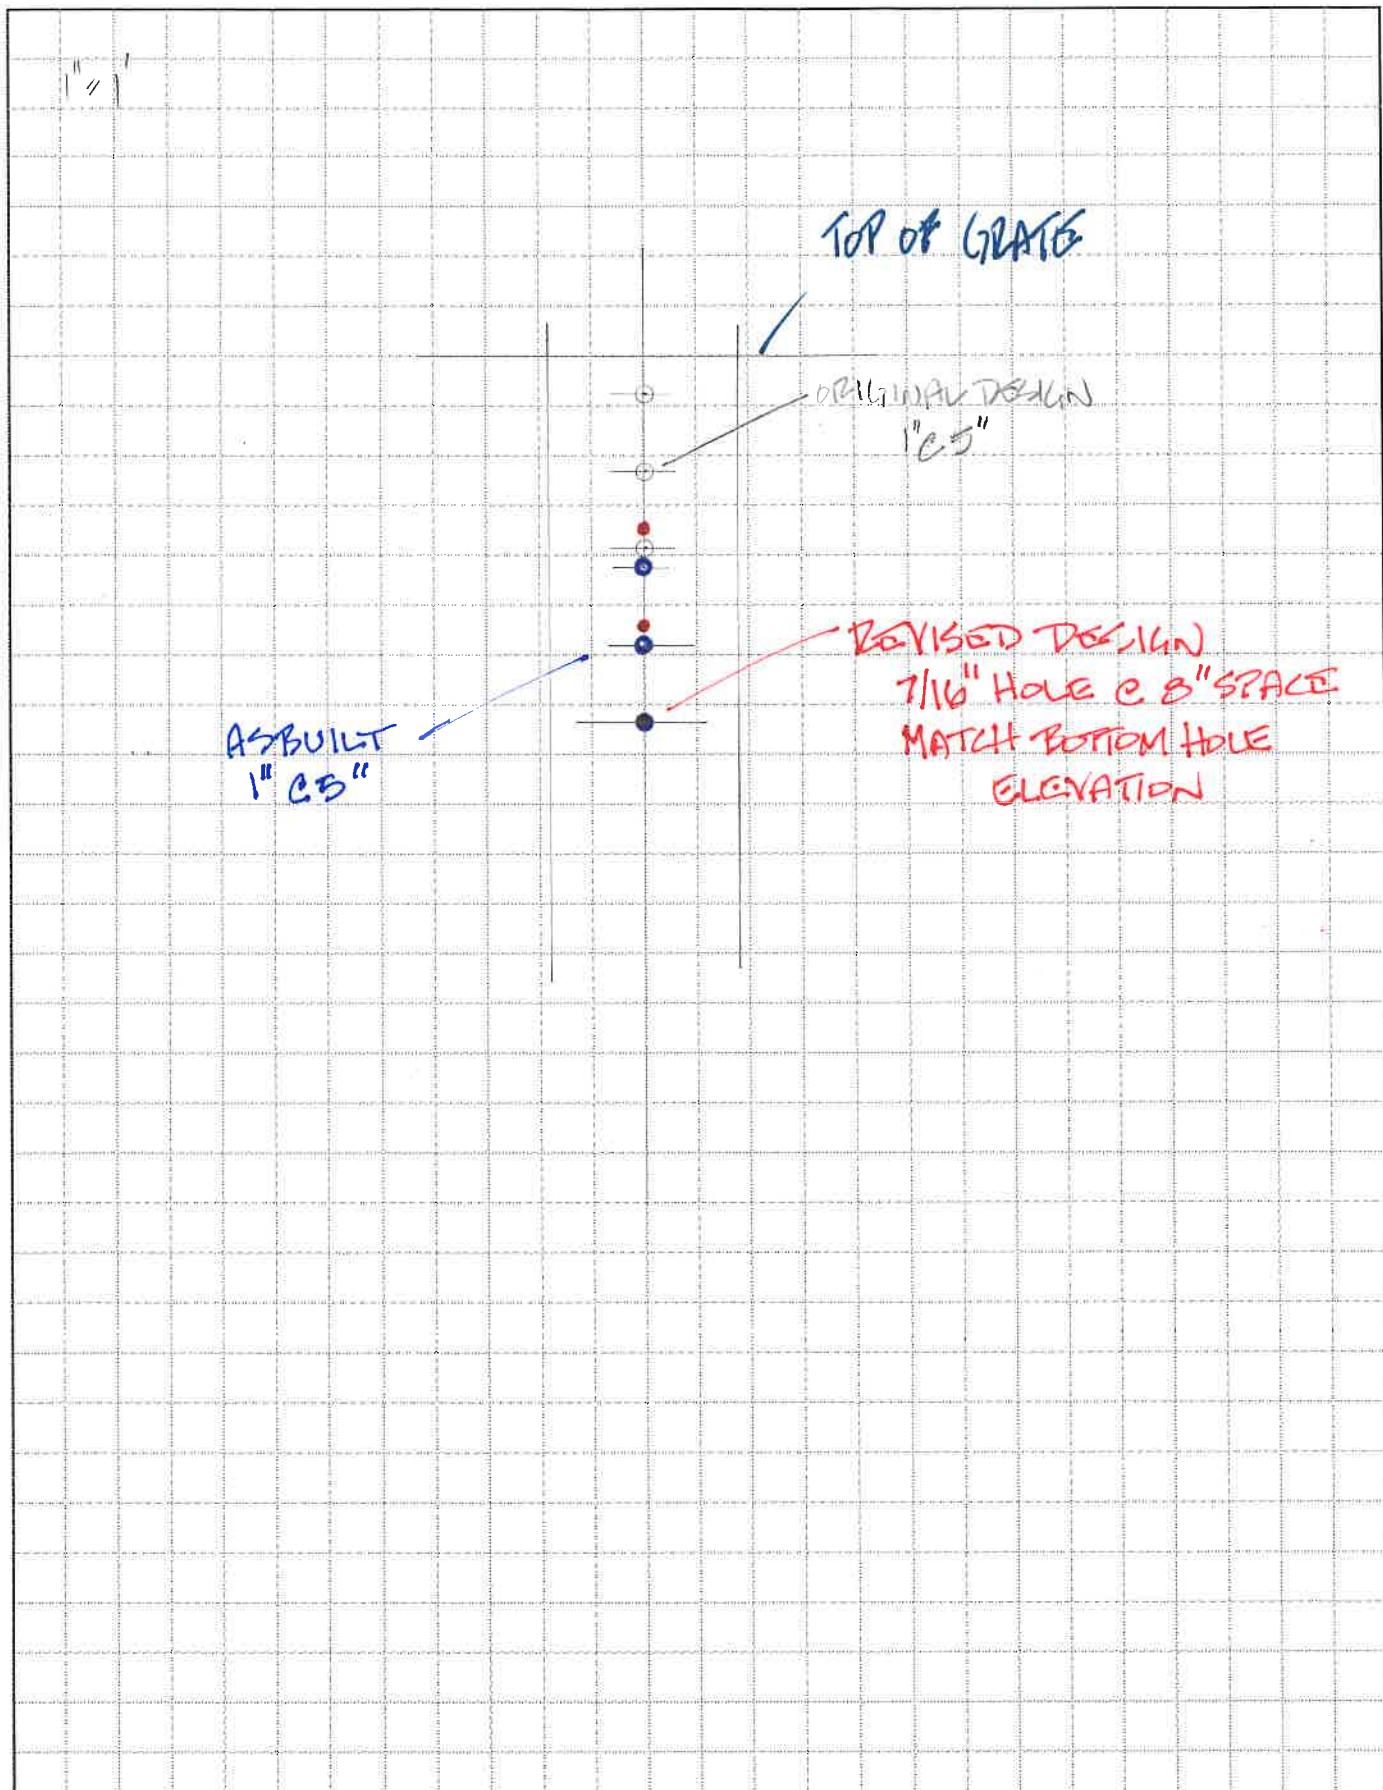


VERTEX®

2420 W. 26th AVE, SUITE 100-D
DENVER, COLORADO 80211

PH. (303) 623-9116

FAX (303) 623-9118

JOB WINSOME PILING No 1
SHEET NO. _____
CALCULATED BY _____ DATE 11/11/21
CHECKED BY _____ DATE _____
SCALE _____

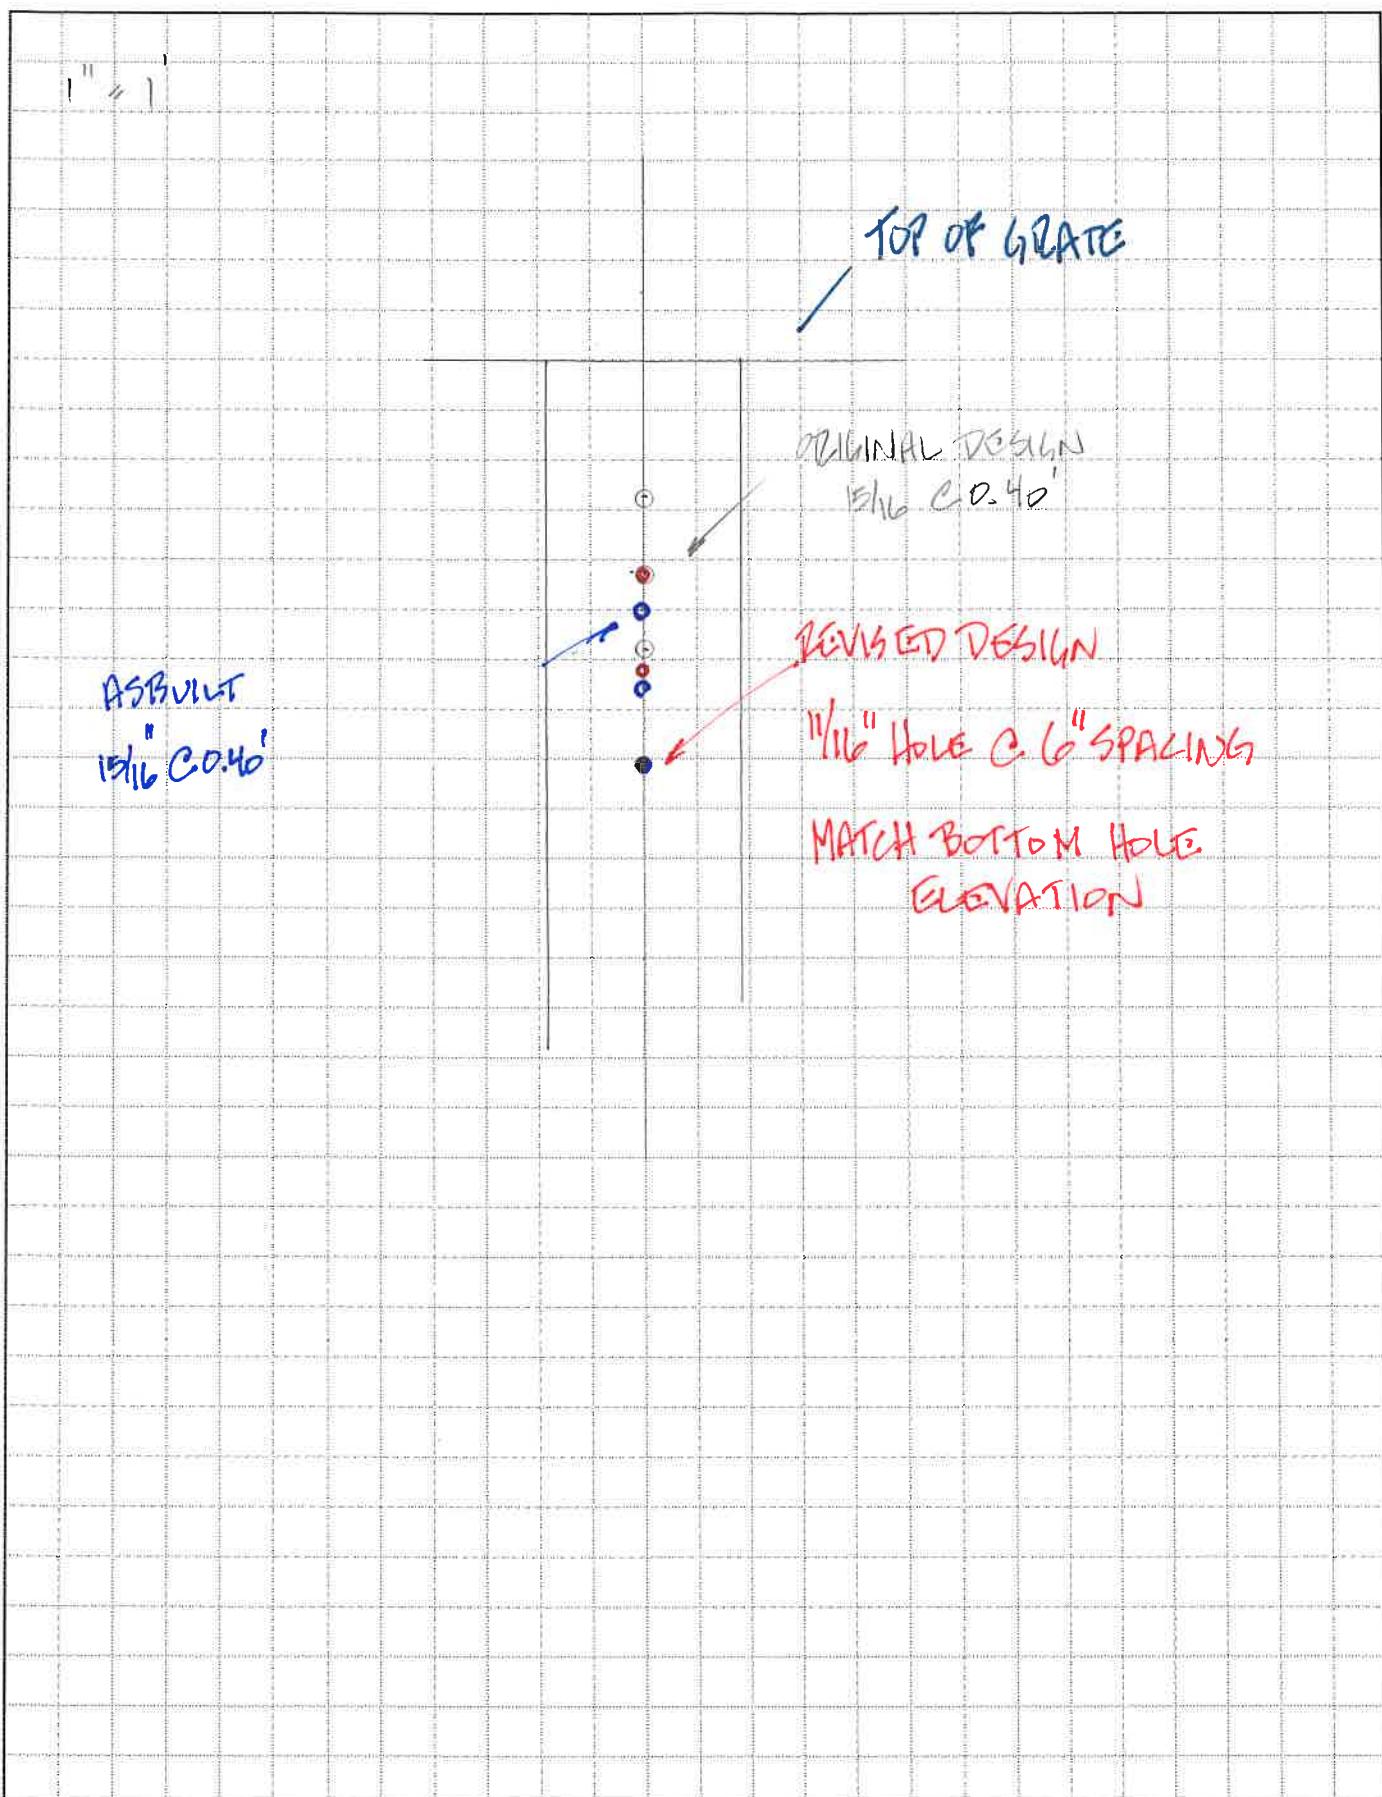

DETENTION BASIN DESIGN WORKBOOK

UD-Detention, Version 3.07 (February 2017)

Urban Drainage and Flood Control District

Denver, Colorado

www.udfcd.org


Purpose:	This workbook aids in the estimation of stormwater detention basin sizing and outlet routing based on the modified puls routing method for urban watersheds. Several different BMP types and various outlet configurations can be sized.
Function:	<ol style="list-style-type: none">1. Approximates the stage-area-volume relationship for a detention basin based on watershed parameters and basin geometry parameters. Also evaluates existing user-defined basin stage-area relationships.2. Sizes filtration media orifice, outlet orifices, elliptical slots, weirs, trash racks, and develops stage-discharge relationships. Uses the Modified Puls method to route a series of hydrographs (i.e., 2-, 5-, 10-, 25-, 50-, 100- and 500-year) and calibrates the peak discharge out of the basin to match the pre-development peak discharges for the watershed.

Content:	This workbook consists of the following sheets:
Basin	Tabulates stage-area-volume relationship estimates based on watershed parameters
Outlet Structure	Tabulates a stage-discharge relationship for the user-defined outlet structure (inlet control).
Reference	Provides reference equations and figures.
User Tips and Tools	Provides instructions and video links to assist in using this workbook. Includes a stage-area calculator.
BMP Zone Images	Provides images of typical BMP zone configurations corresponding with Zone pulldown selections.
Acknowledgements:	<p>Spreadsheet Development Team: Ken MacKenzie, P.E., Holly Piza, P.E. Urban Drainage and Flood Control District</p> <p>Derek N. Rapp, P.E. Peak Stormwater Engineering, LLC</p> <p>Dr. James C.Y. Guo, Ph.D., P.E. Professor, Department of Civil Engineering, University of Colorado at Denver</p>
Comments?	Direct all comments regarding this spreadsheet workbook to: UDFCD email
Revisions?	Check for revised versions of this or any other workbook at: Downloads

DETENTION BASIN STAGE-STORAGE TABLE BUILDER

UD-Detention, Version 3.07 (February 2017)

Project: Winsome Filing 1 - Water Quality Pond B
Basin ID: WQ Pond B

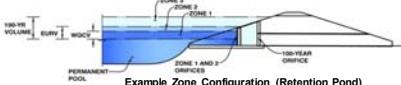

Example Zone Configuration (Retention Pond)


Required Volume Calculation		Depth Increment =									
Selected BMP Type =	EDB		Stage - Storage Description	Stage (ft)	Optional Override Stage (ft)	Length (ft)	Width (ft)	Area (ft²)	Optional Override Area (ft²)	Area (acre)	Volume (ft³)
Watershed Area =	11.00	acres									
Watershed Length =	1.048	ft									
Watershed Slope =	0.019	ft/ft									
Watershed Imperviousness =	11.00%	percent									
Percentage Hydrologic Soil Group A =	0.0%	percent									
Percentage Hydrologic Soil Group B =	100.0%	percent									
Percentage Hydrologic Soil Groups C/D =	0.0%	percent									
Desired WQCV Drain Time =	40.0	hours									
Location for 1-hr Rainfall Depths =	User Input										
Water Quality Capture Volume (WQCV) =	0.067	acre-feet									
Excess Urban Runoff Volume (EURV) =	0.115	acre-feet									
2-yr Runoff Volume ($P_1 = 1.19 \text{ in}$) =	0.080	acre-feet	1.19 inches								
5-yr Runoff Volume ($P_1 = 1.5 \text{ in}$) =	0.123	acre-feet	1.50 inches								
10-yr Runoff Volume ($P_1 = 1.75 \text{ in}$) =	0.268	acre-feet	1.75 inches								
25-yr Runoff Volume ($P_1 = 2.1 \text{ in}$) =	0.680	acre-feet	2.00 inches								
50-yr Runoff Volume ($P_1 = 2.25 \text{ in}$) =	0.939	acre-feet	2.25 inches								
100-yr Runoff Volume ($P_1 = 2.5 \text{ in}$) =	1.277	acre-feet	2.52 inches								
500-yr Runoff Volume ($P_1 = 0 \text{ in}$) =	0.000	acre-feet									
Approximate 2-yr Detention Volume =	0.074	acre-feet									
Approximate 5-yr Detention Volume =	0.115	acre-feet									
Approximate 10-yr Detention Volume =	0.229	acre-feet									
Approximate 25-yr Detention Volume =	0.515	acre-feet									
Approximate 50-yr Detention Volume =	0.330	acre-feet									
Approximate 100-yr Detention Volume =	0.425	acre-feet									

Stage-Storage Calculation

Zone 1 Volume (User Defined) =	0.017	acre-feet	WQCV not provided! Total detention volume is less than 100-year volume.
Select Zone 2 Storage Volume (Optional) =			
Select Zone 3 Storage Volume (Optional) =			
Total Detention Basin Volume =	0.017	acre-feet	
Initial Surcharge Volume (ISV) =	user	ft³	
Initial Surcharge Depth (ISD) =	user	ft	
Total Available Detention Depth (H_{total}) =	user	ft	
Depth of Trickle Channel ($H_{t,c}$) =	user	ft	
Slope of Trickle Channel ($S_{t,c}$) =	user	ft/ft	
Slopes of Main Basin Sides ($S_{m,s}$) =	user	ft/V	
Basin Length-to-Width Ratio ($R_{l,w}$) =	user		
Initial Surcharge Area ($A_{s,u}$) =	user	ft²	
Surcharge Volume Length ($L_{s,u}$) =	user	ft	
Surcharge Volume Width ($W_{s,u}$) =	user	ft	
Depth of Basin Floor ($H_{b,floor}$) =	user	ft	
Length of Basin Floor ($L_{b,floor}$) =	user	ft	
Width of Basin Floor ($W_{b,floor}$) =	user	ft	
Area of Basin Floor ($A_{b,floor}$) =	user	ft²	
Volume of Basin Floor ($V_{b,floor}$) =	user	ft³	
Depth of Main Basin ($H_{m,b}$) =	user	ft	
Length of Main Basin ($L_{m,b}$) =	user	ft	
Width of Main Basin ($W_{m,b}$) =	user	ft	
Area of Main Basin ($A_{m,b}$) =	user	ft²	
Volume of Main Basin ($V_{m,b}$) =	user	ft³	
Calculated Total Basin Volume (V_{total}) =	user	acre-feet	

DETENTION BASIN STAGE-STORAGE TABLE BUILDER


UD-Detention, Version 3.07 (February 2017)

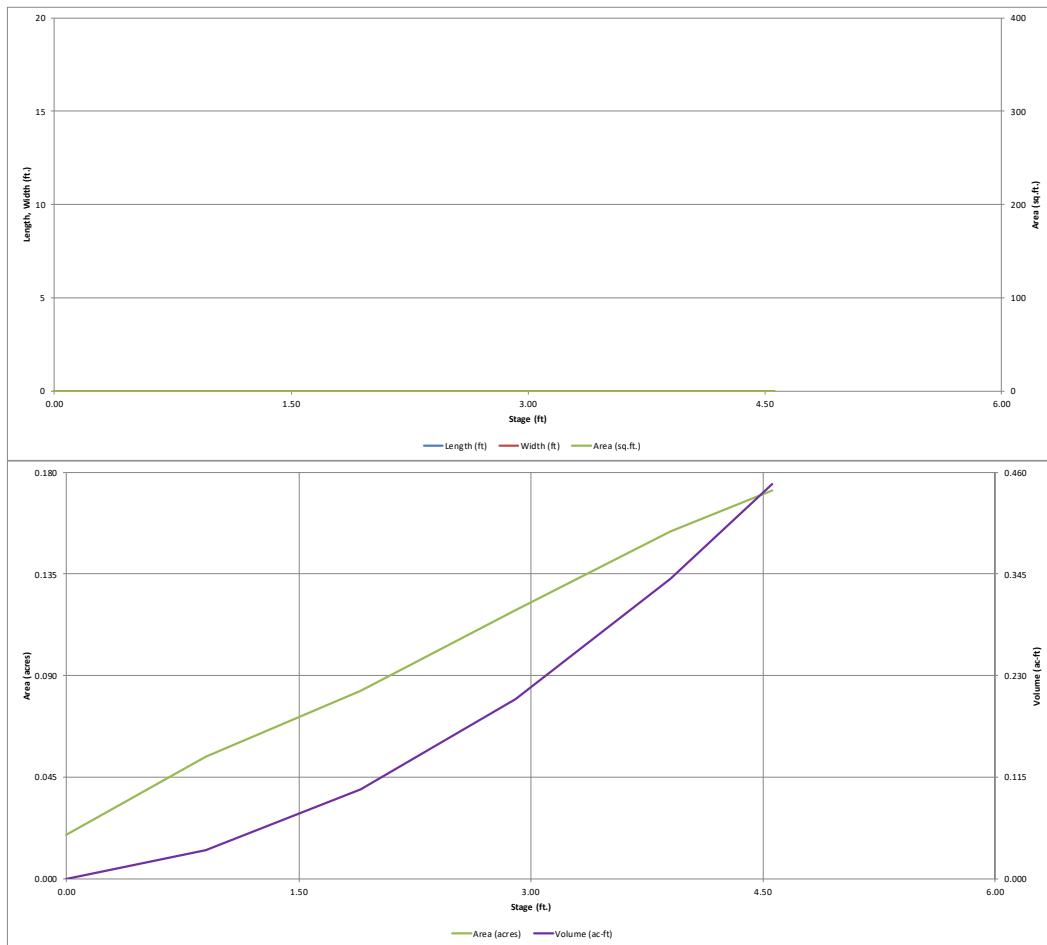

Detention Basin Outlet Structure Design

UD-Detention, Version 3.07 (February 2017)

Project: Winsome Filing 1 - Water Quality Pond B
Basin ID: WQ Pond B

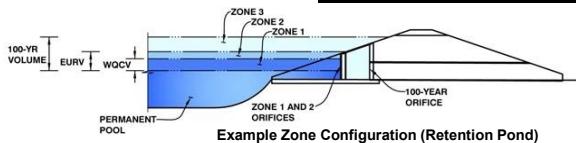

Example Zone Configuration (Retention Pond)

	Stage (ft)	Zone Volume (ac-ft)	Outlet Type
Zone 1 (User)	0.57	0.017	Orifice Plate
Zone 2			Weir&Pipe (Circular)
Zone 3			
Total			0.017

User Input: Orifice at Underdrain Outlet (typically used to drain WQCV in a Filtration BMP)

Underdrain Orifice Invert Depth = ft (distance below the filtration media surface)
Underdrain Orifice Diameter = inches

Calculated Parameters for Underdrain
Underdrain Orifice Area = ft²
Underdrain Orifice Centroid = feet

User Input: Orifice Plate with one or more orifices or Elliptical Slot Weir (typically used to drain WQCV and/or EURV in a sedimentation BMP)

Invert of Lowest Orifice = ft (relative to basin bottom at Stage = 0 ft)
Depth at top of Zone using Orifice Plate = ft (relative to basin bottom at Stage = 0 ft)
Orifice Plate: Orifice Vertical Spacing = inches
Orifice Plate: Orifice Area per Row = sq. inches (diameter = 5/8 inch)

Calculated Parameters for Plate
WQ Orifice Area per Row = ft²
Elliptical Half-Width = feet
Elliptical Slot Centroid = feet
Elliptical Slot Area = ft²

User Input: Stage and Total Area of Each Orifice Row (numbered from lowest to highest)

Row 1 (required)	Row 2 (optional)	Row 3 (optional)	Row 4 (optional)	Row 5 (optional)	Row 6 (optional)	Row 7 (optional)	Row 8 (optional)
Stage of Orifice Centroid (ft)	0.00	0.40	0.80				
Orifice Area (sq. inches)	0.30	0.30	0.30				
Stage of Orifice Centroid (ft)							
Orifice Area (sq. inches)							

User Input: Vertical Orifice (Circular or Rectangular)

Not Selected Not Selected
Invert of Vertical Orifice = ft (relative to basin bottom at Stage = 0 ft)
Depth at top of Zone using Vertical Orifice = ft (relative to basin bottom at Stage = 0 ft)
Vertical Orifice Diameter = inches

Calculated Parameters for Vertical Orifice

Not Selected	Not Selected
Vertical Orifice Area = <input type="text"/>	ft ²
Vertical Orifice Centroid = <input type="text"/>	feet

User Input: Overflow Weir (Dropbox) and Grate (Flat or Sloped)

Zone 2 Weir	Not Selected
Overflow Weir Front Edge Height, Ho = <input type="text" value="0.95"/> ft (relative to basin bottom at Stage = 0 ft)	
Overflow Weir Front Edge Length = <input type="text" value="4.00"/> feet	
Overflow Weir Slope = <input type="text" value="0.00"/> H:V (enter zero for flat grate)	
Horiz. Length of Weir Sides = <input type="text" value="3.00"/> feet	
Overflow Grate Open Area % = <input type="text" value="85%"/> %, grate open area/total area	
Debris Clogging % = <input type="text" value="50%"/> %	

Calculated Parameters for Overflow Weir

Zone 2 Weir	Not Selected
Height of Grate Upper Edge, H _t = <input type="text" value="0.95"/> feet	
Over Flow Weir Slope Length = <input type="text" value="3.00"/> feet	
Grate Open Area / 100-yr Orifice Area = <input type="text" value="5.77"/> should be ≥ 4	
Overflow Grate Open Area w/o Debris = <input type="text" value="10.20"/> ft ²	
Overflow Grate Open Area w/ Debris = <input type="text" value="5.10"/> ft ²	

User Input: Outlet Pipe w/ Flow Restriction Plate (Circular Orifice, Restrictor Plate, or Rectangular Orifice)

Zone 2 Circular	Not Selected
Depth to Invert of Outlet Pipe = <input type="text" value="3.05"/> ft (distance below basin bottom at Stage = 0 ft)	
Circular Orifice Diameter = <input type="text" value="18.00"/> inches	

Calculated Parameters for Outlet Pipe w/ Flow Restriction Plate

Zone 2 Circular	Not Selected
Outlet Orifice Area = <input type="text" value="1.77"/> ft ²	
Outlet Orifice Centroid = <input type="text" value="0.75"/> feet	
Half-Central Angle of Restrictor Plate on Pipe = <input type="text" value="N/A"/> radians	

User Input: Emergency Spillway (Rectangular or Trapezoidal)

Spillway Invert Stage = <input type="text" value="2.52"/> ft (relative to basin bottom at Stage = 0 ft)	
Spillway Crest Length = <input type="text" value="9.00"/> feet	
Spillway End Slopes = <input type="text" value="4.00"/> H:V	
Freeboard above Max Water Surface = <input type="text" value="1.00"/> feet	

Calculated Parameters for Spillway


Spillway Design Flow Depth = <input type="text" value="0.70"/> feet	
Stage at Top of Freeboard = <input type="text" value="4.22"/> feet	
Basin Area at Top of Freeboard = <input type="text" value="0.16"/> acres	

Routed Hydrograph Results

	WQCV	EURV	2 Year	5 Year	10 Year	25 Year	50 Year	100 Year	500 Year
Design Storm Return Period =									
One-Hour Rainfall Depth (in) =	0.53	1.07	1.19	1.50	1.75	2.00	2.25	2.52	0.00
Calculated Runoff Volume (acre-ft) =	0.067	0.115	0.080	0.123	0.268	0.680	0.939	1.277	0.000
OPTIONAL Override Runoff Volume (acre-ft) =	0.017								
Inflow Hydrograph Volume (acre-ft) =	0.017	0.114	0.079	0.122	0.268	0.680	0.939	1.276	#N/A
Predevelopment Unit Peak Flow, q (cfs/acre) =	0.00	0.00	0.01	0.02	0.19	0.63	0.87	1.17	0.00
Predevelopment Peak Q (cfs) =	0.0	0.0	0.1	0.2	2.1	6.9	9.5	12.8	0.0
Peak Inflow Q (cfs) =	0.3	1.8	1.3	2.0	4.3	10.7	14.8	20.0	#N/A
Peak Outflow Q (cfs) =	0.0	1.6	0.9	1.8	4.4	11.3	14.9	17.6	#N/A
Ratio Peak Outflow to Predevelopment Q =	N/A	N/A	N/A	8.4	2.2	1.6	1.6	1.4	#N/A
Structure Controlling Flow =	Plate	Overflow Grate 1	Outlet Plate 1	#N/A					
Max Velocity through Grate 1 (fps) =	N/A	0.13	0.07	0.1	0.4	1.1	1.4	1.7	#N/A
Max Velocity through Grate 2 (fps) =	N/A	N/A	N/A	N/A	N/A	N/A	N/A	N/A	#N/A
Time to Drain 97% of Inflow Volume (hours) =	38	43	46	42	31	15	8	3	#N/A
Time to Drain 99% of Inflow Volume (hours) =	42	52	54	51	46	34	29	23	#N/A
Maximum Ponding Depth (ft) =	0.52	1.07	1.03	1.08	1.19	1.41	1.50	2.00	#N/A
Area at Maximum Ponding Depth (acres) =	0.04	0.06	0.06	0.06	0.06	0.07	0.07	0.09	#N/A
Maximum Volume Stored (acre-ft) =	0.015	0.043	0.040	0.043	0.050	0.064	0.070	0.109	#N/A

Detention Basin Outlet Structure Design

UD-Detention, Version 3.07 (February 2017)

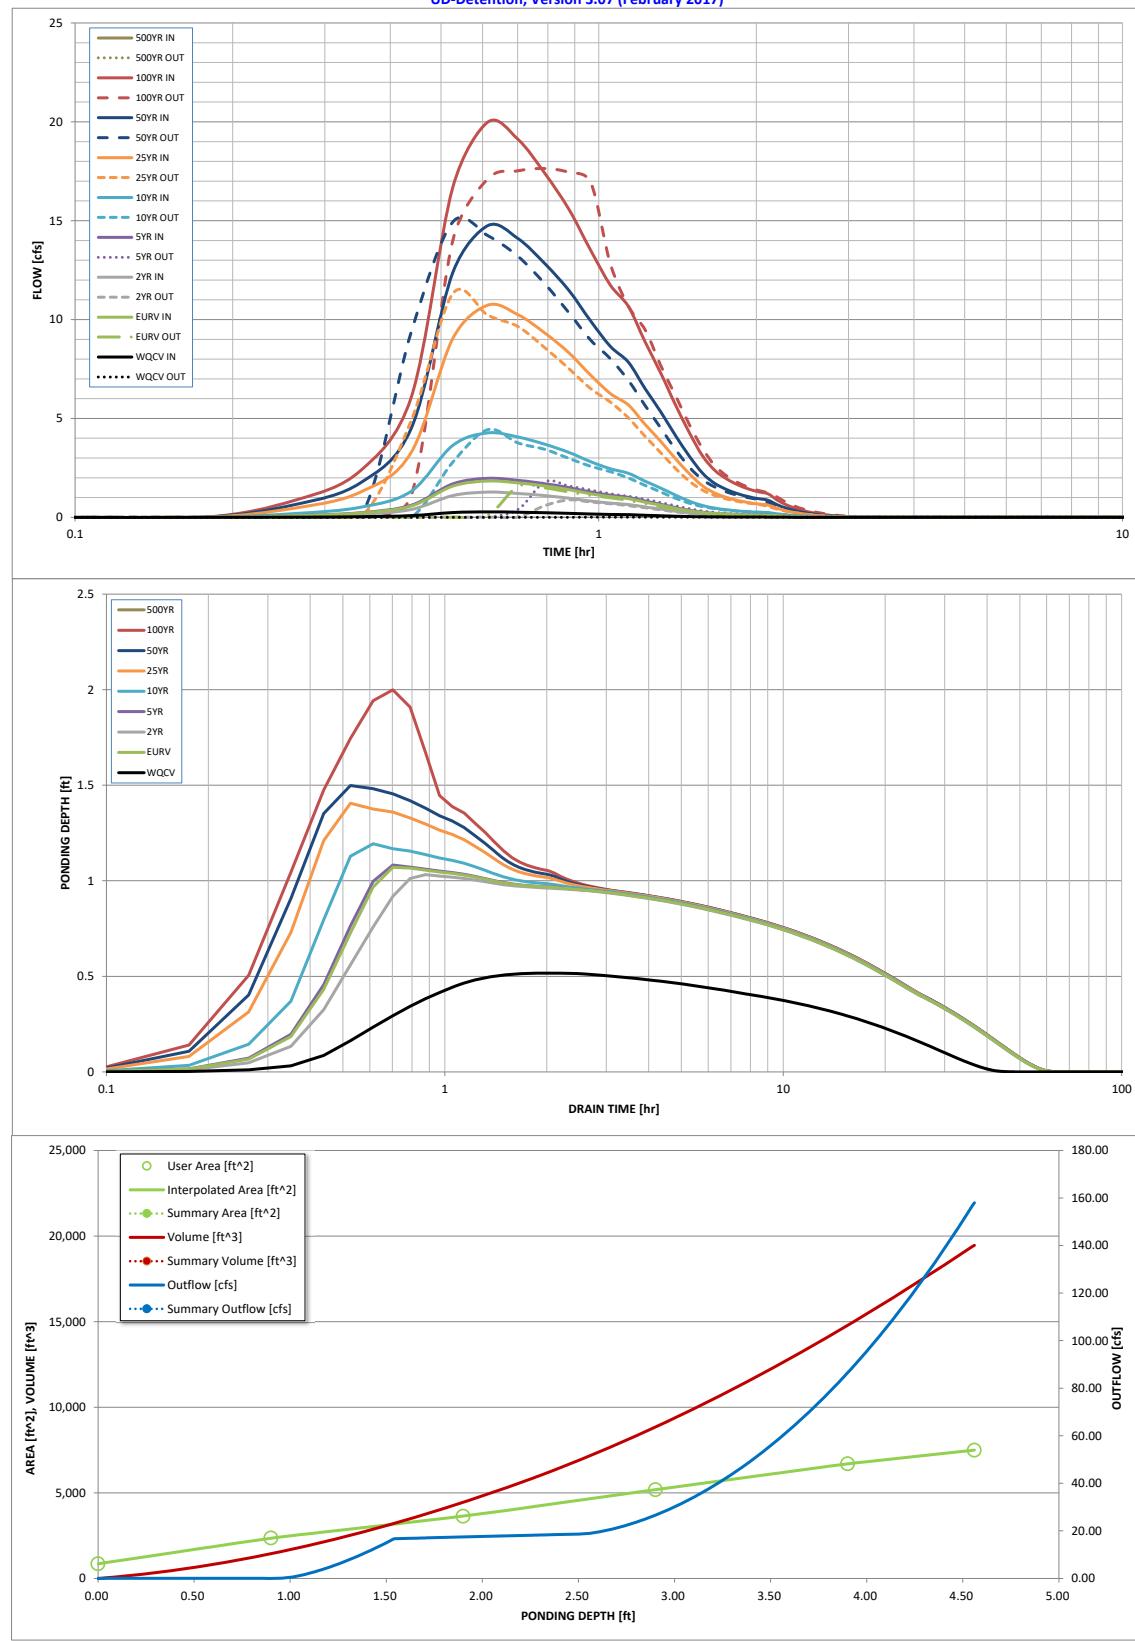

S-A-V-D Chart Axis Override	X-axis	Left Y-Axis	Right Y-Axis
minimum bound			
maximum bound			

Detention Basin Outlet Structure Design

Outflow Hydrograph Workbook Filename:

Storm Inflow Hydrographs

UD-Detention, Version 3.07 (February 2017)

The user can override the calculated inflow hydrographs from this workbook with inflow hydrographs developed in a separate program.

Detention Basin Outlet Structure Design

UD-Detention, Version 3.07 (February 2017)

Summary Stage-Area-Volume-Discharge Relationships

The user can create a summary S-A-V-D by entering the desired stage increments and the remainder of the table will populate automatically.

The user should graphically compare the summary S-A-V-D table to the full S-A-V-D table in the chart to confirm it captures all key transition points.

DETENTION BASIN DESIGN WORKBOOK

UD-Detention, Version 3.07 (February 2017)


**Urban Drainage and Flood Control District
Denver, Colorado
www.udfcd.org**

Purpose:	This workbook aids in the estimation of stormwater detention basin sizing and outlet routing based on the modified puls routing method for urban watersheds. Several different BMP types and various outlet configurations can be sized.
Function:	<ol style="list-style-type: none">1. Approximates the stage-area-volume relationship for a detention basin based on watershed parameters and basin geometry parameters. Also evaluates existing user-defined basin stage-area relationships.2. Sizes filtration media orifice, outlet orifices, elliptical slots, weirs, trash racks, and develops stage-discharge relationships. Uses the Modified Puls method to route a series of hydrographs (i.e., 2-, 5-, 10-, 25-, 50-, 100- and 500-year) and calibrates the peak discharge out of the basin to match the pre-development peak discharges for the watershed.

Content:	This workbook consists of the following sheets:
Basin	Tabulates stage-area-volume relationship estimates based on watershed parameters
Outlet Structure	Tabulates a stage-discharge relationship for the user-defined outlet structure (inlet control).
Reference	Provides reference equations and figures.
User Tips and Tools	Provides instructions and video links to assist in using this workbook. Includes a stage-area calculator.
BMP Zone Images	Provides images of typical BMP zone configurations corresponding with Zone pulldown selections.
Acknowledgements:	<p>Spreadsheet Development Team: Ken MacKenzie, P.E., Holly Piza, P.E. Urban Drainage and Flood Control District</p> <p>Derek N. Rapp, P.E. Peak Stormwater Engineering, LLC</p> <p>Dr. James C.Y. Guo, Ph.D., P.E. Professor, Department of Civil Engineering, University of Colorado at Denver</p>
Comments?	Direct all comments regarding this spreadsheet workbook to: UDFCD email
Revisions?	Check for revised versions of this or any other workbook at: Downloads


DETENTION BASIN STAGE-STORAGE TABLE BUILDER

UD-Detention, Version 3.07 (February 2017)

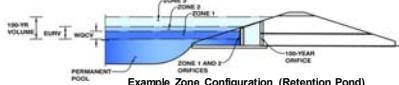Project: Winsome Filing 1 - Water Quality Pond C Basin ID: WQ Pond C																																																																																																																																																																																																																																																																																																																																																																																																																																																																																																																																																																																																								
 <p>Example Zone Configuration (Retention Pond)</p>																																																																																																																																																																																																																																																																																																																																																																																																																																																																																																																																																																																																								
<table border="1" style="width: 100%; border-collapse: collapse;"> <tr> <td style="width: 15%;">Required Volume Calculation</td> <td colspan="9"></td> </tr> <tr> <td>Selected BMP Type =</td> <td colspan="9">EDB</td> </tr> <tr> <td>Watershed Area =</td> <td colspan="9">136.50 acres</td> </tr> <tr> <td>Watershed Length =</td> <td colspan="9">6,193 ft</td> </tr> <tr> <td>Watershed Slope =</td> <td colspan="9">0.026 ft/ft</td> </tr> <tr> <td>Watershed Imperviousness =</td> <td colspan="9">3.70% percent</td> </tr> <tr> <td>Percentage Hydrologic Soil Group A =</td> <td colspan="9">0.0% percent</td> </tr> <tr> <td>Percentage Hydrologic Soil Group B =</td> <td colspan="9">100.0% percent</td> </tr> <tr> <td>Percentage Hydrologic Soil Groups C/D =</td> <td colspan="9">0.0% percent</td> </tr> <tr> <td>Desired WQCV Drain Time =</td> <td colspan="9">40.0 hours</td> </tr> <tr> <td>Location for 1-hr Rainfall Depths =</td> <td colspan="9">User Input</td> </tr> <tr> <td>Water Quality Capture Volume (WQCV) =</td> <td colspan="9">0.310 acre-feet</td> </tr> <tr> <td>Excess Urban Runoff Volume (EURV) =</td> <td colspan="9">0.438 acre-feet</td> </tr> <tr> <td>2-yr Runoff Volume ($P_1 = 1.9 \text{ in.}$) =</td> <td colspan="9">0.273 1.19 inches</td> </tr> <tr> <td>5-yr Runoff Volume ($P_1 = 1.5 \text{ in.}$) =</td> <td colspan="9">0.461 1.50 inches</td> </tr> <tr> <td>10-yr Runoff Volume ($P_1 = 1.75 \text{ in.}$) =</td> <td colspan="9">1.910 1.75 inches</td> </tr> <tr> <td>25-yr Runoff Volume ($P_1 = 2 \text{ in.}$) =</td> <td colspan="9">7.188 2.00 inches</td> </tr> <tr> <td>50-yr Runoff Volume ($P_1 = 2.25 \text{ in.}$) =</td> <td colspan="9">10.442 2.25 inches</td> </tr> <tr> <td>100-yr Runoff Volume ($P_1 = 2.5 \text{ in.}$) =</td> <td colspan="9">14.688 2.52 inches</td> </tr> <tr> <td>500-yr Runoff Volume ($P_1 = 0 \text{ in.}$) =</td> <td colspan="9">0.000 acre-feet</td> </tr> <tr> <td>Approximate 2-yr Detention Volume =</td> <td colspan="9">0.252 acre-feet</td> </tr> <tr> <td>Approximate 5-yr Detention Volume =</td> <td colspan="9">0.430 acre-feet</td> </tr> <tr> <td>Approximate 10-yr Detention Volume =</td> <td colspan="9">1.559 acre-feet</td> </tr> <tr> <td>Approximate 25-yr Detention Volume =</td> <td colspan="9">2.421 acre-feet</td> </tr> <tr> <td>Approximate 50-yr Detention Volume =</td> <td colspan="9">2.420 acre-feet</td> </tr> <tr> <td>Approximate 100-yr Detention Volume =</td> <td colspan="9">3.266 acre-feet</td> </tr> <tr> <td colspan="10" style="padding: 0;"> <div style="display: flex; justify-content: space-between;"> Optional User Override 1-hr Precipitation </div> </td> </tr> <tr> <td colspan="10" style="padding: 0;"> <div style="display: flex; justify-content: space-between;"> WQCV not provided! Total detention volume is less than 100-year volume. </div> </td> </tr> <tr> <td colspan="10" style="padding: 0;"> Stage-Storage Calculation </td> </tr> <tr> <td>Zone 1 Volume (User Defined) =</td> <td>0.048</td> <td>acre-feet</td> <td colspan="8"></td> </tr> <tr> <td>Select Zone 2 Storage Volume (Optional) =</td> <td></td> <td>acre-feet</td> <td colspan="8"></td> </tr> <tr> <td>Select Zone 3 Storage Volume (Optional) =</td> <td></td> <td>acre-feet</td> <td colspan="8"></td> </tr> <tr> <td>Total Detention Basin Volume =</td> <td>0.048</td> <td>acre-feet</td> <td colspan="8"></td> </tr> <tr> <td>Initial Surcharge Volume (ISV) =</td> <td>user</td> <td>ft³</td> <td colspan="8"></td> </tr> <tr> <td>Initial Surcharge Depth (ISD) =</td> <td>user</td> <td>ft</td> <td colspan="8"></td> </tr> <tr> <td>Total Available Detention Depth (H_{total}) =</td> <td>user</td> <td>ft</td> <td colspan="8"></td> </tr> <tr> <td>Depth of Trickle Channel ($H_{trickle}$) =</td> <td>user</td> <td>ft</td> <td colspan="8"></td> </tr> <tr> <td>Slope of Trickle Channel ($S_{trickle}$) =</td> <td>user</td> <td>ft/ft</td> <td colspan="8"></td> </tr> <tr> <td>Slopes of Main Basin Sides (S_{main}) =</td> <td>user</td> <td>ft/V</td> <td colspan="8"></td> </tr> <tr> <td>Basin Length-to-Width Ratio (R_{LW}) =</td> <td>user</td> <td></td> <td colspan="8"></td> </tr> <tr> <td>Initial Surcharge Area (A_{sur}) =</td> <td>user</td> <td>ft²</td> <td colspan="8"></td> </tr> <tr> <td>Surcharge Volume Length (L_{sur}) =</td> <td>user</td> <td>ft</td> <td colspan="8"></td> </tr> <tr> <td>Surcharge Volume Width (W_{sur}) =</td> <td>user</td> <td>ft</td> <td colspan="8"></td> </tr> <tr> <td>Depth of Basin Floor (H_{floor}) =</td> <td>user</td> <td>ft</td> <td colspan="8"></td> </tr> <tr> <td>Length of Basin Floor (L_{floor}) =</td> <td>user</td> <td>ft</td> <td colspan="8"></td> </tr> <tr> <td>Width of Basin Floor (W_{floor}) =</td> <td>user</td> <td>ft</td> <td colspan="8"></td> </tr> <tr> <td>Area of Basin Floor (A_{floor}) =</td> <td>user</td> <td>ft²</td> <td colspan="8"></td> </tr> <tr> <td>Volume of Basin Floor (V_{floor}) =</td> <td>user</td> <td>ft³</td> <td colspan="8"></td> </tr> <tr> <td>Depth of Main Basin (H_{main}) =</td> <td>user</td> <td>ft</td> <td colspan="8"></td> </tr> <tr> <td>Length of Main Basin (L_{main}) =</td> <td>user</td> <td>ft</td> <td colspan="8"></td> </tr> <tr> <td>Width of Main Basin (W_{main}) =</td> <td>user</td> <td>ft</td> <td colspan="8"></td> </tr> <tr> <td>Area of Main Basin (A_{main}) =</td> <td>user</td> <td>ft²</td> <td colspan="8"></td> </tr> <tr> <td>Volume of Main Basin (V_{main}) =</td> <td>user</td> <td>ft³</td> <td colspan="8"></td> </tr> <tr> <td>Calculated Total Basin Volume (V_{total}) =</td> <td>user</td> <td>acre-feet</td> <td colspan="8"></td> </tr> <tr> <td colspan="10" style="height: 200px;"></td> </tr> </table>										Required Volume Calculation										Selected BMP Type =	EDB									Watershed Area =	136.50 acres									Watershed Length =	6,193 ft									Watershed Slope =	0.026 ft/ft									Watershed Imperviousness =	3.70% percent									Percentage Hydrologic Soil Group A =	0.0% percent									Percentage Hydrologic Soil Group B =	100.0% percent									Percentage Hydrologic Soil Groups C/D =	0.0% percent									Desired WQCV Drain Time =	40.0 hours									Location for 1-hr Rainfall Depths =	User Input									Water Quality Capture Volume (WQCV) =	0.310 acre-feet									Excess Urban Runoff Volume (EURV) =	0.438 acre-feet									2-yr Runoff Volume ($P_1 = 1.9 \text{ in.}$) =	0.273 1.19 inches									5-yr Runoff Volume ($P_1 = 1.5 \text{ in.}$) =	0.461 1.50 inches									10-yr Runoff Volume ($P_1 = 1.75 \text{ in.}$) =	1.910 1.75 inches									25-yr Runoff Volume ($P_1 = 2 \text{ in.}$) =	7.188 2.00 inches									50-yr Runoff Volume ($P_1 = 2.25 \text{ in.}$) =	10.442 2.25 inches									100-yr Runoff Volume ($P_1 = 2.5 \text{ in.}$) =	14.688 2.52 inches									500-yr Runoff Volume ($P_1 = 0 \text{ in.}$) =	0.000 acre-feet									Approximate 2-yr Detention Volume =	0.252 acre-feet									Approximate 5-yr Detention Volume =	0.430 acre-feet									Approximate 10-yr Detention Volume =	1.559 acre-feet									Approximate 25-yr Detention Volume =	2.421 acre-feet									Approximate 50-yr Detention Volume =	2.420 acre-feet									Approximate 100-yr Detention Volume =	3.266 acre-feet									<div style="display: flex; justify-content: space-between;"> Optional User Override 1-hr Precipitation </div>										<div style="display: flex; justify-content: space-between;"> WQCV not provided! Total detention volume is less than 100-year volume. </div>										Stage-Storage Calculation										Zone 1 Volume (User Defined) =	0.048	acre-feet									Select Zone 2 Storage Volume (Optional) =		acre-feet									Select Zone 3 Storage Volume (Optional) =		acre-feet									Total Detention Basin Volume =	0.048	acre-feet									Initial Surcharge Volume (ISV) =	user	ft ³									Initial Surcharge Depth (ISD) =	user	ft									Total Available Detention Depth (H_{total}) =	user	ft									Depth of Trickle Channel ($H_{trickle}$) =	user	ft									Slope of Trickle Channel ($S_{trickle}$) =	user	ft/ft									Slopes of Main Basin Sides (S_{main}) =	user	ft/V									Basin Length-to-Width Ratio (R_{LW}) =	user										Initial Surcharge Area (A_{sur}) =	user	ft ²									Surcharge Volume Length (L_{sur}) =	user	ft									Surcharge Volume Width (W_{sur}) =	user	ft									Depth of Basin Floor (H_{floor}) =	user	ft									Length of Basin Floor (L_{floor}) =	user	ft									Width of Basin Floor (W_{floor}) =	user	ft									Area of Basin Floor (A_{floor}) =	user	ft ²									Volume of Basin Floor (V_{floor}) =	user	ft ³									Depth of Main Basin (H_{main}) =	user	ft									Length of Main Basin (L_{main}) =	user	ft									Width of Main Basin (W_{main}) =	user	ft									Area of Main Basin (A_{main}) =	user	ft ²									Volume of Main Basin (V_{main}) =	user	ft ³									Calculated Total Basin Volume (V_{total}) =	user	acre-feet																		
Required Volume Calculation																																																																																																																																																																																																																																																																																																																																																																																																																																																																																																																																																																																																								
Selected BMP Type =	EDB																																																																																																																																																																																																																																																																																																																																																																																																																																																																																																																																																																																																							
Watershed Area =	136.50 acres																																																																																																																																																																																																																																																																																																																																																																																																																																																																																																																																																																																																							
Watershed Length =	6,193 ft																																																																																																																																																																																																																																																																																																																																																																																																																																																																																																																																																																																																							
Watershed Slope =	0.026 ft/ft																																																																																																																																																																																																																																																																																																																																																																																																																																																																																																																																																																																																							
Watershed Imperviousness =	3.70% percent																																																																																																																																																																																																																																																																																																																																																																																																																																																																																																																																																																																																							
Percentage Hydrologic Soil Group A =	0.0% percent																																																																																																																																																																																																																																																																																																																																																																																																																																																																																																																																																																																																							
Percentage Hydrologic Soil Group B =	100.0% percent																																																																																																																																																																																																																																																																																																																																																																																																																																																																																																																																																																																																							
Percentage Hydrologic Soil Groups C/D =	0.0% percent																																																																																																																																																																																																																																																																																																																																																																																																																																																																																																																																																																																																							
Desired WQCV Drain Time =	40.0 hours																																																																																																																																																																																																																																																																																																																																																																																																																																																																																																																																																																																																							
Location for 1-hr Rainfall Depths =	User Input																																																																																																																																																																																																																																																																																																																																																																																																																																																																																																																																																																																																							
Water Quality Capture Volume (WQCV) =	0.310 acre-feet																																																																																																																																																																																																																																																																																																																																																																																																																																																																																																																																																																																																							
Excess Urban Runoff Volume (EURV) =	0.438 acre-feet																																																																																																																																																																																																																																																																																																																																																																																																																																																																																																																																																																																																							
2-yr Runoff Volume ($P_1 = 1.9 \text{ in.}$) =	0.273 1.19 inches																																																																																																																																																																																																																																																																																																																																																																																																																																																																																																																																																																																																							
5-yr Runoff Volume ($P_1 = 1.5 \text{ in.}$) =	0.461 1.50 inches																																																																																																																																																																																																																																																																																																																																																																																																																																																																																																																																																																																																							
10-yr Runoff Volume ($P_1 = 1.75 \text{ in.}$) =	1.910 1.75 inches																																																																																																																																																																																																																																																																																																																																																																																																																																																																																																																																																																																																							
25-yr Runoff Volume ($P_1 = 2 \text{ in.}$) =	7.188 2.00 inches																																																																																																																																																																																																																																																																																																																																																																																																																																																																																																																																																																																																							
50-yr Runoff Volume ($P_1 = 2.25 \text{ in.}$) =	10.442 2.25 inches																																																																																																																																																																																																																																																																																																																																																																																																																																																																																																																																																																																																							
100-yr Runoff Volume ($P_1 = 2.5 \text{ in.}$) =	14.688 2.52 inches																																																																																																																																																																																																																																																																																																																																																																																																																																																																																																																																																																																																							
500-yr Runoff Volume ($P_1 = 0 \text{ in.}$) =	0.000 acre-feet																																																																																																																																																																																																																																																																																																																																																																																																																																																																																																																																																																																																							
Approximate 2-yr Detention Volume =	0.252 acre-feet																																																																																																																																																																																																																																																																																																																																																																																																																																																																																																																																																																																																							
Approximate 5-yr Detention Volume =	0.430 acre-feet																																																																																																																																																																																																																																																																																																																																																																																																																																																																																																																																																																																																							
Approximate 10-yr Detention Volume =	1.559 acre-feet																																																																																																																																																																																																																																																																																																																																																																																																																																																																																																																																																																																																							
Approximate 25-yr Detention Volume =	2.421 acre-feet																																																																																																																																																																																																																																																																																																																																																																																																																																																																																																																																																																																																							
Approximate 50-yr Detention Volume =	2.420 acre-feet																																																																																																																																																																																																																																																																																																																																																																																																																																																																																																																																																																																																							
Approximate 100-yr Detention Volume =	3.266 acre-feet																																																																																																																																																																																																																																																																																																																																																																																																																																																																																																																																																																																																							
<div style="display: flex; justify-content: space-between;"> Optional User Override 1-hr Precipitation </div>																																																																																																																																																																																																																																																																																																																																																																																																																																																																																																																																																																																																								
<div style="display: flex; justify-content: space-between;"> WQCV not provided! Total detention volume is less than 100-year volume. </div>																																																																																																																																																																																																																																																																																																																																																																																																																																																																																																																																																																																																								
Stage-Storage Calculation																																																																																																																																																																																																																																																																																																																																																																																																																																																																																																																																																																																																								
Zone 1 Volume (User Defined) =	0.048	acre-feet																																																																																																																																																																																																																																																																																																																																																																																																																																																																																																																																																																																																						
Select Zone 2 Storage Volume (Optional) =		acre-feet																																																																																																																																																																																																																																																																																																																																																																																																																																																																																																																																																																																																						
Select Zone 3 Storage Volume (Optional) =		acre-feet																																																																																																																																																																																																																																																																																																																																																																																																																																																																																																																																																																																																						
Total Detention Basin Volume =	0.048	acre-feet																																																																																																																																																																																																																																																																																																																																																																																																																																																																																																																																																																																																						
Initial Surcharge Volume (ISV) =	user	ft ³																																																																																																																																																																																																																																																																																																																																																																																																																																																																																																																																																																																																						
Initial Surcharge Depth (ISD) =	user	ft																																																																																																																																																																																																																																																																																																																																																																																																																																																																																																																																																																																																						
Total Available Detention Depth (H_{total}) =	user	ft																																																																																																																																																																																																																																																																																																																																																																																																																																																																																																																																																																																																						
Depth of Trickle Channel ($H_{trickle}$) =	user	ft																																																																																																																																																																																																																																																																																																																																																																																																																																																																																																																																																																																																						
Slope of Trickle Channel ($S_{trickle}$) =	user	ft/ft																																																																																																																																																																																																																																																																																																																																																																																																																																																																																																																																																																																																						
Slopes of Main Basin Sides (S_{main}) =	user	ft/V																																																																																																																																																																																																																																																																																																																																																																																																																																																																																																																																																																																																						
Basin Length-to-Width Ratio (R_{LW}) =	user																																																																																																																																																																																																																																																																																																																																																																																																																																																																																																																																																																																																							
Initial Surcharge Area (A_{sur}) =	user	ft ²																																																																																																																																																																																																																																																																																																																																																																																																																																																																																																																																																																																																						
Surcharge Volume Length (L_{sur}) =	user	ft																																																																																																																																																																																																																																																																																																																																																																																																																																																																																																																																																																																																						
Surcharge Volume Width (W_{sur}) =	user	ft																																																																																																																																																																																																																																																																																																																																																																																																																																																																																																																																																																																																						
Depth of Basin Floor (H_{floor}) =	user	ft																																																																																																																																																																																																																																																																																																																																																																																																																																																																																																																																																																																																						
Length of Basin Floor (L_{floor}) =	user	ft																																																																																																																																																																																																																																																																																																																																																																																																																																																																																																																																																																																																						
Width of Basin Floor (W_{floor}) =	user	ft																																																																																																																																																																																																																																																																																																																																																																																																																																																																																																																																																																																																						
Area of Basin Floor (A_{floor}) =	user	ft ²																																																																																																																																																																																																																																																																																																																																																																																																																																																																																																																																																																																																						
Volume of Basin Floor (V_{floor}) =	user	ft ³																																																																																																																																																																																																																																																																																																																																																																																																																																																																																																																																																																																																						
Depth of Main Basin (H_{main}) =	user	ft																																																																																																																																																																																																																																																																																																																																																																																																																																																																																																																																																																																																						
Length of Main Basin (L_{main}) =	user	ft																																																																																																																																																																																																																																																																																																																																																																																																																																																																																																																																																																																																						
Width of Main Basin (W_{main}) =	user	ft																																																																																																																																																																																																																																																																																																																																																																																																																																																																																																																																																																																																						
Area of Main Basin (A_{main}) =	user	ft ²																																																																																																																																																																																																																																																																																																																																																																																																																																																																																																																																																																																																						
Volume of Main Basin (V_{main}) =	user	ft ³																																																																																																																																																																																																																																																																																																																																																																																																																																																																																																																																																																																																						
Calculated Total Basin Volume (V_{total}) =	user	acre-feet																																																																																																																																																																																																																																																																																																																																																																																																																																																																																																																																																																																																						

DETENTION BASIN STAGE-STORAGE TABLE BUILDER

UD-Detention, Version 3.07 (February 2017)

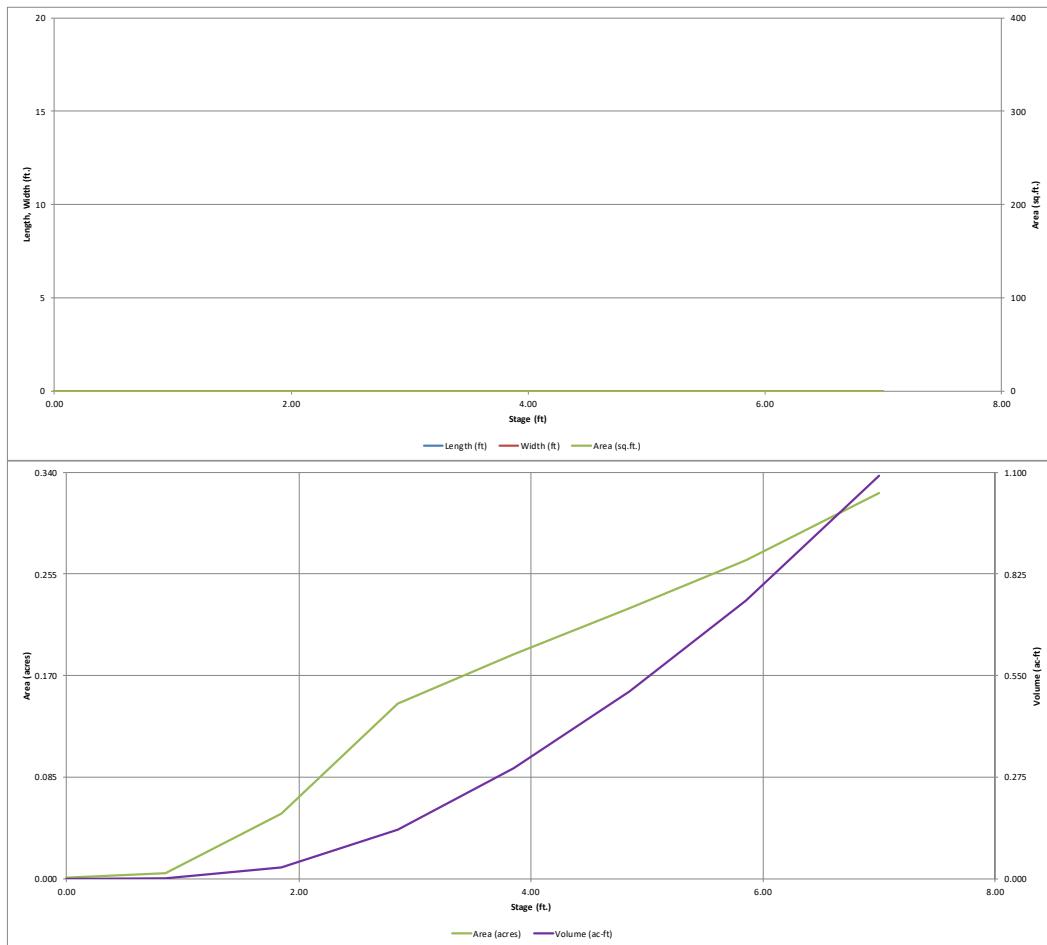


Detention Basin Outlet Structure Design

UD-Detention, Version 3.07 (February 2017)

Project: Winsome Filing 1 - Water Quality Pond C

Basin ID: WQ Pond C

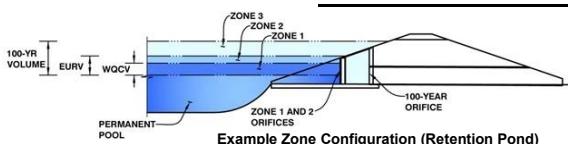

Zone 1 (User)	Stage (ft)	Zone Volume (ac-ft)	Outlet Type
Zone 2			Weir&Pipe (Circular)
Zone 3			
		0.048	Total
		Calculated Parameters for Underdrain	

User Input: Orifice at Underdrain Outlet (typically used to drain WQCV in a Filtration BMP)

Underdrain Orifice Invert Depth = ft (distance below the filtration media surface)
Underdrain Orifice Diameter = inches

Underdrain Orifice Area = ft²
Underdrain Orifice Centroid = feet

User Input: Orifice Plate with one or more orifices or Elliptical Slot Weir (typically used to drain WQCV and/or EURV in a sedimentation BMP)

Invert of Lowest Orifice = ft (relative to basin bottom at Stage = 0 ft)
Depth at top of Zone using Orifice Plate = ft (relative to basin bottom at Stage = 0 ft)
Orifice Plate: Orifice Vertical Spacing = inches
Orifice Plate: Orifice Area per Row = sq. inches (diameter = 7/16 inch)

Calculated Parameters for Plate
WQ Orifice Area per Row = ft²
Elliptical Half-Width = feet
Elliptical Slot Centroid = feet
Elliptical Slot Area = ft²

User Input: Stage and Total Area of Each Orifice Row (numbered from lowest to highest)

Row 1 (required)	Row 2 (optional)	Row 3 (optional)	Row 4 (optional)	Row 5 (optional)	Row 6 (optional)	Row 7 (optional)	Row 8 (optional)
Stage of Orifice Centroid (ft)	0.00	0.70	1.40				
Orifice Area (sq. inches)	0.15	0.15	0.15				
	Row 9 (optional)	Row 10 (optional)	Row 11 (optional)	Row 12 (optional)	Row 13 (optional)	Row 14 (optional)	Row 15 (optional)
	Stage of Orifice Centroid (ft)						
	Orifice Area (sq. inches)						

User Input: Vertical Orifice (Circular or Rectangular)

Invert of Vertical Orifice = ft (relative to basin bottom at Stage = 0 ft)
Depth at top of Zone using Vertical Orifice = ft (relative to basin bottom at Stage = 0 ft)
Vertical Orifice Diameter = inches

Calculated Parameters for Vertical Orifice
Vertical Orifice Area = ft²
Vertical Orifice Centroid = feet

User Input: Overflow Weir (Dropbox) and Grate (Flat or Sloped)

Zone 2 Weir = ft (relative to basin bottom at Stage = 0 ft)
Overflow Weir Front Edge Height, Ho = ft (relative to basin bottom at Stage = 0 ft)
Overflow Weir Front Edge Length = feet
Overflow Weir Slope = H:V (enter zero for flat grate)
Horiz. Length of Weir Sides = feet
Overflow Grate Open Area % = %, grate open area/total area
Debris Clogging % = %

Calculated Parameters for Overflow Weir
Zone 2 Weir = feet
Height of Grate Upper Edge, H_t = feet
Over Flow Weir Slope Length = feet
Grate Open Area / 100-yr Orifice Area = should be ≥ 4
Overflow Grate Open Area w/o Debris = ft²
Overflow Grate Open Area w/ Debris = ft²

User Input: Outlet Pipe w/ Flow Restriction Plate (Circular Orifice, Restrictor Plate, or Rectangular Orifice)

Zone 2 Circular = ft (distance below basin bottom at Stage = 0 ft)
Depth to Invert of Outlet Pipe = ft (distance below basin bottom at Stage = 0 ft)
Circular Orifice Diameter = inches

Calculated Parameters for Outlet Pipe w/ Flow Restriction Plate
Outlet Orifice Area = ft²
Outlet Orifice Centroid = feet
Half-Central Angle of Restrictor Plate on Pipe = radians

User Input: Emergency Spillway (Rectangular or Trapezoidal)

Spillway Invert Stage = ft (relative to basin bottom at Stage = 0 ft)
Spillway Crest Length = feet
Spillway End Slopes = H:V
Freeboard above Max Water Surface = feet


Calculated Parameters for Spillway
Spillway Design Flow Depth = feet
Stage at Top of Freeboard = feet
Basin Area at Top of Freeboard = acres

Routed Hydrograph Results

Design Storm Return Period	WQCV	EURV	2 Year	5 Year	10 Year	25 Year	50 Year	100 Year	500 Year
One-Hour Rainfall Depth (in)	0.53	1.07	1.19	1.50	1.75	2.00	2.25	2.52	0.00
Calculated Runoff Volume (acre-ft) =	0.310	0.438	0.273	0.461	1.910	7.188	10.442	14.689	0.000
OPTIONAL Override Runoff Volume (acre-ft) =	0.048								
Inflow Hydrograph Volume (acre-ft) =	0.048	0.438	0.272	0.460	1.909	7.179	10.433	14.682	#N/A
Predevelopment Unit Peak Flow, q (cfs/acre) =	0.00	0.00	0.01	0.01	0.13	0.46	0.64	0.88	0.00
Predevelopment Peak Q (cfs) =	0.0	0.0	1.1	1.9	17.8	63.0	87.5	119.5	0.0
Peak Inflow Q (cfs) =	0.6	5.3	3.3	5.6	22.8	83.6	120.1	166.9	#N/A
Peak Outflow Q (cfs) =	0.3	6.7	3.2	7.0	22.8	84.1	120.6	163.5	#N/A
Ratio Peak Outflow to Predevelopment Q =	N/A	N/A	N/A	3.6	1.3	1.3	1.4	1.4	#N/A
Structure Controlling Flow =	Overflow Grade 1	#N/A							
Max Velocity through Grade 1 (fps) =	0.00	0.19	0.08	0.2	0.6	2.3	3.4	4.6	#N/A
Max Velocity through Grade 2 (fps) =	N/A	#N/A							
Time to Drain 97% of Inflow Volume (hours) =	39	23	29	22	1	1	1	1	#N/A
Time to Drain 99% of Inflow Volume (hours) =	43	34	37	34	17	2	2	2	#N/A
Maximum Ponding Depth (ft) =	1.92	2.08	2.01	2.08	2.30	2.88	3.30	4.51	#N/A
Area at Maximum Ponding Depth (acres) =	0.06	0.07	0.07	0.08	0.10	0.15	0.16	0.21	#N/A
Maximum Volume Stored (acre-ft) =	0.036	0.046	0.041	0.047	0.066	0.137	0.202	0.429	#N/A

Detention Basin Outlet Structure Design

UD-Detention, Version 3.07 (February 2017)

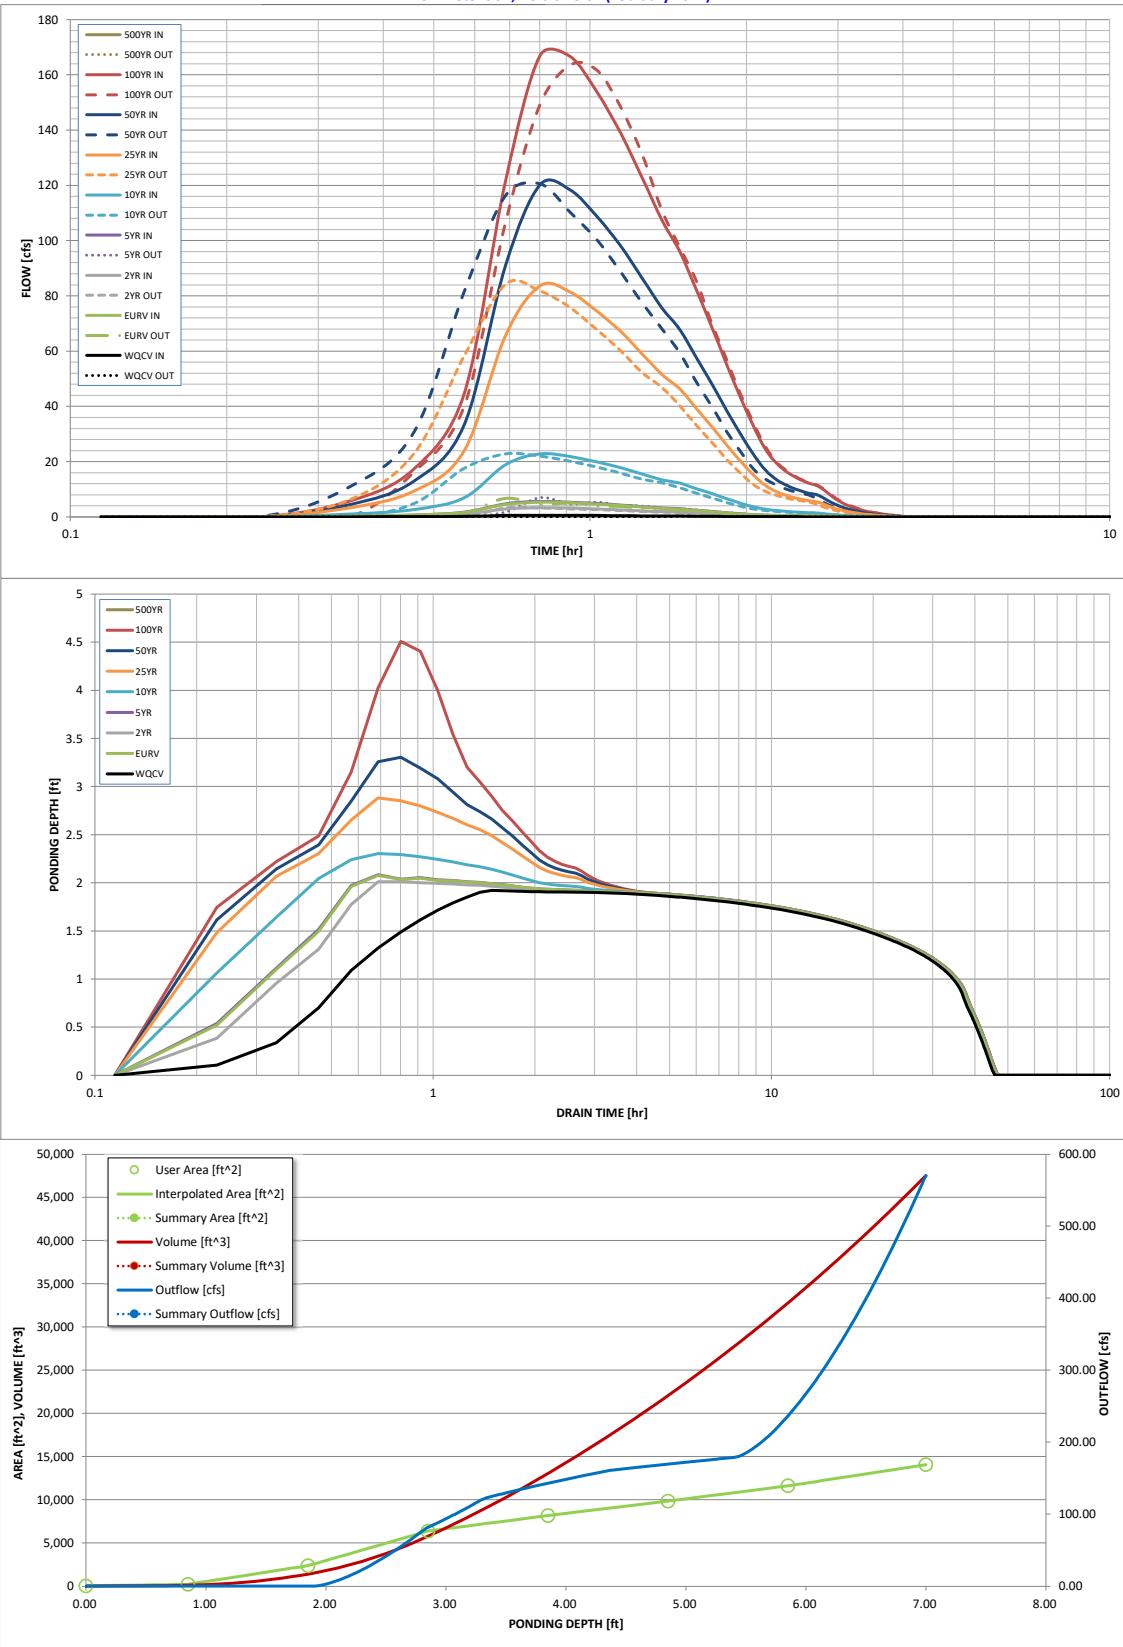

S-A-V-D Chart Axis Override	X-axis	Left Y-axis	Right Y-axis
minimum bound			
maximum bound			

Detention Basin Outlet Structure Design

Outflow Hydrograph Workbook Filename:

Storm Inflow Hydrographs

UD-Detention, Version 3.07 (February 2017)

The user can override the calculated inflow hydrographs from this workbook with inflow hydrographs developed in a separate program.

Detention Basin Outlet Structure Design

UD-Detention, Version 3.07 (February 2017)

Summary Stage-Area-Volume-Discharge Relationships

The user can create a summary S-A-V-D by entering the desired stage increments and the remainder of the table will populate automatically.

The user should graphically compare the summary S-A-V-D table to the full S-A-V-D table in the chart to confirm it captures all key transition points.

DETENTION BASIN DESIGN WORKBOOK

UD-Detention, Version 3.07 (February 2017)

Urban Drainage and Flood Control District

Denver, Colorado

www.udfcd.org

Purpose: This workbook aids in the estimation of stormwater detention basin sizing and outlet routing based on the modified puls routing method for urban watersheds. Several different BMP types and various outlet configurations can be sized.

Function:

1. Approximates the stage-area-volume relationship for a detention basin based on watershed parameters and basin geometry parameters. Also evaluates existing user-defined basin stage-area relationships.
2. Sizes filtration media orifice, outlet orifices, elliptical slots, weirs, trash racks, and develops stage-discharge relationships. Uses the Modified Puls method to route a series of hydrographs (i.e., 2-, 5-, 10-, 25-, 50-, 100- and 500-year) and calibrates the peak discharge out of the basin to match the pre-development peak discharges for the watershed.


Content:	This workbook consists of the following sheets:
Basin	Tabulates stage-area-volume relationship estimates based on watershed parameters
Outlet Structure	Tabulates a stage-discharge relationship for the user-defined outlet structure (inlet control).
Reference	Provides reference equations and figures.
User Tips and Tools	Provides instructions and video links to assist in using this workbook. Includes a stage-area calculator.
BMP Zone Images	Provides images of typical BMP zone configurations corresponding with Zone pulldown selections.
Acknowledgements:	<p>Spreadsheet Development Team: Ken MacKenzie, P.E., Holly Piza, P.E. Urban Drainage and Flood Control District</p> <p>Derek N. Rapp, P.E. Peak Stormwater Engineering, LLC</p> <p>Dr. James C.Y. Guo, Ph.D., P.E. Professor, Department of Civil Engineering, University of Colorado at Denver</p>
Comments?	Direct all comments regarding this spreadsheet workbook to: UDFCD email
Revisions?	Check for revised versions of this or any other workbook at: Downloads

DETENTION BASIN STAGE-STORAGE TABLE BUILDER

UD-Detention, Version 3.07 (February 2017)

Project: Winsome Filing 1 - Water Quality Pond D

Basin ID: Basin D1.1+D2 with Manual WQ Area

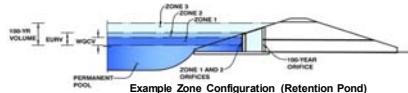

Example Zone Configuration (Retention Pond)

Required Volume Calculation

Selected BMP Type =	EDB
Watershed Area =	127.00 acres
Watershed Length =	4,370 ft
Watershed Slope =	0.034 ft/ft
Watershed Imperviousness =	7.60% percent
Percentage Hydrologic Soil Group A =	0.0% percent
Percentage Hydrologic Soil Group B =	100.0% percent
Percentage Hydrologic Soil Groups C/D =	0.0% percent
Desired WQCV Drain Time =	40.0 hours
Location for 1-hr Rainfall Depths =	User Input
Water Quality Capture Volume (WQCV) =	0.559 acre-feet
Excess Urban Runoff Volume (EURV) =	0.887 acre-feet
2-yr Runoff Volume ($P_1 = 1.9 \text{ in}$) =	0.594 acre-feet
5-yr Runoff Volume ($P_1 = 1.5 \text{ in}$) =	0.945 acre-feet
10-yr Runoff Volume ($P_1 = 1.75 \text{ in}$) =	2.479 acre-feet
25-yr Runoff Volume ($P_1 = 2 \text{ in}$) =	7.312 acre-feet
50-yr Runoff Volume ($P_1 = 2.25 \text{ in}$) =	10.317 acre-feet
100-yr Runoff Volume ($P_1 = 2.5 \text{ in}$) =	14.240 acre-feet
500-yr Runoff Volume ($P_1 = 0 \text{ in}$) =	0.000 acre-feet
Approximate 2-yr Detention Volume =	0.550 acre-feet
Approximate 5-yr Detention Volume =	0.884 acre-feet
Approximate 10-yr Detention Volume =	2.088 acre-feet
Approximate 25-yr Detention Volume =	3.038 acre-feet
Approximate 50-yr Detention Volume =	3.149 acre-feet
Approximate 100-yr Detention Volume =	4.132 acre-feet

Optional User Override
1-hr Precipitation


Stage-Storage Calculation

Zone 1 Volume (User Defined) =	0.051 acre-feet	WQCV not provided! Total detention volume is less than 100-year volume.
Select Zone 2 Storage Volume (Optional) =		
Select Zone 3 Storage Volume (Optional) =		
Total Detention Basin Volume =	0.051 acre-feet	
Initial Surcharge Volume (ISV) =	user ft ³	
Initial Surcharge Depth (ISD) =	user ft	
Total Available Detention Depth (H_{total}) =	user ft	
Depth of Trickle Channel ($H_{trickle}$) =	user ft	
Slope of Trickle Channel ($S_{trickle}$) =	user ft/ft	
Slopes of Main Basin Sides (S_{main}) =	user ft/V	
Basin Length-to-Width Ratio ($R_{L/W}$) =	user	
Initial Surcharge Area (A_{IS}) =	user ft ²	
Surcharge Volume Length (L_{IS}) =	user ft	
Surcharge Volume Width (W_{IS}) =	user ft	
Depth of Basin Floor (H_{floor}) =	user ft	
Length of Basin Floor (L_{floor}) =	user ft	
Width of Basin Floor (W_{floor}) =	user ft	
Area of Basin Floor (A_{floor}) =	user ft ²	
Volume of Basin Floor (V_{floor}) =	user ft ³	
Depth of Main Basin (H_{main}) =	user ft	
Length of Main Basin (L_{main}) =	user ft	
Width of Main Basin (W_{main}) =	user ft	
Area of Main Basin (A_{main}) =	user ft ²	
Volume of Main Basin (V_{main}) =	user ft ³	
Calculated Total Basin Volume (V_{total}) =	user acre-feet	

Depth Increment =	ft	Optional Override Stage (ft)	Length (ft)	Width (ft)	Area (ft ²)	Optional Override Area (ft ²)	Area (acre)	Volume (ft ³)	Volume (ac-ft)
Top of Micropool	--	0.00	--	--	--	64	0.001	--	--
7325	--	0.91	--	--	--	1,677	0.038	775	0.018
7326	--	1.91	--	--	--	7,079	0.163	5,100	0.117
7327	--	2.91	--	--	--	17,549	0.403	17,484	0.401
7328	--	3.91	--	--	--	20,953	0.481	36,735	0.843
7329	--	4.91	--	--	--	24,621	0.565	59,522	1.366
Spillway	--	5.91	--	--	--	28,289	0.649	85,977	1.974
7331	--	6.91	--	--	--	31,993	0.734	116,118	2.666
7332	--	7.91	--	--	--	32,388	0.744	148,309	3.405

DETENTION BASIN STAGE-STORAGE TABLE BUILDER

UD-Detention, Version 3.07 (February 2017)

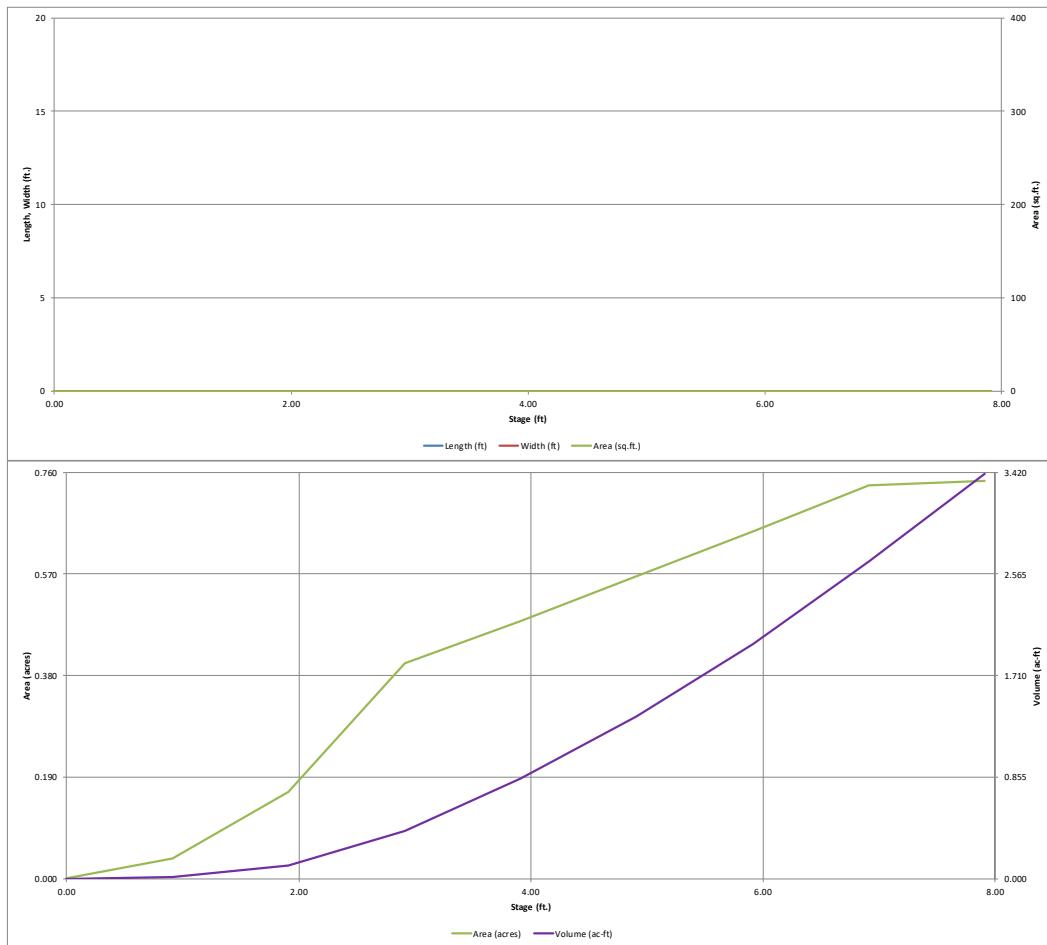


Detention Basin Outlet Structure Design

UD-Detention, Version 3.07 (February 2017)

Project: Winsome Filing 1 - Water Quality Pond

Basin ID: Basin D1.1+D2

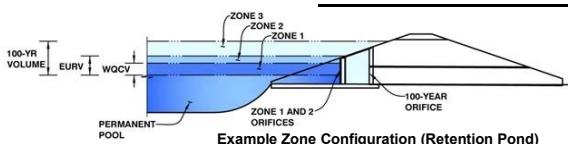

Zone 1 (User)	Stage (ft)	Zone Volume (ac-ft)	Outlet Type
Zone 1	1.40	0.051	Orifice Plate
Zone 2			Weir & Pipe (Circular)
Zone 3			
		0.051	Total

Calculated Parameters for Underdrain

Underdrain Orifice Area = N/A ft²
Underdrain Orifice Centroid = N/A feet

User Input: Orifice at Underdrain Outlet (typically used to drain WQCV in a Filtration BMP)

Underdrain Orifice Invert Depth = N/A ft (distance below the filtration media surface)
Underdrain Orifice Diameter = N/A inches

User Input: Orifice Plate with one or more orifices or Elliptical Slot Weir (typically used to drain WQCV and/or EURV in a sedimentation BMP)

Invert of Lowest Orifice = 0.00 ft (relative to basin bottom at Stage = 0 ft)
Depth at top of Zone using Orifice Plate = 1.40 ft (relative to basin bottom at Stage = 0 ft)
Orifice Plate: Orifice Vertical Spacing = 6.00 inches
Orifice Plate: Orifice Area per Row = 0.40 sq. inches (diameter = 11/16 inch)

Calculated Parameters for Plate

WQ Orifice Area per Row = 2.77E-03 ft²
Elliptical Half-Width = N/A feet
Elliptical Slot Centroid = N/A feet
Elliptical Slot Area = N/A ft²

User Input: Stage and Total Area of Each Orifice Row (numbered from lowest to highest)

Row 1 (required)	Row 2 (optional)	Row 3 (optional)	Row 4 (optional)	Row 5 (optional)	Row 6 (optional)	Row 7 (optional)	Row 8 (optional)
Stage of Orifice Centroid (ft)	0.00	0.50	1.00				
Orifice Area (sq. inches)	0.40	0.40	0.40				
Row 9 (optional)	Row 10 (optional)	Row 11 (optional)	Row 12 (optional)	Row 13 (optional)	Row 14 (optional)	Row 15 (optional)	Row 16 (optional)
Stage of Orifice Centroid (ft)							
Orifice Area (sq. inches)							

User Input: Vertical Orifice (Circular or Rectangular)

Invert of Vertical Orifice = Not Selected ft (relative to basin bottom at Stage = 0 ft)
Depth at top of Zone using Vertical Orifice = Not Selected ft (relative to basin bottom at Stage = 0 ft)
Vertical Orifice Diameter = Not Selected inches

Calculated Parameters for Vertical Orifice

Vertical Orifice Area = Not Selected ft²
Vertical Orifice Centroid = Not Selected feet

User Input: Overflow Weir (Dropbox) and Grate (Flat or Sloped)

Zone 2 Weir = Not Selected ft (relative to basin bottom at Stage = 0 ft)
Overflow Weir Front Edge Height, Ho = 2.10 ft
Overflow Weir Front Edge Length = 12.00 feet
Overflow Weir Slope = 0.00 H:V (enter zero for flat grate)
Horiz. Length of Weir Sides = 3.00 feet
Overflow Grate Open Area % = 85% %, grate open area/total area
Debris Clogging % = 50% %

Calculated Parameters for Overflow Weir

Zone 2 Weir = 2.10 feet
Height of Grate Upper Edge, H_t = 2.10 feet
Over Flow Weir Slope Length = 3.00 feet
Grate Open Area / 100-yr Orifice Area = 1.92 should be ≥ 4
Overflow Grate Open Area w/o Debris = 30.60 ft²
Overflow Grate Open Area w/ Debris = 15.30 ft²

User Input: Outlet Pipe w/ Flow Restriction Plate (Circular Orifice, Restrictor Plate, or Rectangular Orifice)

Zone 2 Circular = Not Selected ft (distance below basin bottom at Stage = 0 ft)
Depth to Invert of Outlet Pipe = 2.10 ft
Circular Orifice Diameter = 54.00 inches

Calculated Parameters for Outlet Pipe w/ Flow Restriction Plate

Outlet Orifice Area = 15.90 ft²
Outlet Orifice Centroid = 2.25 feet
Half-Central Angle of Restrictor Plate on Pipe = N/A radians

User Input: Emergency Spillway (Rectangular or Trapezoidal)

Spillway Invert Stage = 5.80 ft (relative to basin bottom at Stage = 0 ft)
Spillway Crest Length = 68.00 feet
Spillway End Slopes = 4.00 H:V
Freeboard above Max Water Surface = 1.00 feet

Calculated Parameters for Spillway


Spillway Design Flow Depth = 0.97 feet
Stage at Top of Freeboard = 7.77 feet
Basin Area at Top of Freeboard = 0.74 acres

Routed Hydrograph Results

Design Storm Return Period	WQCV	EURV	2 Year	5 Year	10 Year	25 Year	50 Year	100 Year	500 Year
One-Hour Rainfall Depth (in)	0.53	1.07	1.19	1.50	1.75	2.00	2.25	2.52	0.00
Calculated Runoff Volume (acre-ft)	0.559	0.887	0.594	0.945	2.479	7.312	10.317	14.240	0.000
OPTIONAL Override Runoff Volume (acre-ft)	0.051								
Inflow Hydrograph Volume (acre-ft)	0.050	0.887	0.594	0.944	2.479	7.310	10.306	14.238	#N/A
Predevelopment Unit Peak Flow, q (cfs/acre)	0.00	0.00	0.01	0.02	0.18	0.60	0.82	1.11	0.00
Predevelopment Peak Q (cfs)	0.0	0.0	1.4	2.4	22.3	75.6	104.6	141.5	0.0
Peak Inflow Q (cfs)	0.8	13.4	9.0	14.3	37.1	107.0	149.4	203.9	#N/A
Peak Outflow Q (cfs)	0.0	12.2	7.4	13.0	36.3	102.6	131.9	168.2	#N/A
Ratio Peak Outflow to Predevelopment Q =	N/A	N/A	N/A	5.5	1.6	1.4	1.3	1.2	#N/A
Structure Controlling Flow =	Plate	Overflow Grate 1	#N/A						
Max Velocity through Grate 1 (fps)	N/A	0.40	0.25	0.4	1.2	3.3	4.3	5.5	#N/A
Max Velocity through Grate 2 (fps)	N/A	N/A	N/A	N/A	N/A	N/A	N/A	N/A	#N/A
Time to Drain 97% of Inflow Volume (hours)	29	40	45	40	24	2	2	2	#N/A
Time to Drain 99% of Inflow Volume (hours)	31	51	53	50	41	25	17	7	#N/A
Maximum Ponding Depth (ft)	1.33	2.39	2.31	2.40	2.70	3.47	4.36	5.77	#N/A
Area at Maximum Ponding Depth (acres)	0.09	0.28	0.26	0.28	0.35	0.45	0.52	0.64	#N/A
Maximum Volume Stored (acre-ft)	0.044	0.222	0.200	0.227	0.319	0.639	1.063	1.884	#N/A

Detention Basin Outlet Structure Design

UD-Detention, Version 3.07 (February 2017)

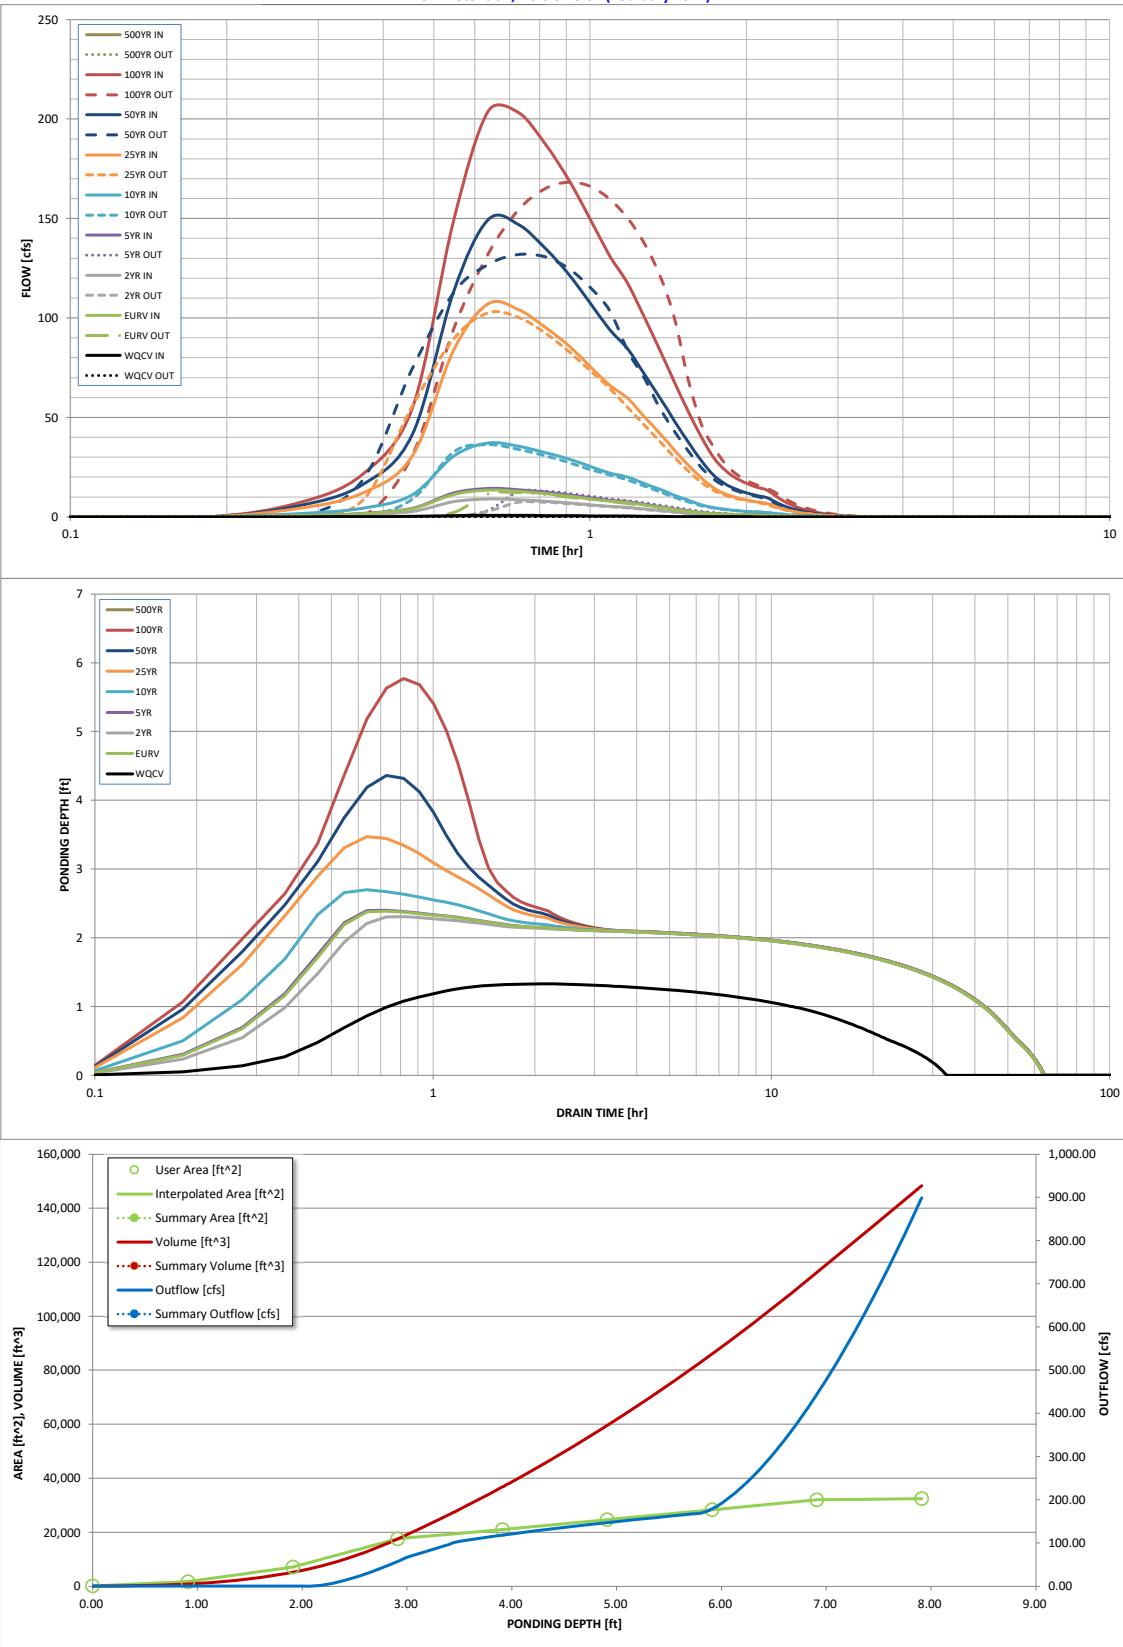

S-A-V-D Chart Axis Override	X-axis	Left Y-axis	Right Y-axis
minimum bound			
maximum bound			

Detention Basin Outlet Structure Design

Outflow Hydrograph Workbook Filename:

Storm Inflow Hydrographs

UD-Detention, Version 3.07 (February 2017)

The user can override the calculated inflow hydrographs from this workbook with inflow hydrographs developed in a separate program.

Detention Basin Outlet Structure Design

UD-Detention, Version 3.07 (February 2017)

Summary Stage-Area-Volume-Discharge Relationships

The user can create a summary S-A-V-D by entering the desired stage increments and the remainder of the table will populate automatically.

The user should graphically compare the summary S-A-V-D table to the full S-A-V-D table in the chart to confirm it captures all key transition points.

DETENTION BASIN DESIGN WORKBOOK

UD-Detention, Version 3.07 (February 2017)

Urban Drainage and Flood Control District

Denver, Colorado

www.udfcd.org


Purpose:	This workbook aids in the estimation of stormwater detention basin sizing and outlet routing based on the modified puls routing method for urban watersheds. Several different BMP types and various outlet configurations can be sized.
Function:	<ol style="list-style-type: none">1. Approximates the stage-area-volume relationship for a detention basin based on watershed parameters and basin geometry parameters. Also evaluates existing user-defined basin stage-area relationships.2. Sizes filtration media orifice, outlet orifices, elliptical slots, weirs, trash racks, and develops stage-discharge relationships. Uses the Modified Puls method to route a series of hydrographs (i.e., 2-, 5-, 10-, 25-, 50-, 100- and 500-year) and calibrates the peak discharge out of the basin to match the pre-development peak discharges for the watershed.

Content:	This workbook consists of the following sheets:
Basin	Tabulates stage-area-volume relationship estimates based on watershed parameters
Outlet Structure	Tabulates a stage-discharge relationship for the user-defined outlet structure (inlet control).
Reference	Provides reference equations and figures.
User Tips and Tools	Provides instructions and video links to assist in using this workbook. Includes a stage-area calculator.
BMP Zone Images	Provides images of typical BMP zone configurations corresponding with Zone pulldown selections.
Acknowledgements:	<p>Spreadsheet Development Team: Ken MacKenzie, P.E., Holly Piza, P.E. Urban Drainage and Flood Control District</p> <p>Derek N. Rapp, P.E. Peak Stormwater Engineering, LLC</p> <p>Dr. James C.Y. Guo, Ph.D., P.E. Professor, Department of Civil Engineering, University of Colorado at Denver</p>
Comments?	Direct all comments regarding this spreadsheet workbook to: UDFCD email
Revisions?	Check for revised versions of this or any other workbook at: Downloads

DETENTION BASIN STAGE-STORAGE TABLE BUILDER																																																																																																																																																																							
UD-Detention, Version 3.07 (February 2017)																																																																																																																																																																							
Project: Winsome Filing 1 - Pond 3																																																																																																																																																																							
Basin ID: Pond 3																																																																																																																																																																							
<p>Example Zone Configuration (Retention Pond)</p>																																																																																																																																																																							
Required Volume Calculation <table border="1" style="margin-left: auto; margin-right: auto;"> <tr> <td style="padding: 2px;">Selected BMP Type =</td> <td style="padding: 2px;">EDB</td> <td style="padding: 2px;">Note: L / W Ratio > 8</td> </tr> <tr> <td style="padding: 2px;">Watershed Area =</td> <td style="padding: 2px;">101.00 acres</td> <td style="padding: 2px;">L / W Ratio = 9.5</td> </tr> <tr> <td style="padding: 2px;">Watershed Length =</td> <td style="padding: 2px;">6,480 ft</td> <td></td> </tr> <tr> <td style="padding: 2px;">Watershed Slope =</td> <td style="padding: 2px;">0.029 ft/ft</td> <td></td> </tr> <tr> <td style="padding: 2px;">Watershed Imperviousness =</td> <td style="padding: 2px;">6.60% percent</td> <td></td> </tr> <tr> <td style="padding: 2px;">Percentage Hydrologic Soil Group A =</td> <td style="padding: 2px;">0.0% percent</td> <td></td> </tr> <tr> <td style="padding: 2px;">Percentage Hydrologic Soil Group B =</td> <td style="padding: 2px;">97.5% percent</td> <td></td> </tr> <tr> <td style="padding: 2px;">Percentage Hydrologic Soil Groups C/D =</td> <td style="padding: 2px;">2.5% percent</td> <td></td> </tr> <tr> <td style="padding: 2px;">Desired WQCV Drain Time =</td> <td style="padding: 2px;">40.0 hours</td> <td></td> </tr> <tr> <td colspan="3" style="text-align: center;">Location for 1-hr Rainfall Depths = User Input</td> </tr> <tr> <td style="padding: 2px;">Water Quality Capture Volume (WQCV) =</td> <td style="padding: 2px;">0.392 acre-feet</td> <td style="padding: 2px;">Optional User Override 1-hr Precipitation</td> </tr> <tr> <td style="padding: 2px;">Excess Urban Runoff Volume (EURV) =</td> <td style="padding: 2px;">0.604 acre-feet</td> <td></td> </tr> <tr> <td style="padding: 2px;">2-yr Runoff Volume ($P_1 = 1.19 \text{ in}$) =</td> <td style="padding: 2px;">0.401 acre-feet</td> <td></td> </tr> <tr> <td style="padding: 2px;">5-yr Runoff Volume ($P_1 = 1.5 \text{ in}$) =</td> <td style="padding: 2px;">0.659 acre-feet</td> <td></td> </tr> <tr> <td style="padding: 2px;">10-yr Runoff Volume ($P_1 = 1.75 \text{ in}$) =</td> <td style="padding: 2px;">1.857 acre-feet</td> <td></td> </tr> <tr> <td style="padding: 2px;">25-yr Runoff Volume ($P_1 = 2 \text{ in}$) =</td> <td style="padding: 2px;">5.716 acre-feet</td> <td></td> </tr> <tr> <td style="padding: 2px;">50-yr Runoff Volume ($P_1 = 2.25 \text{ in}$) =</td> <td style="padding: 2px;">8.114 acre-feet</td> <td></td> </tr> <tr> <td style="padding: 2px;">100-yr Runoff Volume ($P_1 = 2.5 \text{ in}$) =</td> <td style="padding: 2px;">11.244 acre-feet</td> <td></td> </tr> <tr> <td style="padding: 2px;">500-yr Runoff Volume ($P_1 = 0 \text{ in}$) =</td> <td style="padding: 2px;">0.000 acre-feet</td> <td></td> </tr> <tr> <td colspan="3" style="text-align: center;">Approximate 2-yr Detention Volume = 0.372 acre-feet</td> </tr> <tr> <td colspan="3" style="text-align: center;">Approximate 5-yr Detention Volume = 0.617 acre-feet</td> </tr> <tr> <td colspan="3" style="text-align: center;">Approximate 10-yr Detention Volume = 1.536 acre-feet</td> </tr> <tr> <td colspan="3" style="text-align: center;">Approximate 25-yr Detention Volume = 2.263 acre-feet</td> </tr> <tr> <td colspan="3" style="text-align: center;">Approximate 50-yr Detention Volume = 2.332 acre-feet</td> </tr> <tr> <td colspan="3" style="text-align: center;">Approximate 100-yr Detention Volume = 3.087 acre-feet</td> </tr> <tr> <td colspan="9"> Stage-Storage Calculation <table border="1" style="margin-left: auto; margin-right: auto;"> <tr> <td style="padding: 2px;">Zone 1 Volume (User Defined) =</td> <td style="padding: 2px;">0.048 acre-feet</td> <td style="padding: 2px;">WQCV not provided!</td> </tr> <tr> <td style="padding: 2px;">Zone 2 Volume (EURV - Zone 1) =</td> <td style="padding: 2px;">0.556 acre-feet</td> <td></td> </tr> <tr> <td style="padding: 2px;">Zone 3 Volume (100-year - Zones 1 & 2) =</td> <td style="padding: 2px;">2.482 acre-feet</td> <td></td> </tr> <tr> <td style="padding: 2px;">Total Detention Basin Volume =</td> <td style="padding: 2px;">3.087 acre-feet</td> <td></td> </tr> <tr> <td style="padding: 2px;">Initial Surcharge Volume (ISV) =</td> <td style="padding: 2px;">user ft³</td> <td></td> </tr> <tr> <td style="padding: 2px;">Initial Surcharge Depth (ISD) =</td> <td style="padding: 2px;">user ft</td> <td></td> </tr> <tr> <td style="padding: 2px;">Total Available Detention Depth (H_{total}) =</td> <td style="padding: 2px;">user ft</td> <td></td> </tr> <tr> <td style="padding: 2px;">Depth of Trickle Channel ($H_{trickle}$) =</td> <td style="padding: 2px;">user ft</td> <td></td> </tr> <tr> <td style="padding: 2px;">Slope of Trickle Channel ($S_{trickle}$) =</td> <td style="padding: 2px;">user ft/ft</td> <td></td> </tr> <tr> <td style="padding: 2px;">Slopes of Main Basin Sides (S_{main}) =</td> <td style="padding: 2px;">user ft/V</td> <td></td> </tr> <tr> <td style="padding: 2px;">Basin Length-to-Width Ratio ($R_{L/W}$) =</td> <td style="padding: 2px;">user</td> <td></td> </tr> <tr> <td style="padding: 2px;">Initial Surcharge Area (A_{ISU}) =</td> <td style="padding: 2px;">user ft²</td> <td></td> </tr> <tr> <td style="padding: 2px;">Surcharge Volume Length (L_{ISU}) =</td> <td style="padding: 2px;">user ft</td> <td></td> </tr> <tr> <td style="padding: 2px;">Surcharge Volume Width (W_{ISU}) =</td> <td style="padding: 2px;">user ft</td> <td></td> </tr> <tr> <td style="padding: 2px;">Depth of Basin Floor (H_{BASIN}) =</td> <td style="padding: 2px;">user ft</td> <td></td> </tr> <tr> <td style="padding: 2px;">Length of Basin Floor (L_{BASIN}) =</td> <td style="padding: 2px;">user ft</td> <td></td> </tr> <tr> <td style="padding: 2px;">Width of Basin Floor (W_{BASIN}) =</td> <td style="padding: 2px;">user ft</td> <td></td> </tr> <tr> <td style="padding: 2px;">Area of Basin Floor (A_{BASIN}) =</td> <td style="padding: 2px;">user ft²</td> <td></td> </tr> <tr> <td style="padding: 2px;">Volume of Basin Floor (V_{BASIN}) =</td> <td style="padding: 2px;">user ft³</td> <td></td> </tr> <tr> <td style="padding: 2px;">Depth of Main Basin (H_{MAIN}) =</td> <td style="padding: 2px;">user ft</td> <td></td> </tr> <tr> <td style="padding: 2px;">Length of Main Basin (L_{MAIN}) =</td> <td style="padding: 2px;">user ft</td> <td></td> </tr> <tr> <td style="padding: 2px;">Width of Main Basin (W_{MAIN}) =</td> <td style="padding: 2px;">user ft</td> <td></td> </tr> <tr> <td style="padding: 2px;">Area of Main Basin (A_{MAIN}) =</td> <td style="padding: 2px;">user ft²</td> <td></td> </tr> <tr> <td style="padding: 2px;">Volume of Main Basin (V_{MAIN}) =</td> <td style="padding: 2px;">user ft³</td> <td></td> </tr> <tr> <td colspan="3" style="text-align: center;">Calculated Total Basin Volume (V_{total}) = user acre-feet</td> </tr> </table> </td> </tr> </table>									Selected BMP Type =	EDB	Note: L / W Ratio > 8	Watershed Area =	101.00 acres	L / W Ratio = 9.5	Watershed Length =	6,480 ft		Watershed Slope =	0.029 ft/ft		Watershed Imperviousness =	6.60% percent		Percentage Hydrologic Soil Group A =	0.0% percent		Percentage Hydrologic Soil Group B =	97.5% percent		Percentage Hydrologic Soil Groups C/D =	2.5% percent		Desired WQCV Drain Time =	40.0 hours		Location for 1-hr Rainfall Depths = User Input			Water Quality Capture Volume (WQCV) =	0.392 acre-feet	Optional User Override 1-hr Precipitation	Excess Urban Runoff Volume (EURV) =	0.604 acre-feet		2-yr Runoff Volume ($P_1 = 1.19 \text{ in}$) =	0.401 acre-feet		5-yr Runoff Volume ($P_1 = 1.5 \text{ in}$) =	0.659 acre-feet		10-yr Runoff Volume ($P_1 = 1.75 \text{ in}$) =	1.857 acre-feet		25-yr Runoff Volume ($P_1 = 2 \text{ in}$) =	5.716 acre-feet		50-yr Runoff Volume ($P_1 = 2.25 \text{ in}$) =	8.114 acre-feet		100-yr Runoff Volume ($P_1 = 2.5 \text{ in}$) =	11.244 acre-feet		500-yr Runoff Volume ($P_1 = 0 \text{ in}$) =	0.000 acre-feet		Approximate 2-yr Detention Volume = 0.372 acre-feet			Approximate 5-yr Detention Volume = 0.617 acre-feet			Approximate 10-yr Detention Volume = 1.536 acre-feet			Approximate 25-yr Detention Volume = 2.263 acre-feet			Approximate 50-yr Detention Volume = 2.332 acre-feet			Approximate 100-yr Detention Volume = 3.087 acre-feet			Stage-Storage Calculation <table border="1" style="margin-left: auto; margin-right: auto;"> <tr> <td style="padding: 2px;">Zone 1 Volume (User Defined) =</td> <td style="padding: 2px;">0.048 acre-feet</td> <td style="padding: 2px;">WQCV not provided!</td> </tr> <tr> <td style="padding: 2px;">Zone 2 Volume (EURV - Zone 1) =</td> <td style="padding: 2px;">0.556 acre-feet</td> <td></td> </tr> <tr> <td style="padding: 2px;">Zone 3 Volume (100-year - Zones 1 & 2) =</td> <td style="padding: 2px;">2.482 acre-feet</td> <td></td> </tr> <tr> <td style="padding: 2px;">Total Detention Basin Volume =</td> <td style="padding: 2px;">3.087 acre-feet</td> <td></td> </tr> <tr> <td style="padding: 2px;">Initial Surcharge Volume (ISV) =</td> <td style="padding: 2px;">user ft³</td> <td></td> </tr> <tr> <td style="padding: 2px;">Initial Surcharge Depth (ISD) =</td> <td style="padding: 2px;">user ft</td> <td></td> </tr> <tr> <td style="padding: 2px;">Total Available Detention Depth (H_{total}) =</td> <td style="padding: 2px;">user ft</td> <td></td> </tr> <tr> <td style="padding: 2px;">Depth of Trickle Channel ($H_{trickle}$) =</td> <td style="padding: 2px;">user ft</td> <td></td> </tr> <tr> <td style="padding: 2px;">Slope of Trickle Channel ($S_{trickle}$) =</td> <td style="padding: 2px;">user ft/ft</td> <td></td> </tr> <tr> <td style="padding: 2px;">Slopes of Main Basin Sides (S_{main}) =</td> <td style="padding: 2px;">user ft/V</td> <td></td> </tr> <tr> <td style="padding: 2px;">Basin Length-to-Width Ratio ($R_{L/W}$) =</td> <td style="padding: 2px;">user</td> <td></td> </tr> <tr> <td style="padding: 2px;">Initial Surcharge Area (A_{ISU}) =</td> <td style="padding: 2px;">user ft²</td> <td></td> </tr> <tr> <td style="padding: 2px;">Surcharge Volume Length (L_{ISU}) =</td> <td style="padding: 2px;">user ft</td> <td></td> </tr> <tr> <td style="padding: 2px;">Surcharge Volume Width (W_{ISU}) =</td> <td style="padding: 2px;">user ft</td> <td></td> </tr> <tr> <td style="padding: 2px;">Depth of Basin Floor (H_{BASIN}) =</td> <td style="padding: 2px;">user ft</td> <td></td> </tr> <tr> <td style="padding: 2px;">Length of Basin Floor (L_{BASIN}) =</td> <td style="padding: 2px;">user ft</td> <td></td> </tr> <tr> <td style="padding: 2px;">Width of Basin Floor (W_{BASIN}) =</td> <td style="padding: 2px;">user ft</td> <td></td> </tr> <tr> <td style="padding: 2px;">Area of Basin Floor (A_{BASIN}) =</td> <td style="padding: 2px;">user ft²</td> <td></td> </tr> <tr> <td style="padding: 2px;">Volume of Basin Floor (V_{BASIN}) =</td> <td style="padding: 2px;">user ft³</td> <td></td> </tr> <tr> <td style="padding: 2px;">Depth of Main Basin (H_{MAIN}) =</td> <td style="padding: 2px;">user ft</td> <td></td> </tr> <tr> <td style="padding: 2px;">Length of Main Basin (L_{MAIN}) =</td> <td style="padding: 2px;">user ft</td> <td></td> </tr> <tr> <td style="padding: 2px;">Width of Main Basin (W_{MAIN}) =</td> <td style="padding: 2px;">user ft</td> <td></td> </tr> <tr> <td style="padding: 2px;">Area of Main Basin (A_{MAIN}) =</td> <td style="padding: 2px;">user ft²</td> <td></td> </tr> <tr> <td style="padding: 2px;">Volume of Main Basin (V_{MAIN}) =</td> <td style="padding: 2px;">user ft³</td> <td></td> </tr> <tr> <td colspan="3" style="text-align: center;">Calculated Total Basin Volume (V_{total}) = user acre-feet</td> </tr> </table>									Zone 1 Volume (User Defined) =	0.048 acre-feet	WQCV not provided!	Zone 2 Volume (EURV - Zone 1) =	0.556 acre-feet		Zone 3 Volume (100-year - Zones 1 & 2) =	2.482 acre-feet		Total Detention Basin Volume =	3.087 acre-feet		Initial Surcharge Volume (ISV) =	user ft ³		Initial Surcharge Depth (ISD) =	user ft		Total Available Detention Depth (H_{total}) =	user ft		Depth of Trickle Channel ($H_{trickle}$) =	user ft		Slope of Trickle Channel ($S_{trickle}$) =	user ft/ft		Slopes of Main Basin Sides (S_{main}) =	user ft/V		Basin Length-to-Width Ratio ($R_{L/W}$) =	user		Initial Surcharge Area (A_{ISU}) =	user ft ²		Surcharge Volume Length (L_{ISU}) =	user ft		Surcharge Volume Width (W_{ISU}) =	user ft		Depth of Basin Floor (H_{BASIN}) =	user ft		Length of Basin Floor (L_{BASIN}) =	user ft		Width of Basin Floor (W_{BASIN}) =	user ft		Area of Basin Floor (A_{BASIN}) =	user ft ²		Volume of Basin Floor (V_{BASIN}) =	user ft ³		Depth of Main Basin (H_{MAIN}) =	user ft		Length of Main Basin (L_{MAIN}) =	user ft		Width of Main Basin (W_{MAIN}) =	user ft		Area of Main Basin (A_{MAIN}) =	user ft ²		Volume of Main Basin (V_{MAIN}) =	user ft ³		Calculated Total Basin Volume (V_{total}) = user acre-feet		
Selected BMP Type =	EDB	Note: L / W Ratio > 8																																																																																																																																																																					
Watershed Area =	101.00 acres	L / W Ratio = 9.5																																																																																																																																																																					
Watershed Length =	6,480 ft																																																																																																																																																																						
Watershed Slope =	0.029 ft/ft																																																																																																																																																																						
Watershed Imperviousness =	6.60% percent																																																																																																																																																																						
Percentage Hydrologic Soil Group A =	0.0% percent																																																																																																																																																																						
Percentage Hydrologic Soil Group B =	97.5% percent																																																																																																																																																																						
Percentage Hydrologic Soil Groups C/D =	2.5% percent																																																																																																																																																																						
Desired WQCV Drain Time =	40.0 hours																																																																																																																																																																						
Location for 1-hr Rainfall Depths = User Input																																																																																																																																																																							
Water Quality Capture Volume (WQCV) =	0.392 acre-feet	Optional User Override 1-hr Precipitation																																																																																																																																																																					
Excess Urban Runoff Volume (EURV) =	0.604 acre-feet																																																																																																																																																																						
2-yr Runoff Volume ($P_1 = 1.19 \text{ in}$) =	0.401 acre-feet																																																																																																																																																																						
5-yr Runoff Volume ($P_1 = 1.5 \text{ in}$) =	0.659 acre-feet																																																																																																																																																																						
10-yr Runoff Volume ($P_1 = 1.75 \text{ in}$) =	1.857 acre-feet																																																																																																																																																																						
25-yr Runoff Volume ($P_1 = 2 \text{ in}$) =	5.716 acre-feet																																																																																																																																																																						
50-yr Runoff Volume ($P_1 = 2.25 \text{ in}$) =	8.114 acre-feet																																																																																																																																																																						
100-yr Runoff Volume ($P_1 = 2.5 \text{ in}$) =	11.244 acre-feet																																																																																																																																																																						
500-yr Runoff Volume ($P_1 = 0 \text{ in}$) =	0.000 acre-feet																																																																																																																																																																						
Approximate 2-yr Detention Volume = 0.372 acre-feet																																																																																																																																																																							
Approximate 5-yr Detention Volume = 0.617 acre-feet																																																																																																																																																																							
Approximate 10-yr Detention Volume = 1.536 acre-feet																																																																																																																																																																							
Approximate 25-yr Detention Volume = 2.263 acre-feet																																																																																																																																																																							
Approximate 50-yr Detention Volume = 2.332 acre-feet																																																																																																																																																																							
Approximate 100-yr Detention Volume = 3.087 acre-feet																																																																																																																																																																							
Stage-Storage Calculation <table border="1" style="margin-left: auto; margin-right: auto;"> <tr> <td style="padding: 2px;">Zone 1 Volume (User Defined) =</td> <td style="padding: 2px;">0.048 acre-feet</td> <td style="padding: 2px;">WQCV not provided!</td> </tr> <tr> <td style="padding: 2px;">Zone 2 Volume (EURV - Zone 1) =</td> <td style="padding: 2px;">0.556 acre-feet</td> <td></td> </tr> <tr> <td style="padding: 2px;">Zone 3 Volume (100-year - Zones 1 & 2) =</td> <td style="padding: 2px;">2.482 acre-feet</td> <td></td> </tr> <tr> <td style="padding: 2px;">Total Detention Basin Volume =</td> <td style="padding: 2px;">3.087 acre-feet</td> <td></td> </tr> <tr> <td style="padding: 2px;">Initial Surcharge Volume (ISV) =</td> <td style="padding: 2px;">user ft³</td> <td></td> </tr> <tr> <td style="padding: 2px;">Initial Surcharge Depth (ISD) =</td> <td style="padding: 2px;">user ft</td> <td></td> </tr> <tr> <td style="padding: 2px;">Total Available Detention Depth (H_{total}) =</td> <td style="padding: 2px;">user ft</td> <td></td> </tr> <tr> <td style="padding: 2px;">Depth of Trickle Channel ($H_{trickle}$) =</td> <td style="padding: 2px;">user ft</td> <td></td> </tr> <tr> <td style="padding: 2px;">Slope of Trickle Channel ($S_{trickle}$) =</td> <td style="padding: 2px;">user ft/ft</td> <td></td> </tr> <tr> <td style="padding: 2px;">Slopes of Main Basin Sides (S_{main}) =</td> <td style="padding: 2px;">user ft/V</td> <td></td> </tr> <tr> <td style="padding: 2px;">Basin Length-to-Width Ratio ($R_{L/W}$) =</td> <td style="padding: 2px;">user</td> <td></td> </tr> <tr> <td style="padding: 2px;">Initial Surcharge Area (A_{ISU}) =</td> <td style="padding: 2px;">user ft²</td> <td></td> </tr> <tr> <td style="padding: 2px;">Surcharge Volume Length (L_{ISU}) =</td> <td style="padding: 2px;">user ft</td> <td></td> </tr> <tr> <td style="padding: 2px;">Surcharge Volume Width (W_{ISU}) =</td> <td style="padding: 2px;">user ft</td> <td></td> </tr> <tr> <td style="padding: 2px;">Depth of Basin Floor (H_{BASIN}) =</td> <td style="padding: 2px;">user ft</td> <td></td> </tr> <tr> <td style="padding: 2px;">Length of Basin Floor (L_{BASIN}) =</td> <td style="padding: 2px;">user ft</td> <td></td> </tr> <tr> <td style="padding: 2px;">Width of Basin Floor (W_{BASIN}) =</td> <td style="padding: 2px;">user ft</td> <td></td> </tr> <tr> <td style="padding: 2px;">Area of Basin Floor (A_{BASIN}) =</td> <td style="padding: 2px;">user ft²</td> <td></td> </tr> <tr> <td style="padding: 2px;">Volume of Basin Floor (V_{BASIN}) =</td> <td style="padding: 2px;">user ft³</td> <td></td> </tr> <tr> <td style="padding: 2px;">Depth of Main Basin (H_{MAIN}) =</td> <td style="padding: 2px;">user ft</td> <td></td> </tr> <tr> <td style="padding: 2px;">Length of Main Basin (L_{MAIN}) =</td> <td style="padding: 2px;">user ft</td> <td></td> </tr> <tr> <td style="padding: 2px;">Width of Main Basin (W_{MAIN}) =</td> <td style="padding: 2px;">user ft</td> <td></td> </tr> <tr> <td style="padding: 2px;">Area of Main Basin (A_{MAIN}) =</td> <td style="padding: 2px;">user ft²</td> <td></td> </tr> <tr> <td style="padding: 2px;">Volume of Main Basin (V_{MAIN}) =</td> <td style="padding: 2px;">user ft³</td> <td></td> </tr> <tr> <td colspan="3" style="text-align: center;">Calculated Total Basin Volume (V_{total}) = user acre-feet</td> </tr> </table>									Zone 1 Volume (User Defined) =	0.048 acre-feet	WQCV not provided!	Zone 2 Volume (EURV - Zone 1) =	0.556 acre-feet		Zone 3 Volume (100-year - Zones 1 & 2) =	2.482 acre-feet		Total Detention Basin Volume =	3.087 acre-feet		Initial Surcharge Volume (ISV) =	user ft ³		Initial Surcharge Depth (ISD) =	user ft		Total Available Detention Depth (H_{total}) =	user ft		Depth of Trickle Channel ($H_{trickle}$) =	user ft		Slope of Trickle Channel ($S_{trickle}$) =	user ft/ft		Slopes of Main Basin Sides (S_{main}) =	user ft/V		Basin Length-to-Width Ratio ($R_{L/W}$) =	user		Initial Surcharge Area (A_{ISU}) =	user ft ²		Surcharge Volume Length (L_{ISU}) =	user ft		Surcharge Volume Width (W_{ISU}) =	user ft		Depth of Basin Floor (H_{BASIN}) =	user ft		Length of Basin Floor (L_{BASIN}) =	user ft		Width of Basin Floor (W_{BASIN}) =	user ft		Area of Basin Floor (A_{BASIN}) =	user ft ²		Volume of Basin Floor (V_{BASIN}) =	user ft ³		Depth of Main Basin (H_{MAIN}) =	user ft		Length of Main Basin (L_{MAIN}) =	user ft		Width of Main Basin (W_{MAIN}) =	user ft		Area of Main Basin (A_{MAIN}) =	user ft ²		Volume of Main Basin (V_{MAIN}) =	user ft ³		Calculated Total Basin Volume (V_{total}) = user acre-feet																																																																																						
Zone 1 Volume (User Defined) =	0.048 acre-feet	WQCV not provided!																																																																																																																																																																					
Zone 2 Volume (EURV - Zone 1) =	0.556 acre-feet																																																																																																																																																																						
Zone 3 Volume (100-year - Zones 1 & 2) =	2.482 acre-feet																																																																																																																																																																						
Total Detention Basin Volume =	3.087 acre-feet																																																																																																																																																																						
Initial Surcharge Volume (ISV) =	user ft ³																																																																																																																																																																						
Initial Surcharge Depth (ISD) =	user ft																																																																																																																																																																						
Total Available Detention Depth (H_{total}) =	user ft																																																																																																																																																																						
Depth of Trickle Channel ($H_{trickle}$) =	user ft																																																																																																																																																																						
Slope of Trickle Channel ($S_{trickle}$) =	user ft/ft																																																																																																																																																																						
Slopes of Main Basin Sides (S_{main}) =	user ft/V																																																																																																																																																																						
Basin Length-to-Width Ratio ($R_{L/W}$) =	user																																																																																																																																																																						
Initial Surcharge Area (A_{ISU}) =	user ft ²																																																																																																																																																																						
Surcharge Volume Length (L_{ISU}) =	user ft																																																																																																																																																																						
Surcharge Volume Width (W_{ISU}) =	user ft																																																																																																																																																																						
Depth of Basin Floor (H_{BASIN}) =	user ft																																																																																																																																																																						
Length of Basin Floor (L_{BASIN}) =	user ft																																																																																																																																																																						
Width of Basin Floor (W_{BASIN}) =	user ft																																																																																																																																																																						
Area of Basin Floor (A_{BASIN}) =	user ft ²																																																																																																																																																																						
Volume of Basin Floor (V_{BASIN}) =	user ft ³																																																																																																																																																																						
Depth of Main Basin (H_{MAIN}) =	user ft																																																																																																																																																																						
Length of Main Basin (L_{MAIN}) =	user ft																																																																																																																																																																						
Width of Main Basin (W_{MAIN}) =	user ft																																																																																																																																																																						
Area of Main Basin (A_{MAIN}) =	user ft ²																																																																																																																																																																						
Volume of Main Basin (V_{MAIN}) =	user ft ³																																																																																																																																																																						
Calculated Total Basin Volume (V_{total}) = user acre-feet																																																																																																																																																																							

DETENTION BASIN STAGE-STORAGE TABLE BUILDER


UD-Detention, Version 3.07 (February 2017)

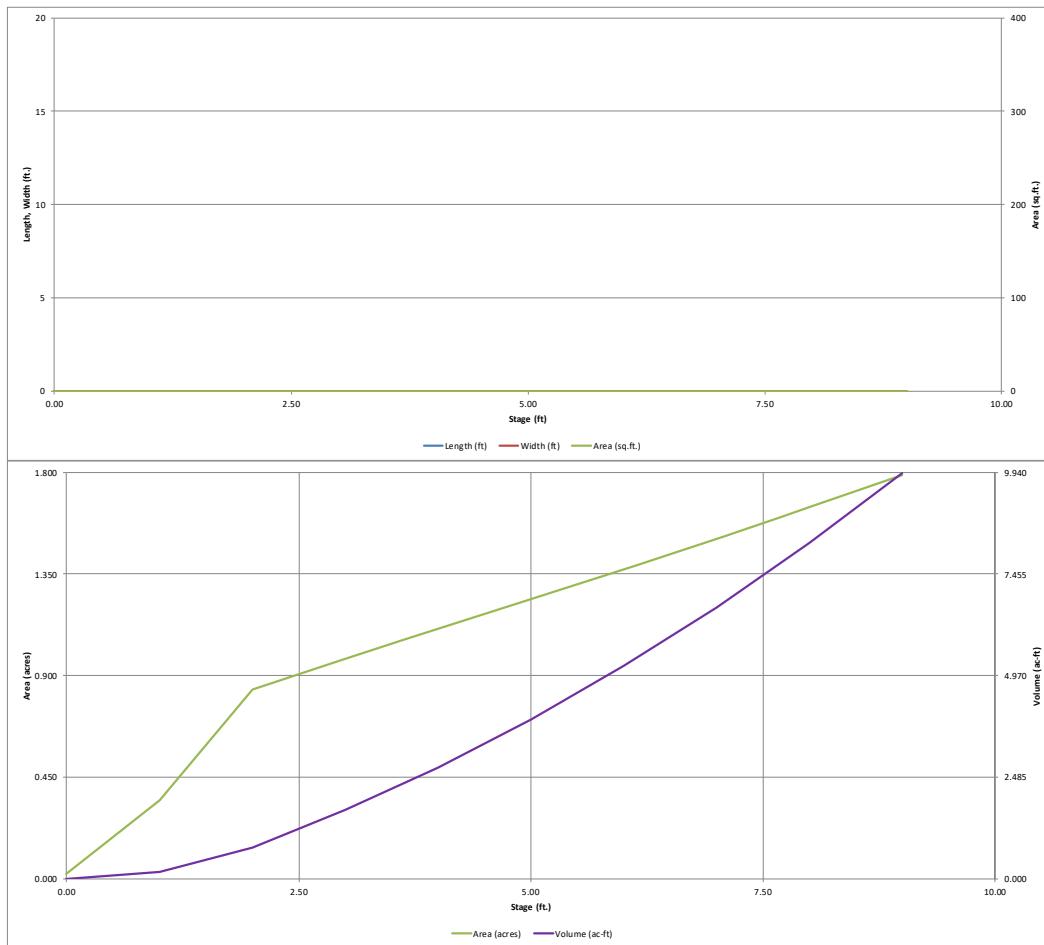

Detention Basin Outlet Structure Design

UD-Detention, Version 3.07 (February 2017)

Project: Winsome Filing 1 - Pond 3 (Water Quality Area)
Basin ID: Pond 3 (WQ Area Only)

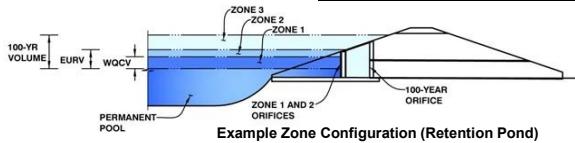

Example Zone Configuration (Retention Pond)

User Input: Orifice at Underdrain Outlet (typically used to drain WQCV in a Filtration BMP)

Underdrain Orifice Invert Depth = ft (distance below the filtration media surface)
Underdrain Orifice Diameter = inches

Calculated Parameters for Underdrain

Underdrain Orifice Area = ft²
Underdrain Orifice Centroid = feet

User Input: Orifice Plate with one or more orifices or Elliptical Slot Weir (typically used to drain WQCV and/or EURV in a sedimentation BMP)

Invert of Lowest Orifice = ft (relative to basin bottom at Stage = 0 ft)
Depth at top of Zone using Orifice Plate = ft (relative to basin bottom at Stage = 0 ft)
Orifice Plate: Orifice Vertical Spacing = inches
Orifice Plate: Orifice Area per Row = sq. inches (diameter = 5/8 inch)

Calculated Parameters for Plate

WQ Orifice Area per Row = ft²
Elliptical Half-Width = feet
Elliptical Slot Centroid = feet
Elliptical Slot Area = ft²

User Input: Stage and Total Area of Each Orifice Row (numbered from lowest to highest)

Row 1 (required)	Row 2 (optional)	Row 3 (optional)	Row 4 (optional)	Row 5 (optional)	Row 6 (optional)	Row 7 (optional)	Row 8 (optional)
Stage of Orifice Centroid (ft)	0.00	0.20					
Orifice Area (sq. inches)	0.35	0.35					
Stage of Orifice Centroid (ft)							
Orifice Area (sq. inches)							

User Input: Vertical Orifice (Circular or Rectangular)

Zone 2 Rectangular =
Invert of Vertical Orifice = ft (relative to basin bottom at Stage = 0 ft)
Depth at top of Zone using Vertical Orifice = ft (relative to basin bottom at Stage = 0 ft)
Vertical Orifice Height = inches
Vertical Orifice Width = inches

Calculated Parameters for Vertical Orifice

Zone 2 Rectangular =
Vertical Orifice Area = ft²
Vertical Orifice Centroid = feet

User Input: Overflow Weir (Dropbox) and Grate (Flat or Sloped)

Zone 3 Weir =
Overflow Weir Front Edge Height, Ho = ft (relative to basin bottom at Stage = 0 ft)
Overflow Weir Front Edge Length = feet
Overflow Weir Slope = H:V (enter zero for flat grate)
Horiz. Length of Weir Sides = feet
Overflow Grate Open Area % = %, grate open area/total area
Debris Clogging % = %

Calculated Parameters for Overflow Weir

Zone 3 Weir	Not Selected
Height of Grate Upper Edge, H _t	<input type="text" value="3.00"/> feet
Over Flow Weir Slope Length	<input type="text" value="3.00"/> feet
Grate Open Area / 100-yr Orifice Area	<input type="text" value="2.08"/> ft ²
Overflow Grate Open Area w/o Debris	<input type="text" value="10.20"/> ft ²
Overflow Grate Open Area w/ Debris	<input type="text" value="5.10"/> ft ²

User Input: Outlet Pipe w/ Flow Restriction Plate (Circular Orifice, Restrictor Plate, or Rectangular Orifice)

Zone 3 Circular =
Depth to Invert of Outlet Pipe = ft (distance below basin bottom at Stage = 0 ft)
Circular Orifice Diameter = inches

Calculated Parameters for Outlet Pipe w/ Flow Restriction Plate

Zone 3 Circular	Not Selected
Outlet Orifice Area	<input type="text" value="4.91"/> ft ²
Outlet Orifice Centroid	<input type="text" value="1.25"/> feet
Half-Central Angle of Restrictor Plate on Pipe	<input type="text" value="N/A"/> radians

User Input: Emergency Spillway (Rectangular or Trapezoidal)

Spillway Invert Stage = ft (relative to basin bottom at Stage = 0 ft)
Spillway Crest Length = feet
Spillway End Slopes = H:V
Freeboard above Max Water Surface = feet

Calculated Parameters for Spillway


Spillway Design Flow Depth	0.80	feet
Stage at Top of Freeboard	<input type="text" value="8.00"/>	feet
Basin Area at Top of Freeboard	<input type="text" value="1.64"/> acres	

Routed Hydrograph Results

	WQCV	EURV	2 Year	5 Year	10 Year	25 Year	50 Year	100 Year	500 Year
Design Storm Return Period =									
One-Hour Rainfall Depth (in) =	0.53	1.07	1.19	1.50	1.75	2.00	2.25	2.52	0.00
Calculated Runoff Volume (acre-ft) =	0.392	0.604	0.401	0.659	1.857	5.716	8.114	11.244	0.000
OPTIONAL Override Runoff Volume (acre-ft) =	0.014								
Inflow Hydrograph Volume (acre-ft) =	0.014	0.604	0.401	0.659	1.858	5.715	8.114	11.247	#N/A
Predevelopment Unit Peak Flow, q (cfs/acre) =	0.00	0.00	0.01	0.02	0.14	0.47	0.66	0.89	0.00
Predevelopment Peak Q (cfs) =	0.0	0.0	0.8	1.6	13.7	47.8	66.2	90.3	0.0
Peak Inflow Q (cfs) =	0.2	6.6	4.4	7.2	20.0	60.3	84.9	116.5	#N/A
Peak Outflow Q (cfs) =	0.0	0.3	0.3	0.4	0.9	31.6	41.6	52.6	#N/A
Ratio Peak Outflow to Predevelopment Q =	N/A	N/A	N/A	0.2	0.1	0.7	0.6	0.6	#N/A
Structure Controlling Flow =	Plate	Vertical Orifice 1	Vertical Orifice 1	Vertical Orifice 1	Overflow Grate 1	Overflow Grate 1	Overflow Grate 1	Overflow Grate 1	#N/A
Max Velocity through Grate 1 (fps) =	N/A	N/A	N/A	N/A	0.0	3.0	4.0	5.1	#N/A
Max Velocity through Grate 2 (fps) =	N/A	N/A	N/A	N/A	N/A	N/A	N/A	N/A	#N/A
Time to Drain 97% of Inflow Volume (hours) =	40	31	33	32	60	54	50	47	#N/A
Time to Drain 99% of Inflow Volume (hours) =	43	54	53	55	66	61	59	57	#N/A
Maximum Ponding Depth (ft) =	0.22	1.68	1.36	1.75	3.05	4.12	4.96	6.15	#N/A
Area at Maximum Ponding Depth (acres) =	0.09	0.67	0.52	0.71	0.98	1.12	1.23	1.39	#N/A
Maximum Volume Stored (acre-ft) =	0.012	0.527	0.336	0.583	1.721	2.855	3.843	5.402	#N/A

Detention Basin Outlet Structure Design

UD-Detention, Version 3.07 (February 2017)

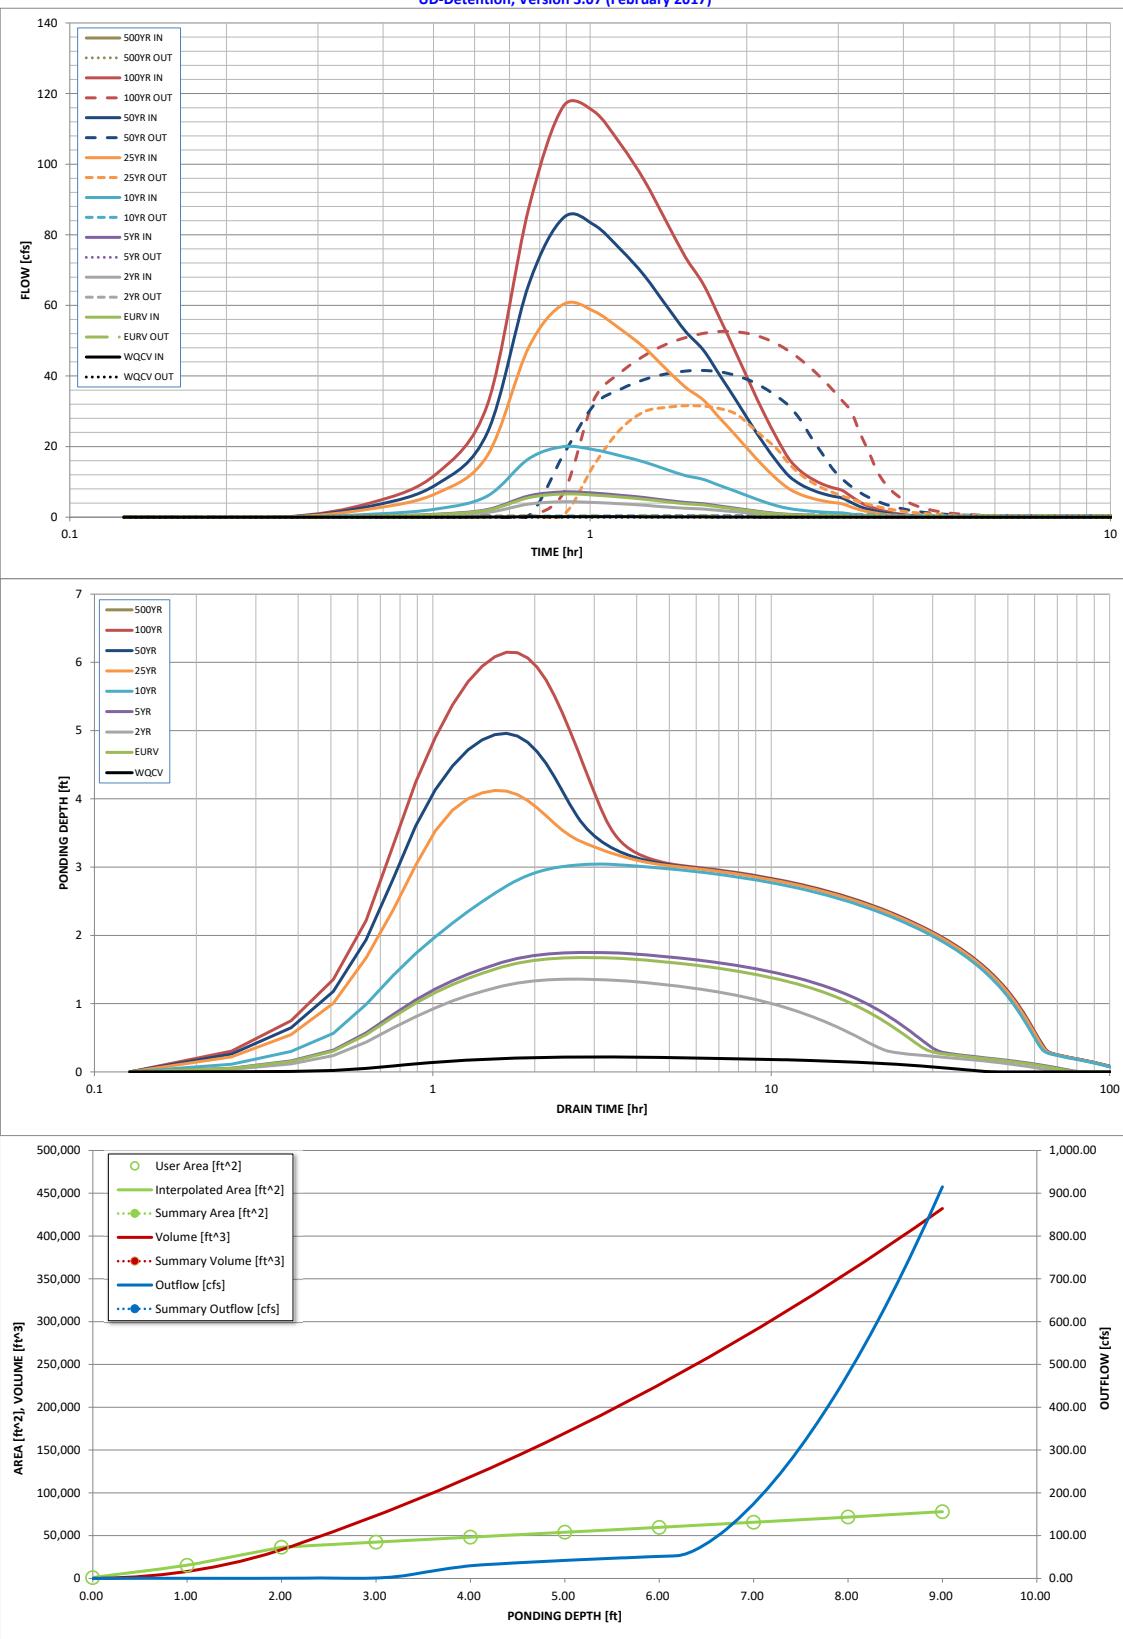

S-A-V-D Chart Axis Override	X-axis	Left Y-Axis	Right Y-Axis
minimum bound			
maximum bound			

Detention Basin Outlet Structure Design

Outflow Hydrograph Workbook Filename:

Storm Inflow Hydrographs

UD-Detention, Version 3.07 (February 2017)

The user can override the calculated inflow hydrographs from this workbook with inflow hydrographs developed in a separate program.

Detention Basin Outlet Structure Design

UD-Detention, Version 3.07 (February 2017)

Summary Stage-Area-Volume-Discharge Relationships

The user can create a summary S-A-V-D by entering the desired stage increments and the remainder of the table will populate automatically.

The user should graphically compare the summary S-A-V-D table to the full S-A-V-D table in the chart to confirm it captures all key transition points.

CONSTRUCTION DOCUMENTS WINSOME FILING NO 1

A TRACT OF LAND BEING A PORTION OF SECTION 24, TOWNSHIP 11 SOUTH, RANGE 65 WEST,
OF THE 6TH PRINCIPAL MERIDIAN, COUNTY OF EL PASO, STATE OF COLORADO





VERTEX
2420 W. 26th Avenue, Suite 100-D | Denver, CO 80211
Main: 303.623.9116 | VERTEXENG.COM



WATER QUALITY POND B - PLAN AND PROFILE
SITE: 17480 MERIDIAN ROAD
ELBERT, COLORADO 80106
FOR: WINSOME, LLC
1864 WOODMORE DR, SUITE 100
MONUMENT, COLORADO 80132

NO.	REVISIONS
1	SUBMITTAL 1
2	04.03.2020 REVISED PER COMMENTS
3	08.01.2020 REVISED PER COMMENTS
4	10.14.2020 REVISED PER COMMENTS
5	11.25.2020 REVISED PER COMMENTS
6	12.15.2020 FOR CONSTRUCTION
7	
8	
9	
10	

DATE: 01.22.20
DRAWN BY: JCP
CHECKED BY: LPV
JOB #: 49388.01

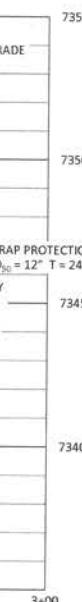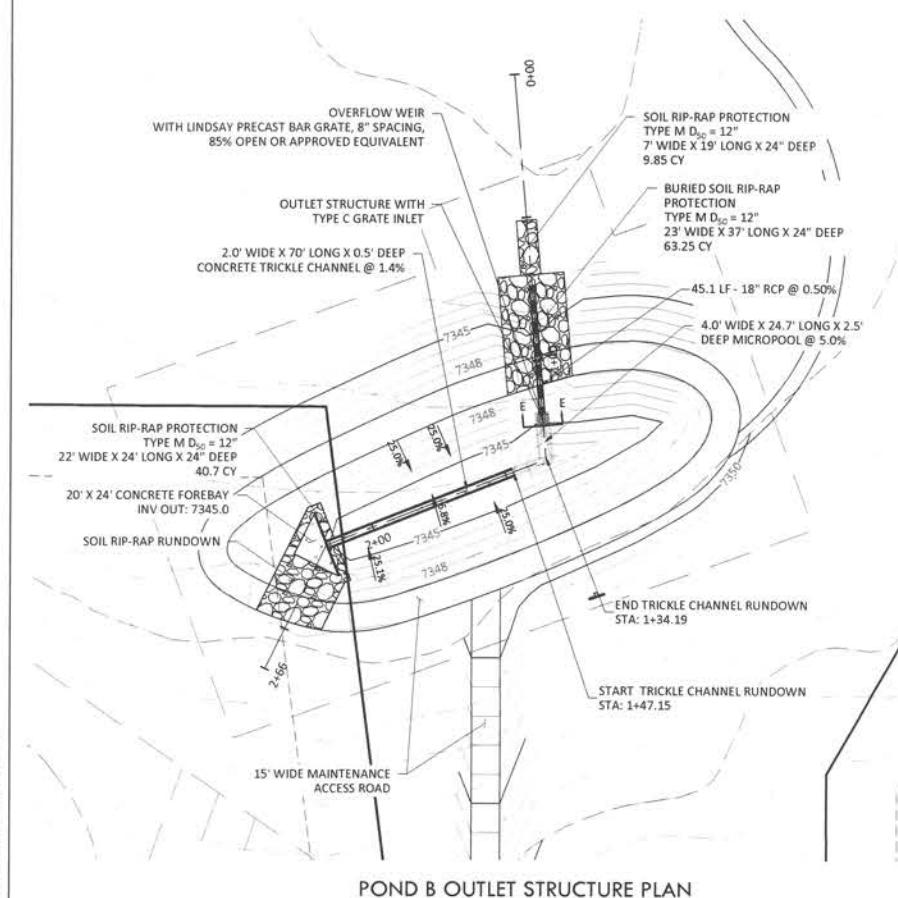





MAINTENANCE ACCESS ROAD
SCALE 1" = 2'

CONCRETE TRICKLE CHANNEL
SCALE 1" = 2'

OUTLET STRUCTURE DETAIL - SECTION E-E
SCALE 1" = 2'

ORIFICE PLATE NOTES:

1. PROVIDE CONTINUOUS NEOPRENE GASKET MATERIAL BETWEEN THE ORIFICE PLATE AND CONCRETE.
 2. BOLT PLATE TO CONCRETE 12" MAX. ON CENTER.
- EVRV AND WQCV TRASH RACKS:
1. WELL-SCREEN TRASH RACKS SHALL BE STAINLESS STEEL AND SHALL BE ATTACHED BY INTERMITTENT WELDS ALONG THE EDGE OF THE MOUNTING FRAME.
 2. BAR GRATE TRASH RACKS SHALL BE ALUMINUM AND SHALL BE BOLTED USING STAINLESS STEEL HARDWARE.

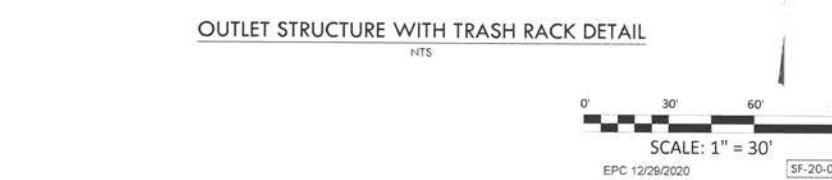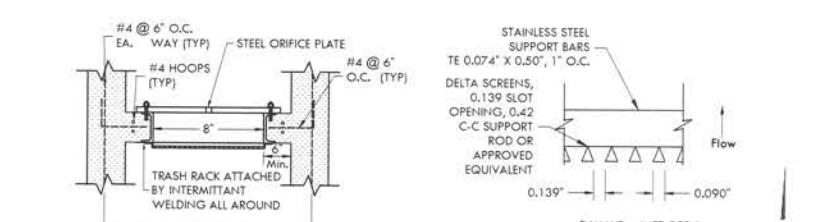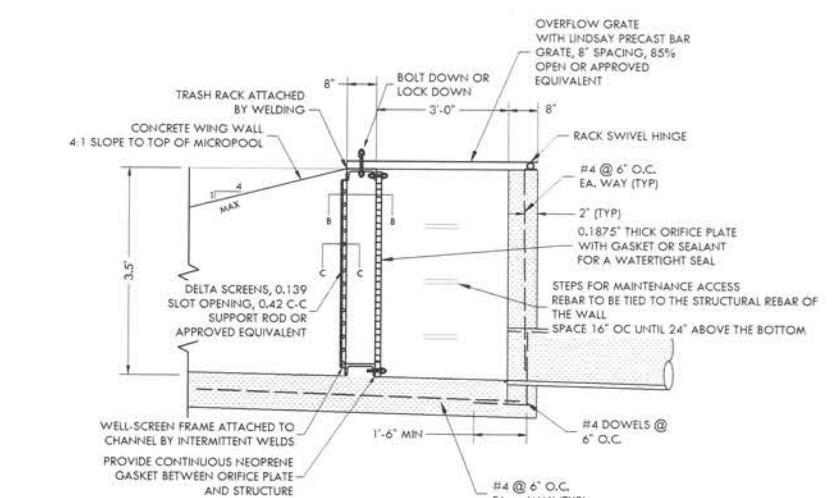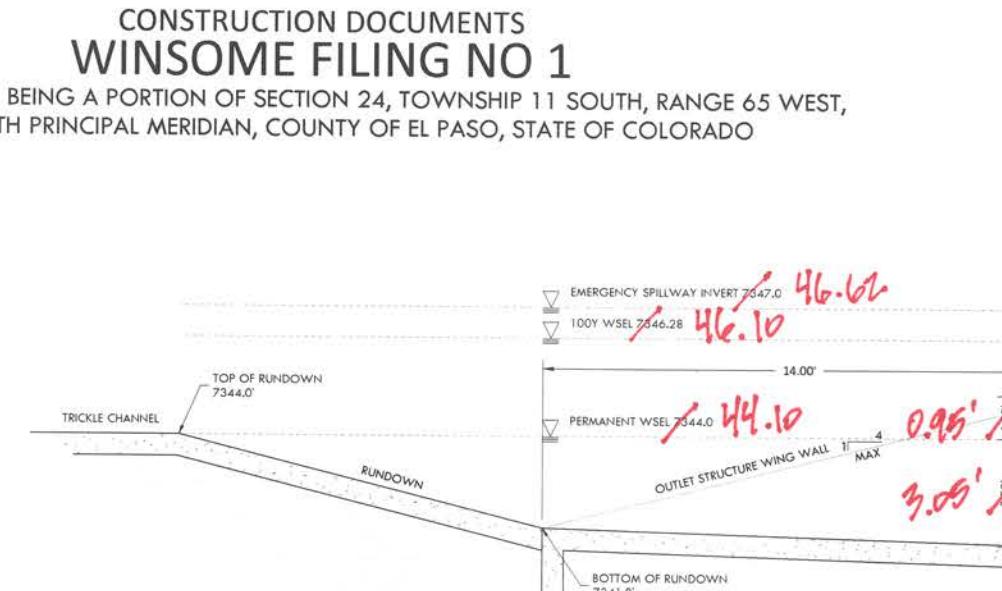

CONSTRUCTION DOCUMENTS WINSOME FILING NO 1

A TRACT OF LAND BEING A PORTION OF SECTION 24, TOWNSHIP 11 SOUTH, RANGE 65 WEST,
OF THE 6TH PRINCIPAL MERIDIAN, COUNTY OF EL PASO, STATE OF COLORADO



Know what's below.
Call before you dig.





VERTEX
2420 W. 26th Avenue, Suite 100-D | Denver, CO 80211
Main: 303.623.9116 | VERTEXENG.COM



WATER QUALITY POND C - PLAN AND PROFILE
SITE: 17480 MERIDIAN ROAD
ELBERT, COLORADO 80106
FOR: WINSOME, LLC
1864 WOODMORE DR, SUITE 100
MONUMENT, COLORADO 80132

NO.	REVISIONS
1	SUBMITTAL 1
2	04.03.2020 REVISED PER COMMENTS
3	08.03.2020 REVISED PER COMMENTS
4	10.14.2020 REVISED PER COMMENTS
5	11.25.2020 REVISED FOR COMMENTS
6	12.15.2020 FOR CONSTRUCTION
7	
8	
9	
10	

DATE: 01.22.20
DRAWN BY: JCP
CHECKED BY: LPV
JOB #: 49388.01

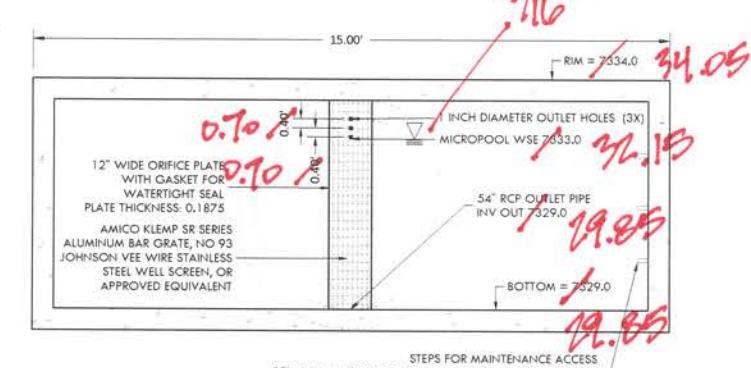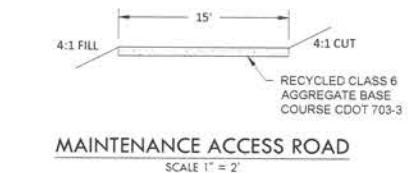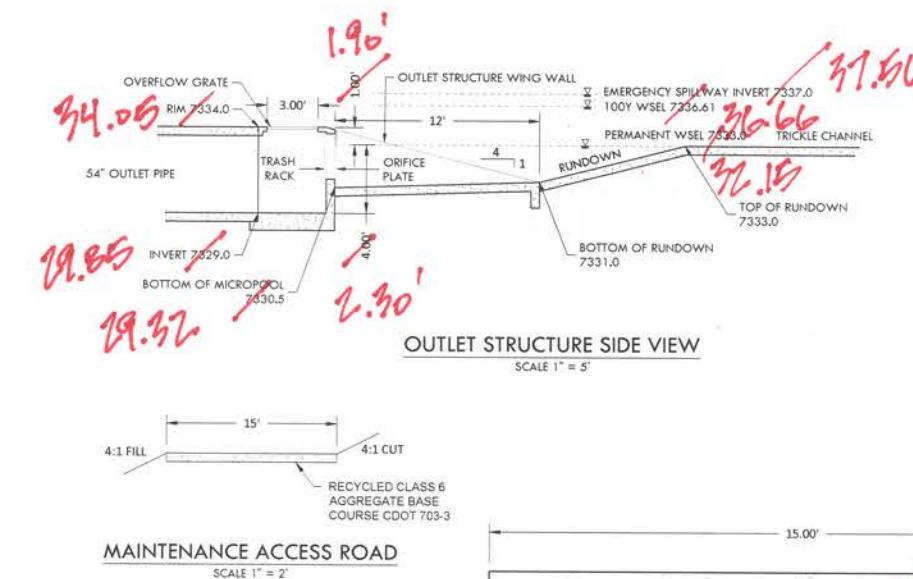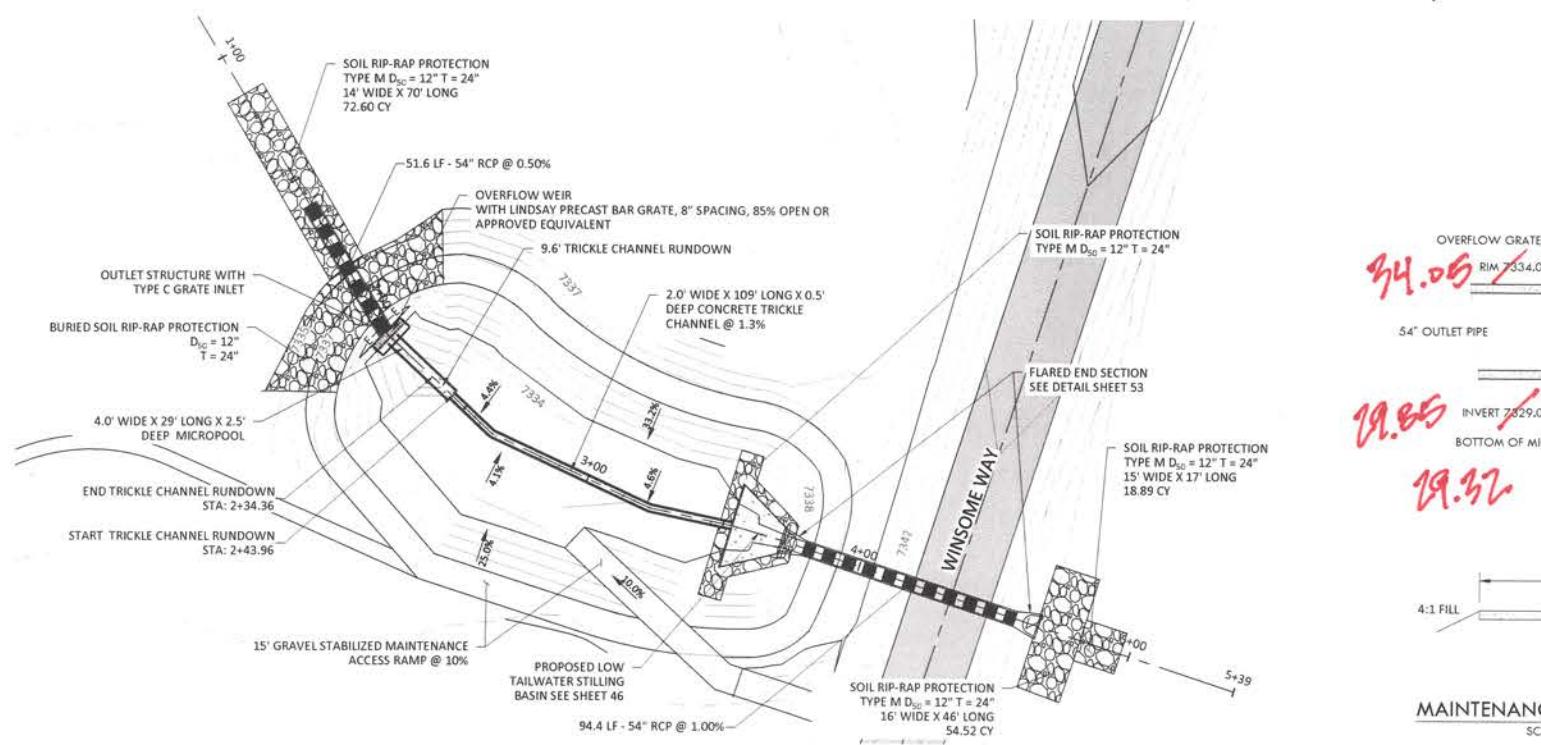

- ORIFICE PLATE NOTES:
1. PROVIDE CONTINUOUS NEOPRENE GASKET MATERIAL BETWEEN THE ORIFICE PLATE AND CONCRETE.
 2. BOLT PLATE TO CONCRETE 12" MAX. ON CENTER.

EURV AND WQCV TRASH RACKS:

1. WELL-SCREEN TRASH RACKS SHALL BE STAINLESS STEEL AND SHALL BE ATTACHED BY INTERMITTENT WELDS ALONG THE EDGE OF THE MOUNTING FRAME.
2. BAR GRATE TRASH RACKS SHALL BE ALUMINUM AND SHALL BE BOLTED USING STAINLESS STEEL HARDWARE.



CONSTRUCTION DOCUMENTS
WINSOME FILING NO 1

A TRACT OF LAND BEING A PORTION OF SECTION 24, TOWNSHIP 11 SOUTH, RANGE 65 WEST,
OF THE 6TH PRINCIPAL MERIDIAN, COUNTY OF EL PASO, STATE OF COLORADO



OUTLET STRUCTURE SIDE VIEW

SCALE 1" = 2'

Handwritten dimensions overlaid on the drawing:

- Top left: 26.19 (RIM 7326.5)
- Top center: 12.10 (OUTLET STRUCTURE WING WALL)
- Top right: 24.09 (PERMANENT WSEL 7325.0)
- Middle left: 21.99 (PIPE INVERT 7322.5)
- Middle center: 12.54 (TRASH RACK)
- Middle right: 21.99 (TOP OF RUNDOWN 7325.0)
- Bottom left: 21.99 (PIPE INVERT 7322.5)
- Bottom center: 21.55 (BOTTOM OF MICROPOL 7322.5)
- Bottom right: 21.99 (BOTTOM OF RUNDOWN 7322.6)
- Bottom right corner: 11/16"

Maintenance Access Road


SCALE 1" = 2'

Handwritten dimensions overlaid on the drawing:

- Top left: 26.19 (RIM = 7326.50)
- Top center: 24.09 (MICROPOOL WSE 7325.0)
- Top right: 21.99 (42" RCP OUTLET PIPE (2X) INV OUT 7322.50)
- Middle left: 0.50' (0.40')
- Middle right: 0.50' (0.40')
- Bottom left: 12" WIDE ORIFICE PLATE WITH GASKET FOR WATERTIGHT SEAL PLATE THICKNESS 0.1875
- Bottom left: DELTA SCREENS, 0.139 SLOT OPENING, 0.42 C-C SUPPORT ROD OR APPROVED EQUIVALENT
- Bottom right: WELL-SCREEN FRAME ATTACHED TO CHANNEL BY INTERMITTENT WELDS PROVIDE CONTINUOUS NEOPRENE GASKET BETWEEN ORIFICE PLATE

SOIL RIP-RAP NOT

1. ELEVATION TOLERANCES FOR THE SOIL RIP-RAP SHALL BE 0.10 FEET. THICKNESS OF SOIL RIP-RAP SHALL BE NO LESS THAN THICKNESS SHOWN AND NO MORE THAN 2-INCHES GREATER THAN THE THICKNESS SHOWN.
 2. WHERE "SOIL RIP-RAP" IS DESIGNATED ON THE CONTRACT DRAWINGS, RIP-RAP VOIDS ARE TO BE FILLED WITH NATIVE SOIL. THE RIP-RAP SHALL BE PRE-MIXED WITH THE NATIVE SOIL AT THE FOLLOWING PROPORTIONS BY VOLUME. 65% RIP-RAP AND 35% SOIL. THE SOIL USED FOR MIXING SHALL BE NATIVE TOPSOIL AND SHALL HAVE A MINIMUM FINES CONTENT OF 15%. THE SOIL RIP-RAP SHALL BE INSTALLED IN A MANNER THAT RESULTS IN A DENSE INTERLOCKED LAYER OF RIP-RAP WITH RIP-RAP VOIDS FILLED COMPLETELY WITH SOIL. SEGREGATION OF MATERIALS SHALL BE AVOIDED AND IN NO CASE SHALL THE COMBINED MATERIAL CONSIST PRIMARILY OF SOIL; THE DENSITY AND INTERLOCKING NATURE OF RIP-RAP IN THE MIXED MATERIAL SHALL ESSENTIALLY BE THE SAME AS IF THE RIP-RAP WAS PLACED WITHOUT SOIL.
 3. WHERE SPECIFIED (TYPICALLY AS "BURIED SOIL RIP-RAP"), A SURFACE LAYER OF TOPSOIL SHALL BE PLACED OVER THE SOIL RIP-RAP ACCORDING TO THE THICKNESS SPECIFIED ON THE CONTRACT DRAWINGS. THE TOPSOIL SURFACE LAYER SHALL BE COMPAKTED TO APPROXIMATELY 85% OF MAXIMUM DENSITY AND WITHIN TWO PERCENTAGE POINTS OF OPTIMUM MOISTURE IN ACCORDANCE WITH ASTM D698. TOPSOIL SHALL BE ADDED TO ANY AREAS THAT SETTLE.
 4. ALL SOIL RIP-RAP THAT IS BURIED WITH TOPSOIL SHALL BE REVIEWED AND APPROVED BY THE ENGINEER PRIOR TO ANY TOPSOIL PLACEMENT.

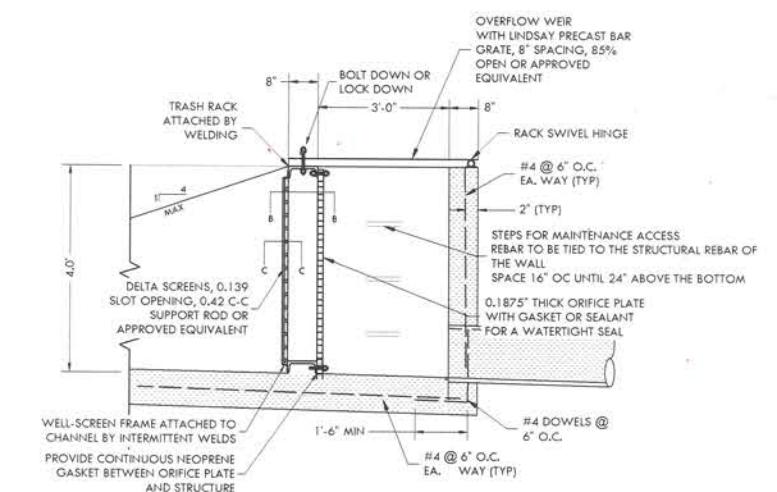

SECTION B-B PLAN VIEW

OUTLET STRUCTURE WITH TRASH RACK DETAIL

© BIELEFELD UNIVERSITÄT

- ORIFICE PLATE NOTES:**

 1. PROVIDE CONTINUOUS NEOPRENE GASKET MATERIAL BETWEEN THE ORIFICE PLATE AND CONCRETE.
 2. BOLT PLATE TO CONCRETE 12" MAX. ON CENTER.

FLIRY AND WOODY TRASH BAGS.

- EUKY AND WVQCY TRASH RACKS:**

 1. WELL-SCREEN TRASH RACKS SHALL BE STAINLESS STEEL AND SHALL BE ATTACHED BY INTERMITTENT WELDS ALONG THE EDGE OF THE MOUNTING FRAME.
 2. BAR GRATE TRASH RACKS SHALL BE ALUMINUM AND SHALL BE BOLTED USING STAINLESS STEEL HARDWARE.

NO.	REVISIONS
1	SUBMITTAL 1
2	04.03.2020 REVISED PER COMMENTS
3	08.01.2020 REVISED PER COMMENTS
4	10.14.2020 REVISED PER COMMENTS
5	11.25.2020 REVISED PER COMMENTS
6	12.15.2020 FOR CONSTRUCTION
7	
8	
9	
10	

DATE:01.22.20
DRAWN BY:JCP
CHECKED BY:LPV
JOB #:49388.01

49

12\Shared\Projects\149000-149399\1493900-1493988\mccure_ranch\OS\engineering\vertex drawings\CD\Filing 1\9d388-CD Filing 1-Pond D Details.dwg Tuesday, December 15, 2020 12:21:55 PM

CONSTRUCTION DOCUMENTS
WINSOME FILING NO 1


A TRACT OF LAND BEING A PORTION OF SECTION 24, TOWNSHIP 11 SOUTH, RANGE 65 WEST,
OF THE 6TH PRINCIPAL MERIDIAN, COUNTY OF EL PASO, STATE OF COLORADO



Now what's below.
Call before you dig.




Main: 303.623.9116 | VERTEXENG.COM

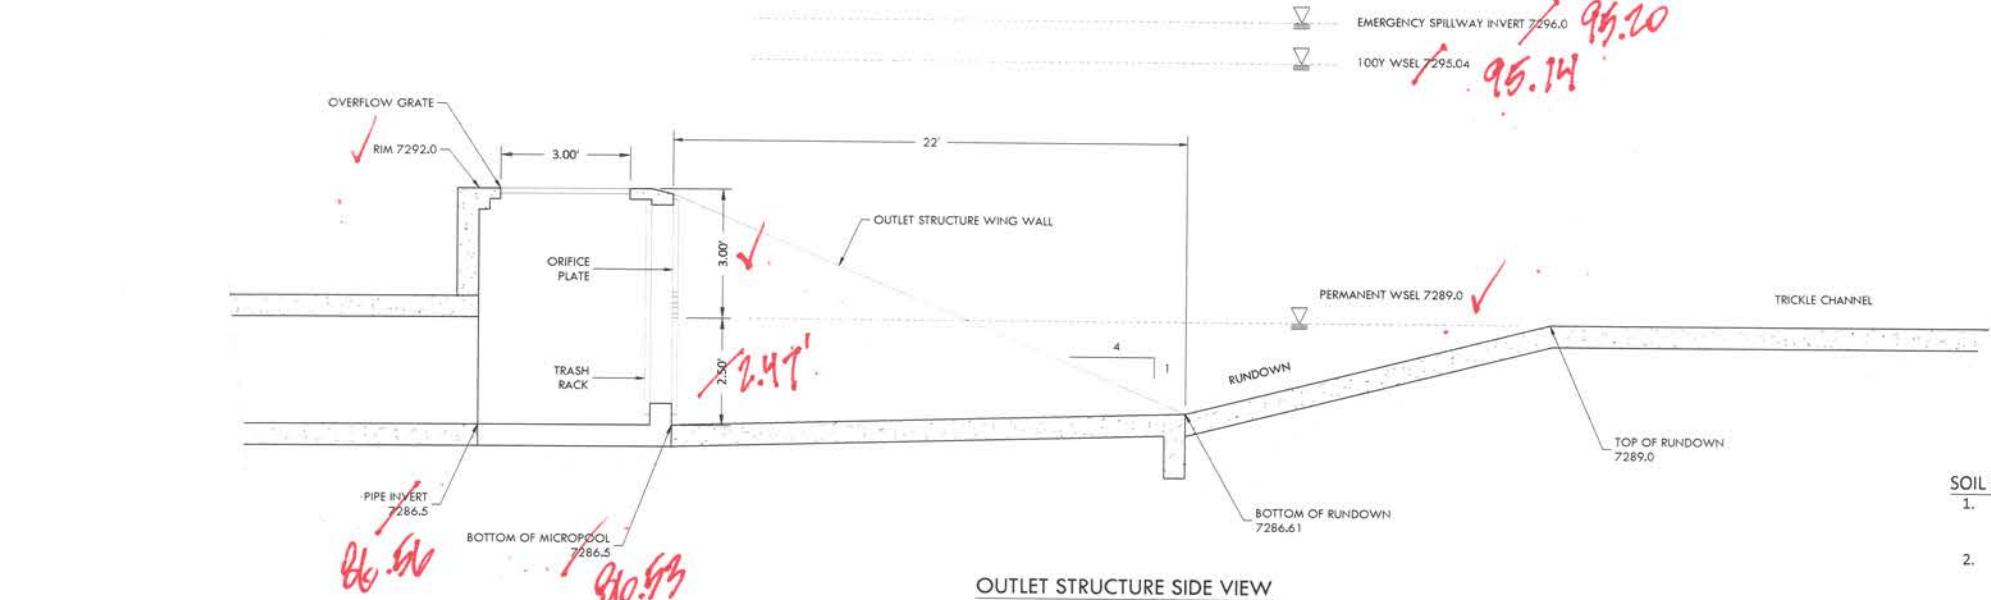


OUTLET STRUCTURE SIDE VIEW

— 1 —

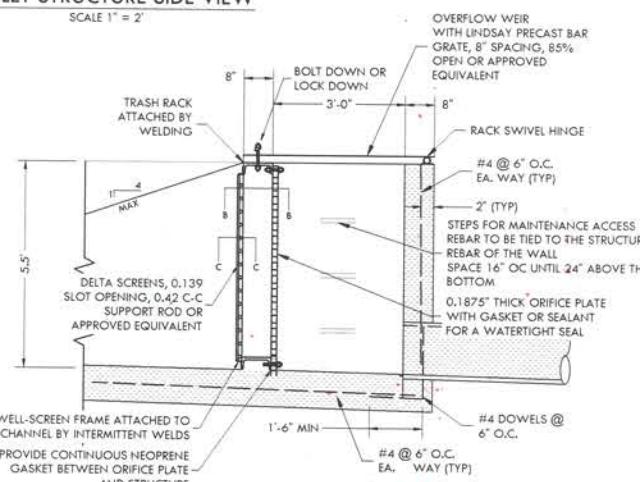


LOW TAILWATER STILLING BASIN WALL SECTION A-A

SCALE 1"

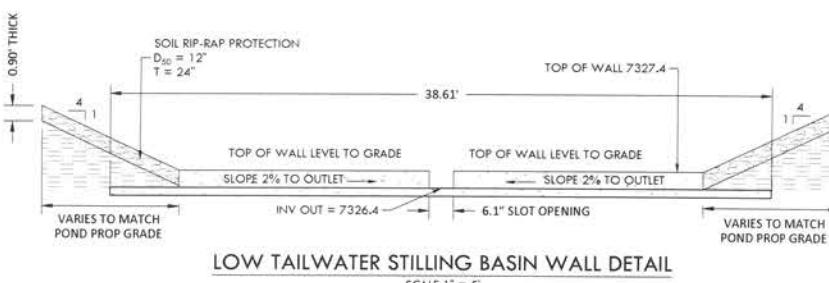

LOW TAILWATER STILLING BASIN WALL DETAIL

Se

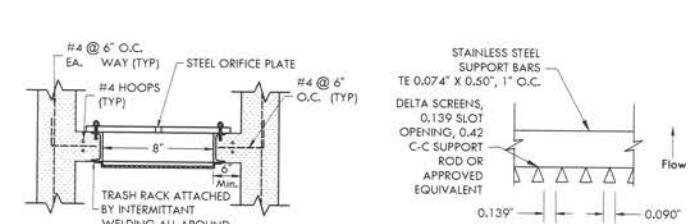

SECTION B-B - PLAN VIEW

SECTION C-C

OUTLET STRUCTURE WITH TRASH RACK DETAIL

ORIFICE PLATE NOTES


- ORIFICE PLATE NOTES:**

 1. PROVIDE CONTINUOUS NEOPRENE GASKET MATERIAL BETWEEN THE ORIFICE PLATE AND CONCRETE.

EDWARD AND MARGARET THAW


- EURV AND WQCV TRASH RACKS:**

 1. WELL-SCREEN TRASH RACKS SHALL BE STAINLESS STEEL AND SHALL BE ATTACHED BY INTERMITTENT WELDS ALONG THE EDGE OF THE MOUNTING FRAME.
 2. BAR GRATE TRASH RACKS SHALL BE ALUMINUM AND SHALL BE BOLTED USING STAINLESS STEEL HARDWARE.

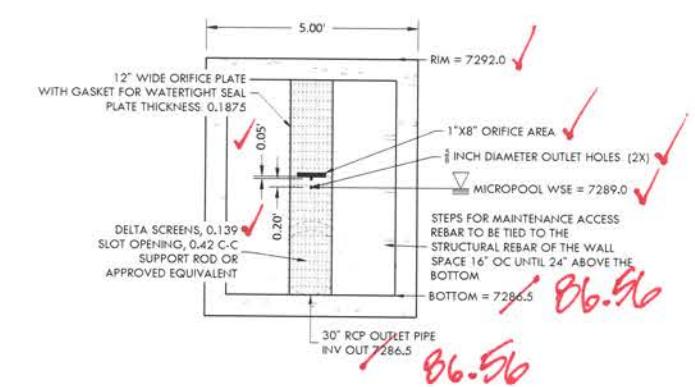

DETENTION POND OUTLET SECTION A-A

SCALE 1"

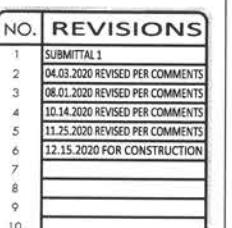

DATE:01.22.20
DRAWN BY:JCP
CHECKED BY:LF
JOB #: 49388.01