



PLOT DATE: 09/30/20 4:14 PM BR: JERMA VALERO PROJ: FILE: P:\Hammers Construction\Woodmen Hills Rec Center East Build\Photometrics\Woodman Hills Rec Center - Photometrics.dwg

Luminaire Schedule						
Symbol	Qty	Label	Lum. Watts	Lum. Lumens	LLF	Catalog
	22	H	22.5	1820	0.900	673-16-L3 840

Calculation Summary						
Label	Units	Avg	Max	Min	Avg/Min	Max/Min
SITE AREA	Fc	0.21	2.1	0.0	N.A.	N.A.
BUILDING PERIMETER	Fc	1.06	2.1	0.2	5.30	10.50

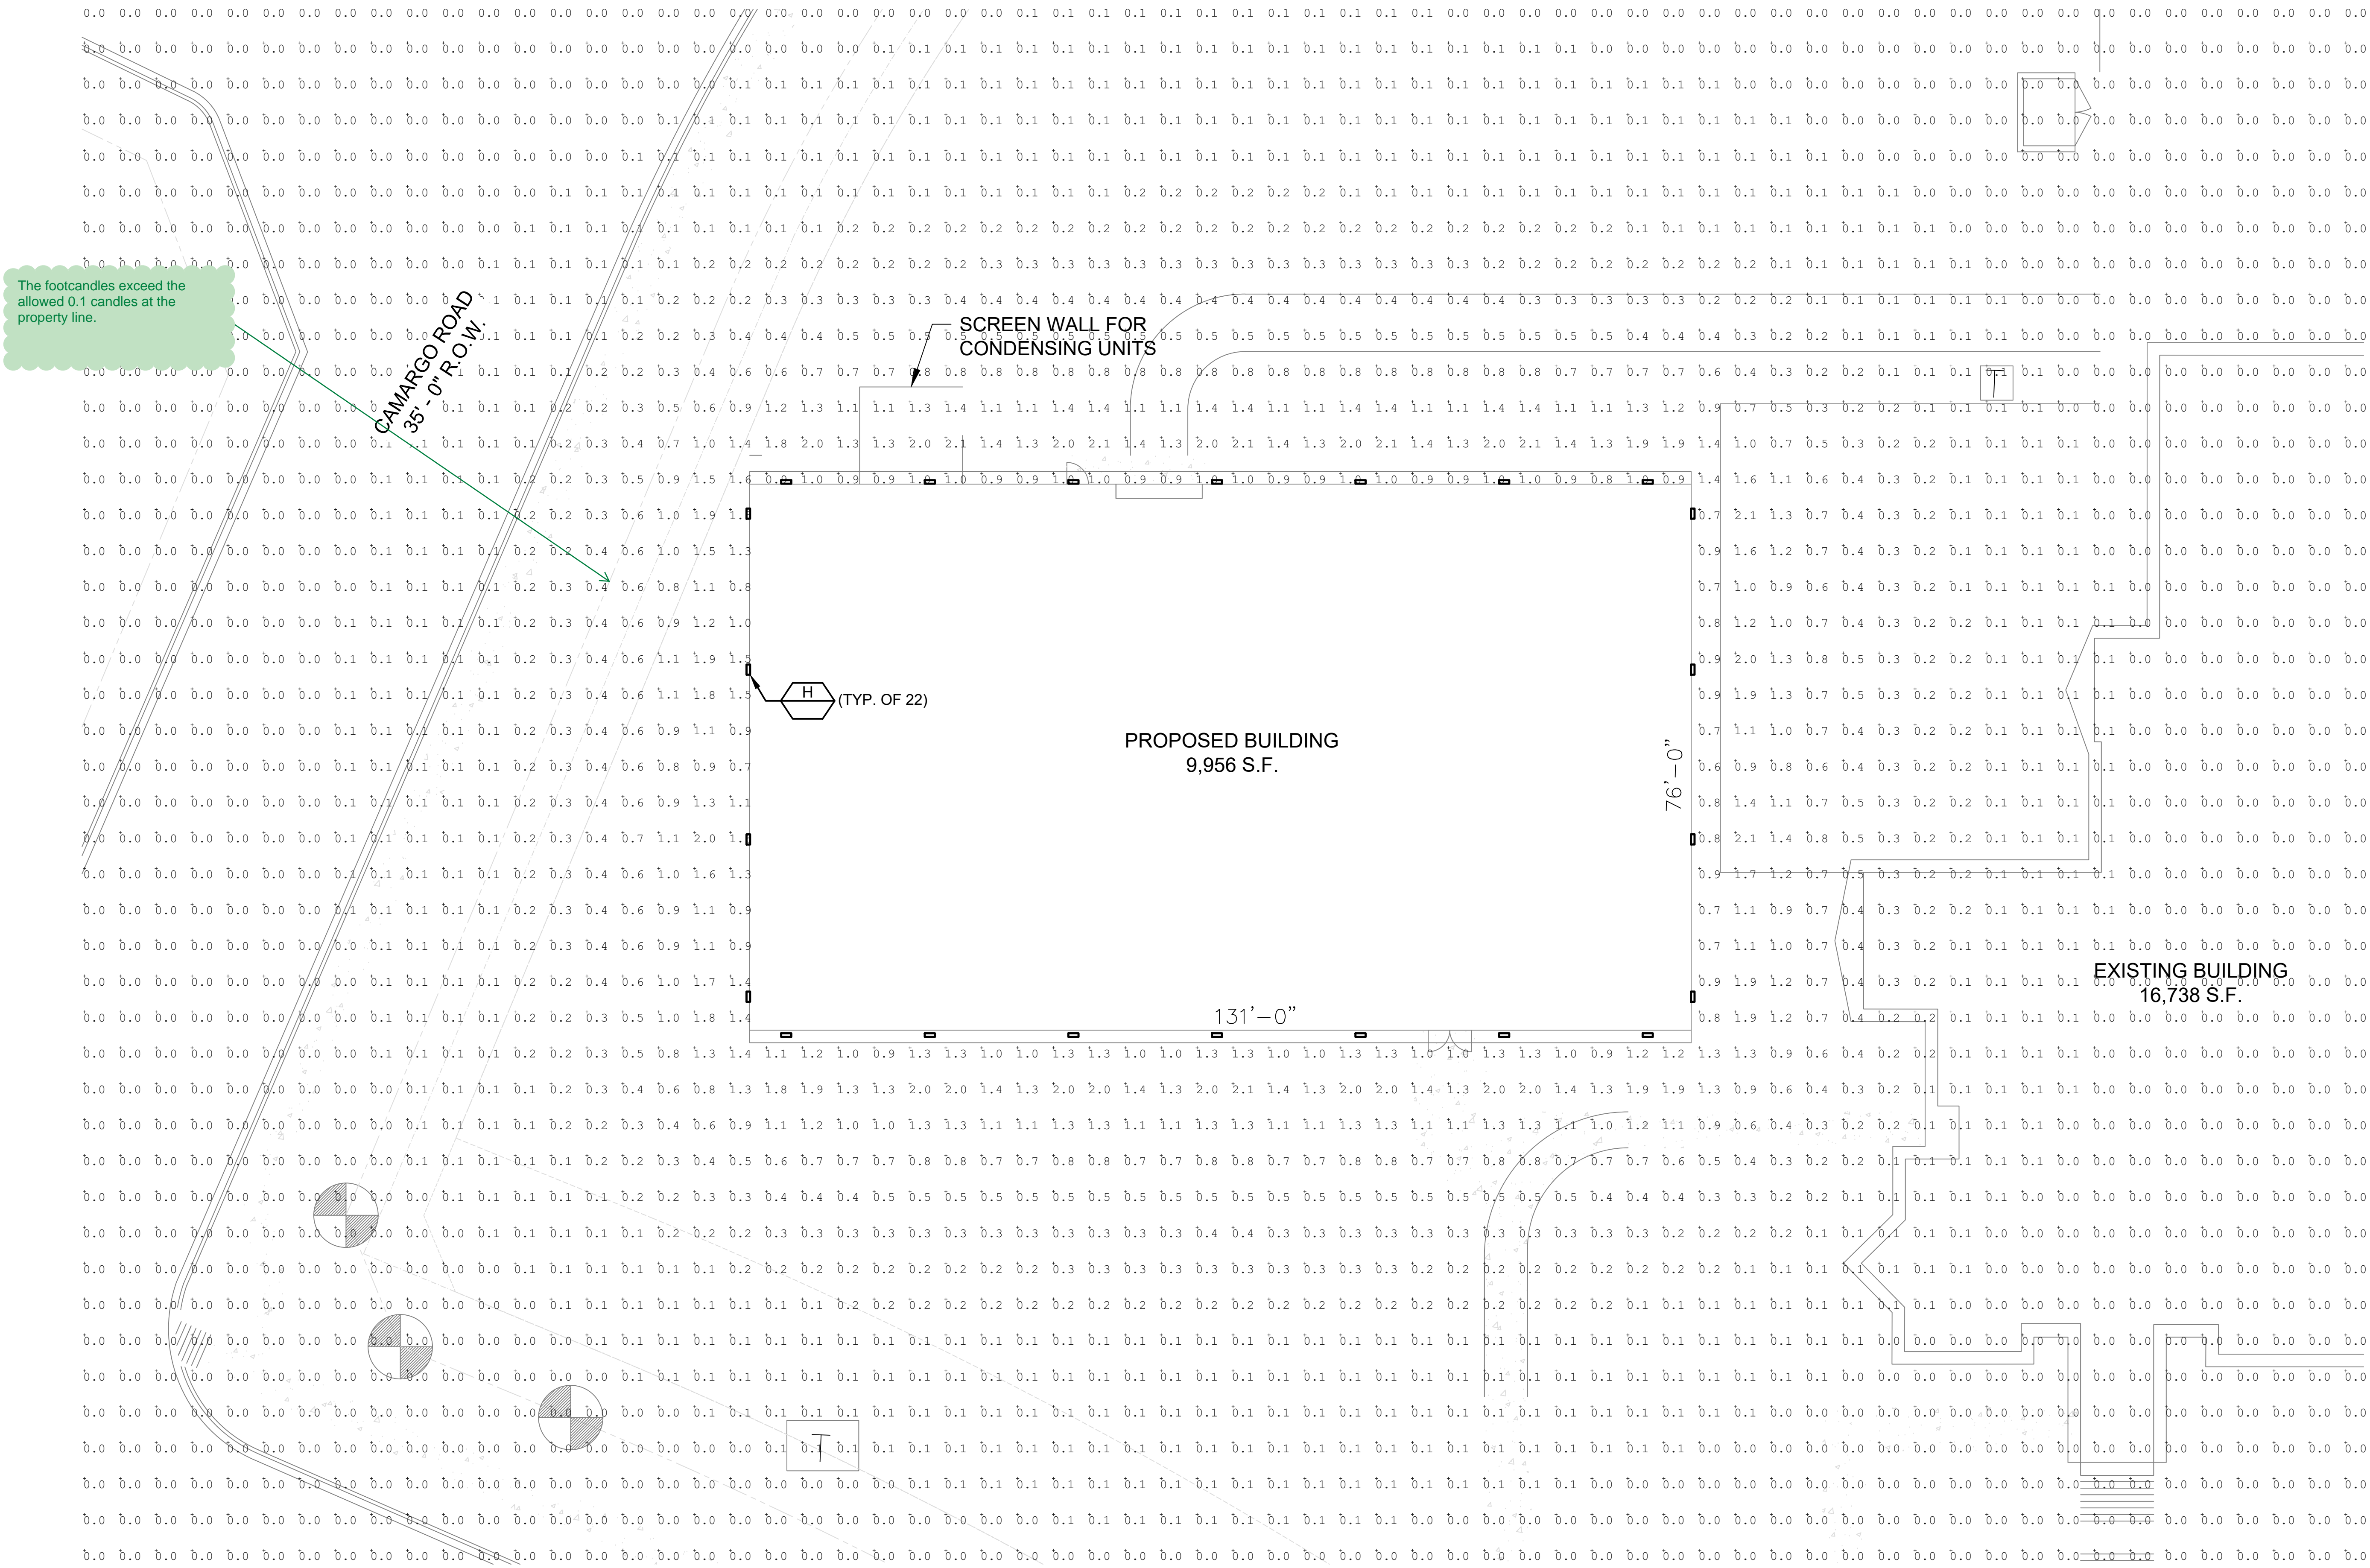

PHOTOMETRICS SITE PLAN
SCALE: NTS

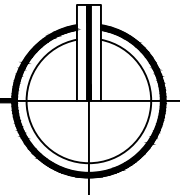


REV	DESCRIPTION	DRAWN	CHECK	APPR	DATE

ISSUANCE:
ISSUED FOR REVIEW
CLIENT:
HAMMERS CONSTRUCTION 1411 WOOLSEY HEIGHTS COLORADO SPRINGS, CO 80915
ARCHITECT:
HAMMERS CONSTRUCTION 1411 WOOLSEY HEIGHTS COLORADO SPRINGS, CO 80915
PROJECT NO:
5151-20-09
TITLE:
PHOTOMETRICS SITE PLAN
SHEET NO:
12 OF 14

Lighting Plan v_1.pdf Markup Summary


Callout (1)

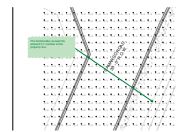


Subject: Callout
Page Label: [1] Woodman Hills Rec Center - Photometrics-12 OF 14
Author: Sophie Kiepe
Date: 11/23/2020 11:28:31 AM
Status:
Layer:
Space:

The footcandles exceed the allowed 0.1 candles at the property line.

(6)

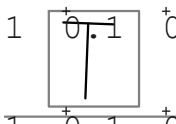

Subject:
Page Label: [1] Woodman Hills Rec Center - Photometrics-12 OF 14
Author: AutoCAD SHX Text
Date:
Status:
Layer:
Space:

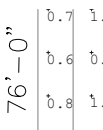


Subject:
Page Label: [1] Woodman Hills Rec Center - Photometrics-12 OF 14
Author: AutoCAD SHX Text
Date:
Status:
Layer:
Space:

76'-0"




Subject:
Page Label: [2] Woodman Hills Rec Center - Photometrics-13 OF 14
Author: AutoCAD SHX Text
Date:
Status:
Layer:
Space:


PLOT DATE: 09/30/20 4:14 PM BY: JERIKA VALERIO PROJ. FILE: P:\Hammers Construction\Woodmen Hills Rec Center East Design Build\Photometrics\Woodman Hills Rec Center - Photometrics.dwg 09/30/20 4:14 PM BY: JERIKA VALERIO PROJ. FILE: P:\Hammers Construction\Woodmen Hills Rec Center East Design Build\Photometrics\Woodman Hills Rec Center - Photometrics.dwg BY: JERIKA VALERIO PROJ. FILE: P:\Hammers Construction\Woodmen Hills Rec Center East Design Build\Photometrics\Woodman Hills Rec Center - Photometrics.dwg JERIKA VALERIO PROJ. FILE: P:\Hammers Construction\Woodmen Hills Rec Center East Design Build\Photometrics\Woodman Hills Rec Center - Photometrics.dwg PROJ. FILE: P:\Hammers Construction\Woodmen Hills Rec Center East Design Build\Photometrics\Woodman Hills Rec Center - Photometrics.dwg

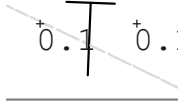

Subject:
Page Label: [1] Woodman Hills Rec Center - Photometrics-12 T
OF 14
Author: AutoCAD SHX Text
Date:
Status:
Layer:
Space:

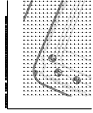

Subject:
Page Label: [1] Woodman Hills Rec Center - Photometrics-12
OF 14
Author: AutoCAD SHX Text
Date:
Status:
Layer:
Space:
PLOT DATE: 09/30/20 4:14 PM BY: JERIKA VALERIO PROJ. FILE: P:\Hammers Construction\Woodmen Hills Rec Center East Design Build\Photometrics\Woodman Hills Rec Center - Photometrics.dwg09/30/20 4:14 PM BY: JERIKA VALERIO PROJ. FILE: P:\Hammers Construction\Woodmen Hills Rec Center East Design Build\Photometrics\Woodman Hills Rec Center - Photometrics.dwg BY: JERIKA VALERIO PROJ. FILE: P:\Hammers Construction\Woodmen Hills Rec Center East Design Build\Photometrics\Woodman Hills Rec Center - Photometrics.dwgJERIKA VALERIO PROJ. FILE: P:\Hammers Construction\Woodmen Hills Rec Center East Design Build\Photometrics\Woodman Hills Rec Center - Photometrics.dwgP:\Hammers Construction\Woodmen Hills Rec Center East Design Build\Photometrics\Woodman Hills Rec Center - Photometrics.dwg

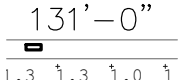

Subject:
Page Label: [1] Woodman Hills Rec Center - Photometrics-12 131'-0"
OF 14
Author: AutoCAD SHX Text
Date:
Status:
Layer:
Space: