


EXHIBIT A

Legal Description:

Lot 10, Block B, Amended Filing of Spring Crest, County of El Paso, State of Colorado.
Together with that portion of vacated Otero Avenue adjoining subject property according to
Resolution recorded February 15, 1972 in Book 2467 at Page 843.

EXHIBIT B

Missing items from checklist:
Existing land uses and zoning on the property and within 500 feet of the boundary.
Adjoining property ownership.
Existing roads, public or private.
Existing structures.
Existing easement.
Name and addresses of the petitioner, owners of all interest, in the property, and preparer.
Existing Topography at 5 feet intervals

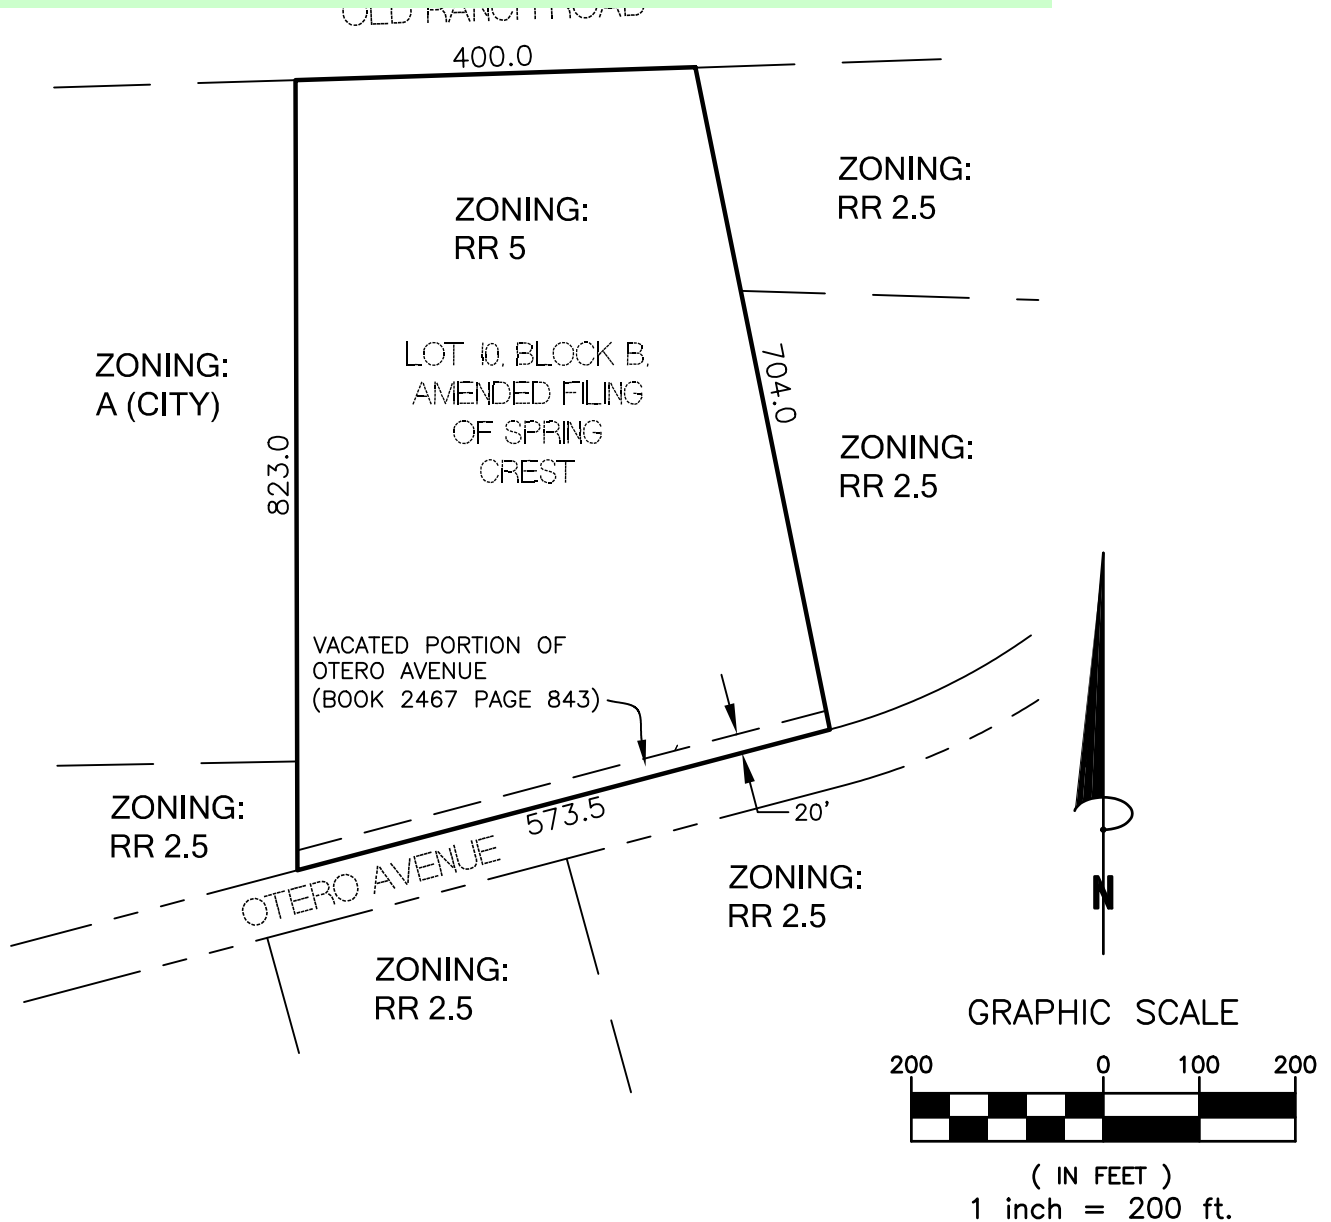


COMPASS SURVEYING & MAPPING, LLC
721 SOUTH 23RD STREET, SUITE B
COLORADO SPRINGS, CO 80904
719-354-4120
WWW.CSAMLLC.COM

NOTE:
This exhibit does not represent a monumented land survey and is only intended to depict the attached legal description.

PROJECT No. 18029
MAY 23, 2018

Markup Summary

Missing items from checklist: Existing land uses and zoning on the property and within 500 feet of the boundary. Adjoining property

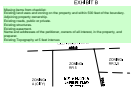

Subject: Text Box
Page Label: 2
Lock: Locked
Author: dsdsevigny
Date: 8/1/2018 1:43:24 PM
Color: ■

Missing items from checklist:
Existing land uses and zoning on the property and within 500 feet of the boundary.
Adjoining property ownership.
Existing roads, public or private.
Existing structures.
Existing easement.
Name and addresses of the petitioner, owners of all interest, in the property, and preparer.
Existing Topography at 5 feet intervals