A VACATION AND REPLAT OF A PORTION OF TRACT B, WOODMOOR PLACER

LOCATED IN THE NE1/4 OF SECTION 23 AND THE NW1/4 OF SECTION 24, TOWNSHIP 11 SOUTH, RANGE 67 WEST OF THE 6TH P.M. COUNTY OF EL PASO, STATE OF COLORADO

KNOW ALL MEN BY THESE PRESENTS:

THAT CND-CLOVERLEAF, LLC, A COLORADO LIMITED LIABILITY COMPANY, BEING THE OWNER OF THE FOLLOWING DESCRIBED TRACTS OF LAND, TO WIT:

LEGAL DESCRIPTION:

THREE PARCELS OF LAND BEING ALL OF THOSE PROPERTIES UNDER RECEPTION NOS. 220071778, 220071836 AND 221062390 IN THE RECORDS OF THE EL PASO COUNTY CLERK AND RECORDER, BEING A PORTION OF TRACT B, WOODMOOR PLACER RECORDED IN BOOK U-2 AT PAGE 66, TOGETHER WITH ALL OF TRACT H, WOODMOOR GREENS RECORDED IN BOOK U-2 AT PAGE 51, LOCATED IN THE NORTHEAST QUARTER OF SECTION 23 AND THE NORTHWEST QUARTER OF SECTION 24, TOWNSHIP 11 SOUTH, RANGE 67 WEST OF THE 6TH PRINCIPAL MERIDIAN. COUNTY OF EL PASO. STATE OF COLORADO. BEING MORE PARTICULARLY DESCRIBED AS FOLLOWS:

BASIS OF BEARINGS: THE LINE BETWEEN THE 30.00' WITNESS CORNER TO THE CENTER QUARTER CORNER OF SECTION 23, TOWNSHIP 11 SOUTH, RANGE 67 WEST OF THE 6TH PRINCIPAL MERIDIAN MONUMENTED BY A 3-1/4" ALUMINUM CAP STAMPED "PLS 10377 1997 30.00 WC" AND THE 30.0' REFERENCE MONUMENT TO THE EAST QUARTER CORNER OF SAID SECTION 23, MONUMENTED BY A 1-1/2" ALUMINUM CAP STAMPED "LS 2692", SAID LINE BEARING S89'54'49"E AS REFERENCED TO COLORADO STATE PLANE CENTRAL ZONE.

COMMENCING AT THE 30' REFERENCE MONUMENT TO THE EAST QUARTER CORNER OF SECTION 23, TOWNSHIP 11 SOUTH, RANGE 67 WEST OF THE 6TH PRINCIPAL MERIDIAN;

THENCE N23°36'18"W A DISTANCE OF 971.92 FEET, TO A POINT ON THE SOUTHWESTERLY LINE OF TRACT B, WOODMOOR PLACER RECORDED IN BOOK U-2 AT PAGE 66 IN THE RECORDS OF THE EL PASO COUNTY CLERK AND RECORDER, SAID POINT BEING THE POINT OF BEGINNING;

THENCE ON SAID SOUTHWESTERLY LINE, N47°53'03"W A DISTANCE OF 244.83 FEET, TO THE SOUTHWESTERLY CORNER OF TRACT H, WOODMOOR GREENS RECORDED IN BOOK U-2 AT PAGE 51;

THENCE ON THE PERIMETER OF SAID TRACT H, THE FOLLOWING THREE (3) COURSES:

- 1. N33°23'09"W A DISTANCE OF 130.11 FEET, TO A POINT OF NON-TANGENT CURVE, ON THE SOUTHERLY RIGHT-OF-WAY LINE OF LEGGINS
- 2. ON SAID SOUTHERLY RIGHT-OF-WAY LINE, ON THE ARC OF A CURVE TO THE RIGHT WHOSE CENTER BEARS S33°24'06"E, HAVING A RADIUS OF 300.00 FEET, A CENTRAL ANGLE OF 15°37'05" AND AN ARC LENGTH OF 81.78 FEET, TO A POINT OF NON-TANGENT;
- 3. S52°28'59"E A DISTANCE OF 196.68 FEET, TO A POINT ON THE WESTERLY LINE OF SAID TRACT B, WOODMOOR PLACER;
- THENCE ON SAID WESTERLY LINE, THE FOLLOWING FIVE (5) COURSES:
- 1. N81°20'01"E A DISTANCE OF 130.03 FEET;
- 2. N26°20'33"E A DISTANCE OF 511.07 FEET;
- 3. N52°03'56"E A DISTANCE OF 451.83 FEET;
- 4. N17°03'30"W A DISTANCE OF 222.24 FEET;
- 5. N07°26'50"W A DISTANCE OF 104.67 FEET;
- THENCE DEPARTING THE WESTERLY LINE OF SAID TRACT B, THE FOLLOWING TEN (10) COURSES:
- 1. N84°15'58"E A DISTANCE OF 126.43 FEET;
- 2. N84°03'34"E A DISTANCE OF 224.55 FEET;
- 3. S05°52'43"E A DISTANCE OF 936.00 FEET;
- 4. S52°15'31"E A DISTANCE OF 279.39 FEET, TO A POINT OF CURVE;
- 5. ON THE ARC OF A CURVE TO THE RIGHT, HAVING A RADIUS OF 570.00 FEET, A CENTRAL ANGLE OF 01°22'45" AND AN ARC LENGTH OF 13.72 FEET, TO A POINT OF NON—TANGENT;
- 6. N28°37'11"E A DISTANCE OF 67.40 FEET, TO A POINT ON CURVE;
- 7. ON THE ARC OF A CURVE TO THE RIGHT, HAVING A RADIUS OF 345.00 FEET, A CENTRAL ANGLE OF 26°50'54" AND AN ARC LENGTH OF 161.66 FEET, TO A POINT OF NON—TANGENT;
- 8. S34°31'56"E A DISTANCE OF 97.38 FEET, TO A POINT OF NON-TANGENT CURVE;
- 9. ON THE ARC OF A CURVE TO THE RIGHT WHOSE CENTER BEARS \$45°14'01"E, HAVING A RADIUS OF 230.00 FEET, A CENTRAL ANGLE
- OF 22°29'51" AND AN ARC LENGTH OF 90.31 FEET, TO A POINT OF TANGENT;
- 10. N67°15'50"E A DISTANCE OF 11.14 FEET, TO THE SOUTHEASTERLY CORNER OF LOT 466, WOODMOOR GREENS, ALSO BEING A POINT ON THE WESTERLY RIGHT—OF—WAY LINE OF CLOVERLEAF ROAD, SAID POINT BEING A POINT OF NON—TANGENT CURVE;


THENCE ON SAID WESTERLY RIGHT-OF-WAY LINE, THE FOLLOWING FIVE (5) COURSES:

- 1. ON THE ARC OF A CURVE TO THE LEFT WHOSE CENTER BEARS N85°06'36"E, HAVING A RADIUS OF 410.00 FEET, A CENTRAL ANGLE OF 46°01'11" AND AN ARC LENGTH OF 329.31 FEET, TO A POINT OF NON-TANGENT;
- 2. S50°58'07"E A DISTANCE OF 104.84 FEET, TO A POINT OF NON-TANGENT CURVE;
- 3. ON THE ARC OF A CURVE TO THE RIGHT WHOSE CENTER BEARS \$39°04'09"W, HAVING A RADIUS OF 269.73 FEET, A CENTRAL ANGLE OF 95"15'09" AND AN ARC LENGTH OF 448.43 FEET, TO A POINT OF NON-TANGENT;
- 4. S44°20'00"W A DISTANCE OF 278.41 FEET, TO A POINT OF NON-TANGENT CURVE;
- 5. ON THE ARC OF A CURVE TO THE LEFT WHOSE CENTER BEARS S45°13'59"E, HAVING A RADIUS OF 310.00 FEET, A CENTRAL ANGLE OF 15°03'35" AND AN ARC LENGTH OF 81.48 FEET, TO A POINT OF NON—TANGENT, SAID POINT BEING ON THE SOUTHERLY LINE OF SAID TRACT B, WOODMOOR PLACER;

THENCE ON SAID SOUTHERLY LINE, THE FOLLOWING THREE (3) COURSES:

- 1. N61°02'18"W A DISTANCE OF 958.19 FEET;
- 2. N60°38'25"W A DISTANCE OF 314.83 FEET;
- 3. N83°12'34"W A DISTANCE OF 466.58 FEET, TO THE POINT OF BEGINNING;

CONTAINING A CALCULATED AREA OF 1,623,721 SQUARE FEET OR 37.2755 ACRES.

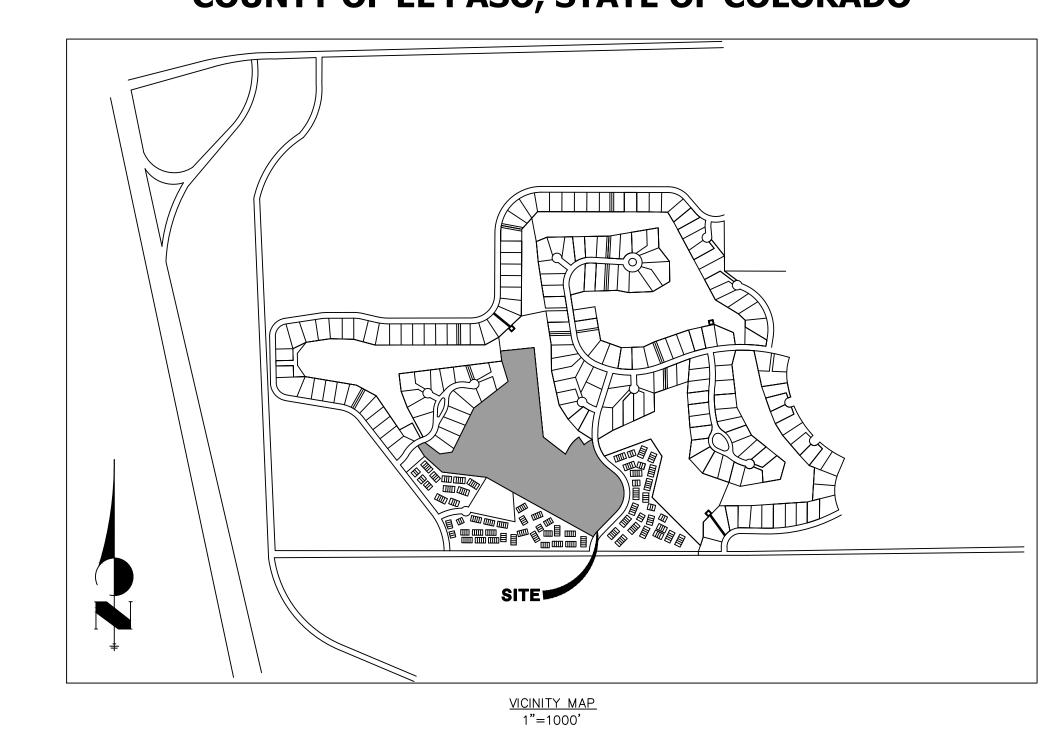

OWNERS CERTIFICATE:

THE UNDERSIGNED, BEING ALL THE OWNERS, MORTGAGEES, BENEFICIARIES OF DEEDS OF TRUST AND HOLDERS OF OTHER INTERESTS IN THE LAND DESCRIBED HEREIN, HAVE LAID OUT, SUBDIVIDED, AND PLATTED SAID LANDS INTO LOTS AND EASEMENTS AS SHOWN HEREON UNDER THE NAME AND SUBDIVISION OF CLOVERLEAF FILING NO. 2. THE UTILITY EASEMENTS SHOWN HEREON ARE HEREBY DEDICATED FOR PUBLIC UTILITIES AND COMMUNICATION SYSTEMS AND OTHER PURPOSES AS SHOWN HEREON. THE ENTITIES RESPONSIBLE FOR PROVIDING THE SERVICES FOR WHICH THE EASEMENTS ARE ESTABLISHED ARE HEREBY GRANTED THE PERPETUAL RIGHT OF INGRESS AND EGRESS FROM AND TO ADJACENT PROPERTIES FOR INSTALLATION, MAINTENANCE, AND REPLACEMENT OF UTILITY LINES AND RELATED FACILITIES.

CND-CLOVERLEAF, LLC, A COLORADO LIMITED LIABILITY COMPANY
BY:AS MANAGER
STATE OF COLORADO))SS.
COUNTY OF)
ACKNOWLEDGED BEFORE ME THIS DAY OF, 20 BY
AS
MY COMMISSION EXPIRES
WITNESS MY HAND AND OFFICIAL SEAL

ACCEPTANCE CERTIFICATE FOR TRACTS:

BY:			
AS:	- _ of cloverleaf metropolitan	DISTRICT	
STATE OF COLORADO)) SS			
COUNTY OF EL PASO)			
ACKNOWLEDGED BEFORE ME THIS	_ DAY OF,	202,	A
BY:	_		
AS:	_ OF CLOVERLEAF METROPOLITAN	DISTRICT	
WITNESS MY HAND AND OFFICIAL SEAL:			
MY COMMISSION EXPIRES:			
NOTARY PUBLIC:			

LAND SUMMARY CHART

TRACT	AREA (SF)	AREA (AC)	USE	OWNERSHIP/MAINTENANCE
Α	127,275	2.9218	DRAINAGE, PUBLIC UTILITIES	CLOVERLEAF METROPOLITAN DISTRICT
В	7,423	0.1704	DRAINAGE, PUBLIC UTILITIES, PEDESTRIAN ACCESS	CLOVERLEAF METROPOLITAN DISTRICT
С	5,143	0.1181	DRAINAGE, PUBLIC UTILITIES	CLOVERLEAF METROPOLITAN DISTRICT
D	2,411	0.0553	DRAINAGE, PUBLIC UTILITIES	CLOVERLEAF METROPOLITAN DISTRICT
E	9,211	0.2115	DRAINAGE, PUBLIC UTILITIES, OPEN SPACE	CLOVERLEAF METROPOLITAN DISTRICT
F	2,660	0.0611	DRAINAGE, PUBLIC UTILITIES, MAINTENANCE ACCESS	CLOVERLEAF METROPOLITAN DISTRICT
G	24,622	0.5652	PUBLIC UTILITIES, OPEN SPACE	CLOVERLEAF METROPOLITAN DISTRICT
Н	37,776	0.8672	DRAINAGE, PUBLIC UTILITIES, OPEN SPACE	CLOVERLEAF METROPOLITAN DISTRICT
I	33,484	0.7687	DRAINAGE, PUBLIC UTILITIES, MAINTENANCE ACCESS	CLOVERLEAF METROPOLITAN DISTRICT
J	35,195	0.8080	PRIVATE ROAD, PUBLIC UTILITIES, DRAINAGE	CLOVERLEAF METROPOLITAN DISTRICT
K	9,175	0.2106	OPEN SPACE, DRAINAGE, PUBLIC UTILITIES	CLOVERLEAF METROPOLITAN DISTRICT
L	12,571	0.2886	DRAINAGE, PUBLIC UTILITIES, MAINTENANCE ACCESS	CLOVERLEAF METROPOLITAN DISTRICT
TOTAL TRACT AREA	306,946	7.0465		
TOTAL LOT AREA	1,048,407	24.0681		
TOTAL ROW AREA	268,368	6.1609		

SURVEYORS CERTIFICATE:

1,623,721 37.2755

I, JARROD ADAMS, A DULY REGISTERED PROFESSIONAL LAND SURVEYOR IN THE STATE OF COLORADO, DO HEREBY CERTIFY THAT THIS PLAT TRULY AND CORRECTLY REPRESENTS THE RESULTS OF A SURVEY MADE ON AUGUST 24, 2020, BY ME OR UNDER MY DIRECT SUPERVISION AND THAT ALL MONUMENTS EXIST AS SHOWN HEREON; THAT MATHEMATICAL CLOSURE ERRORS ARE LESS THAN 1:10,000; AND THAT SAID PLAT HAS BEEN PREPARED IN FULL COMPLIANCE WITH ALL APPLICABLE LAWS OF THE STATE OF COLORADO DEALING WITH MONUMENTS, SUBDIVISION, OR SURVEYING OF LAND AND ALL APPLICABLE PROVISIONS OF THE EL PASO COUNTY LAND DEVELOPMENT CODE.

I ATTEST THE ABOVE ON THIS	_ DAY OF	, 20
JARROD ADAMS COLORADO REGISTERED PLS # 38252	DATE	

NOTICE:

PER C.R.S. 13-80-105, YOU MUST COMMENCE ANY LEGAL ACTION BASED UPON ANY DEFECT IN THIS SURVEY WITHIN THREE YEARS AFTER YOU FIRST DISCOVER SUCH DEFECT. IN NO EVENT MAY ANY ACTION BASED UPON ANY DEFECT IN THIS SURVEY BE COMMENCED MORE THAN TEN YEARS FROM THE DATE OF THE CERTIFICATION SHOWN HEREON. JR ENGINEERING, LLC AND/OR THE SURVEYOR OF RECORD SHALL NOT BE LIABLE FOR MORE THAN THE COST OF THIS SURVEY AND THEN ONLY TO THE CLIENT SPECIFICALLY SHOWN HEREON OR IN OUR FILE BY SIGNED AUTHORIZATION. ACCEPTANCE AND/OR USE OF THIS INSTRUMENT FOR ANY PURPOSE CONSTITUTES AGREEMENT BY THE CLIENT TO ALL TERMS STATED HEREON.

THIS PLAT FOR CLOVERLEAF FILING NO. 2 WAS APPROVED FOR FILING BY THE EL PASO COUNTY, COLORADO BOARD OF COUNTY COMMISSIONERS ON THE ______ OF ______, 20_____, SUBJECT TO ANY NOTES SPECIFIED HEREON AND ANY CONDITIONS INCLUDED IN THE RESOLUTION OF APPROVAL. THE DEDICATIONS OF LAND TO THE PUBLIC STREETS AND EASEMENTS ARE ACCEPTED, BUT THE PUBLIC IMPROVEMENTS THEREON WILL NOT BECOME THE MAINTENANCE RESPONSIBILITY OF EL PASO COUNTY UNTIL PRELIMINARY ACCEPTANCE OF THE PUBLIC IMPROVEMENTS IN ACCORDANCE WITH THE REQUIREMENTS OF THE LAND DEVELOPMENT CODE AND ENGINEERING CRITERIA MANUAL, AND THE SUBDIVISION IMPROVEMENTS AGREEMENT.

WOODMOOR PLACER IN ENTIRETY IS VACATED AND AMENDED FOR THE AREAS DESCRIBED BY THIS REPLAT SUBJECT TO ALL COVENANTS, CONDITIONS, AND RESTRICTIONS RECORDED AGAINST AND APPURTENANT TO THE ORIGINAL PLAT RECORDED IN THE OFFICE OF THE EL PASO COUNTY CLERK AND RECORDER, RECEPTION # 869701.

PRESIDENT, BOARD OF COUNTY COMMI	ISSIONERS	DATE		
THIS PLAT FOR CLOVERLEAF FILING NO DEVELOPMENT DEPARTMENT DIRECTOR SPECIFIED HEREON.			· · · · · · · · · · · · · · · · · · ·	

PCD FILE NO. SF2123 JOB NO. 25158.01 OCTOBER 29, 2021 SHEET 1 OF 9

SUMMARY: 131 LOTS 24.0681 ACRES 64.57% SCHOOL FEE: _____ 12 TRACTS 7.0465 ACRES 18.90% BRIDGE FEE: _____ RIGHTS-OF-WAY 6.1609 ACRES 16.53<u>%</u> PARK FEE: _____ DRAINAGE FEE: TOTAL 37.2755 ACRES 100.00%

PLANNING AND COMMUNITY DEVELOPMENT DIRECTOR



Centennial 303-740-9393 • Colorado Springs 719-593-2593 Fort Collins 970-491-9888 • www.jrengineering.com

A VACATION AND REPLAT OF A PORTION OF TRACT B, WOODMOOR PLACER

LOCATED IN THE NE1/4 OF SECTION 23 AND THE NW1/4 OF SECTION 24, TOWNSHIP 11 SOUTH, RANGE 67 WEST OF THE 6TH P.M. COUNTY OF EL PASO, STATE OF COLORADO

GENERAL NOTES:

- 1. DEFINITION: CERTIFY, CERTIFICATION A PROFESSIONAL'S OPINION BASED ON HIS OR HER OBSERVATION OF CONDITIONS, KNOWLEDGE, INFORMATION AND BELIEFS. IT IS EXPRESSLY UNDERSTOOD THAT THE PROFESSIONAL'S CERTIFICATION OF A CONDITION'S EXISTENCE RELIEVES NO OTHER PARTY OF ANY RESPONSIBILITY OR OBLIGATION HE OR SHE HAS ACCEPTED BY CONTRACT OR CUSTOM.
- 2. PER C.R.S. 18-04-508, ANY PERSON WHO KNOWINGLY REMOVES, ALTERS OR DEFACES ANY PUBLIC LAND SURVEY MONUMENT OR LAND MONUMENT OR ACCESSORY, COMMITS A CLASS TWO (2) MISDEMEANOR.
- 3. ALL REFERENCES HEREON TO BOOKS, PAGES, MAPS AND RECEPTION NUMBERS ARE PUBLIC DOCUMENTS FILED IN THE RECORDS OF EL PASO COUNTY, COLORADO.
- 4. EASEMENTS AND PUBLIC DOCUMENTS SHOWN OR NOTED HEREON WERE EXAMINED AS TO LOCATION AND PURPOSE AND WERE NOT EXAMINED AS TO RESERVATIONS, RESTRICTIONS, CONDITIONS, OBLIGATIONS, TERMS, OR AS TO THE RIGHT TO GRANT THE SAME.
- 5. THE BASIS OF BEARINGS IS THE LINE BETWEEN THE 30.00' WITNESS CORNER TO THE CENTER QUARTER CORNER OF SECTION 23, TOWNSHIP 11 SOUTH, RANGE 67 WEST OF THE 6TH PRINCIPAL MERIDIAN MONUMENTD BY A 3-1/4" ALUMINUM CAP STAMPED "RLS 10377 1997 30.00 WC" AND THE 30.0' REFERENCE MONUMENT TO THE EAST QUARTER CORNER OF SAID SECTION 23, MONUMENTED BY A 1-1/2" ALUMINUM CAP STAMPED "LS 2692", SAID LINE BEARING S89'54'49"E AS REFERENCED TO COLORADO STATE PLANE CENTRAL 70NF
- 6. THE LAST FIELD INSPECTION OF THIS SITE WAS ON JUNE 25, 2021.
- 7. PER C.R.S. 38-51-106, "ALL LINEAL UNITS DEPICTED ON THIS LAND SURVEY PLAT ARE U.S. SURVEY FEET. ONE METER EQUALS 39.37/12 U.S. SURVEY FEET, EXACTLY ACCORDING TO THE NATIONAL INSTITUTE OF STANDARDS AND TECHNOLOGY."
- 8. THIS SITE IS NOT WITHIN A DESIGNATED F.E.M.A. FLOODPLAIN (ZONE X-AREAS DETERMINED TO BE OUTSIDE 0.2% ANNUAL CHANCE FLOODPLAIN), AS DETERMINED BY THE FLOOD INSURANCE RATE MAP FOR EL PASO, COLORADO, MAP NUMBERS 08041C0278G, EFFECTIVE DATE DECEMBER 7, 2018.
- 9. ALL PROPERTY OWNERS ARE RESPONSIBLE FOR MAINTAINING PROPER STORM WATER DRAINAGE IN AND THROUGH THEIR PROPERTY. PUBLIC DRAINAGE EASEMENTS AS SPECIFICALLY NOTED ON THE PLAT SHALL BE MAINTAINED BY THE INDIVIDUAL LOT OWNERS UNLESS OTHERWISE INDICATED. HOMEBUILDERS ARE RESPONSIBLE TO ENSURE PROPER DRAINAGE AROUND STRUCTURES, INCLUDING ELEVATIONS OF FOUNDATIONS AND WINDOW WELLS IN RELATION TO SIDE—LOT DRAINAGE EASEMENTS AND SWALES. HOMEOWNERS SHALL NOT CHANGE THE GRADE OF THE LOT OR DRAINAGE SWALES WITHIN SAID EASEMENTS, AS CONSTRUCTED BY THE BUILDER, IN A MANNER THAT WOULD CAUSE ADVERSE DRAINAGE IMPACTS TO PROPERTIES. STRUCTURES, FENCES, MATERIALS OR LANDSCAPING THAT COULD IMPEDE THE FLOW OF RUNOFF SHALL NOT BE PLACED IN DRAINAGE EASEMENTS.
- 10. TRACTS A, E, H, I, AND L OF THIS PROPERTY ARE SUBJECT TO THE PRIVATE DETENTION/BMP MAINTENANCE AGREEMENT AND EASEMENT RECORDED UNDER RECEPTION NO. _______ IN THE RECORDS OF THE EL PASO COUNTY CLERK AND RECORDER. THE CLOVERLEAF METROPOLITAN DISTRICT IS RESPONSIBLE FOR MAINTENANCE OF THE SUBJECT DRAINAGE FACILITIES.
- 11. WATER AND SANITARY SERVICES SHALL BE SUPPLIED BY WOODMOOR WATER AND SANITATION DISTRICT NO. 1.
- 12. NO DRIVEWAY SHALL BE ESTABLISHED UNLESS AN ACCESS PERMIT HAS BEEN GRANTED BY EL PASO COUNTY.
- 13. THE ADDRESSES EXHIBITED ON THIS PLAT ARE FOR INFORMATIONAL PURPOSES ONLY. THEY ARE NOT THE LEGAL DESCRIPTION AND ARE SUBJECT TO CHANGE.
- 14. THE SUBDIVIDER AGREES ON BEHALF OF HIM/HERSELF AND ANY DEVELOPER OR BUILDER SUCCESSORS AND ASSIGNEES THAT SUBDIVIDER AND/OR SAID SUCCESSORS AND ASSIGNS SHALL BE REQUIRED TO PAY TRAFFIC IMPACT FEES IN ACCORDANCE WITH THE EL PASO COUNTY ROAD IMPACT FEE PROGRAM RESOLUTION (RESOLUTION NO. 19-471), OR ANY AMENDMENTS THERETO, AT OR PRIOR TO THE TIME OF BUILDING PERMIT SUBMITTALS.
- 15. THIS FINAL PLAT IS PART OF THE APPROVED CLOVERLEAF SUBDIVISION PRELIMINARY PLAN, SP20-002.
- 16. LAND WITHIN THIS FINAL PLAT IS ZONED RS-5000.
- 17. THE FOLLOWING REPORTS HAVE BEEN SUBMITTED IN ASSOCIATION WITH THE PRELIMINARY PLAN OR FINAL PLAT FOR THIS SUBDIVISION AND ARE ON FILE AT THE EL PASO COUNTY COMMUNITY PLANNING AND COMMUNITY DEVELOPMENT DEPARTMENT; TRAFFIC IMPACT STUDY, DRAINAGE REPORT, WATER RESOURCES REPORT, WASTEWATER DISPOSAL REPORT, SOIL, GEOLOGY AND GEOLOGIC HAZARD STUDY, FIRE PROTECTION REPORT, WILDFIRE HAZARD REPORT, NATURAL FEATURES REPORT, WETLAND ANALYSIS REPORT, NOXIOUS WEED MANAGEMENT PLAN AND PDB/BMP OPERATIONS AND MAINTENANCE MANUAL.
- 18. NO LOT OR INTEREST THEREIN, SHALL BE SOLD, CONVEYED, OR TRANSFERRED WHETHER BY DEED OR BY CONTRACT, NOR SHALL BUILDING PERMITS BE ISSUED, UNTIL AND UNLESS EITHER THE REQUIRED PUBLIC AND COMMON DEVELOPMENT IMPROVEMENTS HAVE BEEN CONSTRUCTED AND COMPLETED AND PRELIMINARILY ACCEPTED IN ACCORDANCE WITH THE SUBDIVISION IMPROVEMENTS AGREEMENT BETWEEN THE APPLICANT/OWNER AND EL PASO COUNTY AS RECORDED UNDER RECEPTION NUMBER _______ IN THE OFFICE OF THE CLERK AND RECORDER OF EL PASO COUNTY, COLORADO OR, IN THE ALTERNATIVE, OTHER COLLATERAL IS PROVIDED TO MAKE PROVISION FOR THE COMPLETION OF SAID IMPROVEMENTS IN ACCORDANCE WITH THE EL PASO COUNTY LAND DEVELOPMENT CODE AND ENGINEERING CRITERIA MANUAL. ANY SUCH ALTERNATIVE COLLATERAL MUST BE APPROVED BY THE BOARD OF COUNTY COMMISSIONERS OR, IF PERMITTED BY THE SUBDIVISION IMPROVEMENTS AGREEMENT, BY THE DEVELOPMENT SERVICES DEPARTMENT DIRECTOR AND MEET THE POLICY AND PROCEDURE REQUIREMENTS OF EL PASO COUNTY PRIOR TO THE RELEASE BY THE COUNTY OF ANY LOT FOR SALE, CONVEYANCE OR TRANSFER.
- 9. THERE SHALL BE NO DIRECT LOT ACCESS TO CLOVERLEAF ROAD.
- 20. THE PRIVATE ROADS AS SHOWN ON THIS PLAT WILL NOT BE MAINTAINED BY EL PASO COUNTY UNTIL AND UNLESS THE STREETS ARE CONSTRUCTED IN CONFORMANCE WITH EL PASO COUNTY STANDARDS IN EFFECT AT THE DATE OF REQUEST FOR DEDICATION AND MAINTENANCE.
- DEVELOPER SHALL COMPLY WITH FEDERAL AND STATE LAWS, REGULATIONS, ORDINANCES, REVIEW AND PERMIT REQUIREMENTS, AND OTHER AGENCY REQUIREMENTS, IF ANY, OF APPLICABLE AGENCIES INCLUDING, BUT NOT LIMITED TO, THE COLORADO DIVISION OF WILDLIFE, COLORADO DEPARTMENT OF TRANSPORTATION, U.S. ARMY CORPS OF ENGINEERS AND THE U.S. FISH AND WILDLIFE SERVICE REGARDING THE ENDANGERED SPECIES ACT, PARTICULARLY AS IT RELATES TO THE LISTED SPECIES (E.G., PREBLE'S MEADOW JUMPING MOUSE).
- 22. SIGHT DISTANCE EASEMENTS SHALL BE DEDICATED TO EL PASO COUNTY. MAINTENANCE OF THE SIGHT DISTANCE EASEMENT SHALL BE THE RESPONSIBILITY OF THE CLOVERLEAF METROPOLITAN DISTRICT. ANY OBJECT WITHIN THE SIGHT DISTANCE TRIANGLE OR EASEMENT MORE THAN 30 INCHES ABOVE THE SHOULDER ELEVATION OF THE ADJACENT ROADWAY SHALL CONSTITUTE A SIGHT OBSTRUCTION, AND SHALL BE REMOVED OR LOWERED.
- 23. LOTS 1—18 AND LOTS 107—113 SHALL NOT BLOCK OR IMPEDE THE FLOW OF SURFACE WATER IN THE DRAINAGE EASEMENT AND SHALL BE LIMITED TO THE INSTALLATION OF ONLY SPLIT RAIL FENCE ALONG REAR AND SIDE LOT LINES.
- 24. LOTS 1-8, 41-47, 66-70, 77-113, AND 126-131 ARE RESTRICTED TO ONE-STORY IN HEIGHT.
- 25. THE BENEFITED PARTY OF THAT ACCESS EASEMENT RECORDED UNDER RECEPTION NO. 211111395 HAS DEEDED TO CND-CLOVERLEAF, LLC., A COLORADO LIMITED LIABILITY COMPANY ALL OF THEIR INTEREST IN THE PROPERTY AND EASEMENT. CND-CLOVERLEAF HEREBY VACATES THIS EASEMENT WITH THIS PLAT.
- 26. CLOVERLEAF FILING NO. 2 IS SUBJECT TO THE DECLARATION OF PROTECTIVE COVENANTS, RESTRICTIONS, AND CONDITIONS OF THE PLACER COVENANTS FOR WOODMOOR IMPROVEMENT DISTRICT AS RECORDED IN BOOK 2452 AT PAGE 936 AND AS AMENDED IN BOOK 2579 AT PAGE 423 IN THE RECORDS OF THE EL PASO COUNTY CLERK AND RECORDER.

GEOLOGIC HAZARD NOTE:

THE FOLLOWING LOTS HAVE BEEN FOUND TO BE IMPACTED BY GEOLOGIC CONSTRAINTS OR HAZARDS. MITIGATION MEASURES AND A MAP OF THE HAZARD AREA CAN BE FOUND IN THE SOIL, GEOLOGY AND GEOLOGIC HAZARD STUDY CLOVERLEAF DEVELOPMENT, BY ENTEC ENGINEERING INC., NOVEMBER 9, 2020 IN THE CLOVERLEAF PLAN FILE (SP-202) AVAILABLE AT THE EL PASO COUNTY REPORT PLANNING AND COMMUNITY DEVELOPMENT DEPARTMENT.

- EXPANSIVE SOILS: HIGHLY SPORADIC, NOT INDICATED ON MAP. OCCURRENCES SHALE BE IDENTIFIED AND DEALT WITH ON AN INDIVIDUAL BASIS. MITIGATION WILL BE NECESSARY SHOULD EXPANSIVE SOILS BE ENCOUNTERED BENEATH FOUNDATIONS.
- SLOPE STABILITY AND LANDSLIDE HAZARD: SLOPES SHOULD NOT BE STEEPER THAN 3:1 UNLESS SPECIFICALLY EVALUATED. ANY AREAS TO RECEIVE FILL SHOULD HAVE ALL TOPSOIL, ORGANIC MATERIAL OR DEBRIS REMOVED.
- AREAS OF EROSION: AREAS OF EROSION WITH THE TEACHOUT CREEK DRAINAGE IN THE NORTHERN PORTION OF THE SITE, AND AN AREA ALONG THE EASTERN SIDE OF THE SITE ALONG CLOVERLEAF ROAD. RECOMMENDATIONS FOR EROSION CONTROL MITIGATION ARE DISCUSSED UNDER SECTION 9.0 OF ENTECH ENGINEERING'S STUDY.
- GROUNDWATER AND DRAINAGE AREAS: DUE TO HIGH GROUNDWATER IN THE AREA, ALL FOUNDATIONS SHALL INCORPORATE AN UNDERGROUND DRAINAGE SYSTEM.
- POTENTIALLY SHALLOW GROUNDWATER: LOTS 9-13, 29, 41, 42, 84, 85, 101, 102, 105, 108, 113-115.
- SEASONALLY SHALLOW GROUNDWATER: LOTS 27, 28, 53-56, 86, 87. THIS AREA MAY REQUIRE ADDITIONAL OVEREXCAVATION AND/OR STABILIZATION PRIOR TO FILL PLACEMENT, AND/OR SUBSURFACE DRAINAGE.
- COLLAPSIBLE SOILS: IDENTIFIED IN SOME OF THE TEST BORINGS. ADDITIONAL INVESTIGATION REQUIRED WITH EACH BUILDING SITE.
- SHALLOW BEDROCK: WHERE SHALLOW SANDSTONE IS ENCOUNTERED, HIGHER ALLOWABLE BEARING CAPACITIES ARE ANTICIPATED. SHALLOW CLAYSTONE MAY REQUIRE MITIGATION FOR EXPANSIVE SOILS.
- RADIOACTIVITY: APPLIES TO ALL LOTS. SPECIFIC REQUIREMENTS FOR MITIGATION SHOULD BE BASED ON—SITE SPECIFIC TESTING AFTER SITE IS CONSTRUCTED.

EASEMENTS:

UNLESS OTHERWISE INDICATED, ALL SIDE, FRONT, AND REAR LOT LINES ARE HEREBY PLATTED ON EITHER SIDE WITH A 5 FOOT PUBLIC UTILITY AND DRAINAGE EASEMENT. ALL EXTERIOR SUBDIVISION BOUNDARIES ARE HEREBY PLATTED WITH A 7 FOOT PUBLIC UTILITY AND DRAINAGE EASEMENT. THE SOLE RESPONSIBILITY FOR MAINTENANCE OF THESE EASEMENTS IS HEREBY VESTED WITH THE INDIVIDUAL PROPERTY OWNERS.

MAILBOXES:

MAILBOXES SHALL BE INSTALLED IN ACCORDANCE WITH ALL EL PASO COUNTY AND UNITED STATES POSTAL SERVICE REGULATIONS.

PCD FILE NO. SF2123 JOB NO. 25158.01 OCTOBER 29, 2021 SHEET 2 OF 9




CLOVERLEAF FILING NO. 2 A VACATION AND REPLAT OF A PORTION OF TRACT B, WOODMOOR PLACER LOCATED IN THE NE1/4 OF SECTION 23 AND THE NW1/4 OF SECTION 24, TOWNSHIP 11 SOUTH, RANGE 67 WEST OF THE 6TH P.M. **COUNTY OF EL PASO, STATE OF COLORADO** N84°03'34"E 224.55 N07°26'50"W_ **LEGEND** RECOVERED 1-1/4" ORANGE PLASTIC CAP STAMPED "LS 25955" UNLESS NOTED CARIBOU DRIVE WEST RECOVERED 1-1/4" YELLOW PLASTIC CAP RECOVERED #4 REBAR RECOVERED 1-1/2" ALUMINUM CAP STAMPED "32820" RECOVERED #5 REBAR TRACT (RECOVERED 1-1/4" RED PLASTIC CAP STAMPED "LS 13485" SET 18" #5 REBAR W/ 1-1/2" ALUMINUM CAP STAMPED "LS 38252" NOT PART OF SURVEY NW1/4, SEC. 24, T11S, R67W, 6TH P.M. AREA OF SEASONAL SHALLOW GROUNDWATER AND POTENTIALLY SEASONAL SHALLOW S34**°**31'56"E_ 97.38' 97 TRACT D Δ=26*50'54" R=345.00'-Δ=22*29'51' PUBLIC IMPROVEMENTS EASEMENT L=161.66' _R=230.00' PUBLIC UTILITY EASEMENT L=90.31'P.U.E. N28'37'11"E_ 115 67.40'¯ PUBLIC UTILITY AND DRAINAGE EASEMENT TRACT A Δ=15°37'05" R=300.00' **Δ**=1**°**22**'**45" R=570.00'-_S52[•]28'59"E 130.03 NE1/4, SEC. 23, T11S, R67W, 6TH P.M. /N33°23'09"W_ |125 |124 | 123 |122 | 121 | EXISTING RIGHT—OF—WAY WHITE CLOVER DRIVE POINT OF _ BEGINNING TRACT J WALTERS POINT 131 | 130 | 129 | 128 / N23°36'18"W _ 971.92' Δ=15°03'35" R=310.00' L=81.48' ORIGINAL SCALE: 1" = 150"BASIS OF BEARINGS S89°54'49"E 2658.92' PCD FILE NO. SF2123 30.0' REFERENCE MONUMENT 30.00' WITNESS CORNER E1/4 CORNER SEC. 23 JOB NO. 25158.01 C1/4 CORNER SEC. 23 - T.11S, R.67W, 6TH P.M. — T.11S, R.67W, 6TH P.M. OCTOBER 29, 2021 RECOVERED 1-1/2" ALUMINUM CAP RECOVERED 3-1/4" ALUMINUM CAP STAMPED "LS 2692" SHEET 3 OF 9 STAMPED "RLS 10377 1997 30.00 WC" A Westrian Company Centennial 303-740-9393 • Colorado Springs 719-593-2593

Fort Collins 970-491-9888 • www.jrengineering.com

CLOVERLEAF FILING NO. 2 A VACATION AND REPLAT OF A PORTION OF TRACT B, WOODMOOR PLACER LOCATED IN THE NE1/4 OF SECTION 23 AND THE NW1/4 OF SECTION 24, TOWNSHIP 11 SOUTH, RANGE 67 WEST OF THE 6TH P.M. **COUNTY OF EL PASO, STATE OF COLORADO LEGEND** RECOVERED 1-1/4" ORANGE PLASTIC CAP STAMPED "LS 25955" UNLESS NOTED RECOVERED 1-1/4" YELLOW PLASTIC CAP RECOVERED #4 REBAR RECOVERED 1-1/2" ALUMINUM CAP STAMPED "32820" RECOVERED #5 REBAR 20' P.U.D.E. SEE DETAIL C, SHEET 8 7,425 SF 0.1705 AC RECOVERED 1-1/4" RED PLASTIC CAP STAMPED "LS 13485" N84°07'17"E 115.00' SET 18" #5 REBAR W/ 1-1/2" ALUMINUM CAP STAMPED "LS 38252" WOODMOOR GREENS PLAT BOOK U-2 PAGE 51 **38** 6,750 SF 0.1550 AC 6,900 SF 0.1584 AC AREA OF SEASONAL SHALLOW GROUNDWATER AND POTENTIALLY SEASONAL SHALLOW GROUNDWATER P.I.E. PUBLIC IMPROVEMENTS EASEMENT PUBLIC UTILITY EASEMENT P.U.E. PUBLIC UTILITY AND DRAINAGE EASEMENT P.U.D.E. 6,750 SF 0.1550 AC 6,900 SF 0.1584 AC PROPOSED PROPERTY LINE TRACT A 127,275 SF PROPOSED RIGHT-OF-WAY ┌─ 5' P.U.E. LOT 561 2.9218 AC 10' UTILITY EASEMENT REC. NO. 208043977 **36** 6,750 SF 0.1550 AC VACATED BY SIGHT DISTANCE EASEMENT 16' UTILITY AND 6,900 SF —·—·— EXISTING CENTERLINE DRAINAGE EASEMENT 0.1584 AC PLAT BOOK U-2, PAGE 66 **35** 6,750 SF 0.1550 AC 6,900 SF DRAINAGE EASEMENT 0.1584 AC N83°12'34"W 253.02' PLAT BOOK U-2, PAGE 51 **34** 6,750 SF 0.1550 AC 115.00 16' UTILITY AND 43.51 - DRAINAGE EASEMENT PLAT BOOK U-2, PAGE 51 6,900 SF 0.1584 AC 1 10.00' 125 0. 6,000 SF 0. 0.1377 AC **33** 6,750 SF 0.1550 AC 124 6,000 SF * LOT 484_{*} 123 7,142 SF 0.1640 AC 0.1377 AC 8' UTILITY AND DRAINAGE EASEMENT —/ PLAT BOOK U—2, PAGE 51 135.00 ← 5' P.I.E. 6,838 SF 0.1570 AC **120** 7,347 SF 0.1687 AC **32** 7,681 SF _Δ=3°53'18" 0.1763 AC Δ=3°38'07" _Δ=12°49'26" L=39.1<u>7</u>' S84°07'17"W 135.92' WHITE CLOVER DRIVE (50' PUBLIC ROW) ------TRACT L 12,571 SF 0.2886 AC **31** 9,391 SF 0.2156 AC └ 5' P.U.E. └ 5' P.I.E. N61°22'52"W_ 7,194 SF 0.1651 AC 7.50' [7,200 SF 5.77**'**— 5' P.I.E. — **30** 7,655 SF 0.1757 AC 0.1653 AC 7,200 SF 0.1653 AC _Δ=12°37'24" 7,200 SF 0.1653 AC _ L=49.57' 7,200 SF 0.1653 AC 7,200 SF 0.1653 AC 7,500 SF 0.1539 AC 0.1722 AC 7,896 SF 0.1813 AC P.U.D.E. SEE DETAIL E, -12,095 SF 0.2777 AC SHEET 9 5' P.U.E. ¬ 11,263 SF 0.2586 AC P.U.D.E. - SEE DETAIL E, SHEET 9 UTILITY EASEMENT REC. NO. 208043977 VACATED BY REC. NO. LINE TABLE CURVE TABLE 40 20 0 LINE | BEARING | DISTANCE CURVE | DELTA | RADIUS | LENGTH _Δ=3°31[°]12″ ORIGINAL SCALE: 1" = 40'_ L=13.82' 9,763 SF 0.2241 AC S33°23'09"E 33.34' 0°57'18" | 300.00' | 5.00' WALTERS COMMONS FILING NO. 1 4°47'03" | 300.00' | 25.05' N33°23'09"W 34.79' PCD FILE NO. SF2123 REC. NO. 205086620 8' UTILITY AND DRAINAGE EASEMENT — REC. NO. 863562 JOB NO. 25158.01 4°49'29" | 300.00' | 25.26' N33°23'09"W 29.76' 7,578 SF 0.1740 AC OCTOBER 29, 2021 5°03'15" | 300.00' | 26.46' S59°36'01"E 37.79' SHEET 4 OF 9 L5 | S37°13'35"W | 35.31' 16°27'33" | 200.00' | 57.45' 13 7,639 SF 0.1754 AC 16°27'33" | 225.00' | 64.63' | 16°27'33" | 175.00' | 50.27' * COVENTRY RIDGE ESTATES PLAT BOOK M-3 PAGE 83 J·R ENGINEERING 3°47′24" | 200.00' | 13.23' A Westrian Company 14°45'06" | 40.00' C15 | 26°59'00" | 40.00' | 18.84' Centennial 303-740-9393 • Colorado Springs 719-593-2593 C17 | 13°46'03" | 40.00' | 9.61' Fort Collins 970-491-9888 • www.jrengineering.com


A VACATION AND REPLAT OF A PORTION OF TRACT B, WOODMOOR PLACER

LOCATED IN THE NE1/4 OF SECTION 23 AND THE NW1/4 OF SECTION 24, TOWNSHIP 11 SOUTH, RANGE 67 WEST OF THE 6TH P.M.

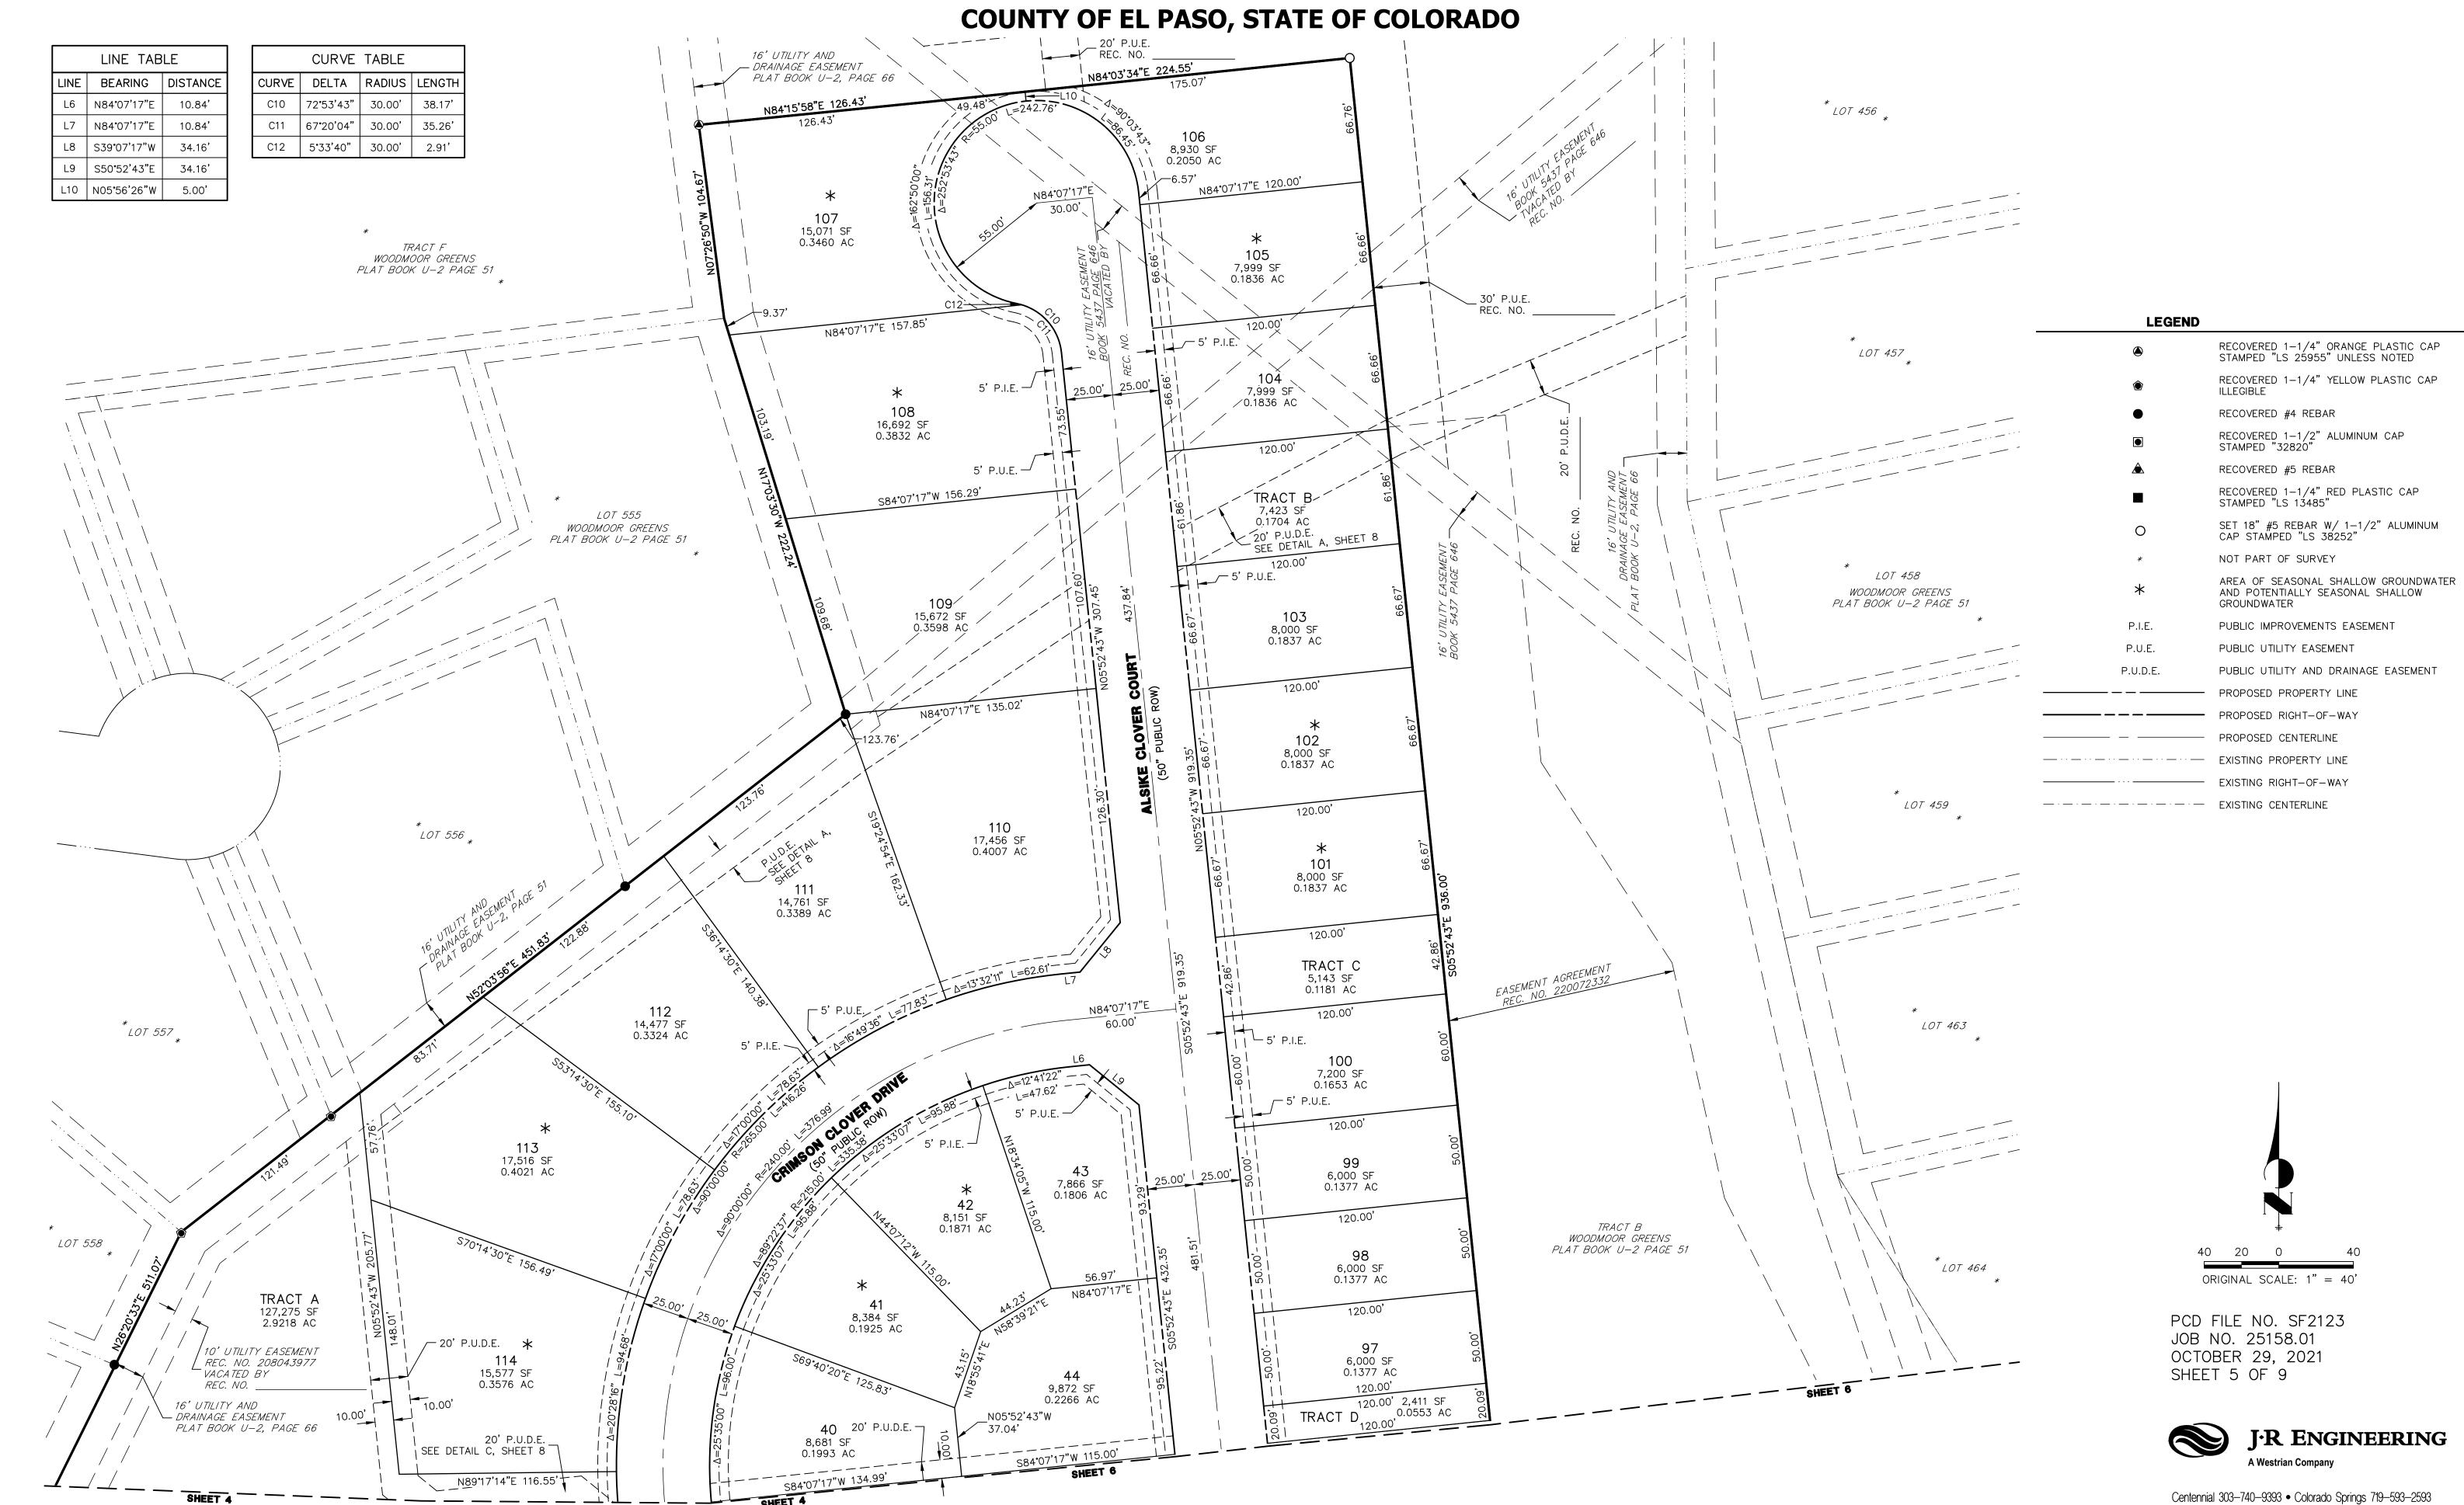


Fort Collins 970-491-9888 • www.jrengineering.com


CLOVERLEAF FILING NO. 2 A VACATION AND REPLAT OF A PORTION OF TRACT B, WOODMOOR PLACER LOCATED IN THE NE1/4 OF SECTION 23 AND THE NW1/4 OF SECTION 24, TOWNSHIP 11 SOUTH, RANGE 67 WEST OF THE 6TH P.M. **COUNTY OF EL PASO, STATE OF COLORADO 96** 6,000 SF 0.1377 AC **LEGEND** RECOVERED 1-1/4" ORANGE PLASTIC CAP STAMPED "LS 25955" UNLESS NOTED 6,325 SF 0.1452 AC RECOVERED 1-1/4" YELLOW PLASTIC CAP ILLEGIBLE 6,000 SF 0.1377 AC RECOVERED #4 REBAR RECOVERED 1-1/2" ALUMINUM CAP STAMPED "32820" 5,750 SF 0.1320 AC WOODMOOR GREENS PLAT BOOK U-2 PAGE 51 RECOVERED #5 REBAR 115.00 **94** 6,000 SF 0.1377 AC RECOVERED 1-1/4" RED PLASTIC CAP STAMPED "LS 13485" SET 18" #5 REBAR W/ 1-1/2" ALUMINUM CAP STAMPED "LS 38252" 5,750 SF 0.1320 AC TRACT B WOODMOOR GREENS PLAT BOOK U-2 PAGE 51 NOT PART OF SURVEY 115.00 **93** 6,000 SF 0.1377 AC AREA OF SEASONAL SHALLOW GROUNDWATER AND POTENTIALLY SEASONAL SHALLOW N84°07'17"E 120.00' 5,750 SF 0.1320 AC PUBLIC IMPROVEMENTS EASEMENT _N67°15'50"E 11.14' 1.10'— _Δ=22**°**29'51" P.U.E. PUBLIC UTILITY EASEMENT S84°07'17"W 115.00 6,311 SF 0.1449 AC Δ=3°57'26"_ N85°06'36"E(R) PUBLIC UTILITY AND DRAINAGE EASEMENT PROPOSED PROPERTY LINE PROPOSED RIGHT-OF-WAY 6,757 SF 0.1551 AC Δ=4°01'35"_ TRACT E 9,211 SF 0.2114 AC **81** 7,744 SF **91** 8,803 SF 0.2021 AC · — · — · — EXISTING CENTERLINE Δ=14°59'43" Δ=1°22'45" **50** 7,437 SF 0.1707 AC R=570.00'-L=13.72' **82** 7,827 SF 7,138 SF 0.1639 AC LINE TABLE CURVE TABLE CURVE | DELTA | RADIUS | LENGTH 89 6,000 SF 0.1377 AC LINE BEARING DISTANCE 80 10,073 SF 0.2312 AC L11 N16°22'52"W 34.16' C14 28°22'50" 40.00' 19.81' **51** 8,446 SF 0.1939 AC C16 27°07'19" 40.00' 18.93' L12 S73°37'08"W 88 6,000 SF 0.1377 AC O' **83** 7,199 SF 0.1653 AC L13 S16°22'52"E 34.16' C18 | 4°43'41" | 225.00' | 18.57' C19 | 55°30'09" | 55.00' | 53.28' **87** 6,000 SF 0.1377 AC C20 4°03'29" 345.00' 24.43' **79** 7,351 SF 0.1688 AC C21 | 29°34'35" | 225.00' | 116.15' **52** 8,424 SF 0.1934 AC 86 6,000 SF 0.1377 AC C22 3°24'14" 175.00' 10.40' 0°45'43" | 410.00' | 5.45' **85** 6,000 SF 0.1377 AC **53** 6,948 SF 0.1595 AC 3°35'45" | 410.00' | 25.73' 3°34'06" 410.00' 25.53' **84** 6,908 SF 0.1586 AC/ 6,000 SF 0.1377 AC C26 49°40'47" 30.00' 26.01' **54** 7,221 SF 0.1658 AC TRACT G 24,622 SF 0.5652 AC 55 6,900 SF 0.1584 AC \$ 56 6,900 SF 0.1584 AC **?**/ 28 6,723 SF 0.1543 AC **57** 6,900 SF 0.1584 AC **76** 8,108 SF 0.1861 AC Δ=0°01'19"_ L=0.10' 75 7,100 SF 0.1630 AC V 27 6,742 SF 0.1548 AC **58** 6,900 SF 0.1584 AC **74** 7,100 SF & 0.1630 AC **26** 6,762 SF 0.1552 AC **59** 6,552 SF 0.1504 AC 73 7,100 SF 0.1630 AC **25** 6,781 SF 0.1557 AC ORIGINAL SCALE: 1" = 40' 72 7,100 SF 0.1630 AC **70** 9,799 SF 0.2250 AC PCD FILE NO. SF2123 24 6,798 SF 0.1561 AC JOB NO. 25158.01 6,545 SF 0.1503 AC OCTOBER 29, 2021 _Δ=4°09'53 L=12.72' / **23** 6,582 SF 0.1511 AC SHEET 6 OF 9 TRACT K 9,175 SF 0.2106 AC $\Delta = 30^{\circ}23'12''$ L = 29.17'J·R ENGINEERING A Westrian Company Centennial 303-740-9393 • Colorado Springs 719-593-2593 Fort Collins 970-491-9888 • www.jrengineering.com

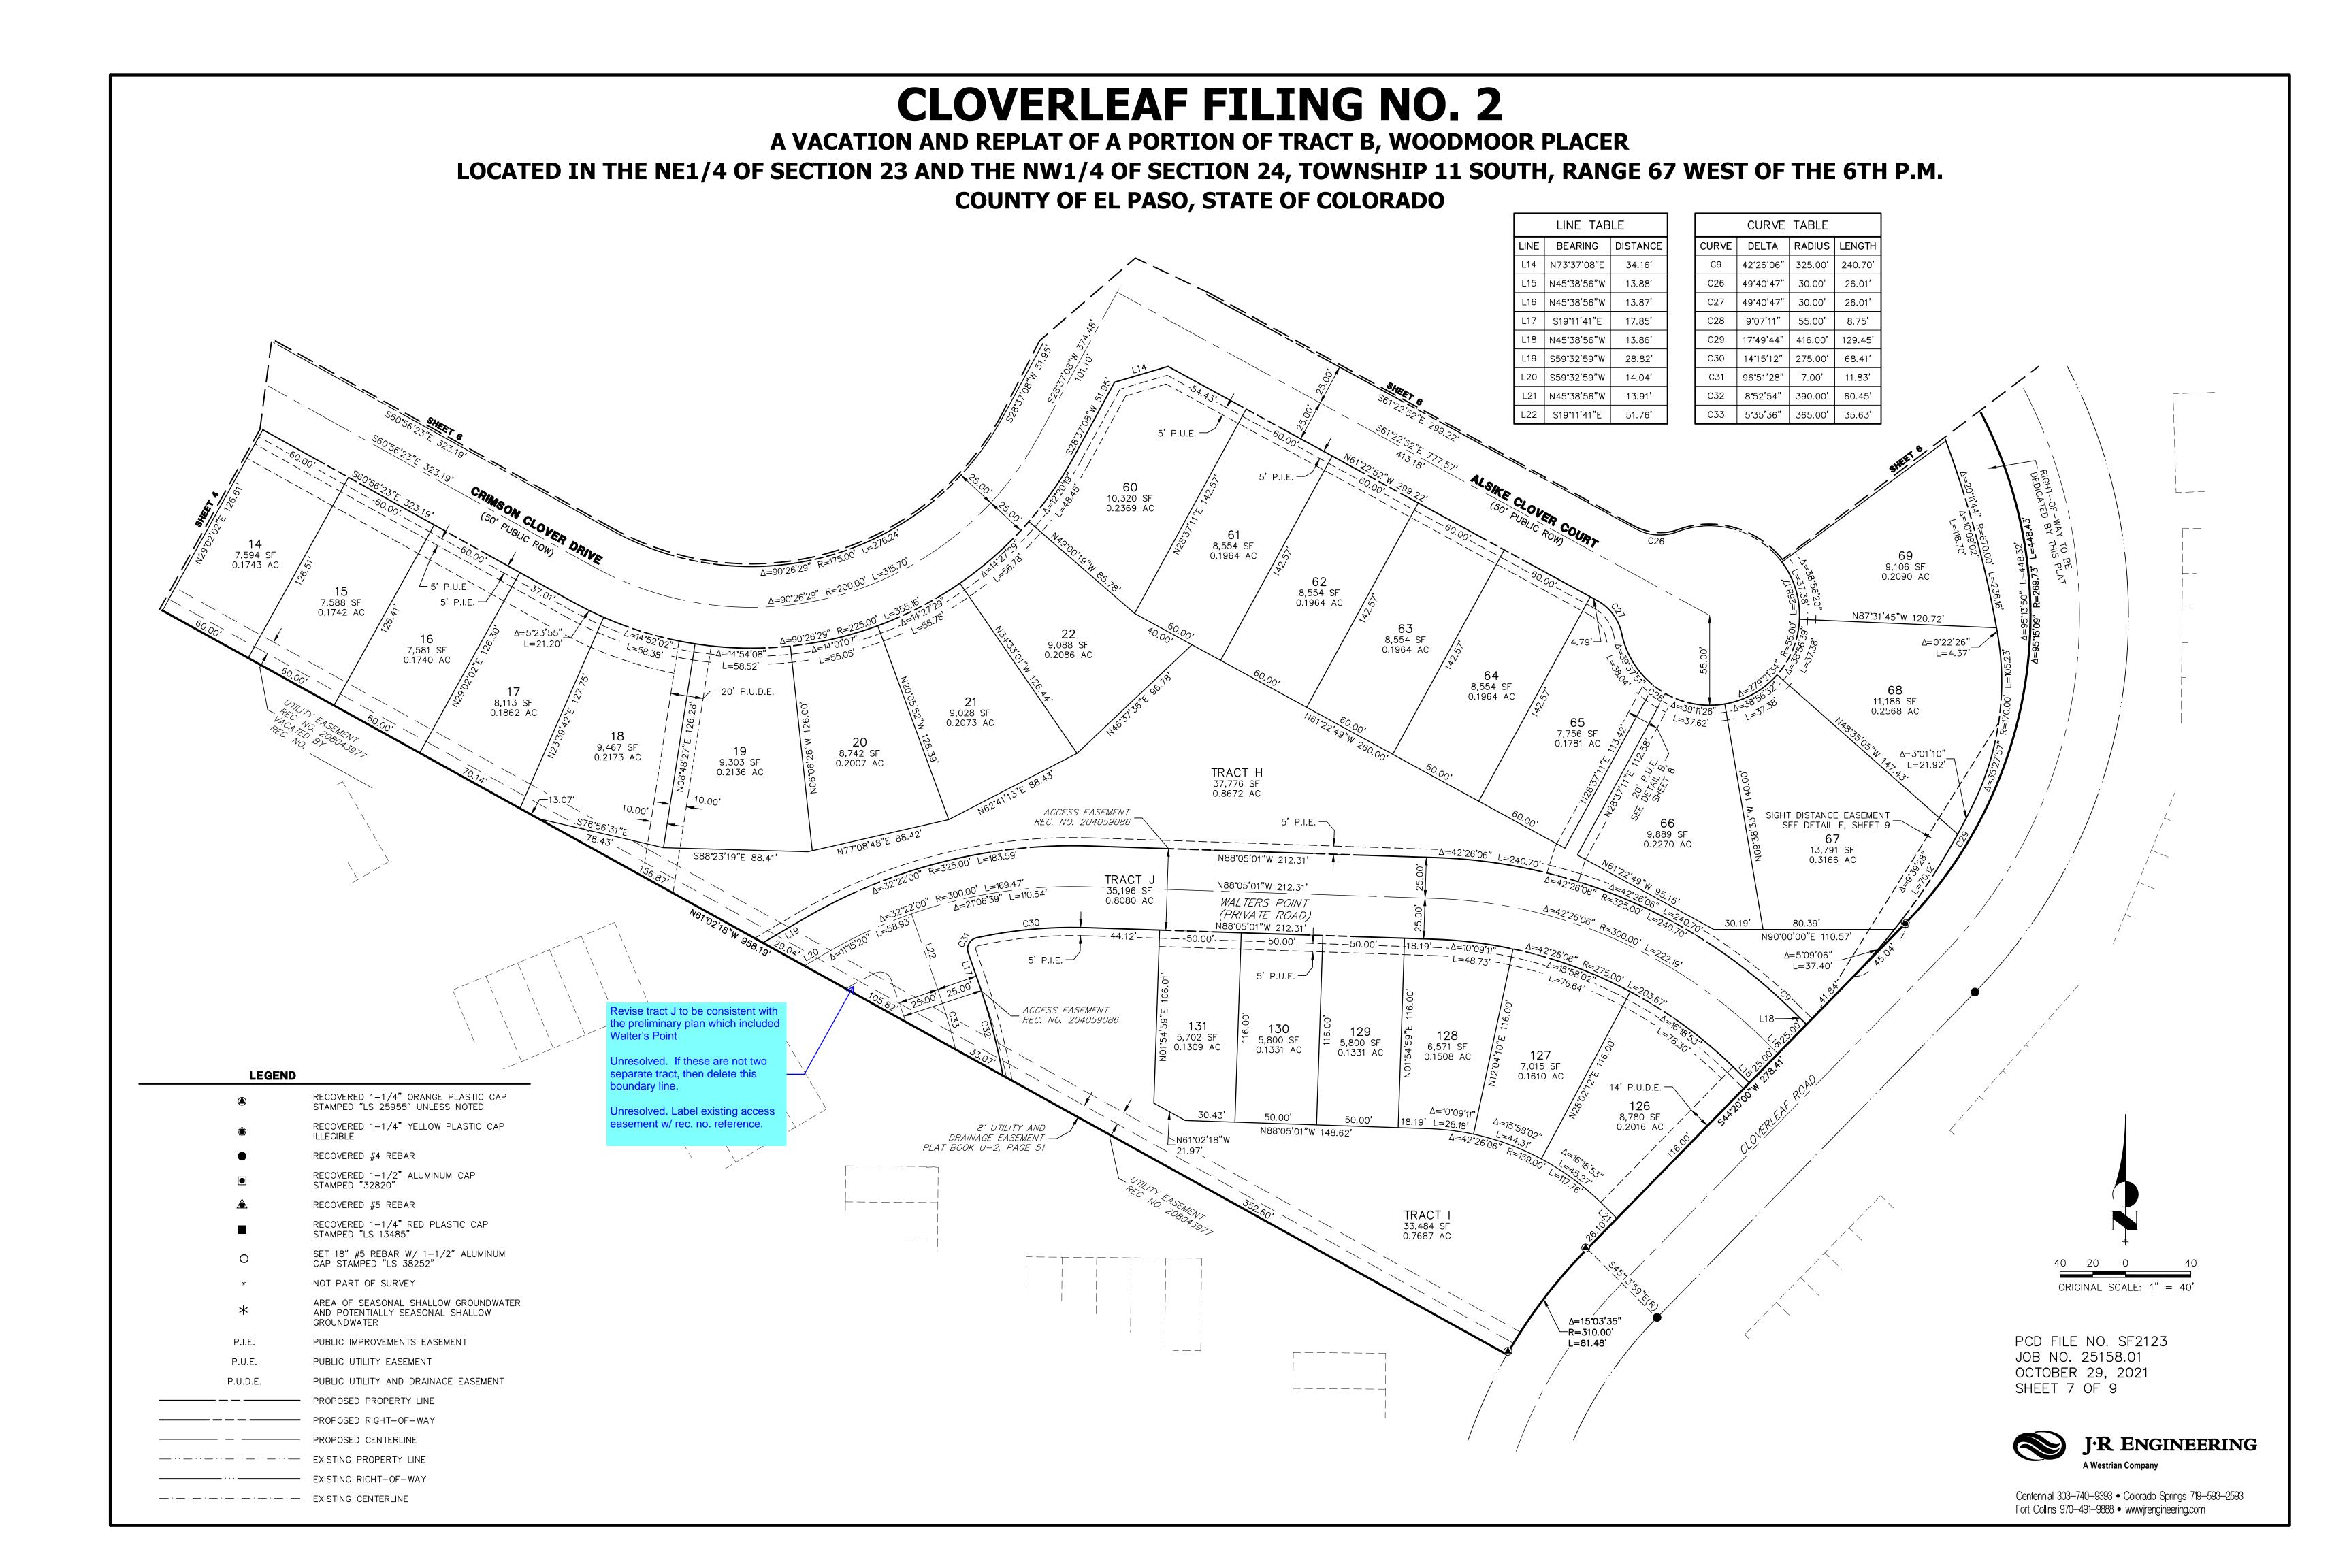


A VACATION AND REPLAT OF A PORTION OF TRACT B, WOODMOOR PLACER LOCATED IN THE NE1/4 OF SECTION 23 AND THE NW1/4 OF SECTION 24, TOWNSHIP 11 SOUTH, RANGE 67 WEST OF THE 6TH P.M.

COUNTY OF EL PASO, STATE OF COLORADO

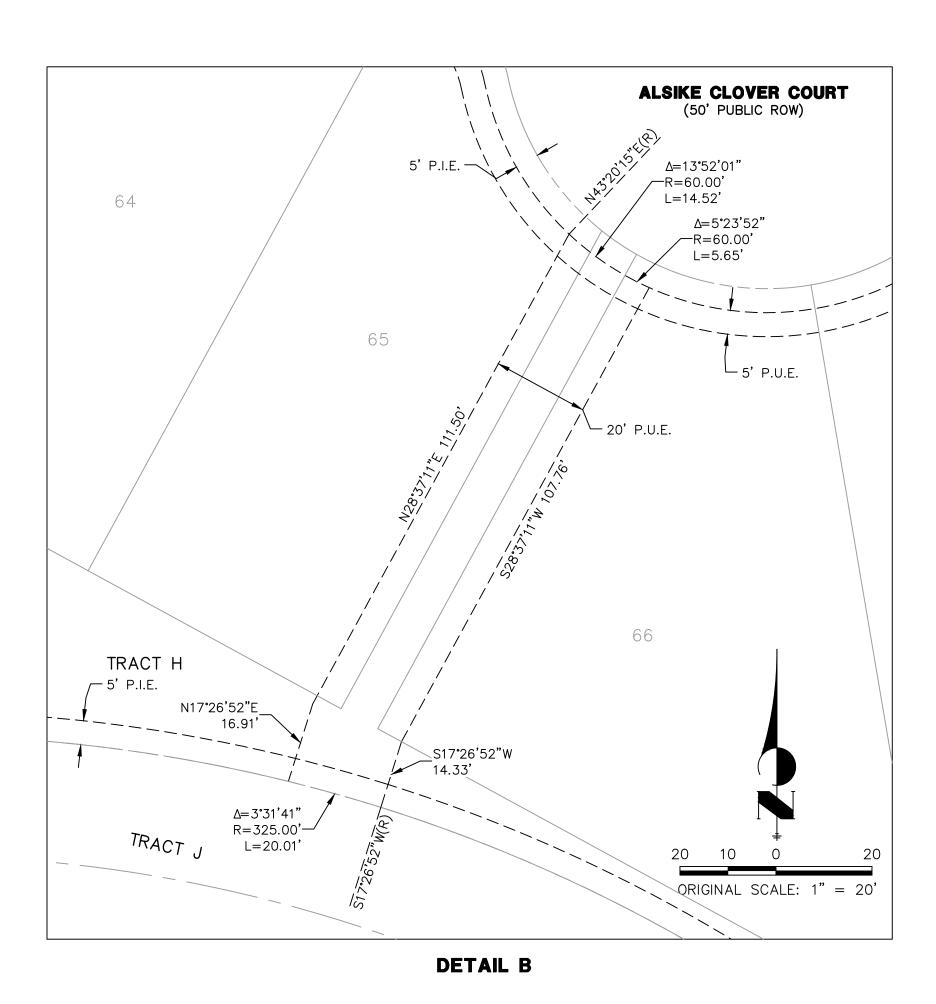

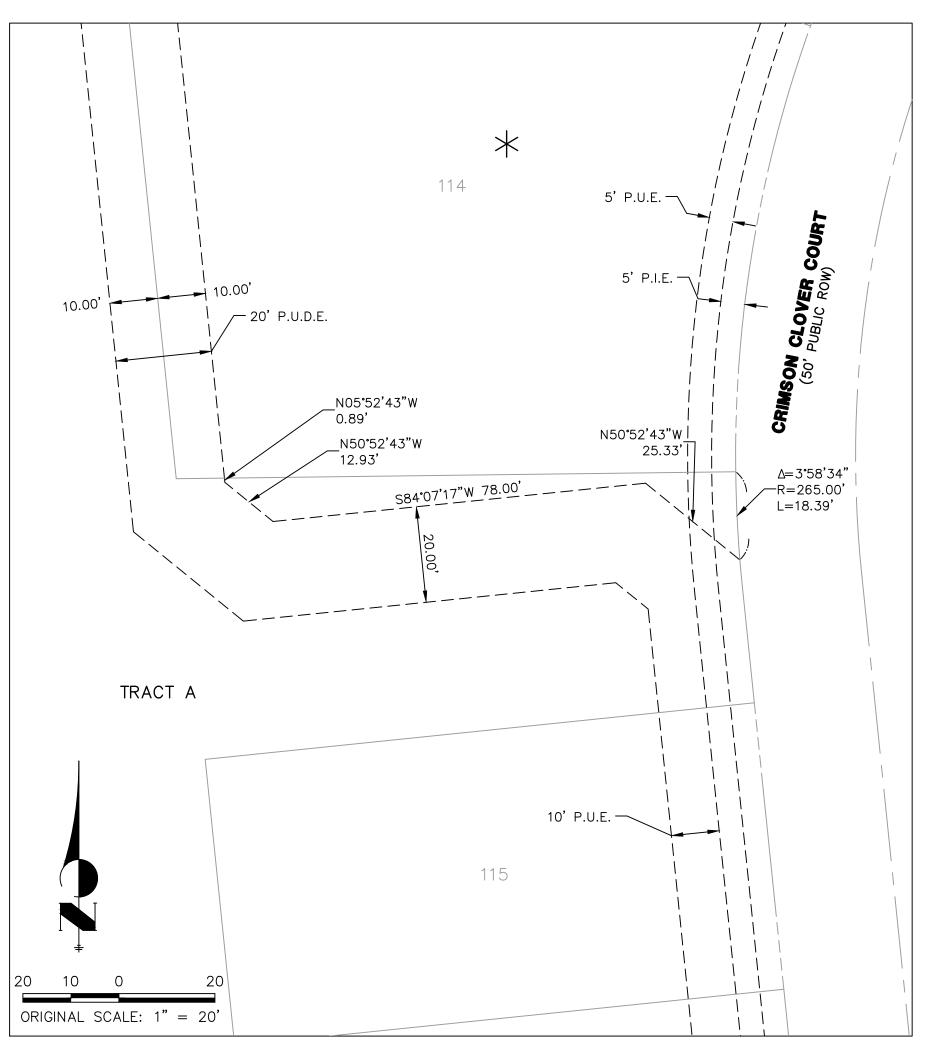



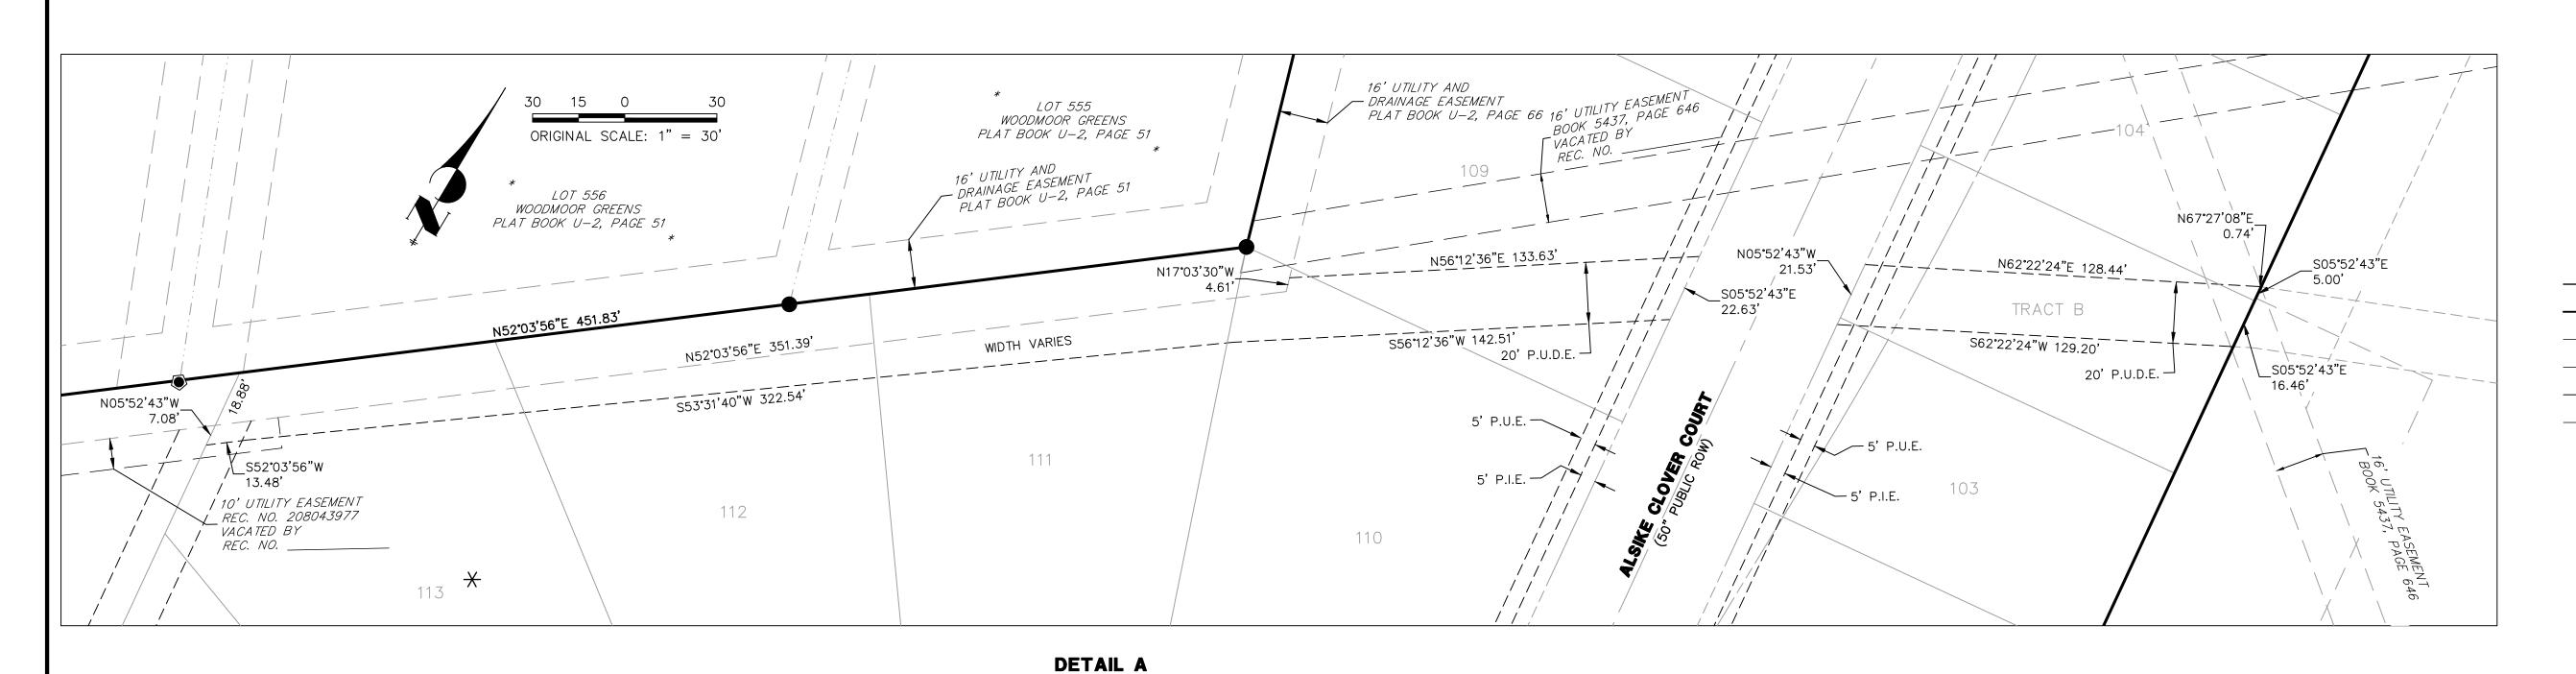

- RECOVERED 1-1/4" ORANGE PLASTIC CAP STAMPED "LS 25955" UNLESS NOTED
- RECOVERED 1-1/4" YELLOW PLASTIC CAP ILLEGIBLE
- RECOVERED #4 REBAR

LEGEND

- RECOVERED 1-1/2" ALUMINUM CAP STAMPED "32820"
- RECOVERED #5 REBAR
- RECOVERED 1-1/4" RED PLASTIC CAP STAMPED "LS 13485"
- SET 18" #5 REBAR W/ 1-1/2" ALUMINUM CAP STAMPED "LS 38252"
- NOT PART OF SURVEY
- AREA OF SEASONAL SHALLOW GROUNDWATER AND POTENTIALLY SEASONAL SHALLOW GROUNDWATER
- PUBLIC IMPROVEMENTS EASEMENT
- P.U.E. PUBLIC UTILITY EASEMENT
- P.U.D.E. PUBLIC UTILITY AND DRAINAGE EASEMENT

- PROPOSED PROPERTY LINE
- PROPOSED RIGHT-OF-WAY
- PROPOSED CENTERLINE
- ·· EXISTING PROPERTY LINE
- EXISTING RIGHT—OF—WAY

PCD FILE NO. SF2123 JOB NO. 25158.01 OCTOBER 29, 2021 SHEET 8 OF 9





Centennial 303-740-9393 • Colorado Springs 719-593-2593 Fort Collins 970-491-9888 • www.jrengineering.com

A VACATION AND REPLAT OF A PORTION OF TRACT B, WOODMOOR PLACER


LOCATED IN THE NE1/4 OF SECTION 23 AND THE NW1/4 OF SECTION 24, TOWNSHIP 11 SOUTH, RANGE 67 WEST OF THE 6TH P.M.

COUNTY OF EL PASO, STATE OF COLORADO

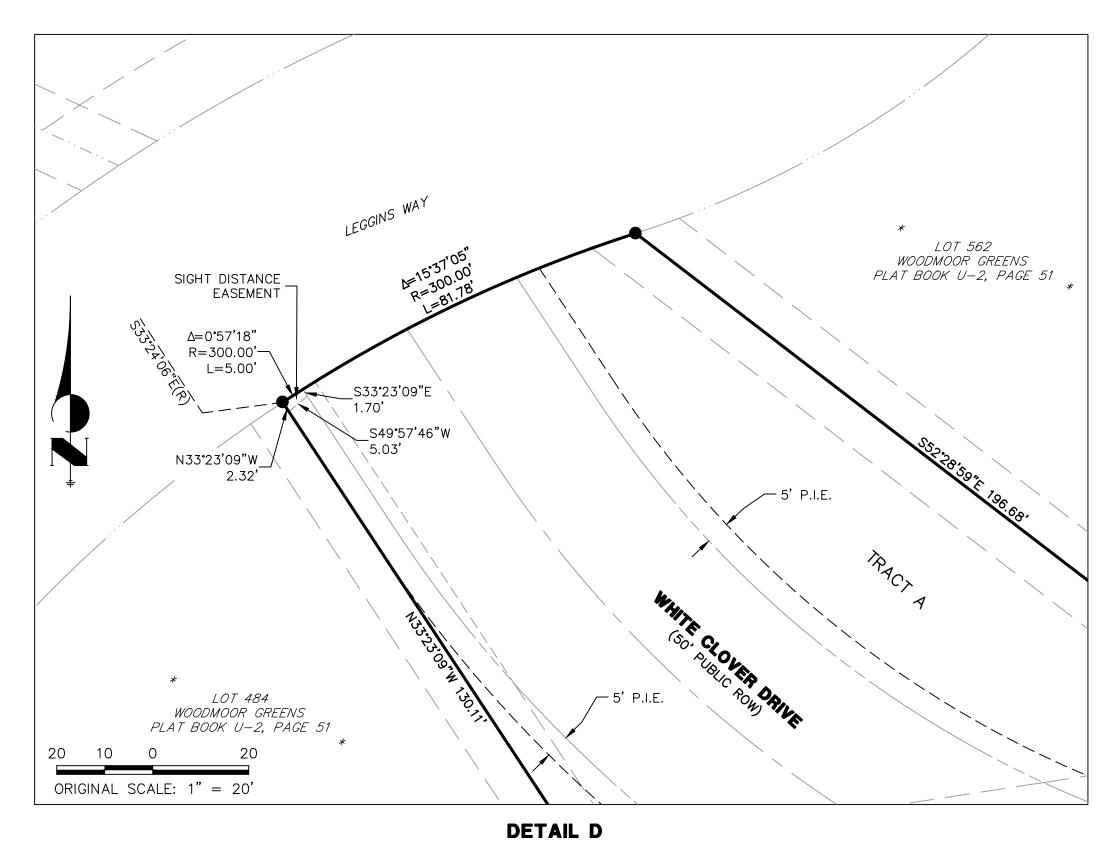

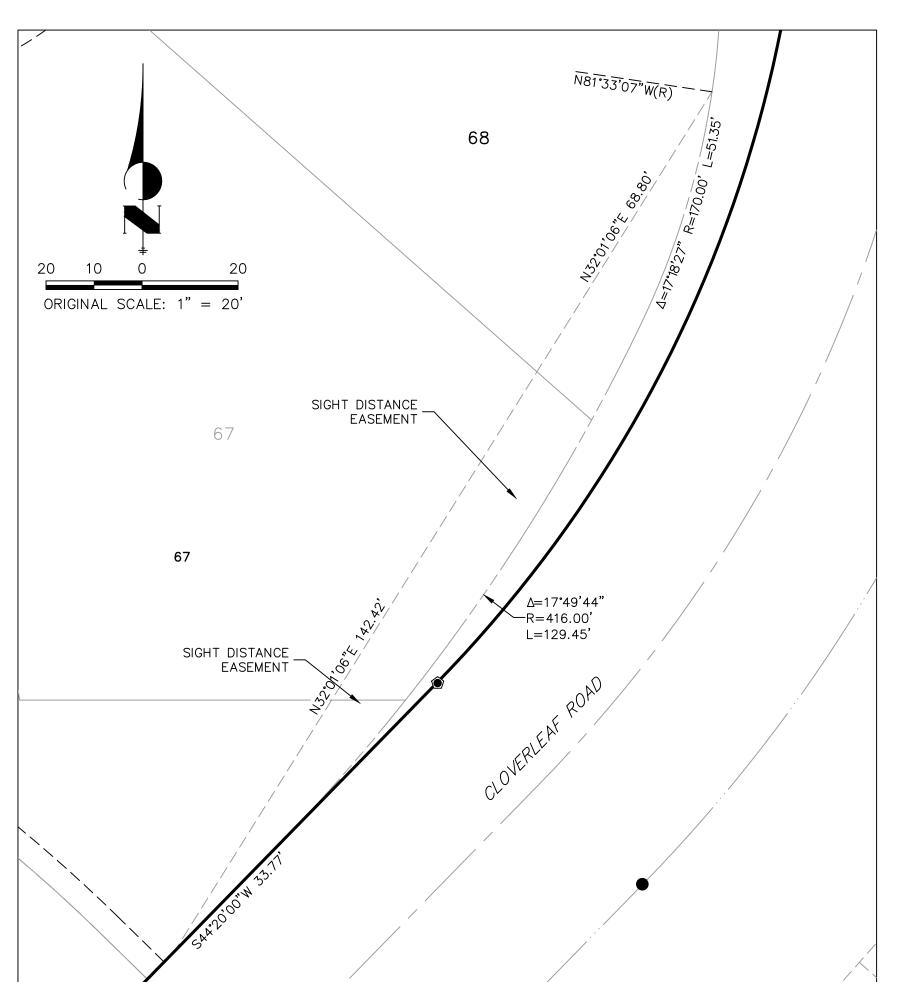

DETAIL F

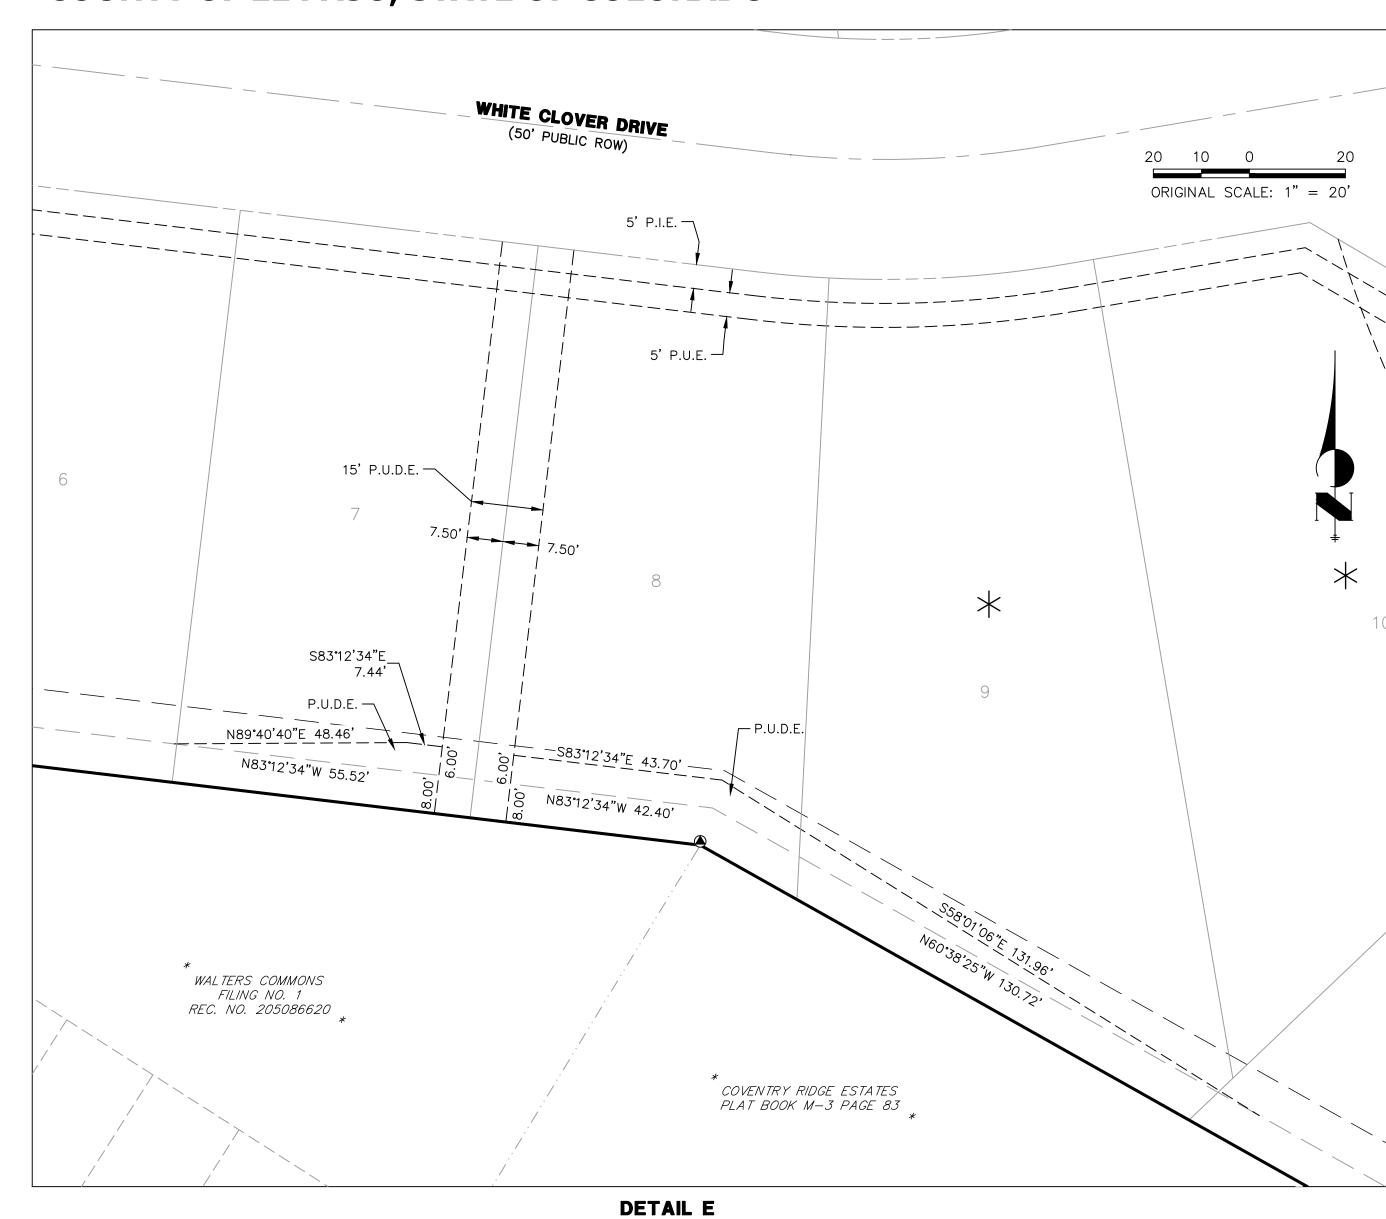

	RECOVERED 1-1/4" ORANGE PLASTIC CAP STAMPED "LS 25955" UNLESS NOTED
	RECOVERED 1-1/4" YELLOW PLASTIC CAP ILLEGIBLE
•	RECOVERED #4 REBAR
	RECOVERED 1-1/2" ALUMINUM CAP STAMPED "32820"
À	RECOVERED #5 REBAR
	RECOVERED 1-1/4" RED PLASTIC CAP STAMPED "LS 13485"
0	SET 18" #5 REBAR W/ 1-1/2" ALUMINUM CAP STAMPED "LS 38252"
*	NOT PART OF SURVEY
*	AREA OF SEASONAL SHALLOW GROUNDWATER AND POTENTIALLY SEASONAL SHALLOW GROUNDWATER
P.I.E.	PUBLIC IMPROVEMENTS EASEMENT
P.U.E.	PUBLIC UTILITY EASEMENT
P.U.D.E.	PUBLIC UTILITY AND DRAINAGE EASEMENT
	PROPOSED PROPERTY LINE
	PROPOSED RIGHT-OF-WAY
	PROPOSED CENTERLINE
	EXISTING PROPERTY LINE
····	EXISTING RIGHT-OF-WAY
	EXISTING CENTERLINE
PCD	FILE NO. SF2123

LEGEND

PCD FILE NO. SF2123 JOB NO. 25158.01 OCTOBER 29, 2021 SHEET 9 OF 9



Centennial 303-740-9393 • Colorado Springs 719-593-2593 Fort Collins 970-491-9888 • www.jrengineering.com