
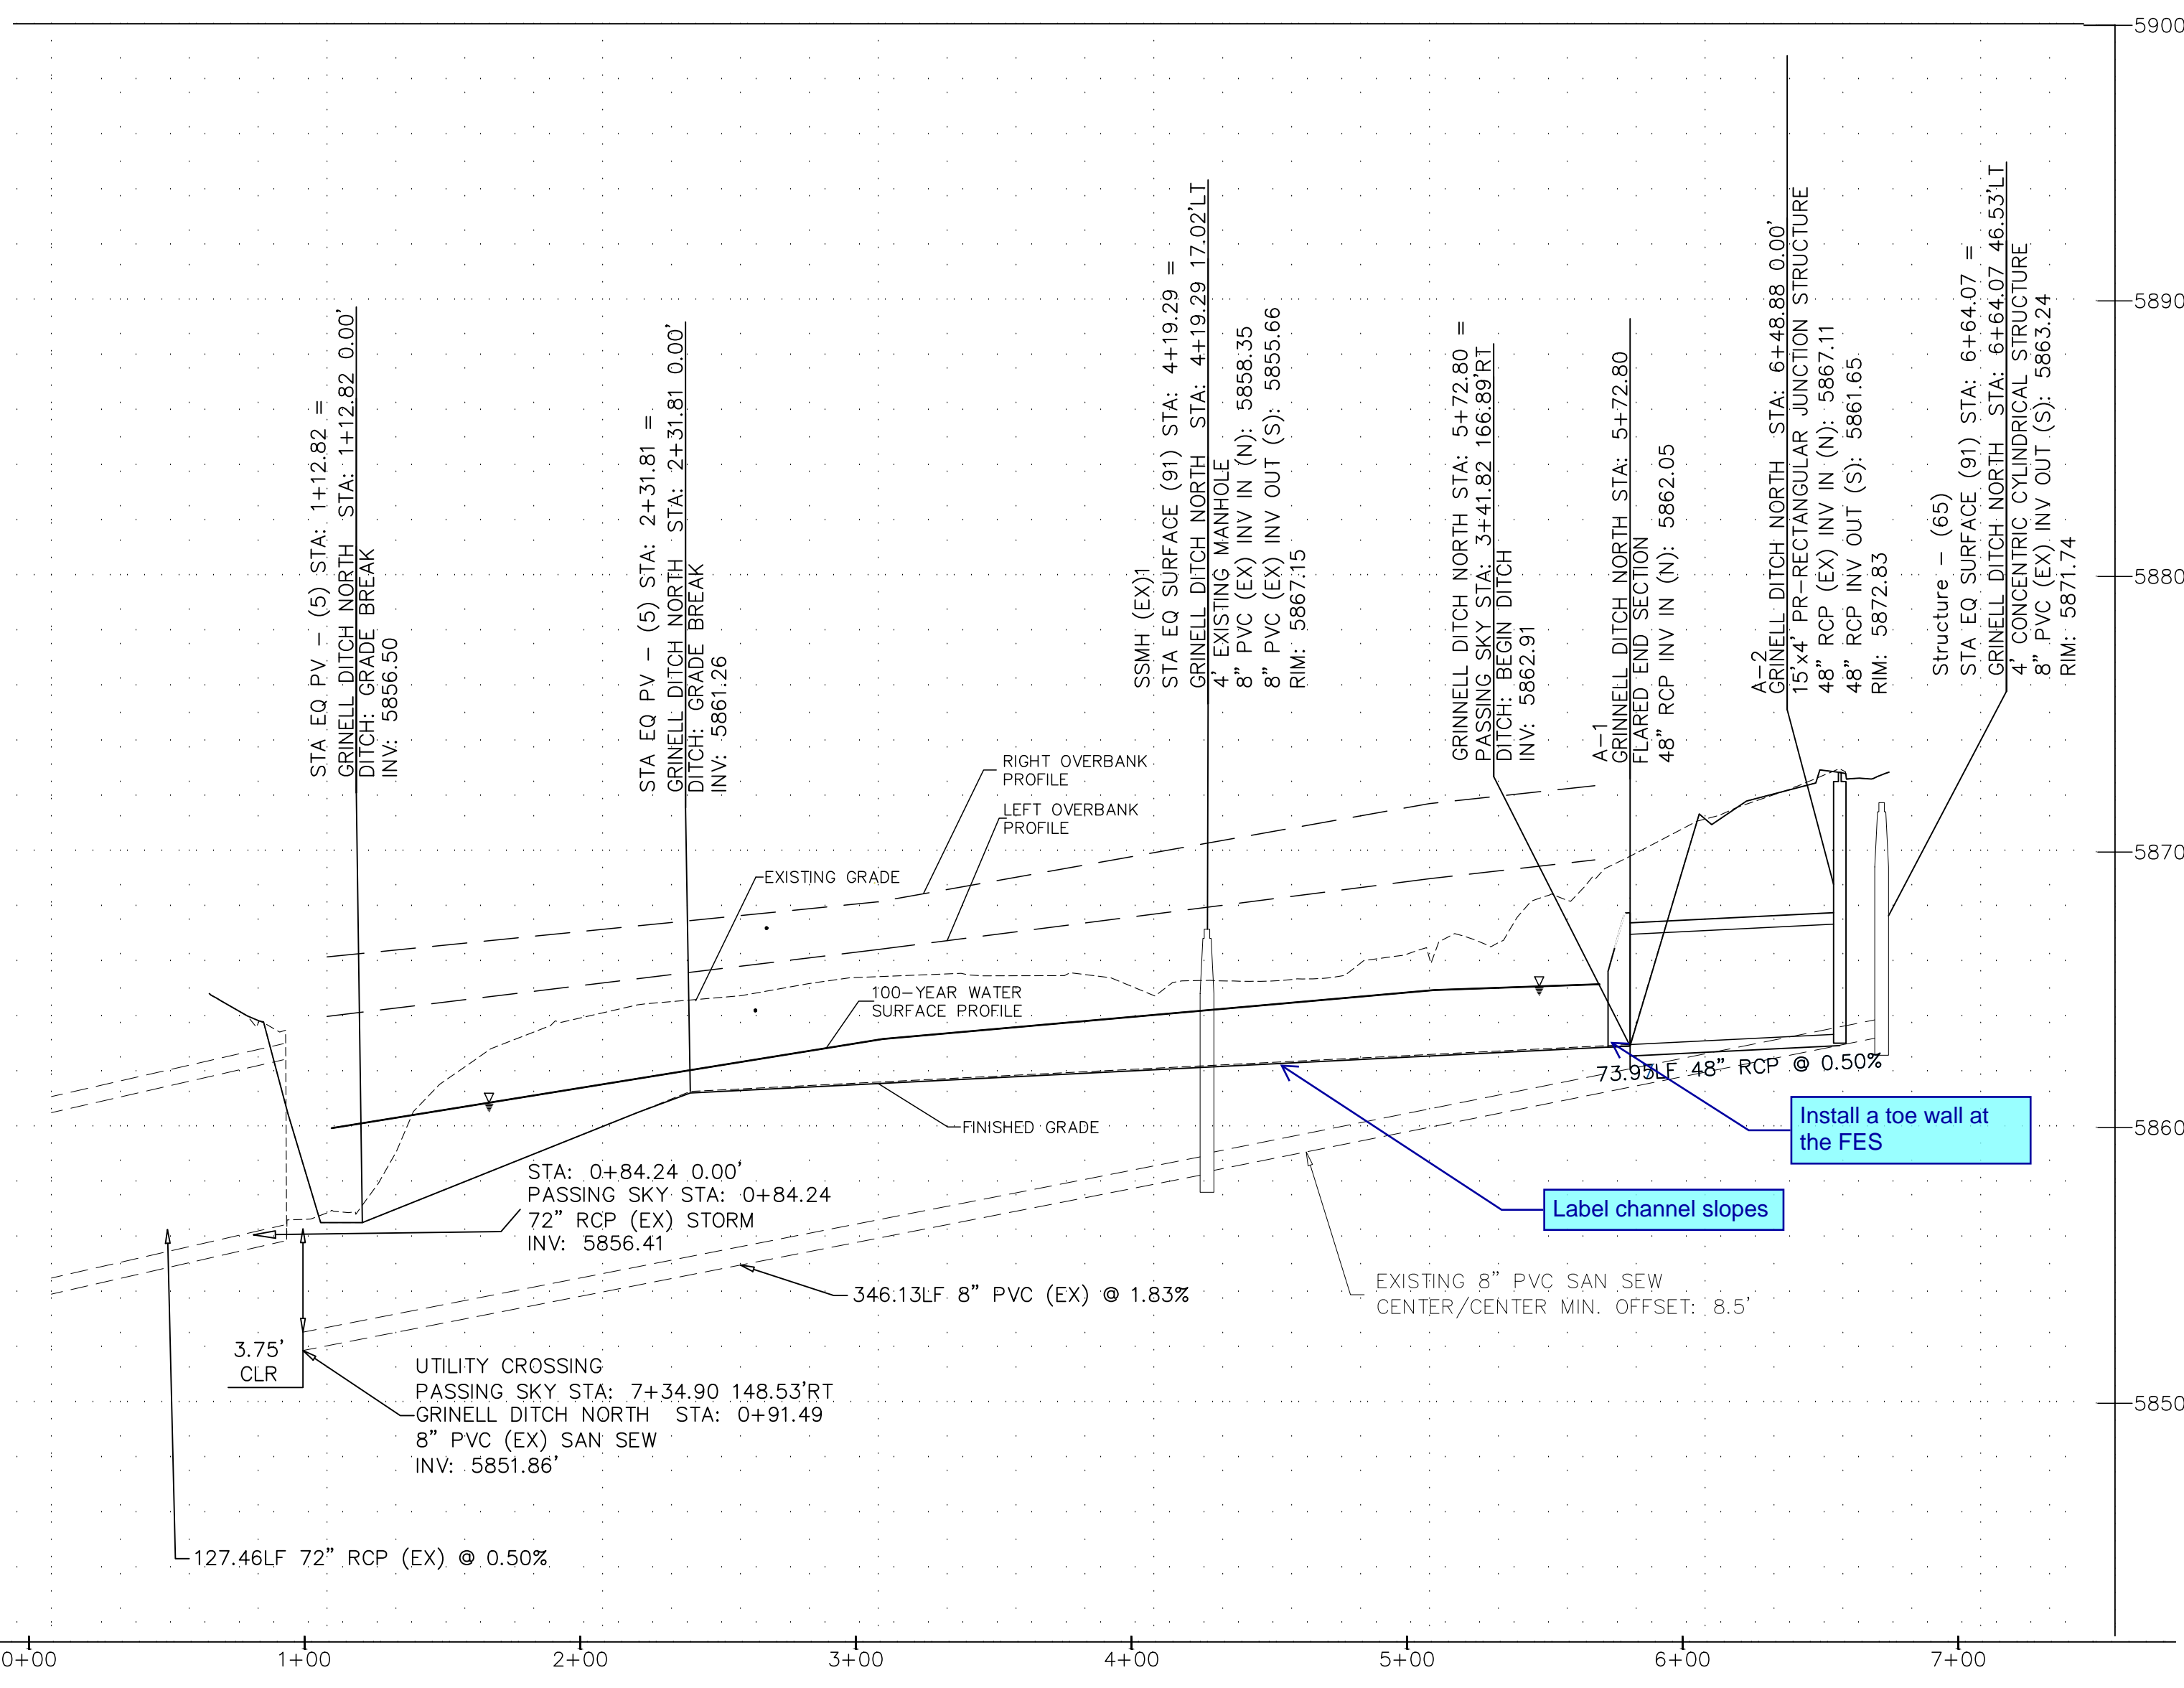
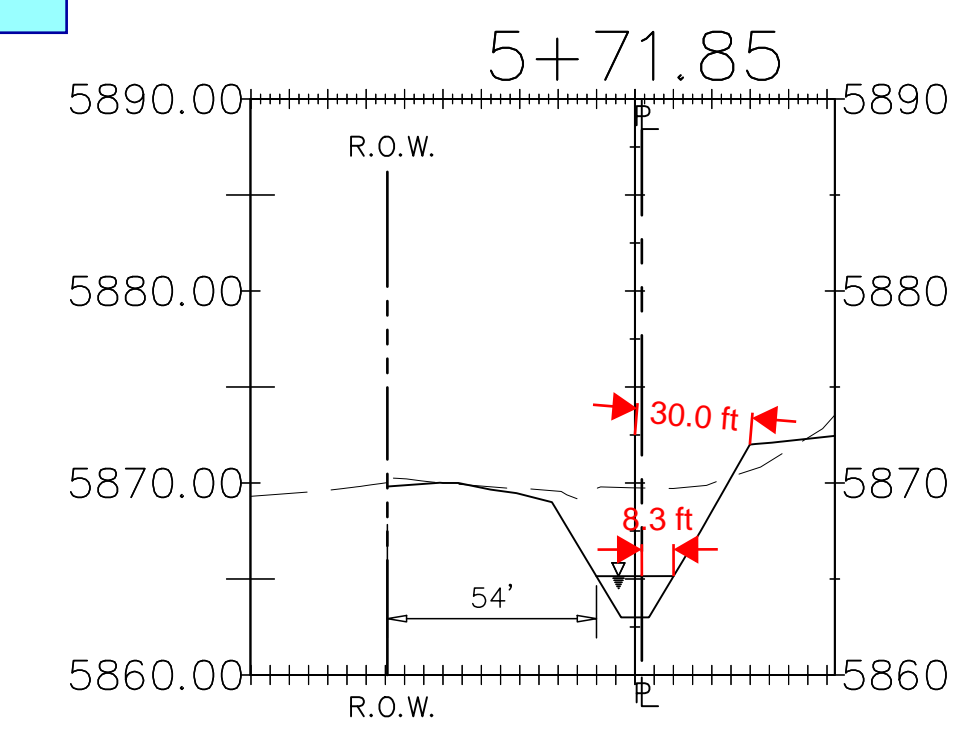
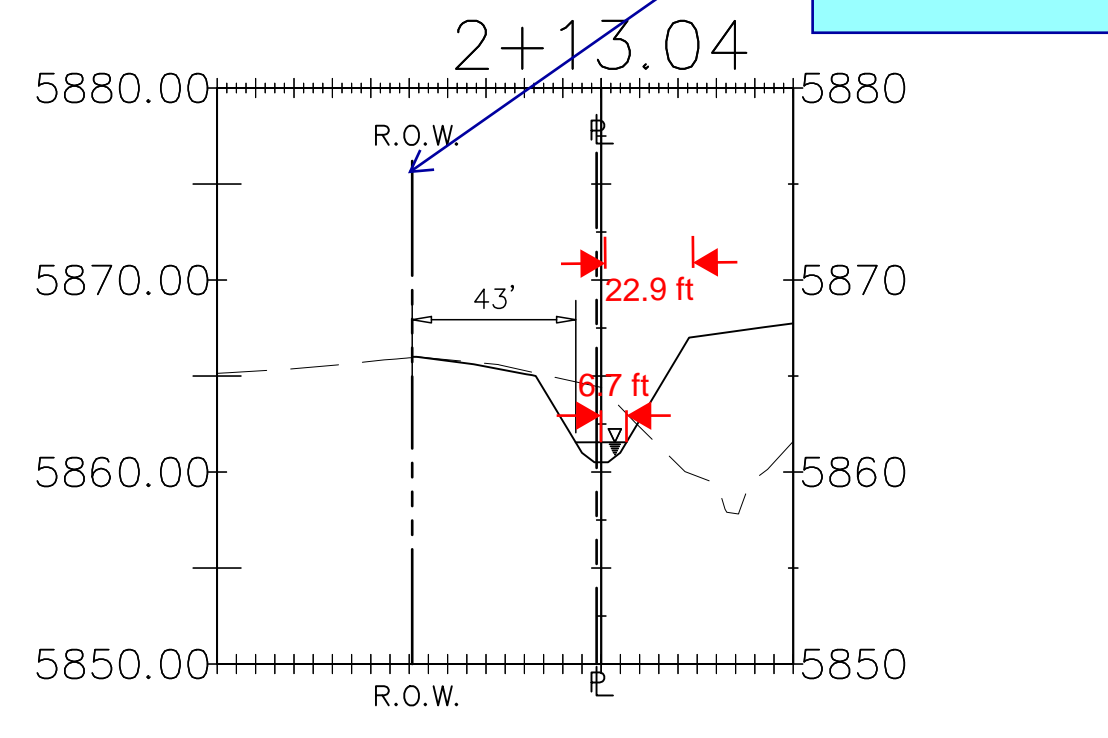
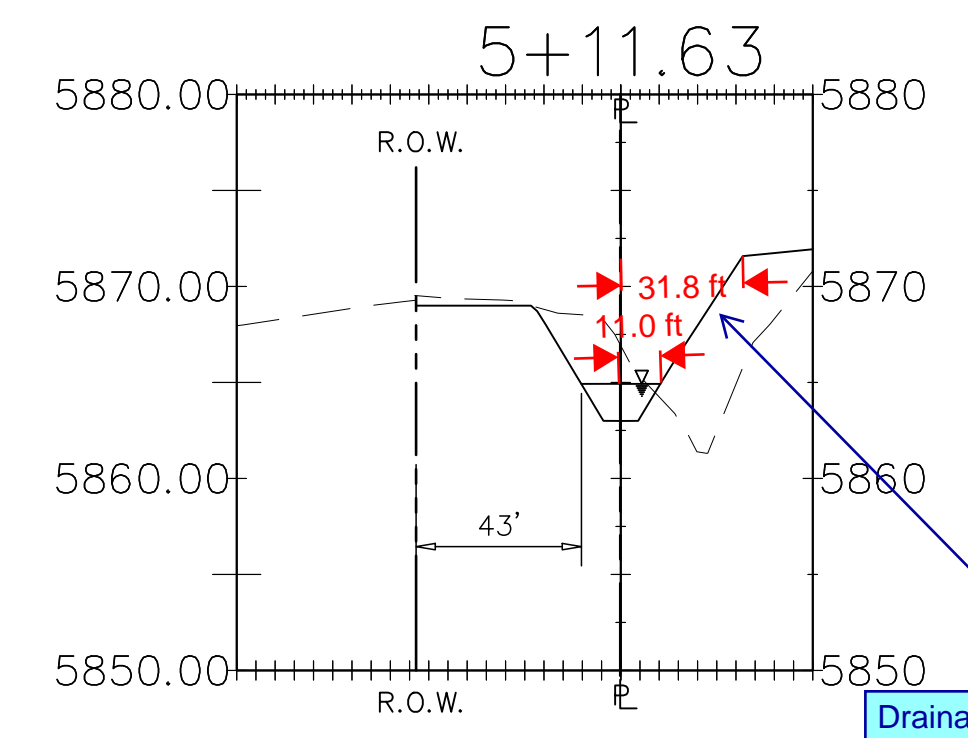
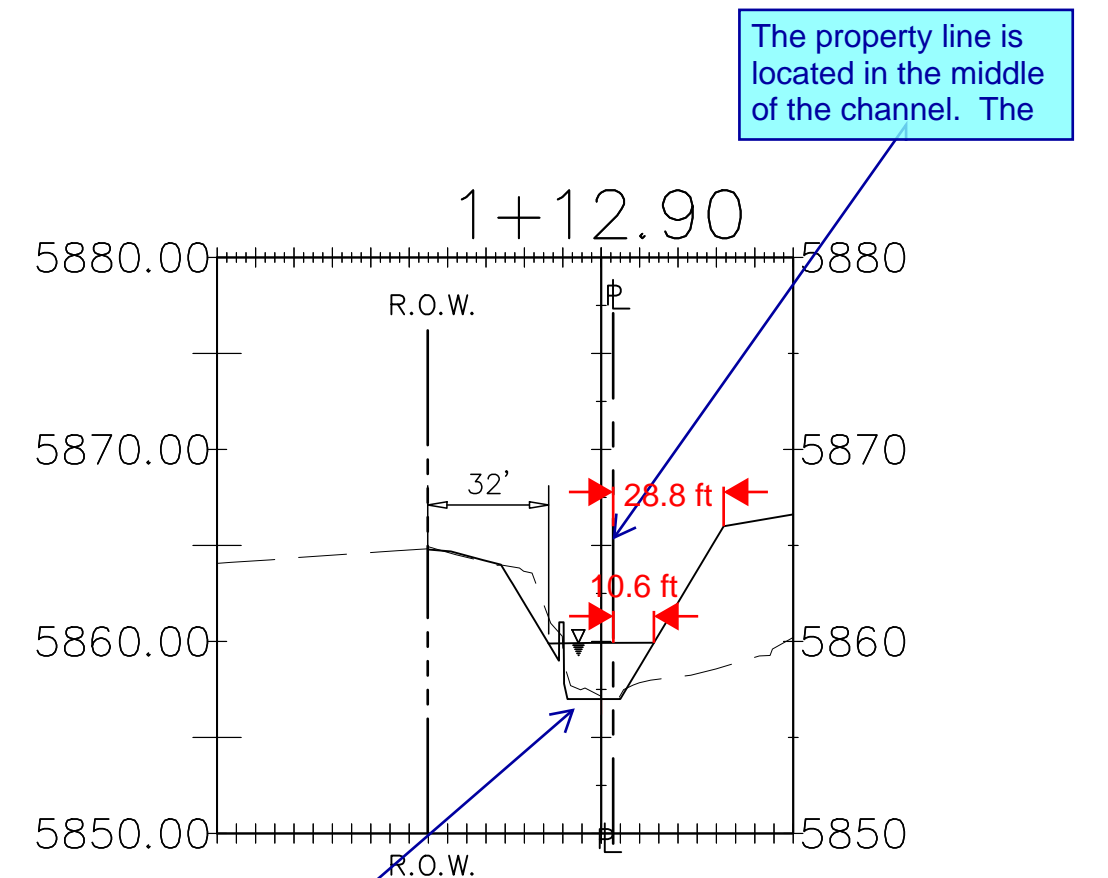
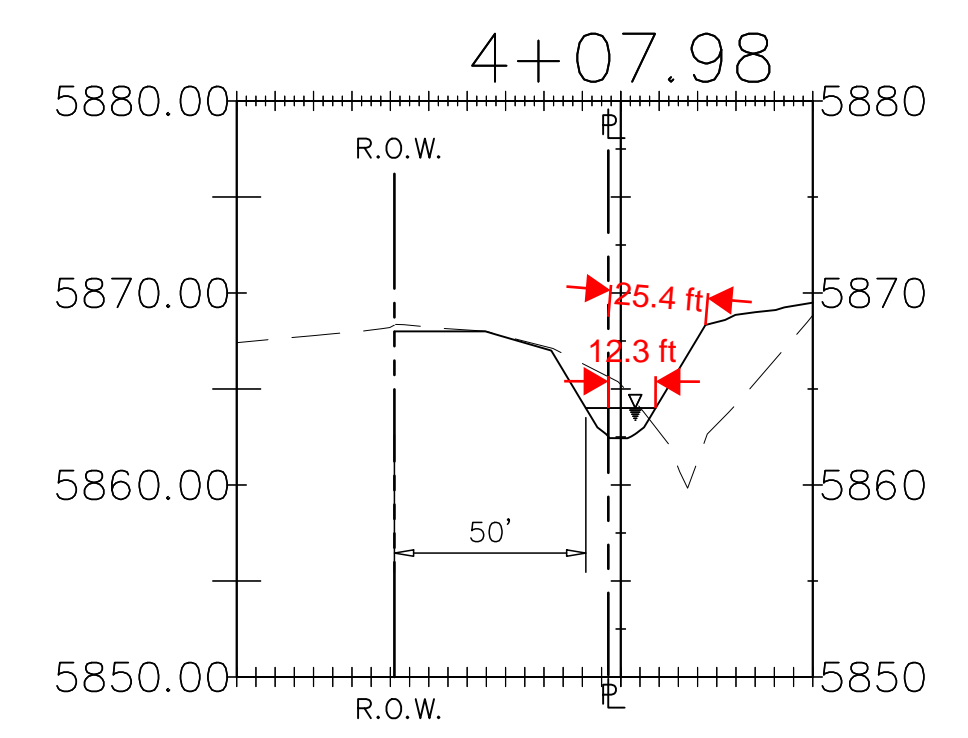


### HORIZONTAL CONTROL FOR GRINNELL DITCH-NORTH ALIGNMENT

MEASURED FROM THE WEST 1/4 CORNER OF SECTION 7, T15S, R65W, TO STA. 0+00 OF THE GRINNELL DITCH NORTH ALIGNMENT; THENCE N19°24'20.17"E A DISTANCE OF 938.234'; THE FOLLOWING TABLE PROVIDES THE HORIZONTAL CONTROL FOR THE GRINNELL DITCH NORTH ALIGNMENT:

Number	Radius	Length	Line/Chord Direction	A Value
L7		101.68	S86° 52' 06.71"E	
C3	205.00	49.38	N2° 10' 51.07"W	
L8		19.61	N9° 04' 51.71"W	
L3		76.08	N14° 49' 16.03"E	
L2		100.00	N4° 04' 35.11"W	
C1	205.00	84.16	N2° 40' 49.87"E	
L5		317.97	N4° 43' 09.58"E	

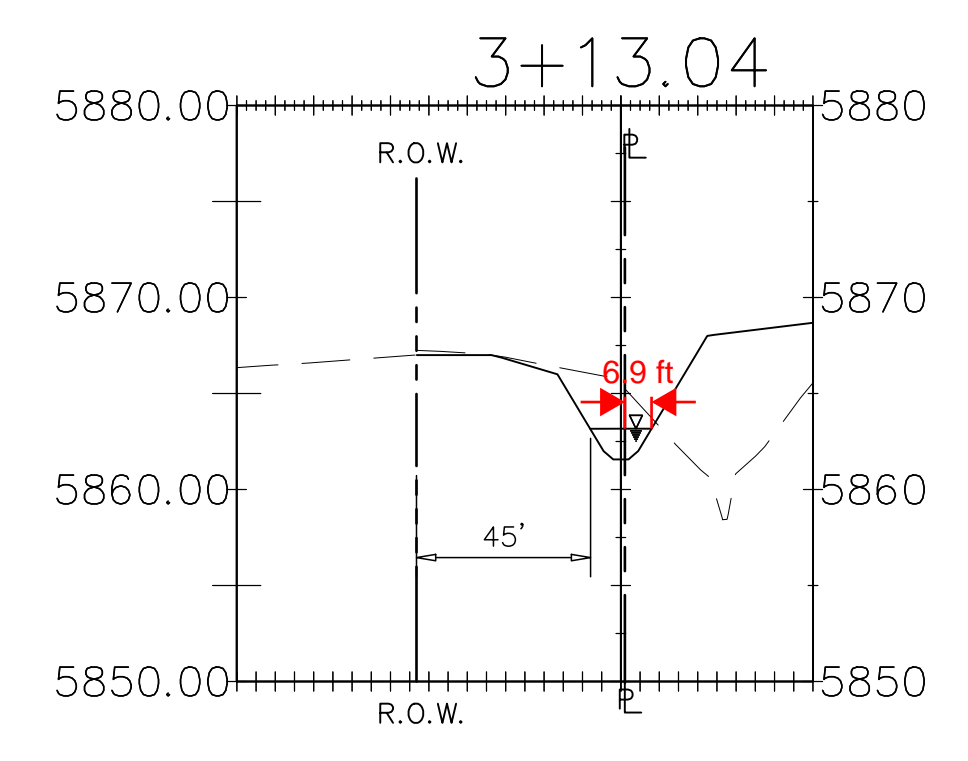

Provide riprap details. Identify the riprap type, length, width, depth. Is there a lining between the riprap and subgrade?

The property line is located in the middle of the channel. The

For all cross sections:  
- Label the station offsets of the toes.  
- Channel bottom width appears to vary  
- Label the existing and proposed grades.

Is this supposed to be the edge of asphalt. Plat only shows a property line.

Drainage easement on the plat was only 25 feet. It should be adjusted to include the entire channel side.

Install a toe wall at the FES

Label channel slopes

**DSE** Dakota Springs Engineering  
 31 N. TOLON, SUITE 600  
 COLORADO SPRINGS, CO 80903  
 F: (719) 227-7392

DESIGNED BY: CEB DATE: 8/15/19  
 DRAWN BY: CEB DATE: 8/15/19  
 CHECKED BY: CC DATE:

SCALE: HORIZ: 1"=50'  
 VERT: 1"=5'  
 STATION: FROM: N/A TO: N/A

**SPRINGS AT WATERVIEW - AMENDED STORM**

GRINNELL DITCH NORTH - PLAN / PROFILE


NO.	DESCRIPTION	DATE

PROJECT NUMBER: 0102.2  
 SHEET NUMBER: 13 OF 19



Z:\2020\cable\Spring\20 Storm\Amend\Storm\102-2 - Storm Amend.dwg, 13A GRINNELL DITCH PROFILE, 8/20/19 7:08:41 PM, ARCT reported (24.00 x 36.00 inches)

PDF: 0102-2 - STORM AMEND.PDF


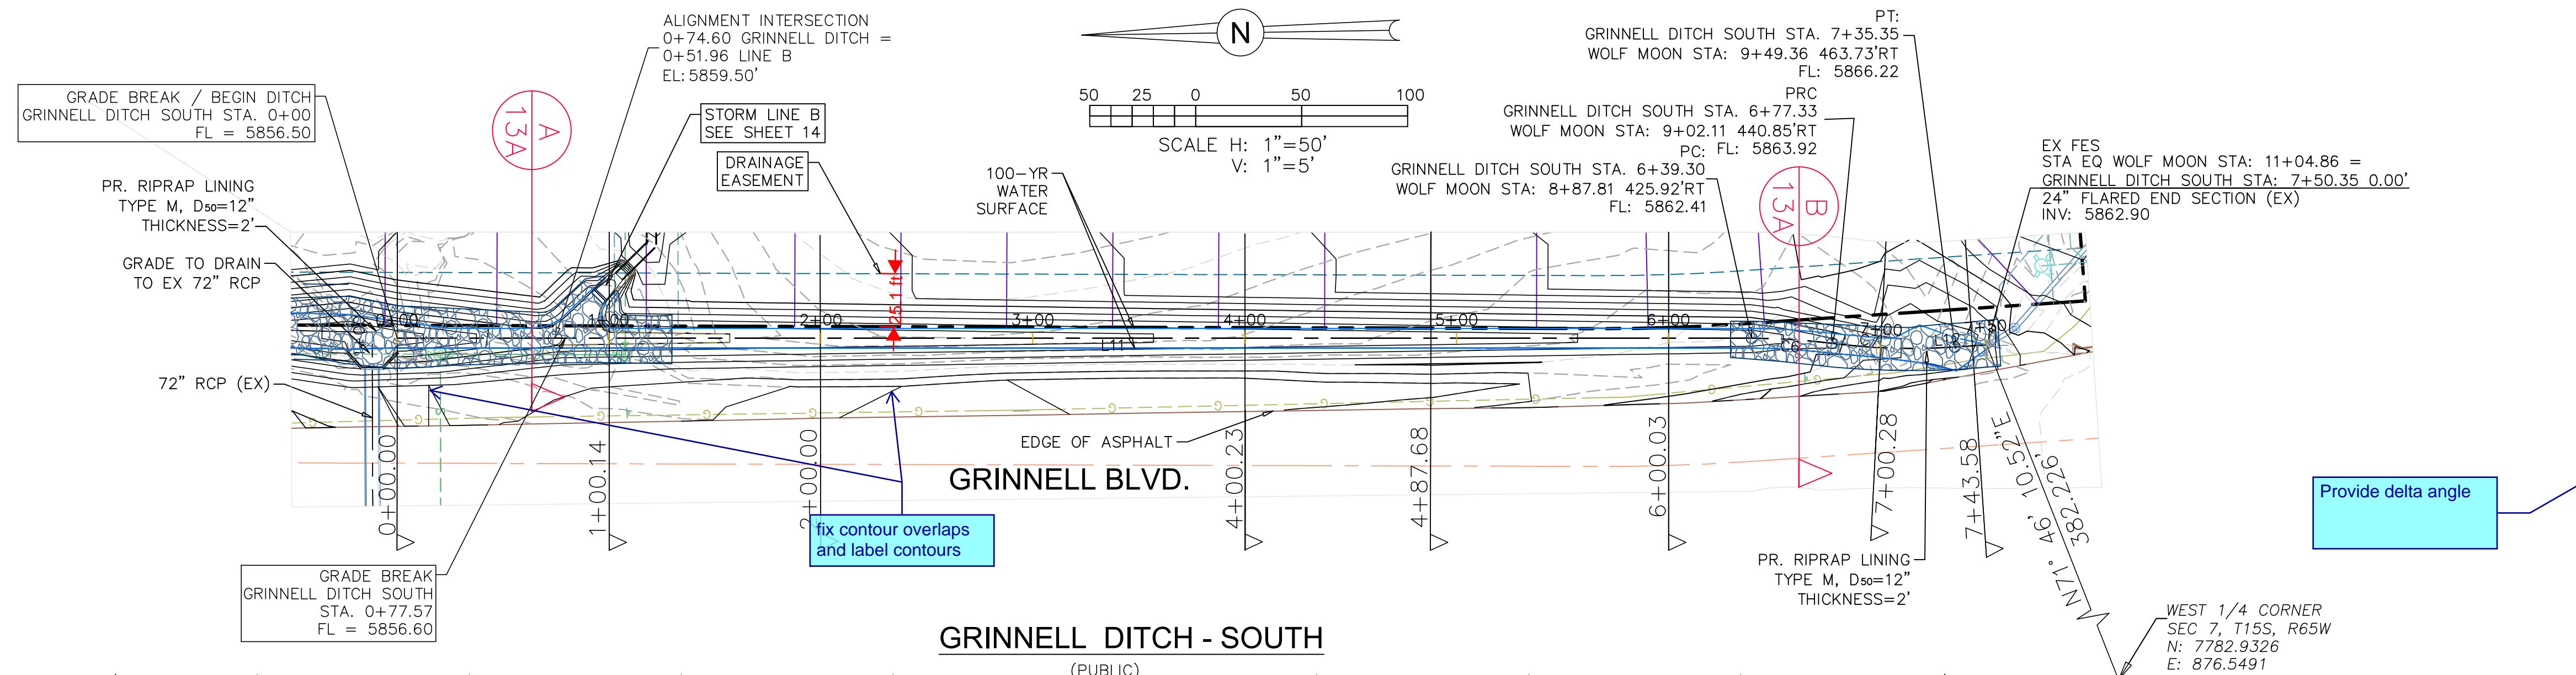


### HORIZONTAL CONTROL FOR GRINNELL DITCH SOUTH

MEASURED FROM THE WEST 1/4 CORNER OF SECTION 7, T15S, R65W, TO STA. 7+49.98 OF THE GRINNELL DITCH SOUTH ALIGNMENT; THENCE N71°46'10.52"E A DISTANCE OF 382.226'; THE FOLLOWING TABLE PROVIDES THE HORIZONTAL CONTROL FOR THE GRINNELL DITCH SOUTH ALIGNMENT:

Number	Radius	Length	Line/Chord Direction	A Value
L12	14.63	50'	S0° 28' 49.00"E	
C7	300.00	58.01	S5° 03' 34.58"W	
C6	300.00	38.04	S6° 58' 01.42"W	
L11	639.30	50'	S3° 20' 04.67"W	

Provide delta angle

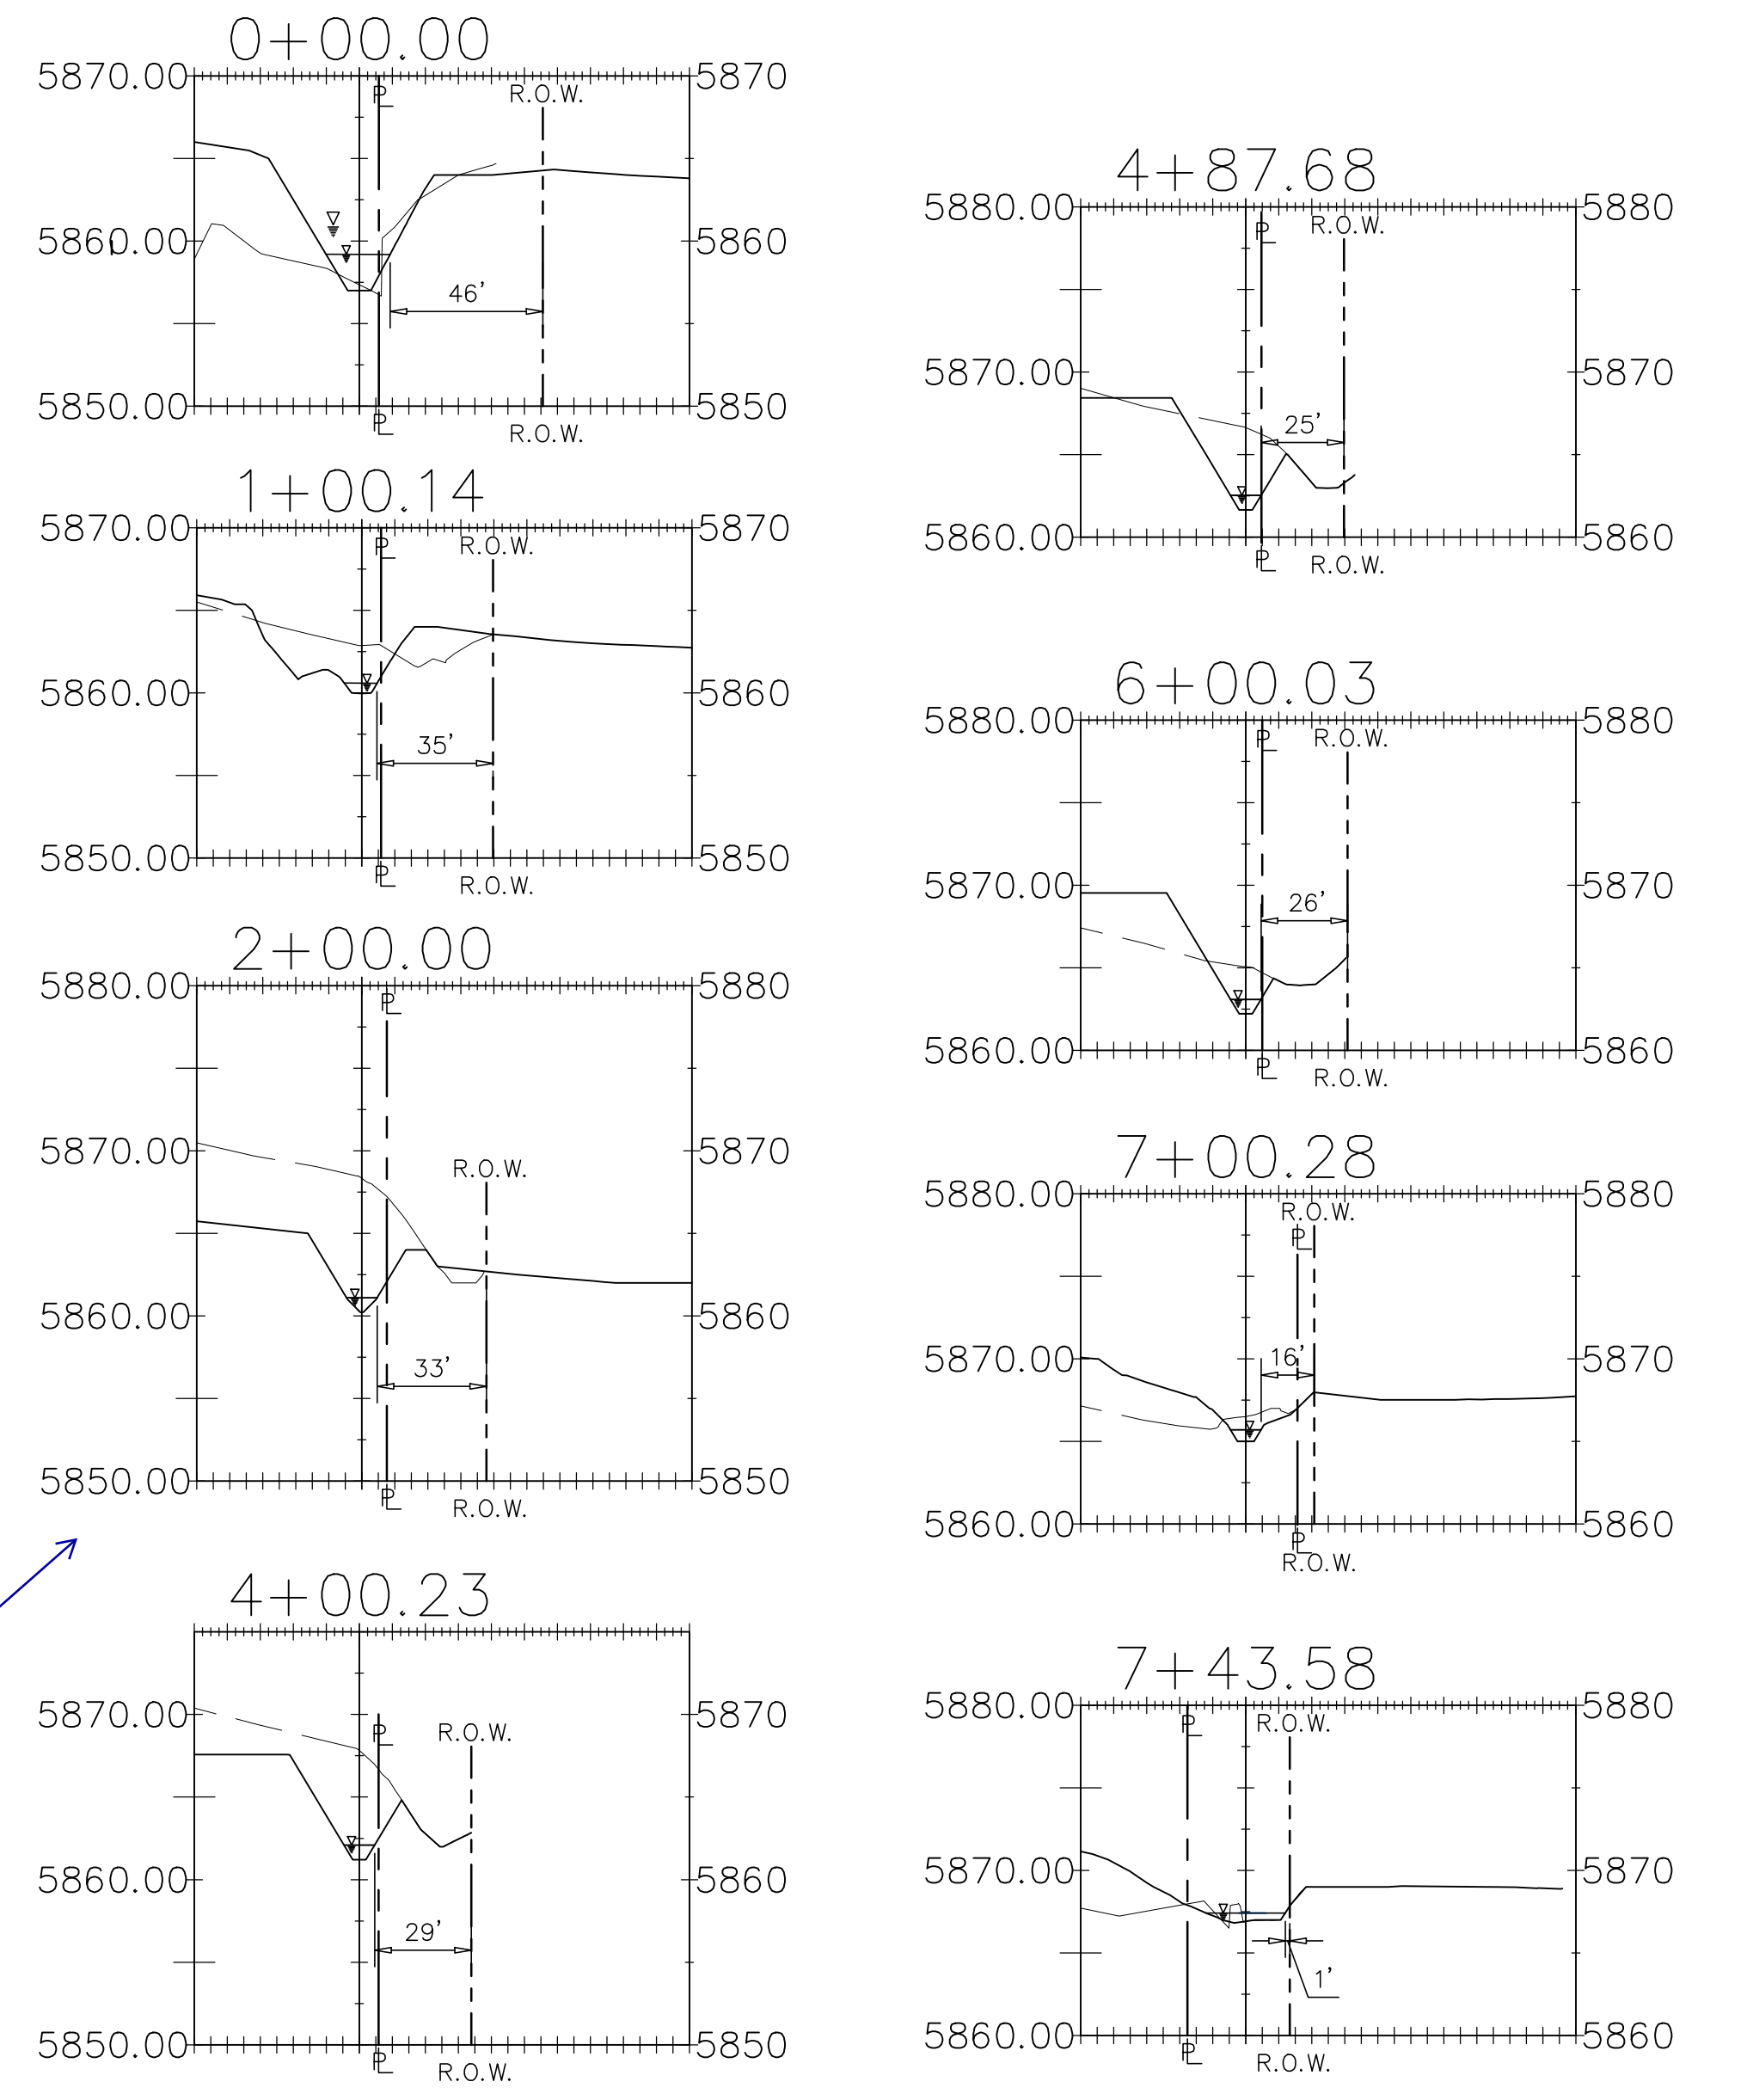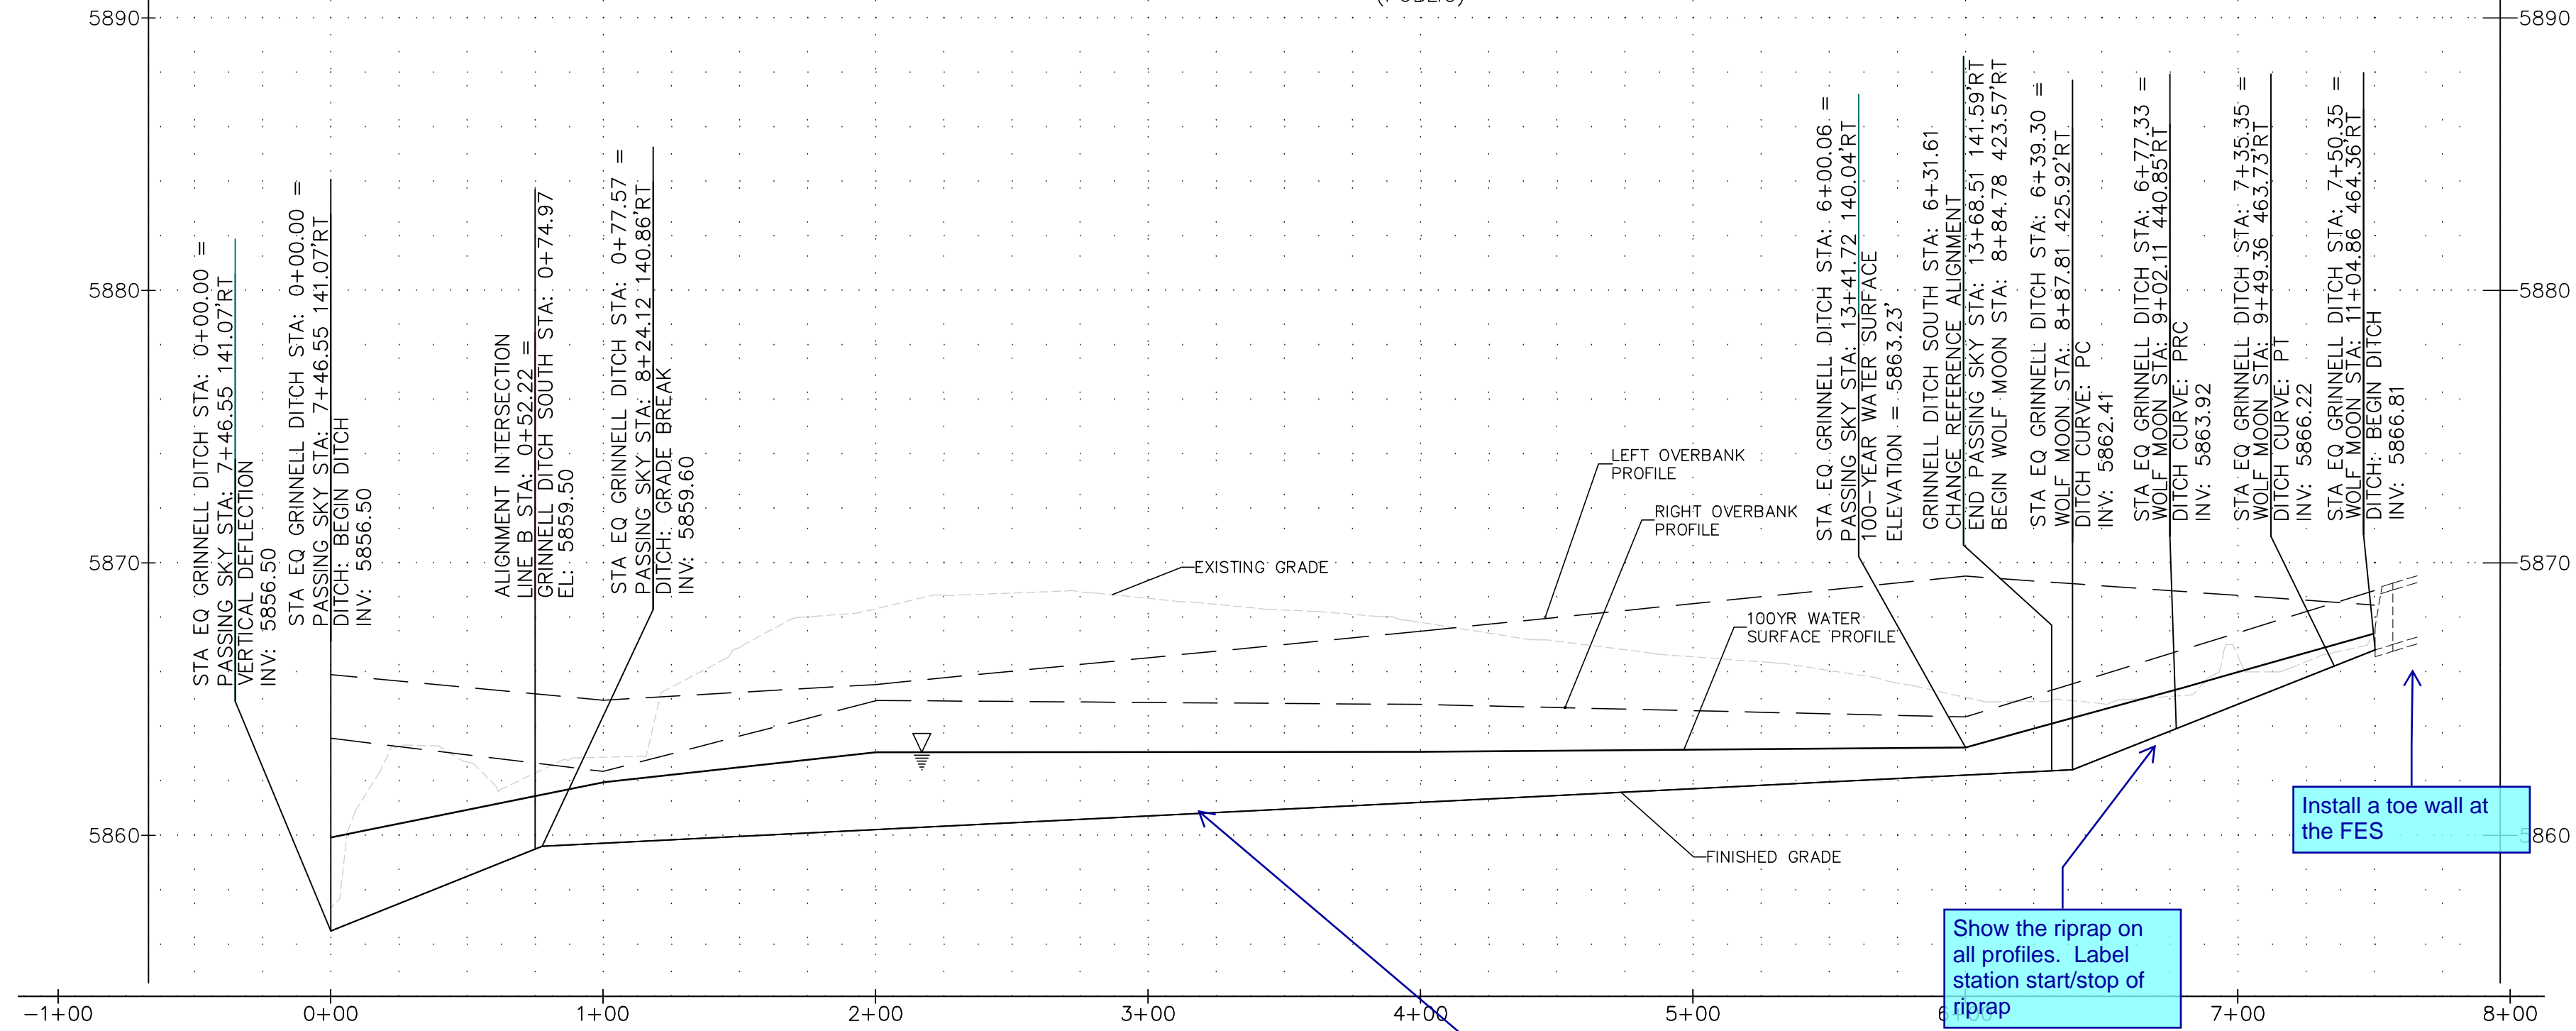



Show the riprap on all profiles. Label station start/stop of riprap

Install a toe wall at the FES

plan view indicates this is edge of asphalt, not ROW

label slopes

See previous page for comments regarding the cross sections

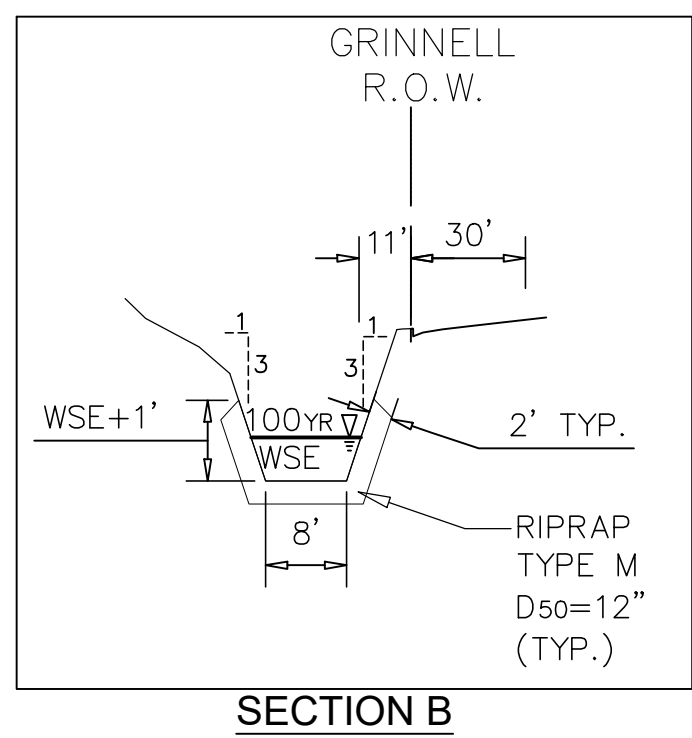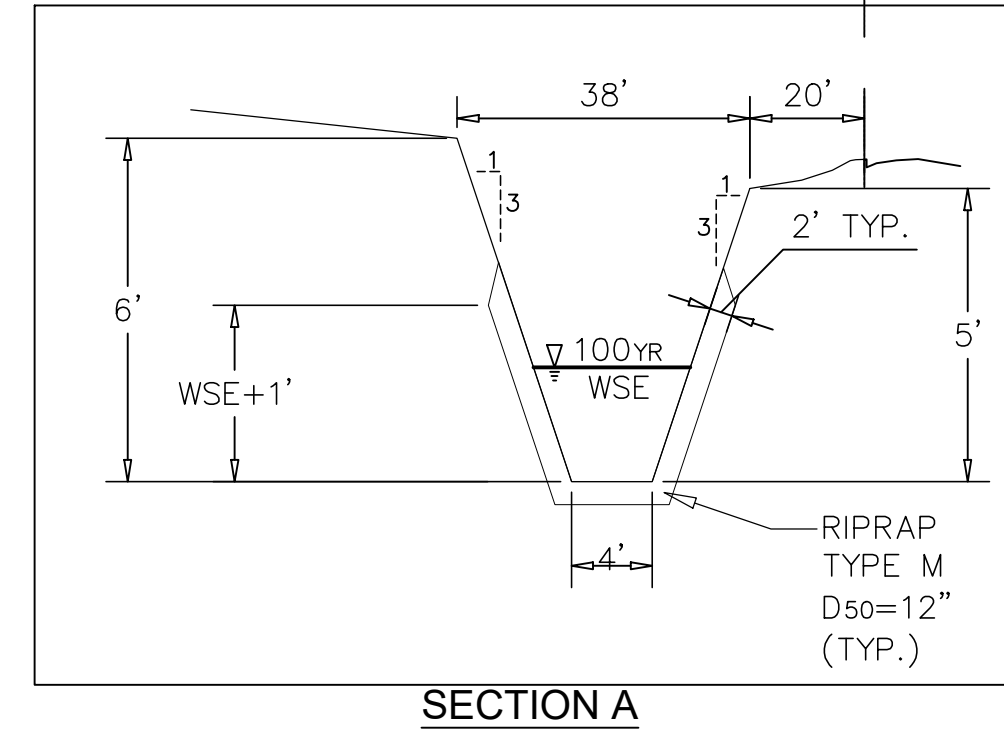

**DSE** Dakota Springs Engineering  
 31 N. TELON, SUITE 500  
 COLORADO SPRINGS, CO 80903  
 P: (719) 227-7388  
 F: (719) 227-7392

48 HOURS BEFORE YOU DIG:  
 CALL UTILITY LOCATORS  
 1-800-922-1987  
 OR CONTACT YOUR LOCAL UTILITIES  
 CITY OF ELECTRIC, WATER AND WASTE WATER

DESIGNED BY: CEB DATE: 8/19/19  
 DRAWN BY: CEB DATE: 8/19/19  
 CHECKED BY: FAK DATE: 8/19/19



SCALE:  
 HORIZ: 1"=50'  
 VERT: 1"=5'  
 STATION: FROM: 0+00 TO: 8+00

## SPRINGS AT WATERVIEW - AMENDED STORM

GRINNELL DITCH SOUTH PROFILE

REVISIONS:	NO.	DESCRIPTION	DATE
PROJECT NUMBER: 0102.2			
SHEET 13A OF 19			



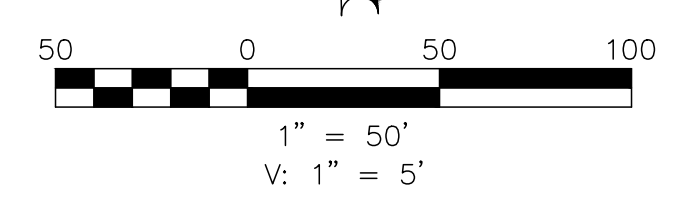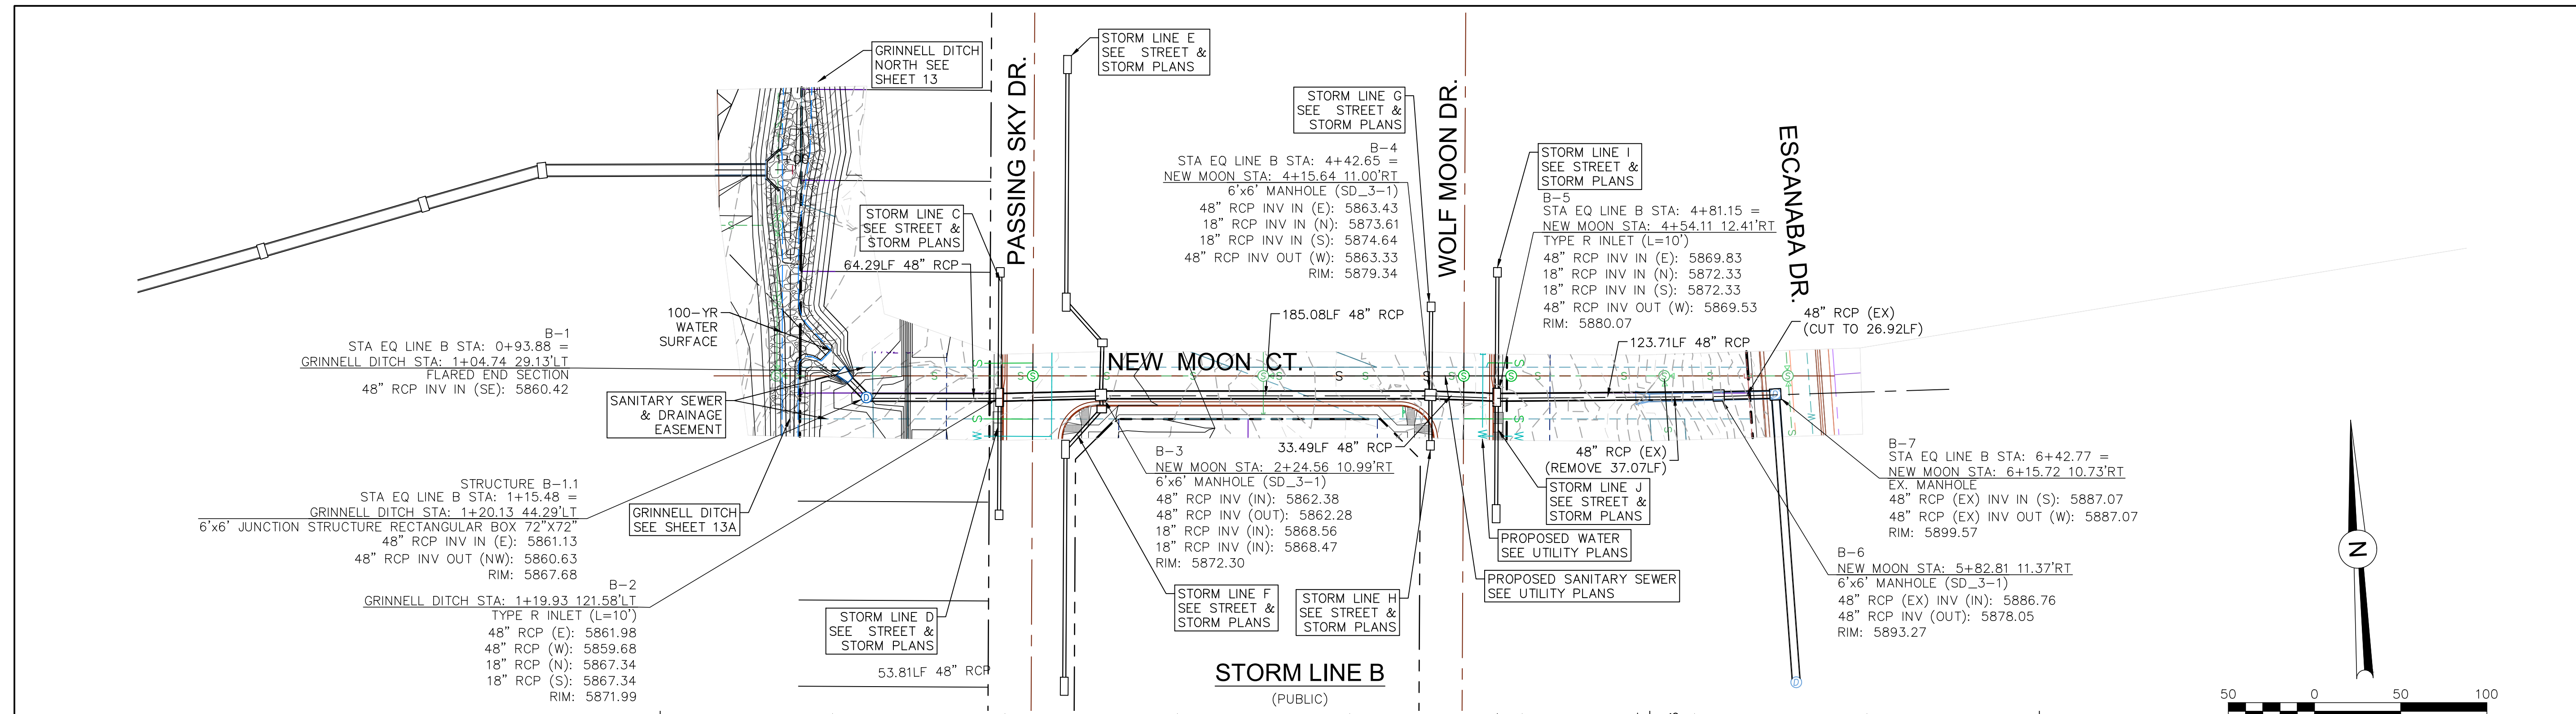

Draw revision cloud around the elements that are revised from the originally approved design.

Per the first review comments, the drainage letter needs address the changes and show the updated calculations. (See snippet below from the review 1 of the drainage letter)

This entire stormline B is completely altered from the originally approved report. Update the drainage letter to have the supporting narrative and calculations.

points 31, 35, 39 and 41 along with all intercepted flows on site.


**Proposed Storm System**

There are three existing storm drain systems that discharge onto or adjacent to the site and one existing system that carries three storm systems. The

Similar comment for the proposed storm. Narrative should be specific to the amendment only. Describing which system is being revised, what is proposed, and explaining the results of the calculations.

**Appendix D: Inlet Design, Runoff Analysis and Channel Design**

Remove any hydraulic analysis not pertinent to this report.

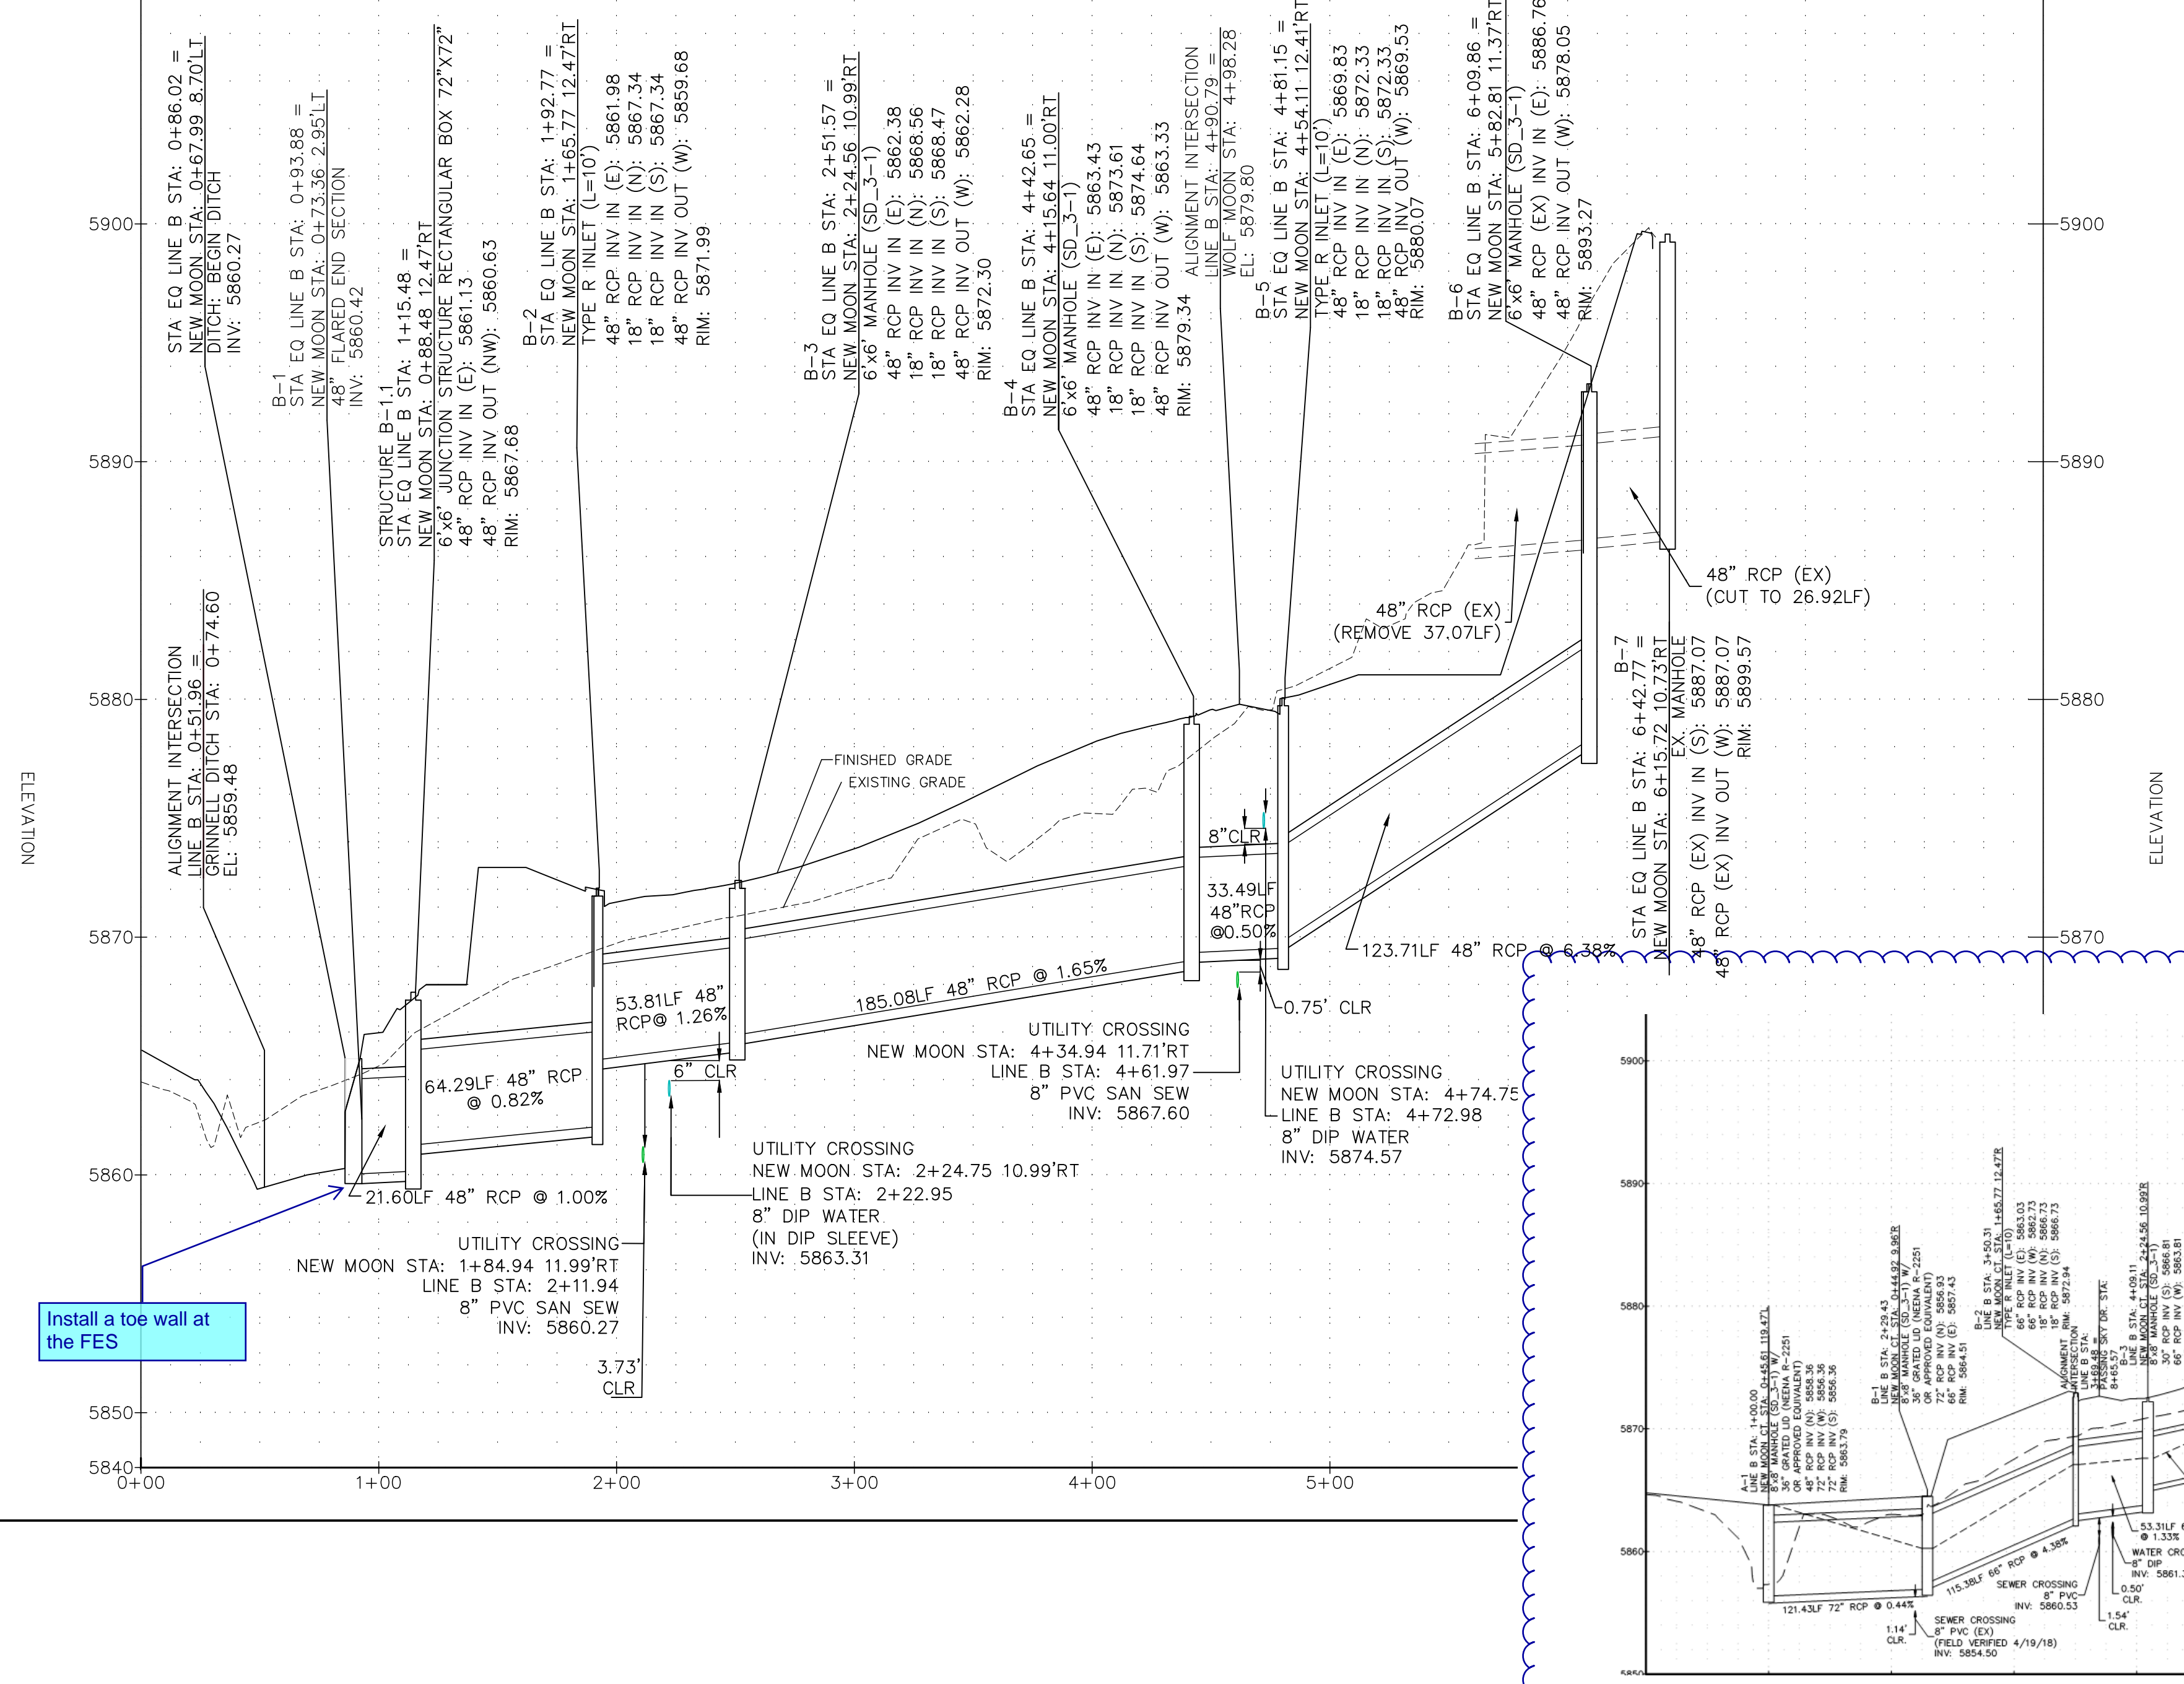

Install a toe wall at the FES

From the approved construction drawings.

**DSE Dakota Springs Engineering**  
 31 N. TEJON, SUITE 500  
 COLORADO SPRINGS, CO 80903  
 P: (719) 227-7388  
 F: (719) 227-7392

DESIGNED BY: CEB DATE: 8/22/19  
 DRAWN BY: CEB DATE: 8/22/19  
 CHECKED BY: DATE:

SCALE: HORIZ: 1"=50'  
 VERT: 1"=5'  
 STATION: FROM: 0+00 TO: 9+00

**SPRINGS AT WATERVIEW - AMENDED STORM**

**STORM B PROFILE**

DATE	DESCRIPTION
08/22/19	14
08/22/19	19

PROJECT NUMBER: 01422