

Memorandum

Dakota Springs Engineering

31 North Tejon Street
Suite 500
Colorado Springs, Colorado 80903
Phone: 719-227-7388
Fax: 719-227-7392

Date: January 23, 2018

To: Ms. Nina Ruiz, Planner II
El Paso County Planning and Community Development

cc: Paul Koscielski
SWV, LLC, CPR Entitlements, LLC

From: Charles K. Cothorn, P.E.

Subject: Waterview Final Plat
SF-16-017

This memorandum has been prepared to address the comments you provided concerning the Springs at Waterview Final Plat in your letter dated November 28, 2017. Your comments are provided below with our response comment immediately following in *italics*.

Also attached is a copy of the updated drawings and reports for your use based on the submittal matrix.

Planning Division

1. The title indicates the mineral rights have been severed.

We reviewed this comment with our title commitment provider and they provided the following answer.

Land Title Guarantee Company has replied as follows:

Per our title commitments, I don't find any evidence of a severance of mineral rights. Perhaps the County is referring to the Patents from the United States which reserve a right of a proprietor of a vein or a lode to follow the vein onto the property if so discovered.

This is standard language in United States Patents, but does not actually sever the mineral rights.

For further clarification, the mineral rights have not been severed and remain with the current owner of the property.

There should be no need to notify any other mineral owner as there are no other mineral owners.

*Ben K. Lowe
Commercial Title Officer
Colorado Title License #137098
Land Title Guarantee Company*

2. Please make all corresponding changes noted on the sketch plan and preliminary plan, including the LOI and TIS.

The Sketch Plan and Preliminary Plan changes have been incorporated

3. The number of units on the subdivision summary does not match the number of the preliminary plan.

All have been corrected to 85

4. The soils report has identified some potentially hazardous areas that are not depicted on the plat.

The areas of concern are related to storm water discharge from existing storm sewers or ditch flow along Grinnell Boulevard. The storm sewers will all be extended by pipe eliminating any discharge to the ground surface. The Grinnell Boulevard ditch will remain and no construction will be near that area. The soils report is referenced on the Plat.

5. The fire protection report includes redlines, please remove.

Removed

6. Engineering has not yet completed their review. Additional comments and redlines will follow.

All have been addressed, see attached.

7. A SIA draft must be submitted.

Provided with upload

Engineering Division

EL PASO COUNTY PUBLIC HEALTH

Please accept the following updated comments from El Paso County Public Health (EPCPH) regarding the project referenced above:

•Water service will be provided by Security Water and Sanitation Districts (CO0121775). There is a finding for sufficiency in terms of water quality for Security Water and Sanitation Districts.

Acknowledged

•Any Colorado Department of Public Health and Environment (CDPHE) regulated additions to the water system will require prior CDPHE approval.

Acknowledged

•Wastewater service will be provided by Security Water and Sanitation Districts (SWSD). The SWSD does have sufficient treatment capacity for the proposed 15.67 acre, 77 residential lot development.

Acknowledged; subdivision has been updated to 85 lots.

•El Paso County Public Health encourages planned walk-ability of residential communities. Please consider appropriate connections to commercial areas through the use of sidewalks, and bike trails. Walk-ability features help reduce obesity and associated heart diseases.

Acknowledged. Access to El Paso County (future) and city trails (future) are provided via sidewalk to Bradley road

•Earthmoving activities Earthmoving activities greater than 25 acres require a Construction Activity Permit from the Colorado Department of Public Health and Environment, Air Pollution Control Division. Go to the El Paso County Public Health site <http://www.elpasocountyhealth.org/service/air-quality> for the link to the Colorado Department of Public Health and Environment, Air Pollution Control Division, for the permit application.

Acknowledged

Mike McCarthy, R.E.H.S.
El Paso County Public Health mikemccarthy@elpasoco.com 719-575-8602
13Nov2017

EL PASO COUNTY COMMUNITY SERVICES DEPARTMENT

Parks

Attached and below, please find comments from the Planning Division of the Community Services Department regarding Springs at Waterview 2106 Sketch Plan Amendment, PUD Development Plan, Preliminary Plan, and Final Plat, as referred to us by the Development Services Department. These comments were endorsed (not all recommendations were endorsed unanimously) by the Park Advisory Board on November 9th. The Board's recommended motion appears below.

Recommended Motion: Springs at Waterview 2016 Sketch Plan Amendment:

“Recommend to the Planning Commission and the Board of County Commissioners that the approval of Springs at Waterview 2016 Sketch Plan Amendment includes the following conditions: (1) the Springs at Waterview 2016 Sketch Plan shall show the Grinnell Boulevard Secondary Regional Trail, (2) fees in lieu of land dedication for regional and urban park purposes will be required time of the recording of the Final Plat.”

Acknowledged; not directly related to this application

Recommended Motion: Springs at Waterview PUD Development Plan:

“Recommend to the Planning Commission and the Board of County Commissioners that the approval of Springs at Waterview PUD Development Plan includes the following conditions: (1) provide additional open space within the current PUD Development Plan and subdivision to accommodate the regional trail on the east side of Grinnell Boulevard, (2) the developer is encouraged to explore urban park options in the form of a neighborhood pocket park or other recreational opportunities, (3) designate and provide to El Paso County a 25-foot trail easement along the east side Grinnell Boulevard that allows for public access, as well as construction and maintenance by El Paso County of a secondary regional trail, the easement shall be shown on the PUD Development Plan, Preliminary Plan, and Final Plat, and the aforementioned easement be dedicated to El Paso County on the Final Plat, (4) and require fees in lieu of land dedication for regional park purposes in the amount of \$26,880 and urban park fees in the amount of \$16,960.”

Acknowledged; not directly related to this application. Zone application has been changed to RS-5000

Recommended Motion: Springs at Waterview Preliminary Plan:

“Recommend to the Planning Commission and the Board of County Commissioners that the approval of Springs at Waterview Preliminary Plan includes the following conditions: (1) provide additional open space within the subdivision to accommodate the regional trail on the east side of Grinnell Boulevard, (2) the developer is encouraged to explore urban park options in the form of a neighborhood pocket park or other recreational opportunities, (3) designate and provide to El Paso County a 25-foot trail easement along the east side Grinnell Boulevard that allows for public access, as well as construction and maintenance by El Paso County of a secondary regional trail, (4) and require fees in lieu of land dedication for regional park purposes in the amount of \$26,880 and urban park fees in the amount of \$16,960.”

Acknowledged; not directly related to this application

Recommended Motion: Springs at Waterview Final Plat:

“Recommend to the Planning Commission and the Board of County Commissioners that the approval of Springs at Waterview Final Plat includes the following conditions: (1)

provide additional open space within the subdivision to accommodate the regional trail on the east side of Grinnell Boulevard, (2) the developer is encouraged to explore urban park options in the form of a neighborhood pocket park or other recreational opportunities, (3) show on the Final Plat and dedicate to El Paso County a 25-foot trail easement along the east side Grinnell Boulevard that allows for public access, as well as construction and maintenance by El Paso County of a secondary regional trail, (4) and require fees in lieu of land dedication for regional park purposes in the amount of \$26,880 and urban park fees in the amount of \$16,960.”

Thanks and please let me know if you have any questions.

Acknowledged

The Planning Division of the Community Services Department has reviewed the development application for the Springs at Waterview Preliminary Plan and Final Plat and has the following comments of behalf of El Paso County Parks. This application will be presented to the Park Advisory Board on December 13, 2017.

The Springs at Waterview Preliminary Plan and Final Plat consists of 77 residential single-family lots on 15.67 acres. The site is located southeast of Colorado Springs, south of the intersection of Powers Boulevard / State Highway 21 and Grinnell Boulevard, northwest of Big Johnson Reservoir. Although zoned currently as A-5, the applicant will seek a zoning reclassification to RS-5000 as the project progresses.

The 2013 Parks Master Plan shows the Grinnell Boulevard Secondary Regional Trail running north-south along the east side of Grinnell Boulevard from Powers Boulevard/State Highway 21 to Fontaine Boulevard where it turns east and connects to McCrae Reservoir and Widefield Community Park. From that point, further trail connections can be made to Crews Gulch Regional Trail, Fountain Creek Regional Park, Ceresa Park, and Fountain Creek Regional Trail. Combined, these are vital trail connections in the Fountain Valley area.

When the Springs at Waterview 2016 Sketch Plan Amendment was first reviewed in July 2017 and subsequently in October 2017, the plans showed the Grinnell Boulevard Secondary Regional Trail on the west side of Grinnell Boulevard, whereas it should be shown on the east side. Furthermore, the Sketch Plan did not display the trail as it continues north of Bradley Road to Powers Boulevard, adjacent to the proposed subdivision.

Prior to the November 2017 Park Advisory Board meeting, Staff met with the applicant, and a decision was made to show the Grinnell Boulevard Secondary Regional Trail on the east side of Grinnell Boulevard south of Bradley Road, and move it to the west side of Grinnell Boulevard, north of Bradley Road, where it will eventually intersect other proposed City of Colorado Springs and Fountain Mutual Metropolitan District trails. During this meeting, Parks staff notified the applicant that El Paso County Parks would request a permanent trail easement on the west side of Grinnell Boulevard as a recommendation of the preliminary plan and final plat. At the November 2017 meeting, the Park Advisory Board endorsed the following recommendations:

“Recommend to the Planning Commission and the Board of County Commissioners that the approval of Springs at Waterview 2016 Sketch Plan Amendment includes the following conditions: (1) designate and provide to El Paso County a 25-foot trail easement along the west side of Grinnell Boulevard, north of Bradley Road, that allows for public access, as well as construction and maintenance by El Paso County of a primary regional trail, (2) the easement shall be shown on all forthcoming preliminary plans and final plats, and the aforementioned easement be dedicated to El Paso County on the forthcoming final plat(s), (3) fees in lieu of land dedication for regional and urban park purposes will be required at time of the recording of the forthcoming final plats.”

Acknowledged; not directly related to this application

The current Preliminary Plan and Final Plat applications do not show the trail easement on the west side of Grinnell Boulevard north of Bradley Road, nor is there mention of the trail easement in the Preliminary Plan or Final Plat general notes or letters of intent. As such, El Paso County Parks recommends that Springs at Waterview Preliminary Plan and Final Plat (1) designate and provide to El Paso County a 25-foot trail easement along the west side of Grinnell Boulevard, north of Bradley Road to Powers Boulevard, that allows for public access, as well as construction and maintenance by El Paso County of the Grinnell Boulevard Secondary Regional Trail, (2) show the easement on the Preliminary Plan and Final Plat, and dedicate the aforementioned easement to El Paso County prior to the recording of the Final Plat, (3) and pay fees in lieu of land dedication for regional and urban park purposes at time of the recording of the Final Plat.

The future trail on the west side of Grinnell Boulevard has been shown on the Sketch Plan with the owner's approval and acknowledgement. The future trail on the west side of Grinnell Boulevard is not within the boundaries of the current Preliminary Plan and Final Plat application. When the property on the west side of Grinnell Boulevard is platted easements will be granted.

*Recommended Motion: Springs at Waterview Preliminary Plan:

“Recommend to the Planning Commission and the Board of County Commissioners that the approval of Springs at Waterview Preliminary Plan includes the following conditions: (1) designate and provide to El Paso County a 25-foot trail easement along the west side of Grinnell Boulevard, north of Bradley Road to Powers Boulevard, that allows for public access, as well as construction and maintenance by El Paso County of the Grinnell Boulevard Secondary Regional Trail, (2) fees in lieu of land dedication for regional park purposes in the amount of \$31,339 and urban park fees in the amount of \$19,789 will be required at time of the recording of the Final Plat.”

The future trail on the west side of Grinnell Boulevard has been shown on the Sketch Plan with the owner's approval and acknowledgement. The future trail on the west side of Grinnell Boulevard is not within the boundaries of the current Preliminary Plan and Final Plat application. When the property on the west side of Grinnell Boulevard is platted easements will be granted.

*Recommended Motion: Springs at Waterview Final Plat:

“Recommend to the Planning Commission and the Board of County Commissioners that the approval of Springs at Waterview Final Plat includes the following conditions: (1) show on the Final Plat and dedicate to El Paso County a 25-foot trail easement along the west side of Grinnell Boulevard, north of Bradley Road to Powers Boulevard, that allows for public access, as well as construction and maintenance by El Paso County of the Grinnell Boulevard Secondary Regional Trail, (2) require fees in lieu of land dedication for regional park purposes in the amount of \$31,339 and urban park fees in the amount of \$19,789.”

The future trail on the west side of Grinnell Boulevard has been shown on the Sketch Plan with the owner's approval and acknowledgement. The future trail on the west side of Grinnell Boulevard is not within the boundaries of the current Preliminary Plan and Final Plat application. When the property on the west side of Grinnell Boulevard is platted easements will be granted.

Please let me know if you have any questions or concerns. Sincerely,
Ross A. Williams Park Planner Planning Division
Community Services Department rosswilliams@elpasoco.com

EL PASO TELLER COUNTY 911

Passing Sky Dr – Acceptable, Logical Continuation Blue Moon Ct – Not Acceptable, existing road name. “Wolf Moon Ct” was previously approved for this project, this could be used as an alternative to Blue Moon. New Moon Ct – Acceptable, previously approved for this project Thank you Justin

Acknowledged

PIKES PEAK REGIONAL BUILDING DEPARTMENT

Enumerations

Enumerations has the following comments: Grinnell road is incorrect; should be Grinnell Blvd. DEVELOPMENT PLAN STAGE: FOR TRACT AND LOT ADDRESSING PLACE (XXXX) WHERE THEY INTEND TO BE UTILIZED. CONTACT ENUMERATIONS DEPARTMENT FOR ADDRESSING. AMY@PPRBD.ORG OR BRENT@PPRBD.ORG FINAL PLAT STAGE: ENUMERATIONS/FLOODPLAIN WILL REVIEW THE MYLAR PRIOR TO PLAT FOR ADDRESS PLACEMENT, ROAD NAMING, TITLE BLOCK, & FLOODPLAIN STATEMENT. \$10.00 PER LOT & TRACT FEE WILL BE DUE AT THE TIME OF THE REVIEW OF THE MYLAR. IF AN ADDRESS IS NOT NEEDED ON A TRACT THEN NO FEE APPLIES. CHECK SHOULD BE MADE OUT TO PIKES PEAK REGIONAL BUILDING DEPARTMENT. PAID DIRECTLY TO ENUMERATIONS DEPARTMENT. A COPY OF THE FINAL RECORDED PLAT IS REQUIRED PRIOR TO PLAN SUBMITTAL FOR RESIDENTAL.

Acknowledged

COLORADO SPRINGS AIRPORT

At the Airport Advisory Commission meeting held on Wednesday, October 26, 2016, the Commissioners approved the “no objection” recommendations/comments for the subject land use review items.

Airport staff has no additional comments beyond those already submitted.

Acknowledged

Due to the number of comments and necessary revisions to the plan(s) an additional detailed review will be necessary. Please address the comments as listed above. A detailed letter needs to accompany the revisions to allow for an expeditious re-review timeframe. The letter should include each comment listed above and, immediately thereafter, include a response from the applicant addressing the comment.

If any review agency has an issue that needs resolution or requires a revision, you will need to provide the necessary documents, drawings, etc., to the Development Services Department in the form of a resubmittal. The Development Services Department will then forward the resubmitted items directly to the appropriate review agency. If you have any questions pertaining to specific agency comments please contact the appropriate agency directly.

PLEASE NOTE: The application cannot be scheduled for public hearing until and unless a final response has been received by Development Services from those agencies that are required (pursuant to state statute and the El Paso County Land Development Code) to provide such response (i.e.- State Engineer’s Office, County Attorney’s Office, County Health Department, etc.).

Acknowledged

If you have any questions feel free to contact me at (719) 432-6889.
Sincerely,


Charles K. Cothorn, P.E.
Dakota Springs Engineering



Subject: Callout
Page Label: 12
Lock: Locked
Author: dsdlaforce

Add a section describing each of the 4 step process for BMP selection and how these were implemented/considered. See ECM Appendix I Section I.7.2 for the County's 4 step process.

ADDED

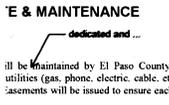

Subject: Callout
Page Label: 12
Lock: Locked
Author: dsdlaforce

dedicated and ...


ADDED



Subject: Callout
Page Label: 13
Lock: Locked
Author: dsdlaforce

Remove. Only facilities specifically identified as such in the DBPS are reimbursable. The storm sewer extensions needed to develop this subdivision are not reimbursable.


REMOVED

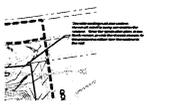

Subject: Callout
Page Label: 21
Lock: Locked
Author: dsdlaforce

ADDED TO PLANS - ADDRESSED IN REPORT


Show the existing road and rundown. How much runoff is being conveyed by the rundown. Since the construction plans shows this to remain, provide the channel analysis for the proposed condition from the rundown to the inlet.

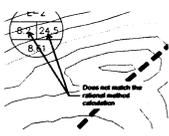

Subject: Callout
Page Label: 21
Lock: Locked
Author: dsdlaforce

Does not match the rational method calculation


UPDATED

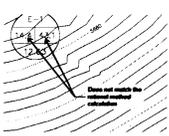

Subject: Callout
Page Label: 21
Lock: Locked
Author: dsdlaforce

Does not match the rational method calculation

UPDATED

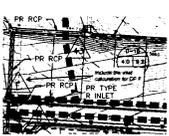

Subject: Callout
Page Label: 23
Lock: Locked
Author: dsdlaforce

Include the inlet calculation for DP F


ADDED



Subject: Cloud+
Page Label: 23
Lock: Locked
Author: dsdlaforce

Delineate the spread of the 100yr runoff.


ADDED TO PLAN

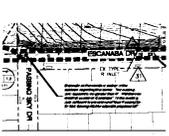

Subject: Callout
Page Label: 23
Lock: Locked
Author: dsdlaforce

NEED YOUR HELP ON THIS ONE - NOTED IN RPT


Elaborate on the narrative section of the subbasin regarding this corner. The existing curb appears to be greater than 6". Will there be direct lot access on Escanaba? Is the existing curb sufficient to prevent runoff from Passing Sky Dr from flowing into the adjacent proposed lot?

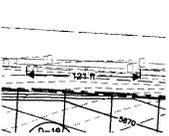

Subject: Length Measurement
Page Label: 23
Lock: Locked
Author: dsdlaforce

121 ft


Removed

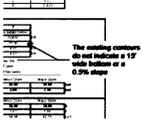

Subject: Callout
Page Label: 78
Lock: Locked
Author: dsdlaforce

The existing contours do not indicate a 15' wide bottom or a 0.5% slope

CHANGED

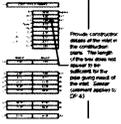


Subject: Callout
Page Label: 79
Lock: Locked
Author: dsdlaforce

Provide construction details of the inlet in the construction plans. The length of the box does not appear to be sufficient for the pipe going in/out of the inlet. Similar comment applies to DP 43

~~DOUBLE INLETS~~
DOUBLE INLETS
STANDARD
CHANGE TO BOX MANHOLES
W/GRATE TOPS

THE SPRINGS AT WATERVIEW FILING NO. 1
 A SUBDIVISION OF A PORTION OF THE NORTHWEST 1/4 OF SECTION 7,
 TOWNSHIP 15 SOUTH, RANGE 66 WEST OF THE 6TH P.M.
 EL PASO COUNTY, COLORADO
 SHEET 2 OF 2

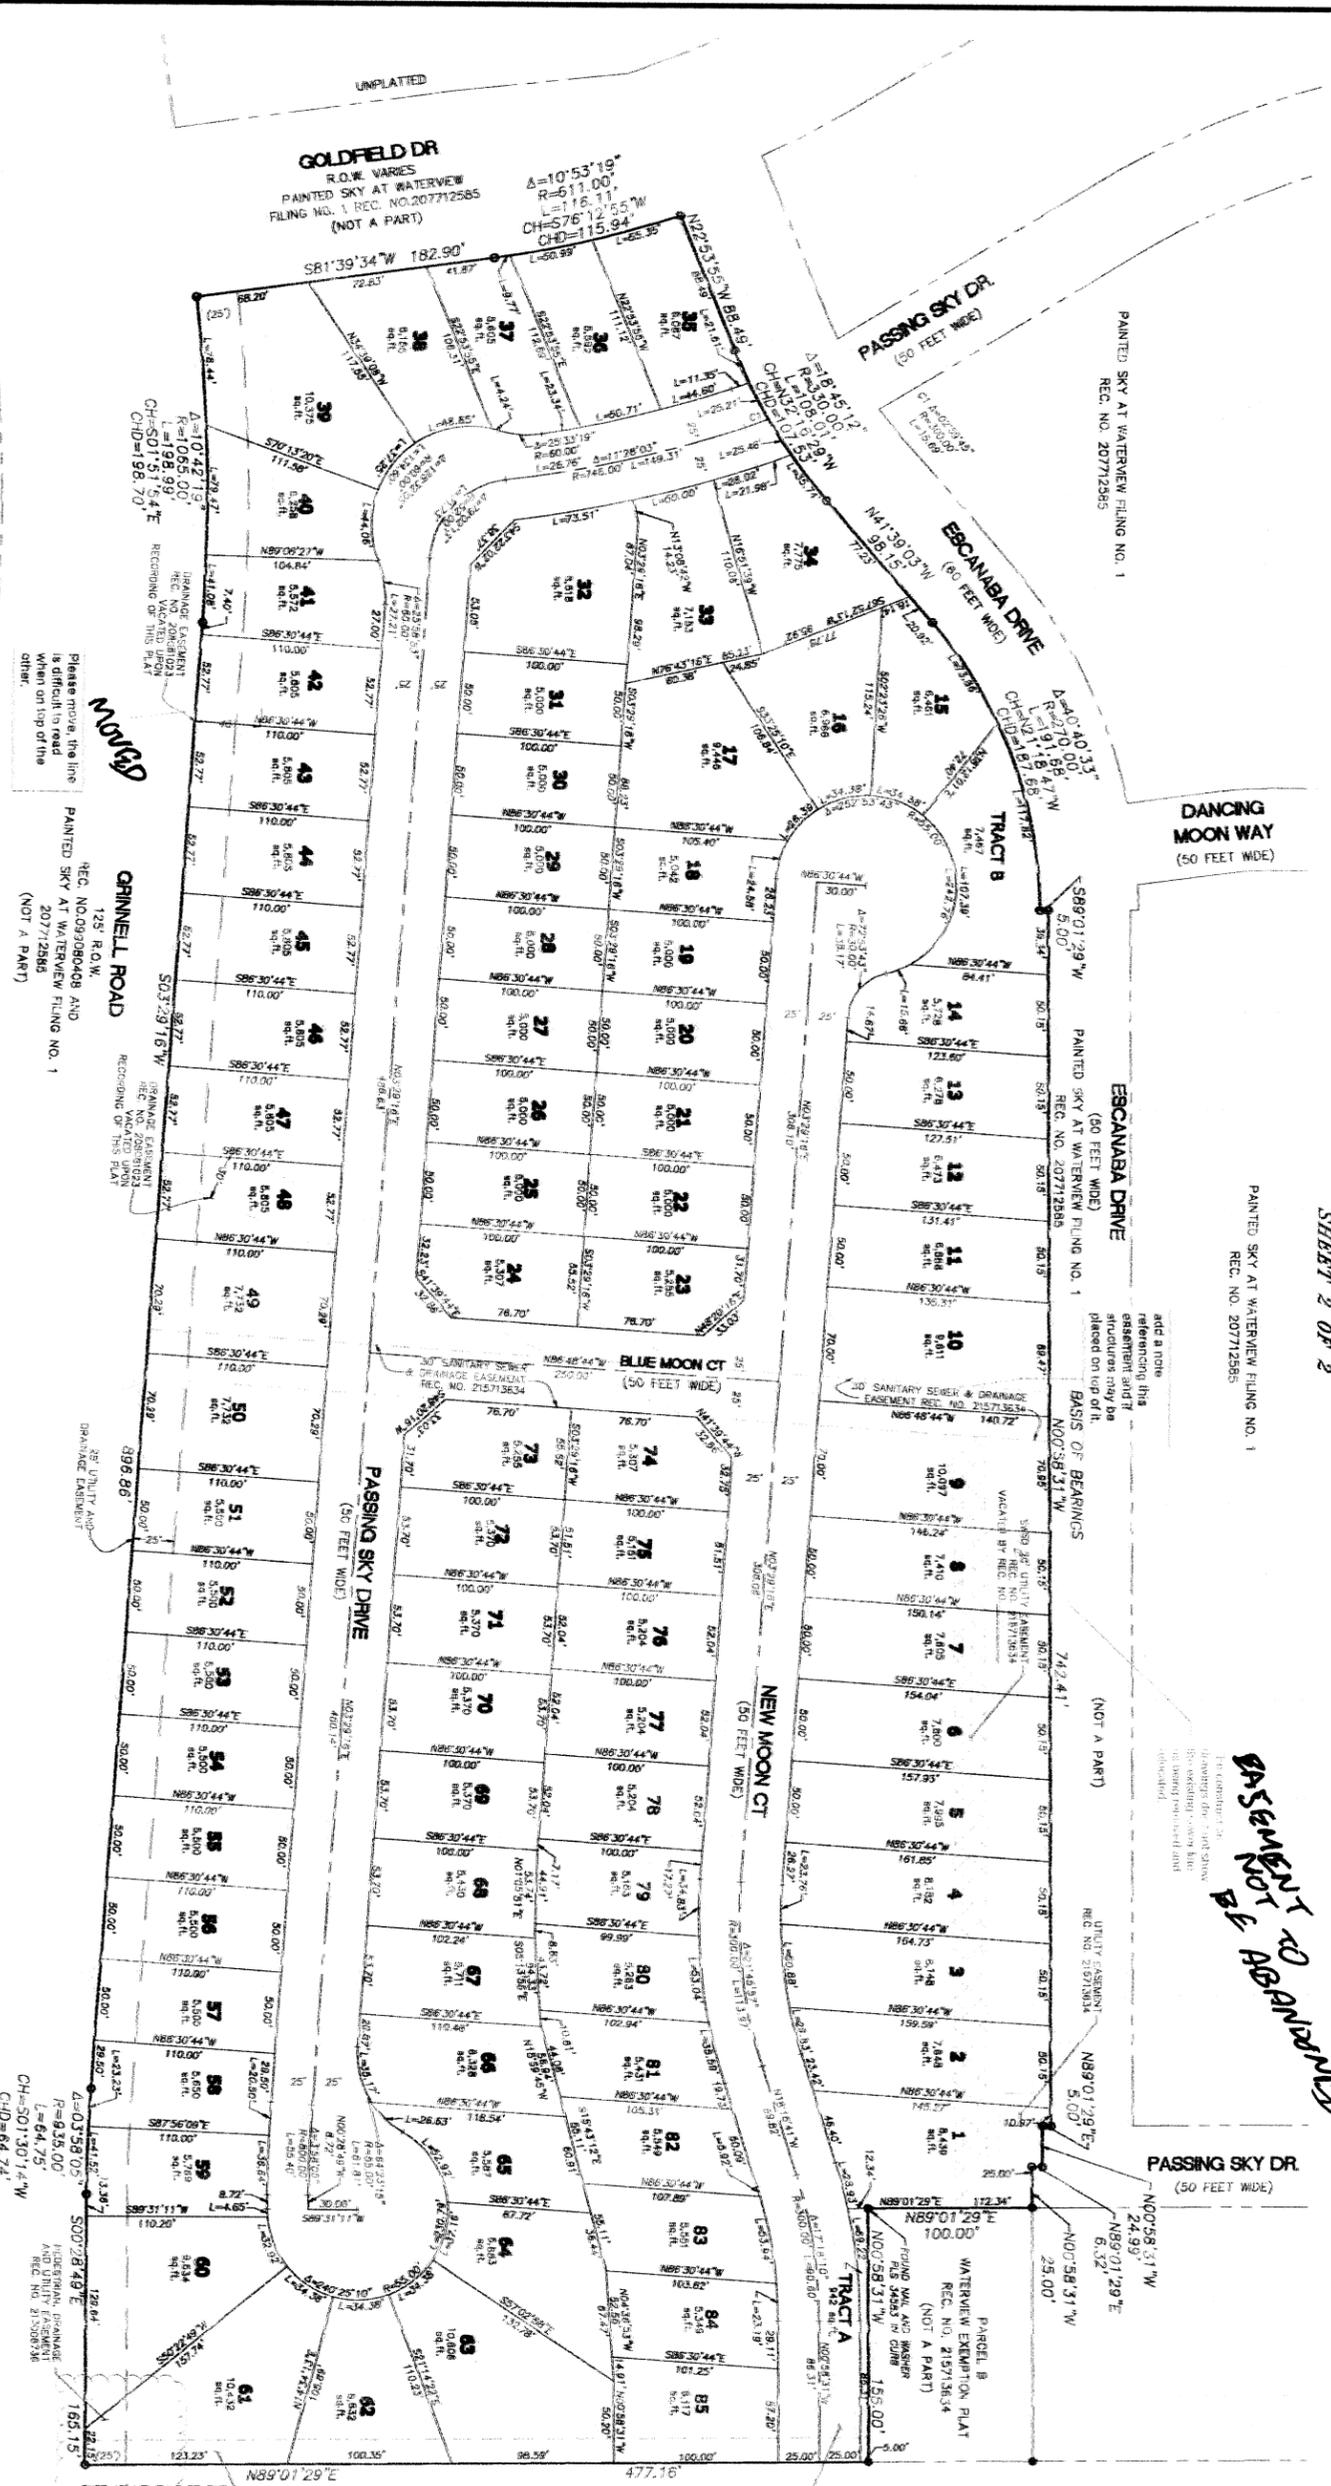

PAINTED SKY AT WATERVIEW FILING NO. 1
 REC. NO. 207712585

PAINTED SKY AT WATERVIEW FILING NO. 1
 REC. NO. 207712585

PAINTED SKY AT WATERVIEW FILING NO. 1
 REC. NO. 207712585

BASEMENT 10 APPROXIMATED
 BY *ADP*

and a note referring this easement and its structures may be placed on top of it.

UTILITY EASEMENT REC. NO. 215713634

UNPLATTED
 CH=576.12, 5.7°W
 CHD=115.94'
 Δ=10°53'19"
 R=611.00'
 L=116.21'
 Δ=10°53'19"
 R=611.00'
 L=116.21'

UNPLATTED
 CH=576.12, 5.7°W
 CHD=115.94'
 Δ=10°53'19"
 R=611.00'
 L=116.21'

- LEGEND**
- ◆ PLS. CORNER
 - FOUND NO.5 REBAR WITH CAP
 - PLS. 30083 AT GRADE
 - FOUND NO.4 REBAR AND CAP
 - PLS. 34583 (UNLESS SHOWN OTHERWISE)
 - (1145) ADDRESS FROM ENUMERATIONS
 - (100007) EASEMENT DIMENSION
 - (NR) NON-RADIAL BEARING
 - SWAD SECURITY WATER & SANITATION DISTRICT
 - EXISTING EASEMENT
 - PROPOSED EASEMENT
 - EXISTING ROW

OWNER/DEVELOPER
 FRANK W. HOWARD #2 LIMITED PARTNERSHIP, LLP
 ADDRESS: _____
 PHONE: _____

ENGINEER/SURVEYOR
 DAKOTA SPRINGS ENGINEERING
 31 N. TELON STREET, SUITE 500
 COLORADO SPRINGS, CO 80903
 (719) 227-7388

DATE OF PREPARATION
 JULY 2016

ADD setback line showing when lots are 50' in width for those that are not 50' at the boundary.
ADP

UNPLATTED
 CH=576.12, 5.7°W
 CHD=115.94'
 Δ=10°53'19"
 R=611.00'
 L=116.21'





UNPLATTED
 CH=576.12, 5.7°W
 CHD=115.94'
 Δ=10°53'19"
 R=611.00'
 L=116.21'

BRADLEY ROAD
 ROW VARIES
 BK. 502, PGS. 500 & 555
 AND
 PAINTED SKY AT WATERVIEW FILING
 NO. 1
 207712585
 (NOT A PART)

CH=576.12, 5.7°W
 CHD=115.94'
 Δ=10°53'19"
 R=611.00'
 L=116.21'



DSEB *Dakota Springs Engineering*
 31 N. TELON SUITE 500
 COLORADO SPRINGS, CO 80903
 PHONE: (719) 227-7388
 DATE: 4/18/2017
 SHEET 2 OF 2

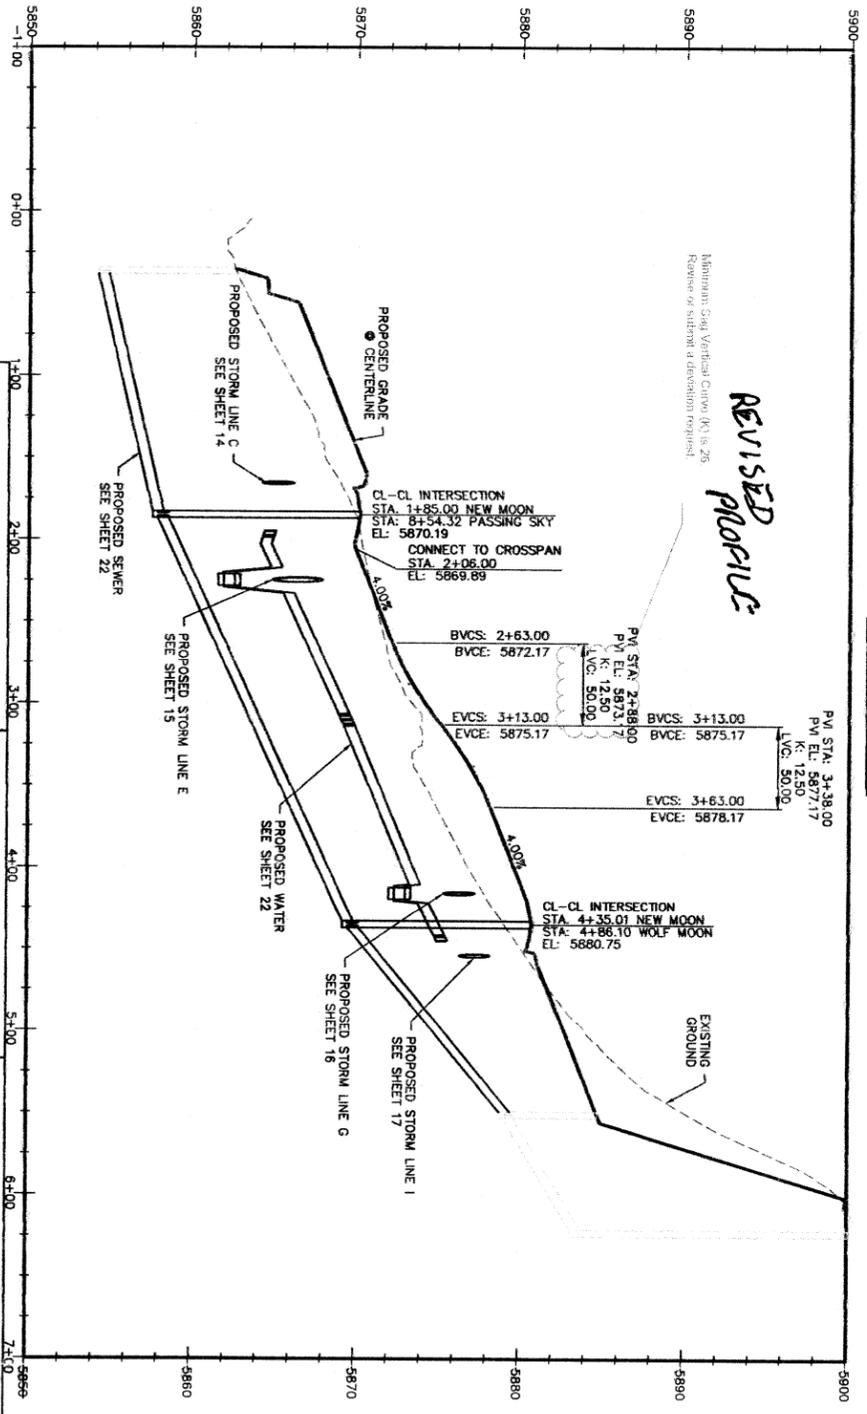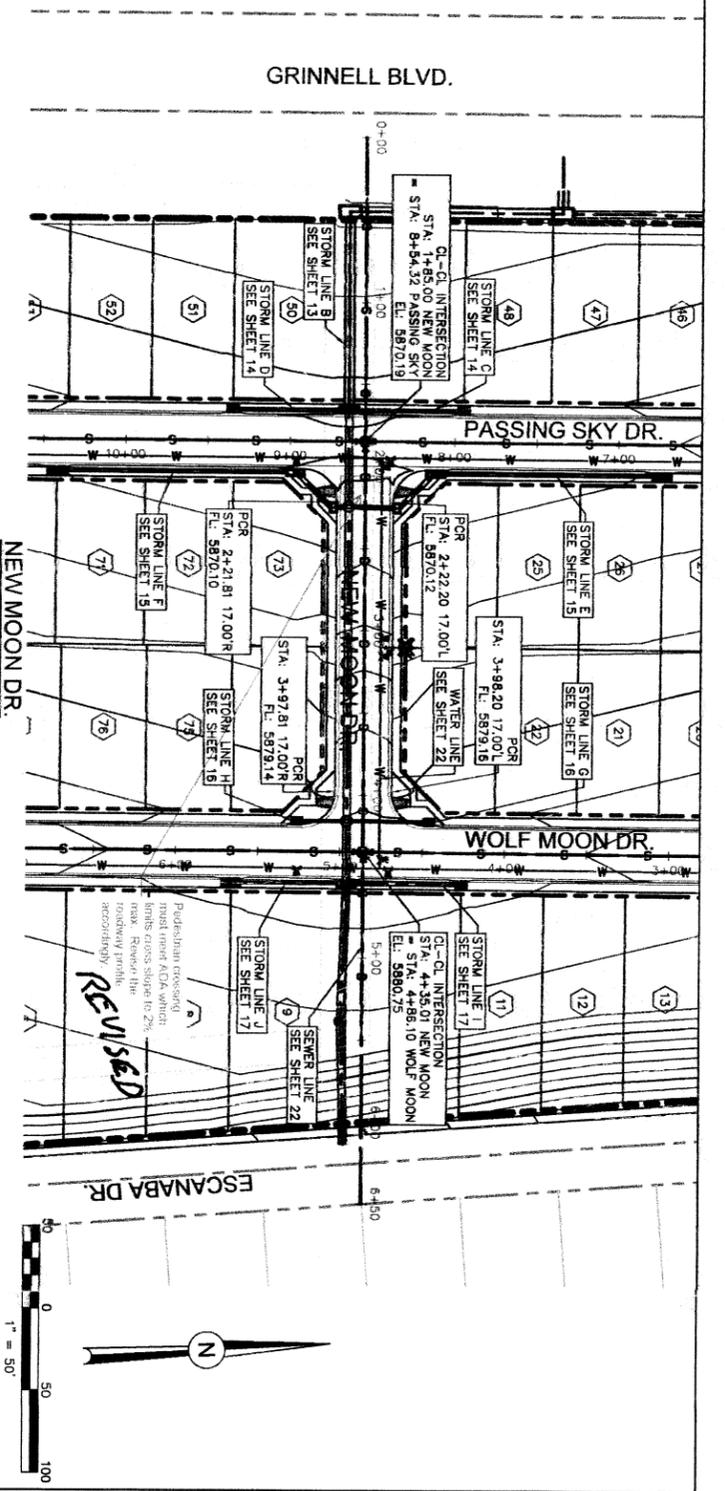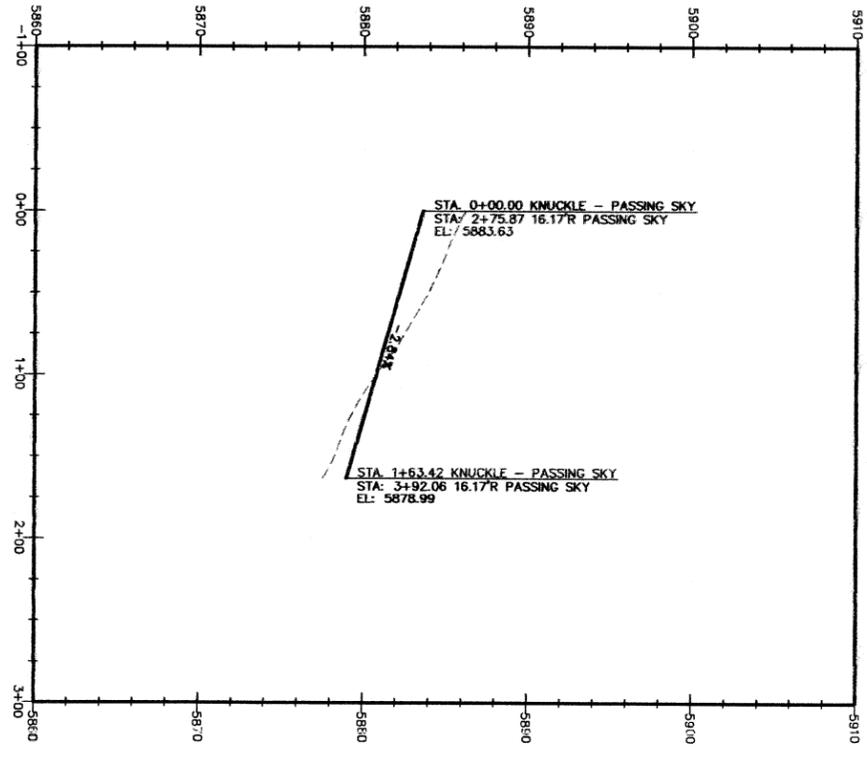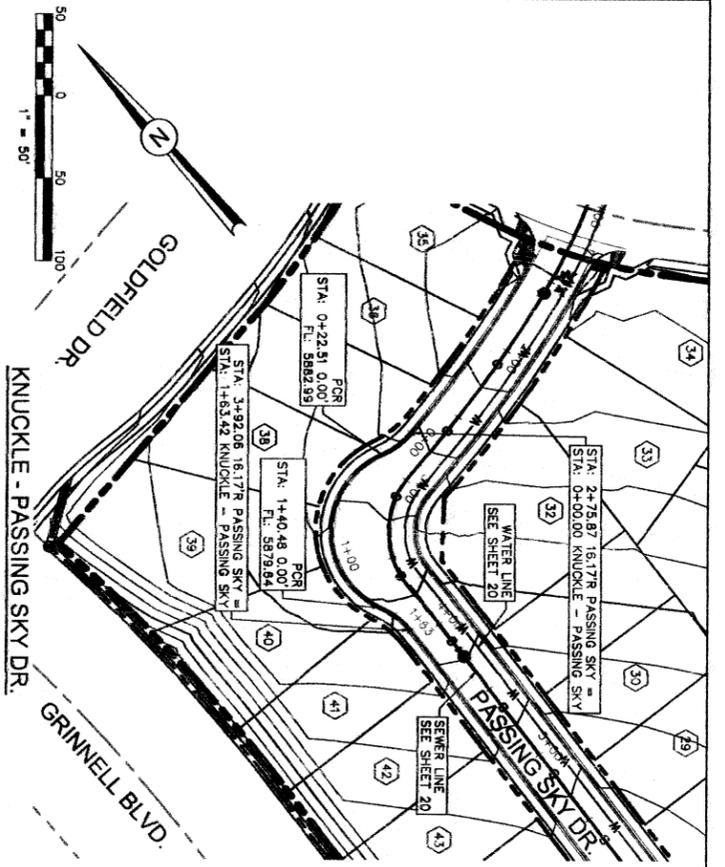


NO.	REVISIONS:	DESCRIPTION:	DATE:

DESIGNED BY: J.M. DATE: 9/21/17
DRAWN BY: T.W. DATE: 9/21/17
CHECKED BY: J.M. DATE: 9/21/17
 48 HOURS BEFORE YOU DIG,
 CALL UTILITY LOCATIONS
 1-800-922-1987
 CITY, GAS, ELECTRIC, WATER AND SEWER LINES


PROJECT: SPRINGS AT WATERVIEW
SHEET TITLE: NEW MOON - P&P
 FROM _____ TO _____ SHEET 9 OF 22



RODENT W/INLET

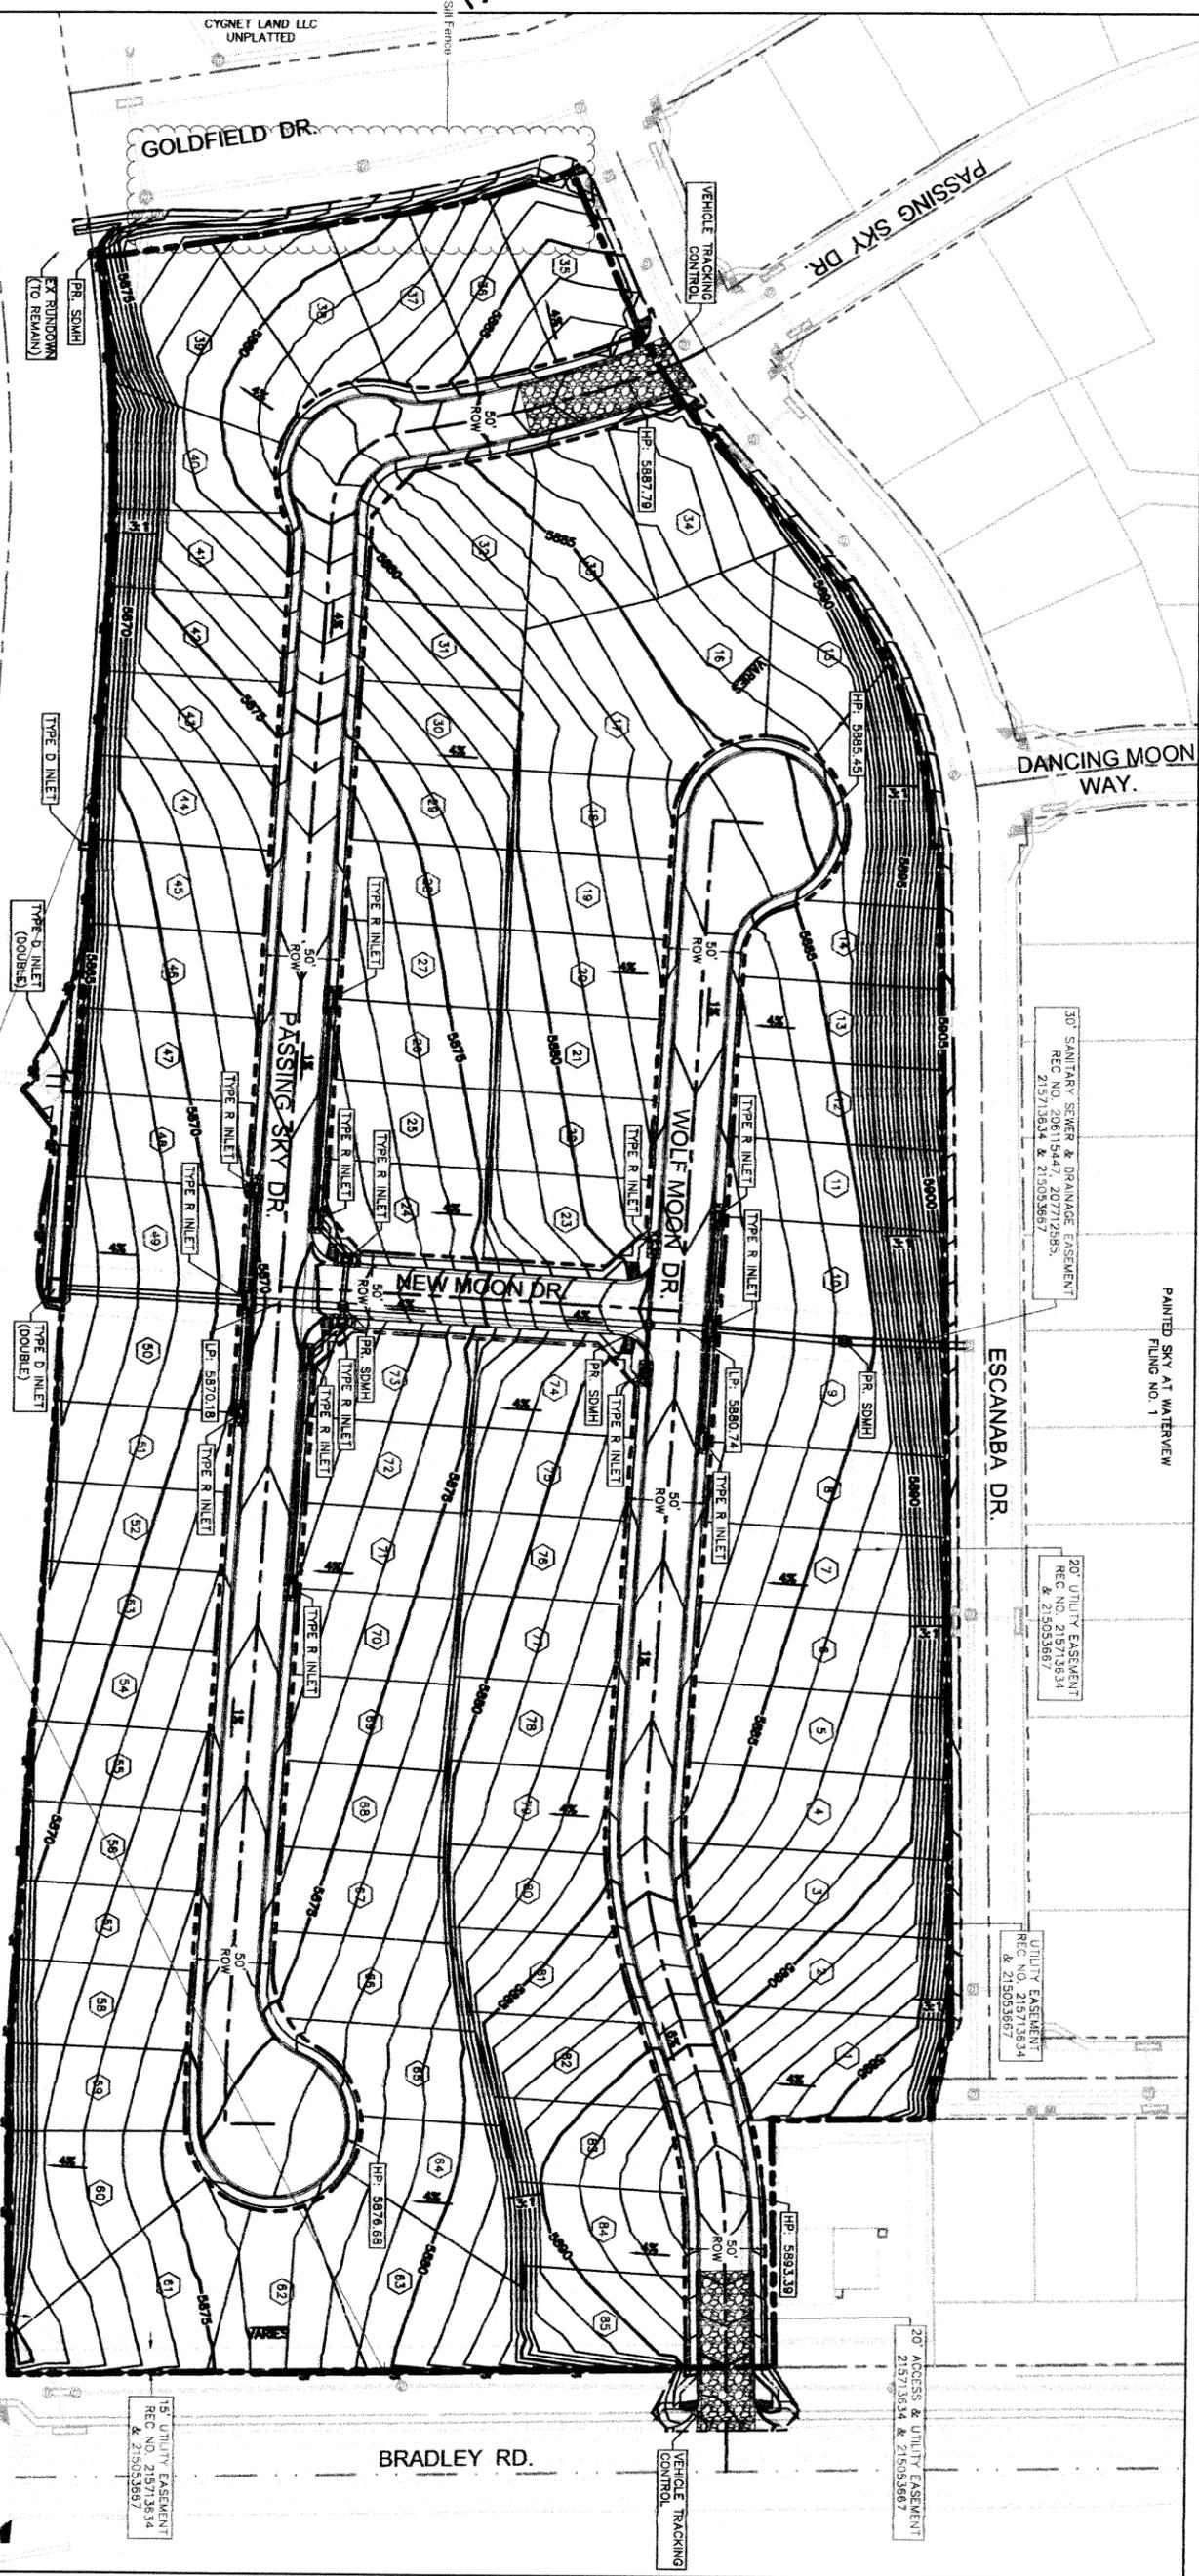

- LEGEND**
- EXISTING MAJOR CONTOUR
 - PROPOSED MAJOR CONTOUR
 - EXISTING MINOR CONTOUR
 - PROPOSED MINOR CONTOUR
 - VEHICLE TRACKING
 - SILT FENCE
 - INLET PROTECTION

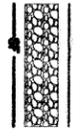

Per DCA Vol 2, temporary sediment basins are required in disturbed areas draining more than one acre. Provide a phasing schedule or Gentl chart of the installation/removal of the temporary BMPs.

CYCNET LAND LLC UNPLATTED

GRINNELL BLVD.

PASSING SKY DR.

WOLF MOON DR.


NEW MOON DR.

ESCANABA DR.

BRADLEY RD.

REVISED

REVISED

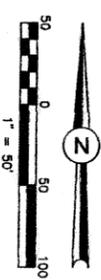

REVISIONS:	
NO.	DESCRIPTION

ENGINEER: **JM** DATE: **8/20/17**
 DESIGNED BY: **JM** DATE: **8/20/17**
 DRAWN BY: **AK** DATE: **8/20/17**
 CHECKED BY: **AK** DATE: **8/20/17**
 48 HOURS BEFORE YOU DIG,
 CALL UTILITY LOCATORS
 1-800-922-1987
 CITY OF COLORADO SPRINGS DEPT. OF UTILITIES
 GAS, ELECTRIC, WATER AND WASTEWATER

DSE Dakota Springs
 Engineering
 PROJECT SPRINGS AT WATERVIEW
 SHEET TITLE GRADING PLAN
 FROM _____ TO _____ SHEET 10 OF 22



PEDESTRIAN, DRAINAGE & UTILITY EASEMENT REC. NO. 215713534 & 215053667

15' UTILITY EASEMENT REC. NO. 215713534 & 215053667

30' SANITARY SEWER & DRAINAGE EASEMENT REC. NO. 206115447, 20712585, 215713534 & 215053667



20' UTILITY EASEMENT REC. NO. 215713534 & 215053667

UTILITY EASEMENT REC. NO. 215713534 & 215053667

20' ACCESS & UTILITY EASEMENT 215713534 & 215053667

PAINTED SKY AT WATERVIEW FLING NO. 1

ON LOTS WHERE SPWER MAIN SLOPES OPPOSITE OF STREET SLOPE, THE SPWER SERVICE SHALL BE LOCATED ON THE DOWNHILL SIDE OF THE SPWER MAIN AND THE FEET OF THE PROPERTY LINE ON THE LOW CORNER OF THE LOT.

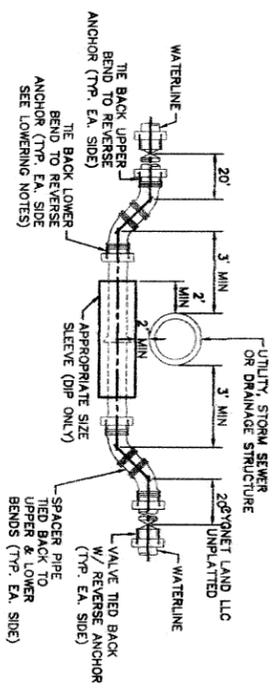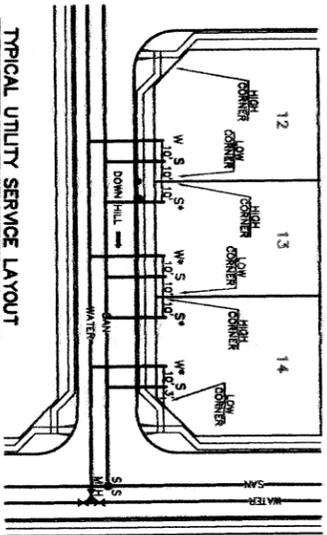



LOWERING NOTES
 1. NO PVC PIPE IN LOWERING
 2. LOWERING TO BE PROTECTED BY CONCRETE CURB
 3. REVIEW CONSTRUCTION OF BE BOUND SLEEVE W/ INSPECTORS APPROVAL

NO.	DESCRIPTION	DATE

REVISIONS:

ENGINEER: **DSE** *Dakota Springs Engineering*
 DRAWN BY: **AM** DATE: **8/20/17**
 CHECKED BY: **PAK** DATE: **8/28/17**
 48 HOURS BEFORE YOU DIG
 CALL UTILITY LOCATORS
 1-800-922-1987
 OR USE ELECTRIC SPRING AND UTILITY CAS. SERVICES

PROJECT TITLE: **MASTER UTILITY PLAN**
 SHEET NO. **0001-02-18-01** TO **02**
 SHEET **18** OF **22**

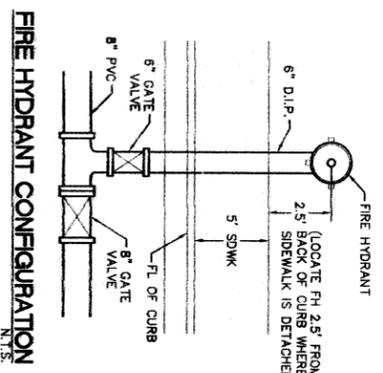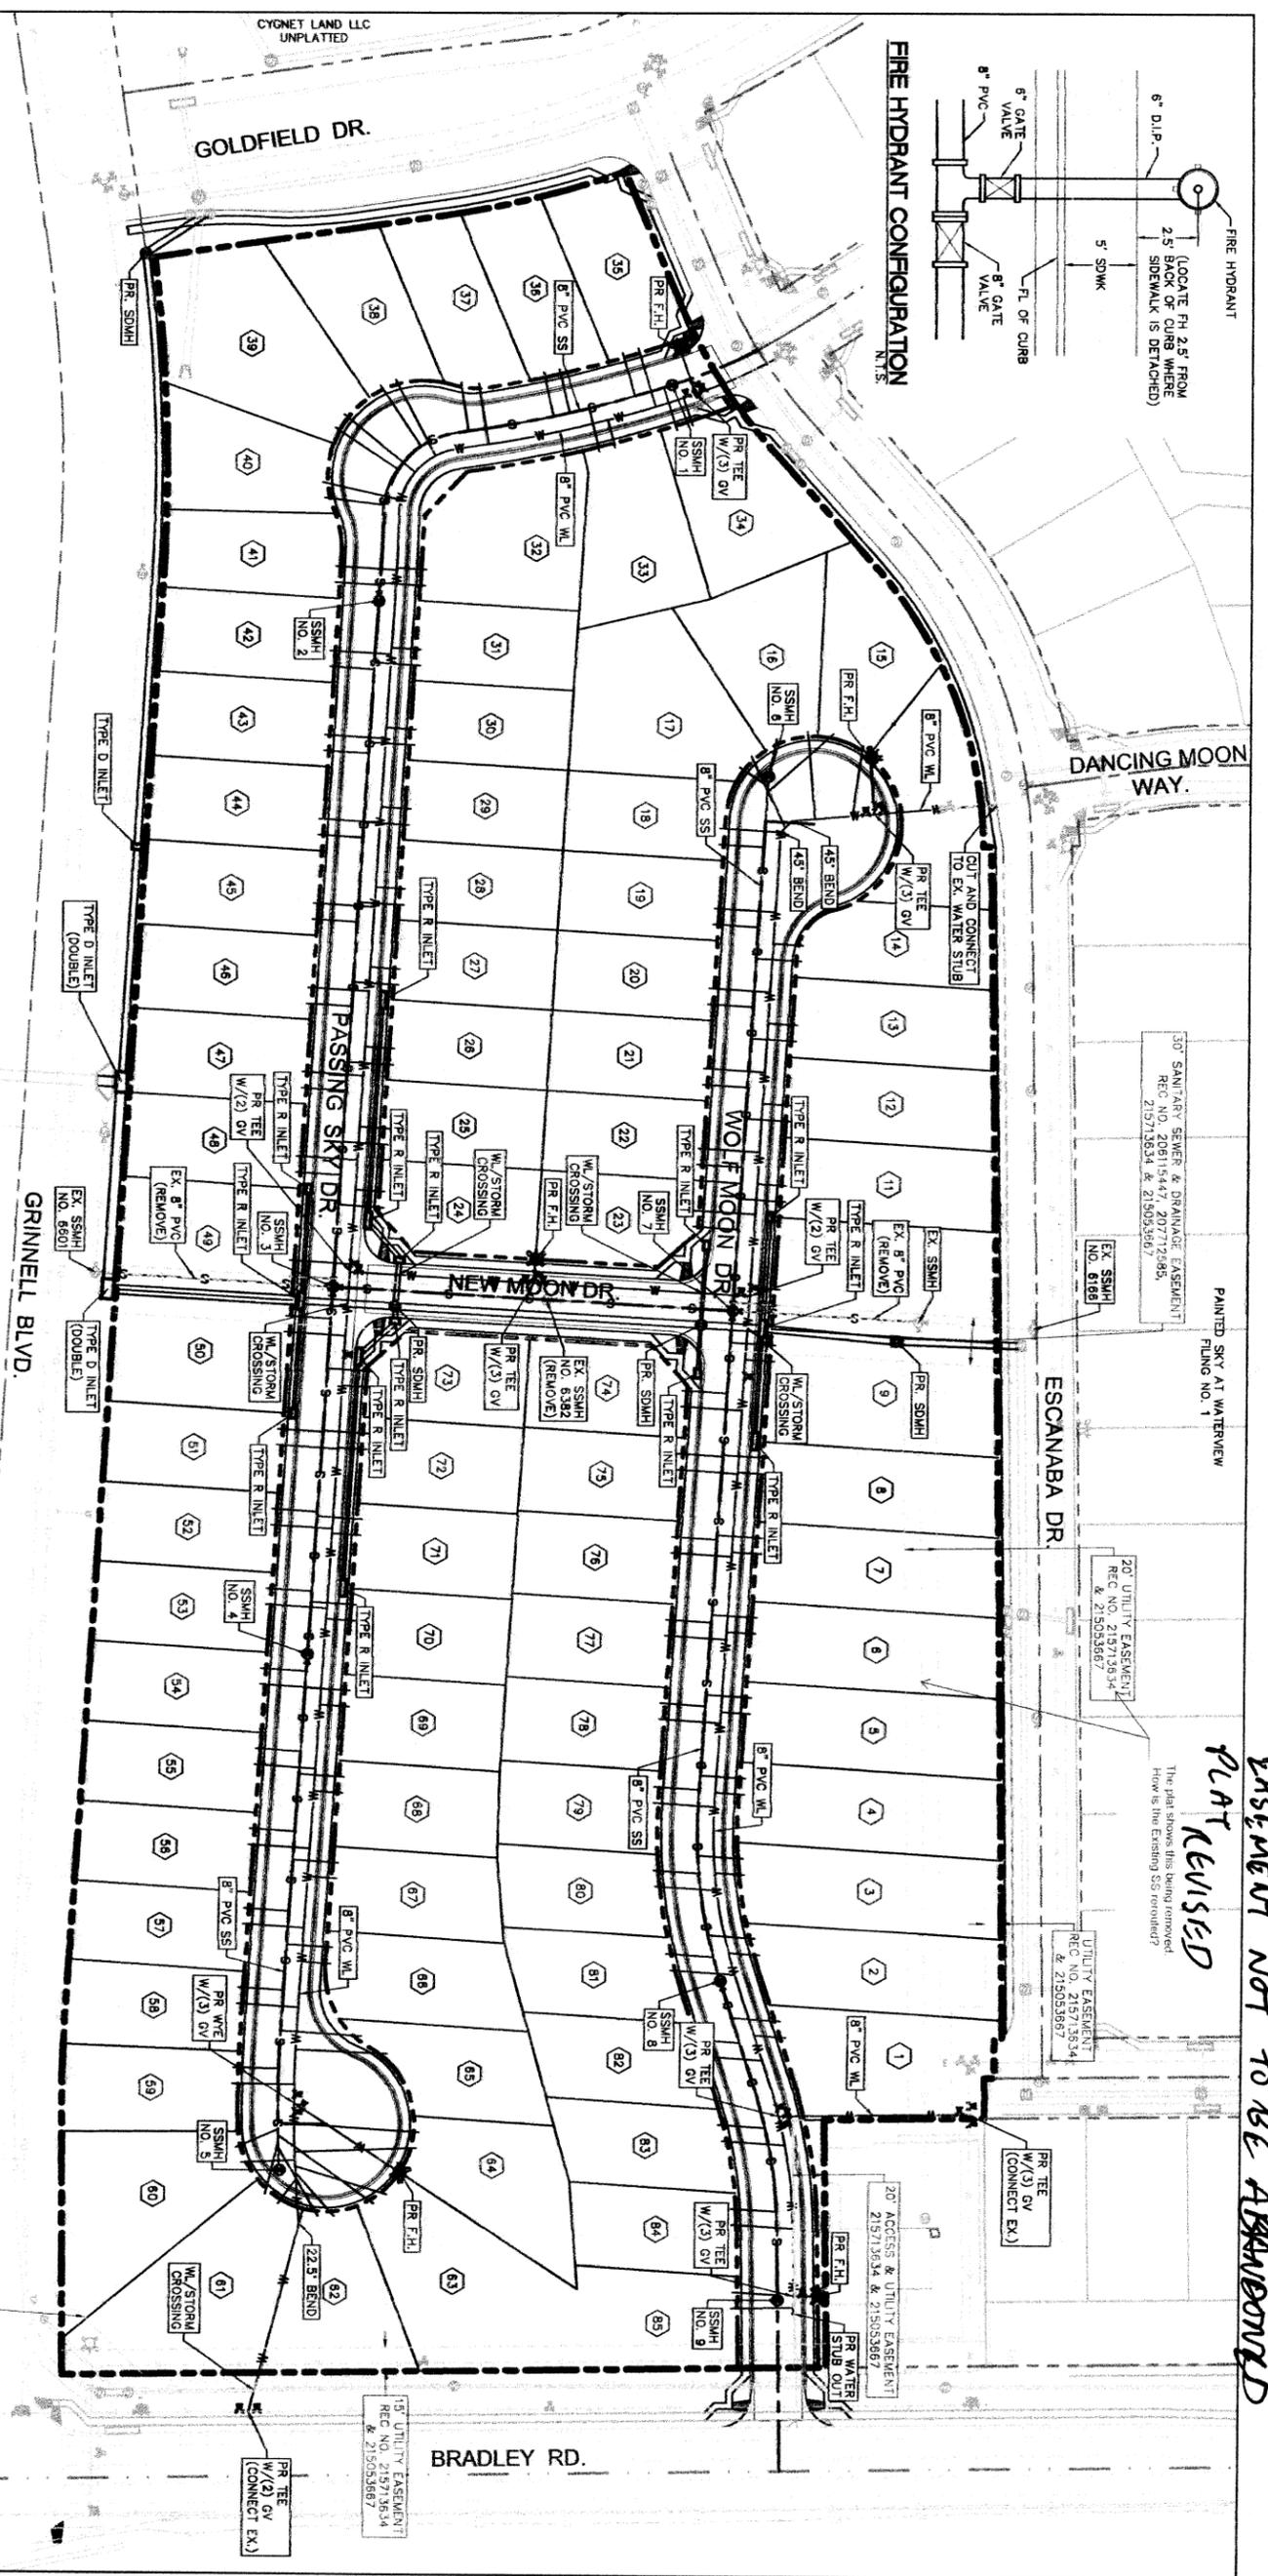

30' SANITARY SEWER & DRAINAGE EASEMENT
 REC. NO. 215713534 & 215053867

20' UTILITY EASEMENT
 REC. NO. 215713534 & 215053867

UTILITY EASEMENT
 REC. NO. 215713534 & 215053867

EASEMENT NOT TO BE ABANDONED
PLAT REVISED
 The plat shows this being removed
 How is the Existing SS rerouted?



DSE *Dakota Springs Engineering*
 31 N. TOWN, SUITE 550
 COLORADO SPRINGS, CO 80903
 P: (719) 227-7388
 F: (719) 227-7382
 1/8/2017/0302

