

SPRINGS AT WATERVIEW
DRAINAGE LETTER
EL PASO COUNTY, COLORADO

July 2019

PREPARED FOR:

SWV, LLC

31 N. Tejon, Suite 500
Colorado Springs, CO 80903

PREPARED BY:

Dakota Springs Engineering

31 N. Tejon Street, Suite 500
Colorado Springs, CO 80903
719.227.7388

PROJECT NO.16-01

PCD No. SP-16-005
PCD No. SF-16-017

CERTIFICATIONS

Design Engineer's Statement:

The attached drainage plan and report were prepared under my direction and supervision and are correct to the best of my knowledge and belief. Said drainage report has been prepared according to the criteria established by the County for drainage reports and said report is in conformity with the applicable master plan of the drainage basin. I accept responsibility for any liability caused by any negligent acts, errors or omissions on my part in preparing this report.

Charles K. Cothorn, P.E. #24997

Seal

Owner/Developer's Statement:

I, the owner/developer have read and will comply with all of the requirements specified in this drainage report and plan.

By (signature): _____

Date: _____

Title: _____

Address: _____

El Paso County:

Filed in accordance with the requirements of the El Paso County Land Development Code, Drainage Criteria Manual Volumes 1 and 2, and the Engineering Criteria Manual, as amended.

Jennifer Irvine, P.E.,
County Engineer / ECM Administrator

Date

Table of Contents

1.0 INTRODUCTION4
PURPOSE 4

2.0 GENERAL LOCATION AND DESCRIPTION4
LOCATION 4
DESCRIPTION OF PROPERTY 4

3.0 DRAINAGE BASINS AND SUB-BASINS4
MAJOR BASIN DESCRIPTION 4
FLOODPLAINS..... 5

4.0 DRAINAGE BASINS.....5
EXISTING DRAINAGE ANALYSIS..... 5
PROPOSED DRAINAGE ANALYSIS 5
PROPOSED STORM SYSTEM 5

5.0 DRAINAGE FEES, COST ESTIMATE & MAINTENANCE6

6.0 REFERENCE MATERIALS6

Appendix

Appendix A: HEC-RAS Analysis of Chennel Reaches

1.0 INTRODUCTION

This report is an amendment to the Preliminary & Final Drainage report prepared by Dakota Springs Engineering and approved October 16, 2018.

Purpose

The purpose of this report is to present revisions to the preliminary and final drainage improvements associated with the construction of Springs at Waterview. Revisions are associated with previously proposed conveyance of storm flows, specifically construction of open channels in place of some of the previously proposed storm sewer pipe along Grinnell Boulevard. No changes have been made concerning onsite or offsite hydrology or acceptance of offsite storm water through the site.

2.0 General Location and Description

Location

Springs at Waterview is a planned 85-unit multi-family residential development within the north half of the northeast quarter of Section 7, Township 15 South, Range 65 West of the 6th Principal Meridian, in El Paso County, Colorado. It is located south of Goldfield Drive, east of Grinnell Boulevard, north of Bradley Road and west of Painted Sky at Waterview Filing No. 1. This portion of the Waterview development is in the Windmill Gulch Drainage Basin.

Description of Property

The proposed site encompasses 15.68 acres. The topography of the site and surrounding area is typical of a high desert; short prairie grass and weeds with slopes generally ranging from 1% to 9%. The area generally drains to the west.

The site is comprised of several different soil types. From the Soil Survey of El Paso County, the site falls into the following soil types:

1. “3” Ascalon sandy loam, 3 to 9 percent slopes.
2. “8” Blakeland loamy sand, 1 to 9 percent slopes.
3. “97” Truckton sandy loam, 3 to 9 percent slopes.

The Blakeland and Truckton soils are classified at Hydrological Group A and the Ascalon soil is classified as Hydrological Group B. Note: “#” indicates Soil Conservation Survey soil classification number. Hydrologic Soil Group B was used in the preparation of this report. See Appendix A: Soils Data.

3.0 Drainage Basins and Sub-Basins

Include the referenced data.

Major Basin Description

Springs at Waterview residential development is located within the Windmill Gulch Drainage Basin. This report complies with the Windmill Gulch Drainage Basin Planning Study (DBPS) by Wilson and Company, the Master Development Drainage Plan for Waterview by Merrick and Company, the

Preliminary Drainage Report for Waterview Phase II, also by Merrick and Company and Painted Sky at Waterview Filing 1 and 2 Final Drainage Report by Merrick and Company and the Approved Springs at Waterview PDR/FDR. All developed runoff will meet El Paso County standards for discharge rates.

Floodplains

The Flood Insurance Rate Map (FIRM No. 08041C0764-G dated 12/7/2018) indicates that there is no floodplain in the vicinity of the proposed site. See Figure 2: FIRM.

Include the referenced data.

4.0 DRAINAGE BASINS

Existing Drainage Analysis

Please refer to the Preliminary and Final Drainage Report for Springs at Waterview, Approved on October 16, 2018, for existing drainage analysis.

Proposed Drainage Analysis

Please refer to the Preliminary and Final Drainage Report for Springs at Waterview, Approved on October 16, 2018, for proposed drainage analysis.

Proposed Storm System

The proposed storm water conveyance system presented in the approved Preliminary and Final Drainage Report of Springs at Waterview remains unchanged except for the facilities that parallel Grinnell Blvd.

The proposed revision to the system parallel to Grinnell Blvd is to replace the storm pipe with open channels. These channels will convey the developed runoff to the existing concrete box culvert under Grinnell Blvd. Hydraulic computations for the proposed channels are contained in the appendix of this letter.

The hydraulic analysis contained in the appendix of the report divides the system parallel to Grinnell Blvd into three reaches, North Reach, South Reach and East Reach. The North Reach is the channel that runs between Goldfield Dr. and the concrete box culvert that crosses under Grinnell Blvd. This reach flows southerly. The South Reach is the channel that runs northerly parallel to Grinnell Blvd between Bradley Rd. and the box culvert under Grinnell Blvd. The East Reach is a short section of channel between the outfall of the storm drain running east-west through the development. And the South Reach. This reach flows westerly and has its confluence with the South Reach approximately 115 feet south of the concrete box culvert under Grinnell Blvd.

There is a section (section 100) in the south channel where the hydraulic computations show a velocity in excess of 5.0 fps (6.71 fps). This section is just downstream of the confluence with the east channel. Current and proposed design calls for rip rap lining of the channel in this area.

There is a section (section 200) in the north channel where the hydraulic computations show a velocity in excess of 5.0 fps (5.91 fps). This section is approximately 100 feet upstream of the box culvert under Grinnell Blvd. The existing design does not call for riprap lining in this area. The design will be revised

to show the necessary riprap lining of the channel in this area. The extents of the additional riprap will be down stream to the currently designed rip rap lining and 25 feet upstream of the section

5.0 DRAINAGE FEES, COST ESTIMATE & MAINTENANCE

There are no additional fees required for this development as a result of the amendments to the approved Preliminary and Final Drainage Report for Springs at Waterview, presented in this Drainage Letter. Those portions of the approved drainage report that established fees for this development remain unchanged. The amendment only addresses changes in conveyance along Grinnell Blvd.

6.0 REFERENCE MATERIALS

1. “City of Colorado Springs/El Paso County Drainage Criteria Manual” May 2014.
2. “Windmill Gulch Drainage Basin Planning Study”, Wilson and Company, February 1992.
3. Master Development Drainage Plan for Waterview, May 2006. Prepared by Merrick & Co.
4. Preliminary Drainage Report for Waterview Phase II, January 2007. Prepared by Merrick & Co.
5. Final Drainage Report for Painted Sky at Waterview Filings 1 and 2, January 2007. Prepared by Merrick & Co.
6. Soils Survey of El Paso County Area, Natural Resources Conservation Services of Colorado.
7. Flood Insurance Rate Study for El Paso County, Colorado and Incorporated Areas. Federal Emergency Management Agency, Revised March 17, 1997.
8. “City of Colorado Springs/El Paso County Drainage Criteria Manual, Volume 2: Stormwater Quality Policies, Procedures and Best Management Practices” May 2014.
9. Springs at Waterview Preliminary and Final Drainage Report, October 2018, Prepared by Dakota Springs Engineering.

- Include the vicinity map from the previous submittal.
- Per the previous comments, include the existing drainage map.
- Per the previous comments, include the proposed drainage map. (See previous redline comments for what needs to be updated on the drainage map. Drainage Map with comments is inserted at the end of this report)

River	Reach	River Sta	Profile	Q Total (cfs)	Min Ch El (ft)	W.S. Elev (ft)	Crit W.S. (ft)	E.G. Elev (ft)	E.G. Slope (ft/ft)	Vel Chnl (ft/s)	Flow Area (sq ft)	Top Width (ft)	Froude # Chl
South Ditch	South	750	100 Yr	16.79	5866.90	5867.40	5867.40	5867.57	0.026977	3.27	5.13	15.89	1.01
South Ditch	South	600	100 Yr	16.79	5862.22	5863.23		5863.31	0.005152	2.36	7.10	10.06	0.50
South Ditch	South	400	100 Yr	16.79	5861.22	5863.07		5863.09	0.000423	0.95	17.74	15.13	0.15
South Ditch	South	200	100 Yr	16.79	5860.22	5863.05		5863.06	0.000065	0.47	35.67	21.15	0.06
South Ditch	South 2	100	100 Yr	160.00	5859.72	5861.95	5861.95	5862.65	0.028635	6.71	23.84	17.40	1.01
South Ditch	South 2	000	100 Yr	160.00	5856.00	5859.83		5860.01	0.004562	3.43	46.71	23.29	0.43
Outlet	Outlet	5500	100 Yr	299.47	5856.50	5859.95		5859.96	0.000314	0.88	340.44	203.56	0.11
Outlet	Outlet	5000	100 Yr	299.47	5858.07	5859.78	5859.40	5859.94	0.010019	3.25	92.01	94.09	0.58
North Ditch	North	460	100 Yr	101.57	5862.96	5865.15		5865.34	0.004336	3.52	28.82	19.65	0.51
North Ditch	North	400	100 Yr	101.57	5862.67	5864.94	5864.17	5865.10	0.003483	3.24	31.38	20.64	0.46
North Ditch	North	200	100 Yr	101.57	5861.67	5863.16	5863.16	5863.71	0.018279	5.91	17.19	15.98	1.00
North Ditch	North	001	100 Yr	101.57	5856.50	5859.93		5859.97	0.001030	1.72	59.10	27.51	0.21
East Ditch	East	028	100 Yr	143.64	5859.96	5862.57		5862.78	0.006542	3.72	38.61	22.63	0.50
East Ditch	East	025	100 Yr	143.64	5859.91	5862.33		5862.68	0.013892	4.69	30.60	22.55	0.71

All values on the Qtotal does not match the previous report.

Examples: The approved FDR showed the following flows at the following river station:

- South ditch station 750 = 24.1 cfs (DP K)
- South ditch station 000 is equivalent to FDR Stormcad pipe P-19 which shows 148 cfs
- East Ditch station 028 is equivalent to FDR Stormcad pip P-18 which shows Q = 130 cfs



... (112.7) is combined flows from Basin E-1 and the released flow from the ... at the north end of the site under Goldfield Drive and the storm system ... east side of ... 72" rep.
 Remove. State to see the approved FDR for proposed sub-basin description and hydrologic/hydraulic analysis.
Analysis
 Narrative shall be for the specific sub-basin or design point impacted and explain what it was and what it is being changed to.
 ... is located ... released into ... this basin ... is 0.7 cfs and 1.6 cfs for the 5 and 100-year events. Currently,

Per the previous review comment, for Section 3.0, provide a narrative for any sub-basin or design point that's changed. If the StormCAD model is now different, then include the updated model and highlighting the segments that has changed.


SPRINGS AT WATERVIEW - STORMCAD OUTPUT 100 YEAR

Label	Up. Node	Dn. Node	L (ft)	Size	Q Full (cfs)	System Q (cfs)	Avg. v (ft/s)	Up. Gr Elev. (ft)	Up. Gr Elev. (ft)	Up. Cover (ft)	Dn. Gr. Elev. (ft)	H	
P-19	Area Inlet DP 42a	Area Inlet DP 43	121.0	72 inch	148.1	285.5	10.19	5864.51	5863.26	5856.93	1.58	5863.79	5
P-25	Area Inlet DP 43	J-8	11.0	72 inch	230	285.0	11.31	5863.79	5862.36	5856.38	1.41	5863.50	5
EX P-1	J-8	J-9	128.0	72 inch	239	463.0	16.51	5863.26	5861.54	5856.33	1.11	5862.29	5
EX P-2	J-9	L-10	71.3	72 inch	238.8	518.8	17.97	5862.26	5853.20	5847.60	8.66	5854.50	5
EX P-3	L-10	L-11	97.5	72 inch	238.7	518.2	17.95	5854.60	5845.27	5840.06	8.44	5853.70	5
EX P-4	L-11	O-1	143.4	72 inch	238.6	300.1	11.76	5853.70	5843.61	5838.41	9.20	5845.00	5
P-4	Inlet D-7	Inlet DP A	80.0	18 inch	8.8	18.9	9.90	5881.33	5879.94	5877.94	2.19	5881.02	5
P-3	Inlet D-8	Inlet DP A	83.0	18 inch	4.1	15.8	7.41	5881.33	5878.25	5877.29	2.74	5881.02	5
P-1	Ex System Flow East	MH 1	73.0	48 inch	86.1	254.4	18.20	5899.57	5884.38	5881.07	14.50	5884.39	5
P-2	MH 1	Inlet DP A	80.0	48 inch	86.1	253.4	18.23	5884.39	5879.51	5876.20	4.10	5881.02	5
P-15	MH 2	Inlet DP F	54.0	48 inch	122.7	403.8	14.90	5872.35	5867.60	5863.91	3.21	5872.94	5
P-18	Inlet DP F	Area Inlet DP 42a	115.0	66 inch	130.0	720.9	23.01	5872.94	5866.70	5862.73	4.71	5864.51	5
P-16	Inlet D-16	Inlet DP F	63.0	18 inch	2.3	22.9	8.09	5873.45	5870.23	5869.73	2.22	5872.94	5
P-22	Ex System Flow North	MH 7	38.0	48 inch	82.7	127.6	10.81	5872.58	5866.61	5863.35	3.21	5871.42	5
P-23	MH 7	Inlet D-17	87.0	48 inch	82.7	129.4	10.92	5871.42	5866.75	5862.75	4.67	5866.25	5
P-24	Inlet D-17	Area Inlet DP 43	142.0	48 inch	88.6	125.8	10.85	5865.25	5862.85	5859.47	1.78	5863.79	5
P-17	Inlet D-15	Inlet DP F	63.0	18 inch	3.0	22.9	8.93	5873.46	5870.38	5869.72	2.24	5872.94	5
P-11	Inlet DP B	MH 2	25.0	30 inch	11.7	41.0	7.21	5873.06	5868.71	5867.06	3.50	5872.96	5
P-14	Inlet DP C	MH 2	5.0	30 inch	10.1	89.9	12.12	5873.04	5868.61	5867.05	3.49	5872.96	5
P-12	Inlet D-14	Inlet DP E	135.0	18 inch	5.1	11.0	6.09	5874.52	5871.13	5870.26	2.76	5873.08	5
P-13	Inlet DP E	Inlet DP C	28.0	24 inch	9.0	36.8	9.67	5873.06	5869.86	5866.29	2.77	5873.04	5
P-8	Inlet D-11	Inlet DP D	128.0	18 inch	4.9	11.1	6.11	5874.68	5871.25	5870.40	2.76	5873.24	5
P-10	Inlet DP D	Inlet DP B	28.0	24 inch	10.3	40.8	10.77	5873.24	5870.11	5868.46	2.78	5873.08	5
P-5	Inlet DP A	MH-6	34.0	48 inch	98.9	181.0	14.72	5881.02	5877.12	5873.41	3.61	5880.27	5
P-8	MH-6	MH 2	184.0	48 inch	102	228.6	17.68	5880.27	5873.23	5869.47	6.80	5872.96	5
P-7	Inlet D-10	MH-6	25.0	18 inch	1.9	22.1	7.65	5881.03	5877.48	5876.48	3.61	5880.27	5
P-6	Inlet D-9	MH-6	45.0	18 inch	2.9	14.9	6.56	5881.03	5877.08	5876.28	3.41	5880.27	5


Identify the corresponding reach and station for each cross section.

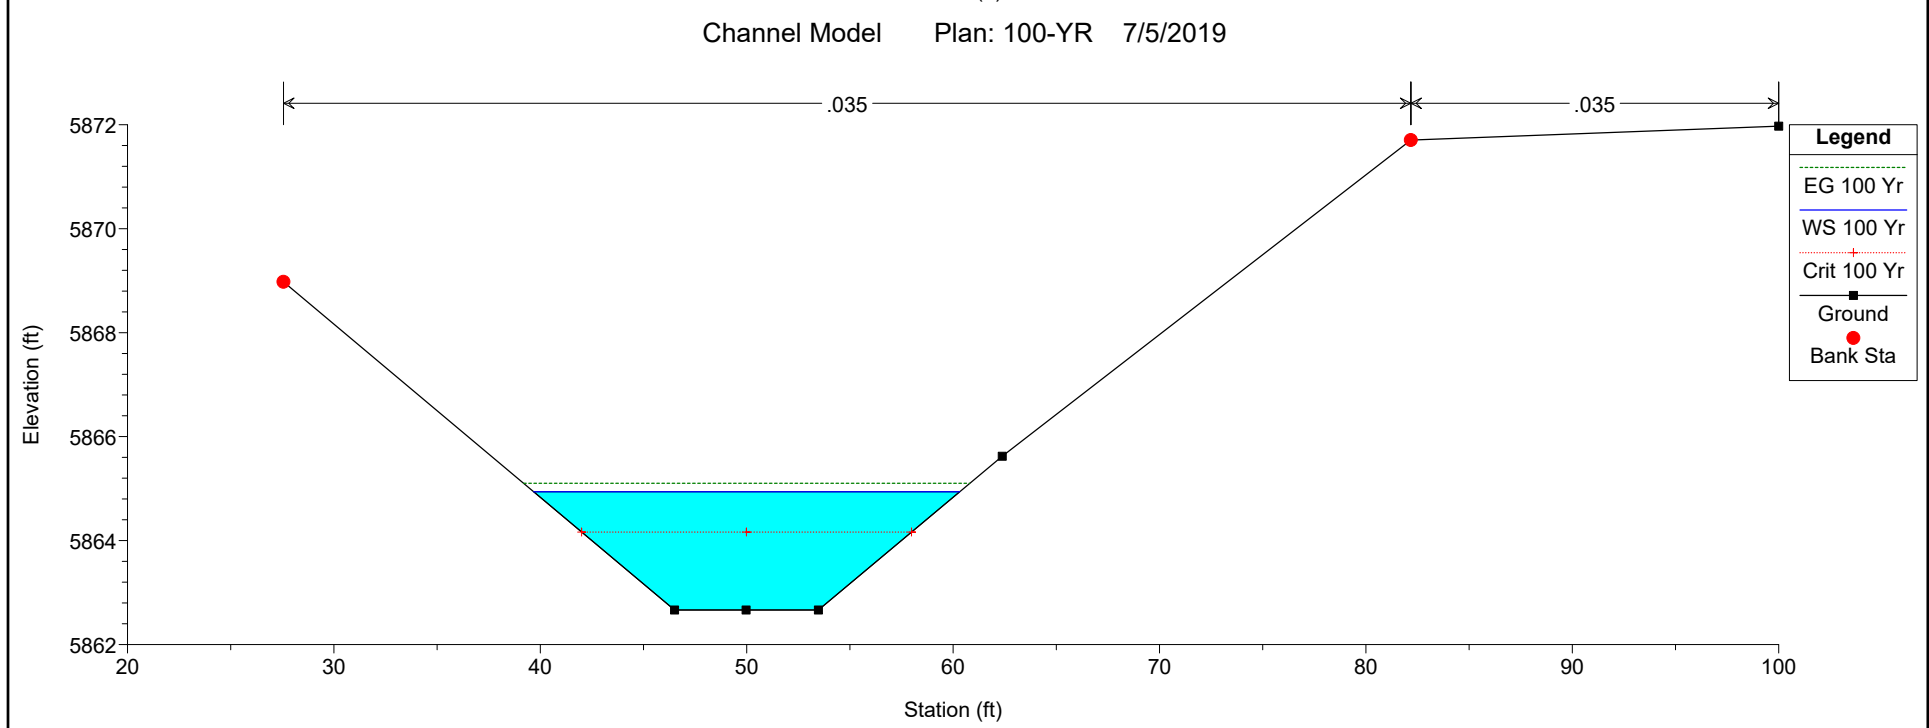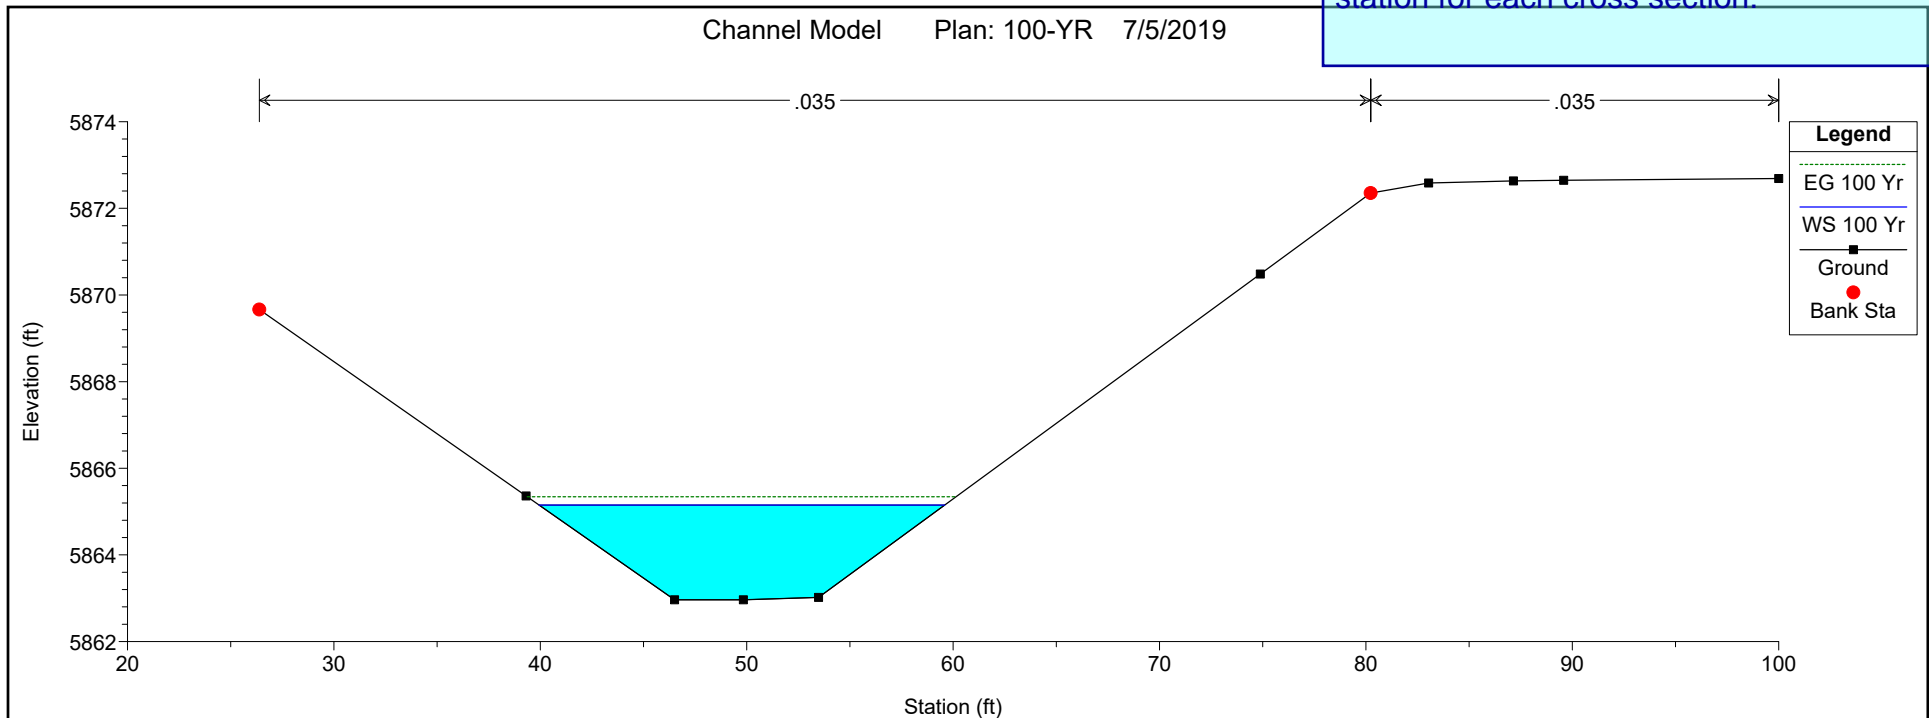


Channel Model Plan: 100-YR 7/5/2019

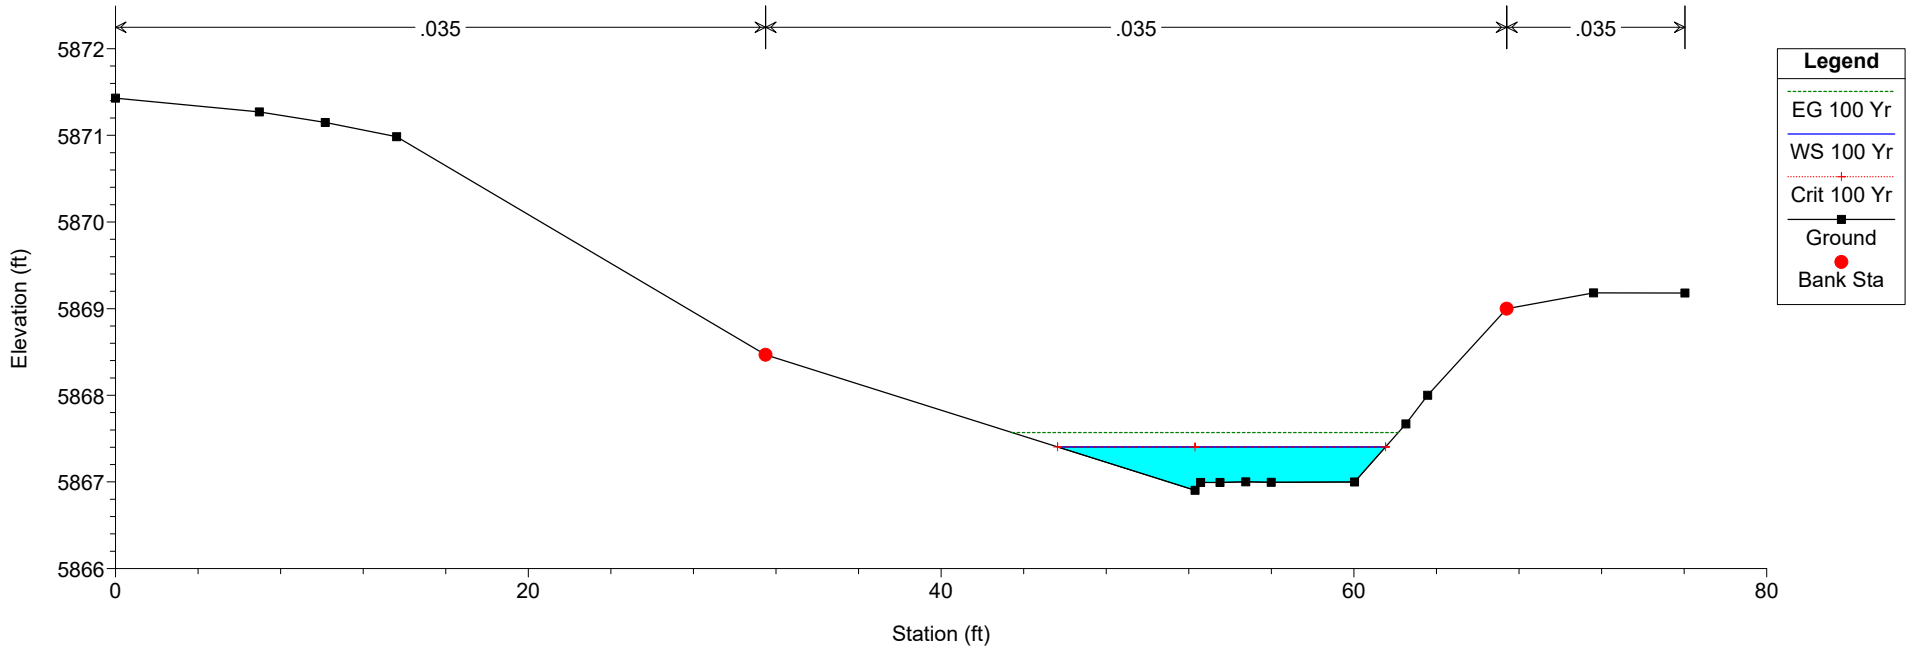


Channel Model Plan: 100-YR 7/5/2019

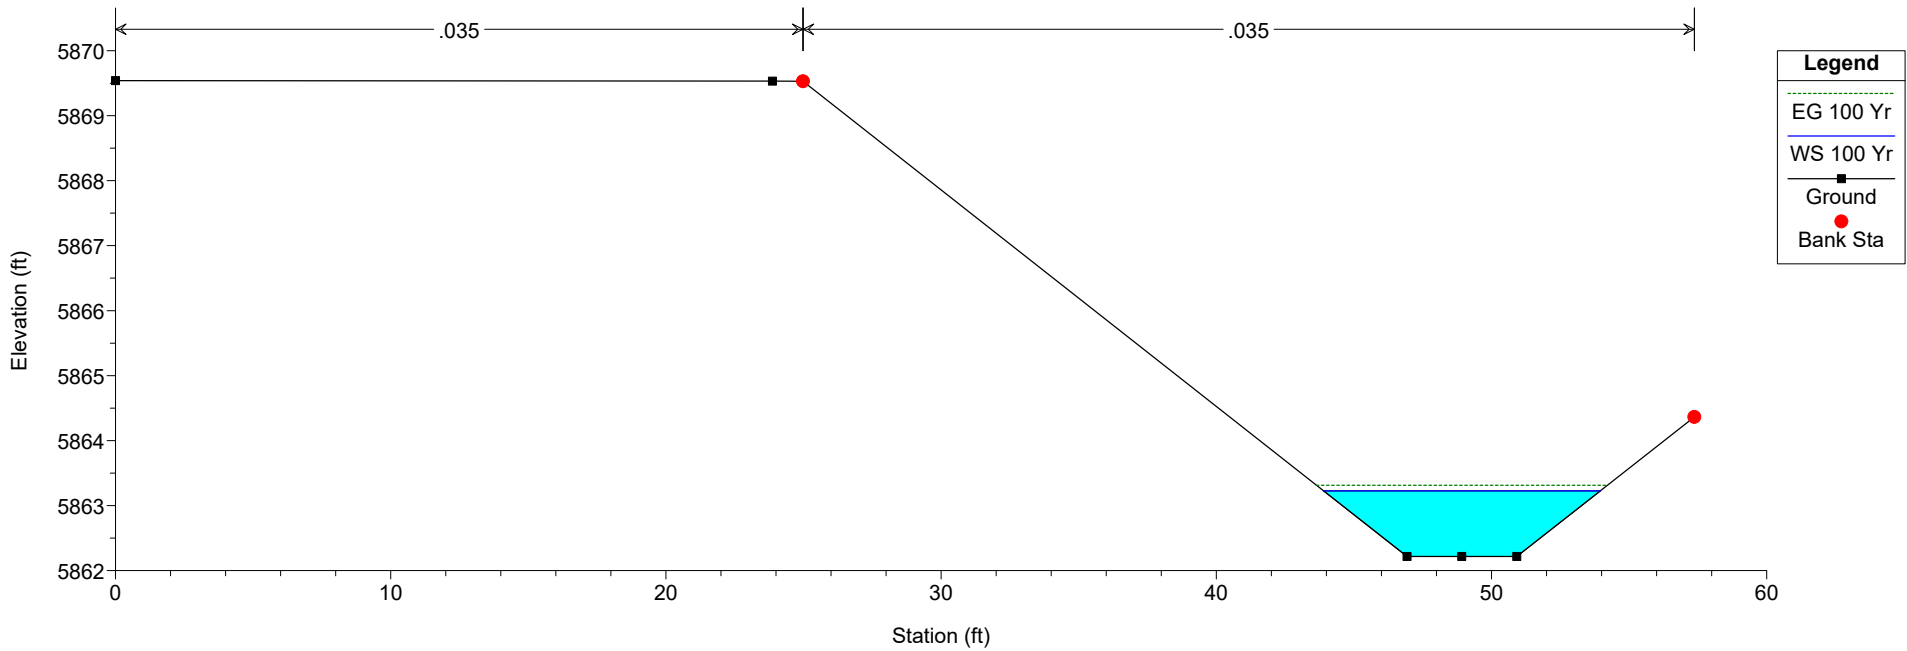


Channel Model Plan: 100-YR 7/5/2019

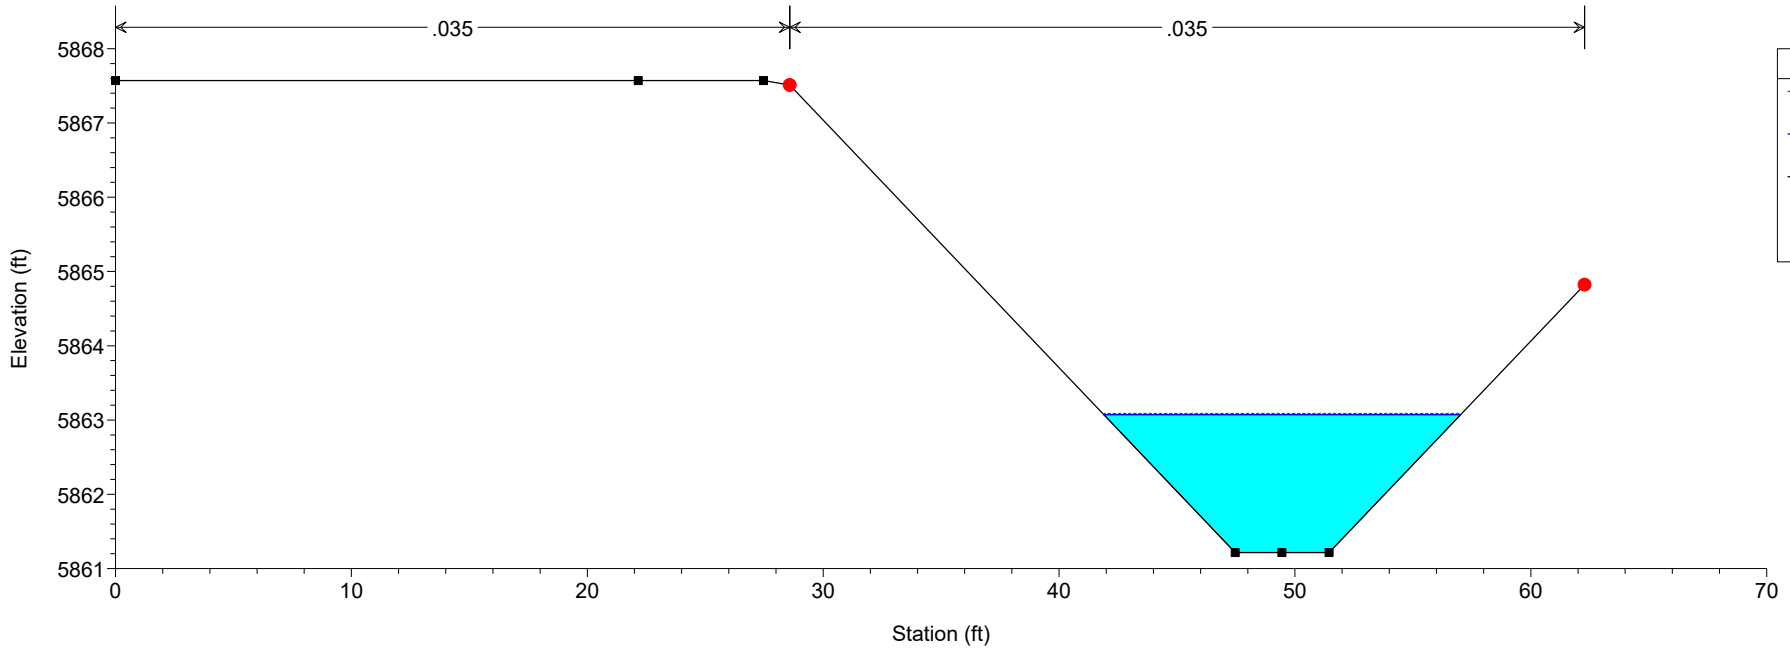


Channel Model Plan: 100-YR 7/5/2019

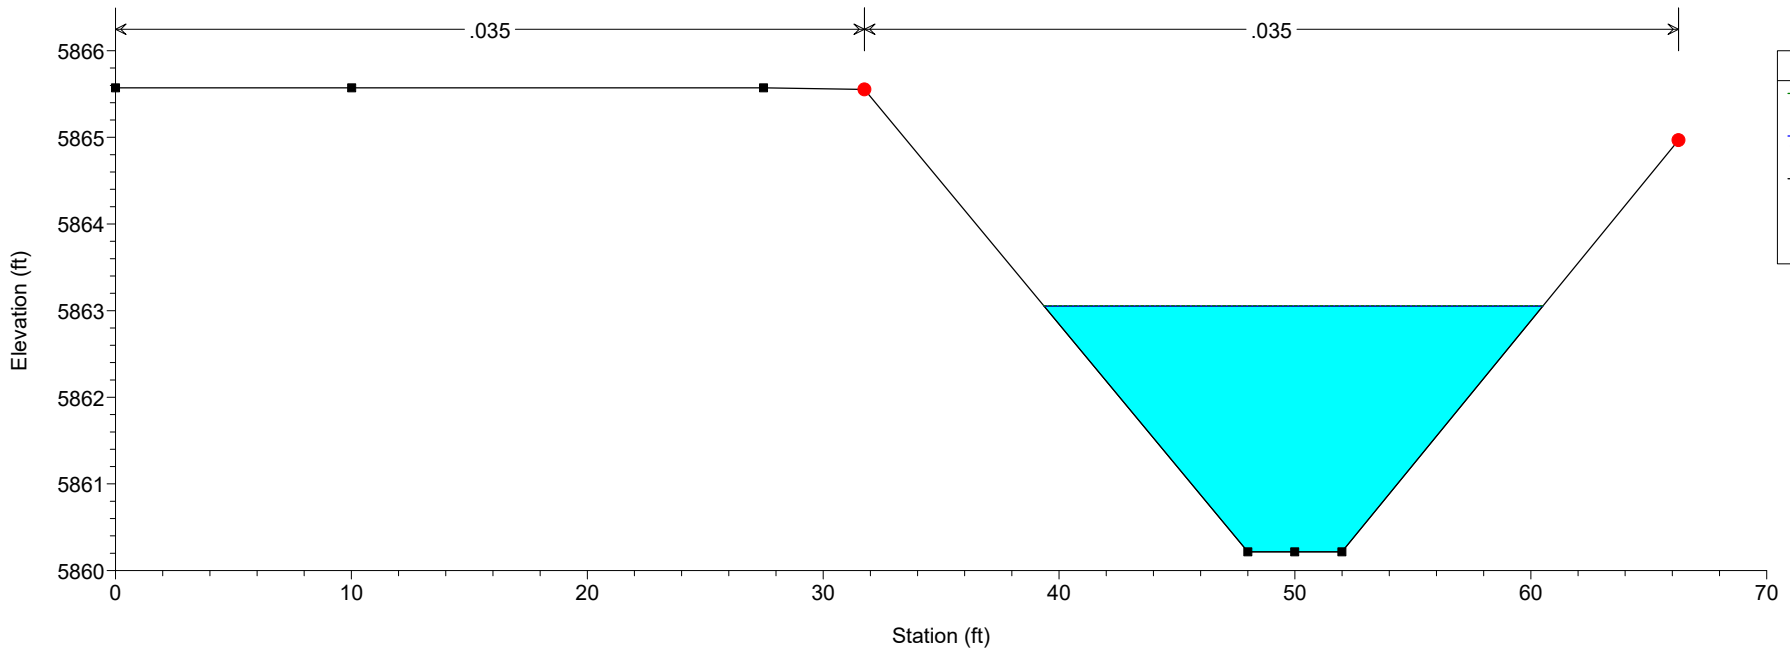


Channel Model Plan: 100-YR 7/5/2019

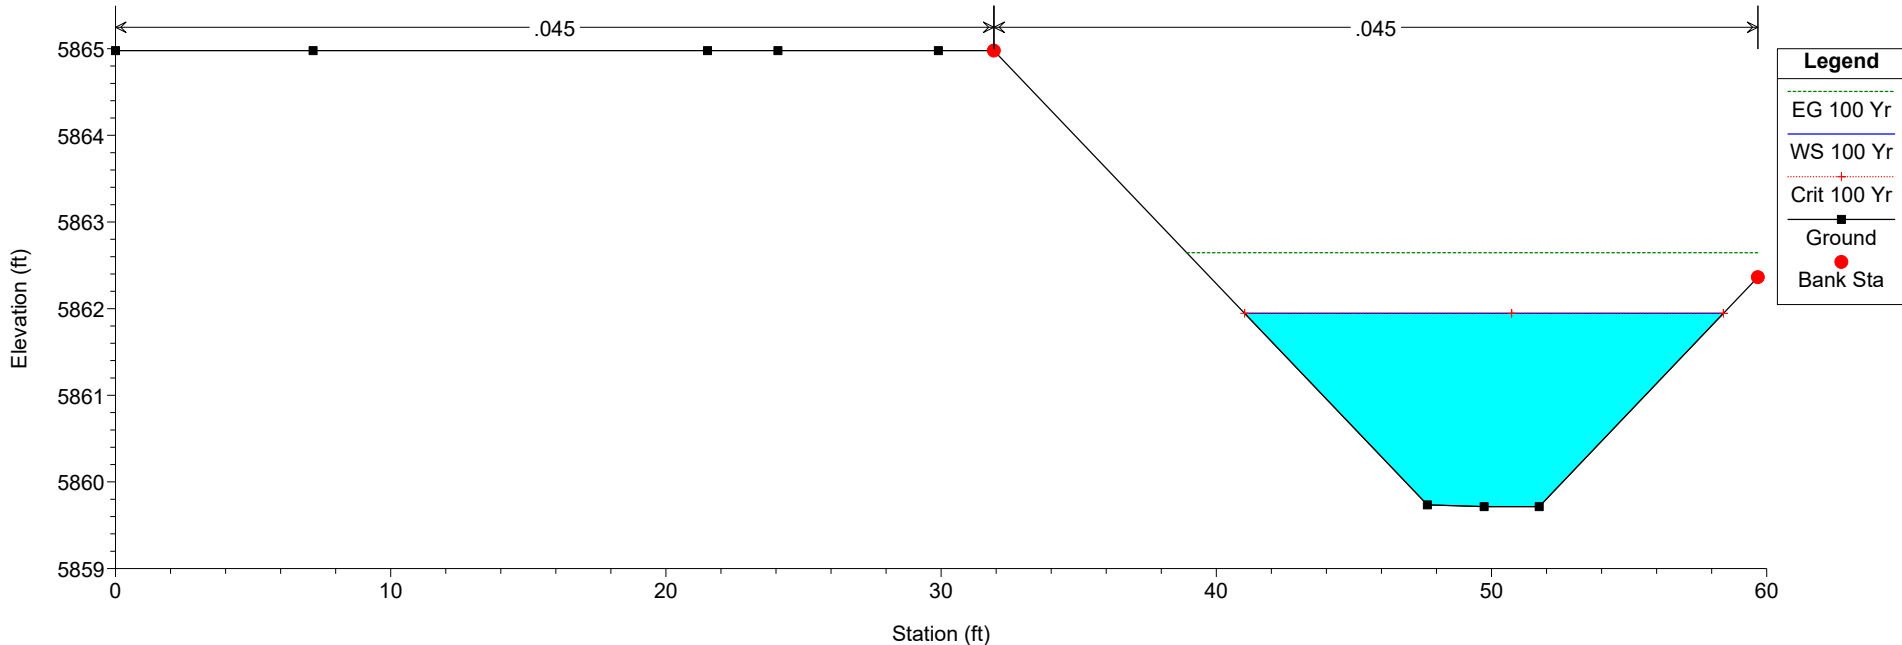


Channel Model Plan: 100-YR 7/5/2019

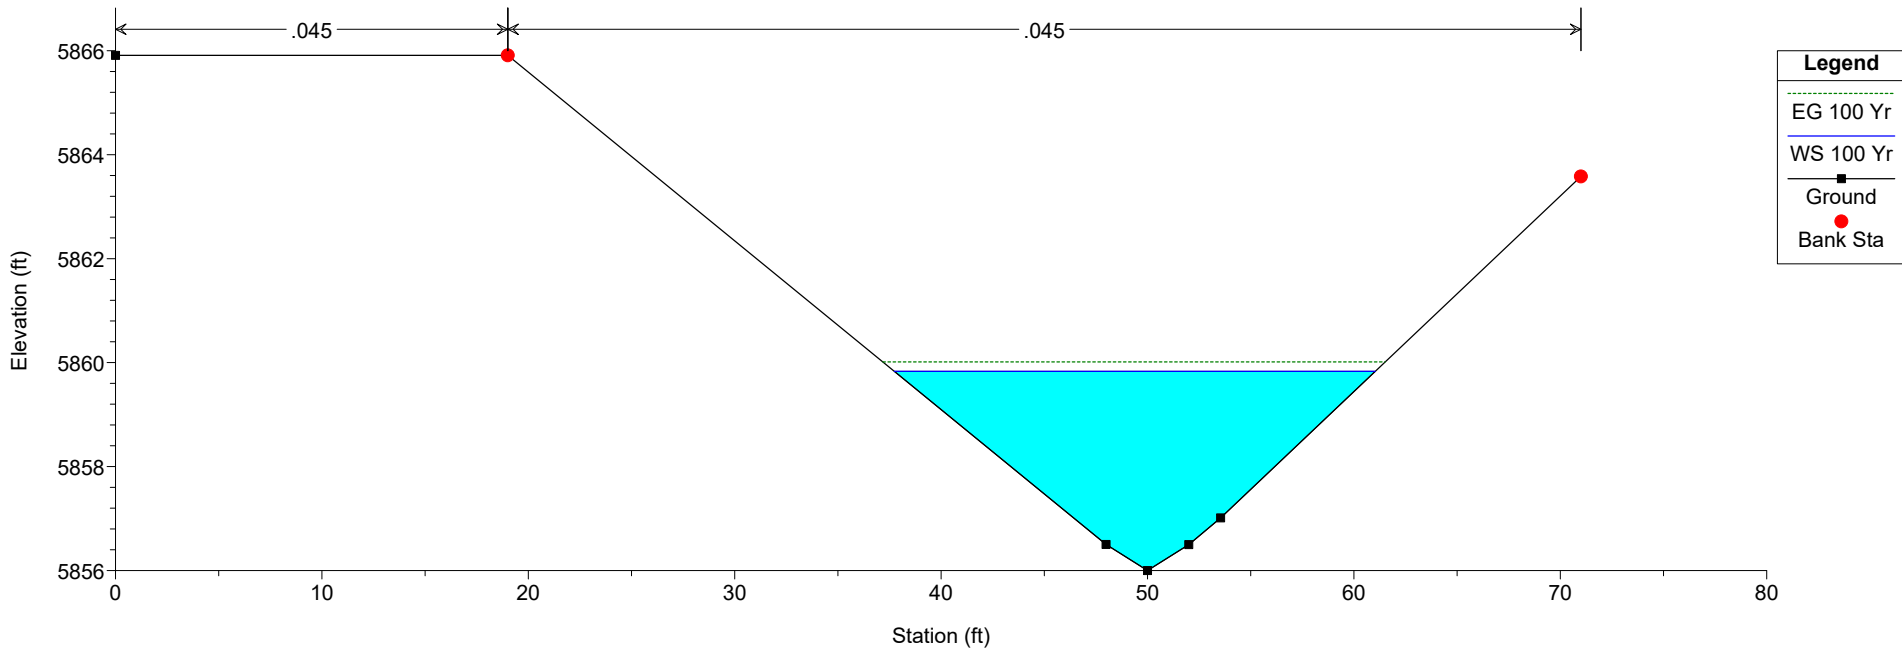


Channel Model Plan: 100-YR 7/5/2019

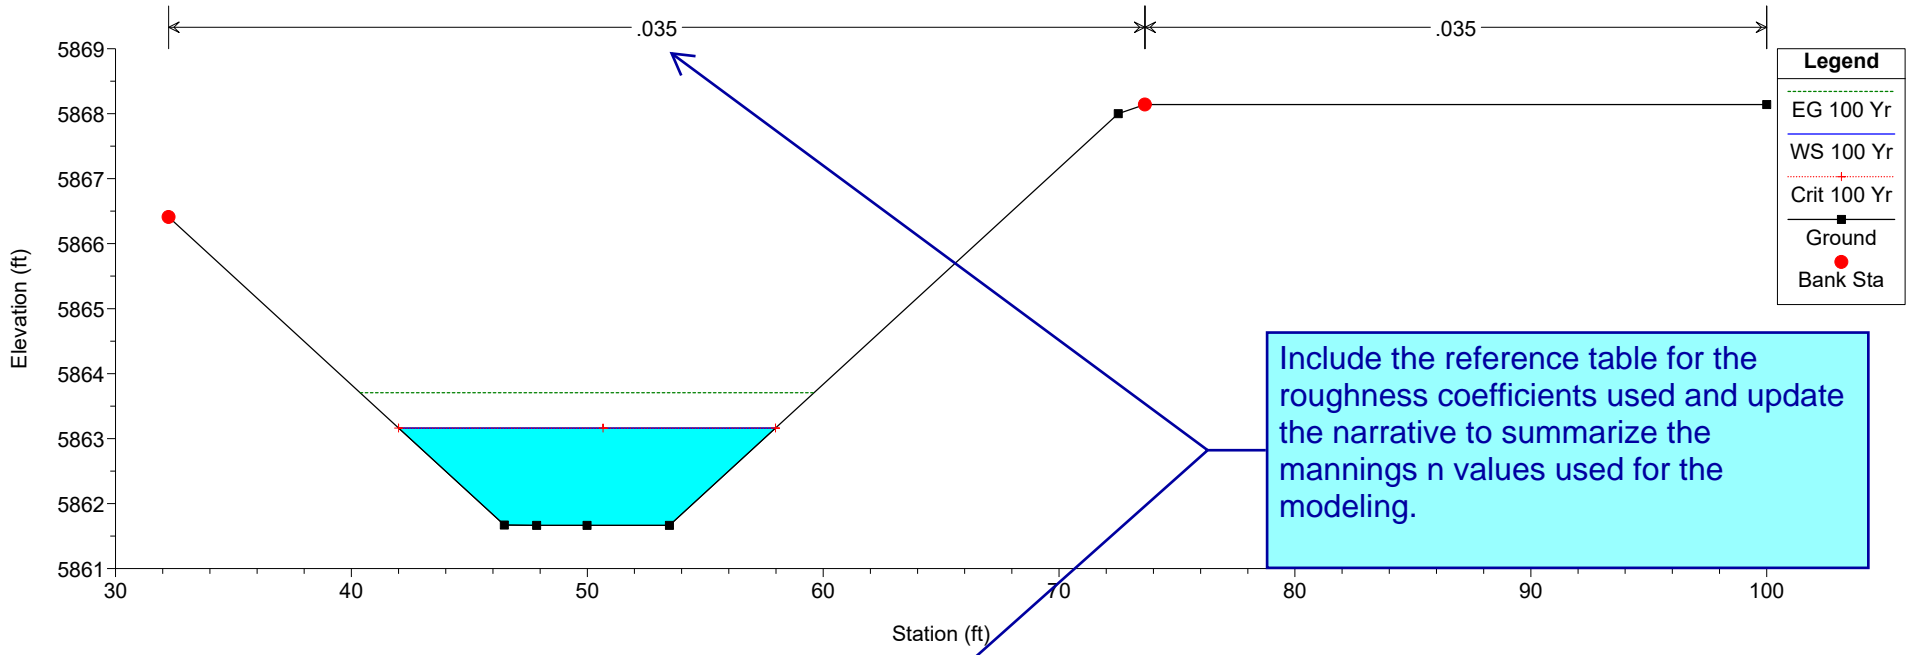


Channel Model Plan: 100-YR 7/5/2019

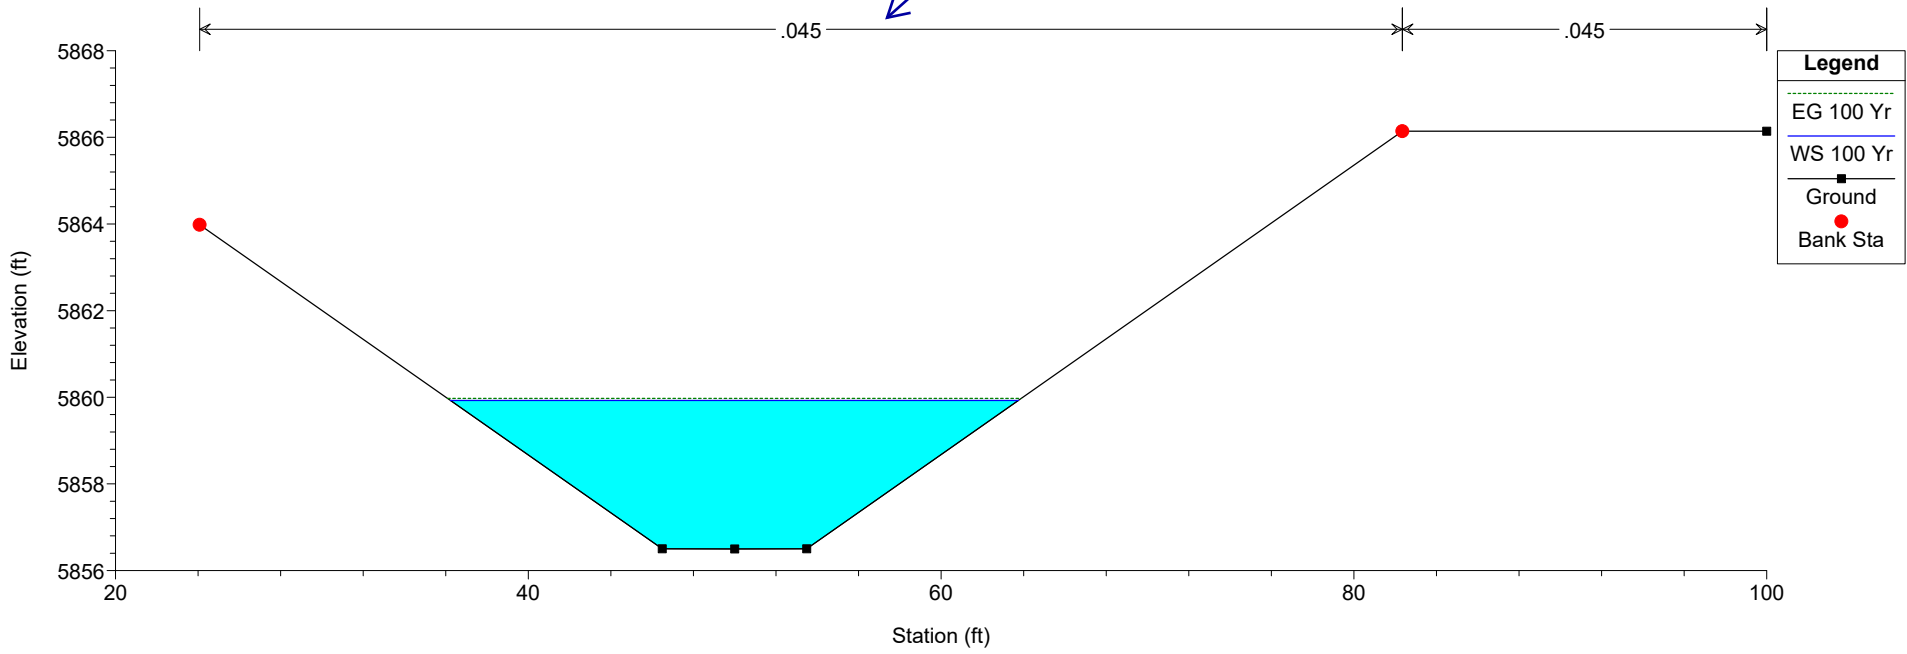


Channel Model Plan: 100-YR 7/5/2019

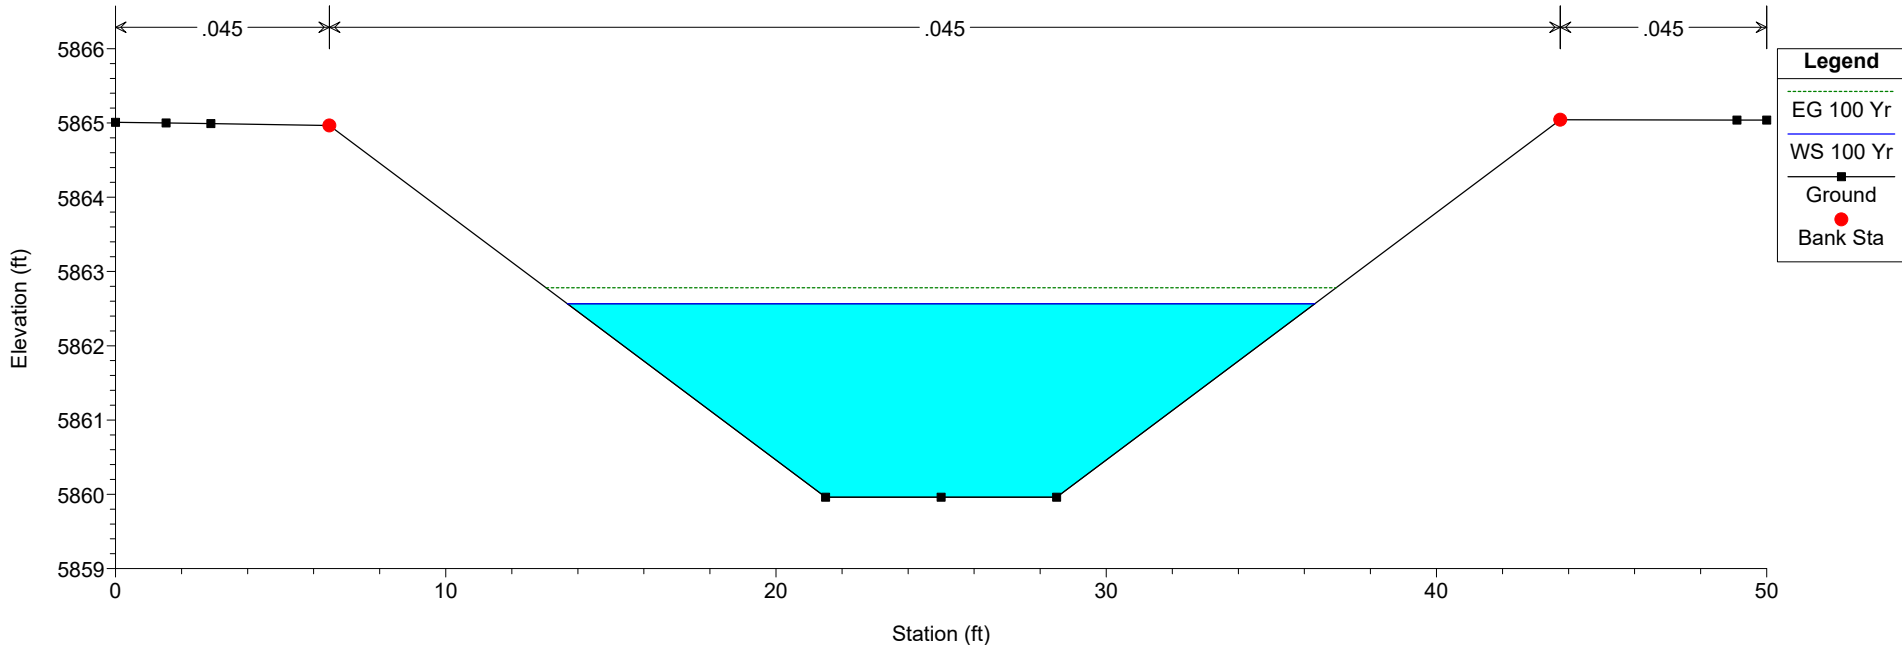


Channel Model Plan: 100-YR 7/5/2019

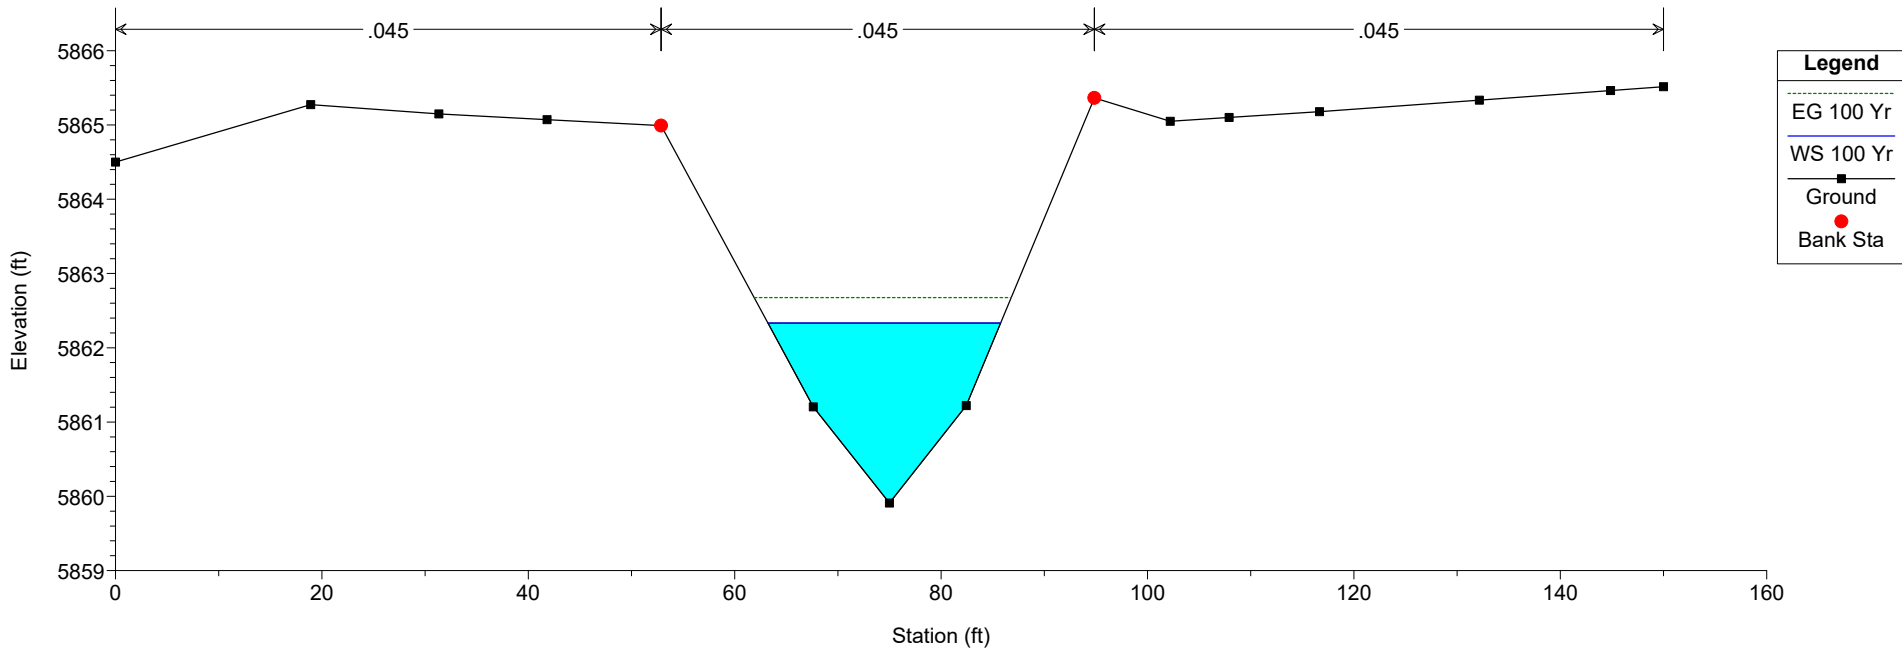

Channel Model Plan: 100-YR 7/5/2019

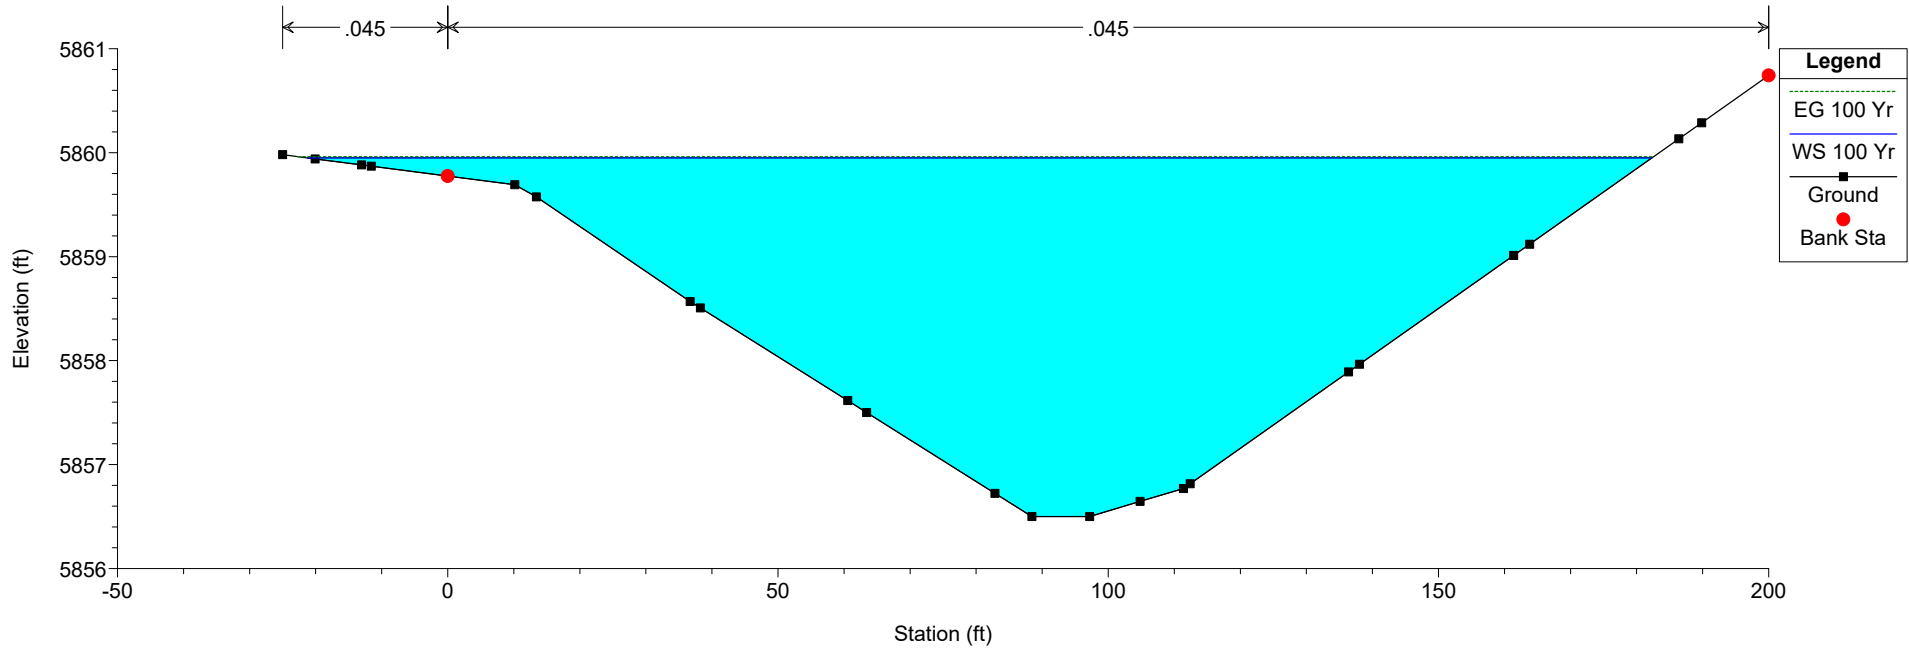

Channel Model Plan: 100-YR 7/5/2019

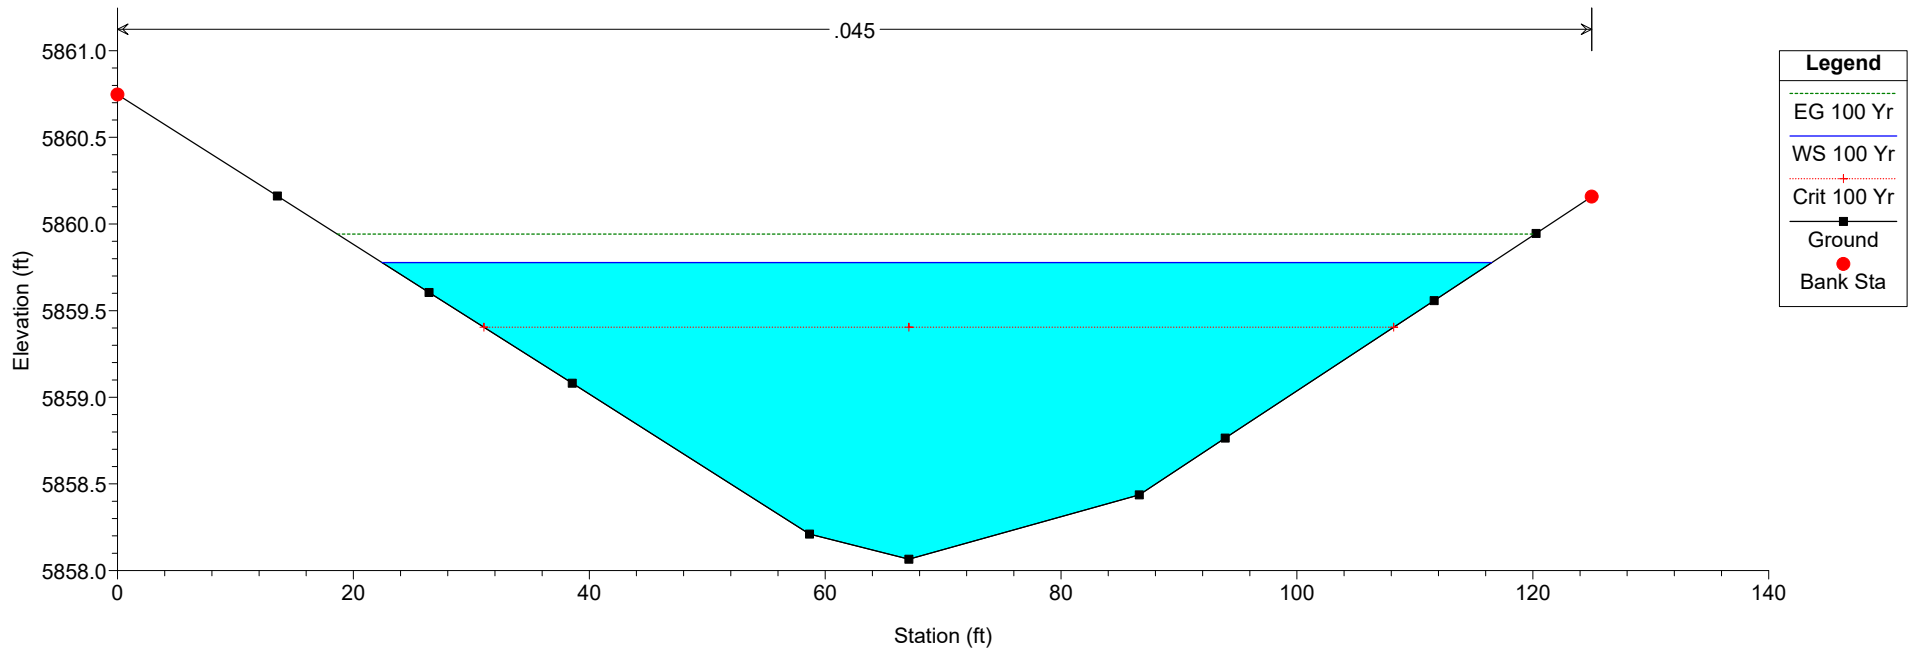

ChannelModel.rep

HEC-RAS HEC-RAS 5.0.3 September 2016
U.S. Army Corps of Engineers
Hydrologic Engineering Center
609 Second Street
Davis, California

```
X  X XXXXXX  XXXX  XXXX  XX  XXXX
X  X X  X  X  X  X  X  X  X
X  X X  X  X  X  X  X  X
XXXXXXXX XXXX  X  XXX XXXX  XXXXXX  XXXX
X  X X  X  X  X  X  X  X
X  X X  X  X  X  X  X  X
X  X XXXXXX  XXXX  X  X  X  X  XXXXX
```

PROJECT DATA

Project Title: Channel Model
Project File : ChannelModel.prj
Run Date and Time: 7/5/2019 4:12:26 PM

Project in English units

PLAN DATA

Plan Title: 100-YR
Plan File : z:\Copy\Personal\Springs at Waterview\Download - 070319\CAD\HEC-RAS\RAS
Model\ChannelModel.p01

Geometry Title: S@W - Ditch Analysis
Geometry File : z:\Copy\Personal\Springs at Waterview\Download - 070319\CAD\HEC-RAS\RAS
Model\ChannelModel.g04

Flow Title : Flow Data
Flow File : z:\Copy\Personal\Springs at Waterview\Download - 070319\CAD\HEC-RAS\RAS
Model\ChannelModel.f01

Plan Summary Information:

Number of: Cross Sections = 14 Multiple Openings = 0
Culverts = 0 Inline Structures = 0
Bridges = 0 Lateral Structures = 0

Computational Information

Water surface calculation tolerance = 0.01
Critical depth calculation tolerance = 0.01
Maximum number of iterations = 20
Maximum difference tolerance = 0.3
Flow tolerance factor = 0.001

Computation Options

Critical depth computed only where necessary

Submit the Hec-Ras model for review

ChannelModel.rep

Conveyance Calculation Method: At breaks in n values only
 Friction Slope Method: Average Conveyance
 Computational Flow Regime: Subcritical Flow

FLOW DATA

Flow Title: Flow Data
 Flow File : z:\Copy\Personal\Springs at Waterview\Download - 070319\CAD\HEC-RAS\RAS Model\ChannelModel.f01

Flow Data (cfs)

River	Reach	RS	100 Yr
North Ditch	North	460	101.57
South Ditch	South	750	16.79
South Ditch	South 2	100	160
East Ditch	East	028	143.64
Outlet	Outlet	5500	299.47
Outlet	Outlet	5000	299.47

Boundary Conditions

River	Reach	Profile	Upstream	Downstream
East Ditch	East	100 Yr	Known WS = 5863.18	Normal S = 0.01
North Ditch	North	100 Yr	Known WS = 5866.11	
Outlet	Outlet	100 Yr		
South Ditch	South	100 Yr	Known WS = 5861.73	

Why was a known WS added? Revise. There should only be normal depth at the outfall. WS is not known at the junctions.

Provide narrative explaining how these were determined and include calculations.

GEOMETRY DATA

Geometry Title: S@W - Ditch Analysis
 Geometry File : z:\Copy\Personal\Springs at Waterview\Download - 070319\CAD\HEC-RAS\RAS Model\ChannelModel.g04

Reach Connection Table

River	Reach	Upstream Boundary	Downstream Boundary
East Ditch	East		Confl
North Ditch	North		Ex Culv
Outlet	Outlet	Ex Culv	
South Ditch	South		Confl
South Ditch	South 2	Confl	Ex Culv

JUNCTION INFORMATION

Name: Ex Culv

It seems more appropriate to use the momentum equation at the culvert junction where the angle of tributary can cause significant energy losses.

Update the narrative explaining why the specific computation method is used. Additional comments may be generated.

ChannelModel.rep

Description:
Energy computation Method

Length across Junction		Tributary		Length	Angle
River	Reach	River	Reach		
North Ditch	North	to Outlet	Outlet	0	0
South Ditch	South 2	to Outlet	Outlet	0	0

Name: Confl
Description:
Energy computation Method

Length across Junction		Tributary		Length	Angle
River	Reach	River	Reach		
South Ditch	South	to South Ditch	South 2	100	0
East Ditch	East	to South Ditch	South 2	0	0

Update lengths for the junction to match the design.

Example: South Ditch XS-100 is around 35' away from junction, not 100' and east ditch XS-25 is not 0' from the East Ditch.

CROSS SECTION

RIVER: East Ditch
REACH: East RS: 028

INPUT

Description:

Station Elevation Data num= 10

Sta	Elev	Sta	Elev	Sta	Elev	Sta	Elev	Sta	Elev
0	5865.01	1.53	5865	2.89	5864.991	6.48	5864.966	21.5	5859.96
25	5859.96	28.5	5859.96	43.75	5865.043	49.1	5865.04	50	5865.039

Manning's n Values num= 3

Sta	n	Val	Sta	n	Val	Sta	n	Val
0	.045	6.48	.045	43.75	.045			

Bank Sta:	Left	Right	Lengths:	Left	Channel	Right	Coeff	Contr.	Expan.
	6.48	43.75		10	10	10	.1	.3	

CROSS SECTION OUTPUT Profile #100 Yr

E.G. Elev (ft)	5862.78	Element	Left OB	Channel	Right OB
Vel Head (ft)	0.22	Wt. n-Val.	0.045		
W.S. Elev (ft)	5862.57	Reach Len. (ft)	10.00	10.00	10.00
Crit W.S. (ft)		Flow Area (sq ft)	38.61		
E.G. Slope (ft/ft)	0.006542	Area (sq ft)	38.61		
Q Total (cfs)	143.64	Flow (cfs)	143.64		
Top Width (ft)	22.63	Top Width (ft)	22.63		
Vel Total (ft/s)	3.72	Avg. Vel. (ft/s)	3.72		
Max Chl Dpth (ft)	2.61	Hydr. Depth (ft)	1.71		
Conv. Total (cfs)	1775.9	Conv. (cfs)	1775.9		
Length Wtd. (ft)	10.00	Wetted Per. (ft)	23.48		
Min Ch El (ft)	5859.96	Shear (lb/sq ft)	0.67		
Alpha	1.00	Stream Power (lb/ft s)	2.50		
Frctn Loss (ft)	0.09	Cum Volume (acre-ft)	0.01		
C & E Loss (ft)	0.01	Cum SA (acres)	0.01		

ChannelModel.rep

Warning: The conveyance ratio (upstream conveyance divided by downstream conveyance) is less than 0.7 or greater than

1.4. This may indicate the need for additional cross sections.

CROSS SECTION

RIVER: East Ditch
REACH: East RS: 025

INPUT

Description:

Station Elevation Data num= 15

Sta	Elev	Sta	Elev	Sta	Elev	Sta	Elev	Sta	Elev
05864.501	18.915865.273	31.335865.149	41.815865.072	52.875864.991					
67.625861.203	75.5859.91	82.445861.222	94.865865.364	102.25865.051					
107.915865.102	116.665865.18	132.155865.335	144.875865.463	1505865.514					

Manning's n Values num= 3

Sta	n Val	Sta	n Val	Sta	n Val
0	.045	52.87	.045	94.86	.045

Bank Sta:	Left	Right	Lengths:	Left	Channel	Right	Coeff	Contr.	Expan.
	52.87	94.86		25	25	25	.1	.3	

CROSS SECTION OUTPUT Profile #100 Yr

	E.G. Elev (ft)	5862.68	Element	Left OB	Channel	Right OB
Vel Head (ft)	0.34	Wt. n-Val.	0.045			
W.S. Elev (ft)	5862.33	Reach Len. (ft)	0.00	0.00	0.00	
Crit W.S. (ft)		Flow Area (sq ft)	30.60			
E.G. Slope (ft/ft)	0.013892	Area (sq ft)	30.60			
Q Total (cfs)	143.64	Flow (cfs)	143.64			
Top Width (ft)	22.55	Top Width (ft)	22.55			
Vel Total (ft/s)	4.69	Avg. Vel. (ft/s)	4.69			
Max Chl Dpth (ft)	2.42	Hydr. Depth (ft)	1.36			
Conv. Total (cfs)	1218.7	Conv. (cfs)	1218.7			
Length Wtd. (ft)	0.00	Wetted Per. (ft)	23.10			
Min Ch El (ft)	5859.91	Shear (lb/sq ft)	1.15			
Alpha	1.00	Stream Power (lb/ft s)	5.39			
Frctn Loss (ft)	0.00	Cum Volume (acre-ft)				
C & E Loss (ft)	0.04	Cum SA (acres)				

CROSS SECTION

RIVER: North Ditch
REACH: North RS: 460

INPUT

Description:

Station Elevation Data num= 11

Sta	Elev	Sta	Elev	Sta	Elev	Sta	Elev	Sta	Elev
26.395869.662	39.315865.36	46.55862.964	49.845862.965	53.485863.021					
74.885870.483	80.235872.354	83.045872.585	87.155872.634	89.585872.65					

Bend must be modeled.

ChannelModel.rep

100 5872.69

Manning's n Values num= 3
 Sta n Val Sta n Val Sta n Val
 26.39 .035 26.39 .035 80.23 .035

Bank Sta: Left Right Lengths: Left Channel Right Coeff Contr. Expan.
 26.39 80.23 60 60 60 .1 .3

CROSS SECTION OUTPUT Profile #100 Yr

	E.G. Elev (ft)	5865.34	Element	Left OB	Channel	Right OB
Vel Head (ft)	0.19	Wt. n-Val.	0.035			
W.S. Elev (ft)	5865.15	Reach Len. (ft)	60.00	60.00	60.00	
Crit W.S. (ft)		Flow Area (sq ft)	28.82			
E.G. Slope (ft/ft)	0.004336	Area (sq ft)	28.82			
Q Total (cfs)	101.57	Flow (cfs)	101.57			
Top Width (ft)	19.65	Top Width (ft)	19.65			
Vel Total (ft/s)	3.52	Avg. Vel. (ft/s)	3.52			
Max Chl Dpth (ft)	2.19	Hydr. Depth (ft)	1.47			
Conv. Total (cfs)	1542.5	Conv. (cfs)	1542.5			
Length Wtd. (ft)	60.00	Wetted Per. (ft)	20.36			
Min Ch El (ft)	5862.96	Shear (lb/sq ft)	0.38			
Alpha	1.00	Stream Power (lb/ft s)	1.35			
Frctn Loss (ft)	0.23	Cum Volume (acre-ft)	0.33			
C & E Loss (ft)	0.01	Cum SA (acres)	0.21			

CROSS SECTION

RIVER: North Ditch
 REACH: North RS: 400

INPUT

Description:

Station Elevation Data num= 7
 Sta Elev Sta Elev Sta Elev Sta Elev Sta Elev
 27.565868.979 46.55862.665 49.975862.665 53.475862.665 62.385865.624
 82.185871.705 1005871.972

Manning's n Values num= 3
 Sta n Val Sta n Val Sta n Val
 27.56 .035 27.56 .035 82.18 .035

Bank Sta: Left Right Lengths: Left Channel Right Coeff Contr. Expan.
 27.56 82.18 200 200 200 .1 .3

CROSS SECTION OUTPUT Profile #100 Yr

	E.G. Elev (ft)	5865.10	Element	Left OB	Channel	Right OB
Vel Head (ft)	0.16	Wt. n-Val.	0.035			
W.S. Elev (ft)	5864.94	Reach Len. (ft)	200.00	200.00	200.00	
Crit W.S. (ft)	5864.17	Flow Area (sq ft)	31.38			
E.G. Slope (ft/ft)	0.003483	Area (sq ft)	31.38			
Q Total (cfs)	101.57	Flow (cfs)	101.57			

ChannelModel.rep

Top Width (ft)	20.64	Top Width (ft)	20.64
Vel Total (ft/s)	3.24	Avg. Vel. (ft/s)	3.24
Max Chl Dpth (ft)	2.27	Hydr. Depth (ft)	1.52
Conv. Total (cfs)	1721.0	Conv. (cfs)	1721.0
Length Wtd. (ft)	200.00	Wetted Per. (ft)	21.37
Min Ch El (ft)	5862.67	Shear (lb/sq ft)	0.32
Alpha	1.00	Stream Power (lb/ft s)	1.03
Frctn Loss (ft)	1.35	Cum Volume (acre-ft)	0.29
C & E Loss (ft)	0.04	Cum SA (acres)	0.18

Warning: The conveyance ratio (upstream conveyance divided by downstream conveyance) is less than 0.7 or greater than

1.4. This may indicate the need for additional cross sections.

Warning: The energy loss was greater than 1.0 ft (0.3 m). between the current and previous cross section. This may indicate

the need for additional cross sections.

CROSS SECTION

RIVER: North Ditch

REACH: North RS: 200

INPUT

Description:

Station Elevation Data num= 8

Sta	Elev	Sta	Elev	Sta	Elev	Sta	Elev	Sta	Elev
32.25	5866.41	46.48	5861.67	47.85	5861.665	49.99	5861.665	53.48	5861.665
72.51	5868	73.64	5868.141	100	5868.141				

Manning's n Values num= 3

Sta	n Val	Sta	n Val	Sta	n Val
32.25	.035	32.25	.035	73.64	.035

Bank Sta:	Left	Right	Lengths:	Left	Channel	Right	Coeff	Contr.	Expan.
	32.25	73.64	200	200	200	.1	.3		

CROSS SECTION OUTPUT Profile #100 Yr

E.G. Elev (ft)	5863.71	Element	Left OB	Channel	Right OB
Vel Head (ft)	0.54	Wt. n-Val.	0.035		
W.S. Elev (ft)	5863.16	Reach Len. (ft)	200.00	200.00	200.00
Crit W.S. (ft)	5863.16	Flow Area (sq ft)	17.19		
E.G. Slope (ft/ft)	0.018279	Area (sq ft)	17.19		
Q Total (cfs)	101.57	Flow (cfs)	101.57		
Top Width (ft)	15.98	Top Width (ft)	15.98		
Vel Total (ft/s)	5.91	Avg. Vel. (ft/s)	5.91		
Max Chl Dpth (ft)	1.50	Hydr. Depth (ft)	1.08		
Conv. Total (cfs)	751.3	Conv. (cfs)	751.3		
Length Wtd. (ft)	200.00	Wetted Per. (ft)	16.46		
Min Ch El (ft)	5861.67	Shear (lb/sq ft)	1.19		
Alpha	1.00	Stream Power (lb/ft s)	7.04		
Frctn Loss (ft)	0.54	Cum Volume (acre-ft)	0.18		
C & E Loss (ft)	0.15	Cum SA (acres)	0.10		

ChannelModel.rep

Warning: The energy equation could not be balanced within the specified number of iterations. The program used critical

depth for the water surface and continued on with the calculations.

Warning: The conveyance ratio (upstream conveyance divided by downstream conveyance) is less than 0.7 or greater than

1.4. This may indicate the need for additional cross sections.

Warning: The energy loss was greater than 1.0 ft (0.3 m). between the current and previous cross section. This may indicate

the need for additional cross sections.

Warning: During the standard step iterations, when the assumed water surface was set equal to critical depth, the calculated

water surface came back below critical depth. This indicates that there is not a valid subcritical answer. The program defaulted to critical depth.

CROSS SECTION

RIVER: North Ditch

REACH: North RS: 001

INPUT

Description:

Station Elevation Data num= 6

Sta	Elev	Sta	Elev	Sta	Elev	Sta	Elev	Sta	Elev
24.085863	982	46.495856	502	50	5856.5	53.495856	503	82.355866	141
1005866	141								

Manning's n Values num= 3

Sta	n Val	Sta	n Val	Sta	n Val
24.08	.045	24.08	.045	82.35	.045

Bank Sta: Left Right Coeff Contr. Expan.

24.08	82.35	.1	.3
-------	-------	----	----

CROSS SECTION OUTPUT Profile #100 Yr

		Element	Left OB	Channel	Right OB
E.G. Elev (ft)	5859.97				
Vel Head (ft)	0.05	Wt. n-Val.	0.045		
W.S. Elev (ft)	5859.93	Reach Len. (ft)	0.00	0.00	0.00
Crit W.S. (ft)		Flow Area (sq ft)	59.10		
E.G. Slope (ft/ft)	0.001030	Area (sq ft)	59.10		
Q Total (cfs)	101.57	Flow (cfs)	101.57		
Top Width (ft)	27.51	Top Width (ft)	27.51		
Vel Total (ft/s)	1.72	Avg. Vel. (ft/s)	1.72		
Max Chl Dpth (ft)	3.43	Hydr. Depth (ft)	2.15		
Conv. Total (cfs)	3164.1	Conv. (cfs)	3164.1		
Length Wtd. (ft)	0.00	Wetted Per. (ft)	28.63		
Min Ch El (ft)	5856.50	Shear (lb/sq ft)	0.13		
Alpha	1.00	Stream Power (lb/ft s)	0.23		
Frctn Loss (ft)	0.00	Cum Volume (acre-ft)			
C & E Loss (ft)	0.01	Cum SA (acres)			

CROSS SECTION

ChannelModel.rep

RIVER: Outlet
 REACH: Outlet RS: 5500

INPUT

Description:

Station Elevation Data num= 24

Sta	Elev	Sta	Elev	Sta	Elev	Sta	Elev	Sta	Elev
-255859.981	-20.08	5859.94	-13.065859.883	-11.575859.871	05859.775				
10.145859.692	13.435859.575	36.715858.569	38.255858.507	60.555857.615					
63.43	5857.5	82.865856.723	88.44	5856.5	97.18	5856.5	104.835856.646		
111.38	5856.77	112.45856.816	136.395857.891	138.035857.965	161.395859.012				
163.8	5859.12	186.395860.133	189.865860.288	2005860.743					

Manning's n Values num= 3

Sta	n Val	Sta	n Val	Sta	n Val
-25	.045	0	.045	200	.045

Bank Sta:	Left	Right	Lengths:	Left	Channel	Right	Coeff	Contr.	Expan.
	0	200		5	5	5	.1	.3	

CROSS SECTION OUTPUT Profile #100 Yr

	E.G. Elev (ft)	5859.96	Element	Left OB	Channel	Right OB
Vel Head (ft)	0.01	Wt. n-Val.	0.045	0.045		
W.S. Elev (ft)	5859.95	Reach Len. (ft)	5.00	5.00	5.00	
Crit W.S. (ft)		Flow Area (sq ft)	1.85	338.59		
E.G. Slope (ft/ft)	0.000314	Area (sq ft)	1.85	338.59		
Q Total (cfs)	299.47	Flow (cfs)	0.21	299.26		
Top Width (ft)	203.56	Top Width (ft)	21.25	182.31		
Vel Total (ft/s)	0.88	Avg. Vel. (ft/s)	0.11	0.88		
Max Chl Dpth (ft)	3.45	Hydr. Depth (ft)	0.09	1.86		
Conv. Total (cfs)	16896.5	Conv. (cfs)	12.0	16884.5		
Length Wtd. (ft)	5.00	Wetted Per. (ft)	21.25	182.44		
Min Ch El (ft)	5856.50	Shear (lb/sq ft)	0.00	0.04		
Alpha	1.01	Stream Power (lb/ft s)	0.00	0.03		
Frctn Loss (ft)	0.00	Cum Volume (acre-ft)	0.00	0.02		
C & E Loss (ft)	0.02	Cum SA (acres)	0.00	0.02		

Warning: The conveyance ratio (upstream conveyance divided by downstream conveyance) is less than 0.7 or greater than 1.4. This may indicate the need for additional cross sections.

CROSS SECTION

RIVER: Outlet
 REACH: Outlet RS: 5000

INPUT

Description:

Station Elevation Data num= 11

Sta	Elev	Sta	Elev	Sta	Elev	Sta	Elev	Sta	Elev
05860.747	13.555860.161	26.415859.605	38.565859.081	58.675858.211					
67.15858.066	86.635858.437	93.915858.764	111.635859.558	120.275859.946					

1255860.158

Manning's n Values num= 3
 Sta n Val Sta n Val Sta n Val
 0 .045 0 .045 125 .04

Bank Sta: Left Right Coeff Contr. Expan.
 0 125 .1 .3

CROSS SECTION OUTPUT Profile #100 Yr

E.G. Elev (ft)	5859.94	Element	Left OB	Channel	Right OB
Vel Head (ft)	0.16	Wt. n-Val.	0.045		
W.S. Elev (ft)	5859.78	Reach Len. (ft)			
Crit W.S. (ft)	5859.40	Flow Area (sq ft)	92.01		
E.G. Slope (ft/ft)	0.010019	Area (sq ft)	92.01		
Q Total (cfs)	299.47	Flow (cfs)	299.47		
Top Width (ft)	94.09	Top Width (ft)	94.09		
Vel Total (ft/s)	3.25	Avg. Vel. (ft/s)	3.25		
Max Chl Dpth (ft)	1.71	Hydr. Depth (ft)	0.98		
Conv. Total (cfs)	2991.8	Conv. (cfs)	2991.8		
Length Wtd. (ft)		Wetted Per. (ft)	94.16		
Min Ch El (ft)	5858.07	Shear (lb/sq ft)	0.61		
Alpha	1.00	Stream Power (lb/ft s)	1.99		
Frctn Loss (ft)		Cum Volume (acre-ft)			
C & E Loss (ft)		Cum SA (acres)			

CROSS SECTION

RIVER: South Ditch
 REACH: South RS: 750

INPUT

Description:

Station Elevation Data num= 16
 Sta Elev Sta Elev Sta Elev Sta Elev Sta Elev
 0 5871.43 6.97 5871.27 10.16 5871.149 13.62 5870.985 31.55 5868.468
 52.35 5866.903 52.57 5866.993 53.51 5866.993 54.76 5867 55.99 5866.995
 60.03 5866.999 62.52 5867.669 63.57 5868 67.4 5869 71.61 5869.181
 76.04 5869.179

Manning's n Values num= 3
 Sta n Val Sta n Val Sta n Val
 0 .035 31.5 .035 67.4 .035

Bank Sta: Left Right Lengths: Left Channel Right Coeff Contr. Expan.
 31.5 67.4 150 150 150 .1 .3

CROSS SECTION OUTPUT Profile #100 Yr

E.G. Elev (ft)	5867.57	Element	Left OB	Channel	Right OB
Vel Head (ft)	0.17	Wt. n-Val.	0.035		
W.S. Elev (ft)	5867.40	Reach Len. (ft)	150.00	150.00	150.00
Crit W.S. (ft)	5867.40	Flow Area (sq ft)	5.13		

ChannelModel.rep

E.G. Slope (ft/ft)	0.026977	Area (sq ft)	5.13
Q Total (cfs)	16.79	Flow (cfs)	16.79
Top Width (ft)	15.89	Top Width (ft)	15.89
Vel Total (ft/s)	3.27	Avg. Vel. (ft/s)	3.27
Max Chl Dpth (ft)	0.50	Hydr. Depth (ft)	0.32
Conv. Total (cfs)	102.2	Conv. (cfs)	102.2
Length Wtd. (ft)	150.00	Wetted Per. (ft)	15.98
Min Ch El (ft)	5866.90	Shear (lb/sq ft)	0.54
Alpha	1.00	Stream Power (lb/ft s)	1.77
Frctn Loss (ft)	1.50	Cum Volume (acre-ft)	0.27
C & E Loss (ft)	0.02	Cum SA (acres)	0.19

Warning: The energy equation could not be balanced within the specified number of iterations. The program used critical

depth for the water surface and continued on with the calculations.

Warning: The conveyance ratio (upstream conveyance divided by downstream conveyance) is less than 0.7 or greater than

1.4. This may indicate the need for additional cross sections.

Warning: The energy loss was greater than 1.0 ft (0.3 m). between the current and previous cross section. This may indicate

the need for additional cross sections.

Warning: During the standard step iterations, when the assumed water surface was set equal to critical depth, the calculated

water surface came back below critical depth. This indicates that there is not a valid subcritical answer. The program defaulted to critical depth.

CROSS SECTION

RIVER: South Ditch

REACH: South RS: 600

INPUT

Description:

Station Elevation Data num= 7

Sta Elev	Sta Elev	Sta Elev	Sta Elev	Sta Elev
05869.539	23.875869.532	24.985869.531	46.935862.216	48.925862.216
50.925862.216	57.375864.363			

Manning's n Values num= 3

Sta n Val	Sta n Val	Sta n Val
0 .035	24.98 .035	57.37 .035

Bank Sta:	Left	Right	Lengths:	Left	Channel	Right	Coeff	Contr.	Expan.
	24.98	57.37		200	200	200	.1	.3	

CROSS SECTION OUTPUT Profile #100 Yr

E.G. Elev (ft)	5863.31	Element	Left OB	Channel	Right OB
Vel Head (ft)	0.09	Wt. n-Val.	0.035		
W.S. Elev (ft)	5863.23	Reach Len. (ft)	200.00	200.00	200.00
Crit W.S. (ft)		Flow Area (sq ft)	7.10		
E.G. Slope (ft/ft)	0.005152	Area (sq ft)	7.10		
Q Total (cfs)	16.79	Flow (cfs)	16.79		
Top Width (ft)	10.06	Top Width (ft)	10.06		

Vel Total (ft/s)	2.36	Avg. Vel. (ft/s)	2.36
Max Chl Dpth (ft)	1.01	Hydr. Depth (ft)	0.71
Conv. Total (cfs)	233.9	Conv. (cfs)	233.9
Length Wtd. (ft)	200.00	Wetted Per. (ft)	10.39
Min Ch El (ft)	5862.22	Shear (lb/sq ft)	0.22
Alpha	1.00	Stream Power (lb/ft s)	0.52
Frctn Loss (ft)	0.20	Cum Volume (acre-ft)	0.25
C & E Loss (ft)	0.02	Cum SA (acres)	0.14

Warning: The conveyance ratio (upstream conveyance divided by downstream conveyance) is less than 0.7 or greater than

1.4. This may indicate the need for additional cross sections.

CROSS SECTION

RIVER: South Ditch
 REACH: South RS: 400

INPUT

Description:

Station Elevation Data num= 8

Sta Elev	Sta Elev	Sta Elev	Sta Elev	Sta Elev
05867.571	22.165867.571	27.475867.571	28.585867.511	47.475861.216
49.455861.216	51.455861.216	62.285864.822		

Manning's n Values num= 3

Sta n Val	Sta n Val	Sta n Val
0 .035	28.58 .035	62.28 .035

Bank Sta: Left	Right	Lengths: Left	Channel	Right	Coeff Contr.	Expan.
28.58	62.28	200	200	200	.1	.3

CROSS SECTION OUTPUT Profile #100 Yr

E.G. Elev (ft)	5863.09	Element	Left OB	Channel	Right OB
Vel Head (ft)	0.01	Wt. n-Val.	0.035		
W.S. Elev (ft)	5863.07	Reach Len. (ft)	200.00	200.00	200.00
Crit W.S. (ft)		Flow Area (sq ft)	17.74		
E.G. Slope (ft/ft)	0.000423	Area (sq ft)	17.74		
Q Total (cfs)	16.79	Flow (cfs)	16.79		
Top Width (ft)	15.13	Top Width (ft)	15.13		
Vel Total (ft/s)	0.95	Avg. Vel. (ft/s)	0.95		
Max Chl Dpth (ft)	1.86	Hydr. Depth (ft)	1.17		
Conv. Total (cfs)	816.1	Conv. (cfs)	816.1		
Length Wtd. (ft)	200.00	Wetted Per. (ft)	15.73		
Min Ch El (ft)	5861.22	Shear (lb/sq ft)	0.03		
Alpha	1.00	Stream Power (lb/ft s)	0.03		
Frctn Loss (ft)	0.03	Cum Volume (acre-ft)	0.19		
C & E Loss (ft)	0.00	Cum SA (acres)	0.08		

Warning: The conveyance ratio (upstream conveyance divided by downstream conveyance) is less than 0.7 or greater than

1.4. This may indicate the need for additional cross sections.

CROSS SECTION

RIVER: South Ditch
 REACH: South RS: 200

INPUT

Description:

Station Elevation Data num= 8
 Sta Elev Sta Elev Sta Elev Sta Elev Sta Elev
 05865.571 10.015865.571 27.475865.571 31.755865.553 485860.216
 49.995860.216 51.995860.216 66.265864.968

Manning's n Values num= 3
 Sta n Val Sta n Val Sta n Val
 0 .035 31.75 .035 66.26 .035

Bank Sta: Left Right Lengths: Left Channel Right Coeff Contr. Expan.
 31.75 66.26 100 100 100 .1 .3

CROSS SECTION OUTPUT Profile #100 Yr

E.G. Elev (ft)	5863.06	Element	Left OB	Channel	Right OB
Vel Head (ft)	0.00	Wt. n-Val.	0.035		
W.S. Elev (ft)	5863.05	Reach Len. (ft)	100.00	100.00	100.00
Crit W.S. (ft)		Flow Area (sq ft)	35.67		
E.G. Slope (ft/ft)	0.000065	Area (sq ft)	35.67		
Q Total (cfs)	16.79	Flow (cfs)	16.79		
Top Width (ft)	21.15	Top Width (ft)	21.15		
Vel Total (ft/s)	0.47	Avg. Vel. (ft/s)	0.47		
Max Chl Dpth (ft)	2.84	Hydr. Depth (ft)	1.69		
Conv. Total (cfs)	2085.5	Conv. (cfs)	2085.5		
Length Wtd. (ft)	100.00	Wetted Per. (ft)	22.06		
Min Ch El (ft)	5860.22	Shear (lb/sq ft)	0.01		
Alpha	1.00	Stream Power (lb/ft s)	0.00		
Frctn Loss (ft)	0.34	Cum Volume (acre-ft)	0.07		
C & E Loss (ft)	0.07	Cum SA (acres)			

Warning: The velocity head has changed by more than 0.5 ft (0.15 m). This may indicate the need for additional cross sections.

CROSS SECTION

RIVER: South Ditch
 REACH: South 2 RS: 100

INPUT

Description:

Station Elevation Data num= 11
 Sta Elev Sta Elev Sta Elev Sta Elev Sta Elev
 05864.977 7.185864.977 21.515864.977 24.075864.977 29.95864.978
 31.925864.978 47.675859.736 49.735859.715 51.735859.715 59.67 5862.36

59.685862.363

Manning's n Values num= 3
 Sta n Val Sta n Val Sta n Val
 0 .045 31.92 .045 59.68 .045

Bank Sta: Left Right Lengths: Left Channel Right Coeff Contr. Expan.
 31.92 59.68 100 100 100 .1 .3

CROSS SECTION OUTPUT Profile #100 Yr

E.G. Elev (ft)	5862.65	Element	Left OB	Channel	Right OB
Vel Head (ft)	0.70	Wt. n-Val.	0.045		
W.S. Elev (ft)	5861.95	Reach Len. (ft)	100.00	100.00	100.00
Crit W.S. (ft)	5861.95	Flow Area (sq ft)	23.84		
E.G. Slope (ft/ft)	0.028635	Area (sq ft)	23.84		
Q Total (cfs)	160.00	Flow (cfs)	160.00		
Top Width (ft)	17.40	Top Width (ft)	17.40		
Vel Total (ft/s)	6.71	Avg. Vel. (ft/s)	6.71		
Max Chl Dpth (ft)	2.23	Hydr. Depth (ft)	1.37		
Conv. Total (cfs)	945.5	Conv. (cfs)	945.5		
Length Wtd. (ft)	100.00	Wetted Per. (ft)	18.12		
Min Ch El (ft)	5859.72	Shear (lb/sq ft)	2.35		
Alpha	1.00	Stream Power (lb/ft s)	15.79		
Frctn Loss (ft)	0.93	Cum Volume (acre-ft)	0.08		
C & E Loss (ft)	0.16	Cum SA (acres)	0.05		

Warning: The energy equation could not be balanced within the specified number of iterations. The program used critical

depth for the water surface and continued on with the calculations.

Warning: The velocity head has changed by more than 0.5 ft (0.15 m). This may indicate the need for additional cross sections.

Warning: The conveyance ratio (upstream conveyance divided by downstream conveyance) is less than 0.7 or greater than

1.4. This may indicate the need for additional cross sections.

Warning: The energy loss was greater than 1.0 ft (0.3 m). between the current and previous cross section. This may indicate

the need for additional cross sections.

Warning: During the standard step iterations, when the assumed water surface was set equal to critical depth, the calculated

water surface came back below critical depth. This indicates that there is not a valid subcritical answer. The program defaulted to critical depth.

CROSS SECTION

RIVER: South Ditch
 REACH: South 2 RS: 000

INPUT

Description:

Station Elevation Data num= 7
 Sta Elev Sta Elev Sta Elev Sta Elev Sta Elev
 05865.912 19.015865.912 47.995856.502 50 5856 52 5856.5

53.545857.012 715863.582

Manning's n Values num= 3
 Sta n Val Sta n Val Sta n Val
 0 .045 19.01 .045 71 .045

Bank Sta: Left Right Coeff Contr. Expan.
 19.01 71 .1 .3

CROSS SECTION OUTPUT Profile #100 Yr

E.G. Elev (ft)	5860.01	Element	Left OB	Channel	Right OB
Vel Head (ft)	0.18	Wt. n-Val.	0.045		
W.S. Elev (ft)	5859.83	Reach Len. (ft)	0.00	0.00	0.00
Crit W.S. (ft)		Flow Area (sq ft)	46.71		
E.G. Slope (ft/ft)	0.004562	Area (sq ft)	46.71		
Q Total (cfs)	160.00	Flow (cfs)	160.00		
Top Width (ft)	23.29	Top Width (ft)	23.29		
Vel Total (ft/s)	3.43	Avg. Vel. (ft/s)	3.43		
Max Chl Dpth (ft)	3.83	Hydr. Depth (ft)	2.01		
Conv. Total (cfs)	2368.8	Conv. (cfs)	2368.8		
Length Wtd. (ft)	0.00	Wetted Per. (ft)	24.54		
Min Ch El (ft)	5856.00	Shear (lb/sq ft)	0.54		
Alpha	1.00	Stream Power (lb/ft s)	1.86		
Frctn Loss (ft)	0.00	Cum Volume (acre-ft)			
C & E Loss (ft)	0.05	Cum SA (acres)			

SUMMARY OF MANNING'S N VALUES

River:East Ditch

Reach	River Sta.	n1	n2	n3
East	028	.045	.045	.045
East	025	.045	.045	.045

River:North Ditch

Reach	River Sta.	n1	n2	n3
North	460	.035	.035	.035
North	400	.035	.035	.035
North	200	.035	.035	.035
North	001	.045	.045	.045

River:Outlet

Reach	River Sta.	n1	n2	n3
Outlet	5500	.045	.045	.045
Outlet	5000	.045	.045	.04

River:South Ditch

Reach	River Sta.	n1	n2	n3
South	750	.035	.035	.035
South	600	.035	.035	.035
South	400	.035	.035	.035
South	200	.035	.035	.035
South 2	100	.045	.045	.045
South 2	000	.045	.045	.045

SUMMARY OF REACH LENGTHS

River: East Ditch

Reach	River Sta.	Left	Channel	Right
East	028	10	10	10
East	025	25	25	25

River: North Ditch

Reach	River Sta.	Left	Channel	Right
North	460	60	60	60
North	400	200	200	200
North	200	200	200	200
North	001			

River: Outlet

Reach	River Sta.	Left	Channel	Right
Outlet	5500	5	5	5
Outlet	5000			

River: South Ditch

Reach	River Sta.	Left	Channel	Right
South	750	150	150	150
South	600	200	200	200
South	400	200	200	200
South	200	100	100	100
South 2	100	100	100	100
South 2	000			

SUMMARY OF CONTRACTION AND EXPANSION COEFFICIENTS

River: East Ditch

Reach	River Sta.	Contr.	Expan.
East	028	.1	.3
East	025	.1	.3

River: North Ditch



Reach	River Sta.	Contr.	Expan.
North	460	.1	.3
North	400	.1	.3
North	200	.1	.3
North	001	.1	.3

River: Outlet

Reach	River Sta.	Contr.	Expan.
Outlet	5500	.1	.3
Outlet	5000	.1	.3

River: South Ditch

Reach	River Sta.	Contr.	Expan.
South	750	.1	.3
South	600	.1	.3
South	400	.1	.3
South	200	.1	.3
South 2	100	.1	.3
South 2	000	.1	.3

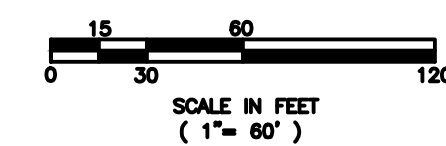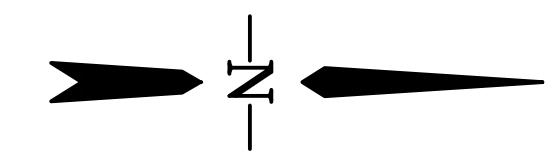

LEGEND

- EXISTING 2' CONTOUR
- EXISTING 10' CONTOUR
- DITCH CENTERLINE
- PROPOSED 2' CONTOUR
- PROPOSED 10' CONTOUR
- PROPOSED BASIN BOUNDARY
- PROPOSED FLOW PATH
- DESIGN POINT
- BASIN LABEL

The simplified open channel calculation provided in the worksheet is not an appropriate modeling for this open channel.

There is significant flow exiting the 48" pipe to the east which then has to make a 90 degree turn (DP 42a). Scouring would likely occur at the bank.

Another situation is the interface of the existing 72" RCP where two opposing flows are converging and making a 90 degree turn at DP 43.

Draw a revision cloud around the area pertinent to this amendment and label accordingly.

Show the limits of the 100 yr. flow at the open channels.

Label each channel.

DESIGN POINT	Q (5)	Q (100)
11	1.6	3.1
32	1.3	2.4
A	0.3	4.3
B	0.8	2.3
C	0.8	2.1
D	2.4	6.7
E	1.6	4.7
F	0.2	3.1
G	3.1	7.1
K	11.5	24.1
39	1.1	2.5
41	0.5	1.0
42a	11.9	26.3
43	4.0	9.2

Update to provide the combined flow at the design points.

Add a footnote on the table referencing the approved FDR for detailed calculations. Asterisk any DP that's changed and provide the calculation.

Fix viewport so that basin label is visible.

Show the existing and proposed contours.

Show and label all storm sewers. It appears that they have been turned off/removed.

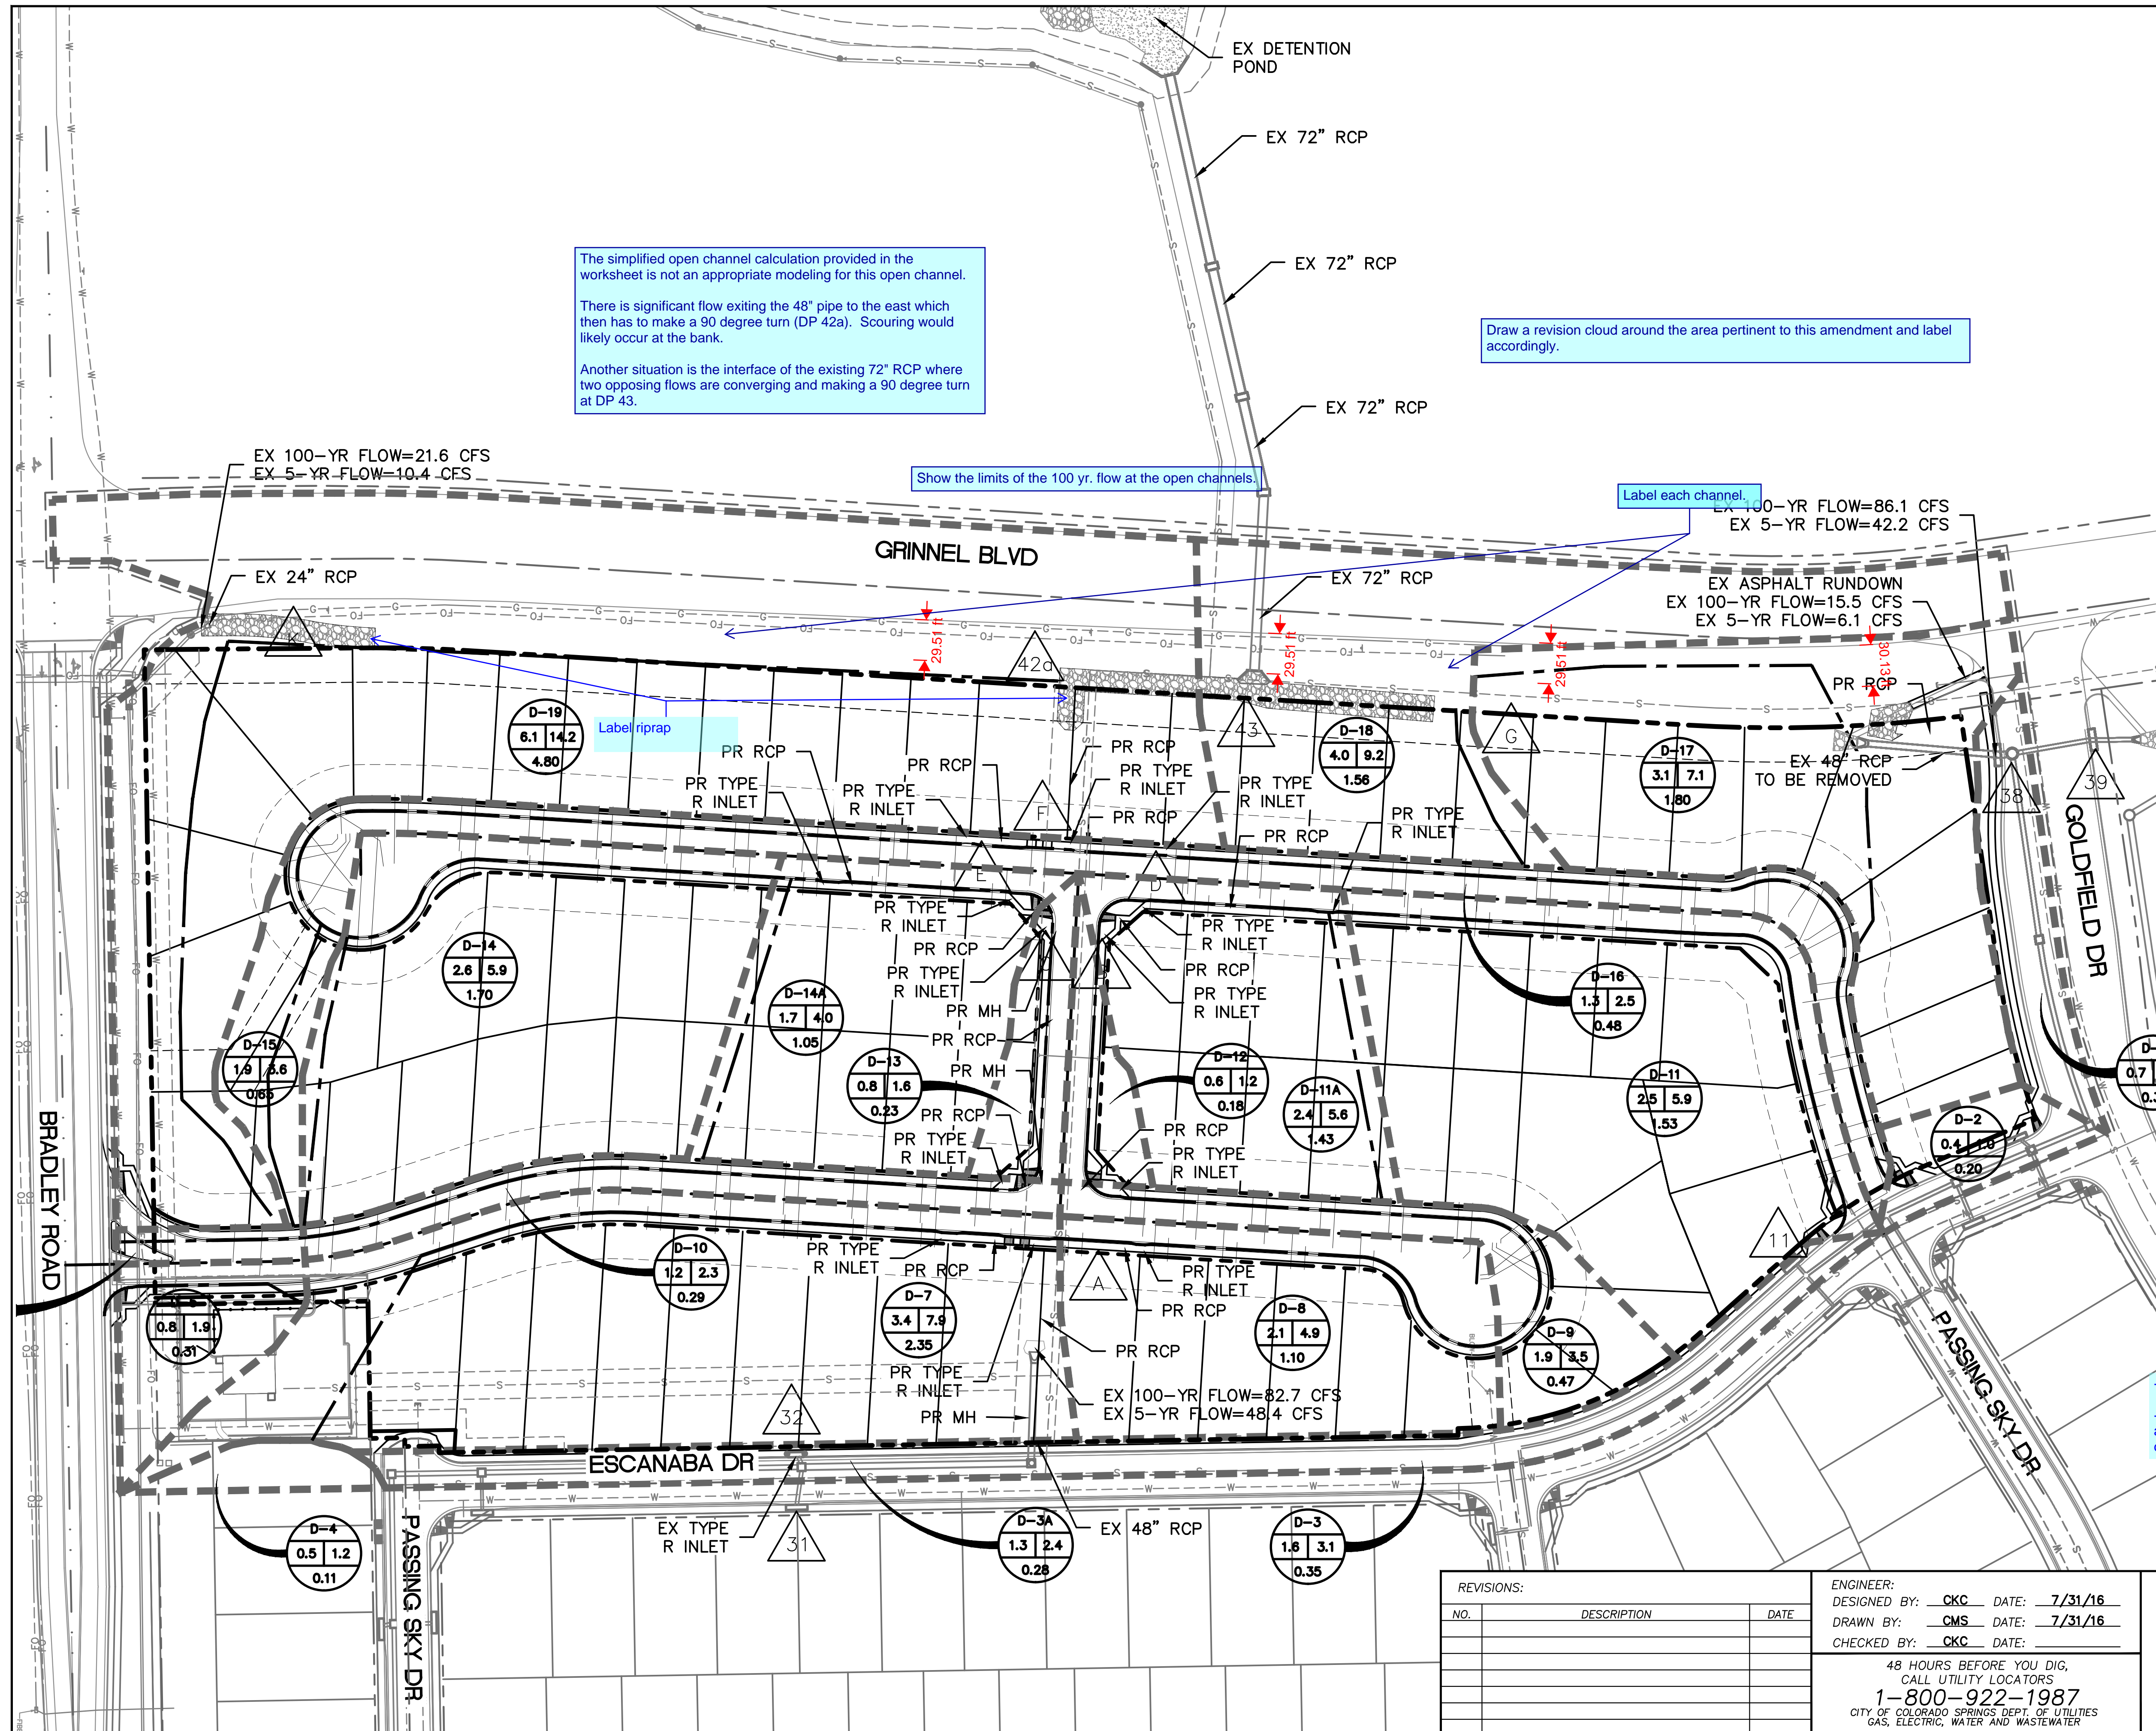


FIGURE 4

REVISIONS:		
NO.	DESCRIPTION	DATE

ENGINEER: _____
 DESIGNED BY: CKC DATE: 7/31/16
 DRAWN BY: CMS DATE: 7/31/16
 CHECKED BY: CKC DATE: _____

48 HOURS BEFORE YOU DIG,
 CALL UTILITY LOCATORS
1-800-922-1987
 CITY OF COLORADO SPRINGS DEPT. OF UTILITIES
 GAS, ELECTRIC, WATER AND WASTEWATER

DSE Dakota Springs Engineering
 31 N. TEJON, SUITE 315
 COLORADO SPRINGS, CO 80903
 P: (719) 227-7388
 F: (719) 227-7392

PROJECT SPRINGS AT WATERVIEW
 SHEET TITLE PROPOSED DRAINAGE MAP
 FROM n/a TO n/a
 JOB NO. 16-01 SHEET 1 OF 1