

RENEHAN SUBDIVISION

A PORTION OF THE EAST HALF OF THE SOUTHEAST QUARTER OF SECTION 13,
TOWNSHIP 12 SOUTH, RANGE 66 WEST OF THE 6TH P.M.,
IN EL PASO COUNTY, COLORADO

BE IT KNOWN BY THESE PRESENTS:

That Bradley W. Renehan, Sandra L. Renehan, Jeffrey N. Renehan and Julie A. Renehan, being the owners of the following described tract of land to wit:

A tract of land located in the East Half (E2) of the Southeast Quarter (SE4) of Section 13, Township 12 South (T12S), Range 66 West (R66W) of the 6th P.M., County of El Paso, State of Colorado, as described in Warranty Deed recorded under Reception No. 213007142 in the records of the Clerk and Recorder's Office of said County, being more particularly described as follows:

Commencing at the Southwest corner of the East Half (E2) of said Southeast Quarter (SE4); thence N00°50'30"W along the West line of said East Half (E2), a distance of 1547.24 feet to the Point of Beginning of the tract herein described; thence continuing along the West line of said East Half (E2), N00°54'21"W, a distance of 434.40 feet to a point on the North line of the South Half (S2) of the Northeast Quarter (NE4) of said Southeast Quarter (SE4); thence N89°30'14"E along said North line, a distance of 1327.97 feet to a point on the East line of said Section 13; thence along the East line of said Section 13, S00°43'00"E, a distance of 1950.70 feet to a point thirty feet (30') North of the Southeast corner of said Section 13; thence S89°27'51"W, thirty feet (30') North of and parallel to the South line of said Section 13, a distance of 605.47 feet; thence N00°50'30"W, a distance of 1517.24 feet; thence S89°27'51"W, a distance of 717.75 feet to the Point of Beginning;

Said tract contains 34.368 acres (1,497,074 square feet), more or less.

Owners Certificate

The undersigned, being all the owners, mortgagees, beneficiaries of deeds of trust and holders of other interests in the land described herein, have laid out, subdivided, and platted said lands into lots, tracts, streets, and easements (use which are applicable) as shown hereon under the name and subdivision of _____ . All public improvements so platted are hereby dedicated to public use and said owner does hereby covenant and agree that the public improvements will be constructed to El Paso County standards and that proper drainage and erosion control for same will be provided at said owner's expense, all to the satisfaction of the Board of County Commissioners of El Paso County, Colorado. Upon acceptance by resolution, all public improvements so dedicated will become matters of maintenance by El Paso County, Colorado. The utility easements shown hereon are hereby dedicated in for public utilities and communication systems and other purposes as shown hereon. The entities responsible for providing the services for which the easements are established are hereby granted the perpetual right of ingress and egress from and to adjacent properties for installation, maintenance, and replacement of utility lines and related facilities.

_____ subdivided, and platted said land into lots, public utility systems and other purposes as shown hereon. The utility easements are hereby granted the perpetual right of replacement of utility lines and related facilities.

Owners/Mortgagee (Signature) _____
By: _____ Julie A. Renehan
Title: _____

ATTEST: (if corporation)
Secretary/Treasurer _____
STATE OF COLORADO)
COUNTY OF _____)
_____ by Bradley W. Renehan, Sandra L. Renehan,

Acknowledged before me this _____ day of _____, 20____, by _____
My commission expires _____
Witness my hand and official seal _____
Notary Public _____
Signatures of officers signing for a corporation shall be acknowledged as follows:
(print name) as President/Vice President and print name as Secretary/Treasurer, name of corporation, a state corporation. _____ Notary Public

Signatures of managers/members for a LLC shall be acknowledged as follows:
(print name) as Manager/Member of company, a state limited liability company. _____
(Note: Required when separate ratification statements for deed of trust holders, mortgagees are not utilized)

NOTES:

- - Indicates survey monument recovered as a #4 rebar with Surveyor's Cap, PLS #20681.
● - Indicates recovered survey monument as noted.
- This survey does not constitute a title search by LDC, Inc. to determine ownership or easements of record. For all information regarding easements, rights-of-way and title of record, LDC, Inc. relied upon an ALTA Commitment for Title Insurance prepared by STEWART TITLE GUARANTY COMPANY, Commitment No. 1978475-10 dated March 22, 2023 at 8:00 a.m.
- Individual lot purchasers are responsible for constructing driveways. No driveway shall be established unless an access permit has been granted by El Paso County.
- Each individual property owner is responsible for the construction and operation of a non-evaporative wastewater disposal system approved by the El Paso County Health Department. The Health Department may require a specially designed, or "engineered," system prior to permit approval. Engineered systems may cost more to design, install and maintain than systems which are not engineered.
- Basis of Bearings: All bearings are based on that Southerly boundary line, said line also being coincident with the Northerly right-of-way line of Burgess Road (60' public r.o.w.), being a #4 rebar and cap marked "PLSC RLS 25968" at each end, and a line between them assumed to bear S89°27'52"W, a distance of 605.47 feet.
- All structural foundations shall be located and designed by a Professional Engineer, currently registered in the State of Colorado.
- The private driveway as shown on this plat will not be maintained by El Paso County. A Declaration of Easement and Joint Driveway Maintenance is recorded under Reception No. _____ of the records of El Paso County, Colorado.
- FEDERAL EMERGENCY MANAGEMENT AGENCY, Flood Insurance Rate Map Number 08041CO315 G, effective date December 7, 2018 indicates the area in the vicinity of this parcel of land to be a Zone X (area determined to be out of the 500 year flood plain).
- (1581) - Indicates property address. The addresses exhibited on this plat are for informational purposes only. They are not the legal description and are subject to change.
- Fire protection to be provided by Black Forest Fire Rescue Protection District.
- Unless otherwise indicated, side, front and rear lot lines are hereby platted on each side with a ten foot Public Utility and Drainage Easement, as shown hereon. All exterior subdivision boundaries shall have a twenty foot Public Utility and Drainage Easement, as modified in the vicinity of the driveway cul-de-sac. The sole responsibility for maintenance of these easements is hereby vested with the individual property owners.
- The following reports and/or documentation have been submitted in association with the Final Plat for this subdivision and are on file at the County Planning and Community Development Department: Transportation Memorandum; Drainage Report; Water Resources Report; Wastewater Disposal Report; Geology and Soils Report; Wildfire Hazard Report; Fire Protection Report and Natural Features Report.
- All property owners are responsible for maintaining proper storm water drainage in and through their property. Public drainage easements as specifically noted on the plat shall be maintained by the individual lot owners unless otherwise indicated. Structures, fences, materials or landscaping that could impede the flow of runoff shall not be placed in drainage easements.
- Environmental: Developer shall comply with federal and state laws, regulations, ordinances, review and permit requirements, and other agency requirements, if any, of applicable agencies including, but not limited to, the Colorado Division of Wildlife, Colorado Department of Transportation, U.S. Army Corps of Engineers and the U.S. Fish and Wildlife Service regarding the Endangered Species Act, particularly as it relates to the listed species (e.g., Preble's Meadow Jumping Mouse).
- Mailboxes shall be installed in accordance with all El Paso County and United States Postal Service regulations.

NOTES (CONT.):

- Any person who knowingly removes, alters or defaces any public land survey monument or land boundary monument or accessory commits a Class Two (2) Misdemeanor pursuant to C.R.S. 18-4-508.
 - The subdivider(s) agrees on behalf of him/herself and any developer or builder successors and assignees that subdivider and/or said successors and assigns shall be required to pay traffic impact fees in accordance with El Paso County Road Impact Fee Program Resolution (Resolution No. 19-471), or any amendments thereto, at or prior to the time of building permit submittals. The fee obligation, if not paid at final plat recording, shall be documented on all sales documents and n plat notes to ensure that a title search would find the fee obligation before sale of the property.
 - Individual wells are the responsibility of each property owner. permits for individual wells must be obtained from the State Engineer who by law has the authority to set conditions for the issuance of these permits. water in the Denver Basin aquifers is allocated based on a 100-year aquifer life; however, for El Paso county planning purposes, water in the Denver Basin aquifers is evaluated based on a 300-year aquifer life. Applicants and all future owners of the subdivision should be aware that the economic life of a water supply based on wells in a given Denver Basin aquifer may be less than either the 100 years or 300 years indicated due to anticipated water level declines. Furthermore, the water supply plan should not rely solely on non-renewable aquifers. alternate renewable water resources should be acquired and incorporated in a permanent water supply plan that provides future generations with a water supply.
- Property is subject to terms therefore granted by Decree in the District Court, Water Division 2, State of Colorado and filed for record in the Central Files as Case Number 00CW99 dated May 21, 2001 and June 29, 2001.
- Soil and Geologic Conditions: Areas within this subdivision have been found to be impacted by potential geologic constraints as detailed in the Soil, Geology, and Geologic Hazard Study for RENEHAN SUBDIVISION prepared by ENTECH ENGINEERING, INC. and dated February 3, 2023. The report is available in the El Paso County Planning and Community Development Department records (www.epcddevelopment.com) under File Number MS238. The report includes mapping of any potential hazard areas within the subdivision. A description of uncollected lots, potential constraints and mitigation measures are listed below. No buildable areas of the site exceed 8% in grade. Individual soils investigations and foundation designs for all new building sites and septic systems are required once building locations have been determined. Should groundwater or bedrock be encountered within 6 feet of the surface, designed onsite wastewater systems are required. Wastewater absorption fields must be located at least 100 feet from any well, 50 feet from drainages, floodplains or ponded areas and 25 feet from dry gulches.
- Lot 3: Potentially seasonal shallow ground water area within the most Westerly buildable are of the lot.
- Lineal units shown hereon are US Survey Feet.
 - No obstruction greater than eighteen inches (18") are allowed in the fifty foot (50') by fifty foot (50') sight triangle no-build areas from the driveway width each side to Burgess Road right-of-way addition near the corner lot at the drive/road intersection.
 - No direct vehicular access to/from Lot 1 will be allowed except via the indicated Private Driveway.

Environmental:
Developer shall comply with federal and state laws, regulations, ordinances, review and permit requirements, and other agency requirements, if any, of applicable agencies including, but not limited to, the Colorado Division of Wildlife, Colorado Department of Transportation, U.S. Army Corps of Engineers and the U.S. Fish and Wildlife Service regarding the Endangered Species Act, particularly as it relates to the listed species (e.g., Preble's Meadow Jumping Mouse).

Revise to add the following sentence: "El Paso County is not responsible for the maintenance of driveways."

Wastewater:
Sewage treatment is the responsibility of each individual property owner. The El Paso County Department of Health and Environment must approve each system and, in some cases the Department may require an engineer designed system prior to permit approval. These systems may cost more to design, install, and maintain. Soils and Geology conditions on site require that all (or certain lots) On-Site Wastewater Systems shall be located and designed by a Professional Engineer, currently registered in the State of Colorado. (Note: this note used in special cases only when requested by the Health Department or pursuant to a condition of approval)
Water and wastewater service for this subdivision is provided by the _____ (District or provider name(s)) subject to the District's (Providers) rules, regulations and specifications. (Combined notes, which can be broken into separate notes for water or sewer in the case of different providers)

Please keep director signature block


This plat does not qualify as an administrative plat. Please remove.

Informational comment: please note that El Paso County Planning and Community Development cannot and will not accept collateral or escrow (use whichever necessary) payment until plat recording (for plats), escrow agreement is signed and recorded (for escrow), financial assurance form is signed and approved (for FAE no plat). Any collateral or escrow payments that are received prior to the appropriate conditions being met will not be accepted and will be returned until such time payment is deemed as appropriate. Please coordinate with PCD Project Manager prior to making any collateral or escrow payments.

On the submitted PBMP form, Exclusion E "Large Lot Single Family Sites" was selected to exclude the site from a PBMP. The qualifications for this exclusions is presented in the ECM section I.7.1.B.5:

"Large Lot Single Family Sites. A single-family residential lot, or agricultural zoned lands, greater than or equal to 2.5 acres in size per dwelling and having a total lot impervious area of less than 10 percent. A total lot imperviousness greater than 10 percent is allowed when a study specific to the watershed and/or MS4 shows that expected soil and vegetation conditions are suitable for infiltration/filtration of the WQCv for a typical site, and the permittee accepts such study as applicable within its MS4 boundaries. The maximum total lot impervious covered under this exclusion shall be 20 percent."

Add a note to the plat acknowledging that per ECM section I.7.1.B.5, the residential lots impervious area may not exceed 10 percent unless a study is prepared in compliance with the requirements laid out in the above ECM section and the impervious area may not exceed 20 percent. This impervious area for each lot must include the proposed driveway.

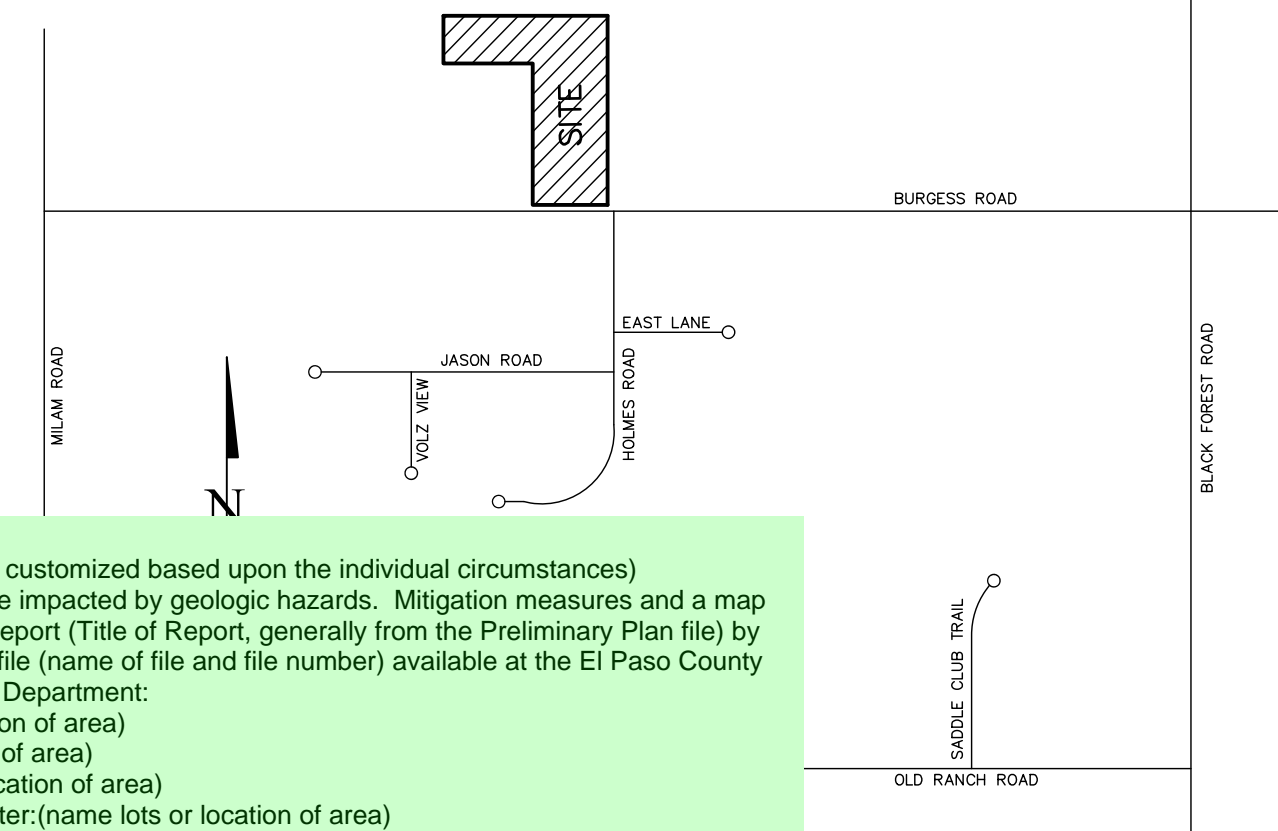

Soil and Geologic Conditions:
Geologic Hazard Note-Final Plat: (to be customized based upon the individual circumstances)
The following lots have been found to be impacted by geologic hazards. Mitigation measures and a map of the hazard area can be found in the report (Title of Report, generally from the Preliminary Plan file) by (author of the report) (date of report) in file (name of file and file number) available at the El Paso County Planning and Community Development Department:
•Downslope Creep: (name lots or location of area)
•Rockfall Sources: (name lots or location of area)
•Rockfall Runout Zone: (name lots or location of area)
•Potentially Seasonally High Groundwater: (name lots or location of area)
•Other Hazard:
In Areas of High Groundwater:
Due to high groundwater in the area, all foundations shall incorporate an underground drainage system.

SURVEYOR'S CERTIFICATION:

Surveyors Certificate

I, _____ a duly registered Professional Land Surveyor in the State of Colorado, do hereby certify that this plat truly and correctly represents the results of a survey made on the date of survey, by me or under my direct supervision and that all monuments exist as shown hereon; that mathematical closure errors are less than 1:10,000; and that said plat has been prepared in full compliance with all applicable laws of the State of Colorado dealing with monuments, subdivision, or surveying of land and all applicable provisions of the El Paso County Land Development Code.

I attest the above on this _____ day of _____, 20____.

Surveyor's Name, (Signature) _____ Date _____
Colorado registered PLS # _____

PRELIMINARY COPY
SUBJECT TO FINAL COUNTY APPROVAL

Board of County Commissioners Certificate

This plat for (name of subdivision or plat) was approved for filing by the El Paso County, Colorado Board of County Commissioners on the _____ day of _____, 20____, subject to any notes specified hereon and any conditions included in the resolution of approval. The dedications of land to the public (streets, tracks, easements: list those applicable) are accepted, but public improvements thereon will not become the maintenance responsibility of El Paso County until preliminary acceptance of the public improvements in accordance with the requirements of the Land Development Code and Engineering Criteria Manual, and the Subdivision Improvements Agreement.

Chair, Board of County Commissioners Date _____

Chair, Board of County Commissioners Date _____

PCD DIRECTOR:

This plat for RENEHAN SUBDIVISION was approved for filing by the El Paso County, Colorado Planning and Community Development Department Director on the _____ day of _____, 20____, subject to any notes specified hereon.

Planning and Community Development Director Date _____

RECORDING:

STATE OF COLORADO)
COUNTY OF EL PASO)
I hereby certify that this instrument was filed for record in my office at _____ o'clock _____ M., this _____ day of _____, 20____ A.D., and is duly recorded under Reception No. _____ of the records of El Paso County, Colorado.

SURCHARGE: _____ BY: _____ Deputy
FEE: _____

Owner of Record at time of platting:
Bradley W. Renehan, Sandra L. Renehan,
Jeffery N. Renehan and Julie A. Renehan
640 Southpointe Court, Suite 150
Colorado Springs CO 80906-3884
(719) 358-5827

DSD FILE NO.: MS238

According to Colorado law, legal action based upon any defect in this survey must be brought within the first three years after you are notified of any defect in no event, may any action based upon any defect in this survey be brought more than ten years from the date of the certification shown hereon.

CALL BEFORE YOU DIG . . .
811
DIAL 811
48 HOURS BEFORE YOU DIG. CALL UTILITY LOCATORS FOR LOCATING AND MARKING GAS, ELECTRIC, WATER AND WASTEWATER.

No.	Description	By	Date
1	CONSULTANT/CLIENT COMMENTS	DVH	03/31/23

H Scale: N/A
V Scale: N/A
Designed By: N/A
Drawn By: WCS
Checked By: DVH
Date: 11/21/22

Land Development Consultants, Inc.
PLANNING SURVEYING
www ldc inc com TEL: (719) 528-6133 FAX: (719) 528-8848
3888 MAZELAND ROAD COLORADO SPRINGS, CO 80909

RENEHAN SUBDIVISION
FINAL PLAT


Project No.: 22027
Sheet: 1 of 2

RENEHAN SUBDIVISION

A PORTION OF THE EAST HALF OF THE SOUTHEAST QUARTER OF SECTION 13,
TOWNSHIP 12 SOUTH, RANGE 66 WEST OF THE 6TH P.M.,
IN EL PASO COUNTY, COLORADO

LEGEND:

- Indicates survey monument "to be set" with #4 rebar and red plastic cap, PLS No. 20681 flush w/ground, except where noted otherwise
- Indicates survey monument found as noted
- Indicates boundary line
- ** - Indicates data relative to Private Access Easement (shared driveway)
- (5740) - Indicates lot address

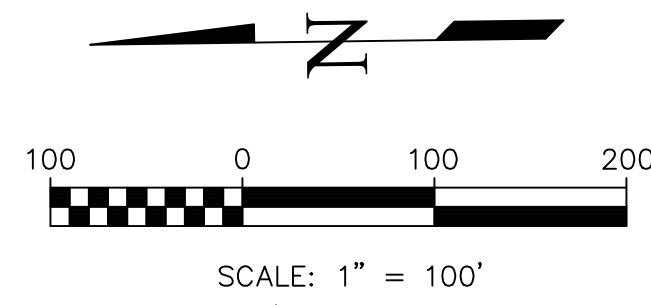

Please provide a name for the road. As a private drive, this should have one of the following suffixes: Grove, Heights, Point, or View.


Please adjust the drainage easement to encompass the swale along the driveway

see comments on the drainage report and provide the appropriate drainage easement.

Please show entire area detailed in geology report.

Please label these parcels as not part of the subdivision.

Please make these lines dotted.

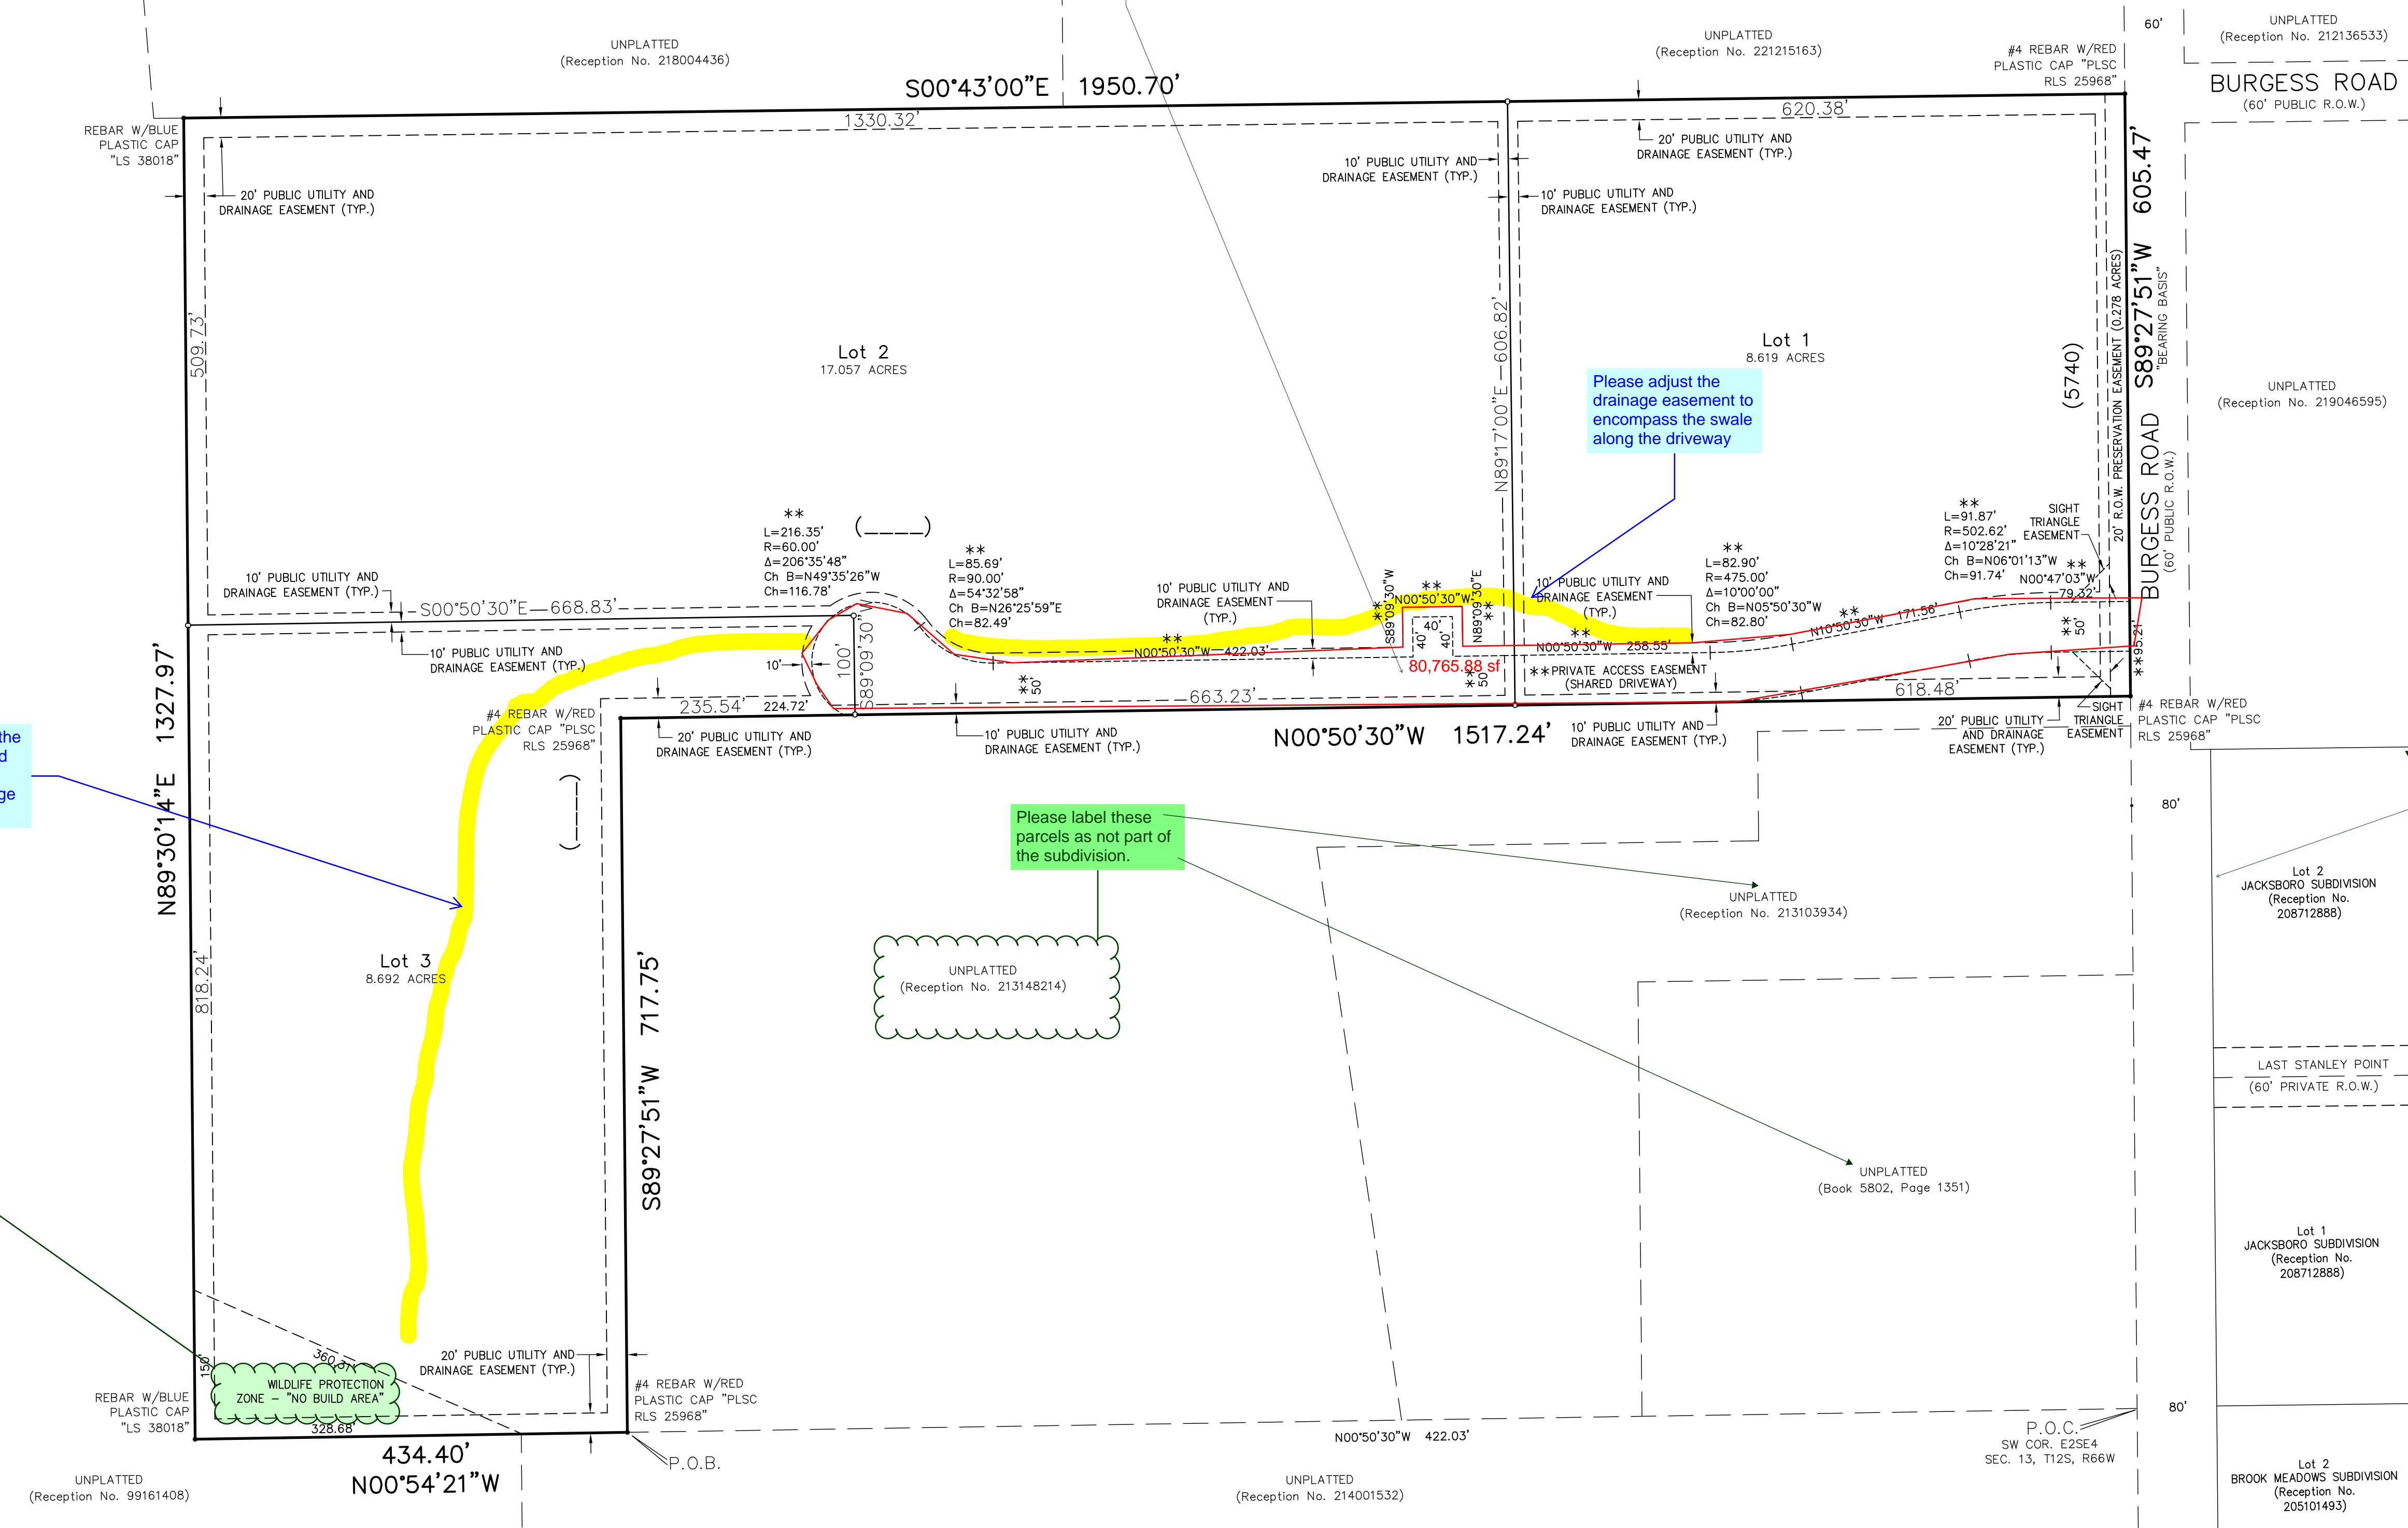

According to Colorado law, any legal action based upon any defect in this survey must be commenced within the first anniversary after the date of the survey. In no event, may any action based upon any defect in this survey be commenced more than ten years from the date of the certification shown hereon.

CALL BEFORE YOU DIG
811
DIAL 811
48 HOURS BEFORE YOU DIG. CALL UTILITY LOCATORS FOR LOCATING AND MARKING GAS, ELECTRIC, WATER AND WASTEWATER

No.	Description	By	Date
1	CONSULTANT/CLIENT COMMENTS	DVH	03/01/23

H Scale: 1" = 100'
V Scale: N/A
Designed By: N/A
Drawn By: WCS
Checked By: DVH
Date: 01/25/23

Land Development Consultants, Inc.
PLANNING · SURVEYING
www ldc inc com · TEL: (719) 528-6133 · FAX: (719) 528-8548
3888 MAZELAND ROAD · COLORADO SPRINGS, CO 80909

RENEHAN SUBDIVISION
FINAL PLAT

PRELIMINARY COPY
SUBJECT TO FINAL COUNTY APPROVAL

Project No.: 22027
Sheet: 2 of 2

DSD FILE NO.: MS238