


SPACE VILLAGE APARTMENTS

SITE DEVELOPMENT PLAN

SITUATED IN A PORTION OF THE NORTHWEST QUARTER OF SECTION 17, TOWNSHIP 14 SOUTH, RANGE 65 WEST
OF THE 6TH P.M., COUNTY OF EL PASO, STATE OF COLORADO

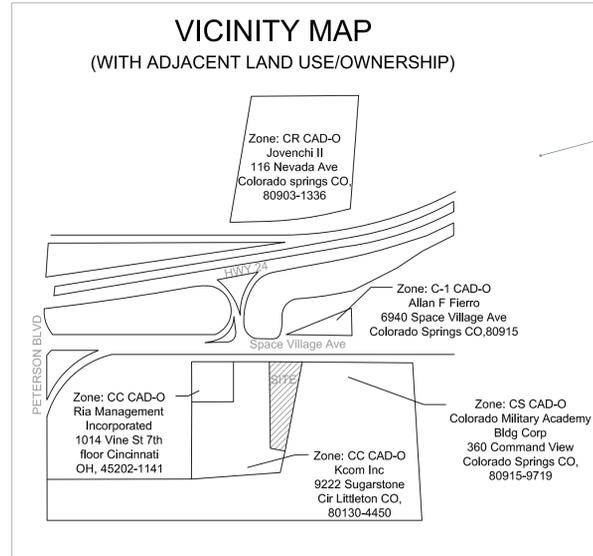

GENERAL NOTES:

1. THE PARTIES RESPONSIBLE FOR THE PLAN HAVE FAMILIARIZED THEMSELVES WITH ALL CURRENT ACCESSIBILITY CRITERIA AND SPECIFICATIONS AND THE PROPOSED PLAN REFLECTS ALL SITE ELEMENTS REQUIRED BY THE APPLICABLE ADA DESIGN STANDARDS AND GUIDELINES AS PUBLISHED BY THE UNITED STATES DEPARTMENT OF JUSTICE.

BASIS OF BEARINGS:

ALL BEARINGS REFERRED TO HEREIN ARE RELATIVE TO THE NORTH LINE OF SAID SECTION 17, ON AN ASSUMED BEARING OF NORTH 89 DEGREES 42 MINUTES 7 SECONDS EAST

LEGAL DESCRIPTION:

(TO BE PLATTED AS: LOT 1, SPACE VILLAGE APARTMENTS, FILING NO. 1)
THAT PORTION OF THE NORTHWEST QUARTER, SECTION 17, TOWNSHIP 14 SOUTH, RANGE 65 WEST OF THE SIXTH PRINCIPAL MERIDIAN, EL PASO COUNTY, COLORADO, BEING A PORTION OF THAT TRACT OF LAND DESCRIBED IN BOOK 3630 AT PAGE 188 OF THE RECORDS OF SAID COUNTY, ALSO BEING A PORTION OF THAT TRACT OF LAND DESCRIBED IN BOOK 3679 AT PAGE 489 OF SAID RECORDS, MORE PARTICULARLY DESCRIBED AS FOLLOWS:

COMMENCING AT THE NORTHWEST CORNER OF SAID SECTION 17; THENCE SOUTH 00 DEGREES 29 MINUTES 53 SECONDS E. A DISTANCE OF 50.00 FEET ALONG THE WEST LINE OF SAID SECTION 17 TO INTERSECT THE WESTERLY EXTENSION OF THE SOUTHERLY LINE OF THE TRACT OF LAND DESCRIBED IN BOOK 1005 AT PAGE 262 OF SAID RECORDS, (ALL BEARINGS REFERRED TO HEREIN ARE RELATIVE TO THE NORTH LINE OF SAID SECTION 17, ON AN ASSUMED BEARING OF NORTH 89 DEGREES 42 MINUTES 7 SECONDS EAST);

THENCE NORTH 89 DEGREES 42 MINUTES 7 SECONDS EAST, 533.50 FEET ALONG SAID WESTERLY EXTENSION AND SOUTHERLY LINE TO THE NORTHWEST CORNER OF THAT TRACT OF LAND AS DESCRIBED IN BOOK 3630 AT PAGE 188;

THENCE CONTINUING NORTH 89 DEGREES 42 MINUTES 7 SECONDS EAST, 280.10 FEET ALONG THE NORTHERLY LINE OF SAID TRACT OF LAND DESCRIBED IN BOOK 3630 AT PAGE 188 TO THE POINT OF BEGINNING OF THE TRACT OF LAND HEREIN DESCRIBED;

THENCE CONTINUING NORTH 89 DEGREES 42 MINUTES 7 SECONDS EAST 118.00 FEET ALONG THE NORTHERLY LINE OF SAID TRACT OF LAND DESCRIBED IN BOOK 3630 AT PAGE 188 TO THE NORTHEAST CORNER THEREOF;

THENCE SOUTH 10 DEGREES 54 MINUTES 42 SECONDS WEST, 330.00 FEET ALONG THE EASTERLY LINE OF SAID TRACT OF LAND DESCRIBED IN BOK 3679 AT PAGE 489;

THENCE NORTH 79 DEGREES 5 MINUTES 8 SECONDS WEST, 53.77 FEET

THENCE NORTH 00 DEGREES 29 MINUTES 53 SECONDS WEST, 227.41 FEET TO THE NORTHWESTERLY LINE OF SAID TRACT OF LAND DESCRIBED IN BOOK 3679 AT PAGE 489;

THENCE CONTINUING NORTH 00 DEGREES 29 MINUTES 53 SECONDS WEST, 85.84 FEET TO THE POINT OF BEGINNING.

FEMA CLASSIFICATION:

THIS SITE IS NOT WITHIN A DESIGNATED F.E.M.A. FLOODPLAIN AS DETERMINED BY FLOOD INSURANCE RATE MAP, COMMUNITY PANEL NUMBER 08041C0754G EFFECTIVE DATE, DECEMBER 07, 2018 AND IS LABELED AS A ZONE "X" AREA, OR AREA OF MINIMAL FLOOD HAZARD.

NOTICE AND WARNING (ADA NOTE):

COMPLIANCE WITH THE AMERICANS FOR DISABILITIES ACT ("ADA") AND OTHER FEDERAL AND STATE ACCESSIBILITY LAWS IS THE SOLE RESPONSIBILITY OF THE PROPERTY OWNER. THEREFORE, COMPLIANCE WITH CITY CODES DOES NOT ASSURE COMPLIANCE WITH THE ADA OR ANY OTHER FEDERAL OR STATE ACCESSIBILITY LAWS OR ANY REGULATIONS OR GUIDELINES ENACTED OR PROMULGATED UNDER OR WITH RESPECT TO SUCH LAWS. EL PASO COUNTY IS NOT RESPONSIBLE FOR ENFORCEMENT OF THE ADA OR ANY OTHER FEDERAL OR STATE ACCESSIBILITY LAWS.

Please add the following to the site plan:
Owner and applicant contact telephone number and email
Legal description
Existing/proposed land use
Open space, landscaping, and impermeable surface percentage
Density and total number of dwelling units (residential)
The footprint of all existing and proposed buildings
Traffic circulation on site including all points of ingress/egress into the property
Location of all ADA spaces, ramps and signs, including ADA pathways
Please show dimension of parking spaces so we can verify it meets the code requirement
Location of all garbage receptacles with a graphical depiction of the screening mechanism
Location of all existing and proposed utility lines and associated infrastructure

SITE DATA	
ADDRESS/LOCATION:	6895 & 6875 SPACE VILLAGE AVE
PARCEL ID #:	5417000019
ACREAGE:	0.628 AC (27,625 SF)
ZONING:	CC
LAND USE:	MULTI-FAMILY (VA 20-1)
BUILDING HEIGHT	±22.1'
DENSITY	35 UNITS/ AC

SETBACKS	
FRONT	25'
SAME ZONE DISTRICT (SIDE/REAR)	0'
APPROVED FOR EXISTING STRUCTURE BY BOA 83-074 (SIDE)	10'

BUILDING DATA	
BUILDING AREA	6,170SF
BUILDING HEIGHT	±22.1
BUILDING LOT COVERAGE	22.33%

PARKING COUNTS	
REQUIRED PARKING (PROPOSED ALTERNATE RATIO)	33 SPACES (TOTAL OF RESIDENT, GUEST, ADA)
RESIDENT PARKING	22
GUEST PARKING	8
ADA PARKING	3

OPEN SPACE AREA	
TOTAL MULTIFAMILY OPEN SPACE REQ/ PRO	4,144 SF/ 8,377 SF

DP1	COVER SHEET
* DP2	SITE DEVELOPMENT/LANDSCAPE PLAN

*PLANS ARE INCORPORATED ON SAME SHEET

OWNERSHIP:
ELITE PROPERTY GROUP, LLC
6400 MONTVIEW BOULEVARD
DENVER, CO 80207

CONSULTANT(S):
KIMLEY-HORN
2, N. NEVADA AVENUE, SUITE 300
COLORADO SPRINGS, CO 80903



Space Village Apartments
SITE DEVELOPMENT PLAN
Colorado Springs, CO



REV #	REVISIONS	DATE
1		
2		
3		
4		
5		
6		

DESIGNED	02.14.19	RSF	06.01.21	AS NOTED
DRAWN		CHECKED	7.8.2021	
		PROJECT NUMBER:	3837.00	
		SCALE:		

COVER SHEET
DP1

