


Please add the standard county signature blocks and standard EPC construction notes (attached)



COLORADO STATE HIGHWAY 94 (SPACE VILLAGE AVE)

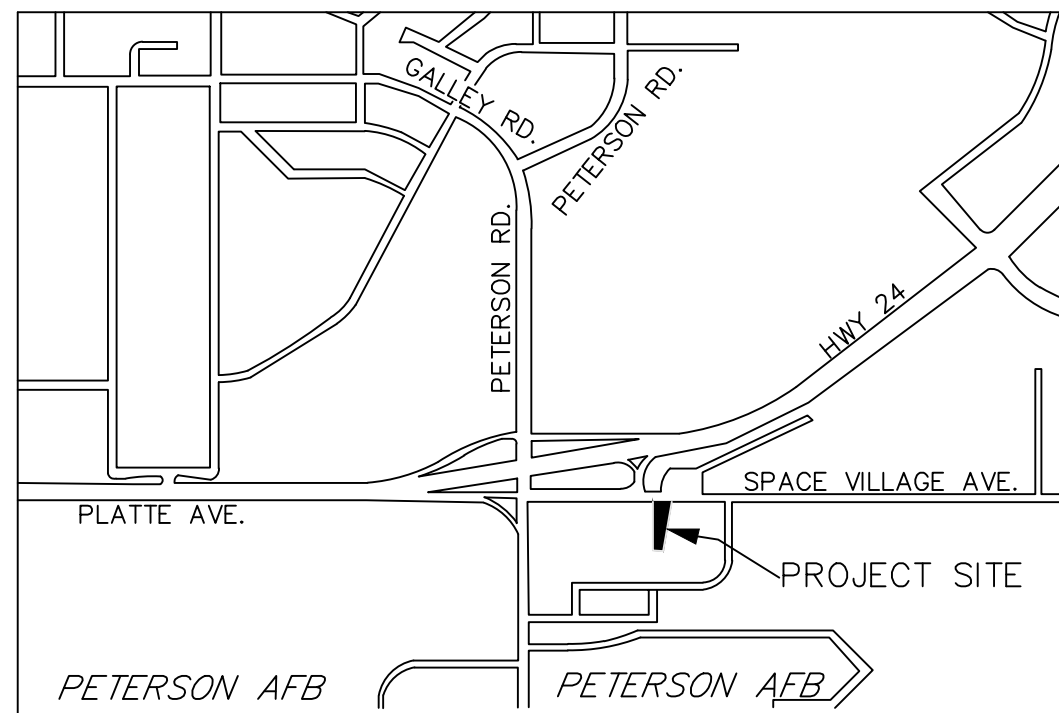

VICINITY MAP
NOT TO SCALE








SCALE: 1"=10'


LEGEND

5542.19	SIDEWALK GRADE
FL	FLOWLINE
P.V.M.T.	PAVEMENT
M.E.	MATCH EXISTING
T/C	TOP OF CURB
O CO	SANITARY SEWER CLEANOUT
FOB	FIBER OPTIC BOX
TP	TELEPHONE PEDESTAL
SSMH	SANITARY MANHOLE
EV	ELECTRIC VAULT
FH	FIRE HYDRANT
WV	WATER VALVE
CATV	CABLE TV VAULT
DOWNDRN	ROOF DRAIN PIPE
X	CHAIN LINK FENCE
T	TELEPHONE
E	ELECTRIC
G	GAS
W	WATER

NOTE:
ALL WORK TO BE COMPLETED PER EL PASO COUNTY
ENGINEERING CRITERIA MANUAL STANDARDS AND DETAILS.

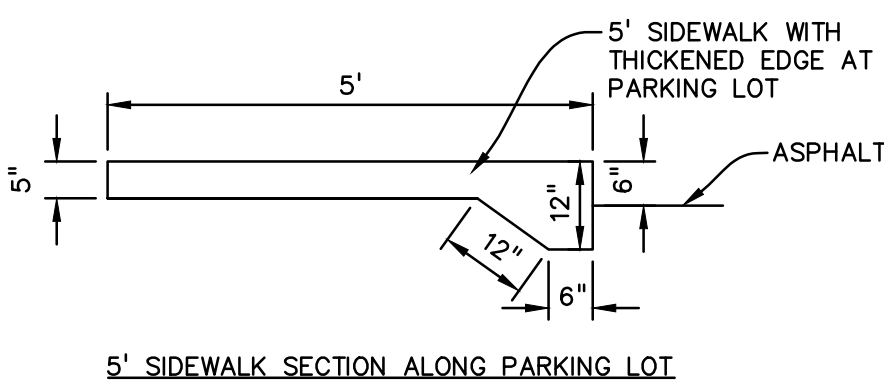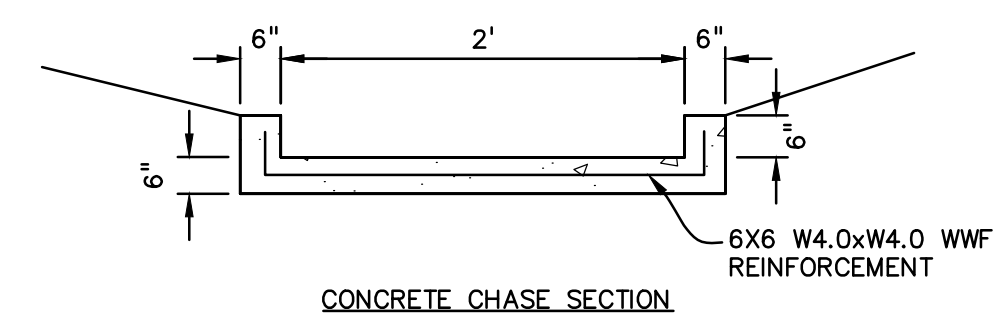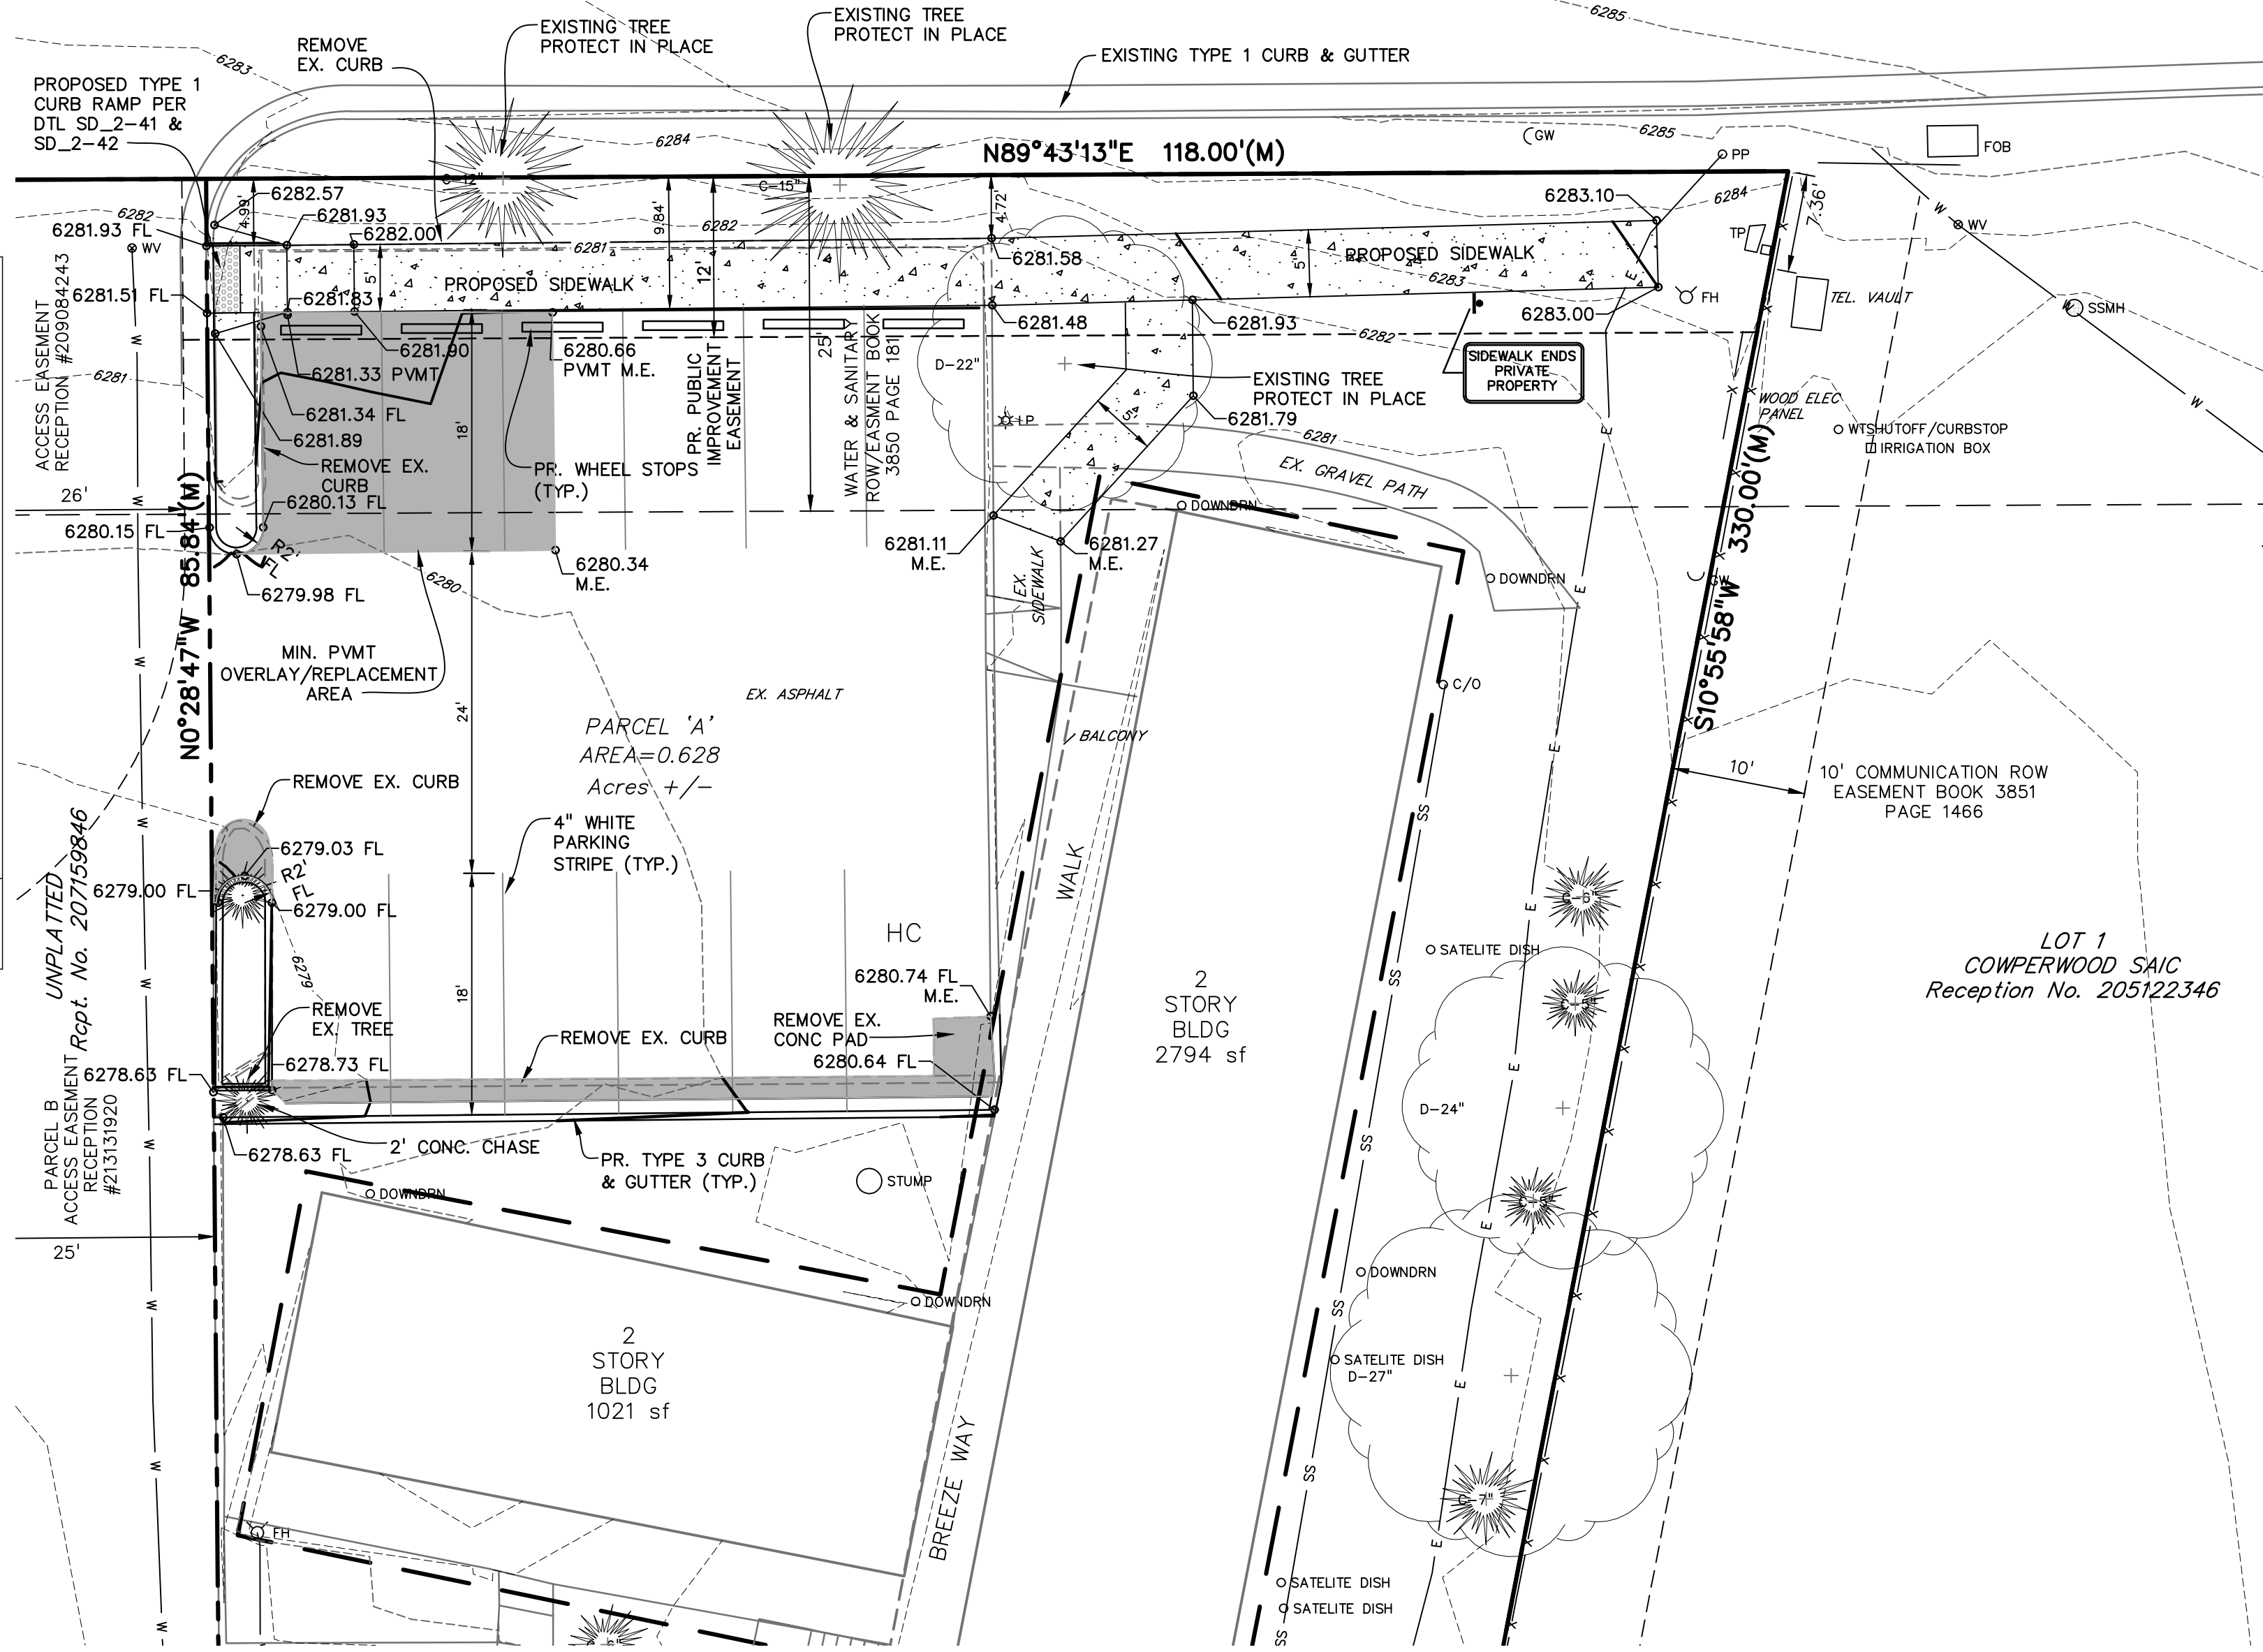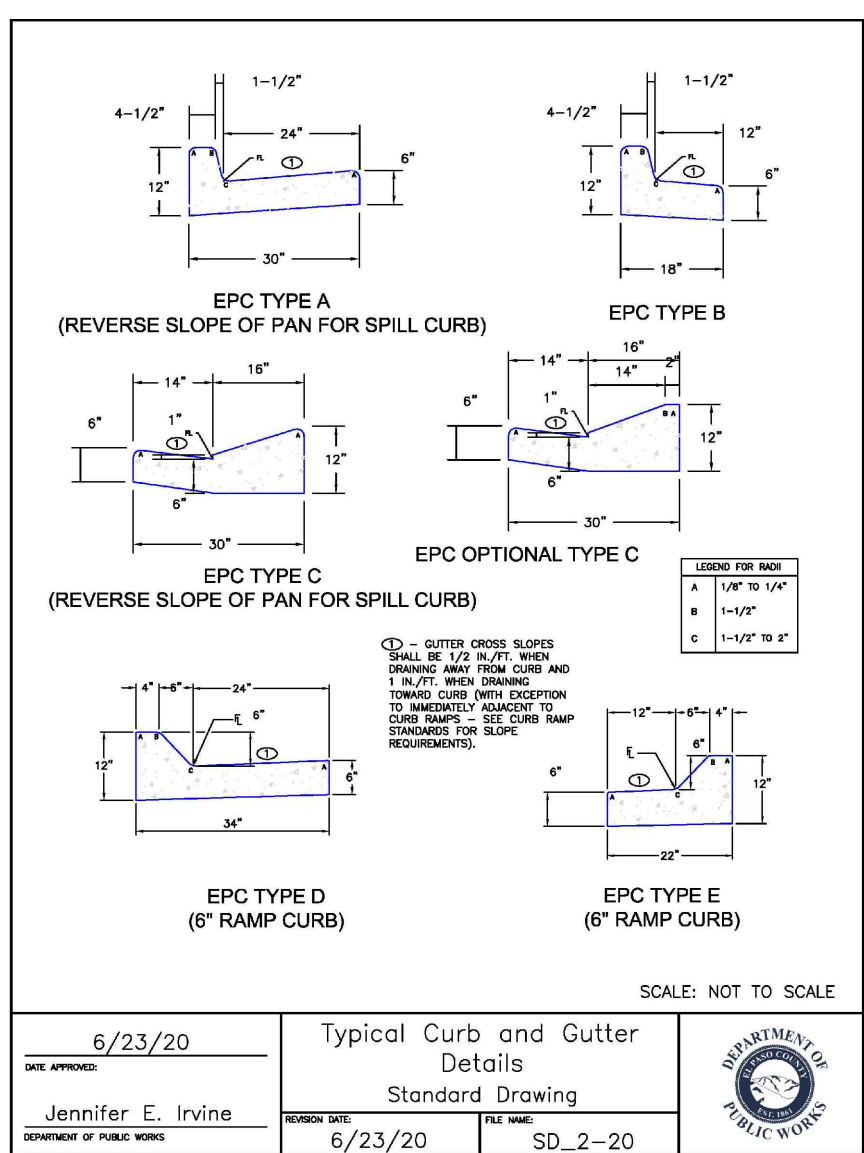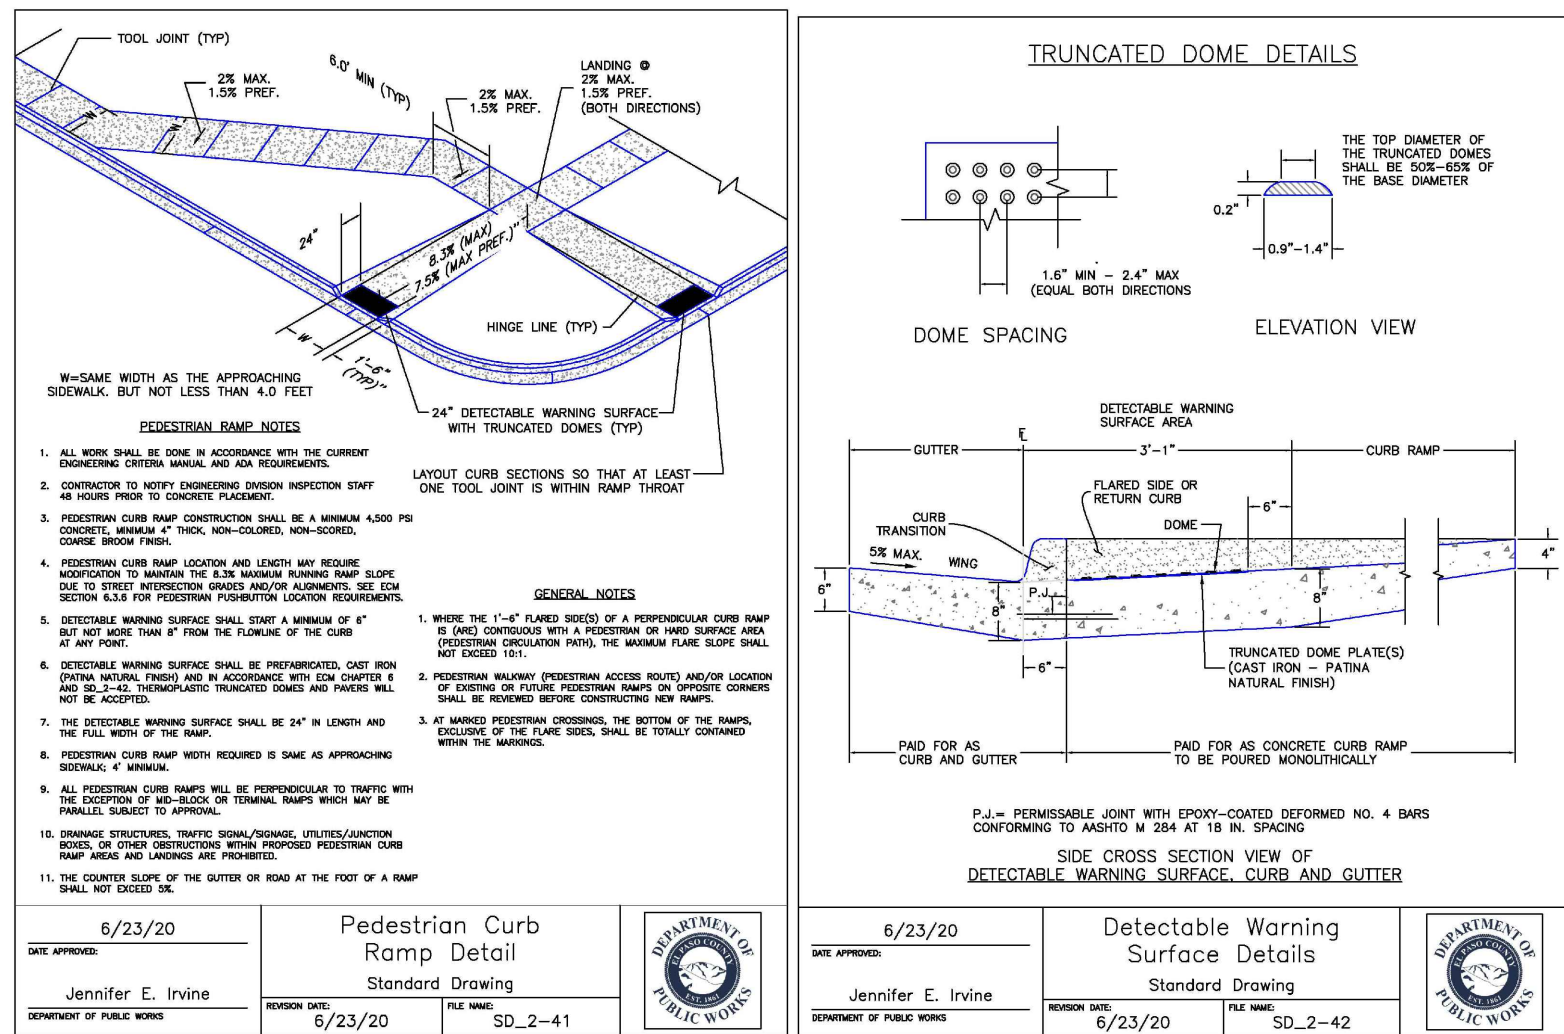

PREPARED BY:

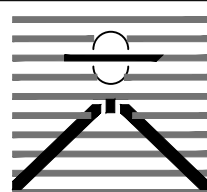

DREXEL, BARRELL & CO.
Engineers-Surveyors
3 SOUTH 7TH STREET
COLORADO SPRINGS, COLORADO 80905
CONTACT: TIM D. McCONNELL, P.E.
(719) 560-0887
BOULDER • COLORADO SPRINGS • GREELY

CLIENT:

107 N. NEVADA AVE. #300
COLORADO SPRINGS CO. 80903
(719)-385-5986
CONTACT: JOE CURRO
(719)-444-7430

CIVIL CONSTRUCTION PLANS
**SPACE VILLAGE
APARTMENTS**
6895 SPACE VILLAGE AVE
COLORADO SPRINGS, COLORADO

ISSUE	DATE
INITIAL ISSUE	11-22-21
DESIGNED BY:	TDM
DRAWN BY:	GES
CHECKED BY:	TDM
FILE NAME:	21268-01SP01

PREPARED UNDER MY DIRECT
SUPERVISION FOR AND ON BEHALF
OF DREXEL, BARRELL & CO.

DRAWING SCALE:
HORIZONTAL: 1" = 10'
VERTICAL: N/A

**SIDEWALK/
PARKING PLAN**

PROJECT NO. 21268-01CSCV
DRAWING NO.

SP01

SHEET: 1 OF 1



Know what's below.
Call before you dig.
CALL 3-BUSINESS DAYS IN ADVANCE
BEFORE YOU DIG, GRADE, OR
EXCAVATE FOR THE MARKING OF
UNDERGROUND MEMBER UTILITIES.