




8 WALL PACK LIGHT DETAIL  
SCALE: 1/4"=1'-0"

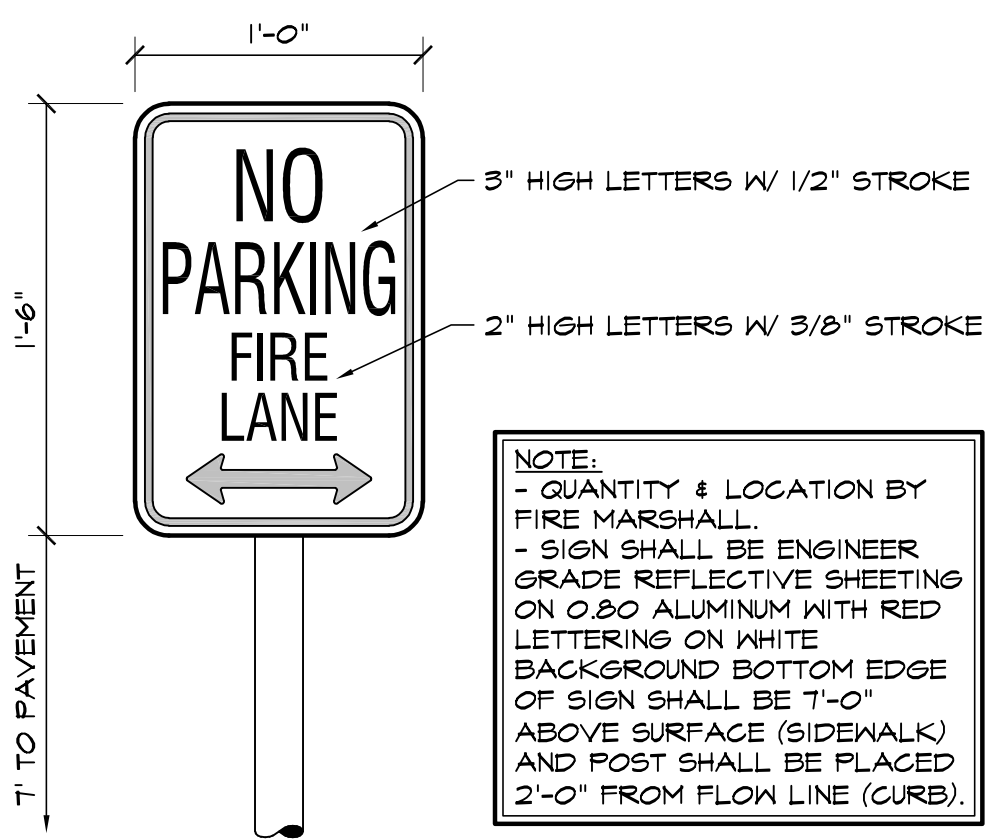


6 FIRE LANE SIGN  
SCALE: 1 1/2"=1'-0"

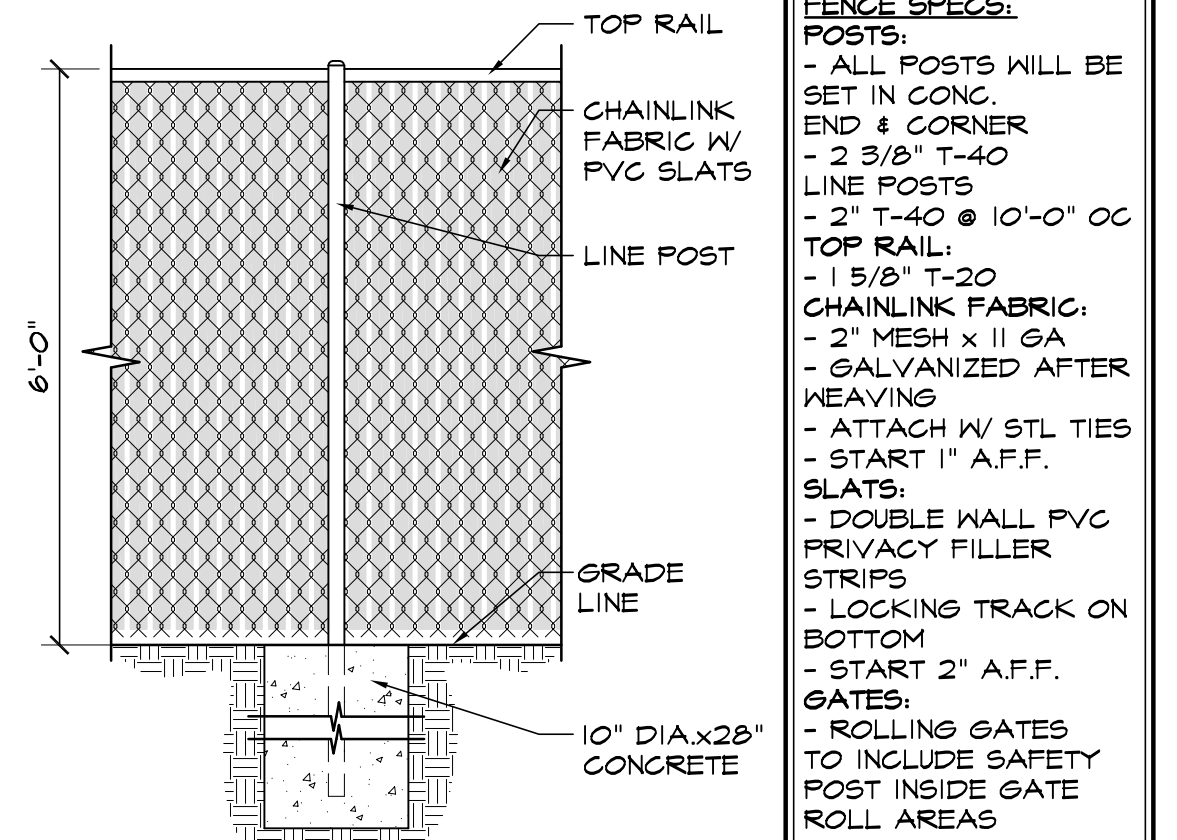


4 CHAINLINK FENCE DETAIL  
SCALE: 1/2"=1'-0"

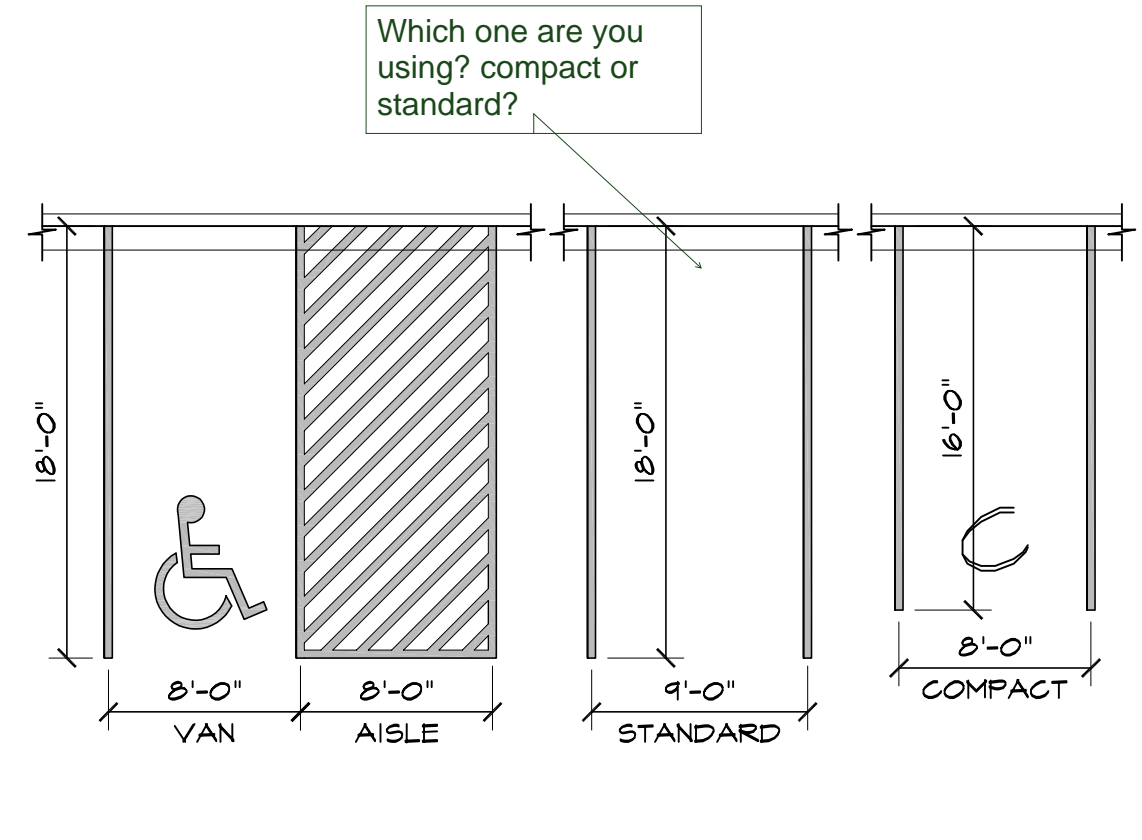


2 ADA / STANDARD PARKING  
SCALE: 1/8"=1'-0"

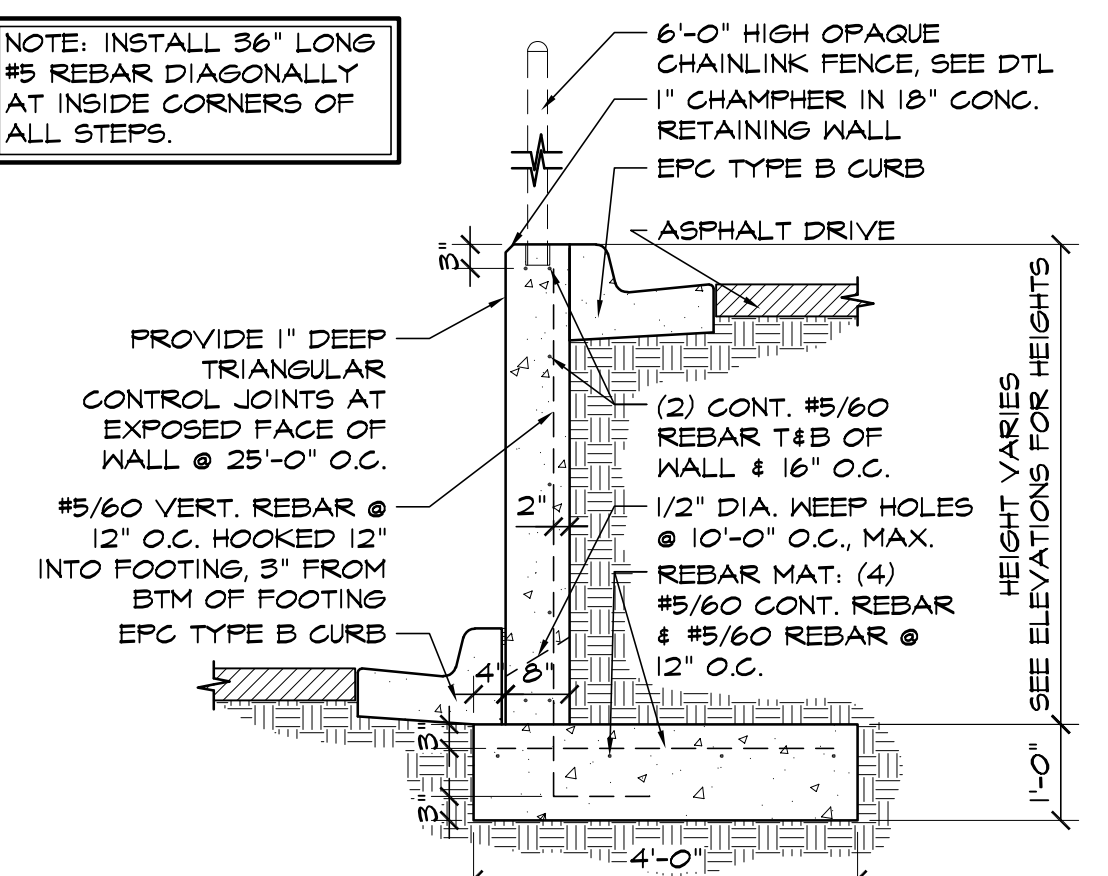


9 RETAINING WALL DETAIL  
SCALE: 1/2"=1'-0"

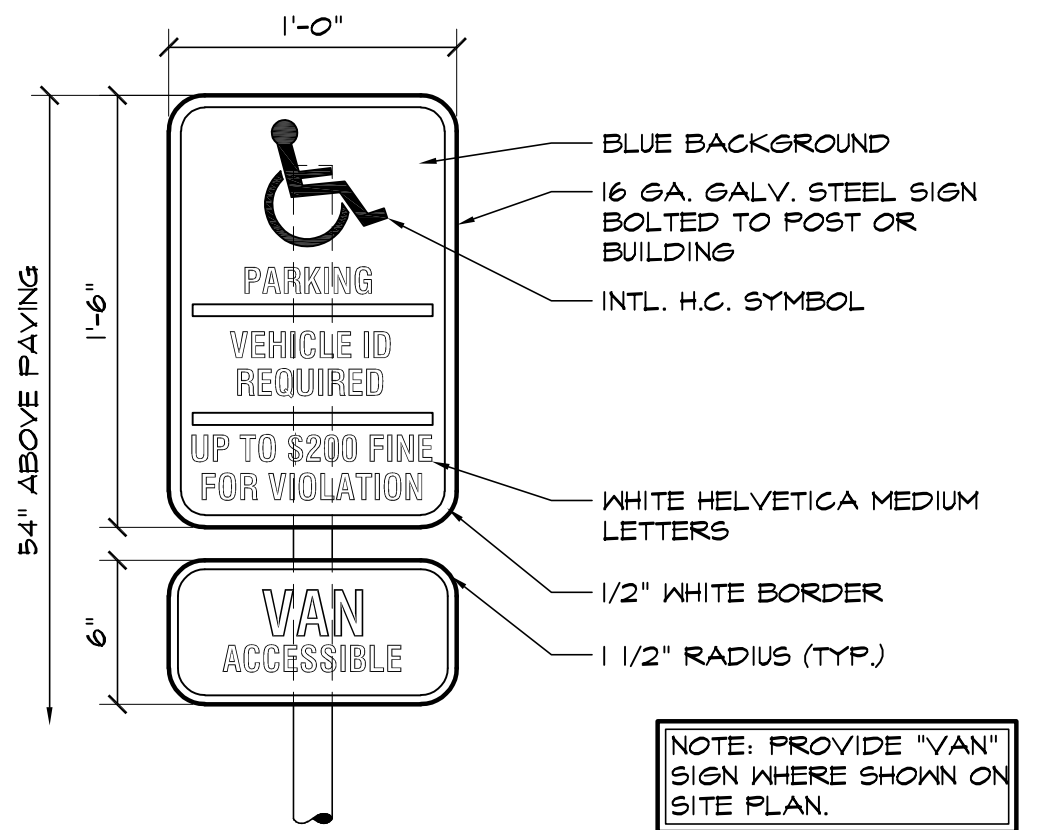



7 HANDICAPPED PARKING SIGN  
SCALE: 1 1/2"=1'-0"

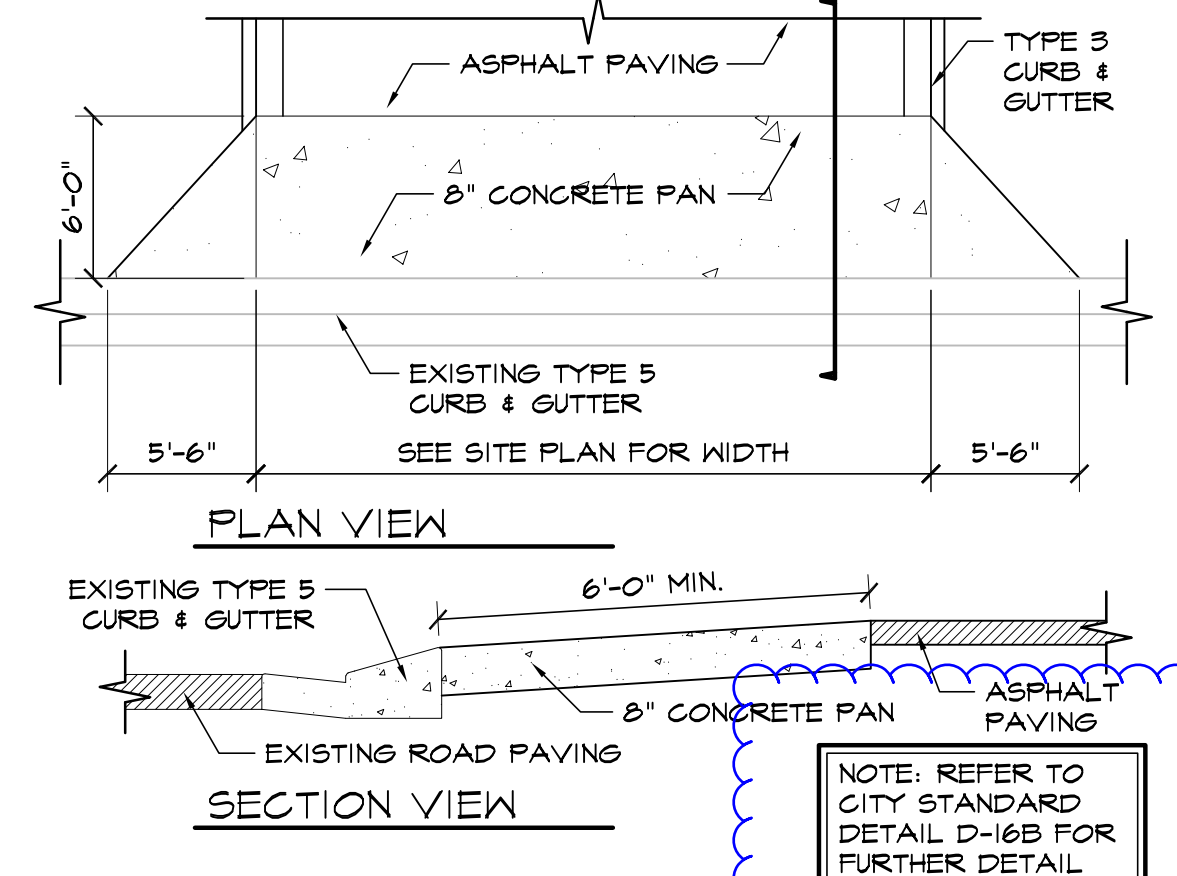

5 DRIVEWAY DETAIL  
NOT TO SCALE

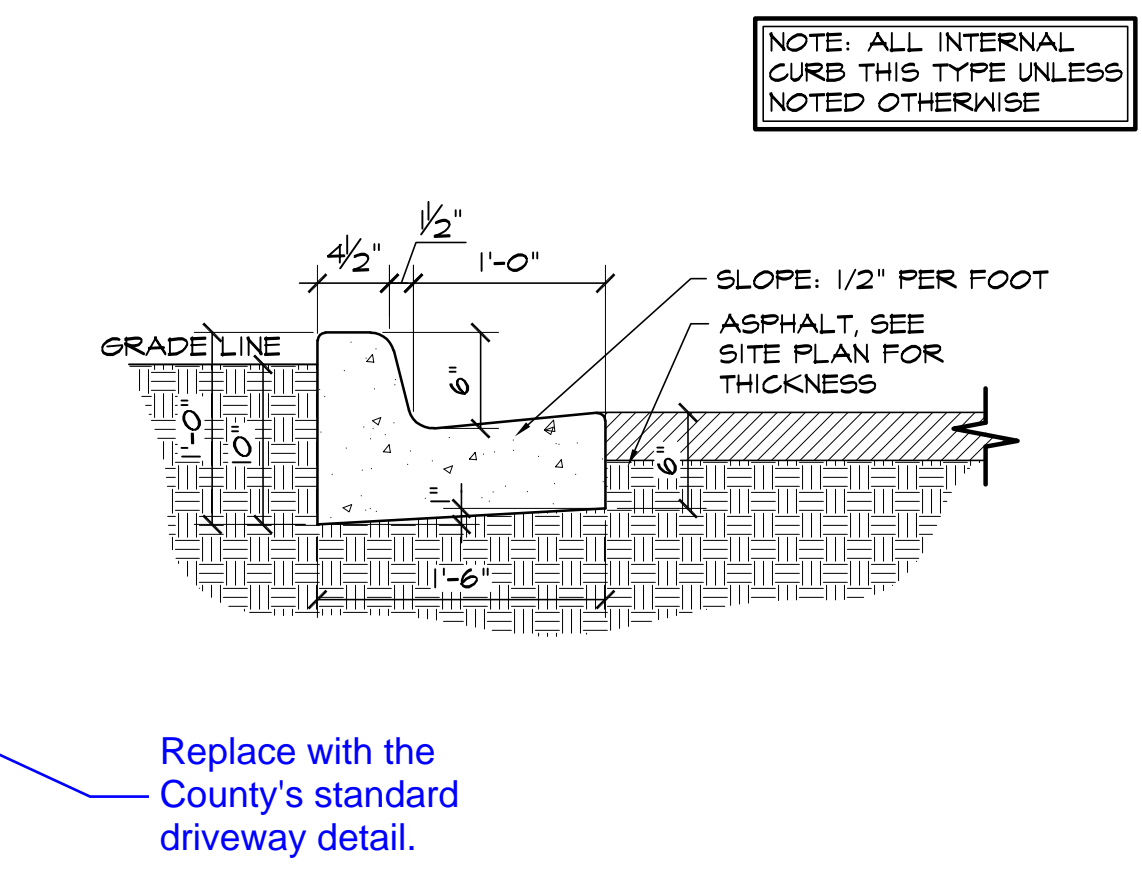

3 EPC TYPE B CURB  
SCALE: 1"=1'-0"

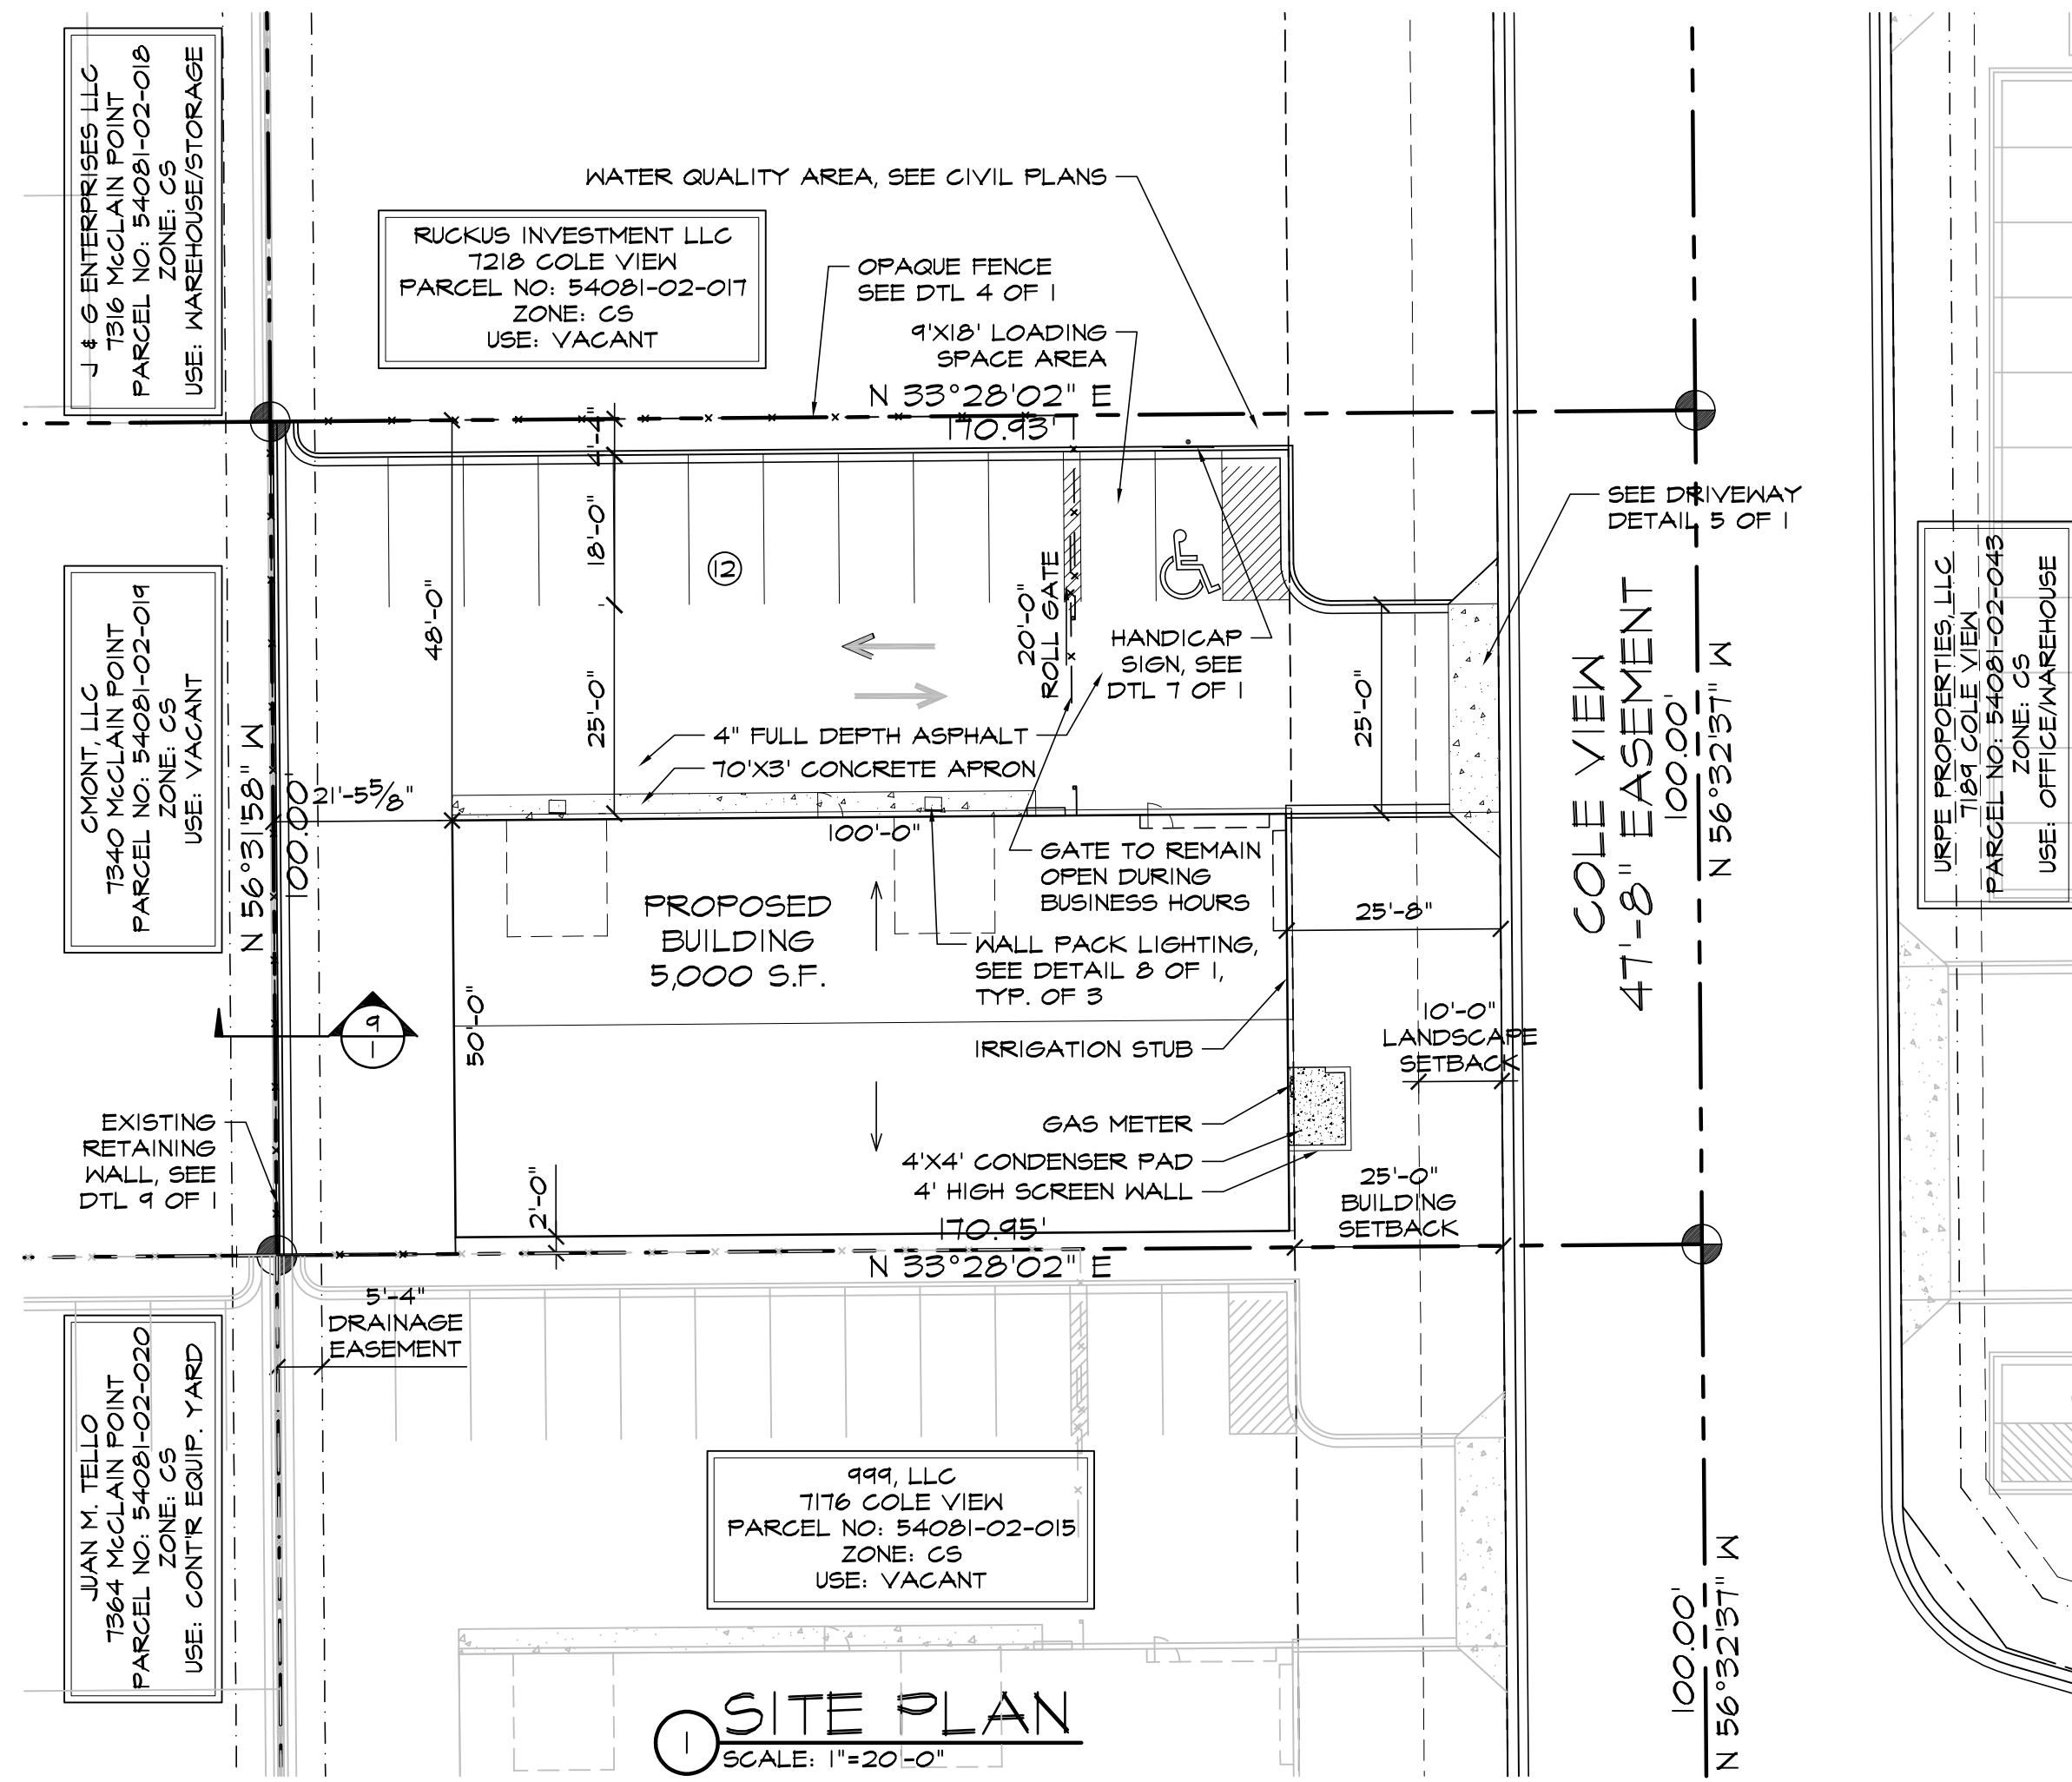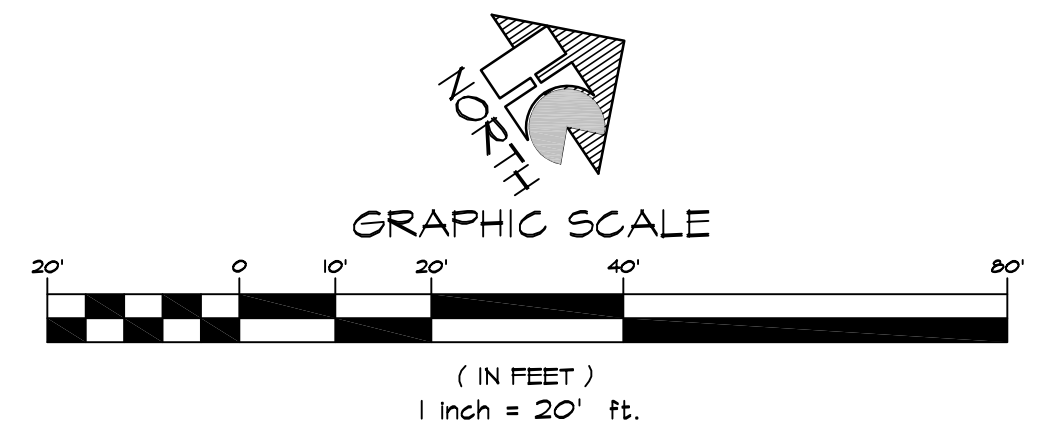


1 SITE PLAN  
SCALE: 1"=20'-0"

DRAWING INDEX

- 1 OF 9 - SITE PLAN & DETAILS, PROJECT INFORMATION, DRAWING INDEX
- 2 OF 9 - UTILITY PLAN
- 3 OF 9 - GRADING & EROSION CONTROL PLAN
- 4 OF 9 - EROSION CONTROL DETAILS
- 5 OF 9 - WATER QUALITY DETAILS
- 6 OF 9 - LANDSCAPE PLAN
- 7 OF 9 - LANDSCAPE DETAILS
- 8 OF 9 - PHOTOMETRIC PLAN
- 9 OF 9 - DP BUILDING ELEVATIONS

VICINITY MAP

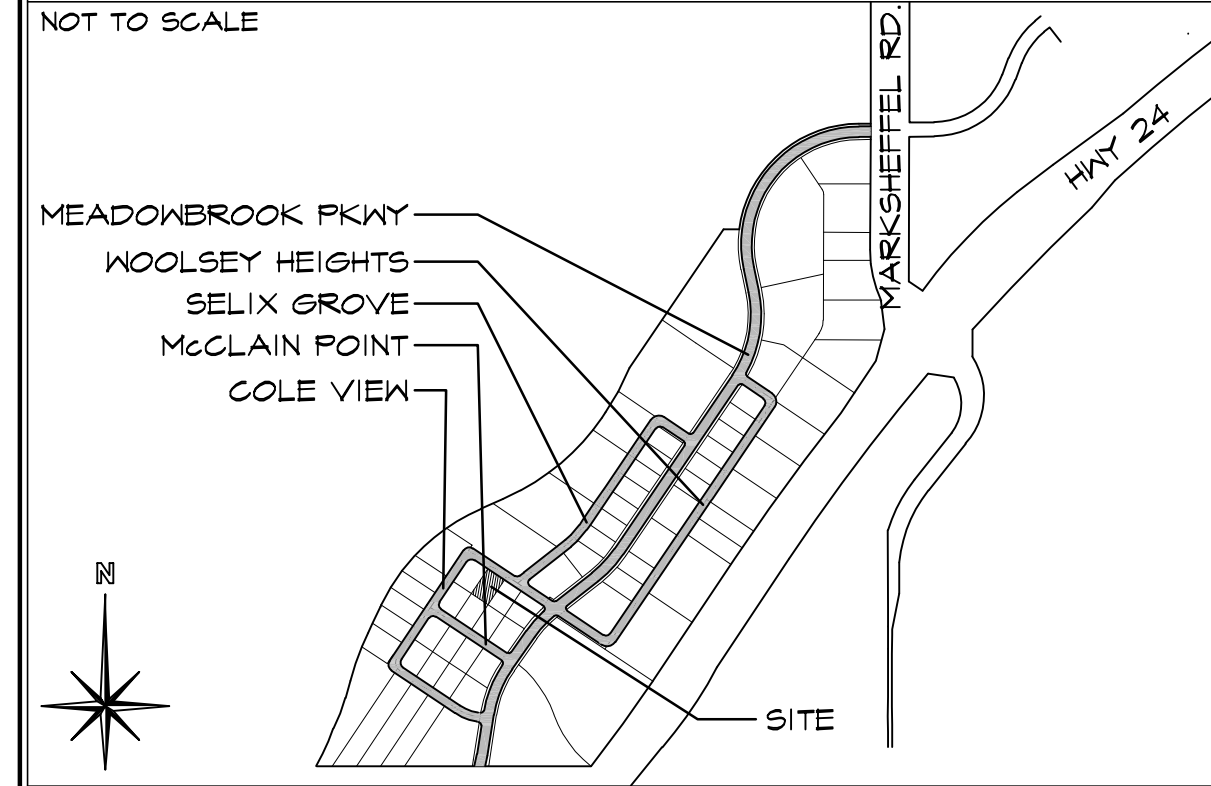

PROJECT INFORMATION

<b>PROPERTY INFORMATION</b>	
OWNER NAME:	1000, LLC 1411 WOOLSEY HEIGHTS COLORADO SPRINGS, CO 80915
LEGAL DESCRIPTION:	LOT 12, FILING 2 OF CLAREMONT BUSINESS PARK
PARCEL NUMBER LOT 10:	54081-02-016
ZONING:	CS
LOT SIZE LOT 10:	17,094 SF (3/4 ACRES)
CURRENT USE:	VACANT
FLOODPLAIN STATEMENT:	ZONE X (MAP NO. 08041C0752 F, DATED MARCH 17, 1997 & AS MODIFIED BY LOMR 06-08-B131P EFFECTIVE DATE DEC. 13, 2006)
<b>BUILDING INFORMATION</b>	
GROSS BUILDING AREA:	5,000 SF
BUILDING OCCUPANCY:	B/S-2
TYPE OF CONSTRUCTION:	11-B
FIRE SYSTEMS:	NONE
AREA SEPARATION WALLS:	NONE
<b>ZONING CODE STUDY</b>	
PROPOSED PRINCIPAL USE:	OFFICE/WAREHOUSE
STRUCTURAL COVERAGE:	25%
PAVEMENT COVERAGE:	41%
STREET COVERAGE:	12%
BUILDING STRUCTURAL HEIGHT:	18'-7 3/8" (45'-0" MAX)
FRONT YARD SETBACK:	25'-0"
SIDE YARD SETBACK:	0'-0"
REAR YARD SETBACK:	0'-0"
<b>REQUIRED PARKING SPACES:</b>	
OFFICE-(1 SPACE/300 S.F.) (1,500 S.F. / 300 S.F.)	5
WAREHOUSE-(1 SPACE/1,000 S.F.) (3,500 S.F. / 1,000 S.F.)	4
H.C.-(1 SPACE/25 REQ'D)	1
TOTAL PARKING SPACES REQUIRED:	10
TOTAL PARKING PROVIDED:	12
STANDARD SPACES PROVIDED:	10
H.C. SPACES PROVIDED:	0
COMPACT SPACES PROVIDED:	0
LOADING SPACE PROVIDED:	1 (9'X18')
(SEE DETAIL 2 OF 1 FOR DIMENSIONS)	
<b>DEVELOPMENT SCHEDULE</b>	
CONSTRUCTION:	WINTER 2017
LANDSCAPING:	SPRING 2017
<b>DEVELOPMENT APPLICANT</b>	
COMPANY:	HAMMERS CONSTRUCTION, INC. 1411 WOOLSEY HEIGHTS COLO. SPRINGS, CO 80915
PHONE NUMBER:	(719)-570-1549
FAX NUMBER:	(719)-570-1008
APPLICANT NAME:	LISA PETERSON
APPLICANT E-MAIL:	lpeterson@hammersconstruction.com

SITE LEGEND

---	PROPERTY LINE
- - - -	RIGHT OF WAY
- - - -	BUILDING SETBACK
- - - -	LANDSCAPE SETBACK
- - - -	UTILITY/DRAINAGE EASEMENT
- - - -	ELECTRICAL EASEMENT
- - - -	ACCESS EASEMENT
- - - -	OPAQUE CHAINLINK FENCE
- - - -	6' HIGH WROUGHT IRON FENCE
- - - -	GAS LINE
- - - -	WATER LINE
- - - -	ELECTRICAL LINE
- - - -	SANITARY SEWER LINE
- - - -	STORM SEWER LINE
- - - -	RETAINING WALL
- - - -	NEW SIDEWALK LOCATIONS W/ CONTROL JOINTS @ 5'-0" O.C.
⊙	PROPERTY CORNER
⊙	SIGN
⊙	EXISTING FIRE HYDRANT
→	TRAFFIC FLOW
⊙	MANHOLE
⊙	PROPOSED FIRE HYDRANT
⊙	WALL PACK LIGHTING
⊙	ELECTRICAL TRANSFORMER

**HAMMERS CONSTRUCTION INC.**  
COMMERCIAL GENERAL CONTRACTORS SPECIALIZING IN DESIGN/BUILD  
PRESIDENT: STEVE R. HAMMERS  
VICE PRES: DAVID J. HAMMERS  
1411 WOOLSEY HEIGHTS  
COLORADO SPRINGS, CO 80915  
(719) 570-1599 FAX (719) 570-7008  
www.hammersconstruction.com

THIS DRAWING CONTAINS MATERIAL & INFORMATION WHICH MAY NOT BE REPRODUCED WITHOUT WRITTEN CONSENT OF HAMMERS CONSTRUCTION, INC. THESE DRAWINGS ARE INTENDED TO BE USED ONLY BY HAMMERS CONSTRUCTION & ITS REPRESENTATIVES. THESE DRAWINGS HAVE NOT BEEN PREPARED FOR ANY OTHER PURPOSE THAN TO INDICATE THE GENERAL FEATURES AND PLACEMENT OF THE PROPOSED PROJECT. COPYRIGHT © 2017 HAMMERS CONSTRUCTION

**1000, LLC**  
GBP LOT 12-2  
7190 COLE VIEW  
COLORADO SPRINGS, CO 80915  
EL PASO COUNTY, COLORADO

DATE: JUNE 13, 2017  
DRAWN BY: D. AQUINO  
PROJ. MGR: Z. GRABTREE  
SCALE: SEE PLAN  
APPROVED BY:  
JOB NO: 1000

RESUBMITTALS:  
\_\_\_\_\_  
\_\_\_\_\_  
1 of 9  
SITE PLAN

# Markup Summary

---

dsdlaforce (1)

---

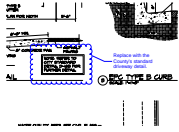


**Subject:** Cloud+  
**Page Label:** 1  
**Lock:** Locked  
**Author:** dsdlaforce

Replace with the County's standard driveway detail.

---

dsdruiz (1)

---

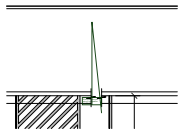

**Subject:** Callout  
**Page Label:** 1  
**Lock:** Locked  
**Author:** dsdruiz

Which one are you using? compact or standard?