



Detail sheet of light pole height to verify it meets standards in the LDC

Needs to be a full photometric to determine scale at boundary line.

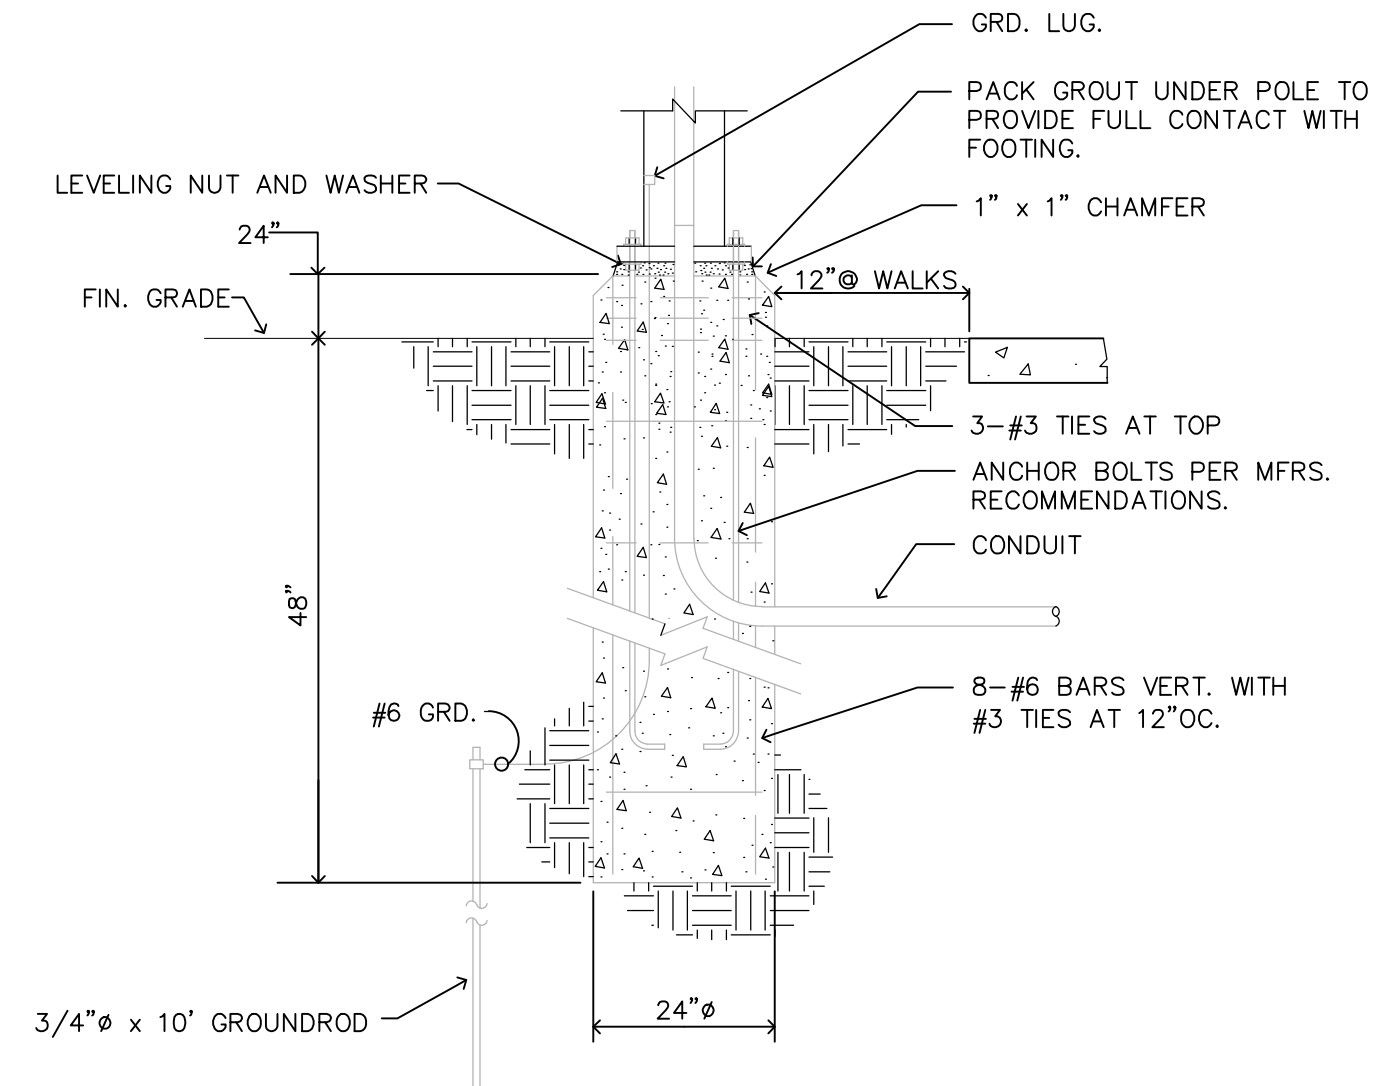

NOT TO SCALE


1
PME100

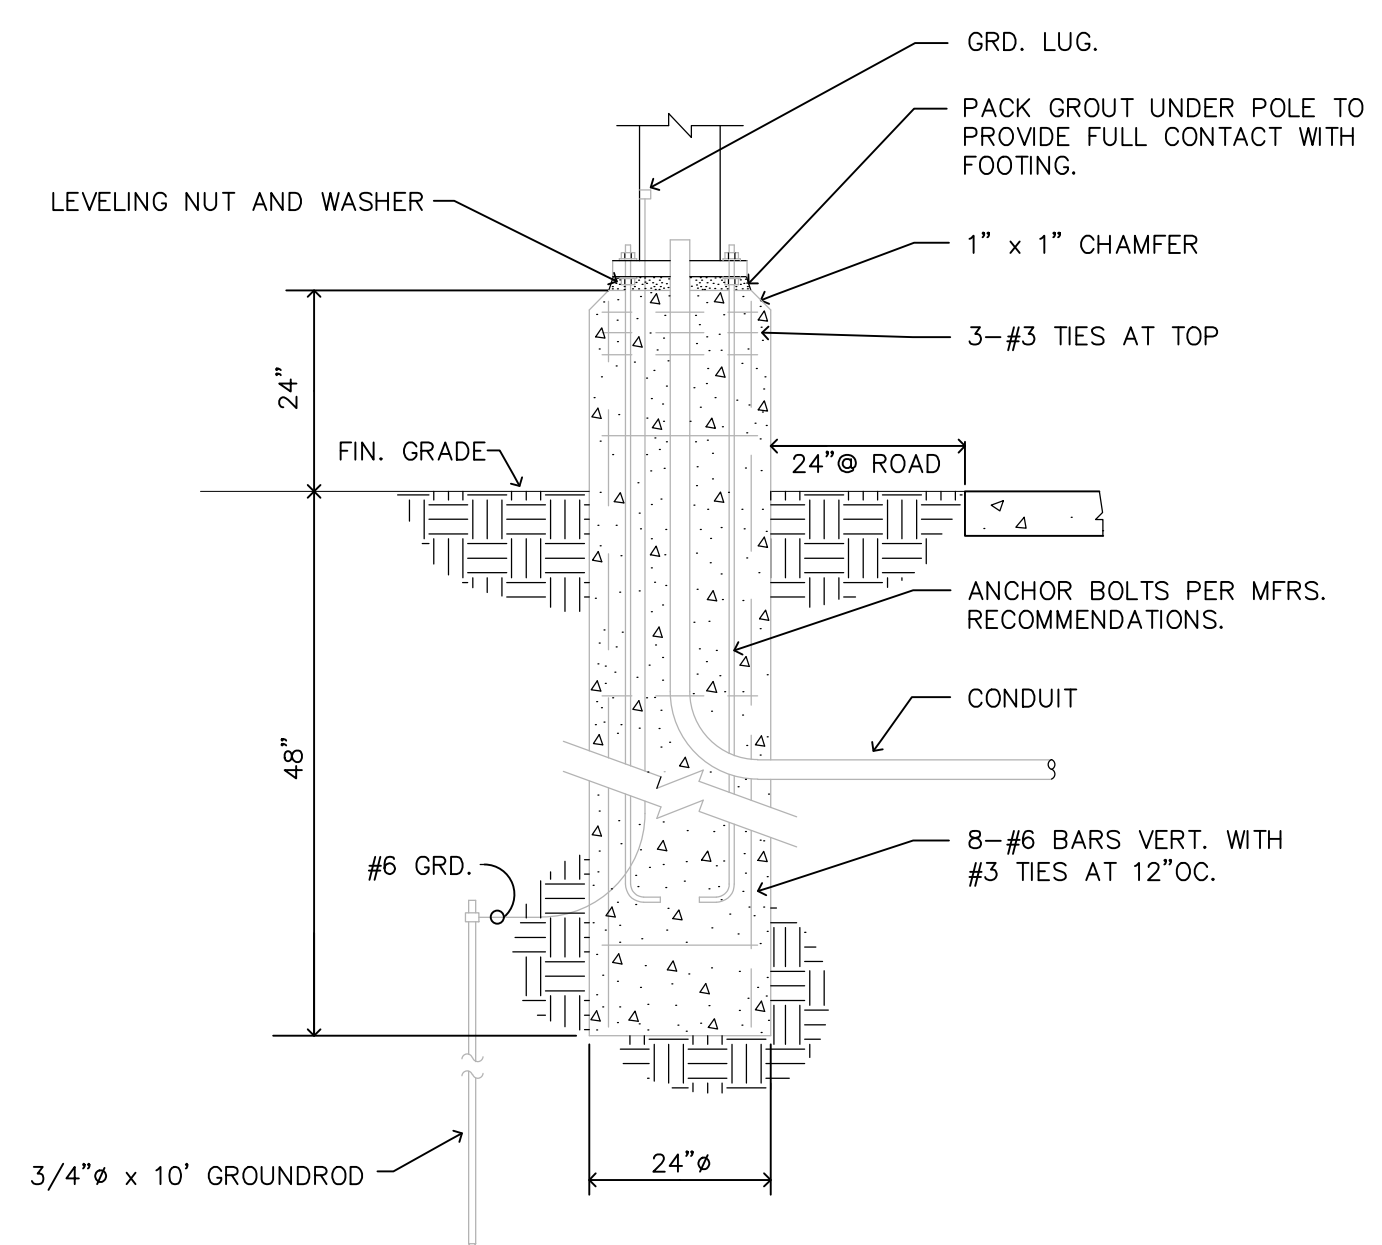

NOT TO SCALE

2
PME100

PME UTILITY PLAN & PHOTOMETRICS
SCALE: 1" = 20'-0"

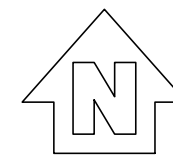

FREEDOM SPRINGS
734 WESTERN DRIVE
COLORADO SPRINGS, EL PASO COUNTY,
COLORADO, 80915

REVISION	DESCRIPTION	DATE
	PERMIT SET	03-05-18
Δ	ADDENDUM 02	7-30-18

This drawing and the details on it are the sole property of the Design Professional of Record and may be used for this specific project only. It shall not be loaned, copied, or reproduced in whole or in part or for any other purpose or project without their written consent.



Walter Warren - PE
CO 0051474

PROJECT NUMBER: 17190
DRAWN BY: WAW
COPYRIGHT: © VECINO DESIGN, LLC

PME UTILITY PLAN
PME-100

Markup Summary

Detail sheet of light pole height to verify it meets standards in the LDC (1)

Detail sheet of light pole height to verify it meets standards in the LDC

Subject: Text Box
Page Label: [1] PME-100 - SITE UTILITY
Lock: Locked
Author: dsdsevigny
Date: 10/2/2018 12:19:54 PM
Color: ■

Detail sheet of light pole height to verify it meets standards in the LDC

Needs to be a full photometric to determine scale at boundary line. (1)



Needs to be a full photometric to determine scale at boundary line.

Subject: Text Box
Page Label: [1] PME-100 - SITE UTILITY
Lock: Locked
Author: dsdsevigny
Date: 10/2/2018 12:19:56 PM
Color: ■

Needs to be a full photometric to determine scale at boundary line.