



# CORE ENGINEERING GROUP

April 27, 2023

El Paso County Planning and Community Development  
2880 International Circle, Suite 110  
Colorado Springs, CO 80910

RE: Lorson Ranch East Filing No. 1 (SF 18-008)  
Certification Letter

Dear El Paso County PCD,

Based upon information gathered from as-built surveys and periodic visits to the project, Core Engineering Group is of the opinion that the subdivision improvements have been constructed in general conformance with the approved design plans as filed with El Paso County.

The site and adjacent properties (as affected by work performed under the County permit) appear to be stable with respect to settlement and subsidence, sloughing of cut and fill slopes, revegetation or other ground cover, and the improvements (public improvements, common development improvements, site grading and paving) visually appear to meet or exceed the minimum design requirements.

The sanitary and watermain located in the public ROW has also been completed in accordance with Widefield Water and Sanitation Districts criteria.

In addition, Core Engineering Group has verified that the Extended Detention Basin/WQ Pond C5 and D2 meet the volume and elevation requirements and are constructed in general compliance with the approved construction plans. The pond "as-built" documents are attached to this letter. The tributary area draining to Pond D2 has changed and the updated spreadsheet with the corresponding spreadsheet printouts is attached.

Based on information gathered during construction and post-construction, Core Engineering Group is of the opinion that the public streets, storm sewer, and Detention Pond C5 and D2 have been constructed in general accordance with the approved construction documents.

Sincerely,  
Core Engineering Group, LLC




Richard L. Schindler, P.E. 33997

Attachments: Pond As-built elevations

## Detention Basin Outlet Structure Design

UD-Detention, Version 3.07 (February 2017)

Project: **Lorson Ranch East MDDP**  
 Basin ID: **Pond D2 - As-built**

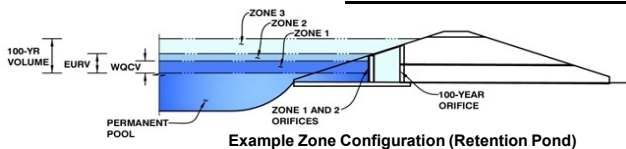

**Example Zone Configuration (Retention Pond)**

	Stage (ft)	Zone Volume (ac-ft)	Outlet Type
Zone 1 (WQCV)	3.08	1.552	Orifice Plate
Zone 2 (EURV)	4.77	2.878	Rectangular Orifice
Zone 3 (100-year)	6.75	3.737	Weir&Pipe (Restrict)
		8.168	<b>Total</b>

**User Input: Orifice at Underdrain Outlet (typically used to drain WQCV in a Filtration BMP)**

Underdrain Orifice Invert Depth =	N/A	ft (distance below the filtration media surface)
Underdrain Orifice Diameter =	N/A	inches

**Calculated Parameters for Underdrain**

Underdrain Orifice Area =	N/A	ft <sup>2</sup>
Underdrain Orifice Centroid =	N/A	feet

**User Input: Orifice Plate with one or more orifices or Elliptical Slot Weir (typically used to drain WQCV and/or EURV in a sedimentation BMP)**

Invert of Lowest Orifice =	0.00	ft (relative to basin bottom at Stage = 0 ft)
Depth at top of Zone using Orifice Plate =	3.08	ft (relative to basin bottom at Stage = 0 ft)
Orifice Plate: Orifice Vertical Spacing =	9.00	inches
Orifice Plate: Orifice Area per Row =	4.00	sq. inches (use rectangular openings)

**Calculated Parameters for Plate**

WQ Orifice Area per Row =	2.778E-02	ft <sup>2</sup>
Elliptical Half-Width =	N/A	feet
Elliptical Slot Centroid =	N/A	feet
Elliptical Slot Area =	N/A	ft <sup>2</sup>

**User Input: Stage and Total Area of Each Orifice Row (numbered from lowest to highest)**

	Row 1 (required)	Row 2 (optional)	Row 3 (optional)	Row 4 (optional)	Row 5 (optional)	Row 6 (optional)	Row 7 (optional)	Row 8 (optional)
Stage of Orifice Centroid (ft)	0.00	0.60	1.20					
Orifice Area (sq. inches)	4.00	4.00	4.00					

	Row 9 (optional)	Row 10 (optional)	Row 11 (optional)	Row 12 (optional)	Row 13 (optional)	Row 14 (optional)	Row 15 (optional)	Row 16 (optional)
Stage of Orifice Centroid (ft)								
Orifice Area (sq. inches)								

**User Input: Vertical Orifice (Circular or Rectangular)**

	Zone 2 Rectangular	Not Selected	
Invert of Vertical Orifice =	2.80	N/A	ft (relative to basin bottom at Stage = 0 ft)
Depth at top of Zone using Vertical Orifice =	4.77	N/A	ft (relative to basin bottom at Stage = 0 ft)
Vertical Orifice Height =	10.00	N/A	inches
Vertical Orifice Width =	2.00		inches

**Calculated Parameters for Vertical Orifice**

	Zone 2 Rectangular	Not Selected
Vertical Orifice Area =	0.14	N/A
Vertical Orifice Centroid =	0.42	N/A

**User Input: Overflow Weir (Dropbox) and Grate (Flat or Sloped)**

	Zone 3 Weir	Not Selected	
Overflow Weir Front Edge Height, H <sub>o</sub> =	4.52	N/A	ft (relative to basin bottom at Stage = 0 ft)
Overflow Weir Front Edge Length =	4.00	N/A	feet
Overflow Weir Slope =	13.50	N/A	H:V (enter zero for flat grate)
Horiz. Length of Weir Sides =	20.00	N/A	feet
Overflow Grate Open Area % =	70%	N/A	% , grate open area/total area
Debris Clogging % =	50%	N/A	%

**Calculated Parameters for Overflow Weir**

	Zone 3 Weir	Not Selected
Height of Grate Upper Edge, H <sub>g</sub> =	6.00	N/A
Over Flow Weir Slope Length =	20.05	N/A
Grate Open Area / 100-yr Orifice Area =	5.15	N/A
Overflow Grate Open Area w/o Debris =	56.15	N/A
Overflow Grate Open Area w/ Debris =	28.08	N/A

**User Input: Outlet Pipe w/ Flow Restriction Plate (Circular Orifice, Restrictor Plate, or Rectangular Orifice)**

	Zone 3 Restrictor	Not Selected	
Depth to Invert of Outlet Pipe =	0.00	N/A	ft (distance below basin bottom at Stage = 0 ft)
Outlet Pipe Diameter =	54.00	N/A	inches
Restrictor Plate Height Above Pipe Invert =	35.00		inches

**Calculated Parameters for Outlet Pipe w/ Flow Restriction Plate**

	Zone 3 Restrictor	Not Selected
Outlet Orifice Area =	10.91	N/A
Outlet Orifice Centroid =	1.64	N/A
Half-Central Angle of Restrictor Plate on Pipe =	1.87	N/A

**User Input: Emergency Spillway (Rectangular or Trapezoidal)**

Spillway Invert Stage =	7.00	ft (relative to basin bottom at Stage = 0 ft)
Spillway Crest Length =	30.00	feet
Spillway End Slopes =	4.00	H:V
Freeboard above Max Water Surface =	3.00	feet

**Calculated Parameters for Spillway**

Spillway Design Flow Depth =	1.64	feet
Stage at Top of Freeboard =	11.64	feet
Basin Area at Top of Freeboard =	2.43	acres
bottom orifice-95.00		

**Routed Hydrograph Results**


	WQCV	EURV	2 Year	5 Year	10 Year	25 Year	50 Year	100 Year
Design Storm Return Period =								
One-Hour Rainfall Depth (in)	0.53	1.07	1.19	1.50	1.75	2.00	2.25	2.52
Calculated Runoff Volume (acre-ft)	1.552	4.430	4.191	6.097	7.712	10.275	12.244	14.693
OPTIONAL Override Runoff Volume (acre-ft)								
Inflow Hydrograph Volume (acre-ft)	1.551	4.428	4.189	6.089	7.707	10.263	12.238	14.680
Predevelopment Unit Peak Flow, q (cfs/acre)	0.00	0.00	0.02	0.15	0.42	0.95	1.26	1.63
Predevelopment Peak Q (cfs)	0.0	0.0	1.5	13.0	35.3	80.5	106.2	137.4
Peak Inflow Q (cfs)	30.0	84.3	79.8	115.1	144.8	191.1	226.6	269.8
Peak Outflow Q (cfs)	0.7	2.1	1.6	14.8	36.6	76.7	108.8	119.1
Ratio Peak Outflow to Predevelopment Q	N/A	N/A	N/A	1.1	1.0	1.0	1.0	0.9
Structure Controlling Flow	Vertical Orifice 1	Overflow Grate 1	Overflow Grate 1	Overflow Grate 1	Overflow Grate 1	Overflow Grate 1	Overflow Grate 1	Outlet Plate 1
Max Velocity through Grate 1 (fps)	N/A	0.01	0.00	0.2	0.6	1.3	1.9	2.1
Max Velocity through Grate 2 (fps)	N/A	N/A	N/A	N/A	N/A	N/A	N/A	N/A
Time to Drain 97% of Inflow Volume (hours)	35	62	60	62	61	59	58	56
Time to Drain 99% of Inflow Volume (hours)	37	65	63	66	66	65	65	64
Maximum Ponding Depth (ft)	3.02	4.64	4.52	5.22	5.61	6.05	6.31	6.78
Area at Maximum Ponding Depth (acres)	1.59	1.78	1.77	1.84	1.88	1.92	1.95	2.00
Maximum Volume Stored (acre-ft)	1.461	4.200	3.988	5.230	5.973	6.809	7.312	8.239

# DETENTION BASIN STAGE-STORAGE TABLE BUILDER

UD-Depot, Version 3.07 (February 2017)

Project: LRE Filing No. 1

Basin ID: Pond D2 - As-built

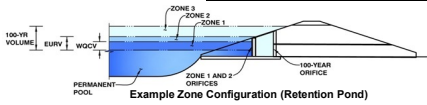

Example Zone Configuration (Retention Pond)

**Required Volume Calculation**

Selected BMP Type =	<b>EDB</b>	
Watershed Area =	84.50	acres
Watershed Length =	2,200	ft
Watershed Slope =	0.025	ft/ft
Watershed Imperviousness =	55.00%	percent
Percentage Hydrologic Soil Group A =	0.0%	percent
Percentage Hydrologic Soil Group B =	0.0%	percent
Percentage Hydrologic Soil Groups C/D =	100.0%	percent
Desired WQCV Drain Time =	40.0	hours
Location for 1-hr Rainfall Depths =	User Input	
Water Quality Capture Volume (WQCV) =	1,552	acre-feet
Excess Urban Runoff Volume (EURV) =	4,430	acre-feet
2-yr Runoff Volume (P1 = 1.19 in.) =	4,191	acre-feet
5-yr Runoff Volume (P1 = 1.5 in.) =	6,097	acre-feet
10-yr Runoff Volume (P1 = 1.75 in.) =	7,712	acre-feet
25-yr Runoff Volume (P1 = 2 in.) =	10,275	acre-feet
50-yr Runoff Volume (P1 = 2.25 in.) =	12,244	acre-feet
100-yr Runoff Volume (P1 = 2.52 in.) =	14,693	acre-feet
500-yr Runoff Volume (P1 = 0 in.) =	0.000	acre-feet
Approximate 2-yr Detention Volume =	3,931	acre-feet
Approximate 5-yr Detention Volume =	5,745	acre-feet
Approximate 10-yr Detention Volume =	6,551	acre-feet
Approximate 25-yr Detention Volume =	7,048	acre-feet
Approximate 50-yr Detention Volume =	7,284	acre-feet
Approximate 100-yr Detention Volume =	8,168	acre-feet

**Optional User Override**


1-hr Precipitation	1.19	inches
	1.50	inches
	1.75	inches
	2.00	inches
	2.25	inches
	2.52	inches

**Stage-Storage Calculation**

Zone 1 Volume (WQCV) =	1,552	acre-feet
Zone 2 Volume (EURV - Zone 1) =	2,878	acre-feet
Zone 3 Volume (100-year - Zones 1 & 2) =	3,737	acre-feet
Total Detention Basin Volume =	8,168	acre-feet
Initial Surcharge Volume (ISV) =	user	ft <sup>3</sup>
Initial Surcharge Depth (ISD) =	user	ft
Total Available Detention Depth (H <sub>total</sub> ) =	user	ft
Depth of Trickle Channel (H <sub>TC</sub> ) =	user	ft
Slope of Trickle Channel (S <sub>TC</sub> ) =	user	ft/ft
Slopes of Main Basin Sides (S <sub>main</sub> ) =	user	H:V
Basin Length-to-Width Ratio (R <sub>LW</sub> ) =	user	
Initial Surcharge Area (A <sub>sv</sub> ) =	user	ft <sup>2</sup>
Surcharge Volume Length (L <sub>sv</sub> ) =	user	ft
Surcharge Volume Width (W <sub>sv</sub> ) =	user	ft
Depth of Basin Floor (H <sub>f,100</sub> ) =	user	ft
Length of Basin Floor (L <sub>f,100</sub> ) =	user	ft
Width of Basin Floor (W <sub>f,100</sub> ) =	user	ft
Area of Basin Floor (A <sub>f,100</sub> ) =	user	ft <sup>2</sup>
Volume of Basin Floor (V <sub>f,100</sub> ) =	user	ft <sup>3</sup>
Depth of Main Basin (H <sub>main</sub> ) =	user	ft
Length of Main Basin (L <sub>main</sub> ) =	user	ft
Width of Main Basin (W <sub>main</sub> ) =	user	ft
Area of Main Basin (A <sub>main</sub> ) =	user	ft <sup>2</sup>
Volume of Main Basin (V <sub>main</sub> ) =	user	ft <sup>3</sup>
Calculated Total Basin Volume (V <sub>total</sub> ) =	user	acre-feet

bottom orifice - 95.00

Depth Increment =	0.2		ft											
Stage - Storage Description	Stage (ft)	Optional Override Stage (ft)	Length (ft)	Width (ft)	Area (ft <sup>2</sup> )	Optional Override Area (ft <sup>2</sup> )	Area (acre)	Volume (ft <sup>3</sup> )	Volume (ac-ft)					
Top of Micropool	--	0.00	--	--	--	56	0.001							
5695.33	--	0.33	--	--	--	56	0.001	18	0.000					
5696	--	1.00	--	--	--	1,701	0.039	590	0.014					
5697	--	2.00	--	--	--	26,100	0.599	14,247	0.327					
5698	--	3.00	--	--	--	69,360	1.592	62,237	1.429					
5699	--	4.00	--	--	--	74,702	1.715	134,268	3.082					
5700	--	5.00	--	--	--	79,028	1.814	211,133	4.847					
5701	--	6.00	--	--	--	83,502	1.917	292,398	6.713					
5702	--	7.00	--	--	--	88,029	2.021	378,164	8.681					
5703	--	8.00	--	--	--	92,327	2.120	468,342	10.752					
5704	--	9.00	--	--	--	96,850	2.223	562,930	12.923					
5705	--	10.00	--	--	--	100,980	2.318	661,845	15.194					
5706	--	11.00	--	--	--	105,820	2.429	765,245	17.568					

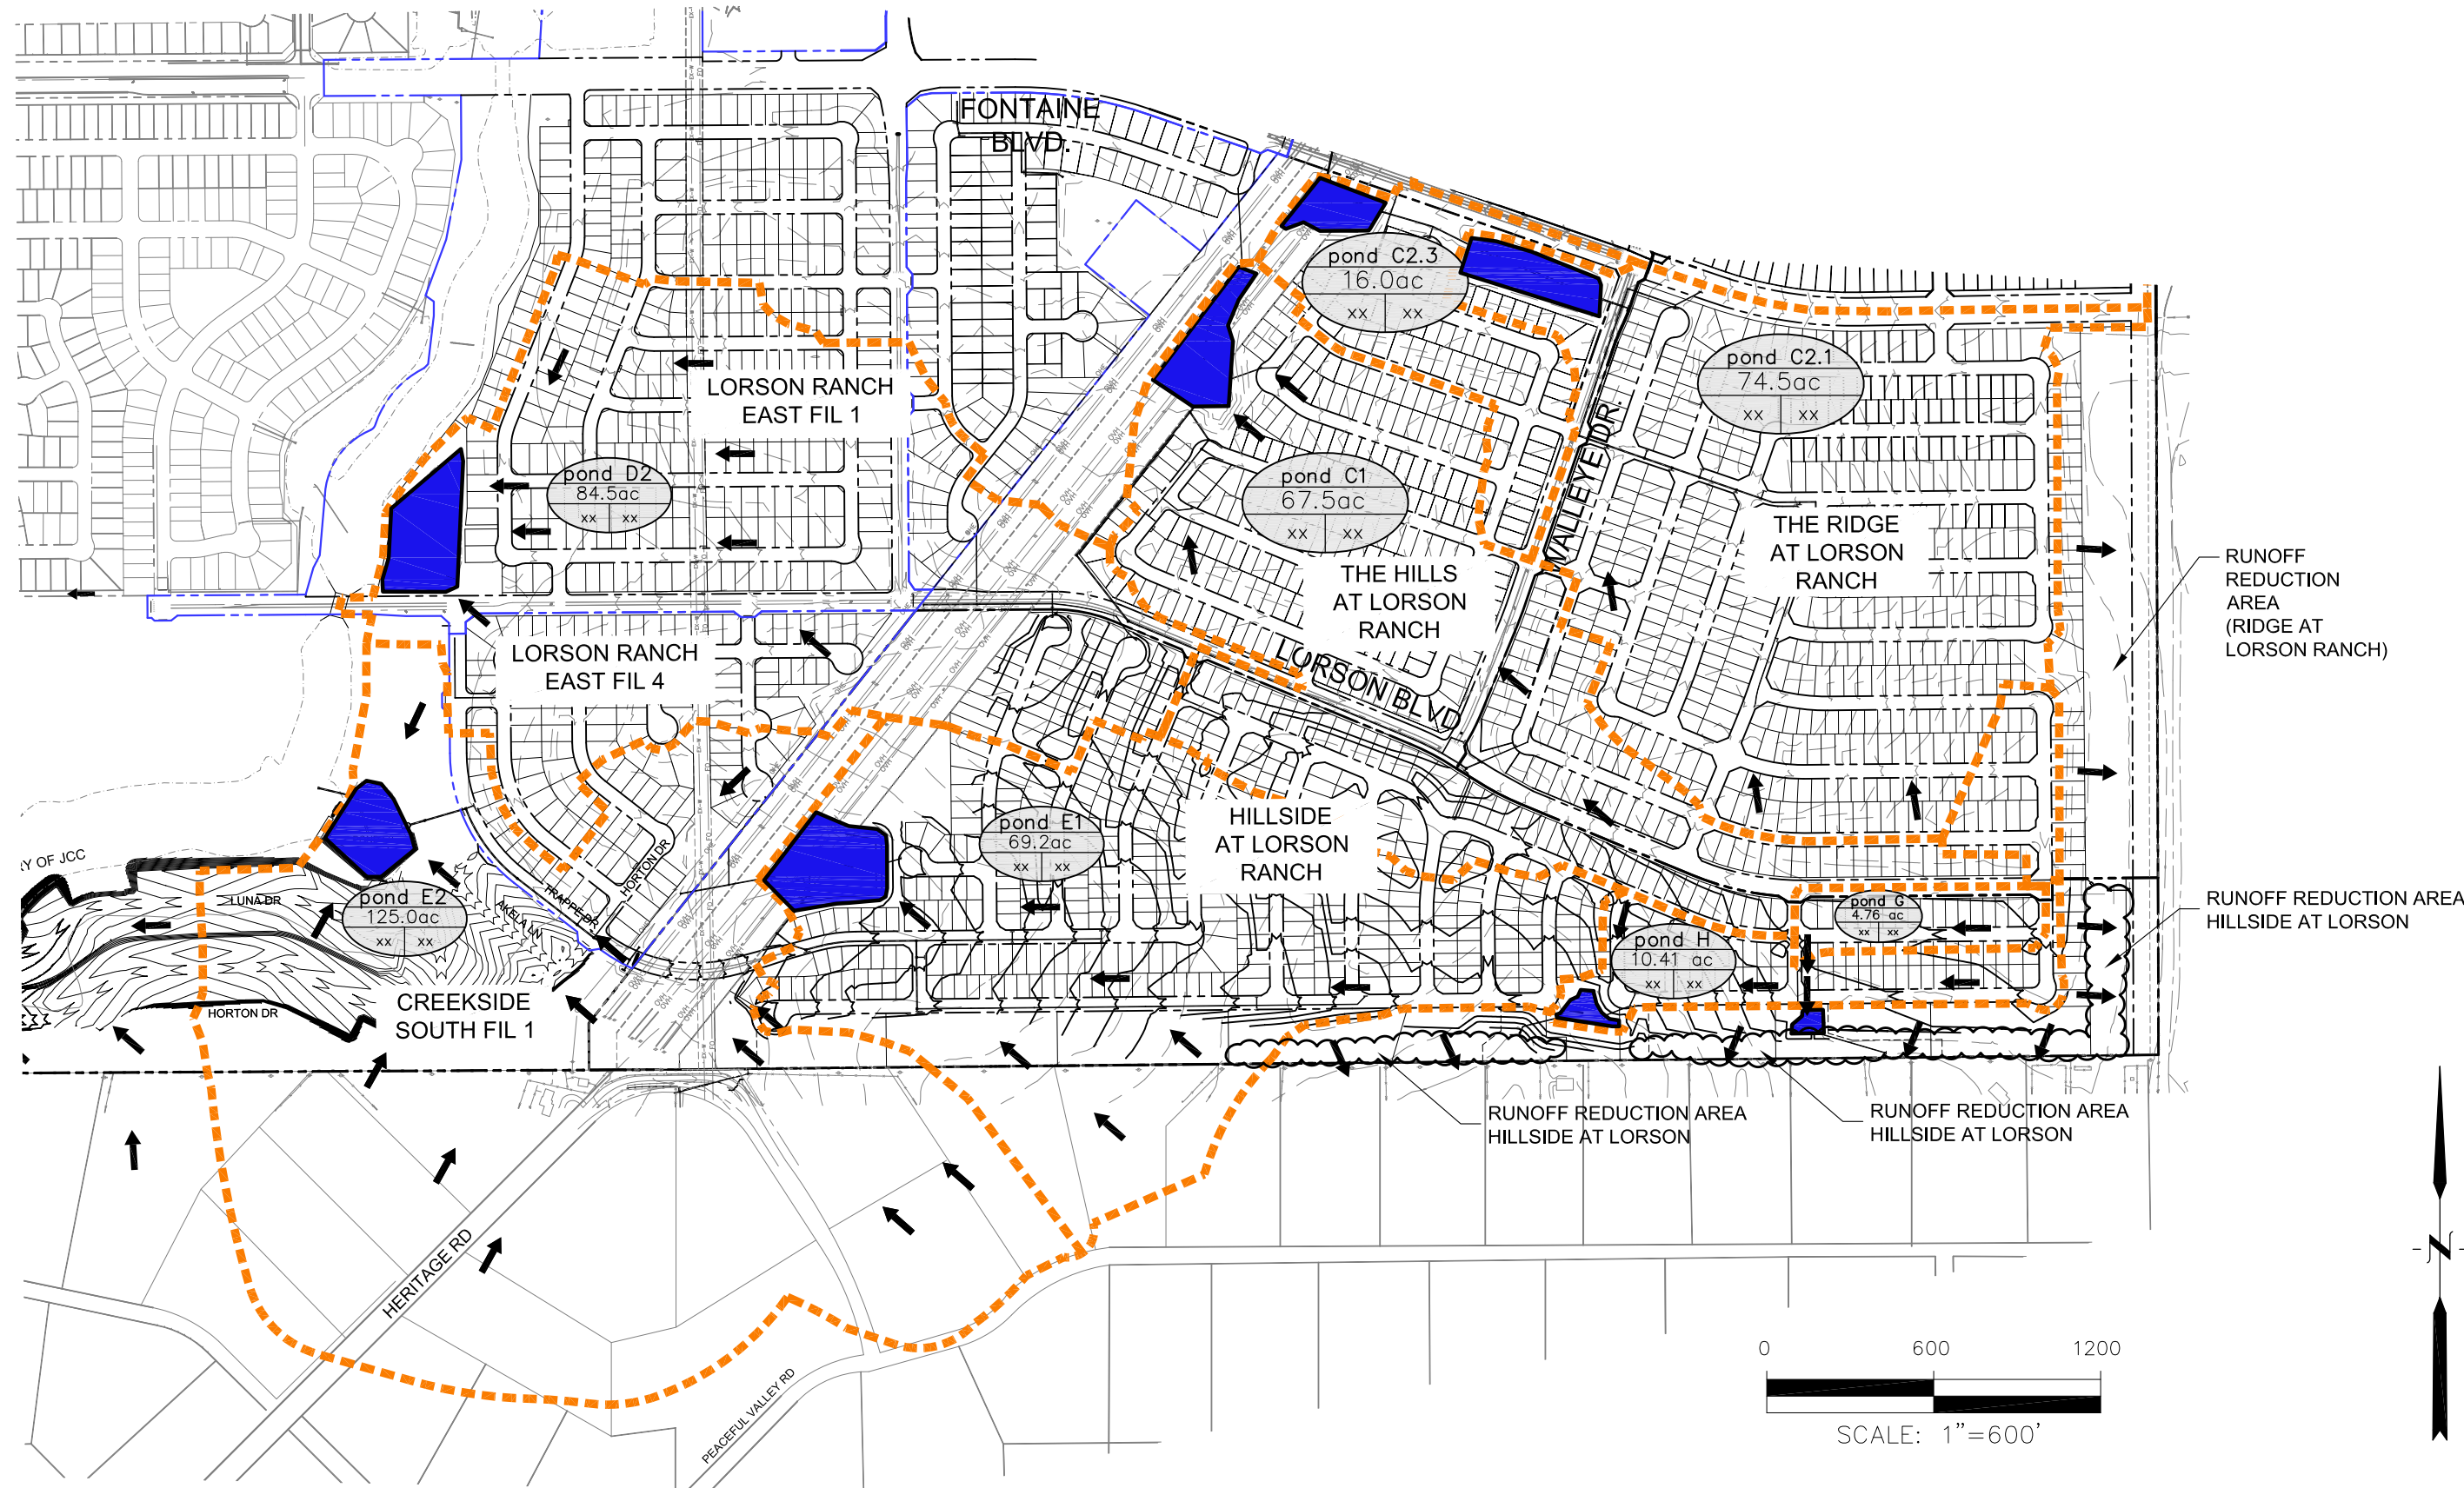


**CORE ENGINEERING GROUP**

15004 1ST AVENUE S.  
 BURNSVILLE, MN 55306  
 PH: 719.570.1100  
 CONTACT: RICHARD L. SCHINDLER, P.E.  
 EMAIL: Rich@ceg1.com


**HILLSIDE AT LORSON RANCH  
 WATER QUALITY & POND TRIBUTARY AREAS**

SCALE: NTS	DATE: APRIL, 2022	FIGURE NO. 1
---------------	----------------------	-----------------


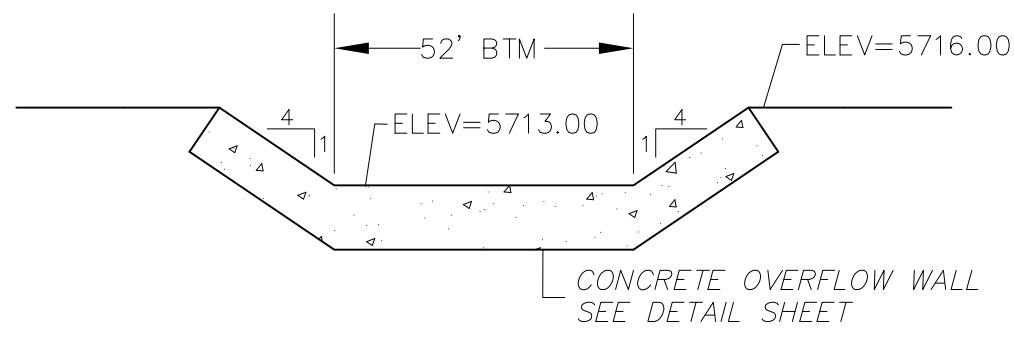



**POND C5 EMERGENCY OVERFLOW PROFILE**  
 SCALE: NTS

**AS-BUILT**  
 DATE: 07/19/2022

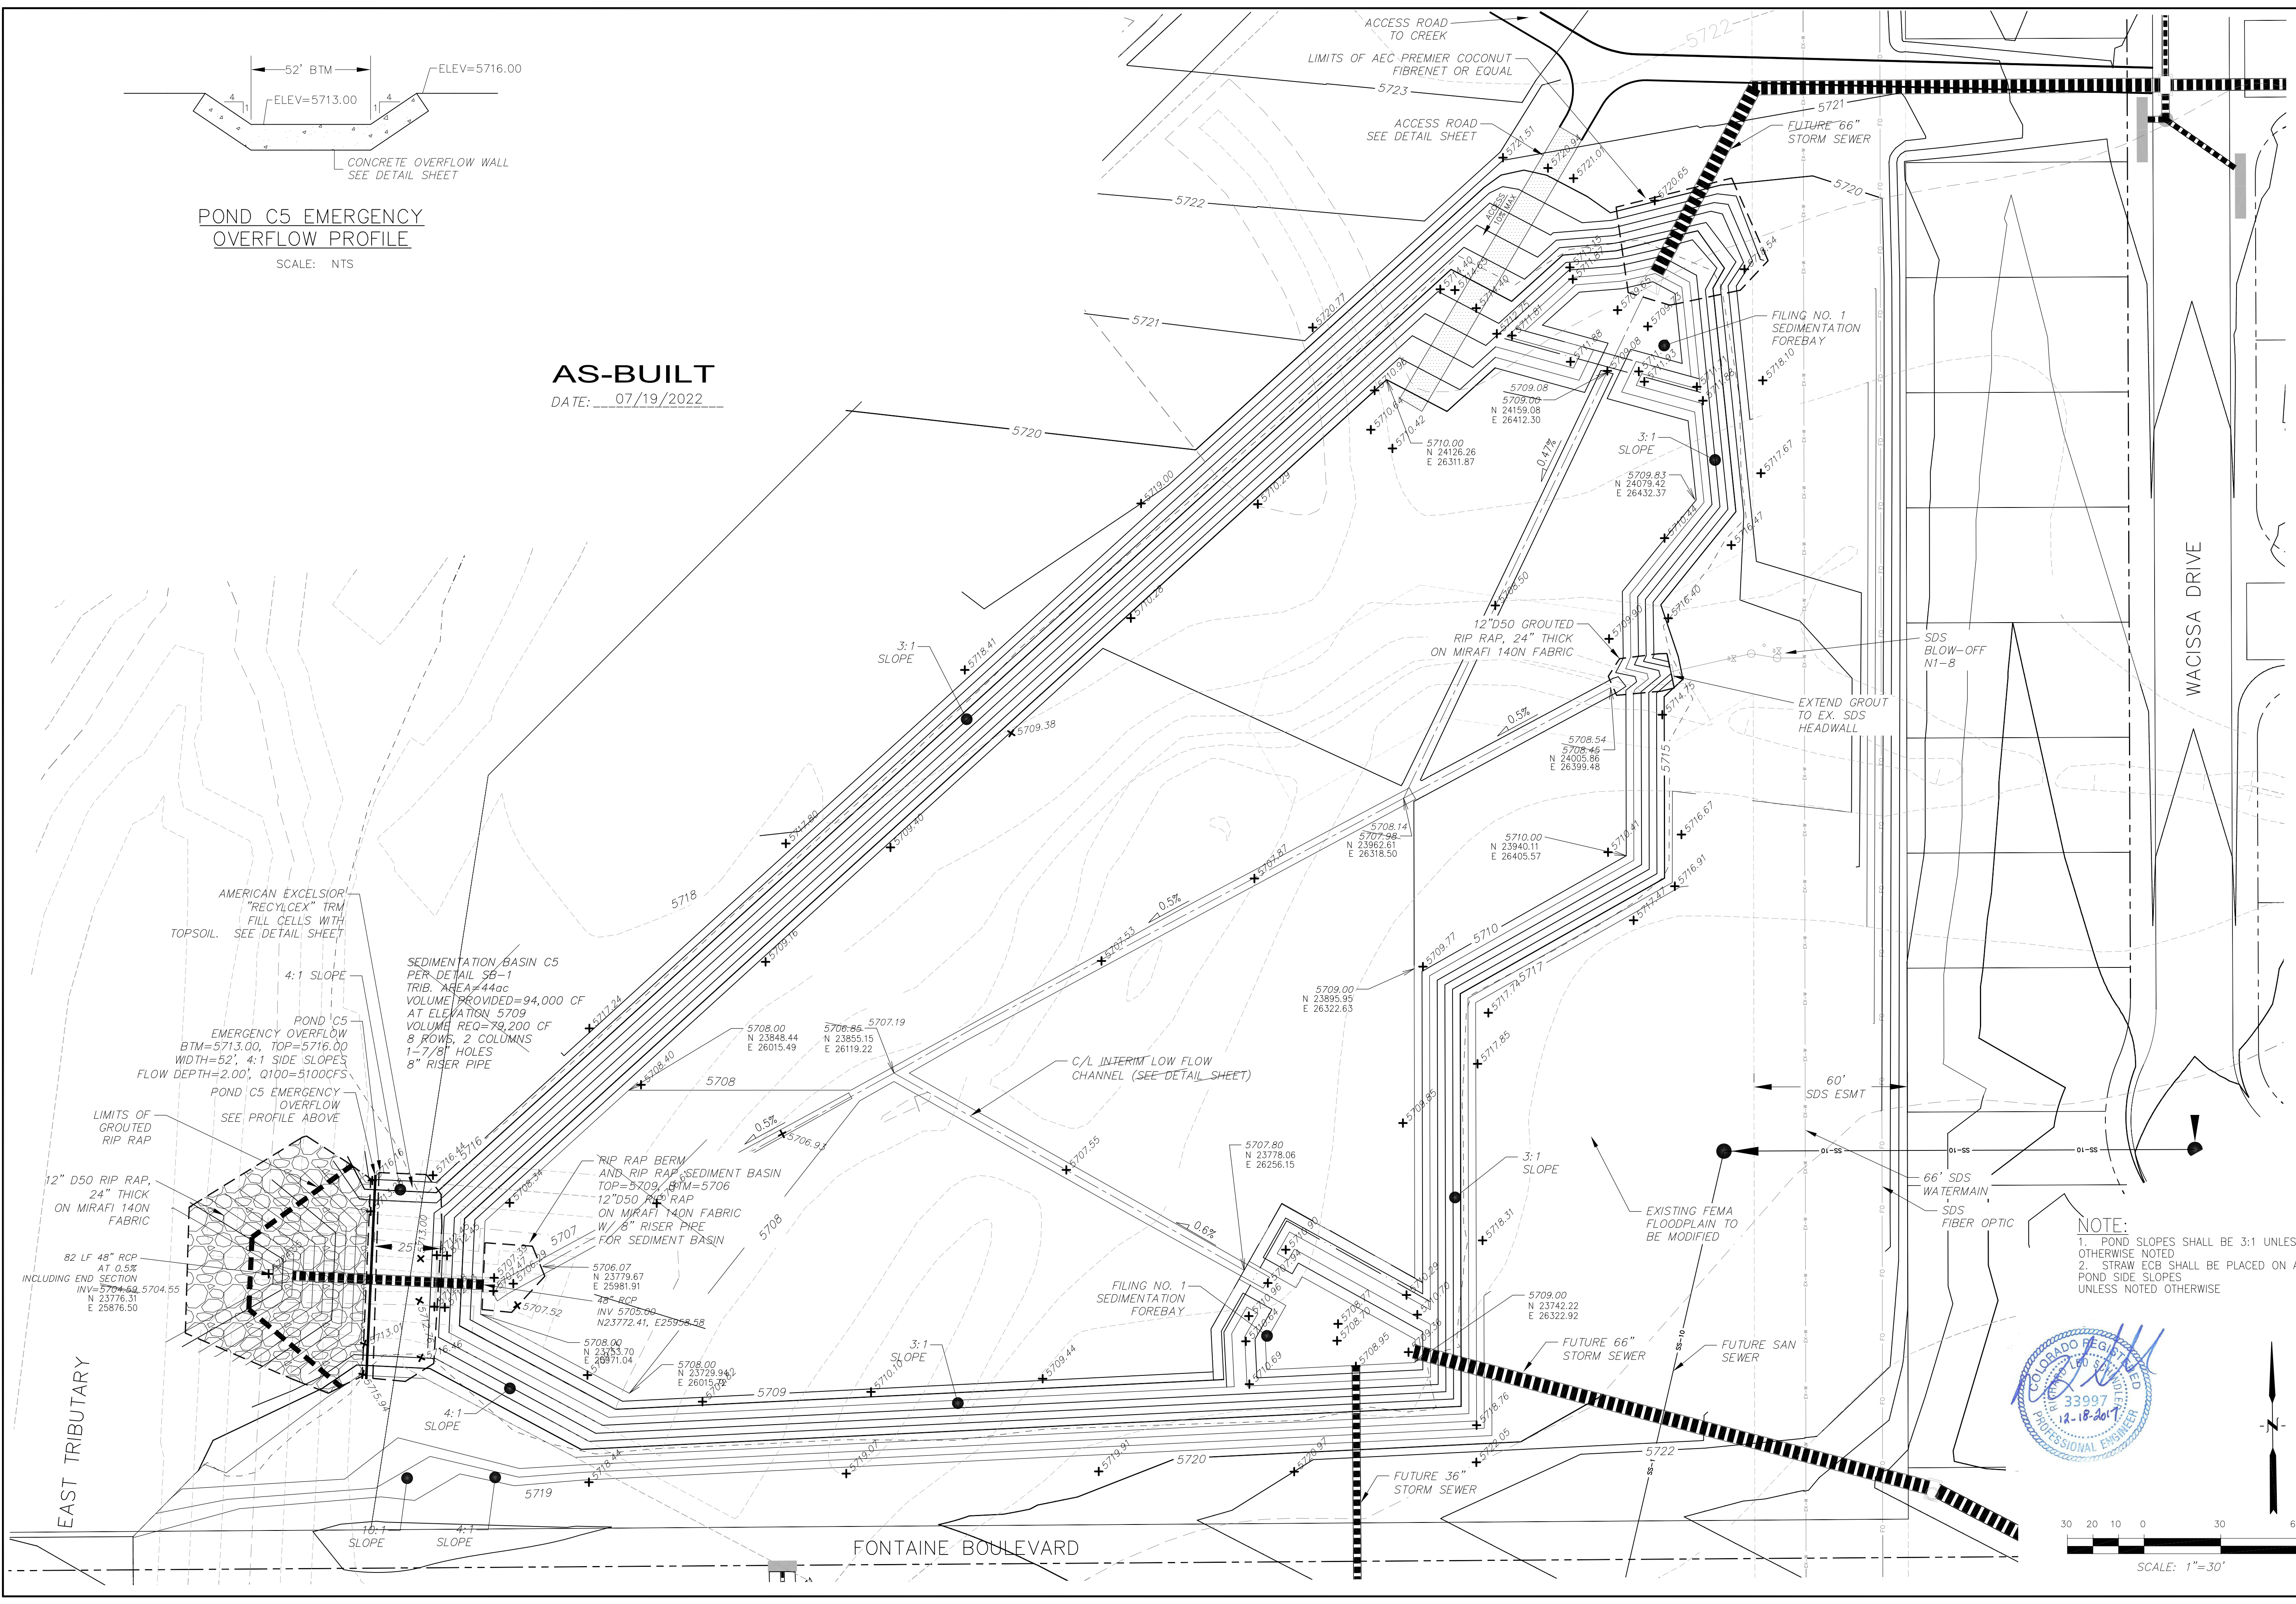

**NOTE:**  
 1. POND SLOPES SHALL BE 3:1 UNLESS OTHERWISE NOTED  
 2. STRAW ECB SHALL BE PLACED ON ALL POND SIDE SLOPES UNLESS NOTED OTHERWISE

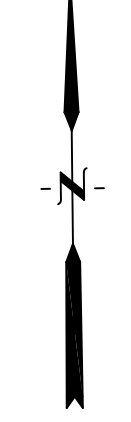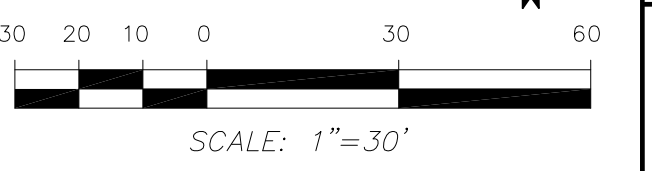

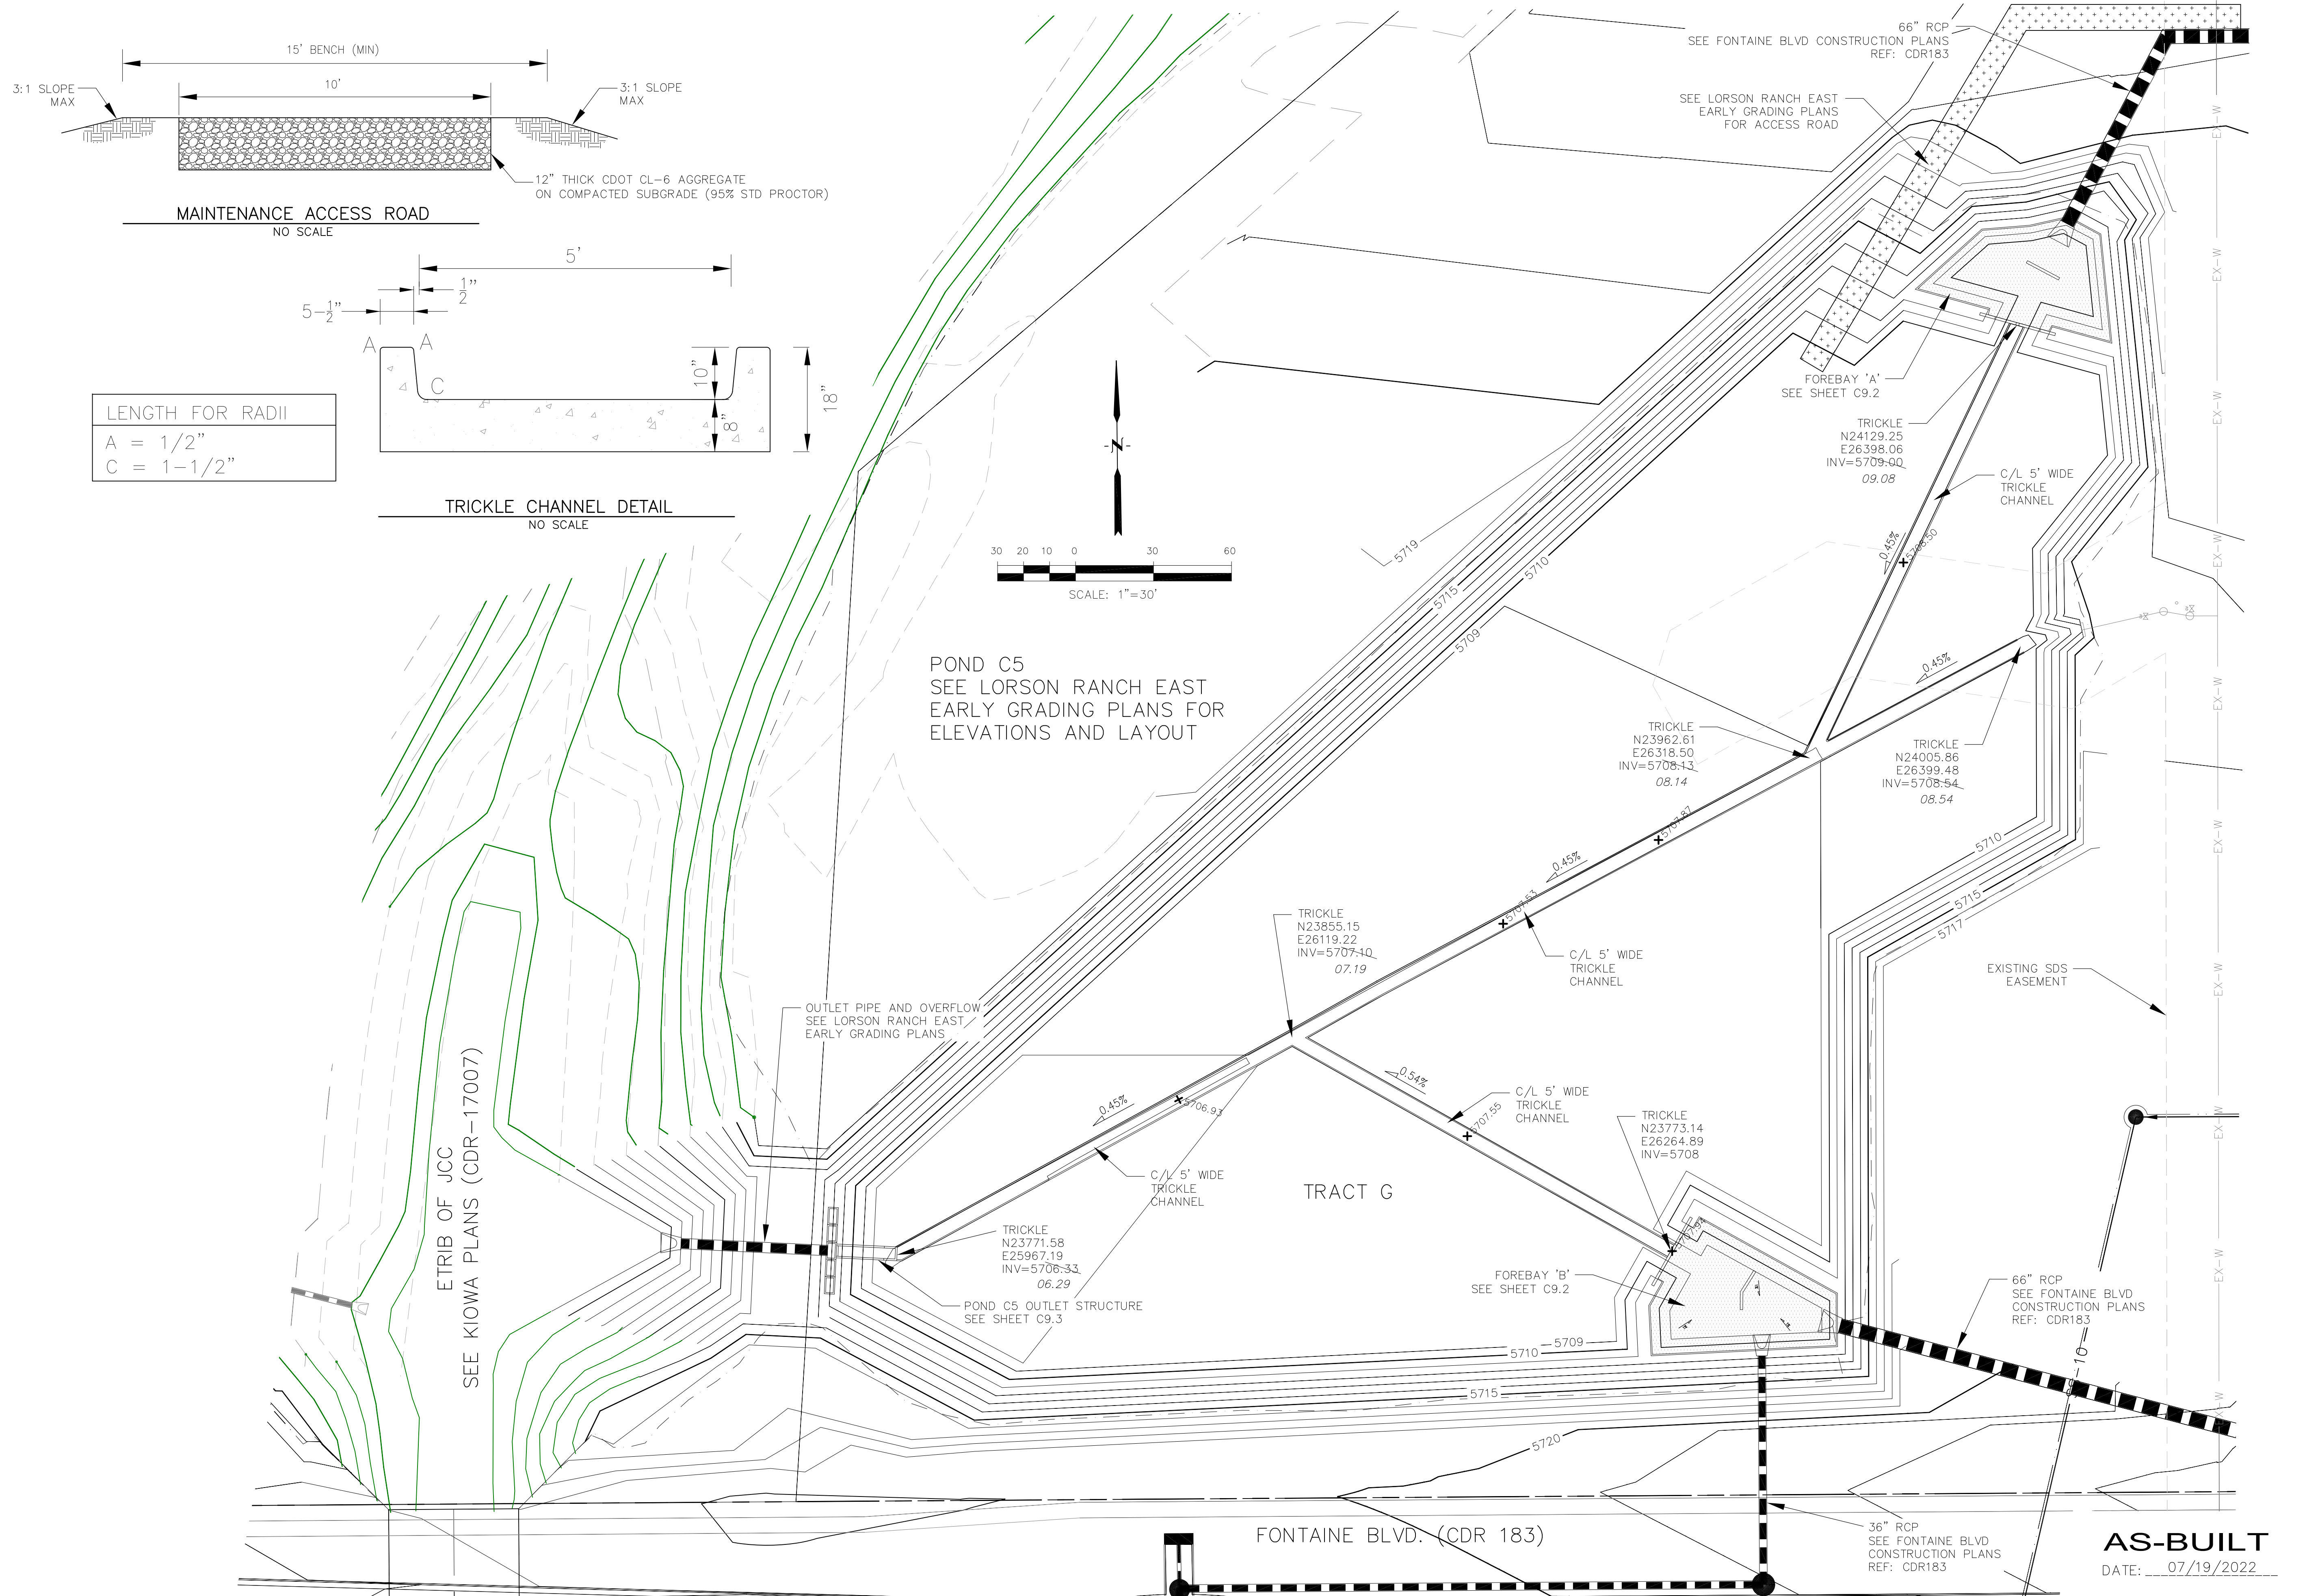

**CORE**  
**ENGINEERING GROUP**  
15004 1ST AVENUE, S.  
DENVER, CO 80202  
PHONE: 719.570.1100  
CONTACT: RICHARD L. SCHINDLER, P.E.  
EMAIL: Rich@ceg1.com


DATE: \_\_\_\_\_  
DESCRIPTION: \_\_\_\_\_  
NO: \_\_\_\_\_

PREPARED FOR:  
**LORSON, LLC**  
212 N. WAHSATCH AVE, SUITE 301  
COLORADO SPRINGS, COLORADO 80903  
(719) 635-3200  
CONTACT: JEFF MARK

PROJECT:  
**LORSON RANCH EAST**  
FILING NO. 1  
FONTAINE BLVD. - OLD GLORY DR  
COLORADO SPRINGS, COLORADO

DRAWN: RLS  
DESIGNED: RLS  
CHECKED: RLS

**POND C5**  
**TRICKLE CHANNEL**  
**LAYOUT AND DETAILS**

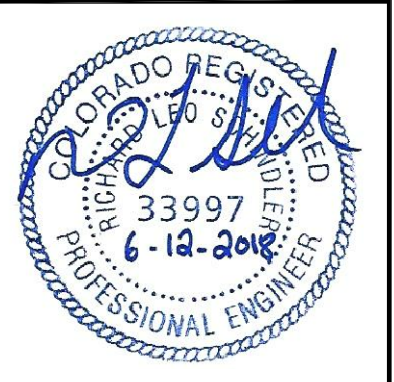


DATE:  
JUNE 12, 2018


PROJECT NO.  
100.042

SHEET NUMBER  
**C9.1**


TOTAL SHEETS: 45

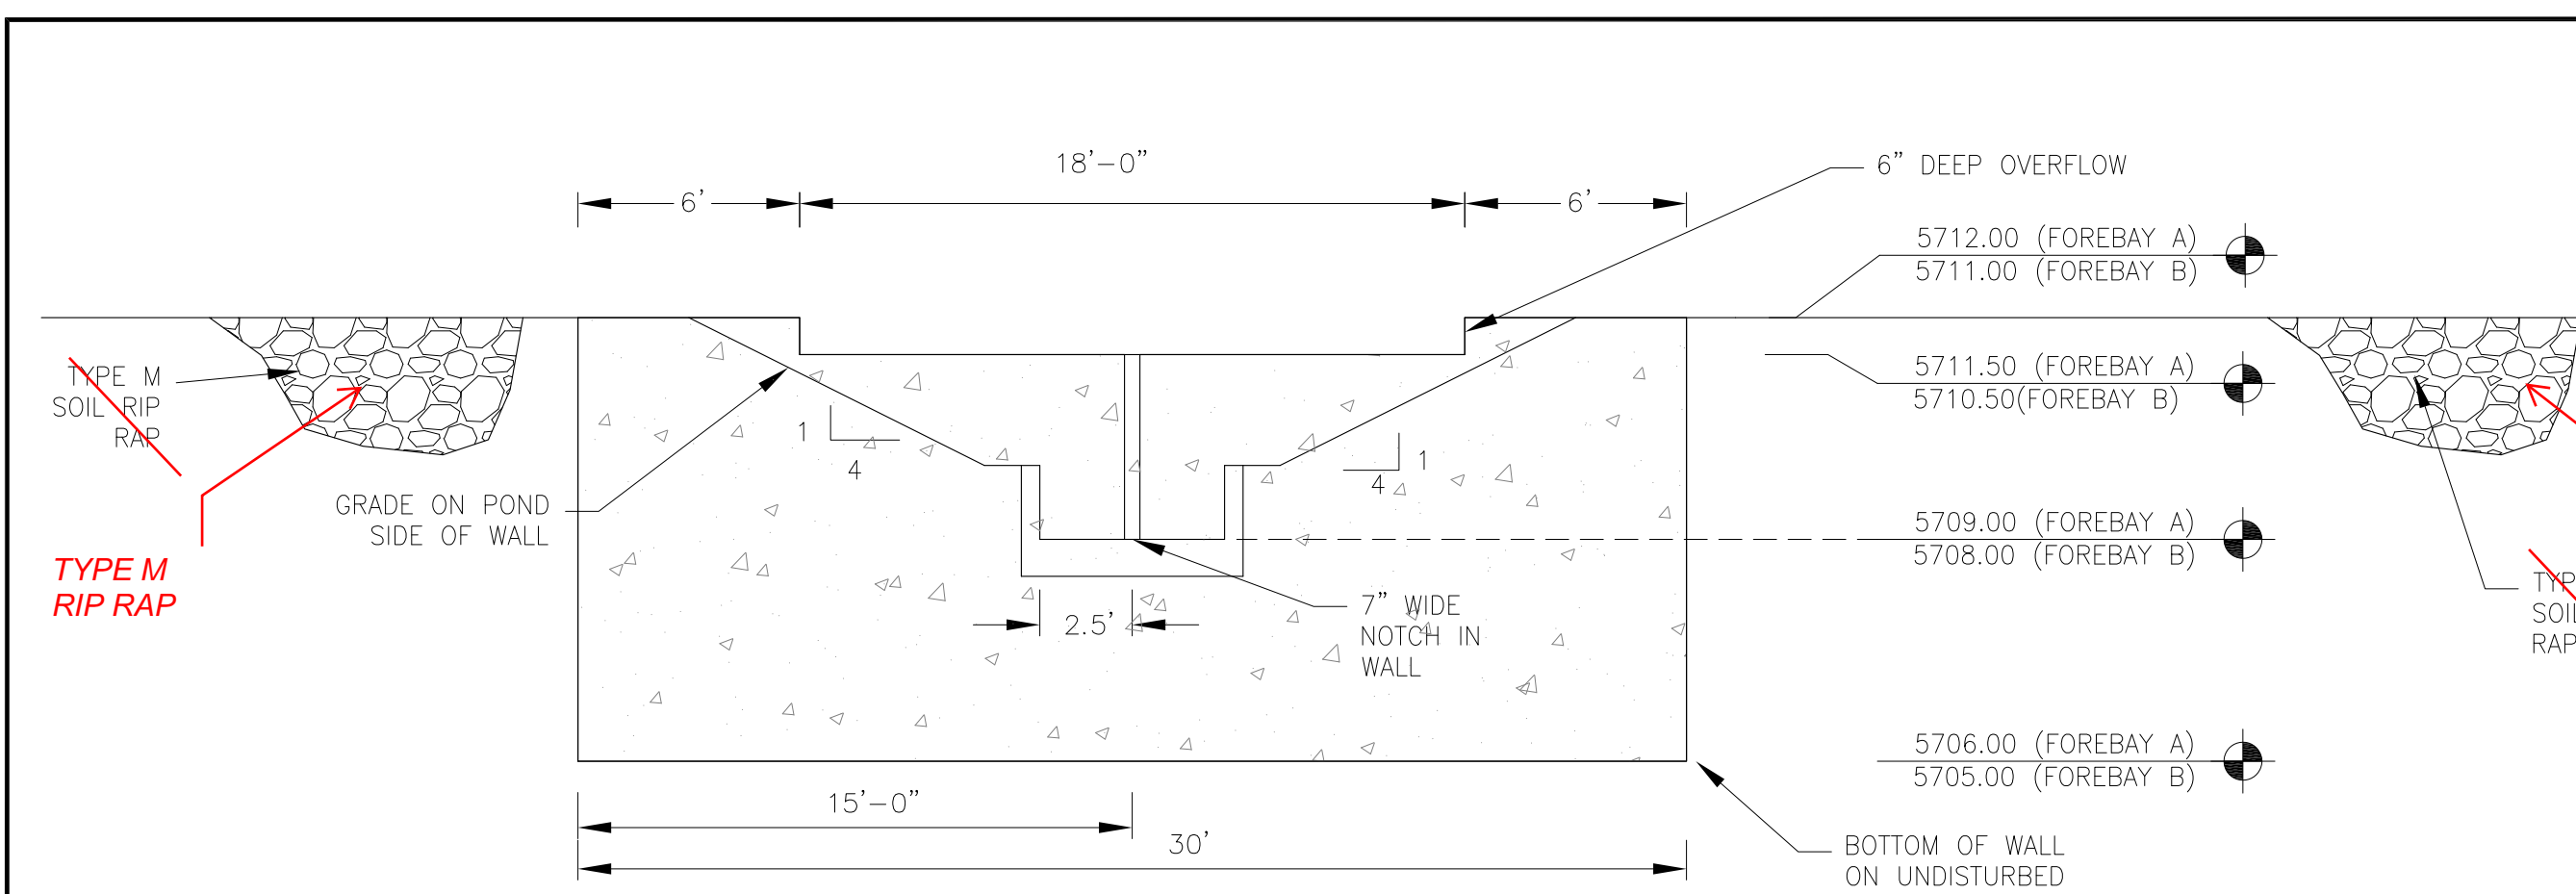

WALL SECTION A-A  
1"=10'

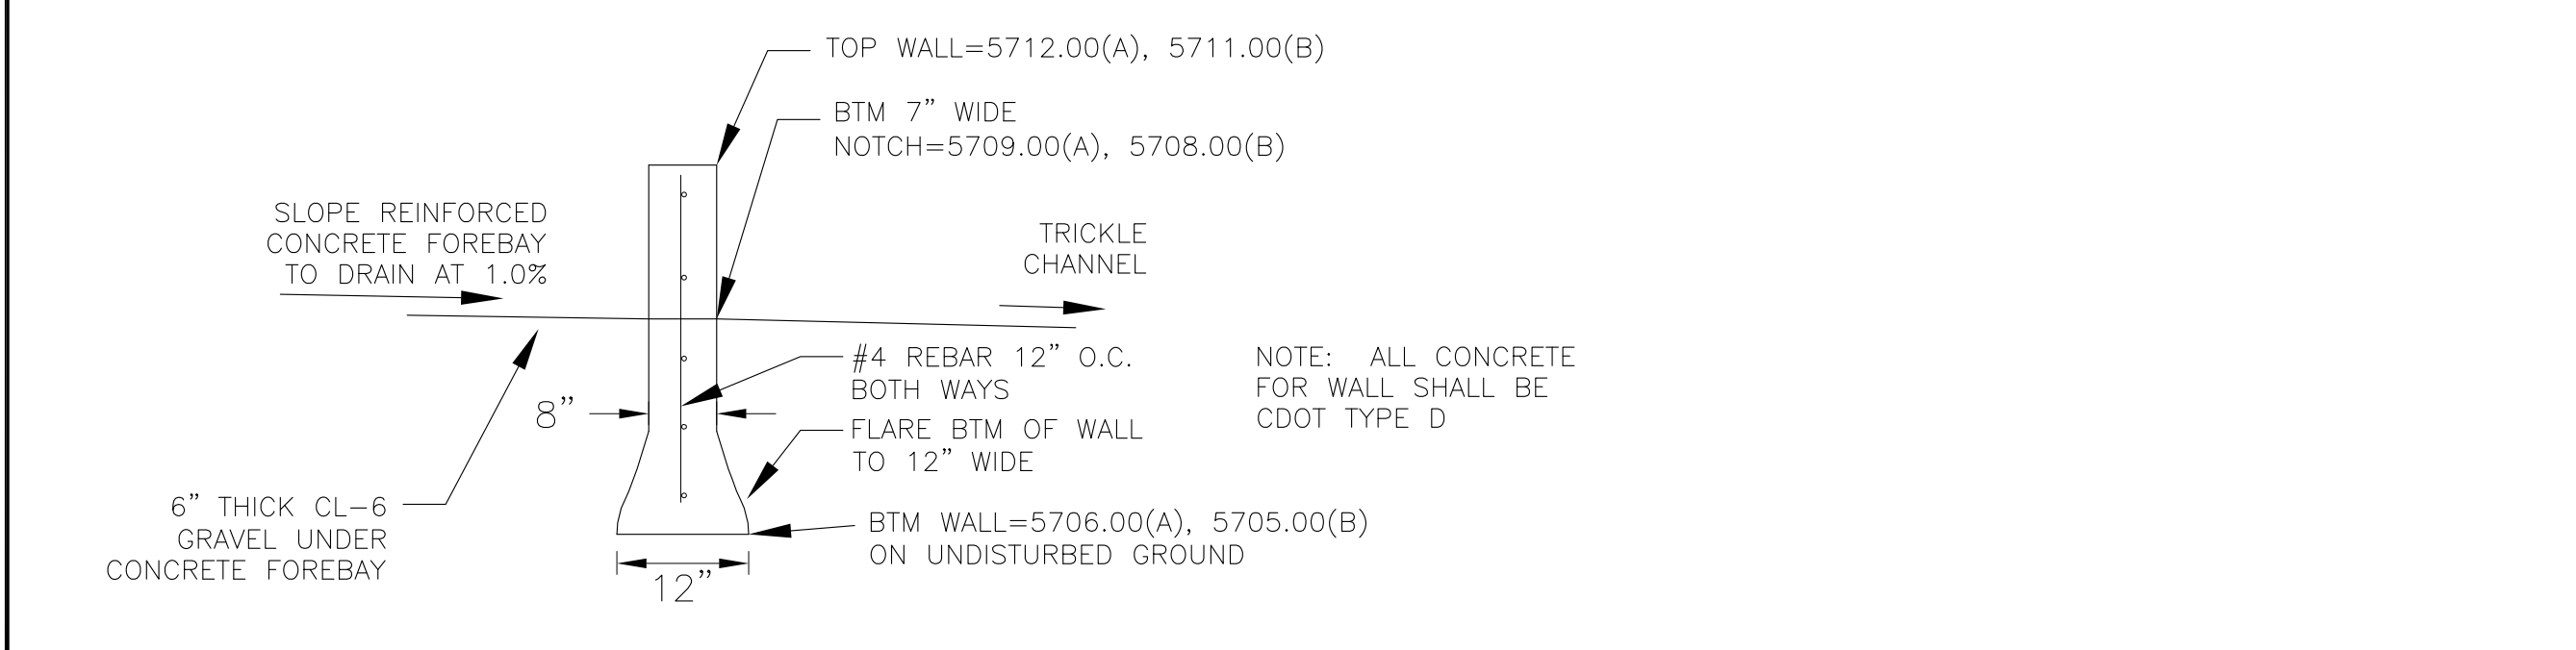


WALL SECTION B-B  
NO SCALE

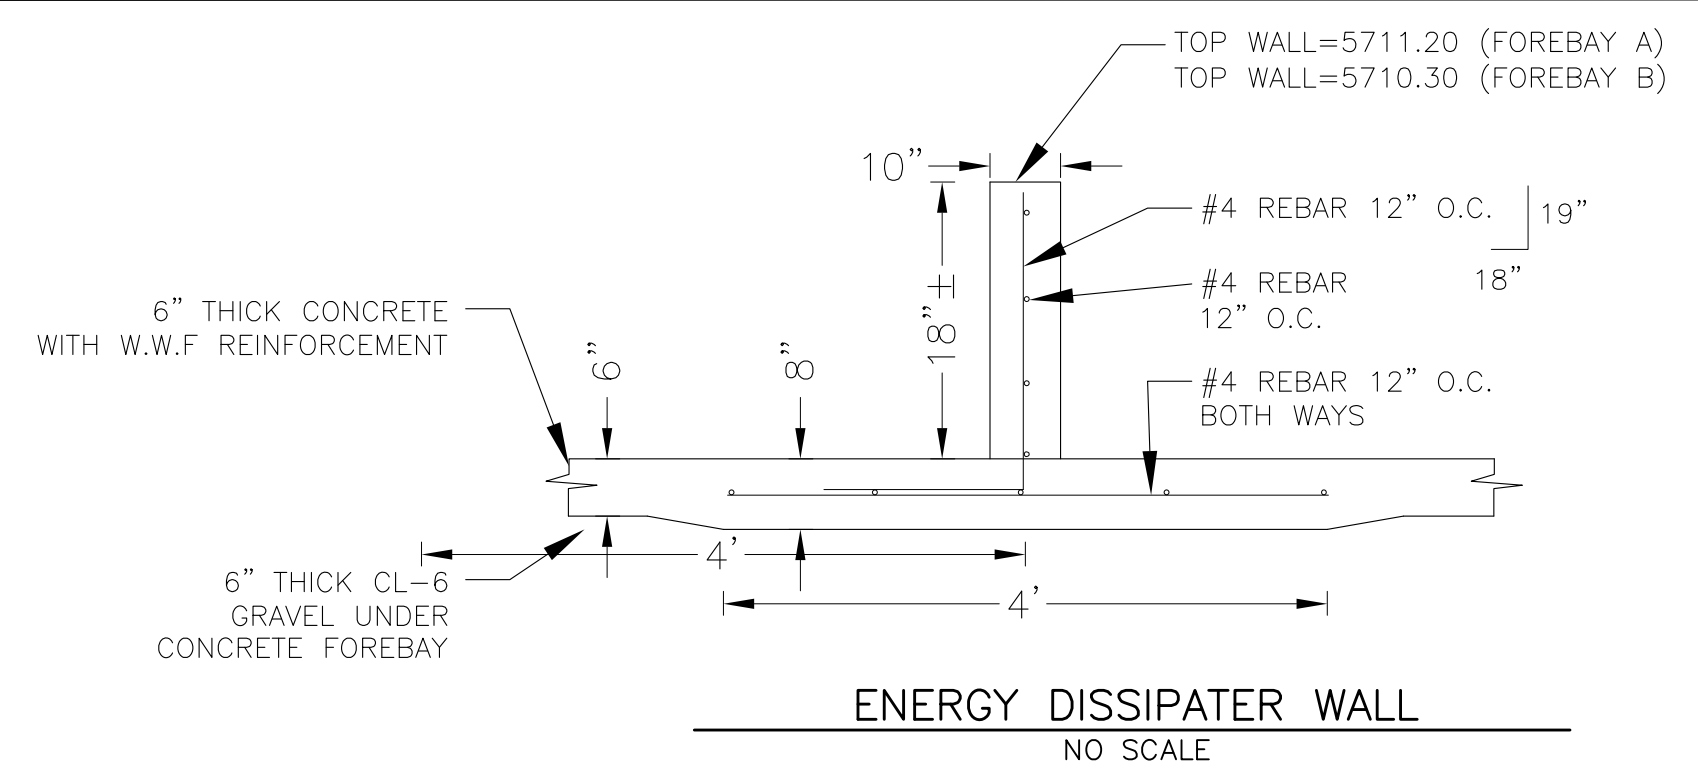



NOTE: ALL CONCRETE FOR WALL SHALL BE CDOT TYPE D

POINT TABLE (FOREBAY A)				
NUMBER	NORTHING	EASTING	ELEVATION	NOTES
1	24130.17	26398.49	5709.10	FOREBAY BOTTOM
2	24143.93	26404.81	5709.25	FOREBAY BOTTOM
3	24145.19	26420.81	5709.41	FOREBAY BOTTOM
4	24154.44	26410.13	5709.55	FOREBAY BOTTOM
5	24161.46	26413.90	5709.70	FOREBAY BOTTOM
6	24156.46	26397.97	5709.41	FOREBAY BOTTOM
7	24148.40	26377.53	5709.60	FOREBAY BOTTOM
8	24158.47	26388.19	5709.55	FOREBAY BOTTOM
9	24135.44	26425.04	5709.60	FOREBAY BOTTOM
10	24154.10	26423.78	5709.70	FOREBAY BOTTOM
11	24153.68	26401.87	5709.70	ENERGY DISSIPATER WALL
12	24147.13	26414.24	5709.70	ENERGY DISSIPATER WALL

POINT TABLE (FOREBAY B)				
NUMBER	NORTHING	EASTING	ELEVATION	NOTES
1	23772.63	26265.75	5708.10	FOREBAY BOTTOM
2	23762.58	26283.27	5708.30	FOREBAY BOTTOM
3	23746.29	26279.56	5708.50	FOREBAY BOTTOM
4	23749.41	26299.77	5708.70	FOREBAY BOTTOM
5	23751.14	26310.99	5708.70	FOREBAY BOTTOM
6	23746.27	26322.62	5708.95	FOREBAY BOTTOM
7	23740.80	26299.85	5708.80	FOREBAY BOTTOM
8	23765.15	26295.04	5708.40	FOREBAY BOTTOM
9	23750.52	26292.05	5708.80	ENERGY DISSIPATER WALL
10	23757.25	26292.22		ENERGY DISSIPATER WALL
11	23765.34	26297.18		ENERGY DISSIPATER WALL

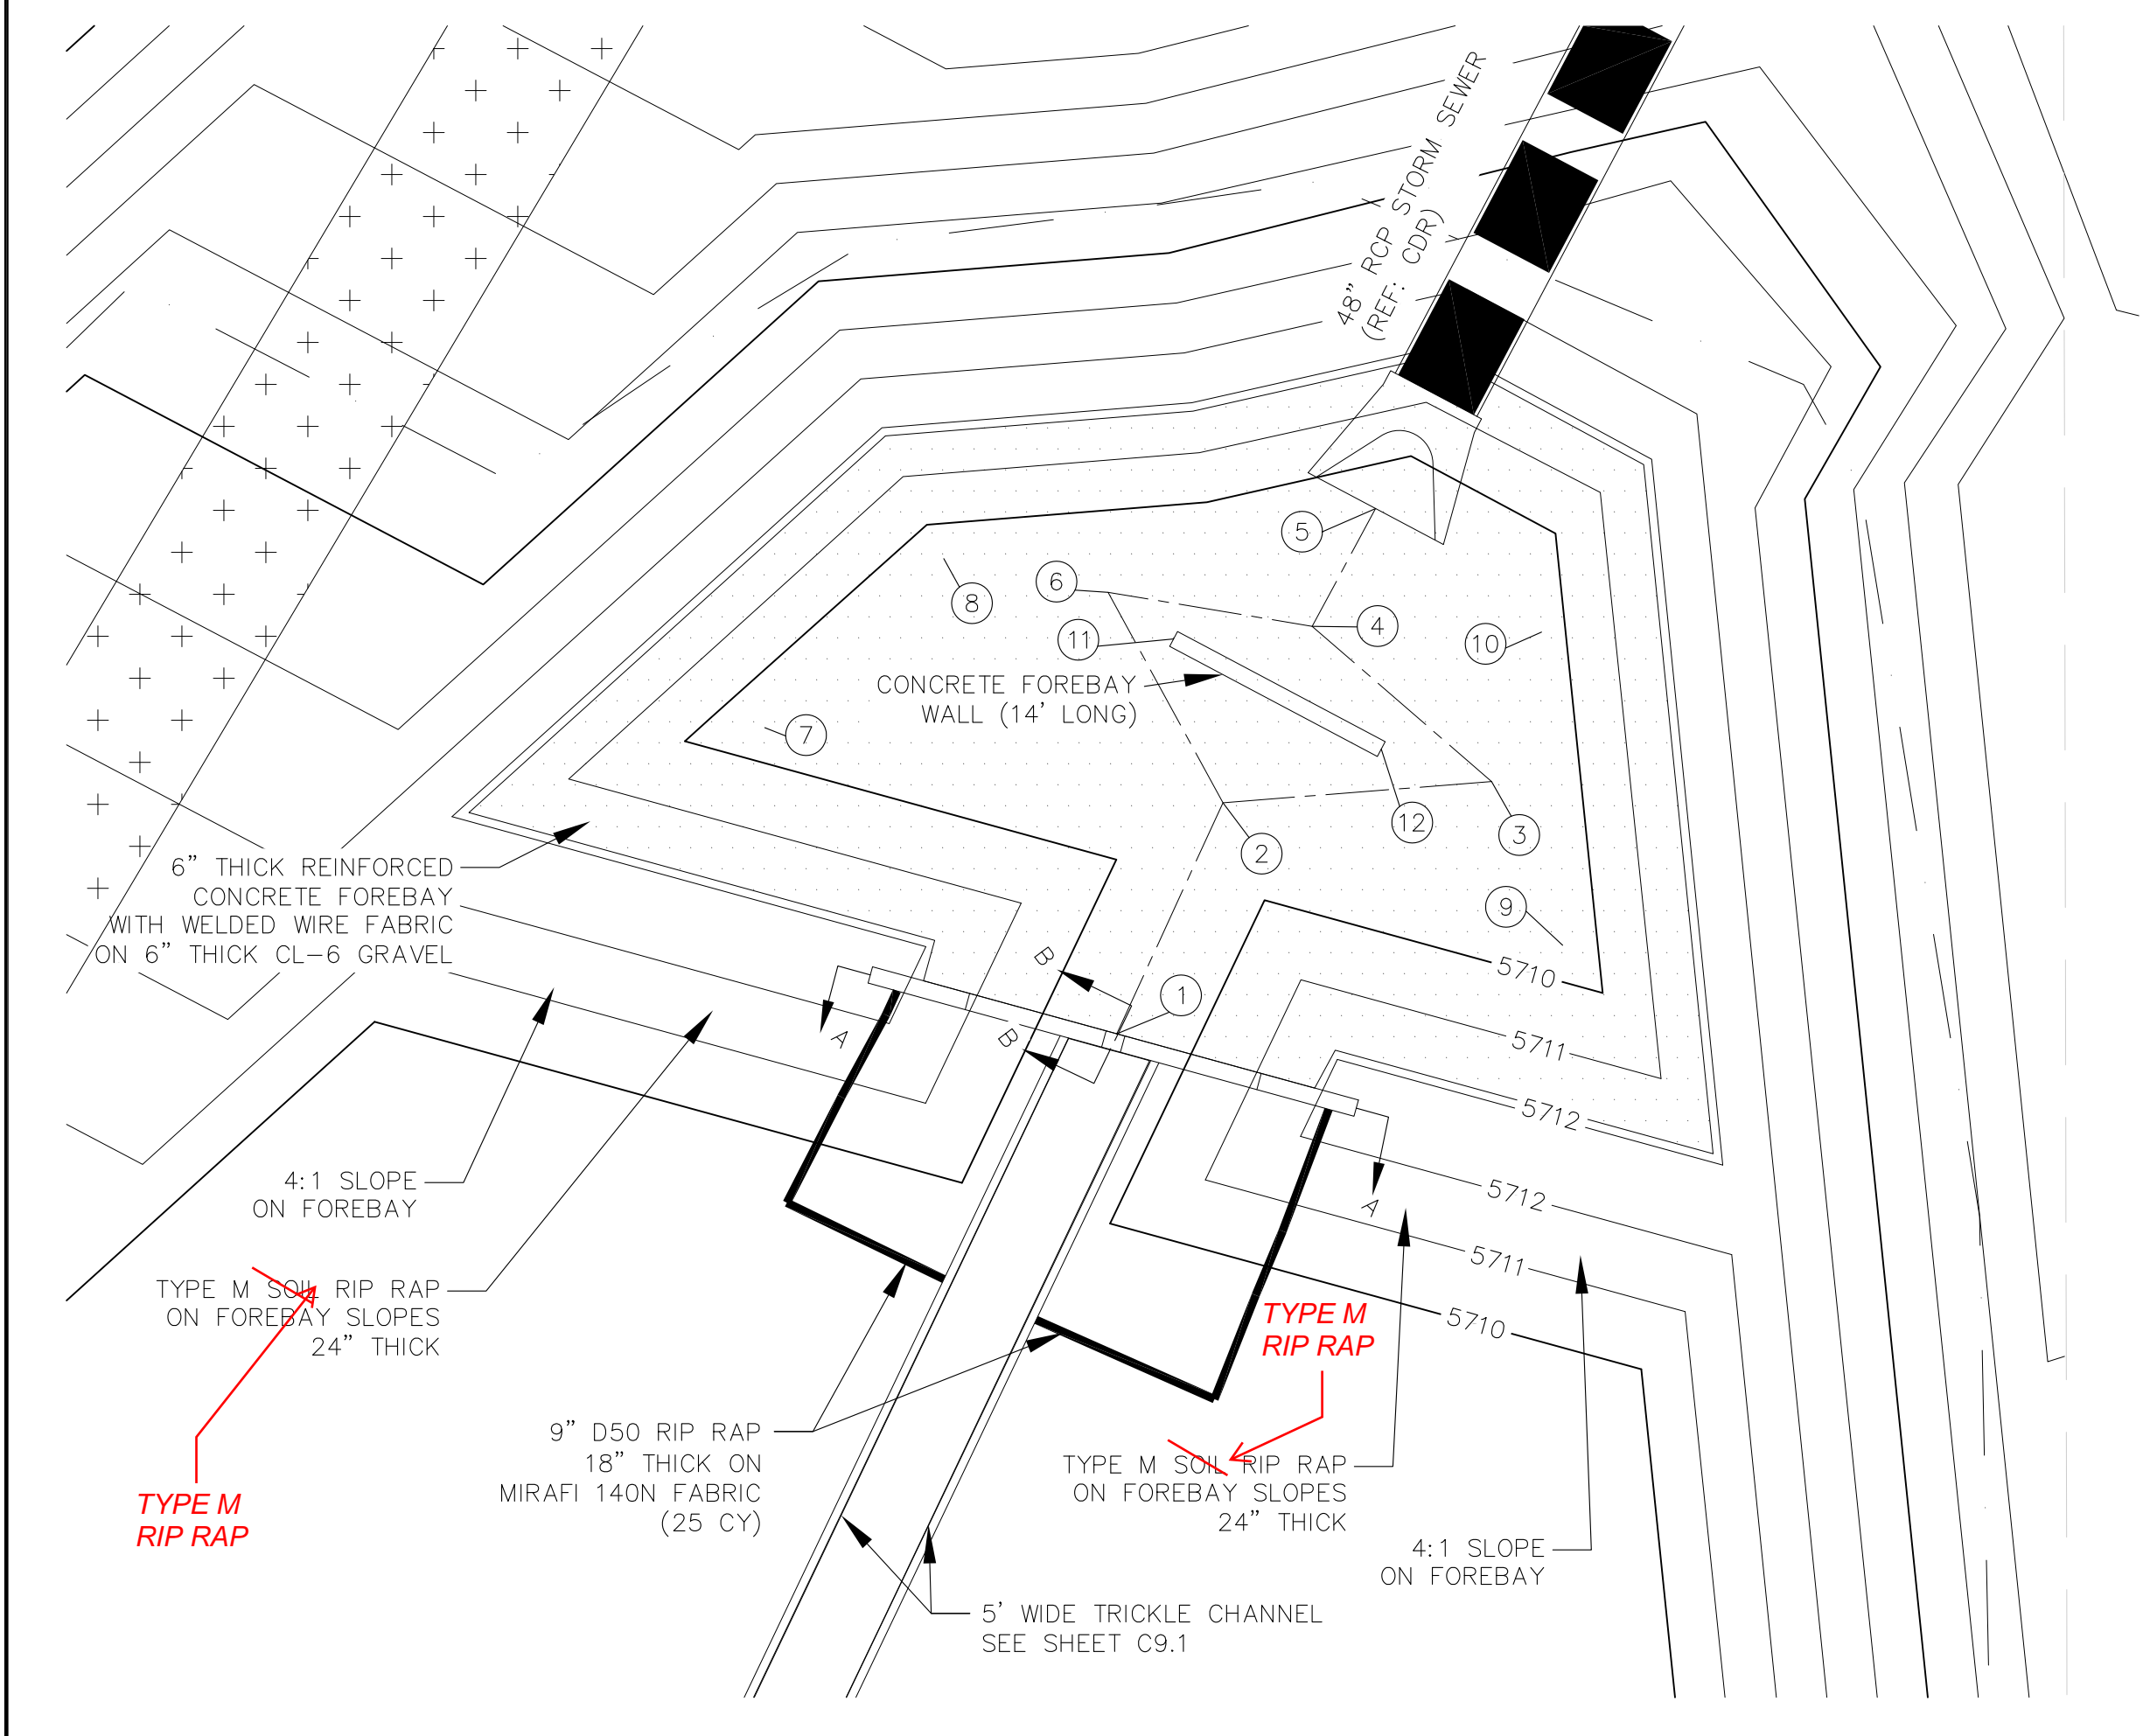

POND C5 - FOREBAY 'A' LAYOUT  
SCALE 1"=10'

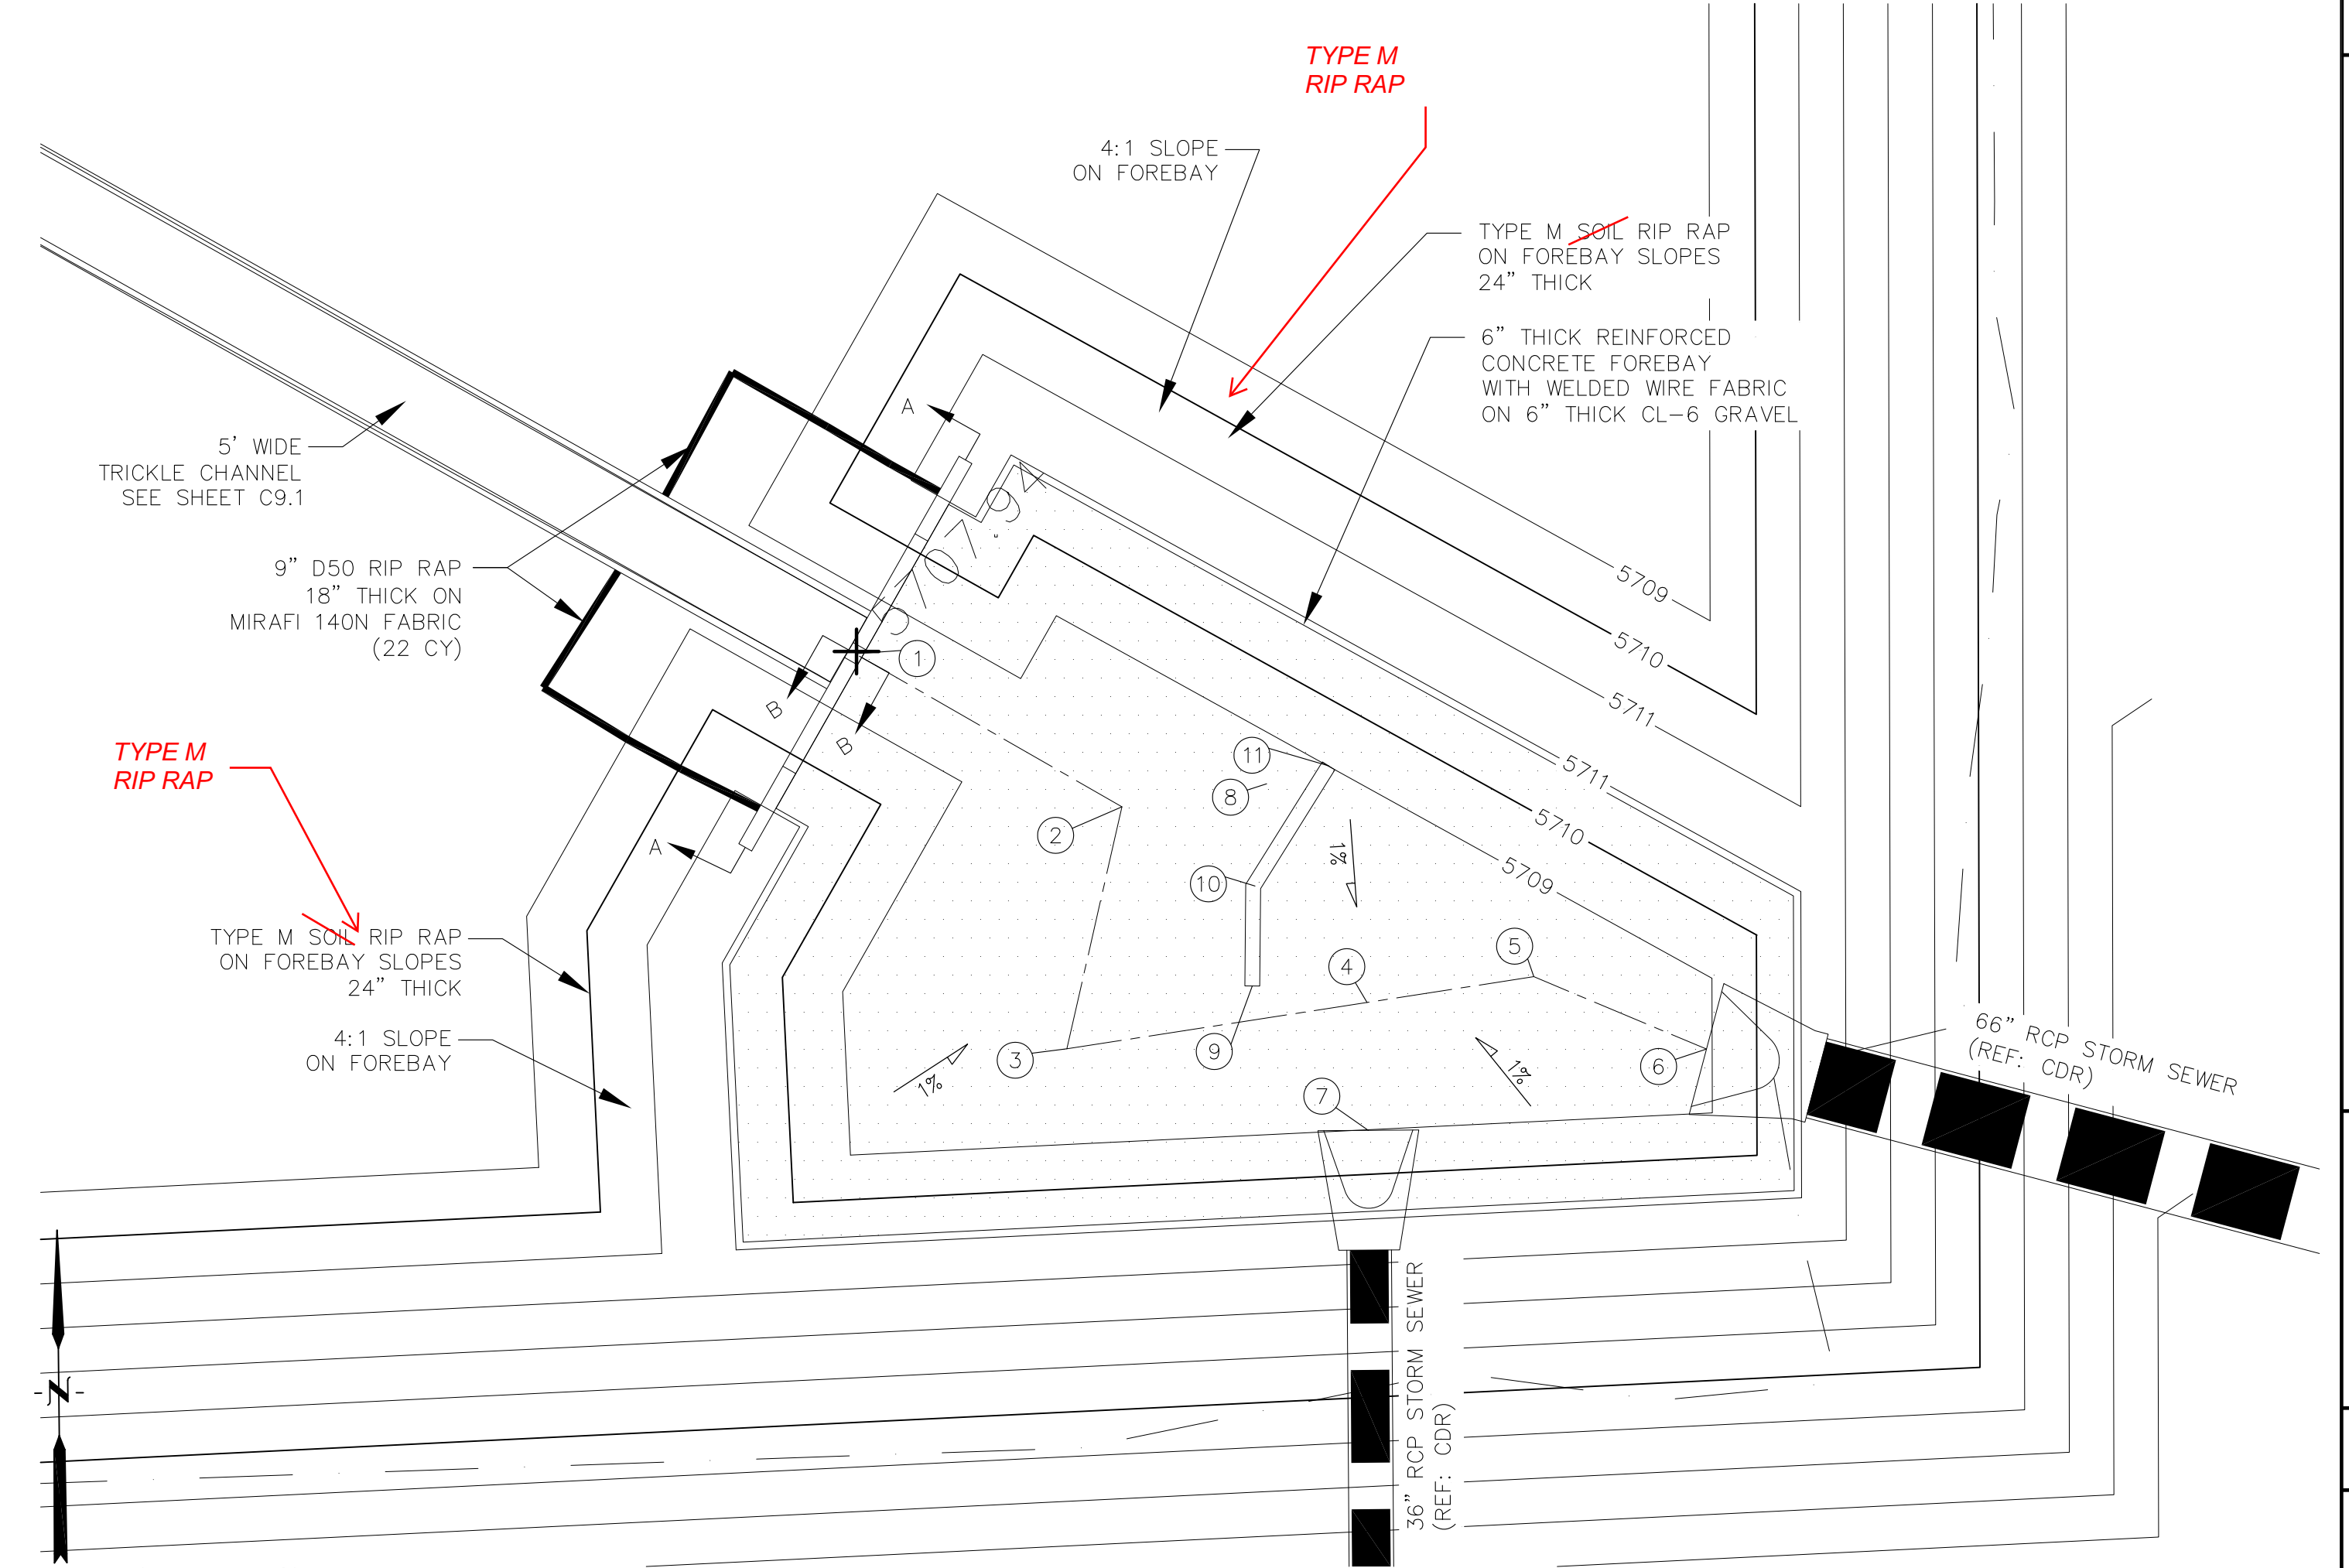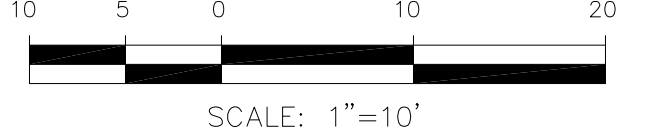

POND C5 - FOREBAY 'B' LAYOUT  
SCALE: 1"=10'


AS-BUILT  
DATE: 07/19/2022

**CORE ENGINEERING GROUP**  
15004 1ST AVENUE S.  
PH: 719.570.5506  
CONTACT: RICHARD L. SCHINDLER, P.E.  
EMAIL: Rich@cegi.com



DATE: \_\_\_\_\_  
DESCRIPTION: \_\_\_\_\_  
NO: \_\_\_\_\_  
PROJECT: **LORSON RANCH EAST**  
FILING NO. 1  
PREPARED FOR: **LORSON, LLC**  
212 N. WAHSATCH AVE, SUITE 301  
COLORADO SPRINGS, COLORADO 80903  
CONTACT: RICHARD L. SCHINDLER, P.E.  
FONTAINE BLDG.-OLD GLORY DR  
COLORADO SPRINGS, COLORADO  
(719) 635-3200  
CONTACT: JEFF MARK

DRAWN: RLS  
DESIGNED: RLS  
CHECKED: RLS


**POND C5  
FOREBAY 'A' AND 'B'  
LAYOUT AND DETAILS**

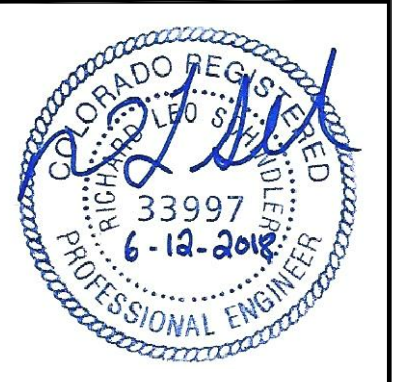


DATE: JUNE 12, 2018  
PROJECT NO. 100.042  
SHEET NUMBER **C9.2**  
TOTAL SHEETS: 45

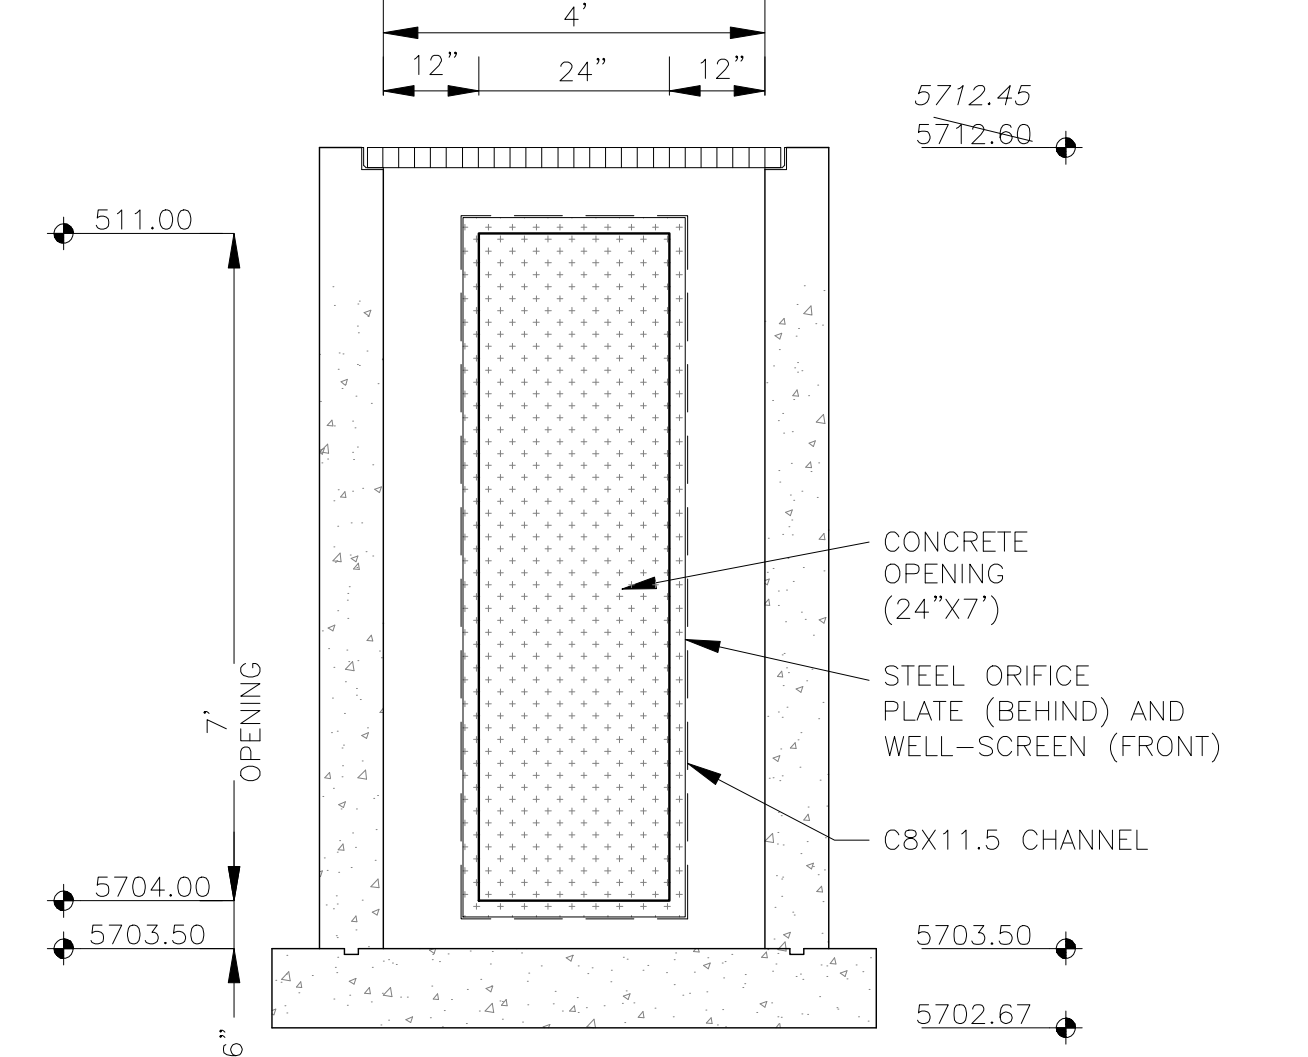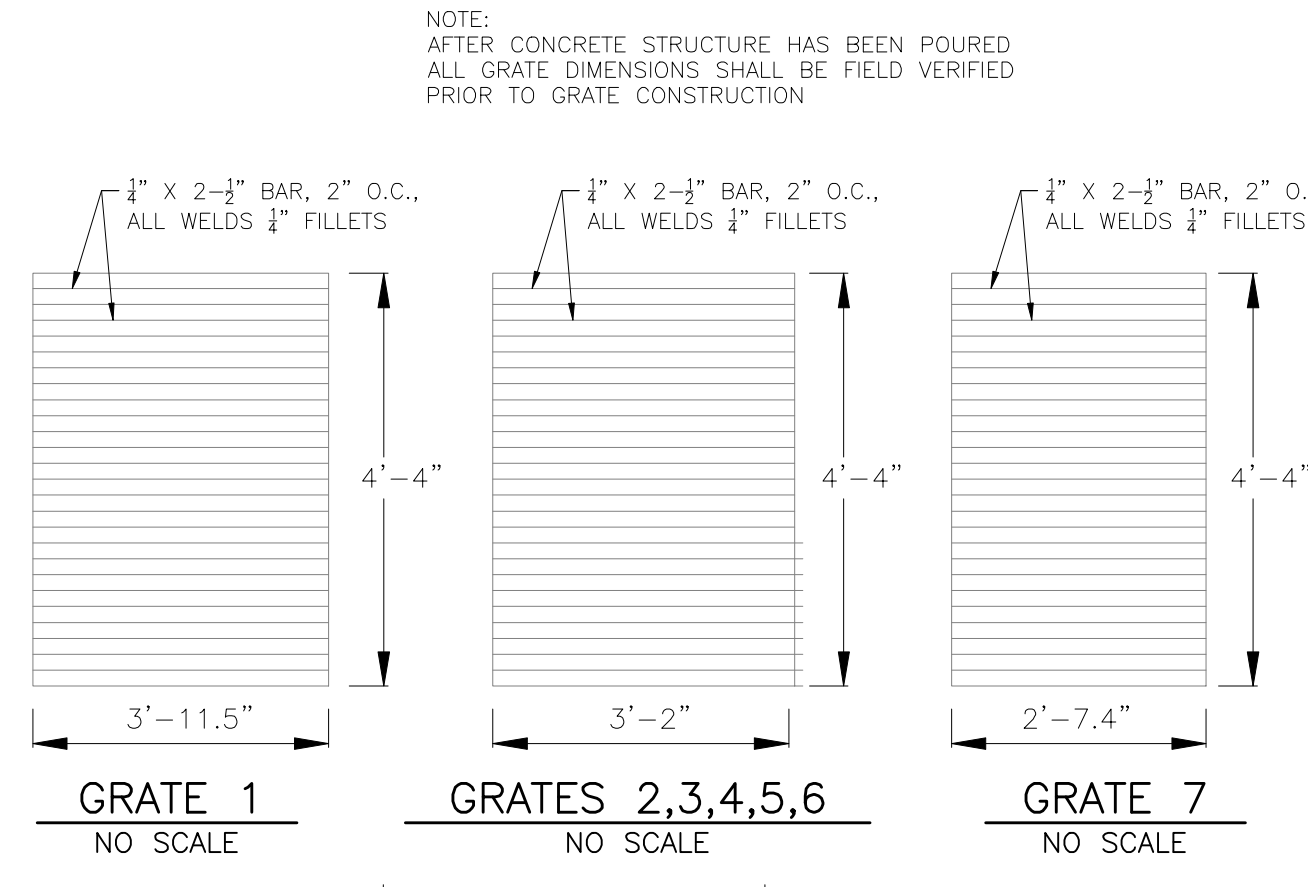

OUTLET STRUCTURE DETAIL - SECTION B-B  
NO SCALE

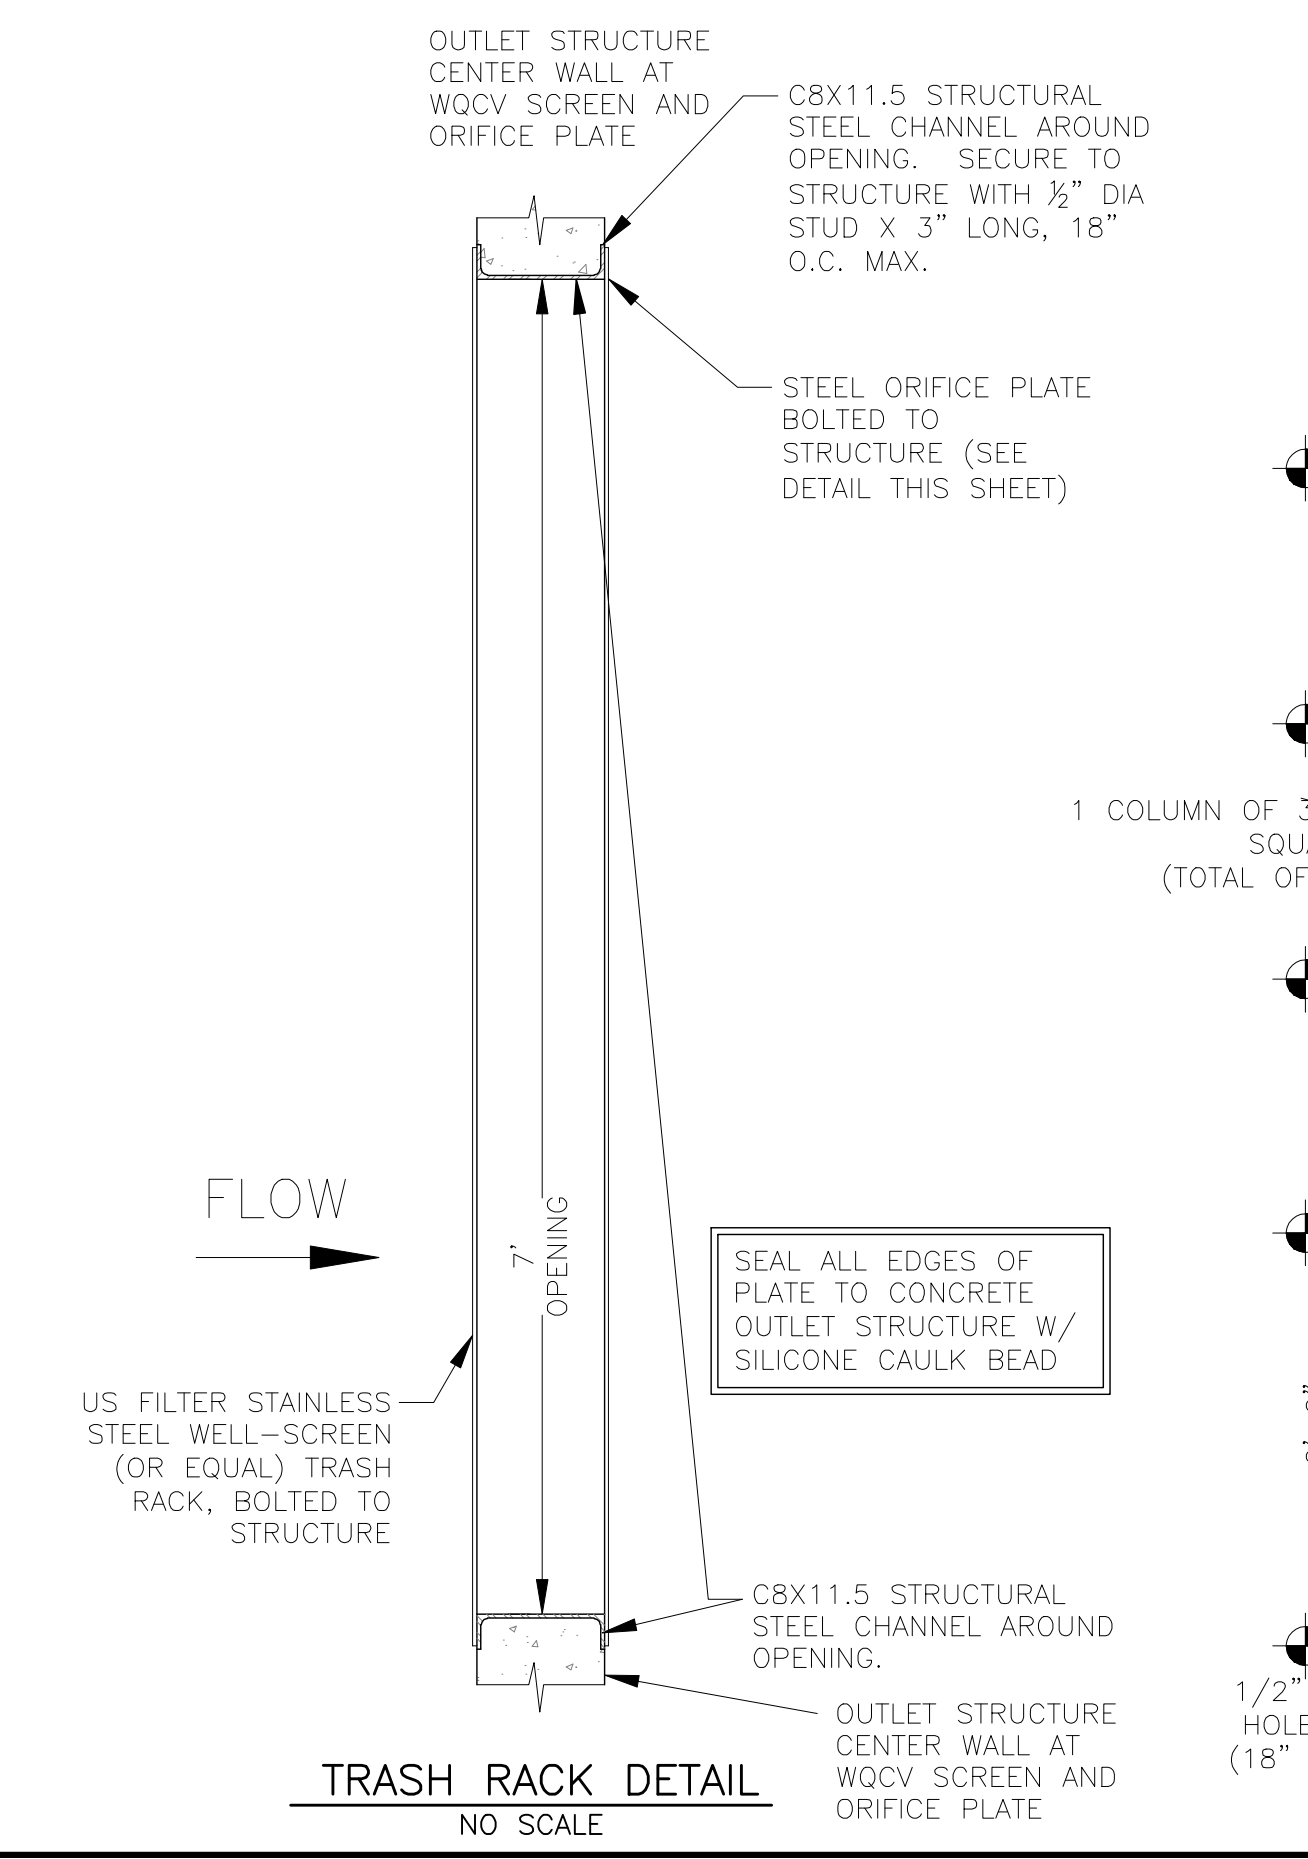


TRASH RACK DETAIL NO SCALE  
ORIFICE PLATE DETAIL NO SCALE

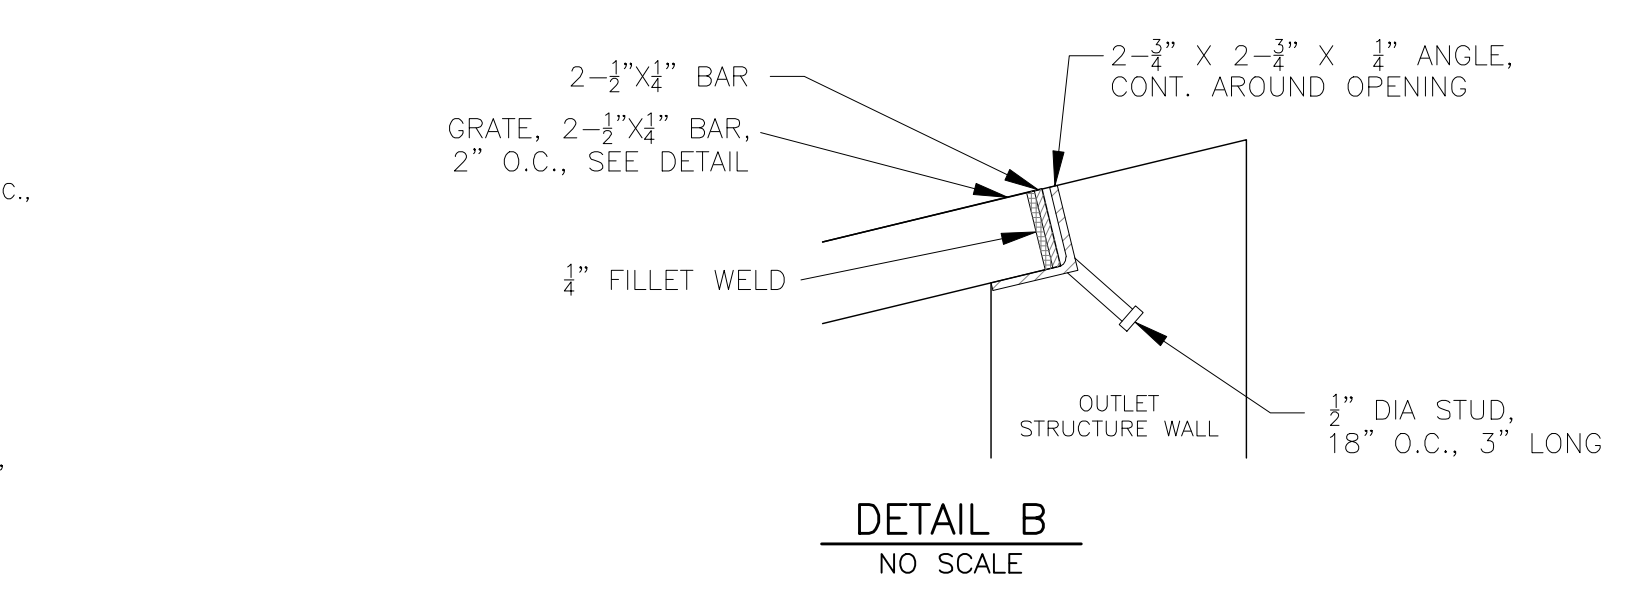


DETAIL B  
NO SCALE

- WQCV WELL-SCREEN NOTES:
- Well-Screen shall be stainless steel and attached by stainless steel bolts along edge of the mounting frame.
  - WQCV Well Screen
    - Type of Screen: Stainless steel #93 Vee Wire (Johnson Vee Wire (tm) Stainless Steel Screen or equivalent with 60% open area)
    - Screen slot opening dimension: 0.139" (Screen #93 Vee Wire Slot Opening)
    - Type and Size of Support Rod: TE 0.074"X0.50"
    - Spacing of Support Rod (O.C.): 1.0 Inch
    - Total Screen Thickness: 0.655"
    - Carbon Steel Holding Frame Type: 3/4" x 1.0" angle

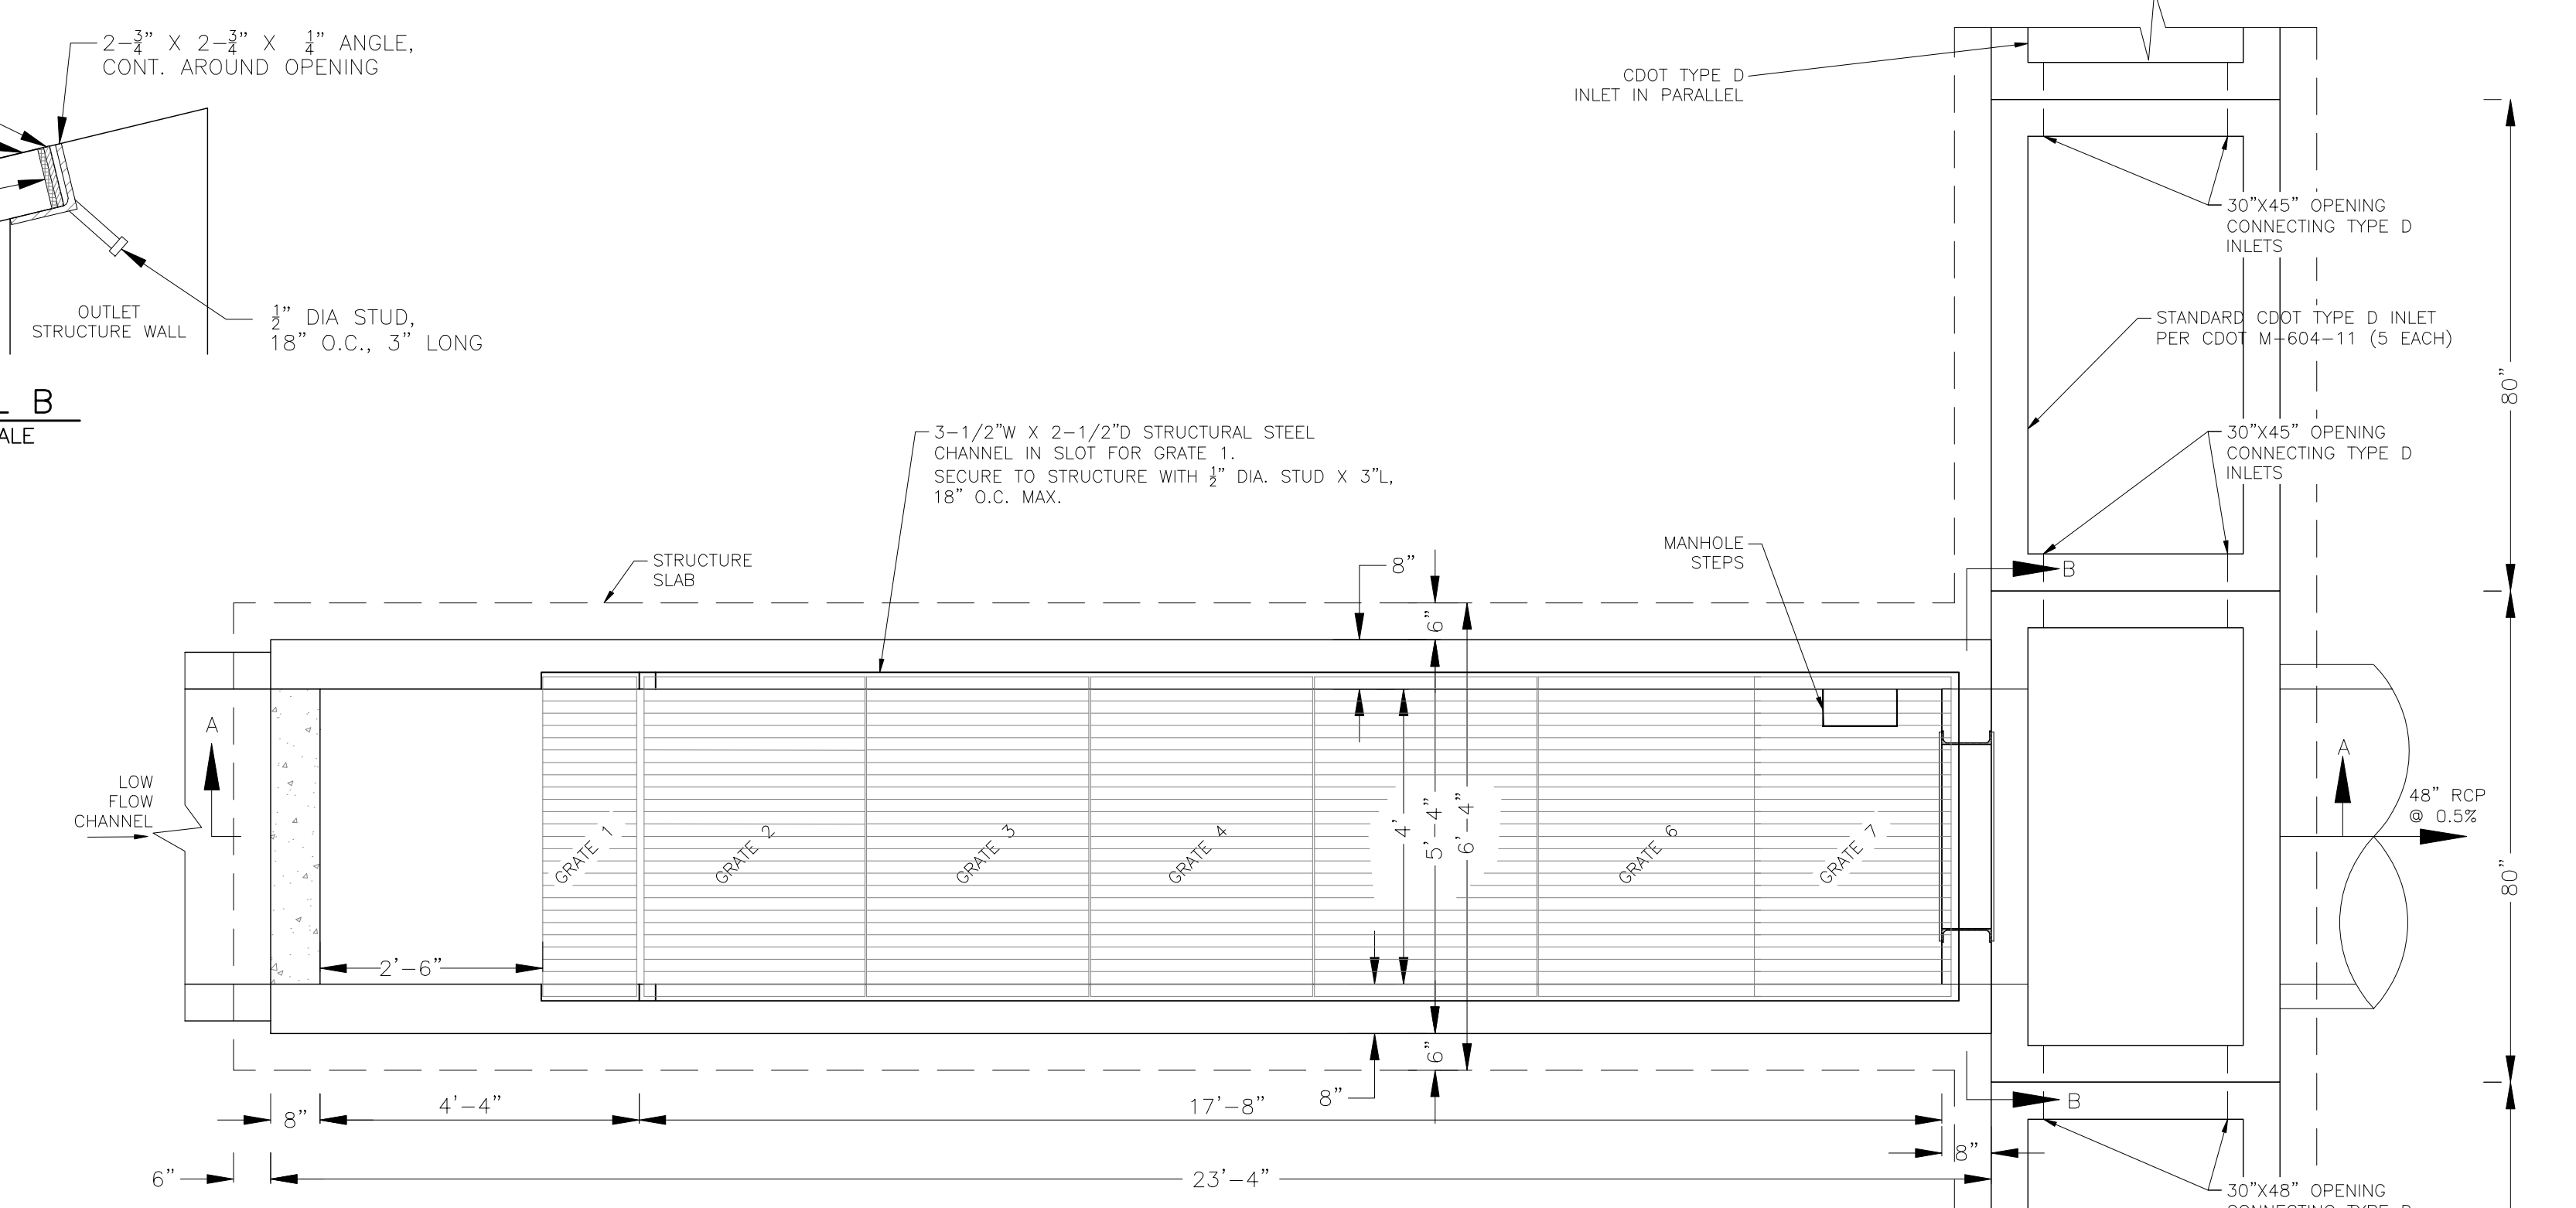

OUTLET STRUCTURE DETAIL - PLAN VIEW  
NO SCALE

- OUTLET STRUCTURE, FOREBAY, AND DRAIN CHANNEL NOTES:
- PRIOR TO CONSTRUCTION, CONTRACTOR SHALL PROVIDE SHOP DRAWINGS FOR ALL COMPONENTS OF THE OUTLET STRUCTURE.
  - GRADE 60 REINFORCING STEEL REQUIRED. SEE TABLE FOR THE MINIMUM LAP SPlice LENGTH FOR REINFORCING BARS. ALL REINFORCING STEEL SHALL HAVE A TWO-INCH MINIMUM CLEARANCE FROM EDGE OF CONCRETE, UNLESS OTHERWISE NOTED.
- | BAR SIZE           | #4    | #5    | #6    |
|--------------------|-------|-------|-------|
| MIN. SPlice LENGTH | 1'-3" | 1'-7" | 2'-0" |
- CONCRETE FOR THE OUTLET STRUCTURE AND FOREBAY SHALL BE CDOT CLASS D CONCRETE.
  - CONCRETE FOR DRAIN CHANNELS SHALL BE CDOT CLASS B CONCRETE.
  - EXPANSION JOINT MATERIAL SHALL MEET AASHTO SPECIFICATION M-213. EXPANSION JOINT MATERIAL SHALL BE 1/2" THICK, SHALL EXTEND THE FULL DEPTH OF CONTACT SURFACE AND THE JOINT SHALL BE SEALED, REFER TO DETAILS.
  - ALL EXPOSED CONCRETE CORNERS SHALL HAVE A 3/8" CHAMFER UNLESS OTHERWISE NOTED.
  - SUBGRADE TO BE 12" THICK CLEAN FILL COMPACTED TO 95% STANDARD PROCTOR DENSITY PER ASTM M698 UNDER STRUCTURE.
  - REFER TO SHEET C9.2 FOR PRESEDIMENTATION/FOREBAY DESIGN.
  - ENGINEER SHALL BE NOTIFIED PRIOR TO BEGINNING CONSTRUCTION OF OUTLET STRUCTURE TO SCHEDULE OBSERVATION VISITS FOR STRUCTURES.

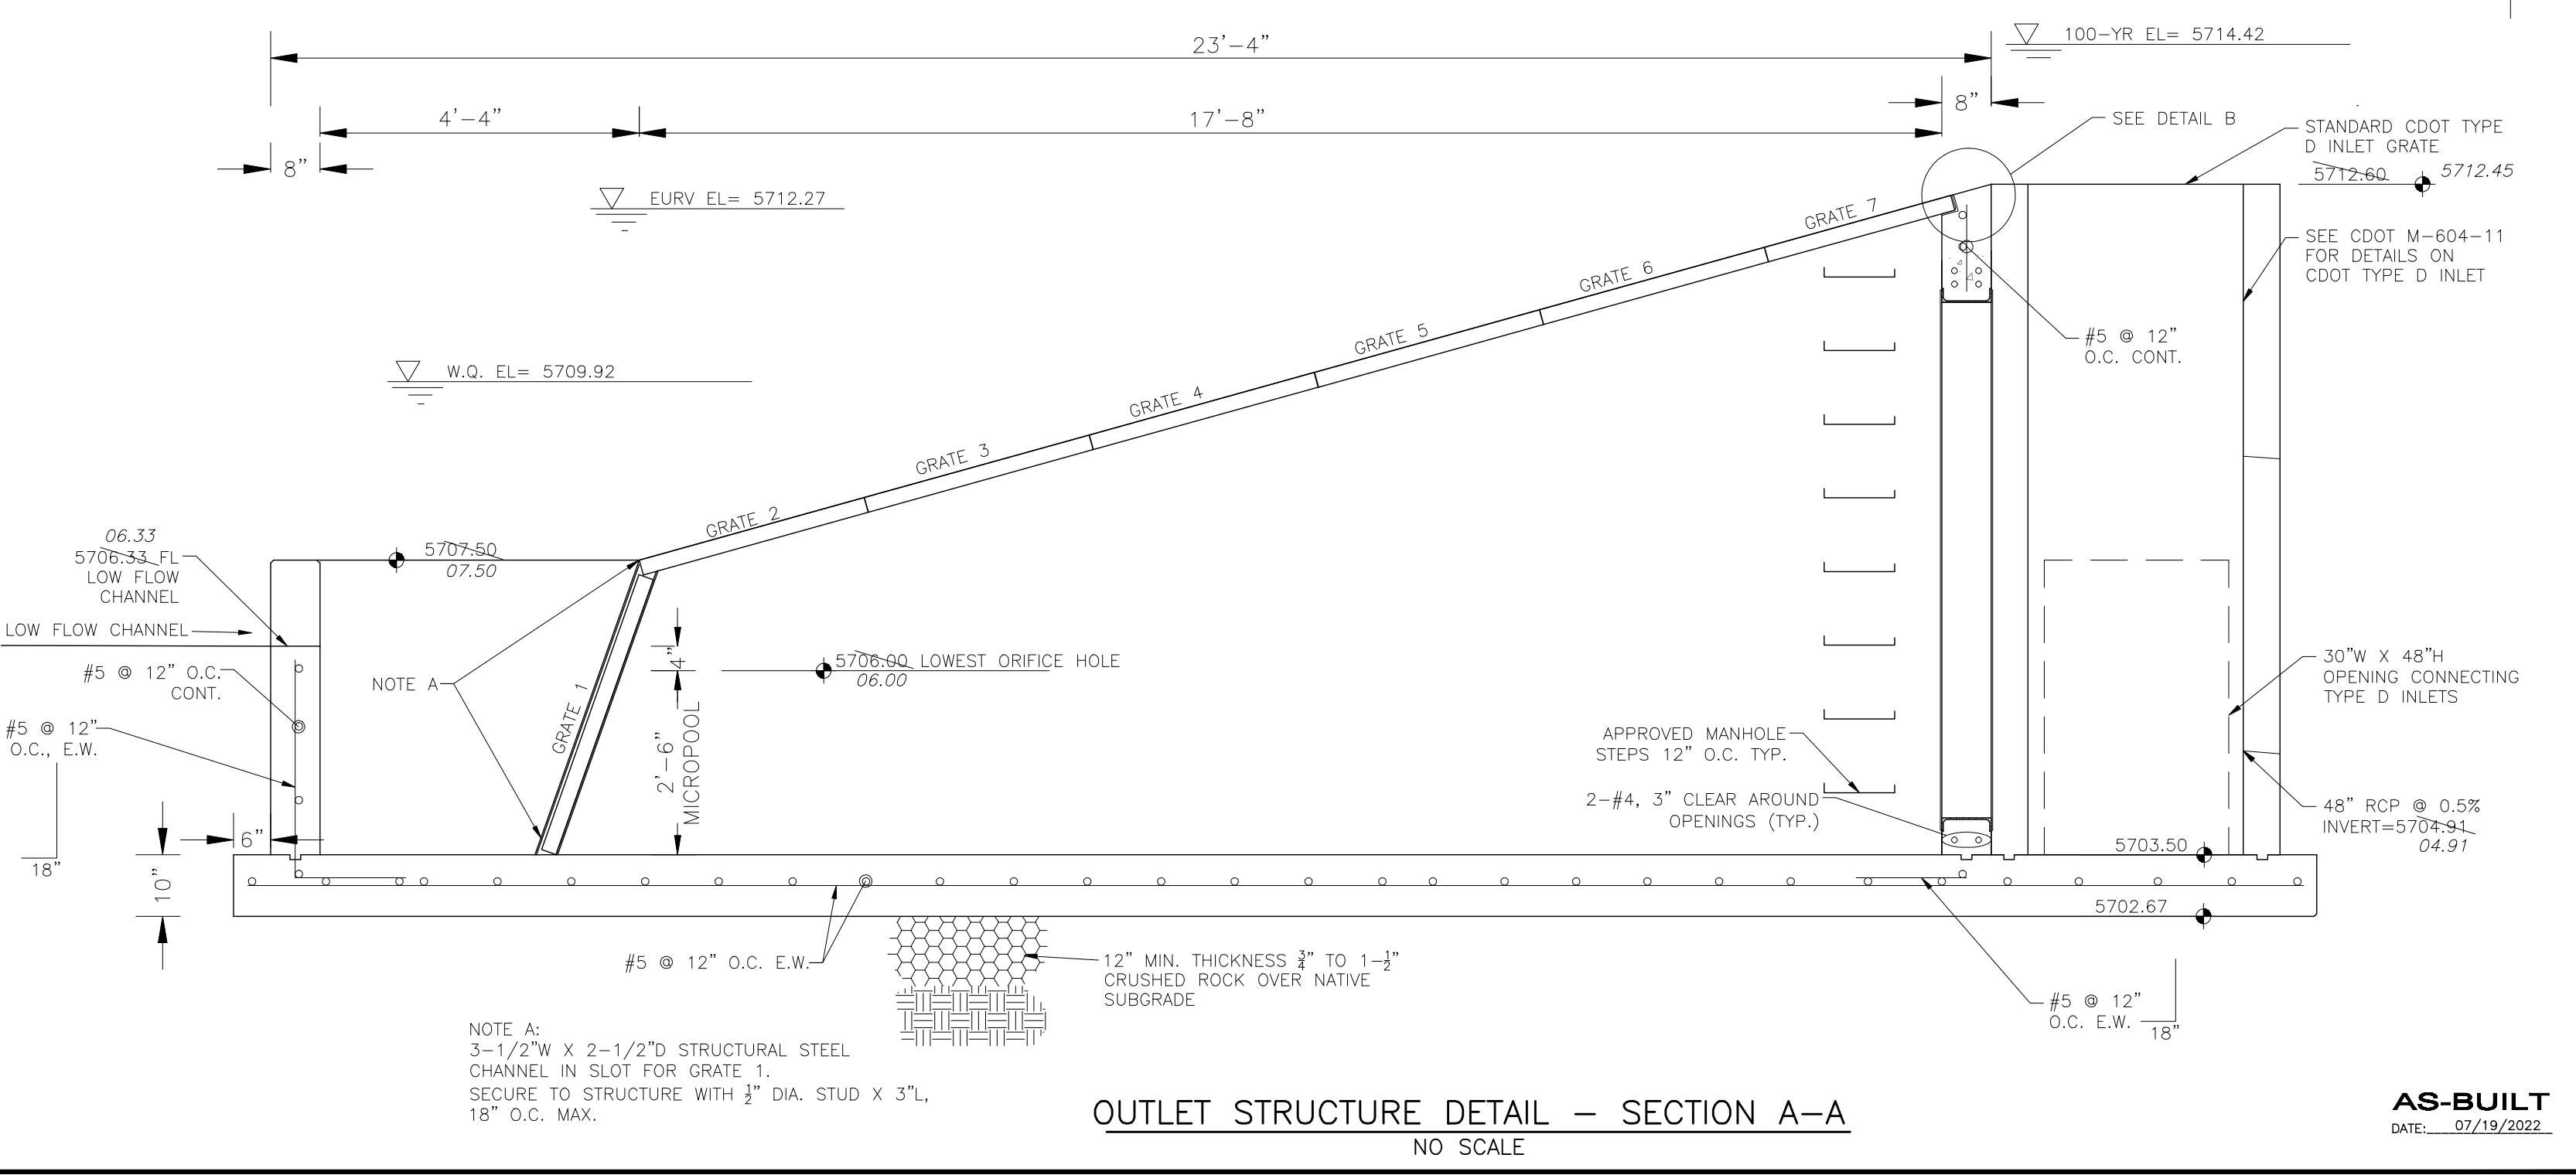

OUTLET STRUCTURE DETAIL - SECTION A-A  
NO SCALE

**CORE ENGINEERING GROUP**  
15004 1ST AVENUE S.  
BURNSVILLE, MN 55306  
19157 O.T. ROAD  
CANTON, MN 55008  
TEL: 763-892-1100  
FAX: 763-892-1101  
EMAIL: Rich@ceg1.com


DATE: \_\_\_\_\_  
DESCRIPTION: \_\_\_\_\_  
NO. \_\_\_\_\_

PREPARED FOR: **LORSON, LLC**  
212 N. WASHINGTON, SUITE 301  
COLORADO SPRINGS, COLORADO 80903  
CONTACT: JEFF MARK

DRAWN: **BBB**  
DESIGNED: **BBB**  
CHECKED: **BBB**

PROJECT: **LORSON RANCH EAST**  
**FILING NO. 1**  
FONTAINE BLVD.-OLD GLORY DR  
COLORADO SPRINGS, COLORADO

**LORSON RANCH EAST FILING NO. 1**  
**FULL SPECTRUM POND C5**  
**OUTLET STRUCTURE**

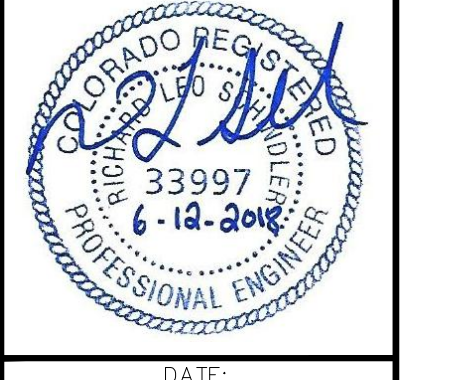


DATE: JUNE 12, 2018  
PROJECT NO. 100.042  
SHEET NUMBER **C9.3**  
TOTAL SHEETS: 45

AS-BUILT  
DATE: 07/19/2022



AS-BUILT

DATE: 07/19/2022


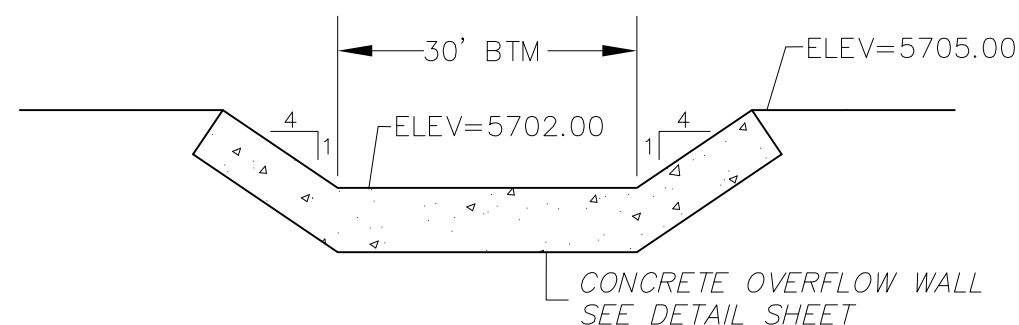


POND D2 EMERGENCY OVERFLOW PROFILE

SCALE: NTS

NOTE:

- 1. POND SLOPES SHALL BE 3:1 UNLESS OTHERWISE NOTED
- 2. STRAW ECB SHALL BE PLACED ON ALL POND SIDE SLOPES UNLESS NOTED OTHERWISE

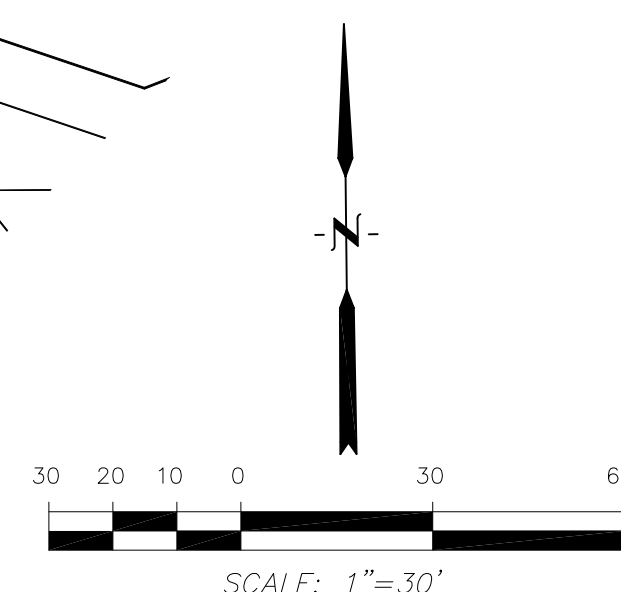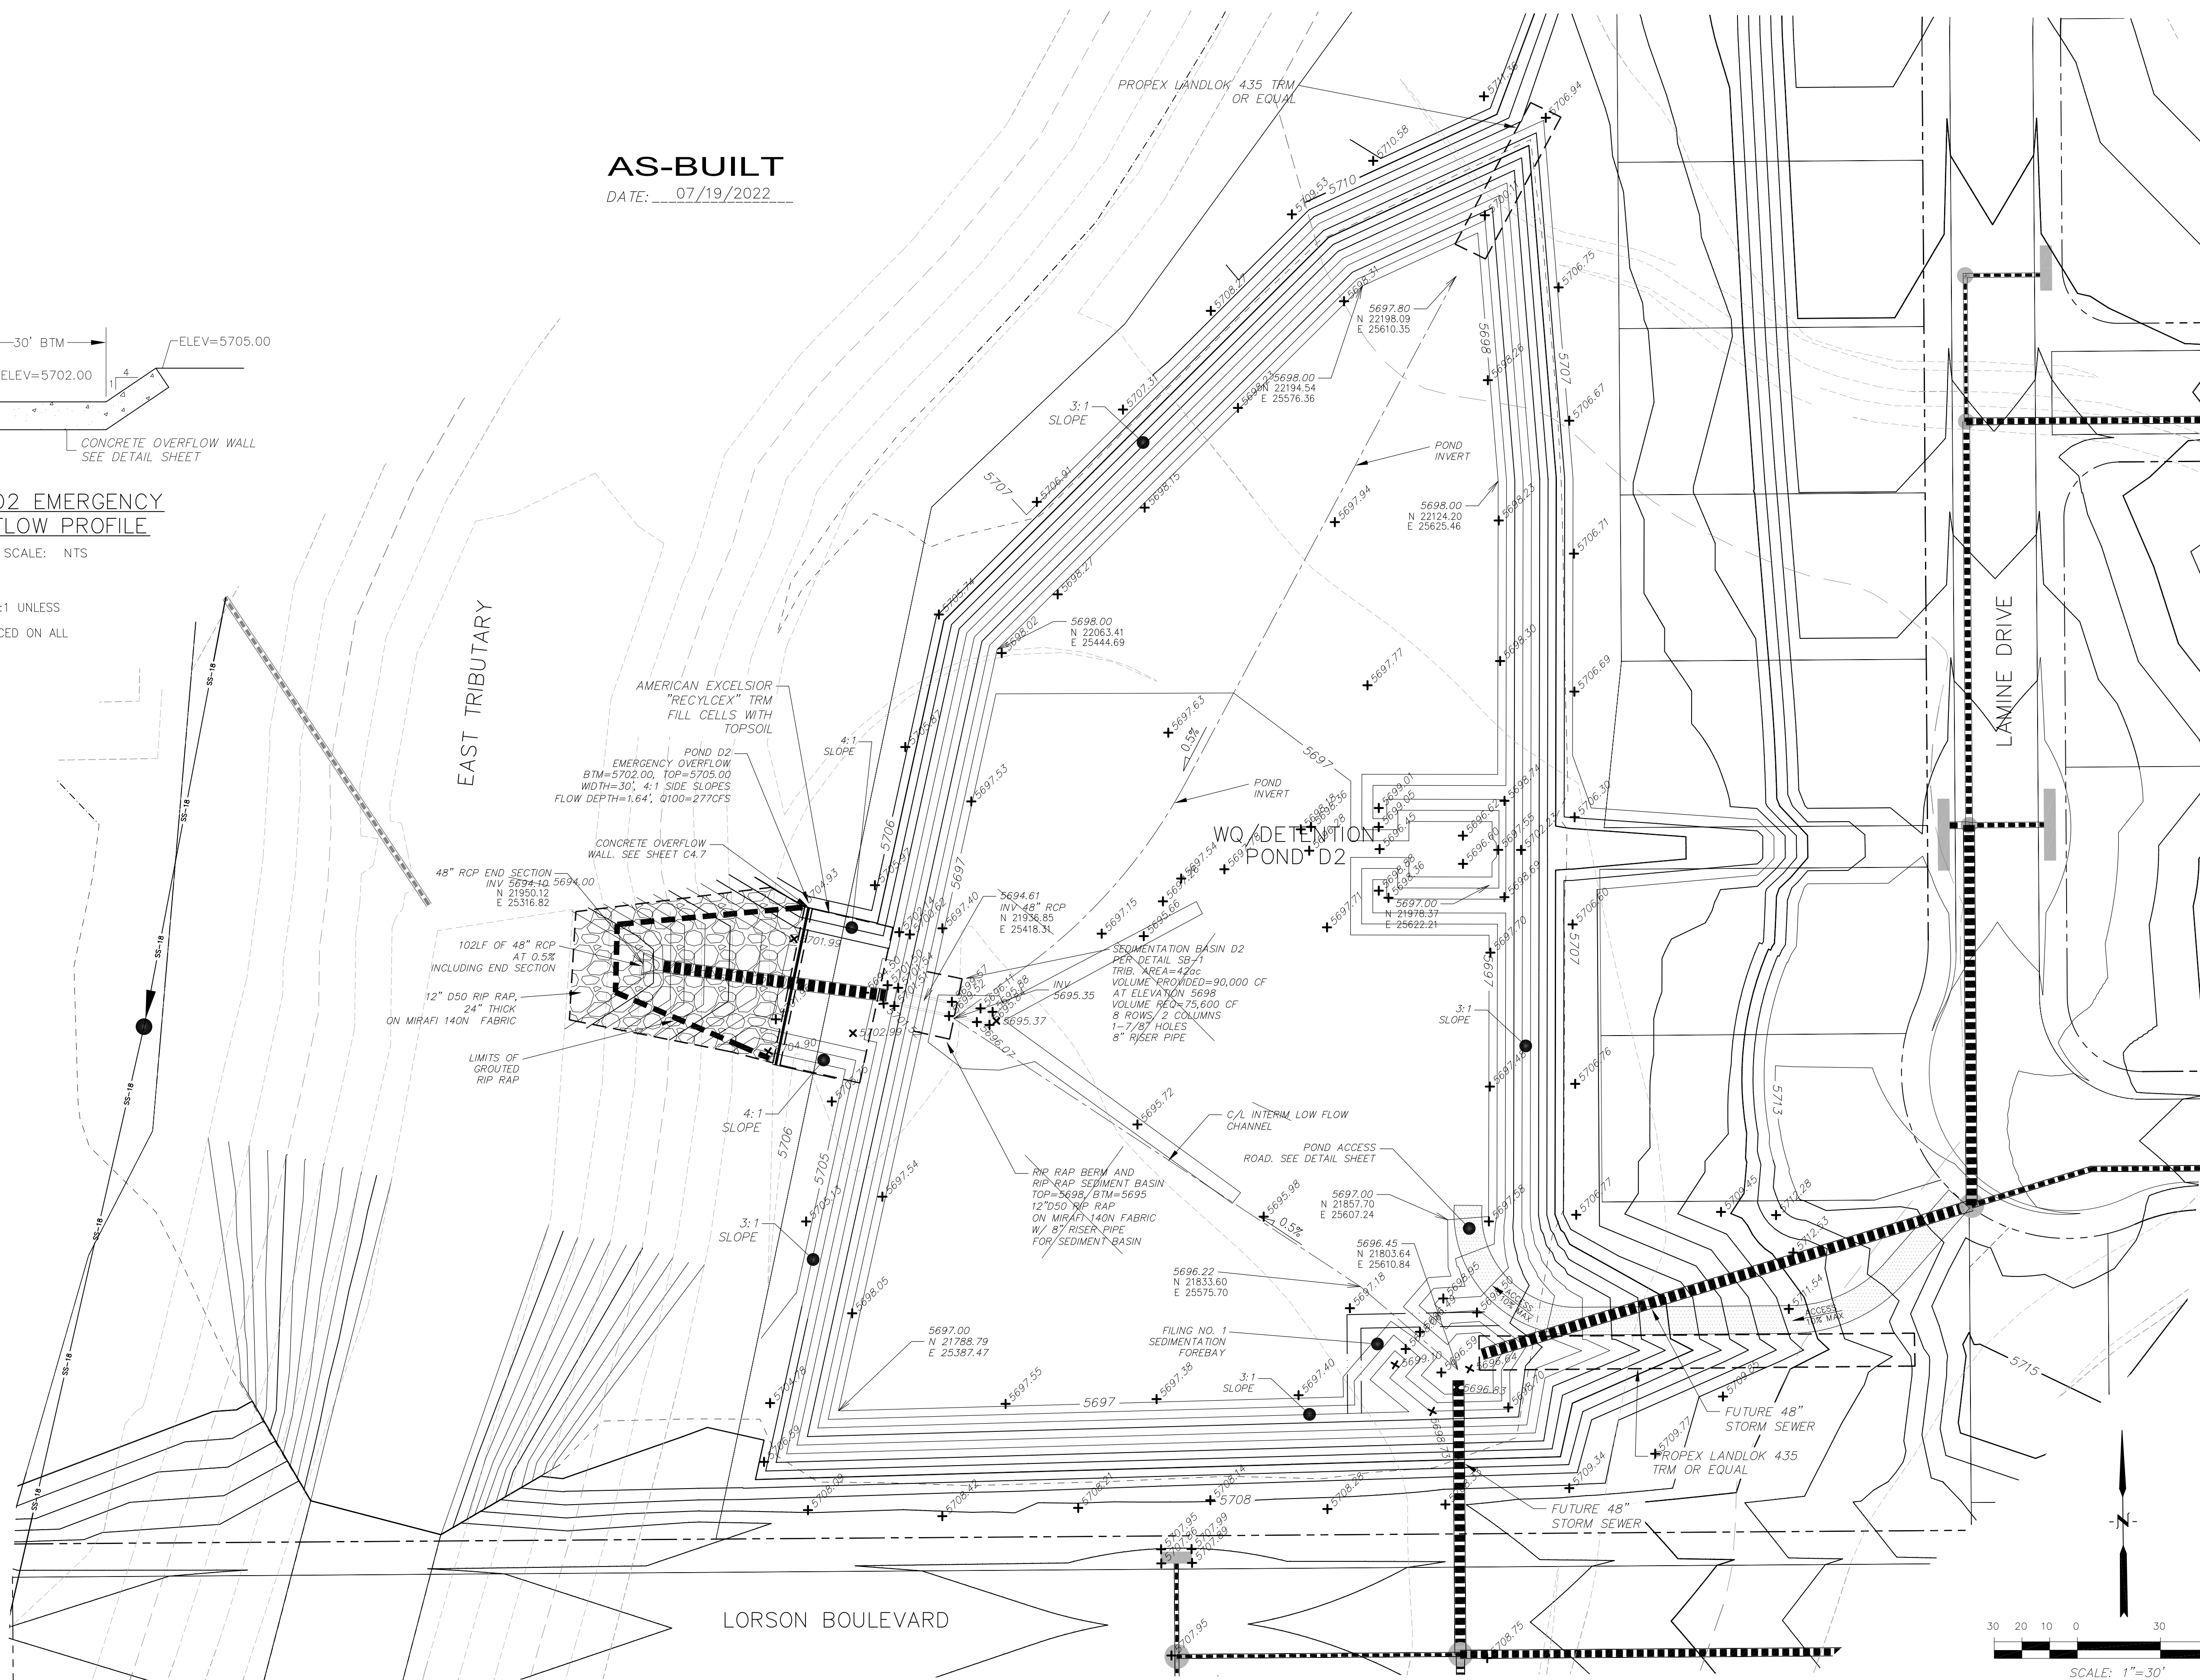

**CORE ENGINEERING GROUP**  
 15004 15<sup>TH</sup> AVE. S. #5506  
 BURNING WOODS, CO 80016  
 PHONE: 719.570.1100  
 CONTACT: RICHARD L. SCHINDLER, P.E.  
 EMAIL: Rich@ceg1.com

NO.	DESCRIPTION	DATE

PREPARED FOR: **LORSON, LLC**  
 212 N. WAHSATCH AVE., SUITE 301  
 COLORADO SPRINGS, COLORADO 80903  
 (719) 635-3200  
 CONTACT: JEFF MARK

DRAWN:	RLS
DESIGNED:	RLS
CHECKED:	RLS


**FULL SPECTRUM DETENTION POND D2**  
**LORSON RANCH EAST**

DATE: **DECEMBER 18, 2017**

PROJECT NO.: **100.040**

SHEET NUMBER: **C4.10**

TOTAL SHEETS: **28**

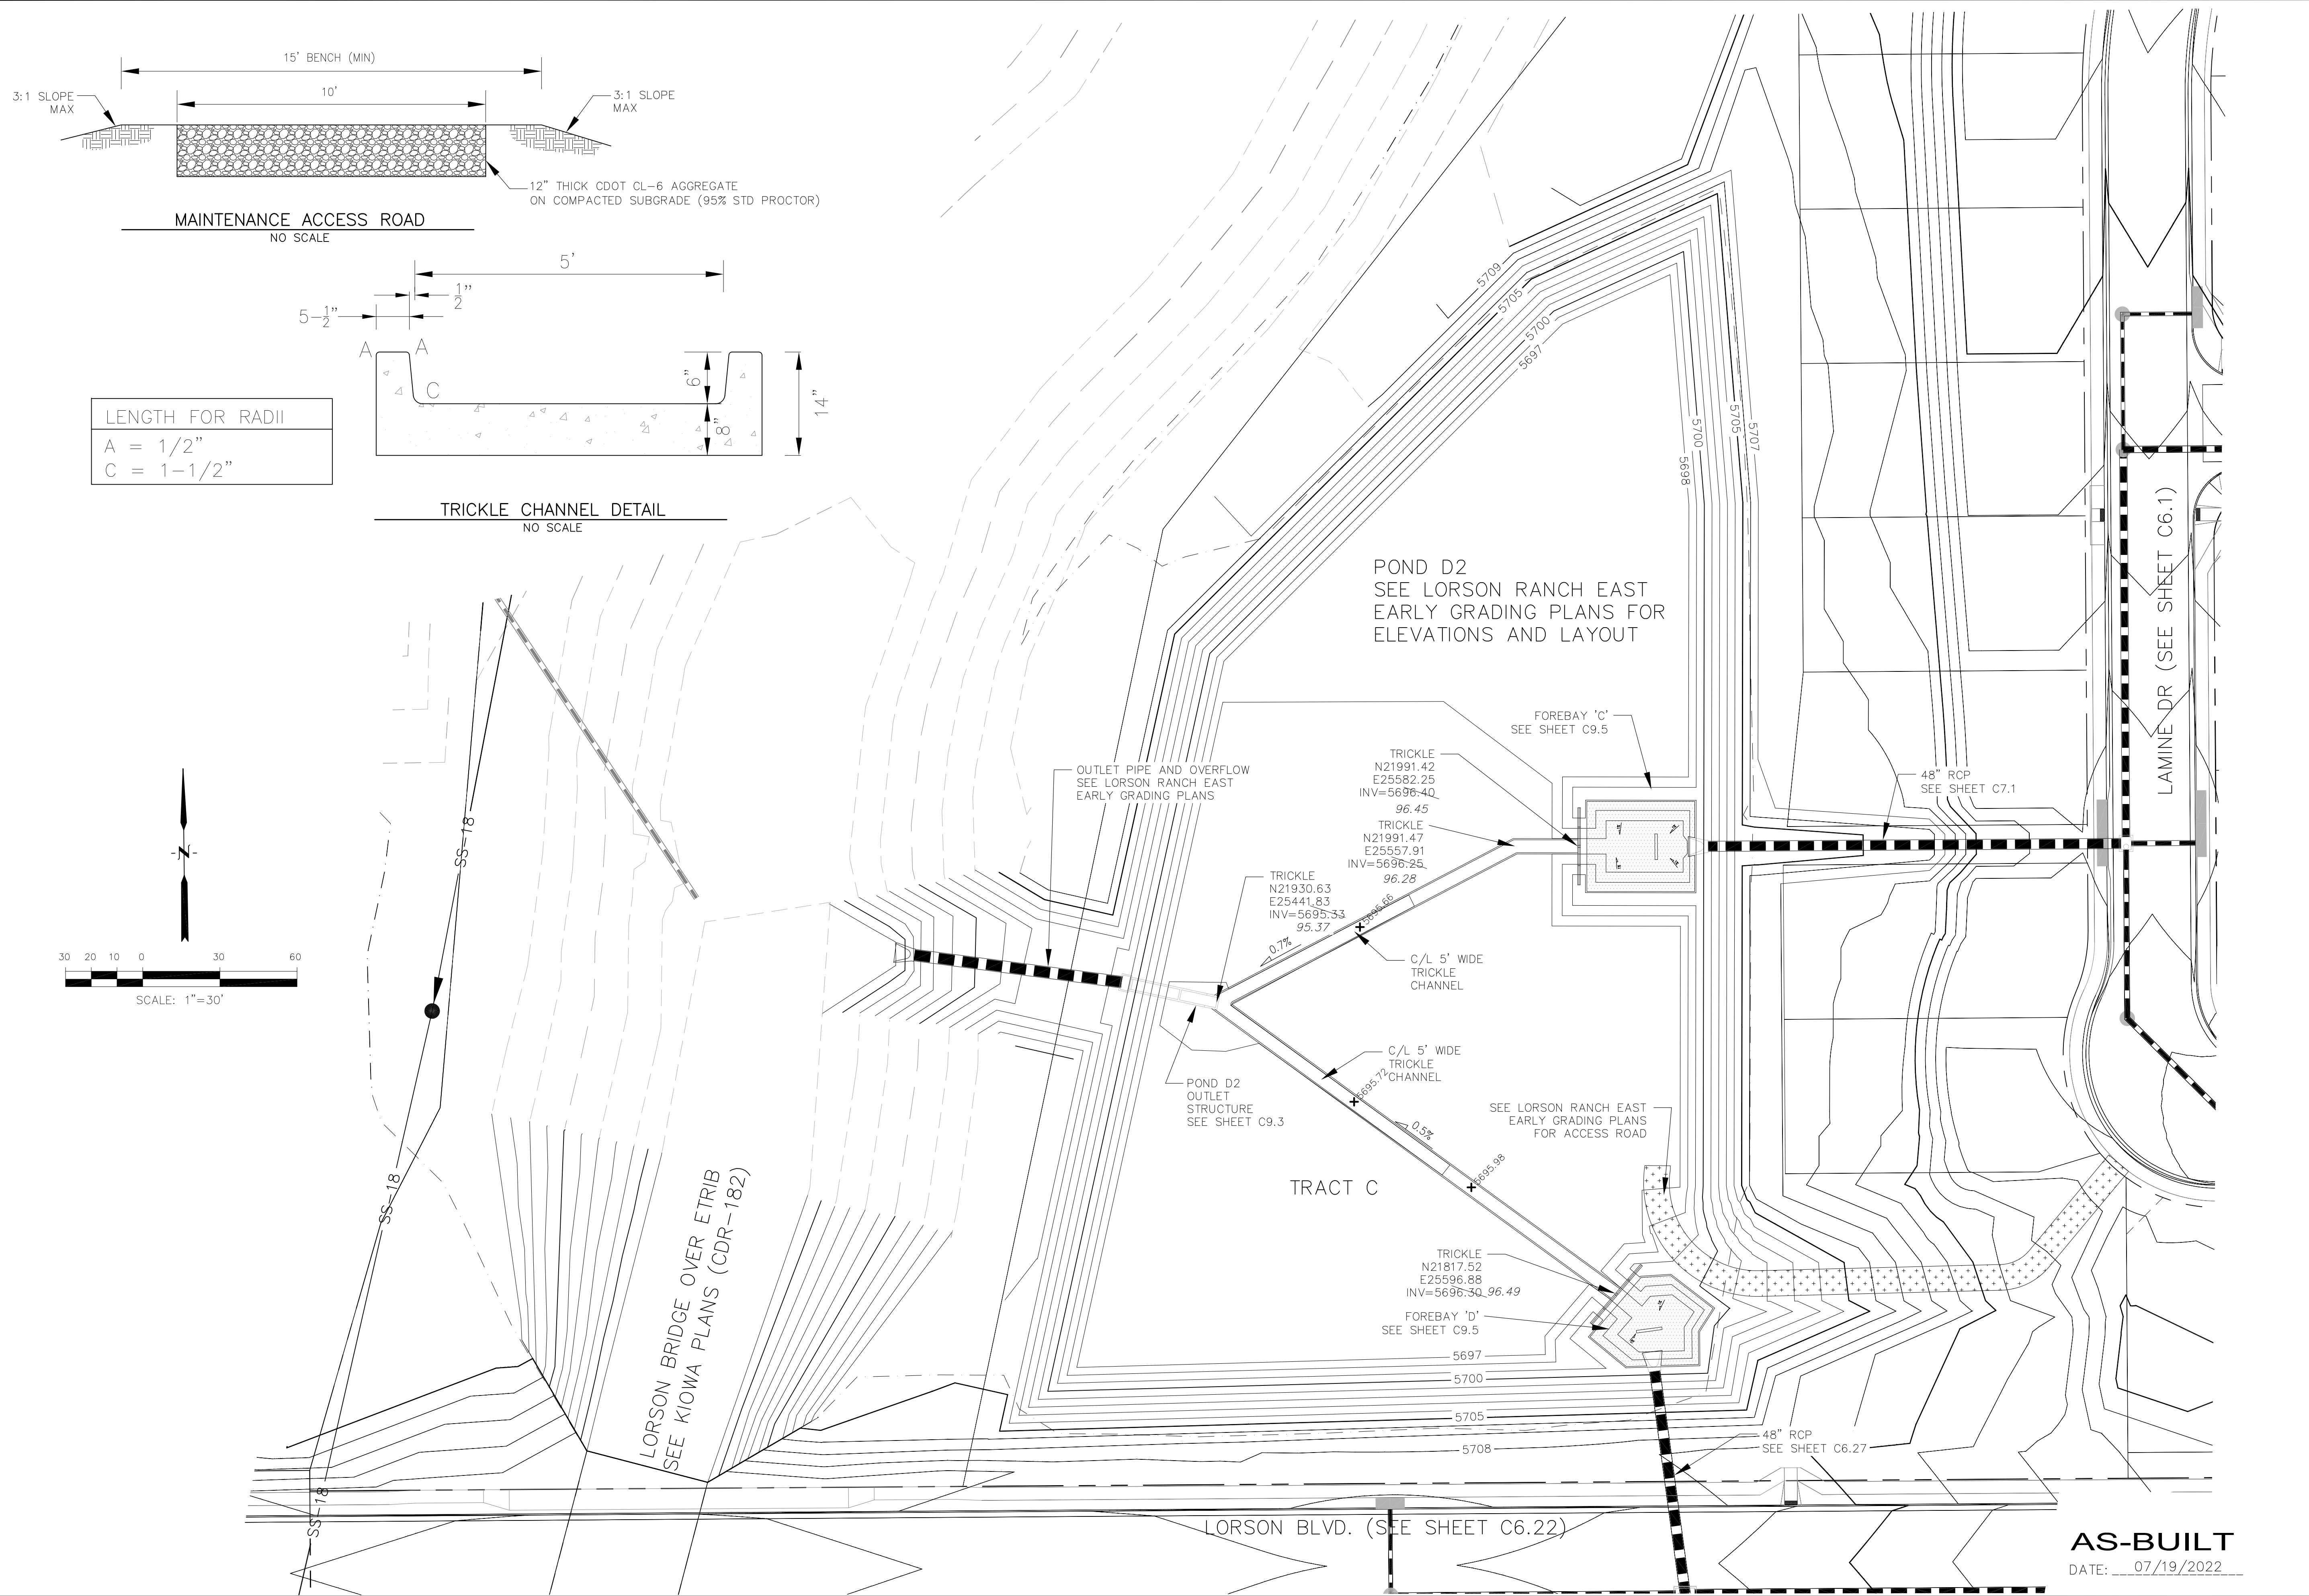

**CORE ENGINEERING GROUP**  
15004 1ST AVENUE S.  
DENVER, CO 80202  
PH: 719.570.1100  
CONTACT: RICHARD L. SCHINDLER, P.E.  
EMAIL: Rich@ceg1.com

DATE: \_\_\_\_\_  
DESCRIPTION: \_\_\_\_\_  
NO: \_\_\_\_\_

PREPARED FOR:  
**LORSON, LLC**  
212 N. WAHSATCH AVE, SUITE 301  
COLORADO SPRINGS, COLORADO 80903  
FONTAINE BLDG.-OLD GLORY DR  
COLORADO SPRINGS, COLORADO  
CONTACT: JEFF MARK


PROJECT:  
**LORSON RANCH EAST**  
FILING NO. 1


DRAWN: RLS  
DESIGNED: RLS  
CHECKED: RLS

**POND D2**  
**TRICKLE CHANNEL**  
**LAYOUT AND DETAILS**


**AS-BUILT**  
DATE: 07/19/2022

DATE: JUNE 12, 2018  
PROJECT NO. 100.042  
SHEET NUMBER C9.4  
TOTAL SHEETS: 45

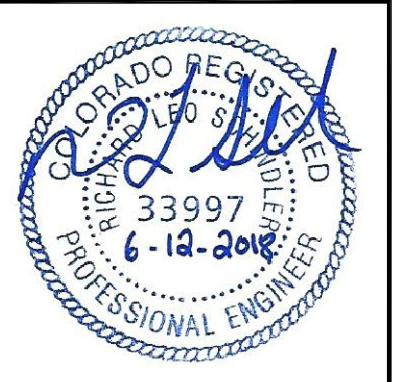

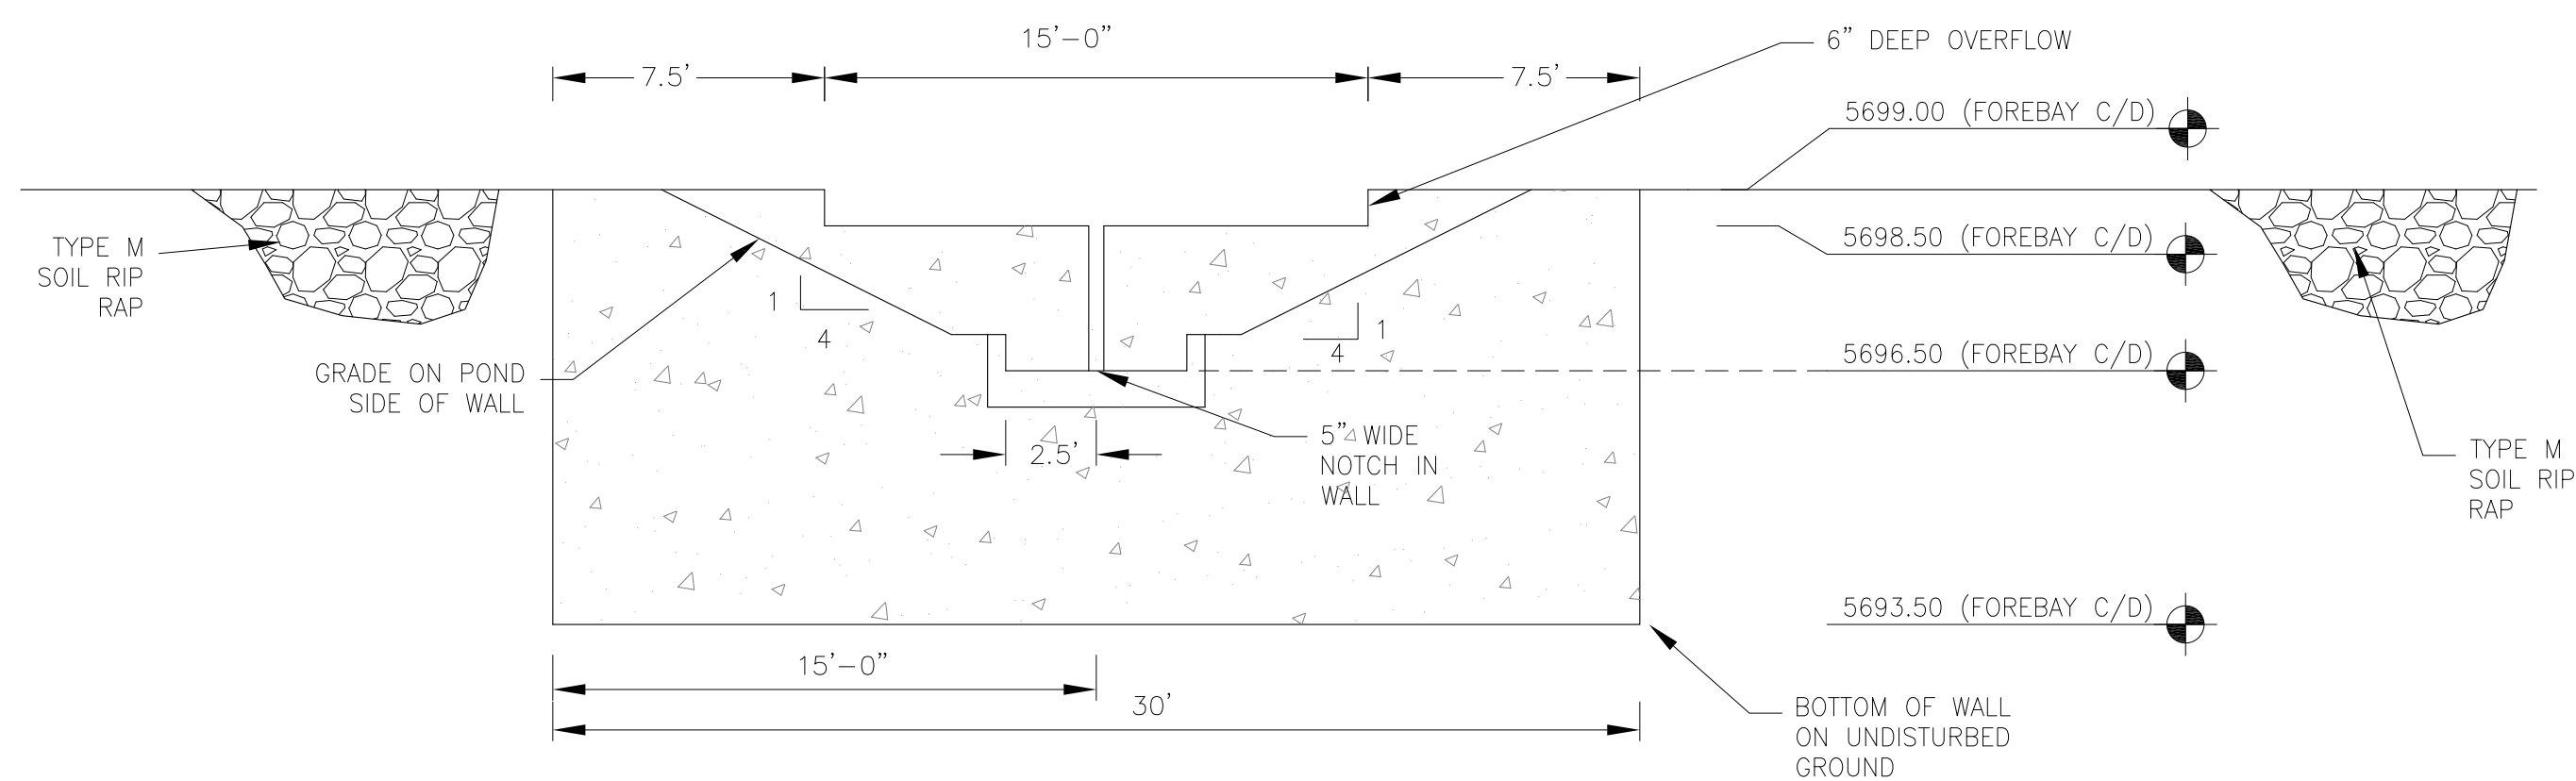


WALL SECTION A-A  
1"=10'

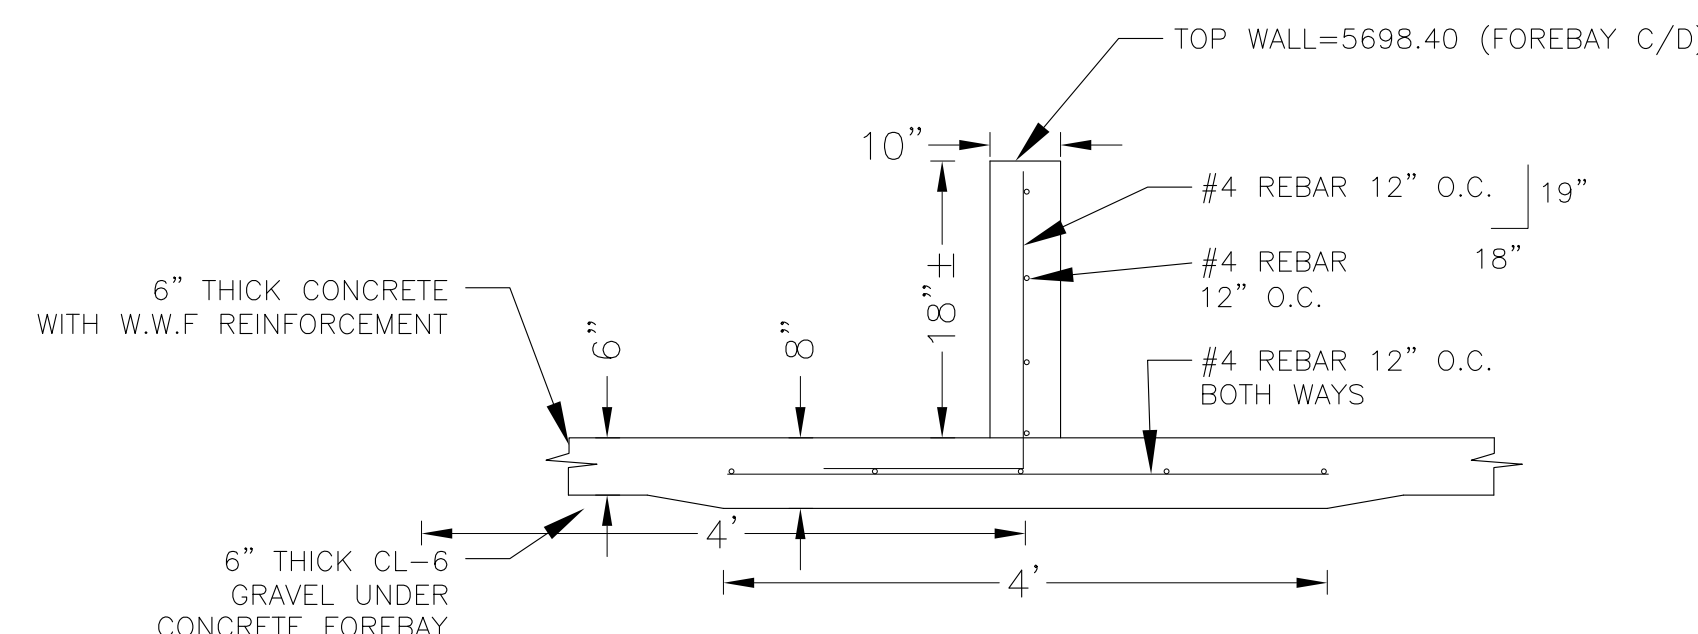

ENERGY DISSIPATER WALL  
NO SCALE

NOTE: ALL CONCRETE FOR WALL SHALL BE CDOT TYPE D

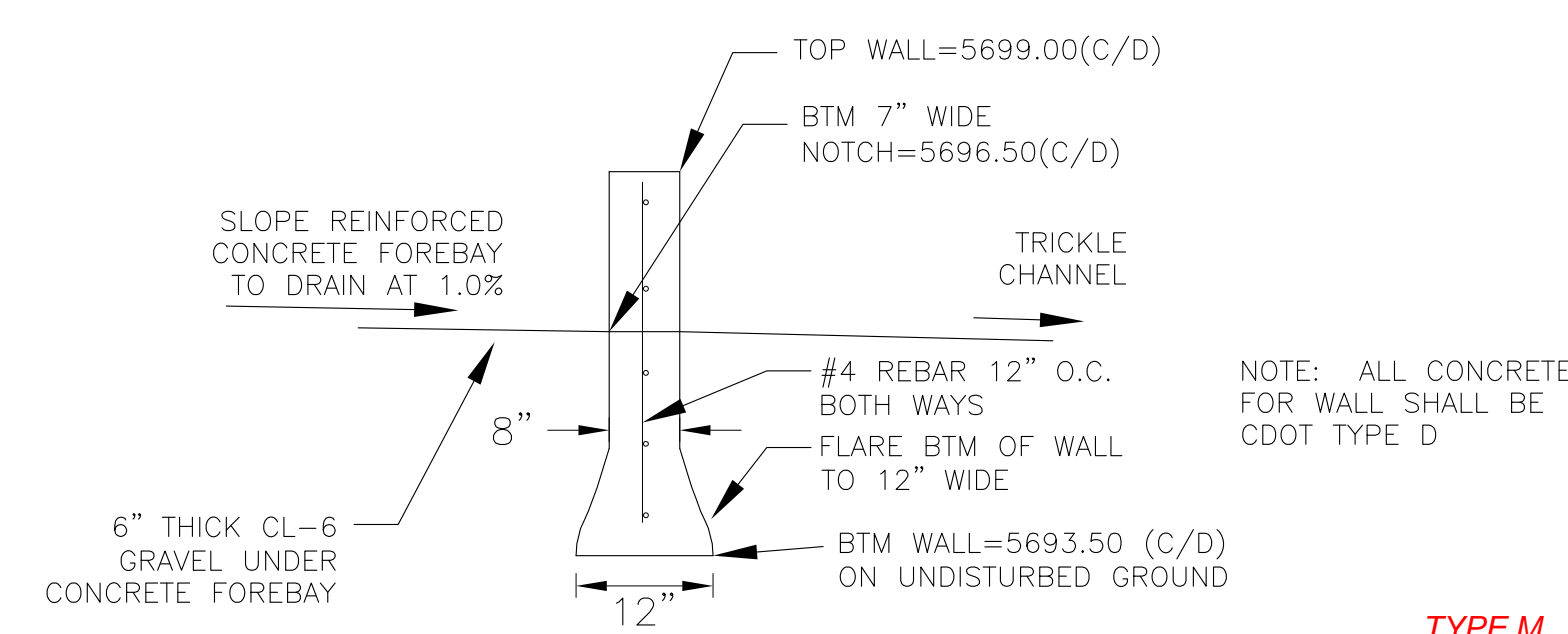


WALL SECTION B-B  
NO SCALE


NOTE: ALL CONCRETE FOR WALL SHALL BE CDOT TYPE D

POINT TABLE (FOREBAY C)				
NUMBER	NORTHING	EASTING	ELEVATION	NOTES
1	21991.42	25583.25	5696.50	FOREBAY BOTTOM
2	21991.58	25602.95	5696.70	FOREBAY BOTTOM
3	21983.61	25612.73	5696.80	FOREBAY BOTTOM
4	21991.43	25618.89	5696.90	FOREBAY BOTTOM
5	21991.47	25625.24	5696.99	FOREBAY BOTTOM
6	21998.92	25612.59	5696.80	FOREBAY BOTTOM
7	21996.26	25612.70	5696.90	ENERGY DISSIPATER WALL
8	21986.26	25612.77	5696.90	ENERGY DISSIPATER WALL


POINT TABLE (FOREBAY D)				
NUMBER	NORTHING	EASTING	ELEVATION	NOTES
1	21816.93	25597.69	5696.50	FOREBAY BOTTOM
2	21808.83	25607.67	5696.60	FOREBAY BOTTOM
3	21809.40	25618.82	5696.70	FOREBAY BOTTOM
4	21800.77	25619.40	5696.80	FOREBAY BOTTOM
5	21799.69	25610.82	5696.90	FOREBAY BOTTOM
6	21794.95	25611.47	5697.00	FOREBAY BOTTOM
7	21802.65	25605.08	5708.80	ENERGY DISSIPATER WALL
8	21804.01	25614.99	5708.40	ENERGY DISSIPATER WALL

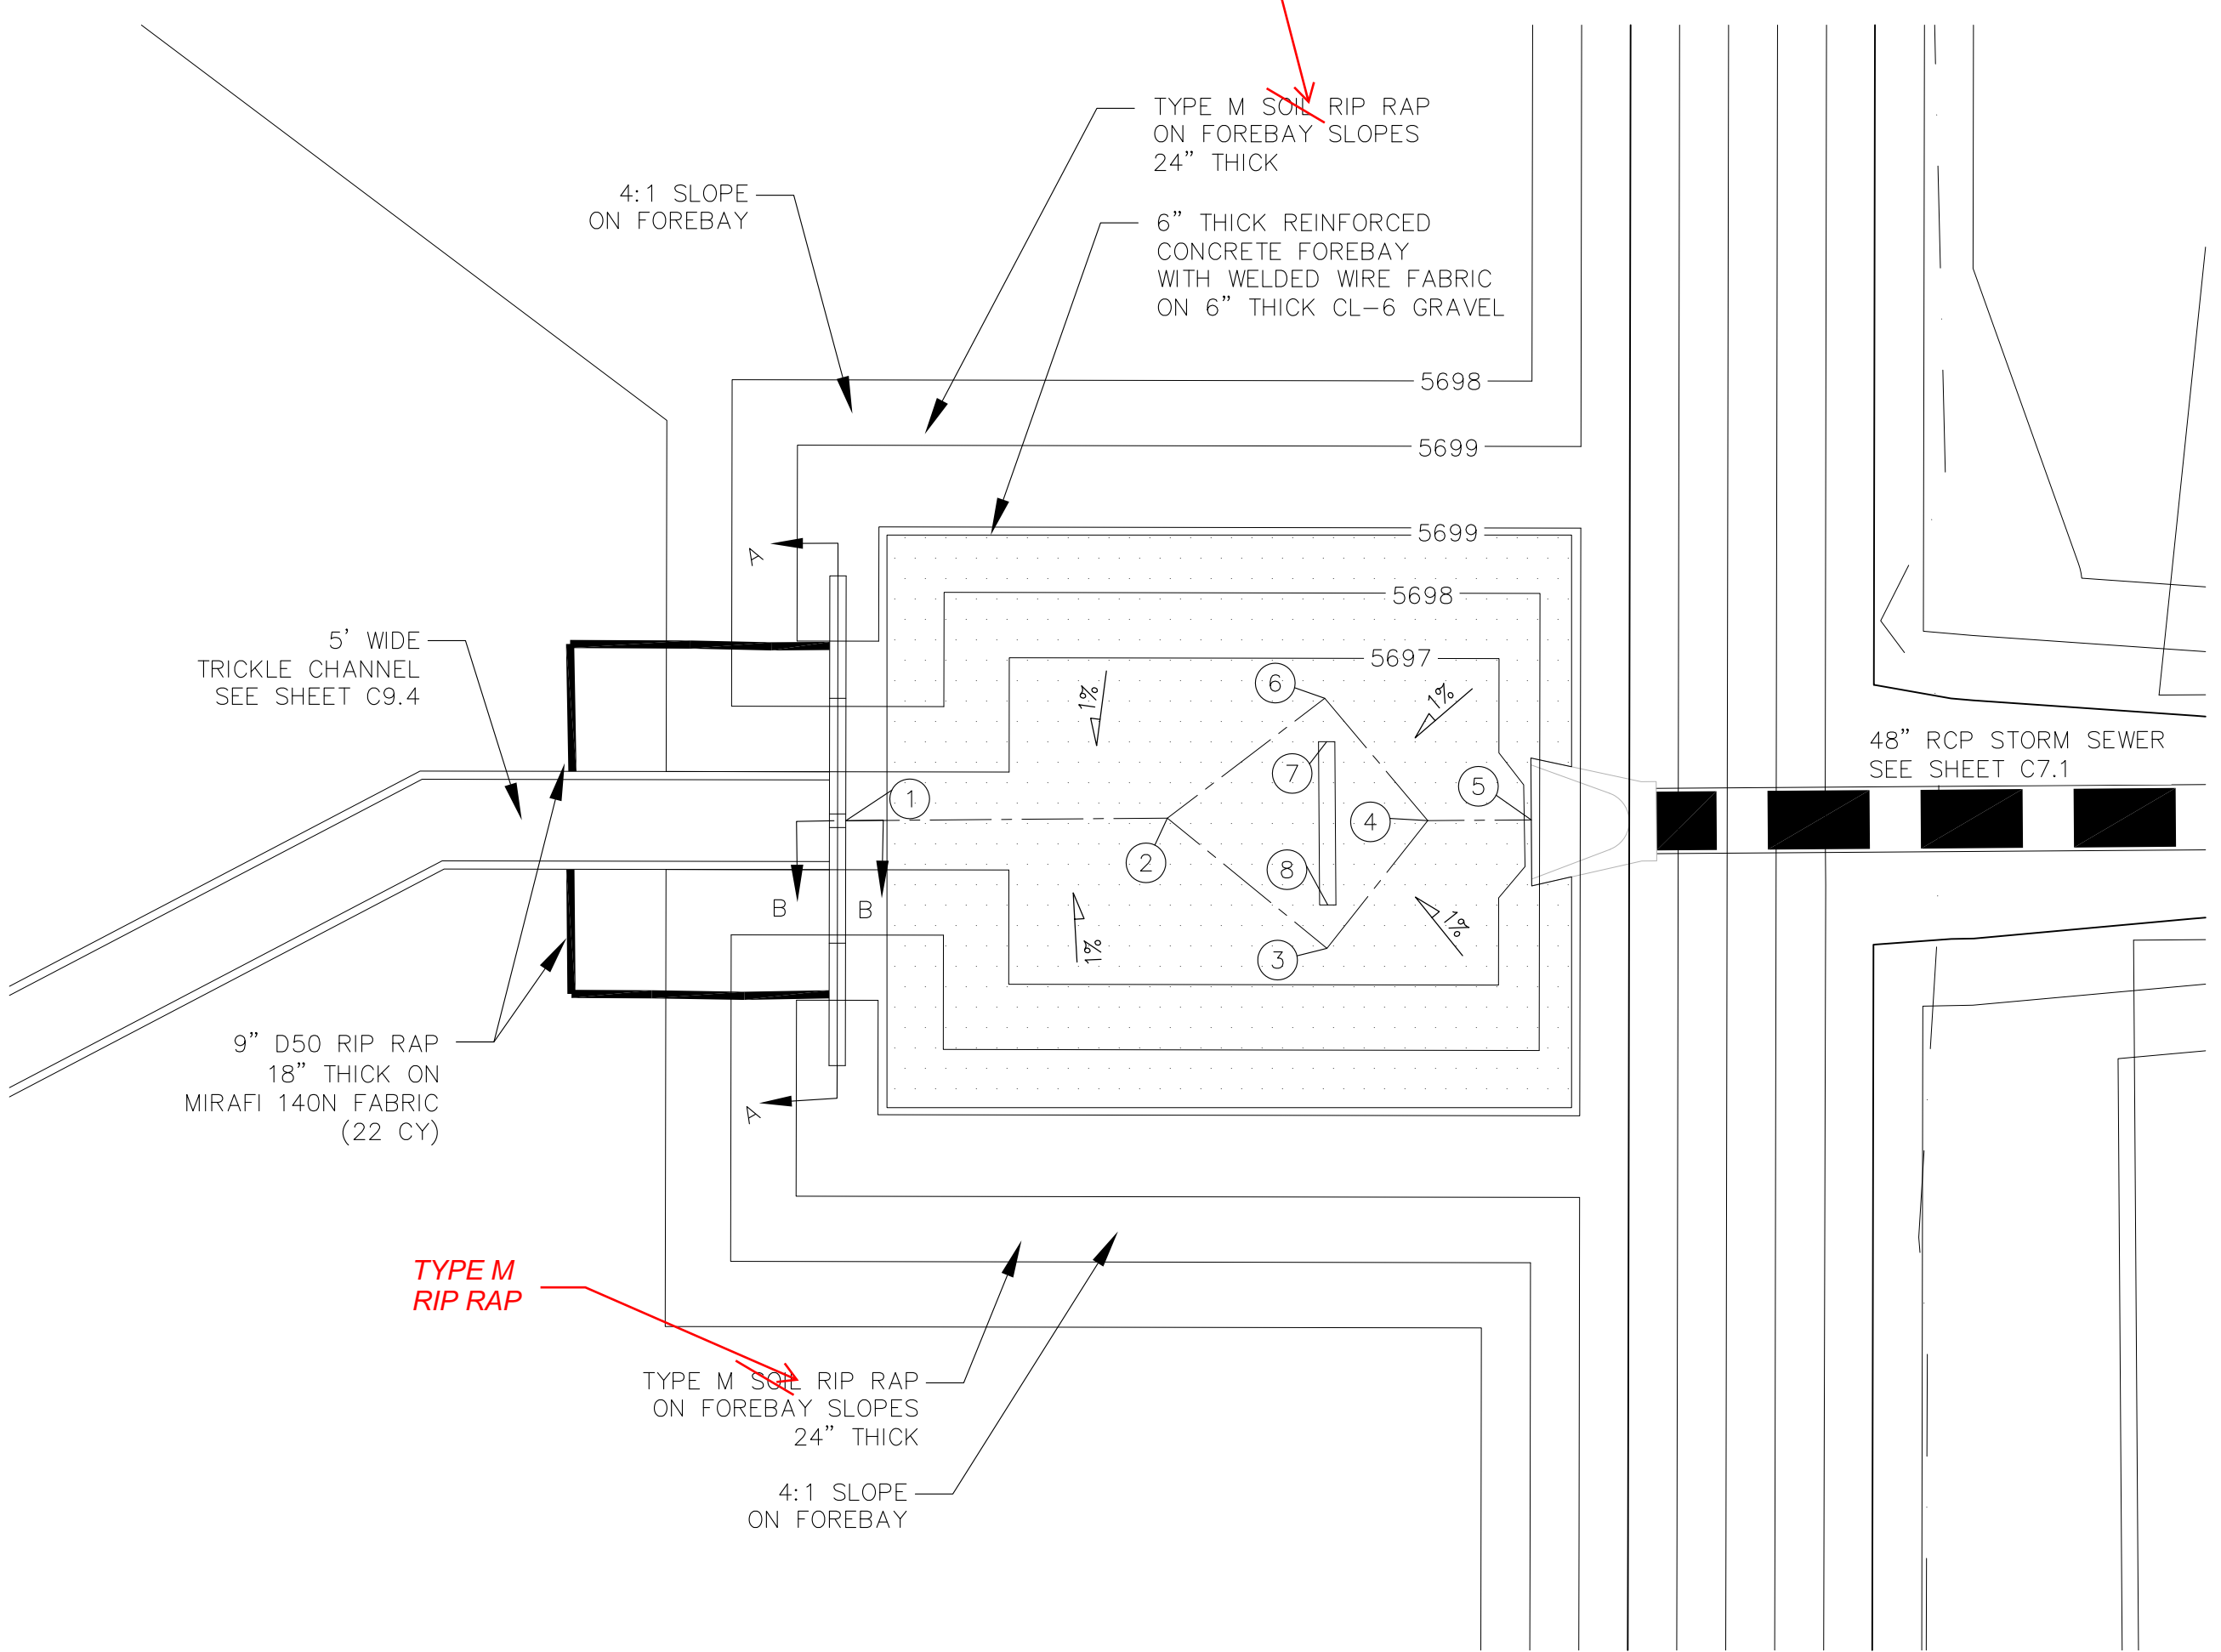

POND D2 - FOREBAY 'C' LAYOUT  
SCALE: 1"=10'

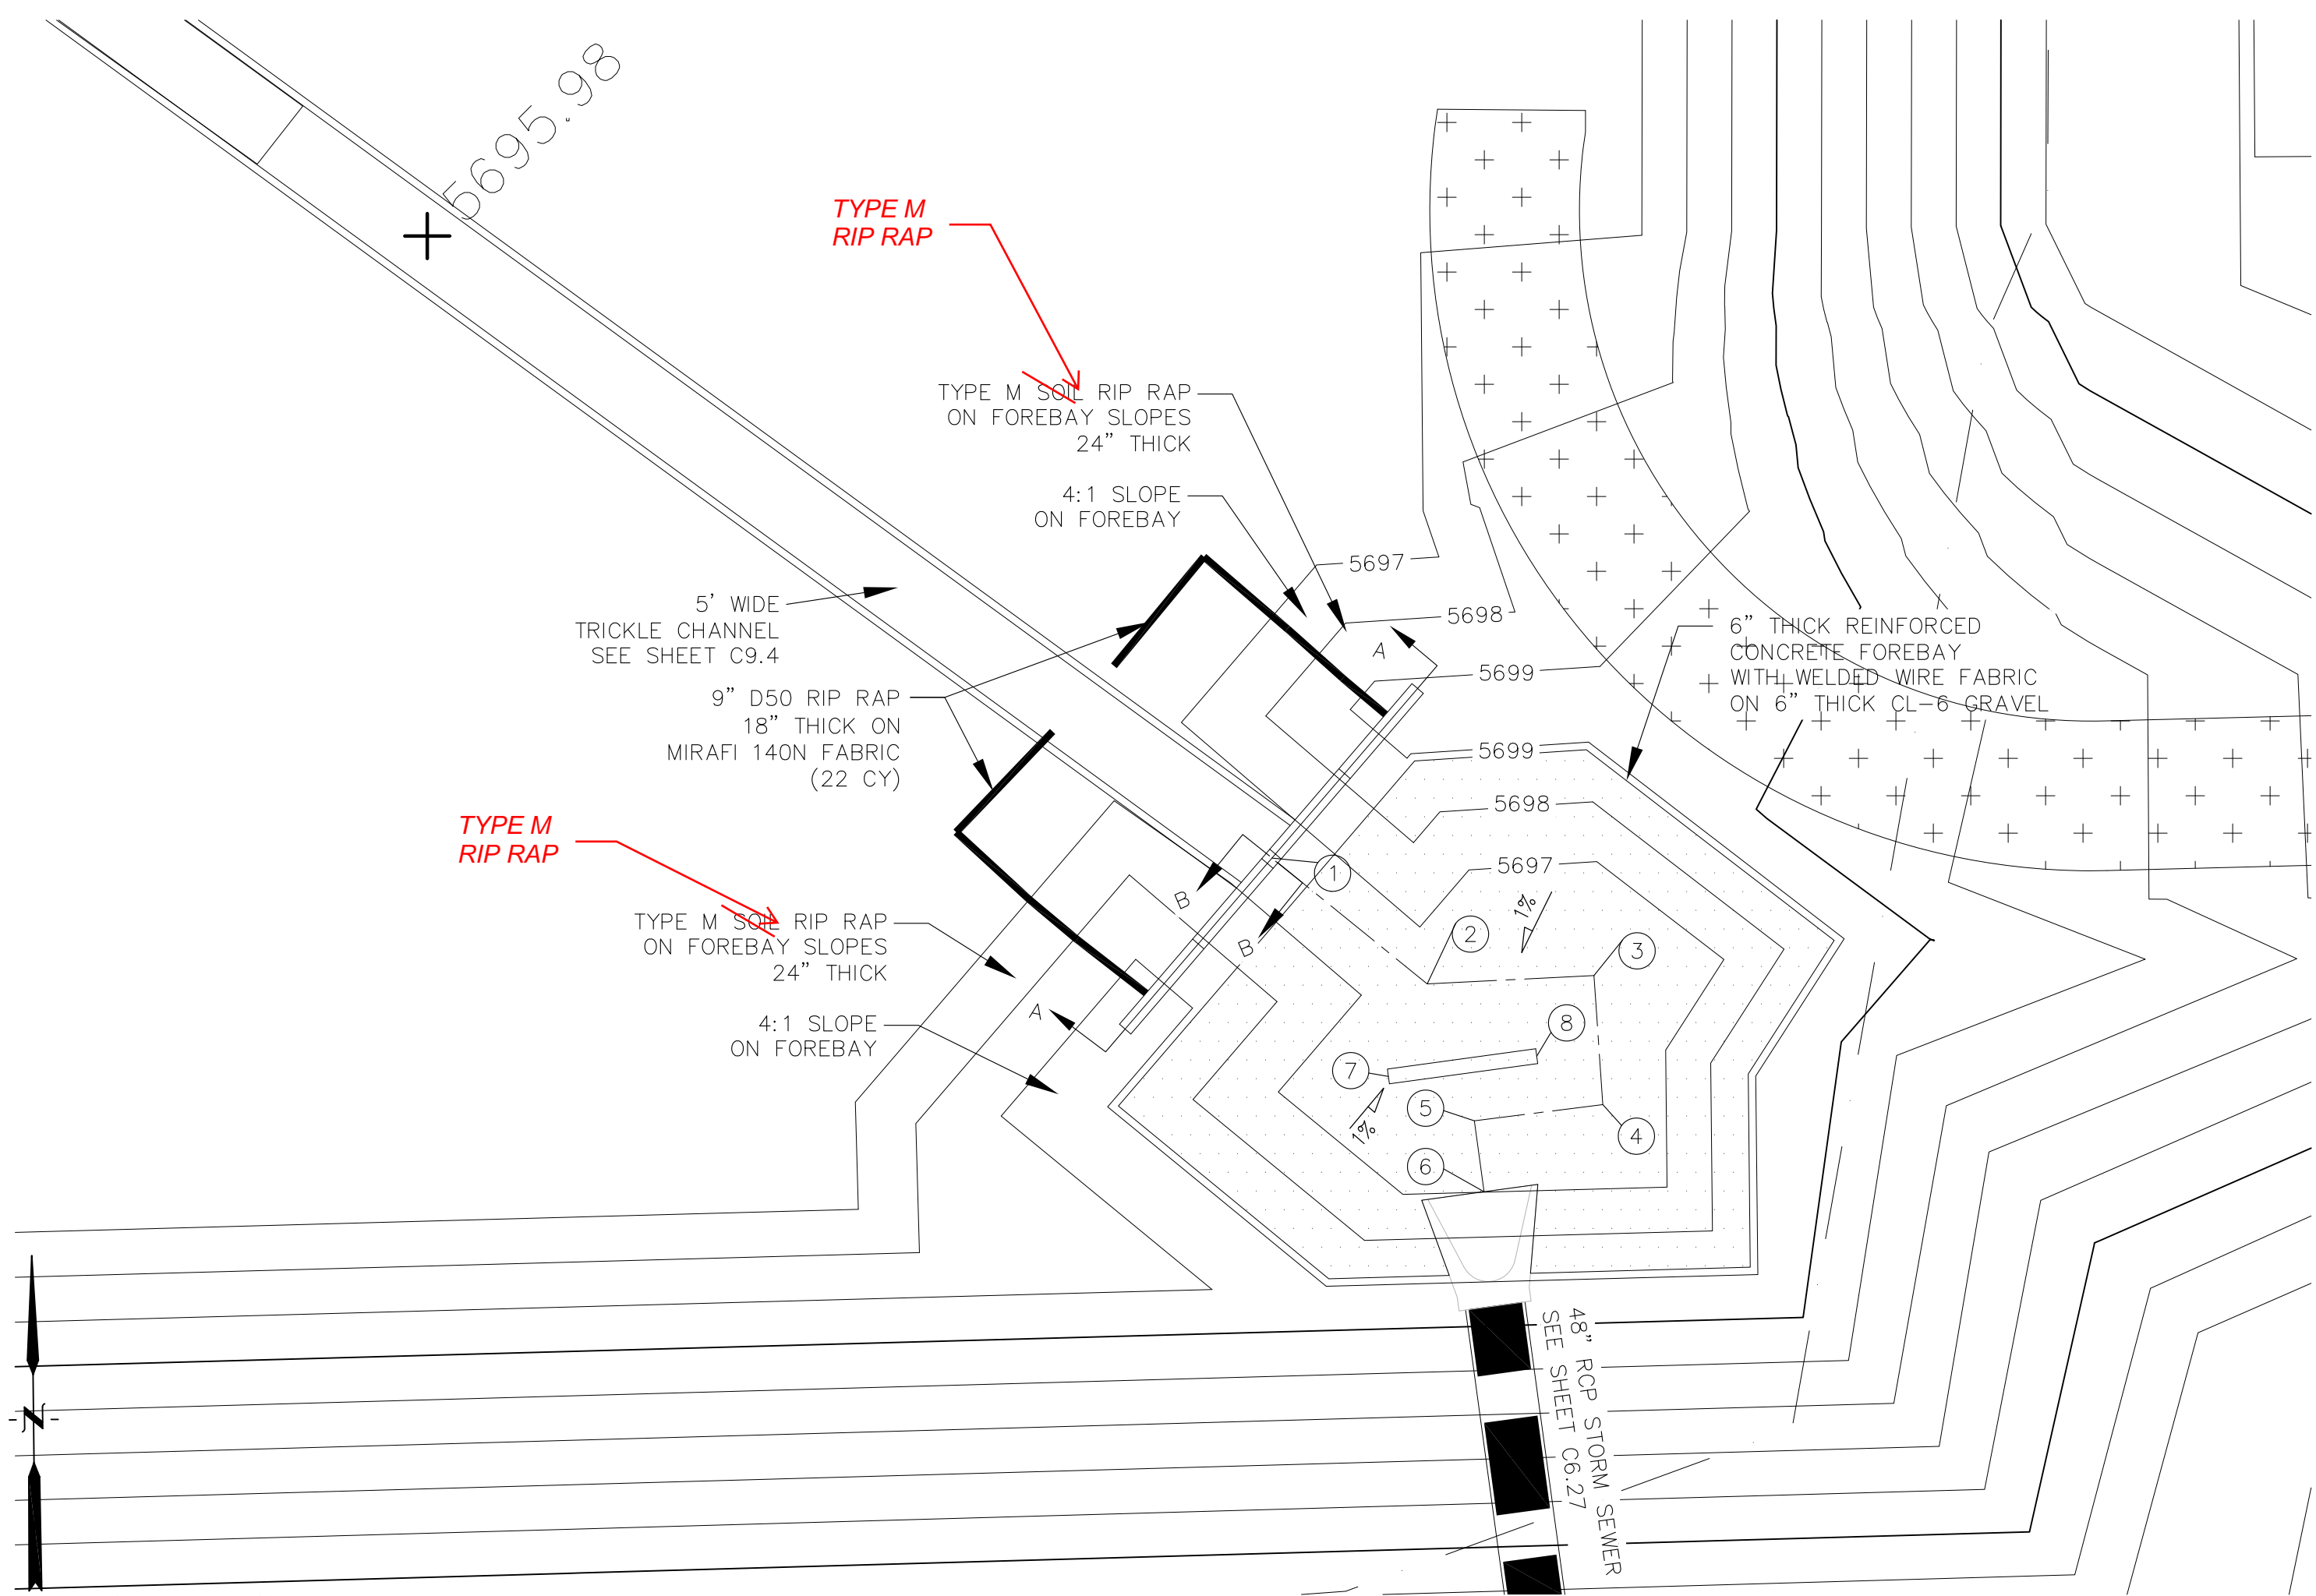

POND D2 - FOREBAY 'D' LAYOUT  
SCALE: 1"=10'

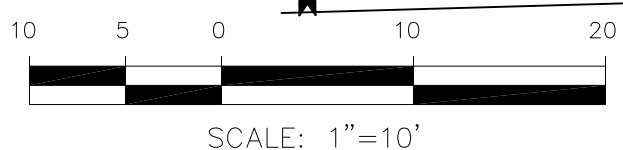


SCALE: 1"=10'

**CORE ENGINEERING GROUP**  
15004 1ST AVENUE S.  
DENVER, CO 80202  
PHONE: 719.570.1100  
CONTACT: RICHARD L. SCHINDLER, P.E.  
EMAIL: Rich@cegi.com

DATE: \_\_\_\_\_  
DESCRIPTION: \_\_\_\_\_  
NO: \_\_\_\_\_  
PREPARED FOR: **LORSON, LLC**  
212 N. WAHSATCH AVE, SUITE 301  
COLORADO SPRINGS, COLORADO 80903  
CONTACT: JEFF MARK  
PROJECT: **LORSON RANCH EAST**  
FILING NO. 1  
FONTAINE BLVD. - OLD GLORY DR  
COLORADO SPRINGS, COLORADO



DRAWN: RLS  
DESIGNED: RLS  
CHECKED: RLS

POND D2  
FOREBAY 'C' AND 'D'  
LAYOUT AND DETAILS




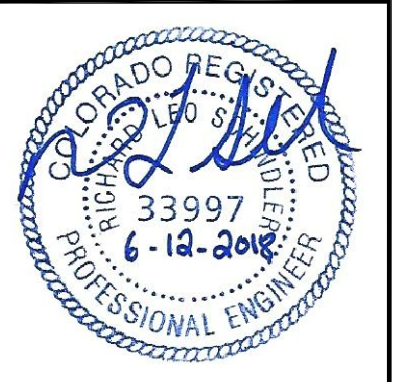


DATE: JUNE 12, 2018  
PROJECT NO: 100.042  
SHEET NUMBER: C9.5  
TOTAL SHEETS: 45

AS-BUILT  
DATE: 07/19/2022

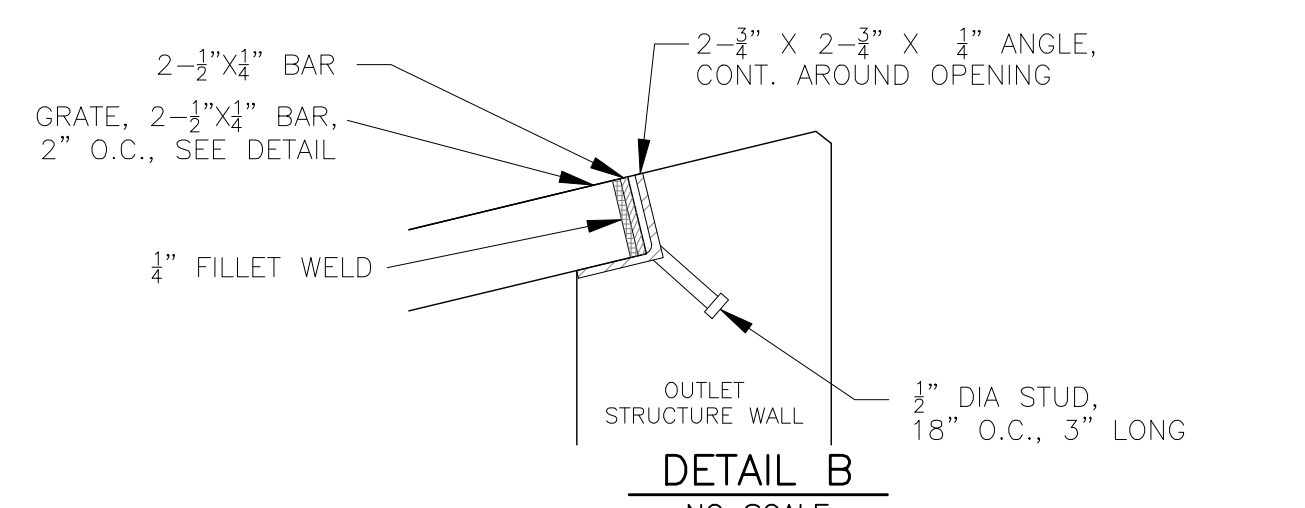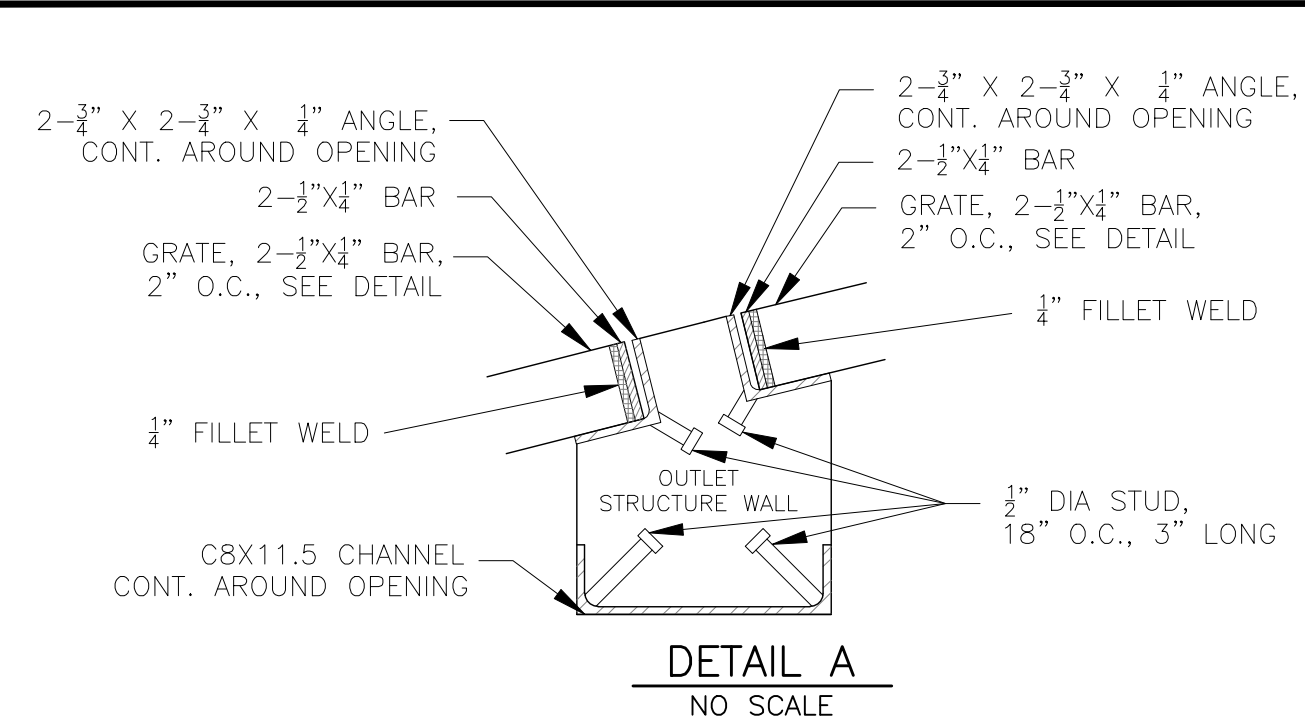

NOTE:  
AFTER CONCRETE STRUCTURE HAS BEEN POURED  
ALL GRATE DIMENSIONS SHALL BE FIELD VERIFIED  
PRIOR TO GRATE CONSTRUCTION

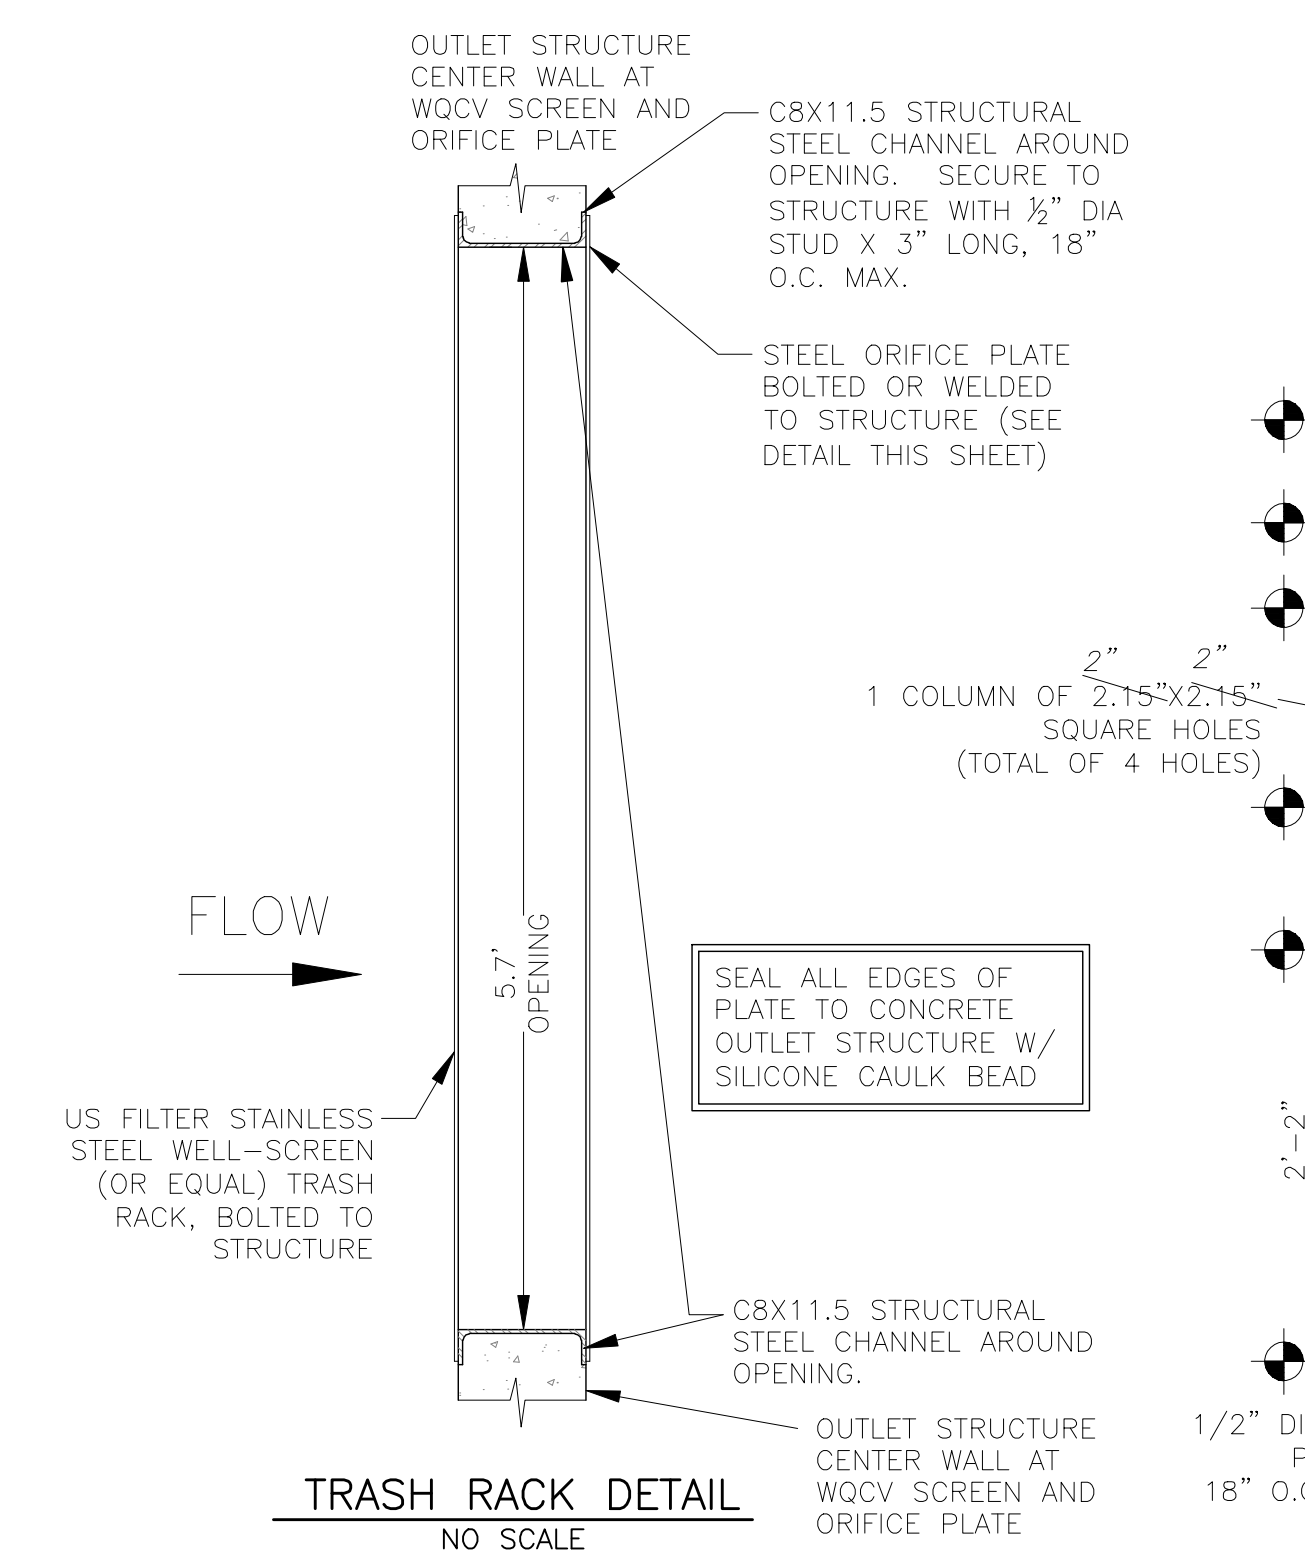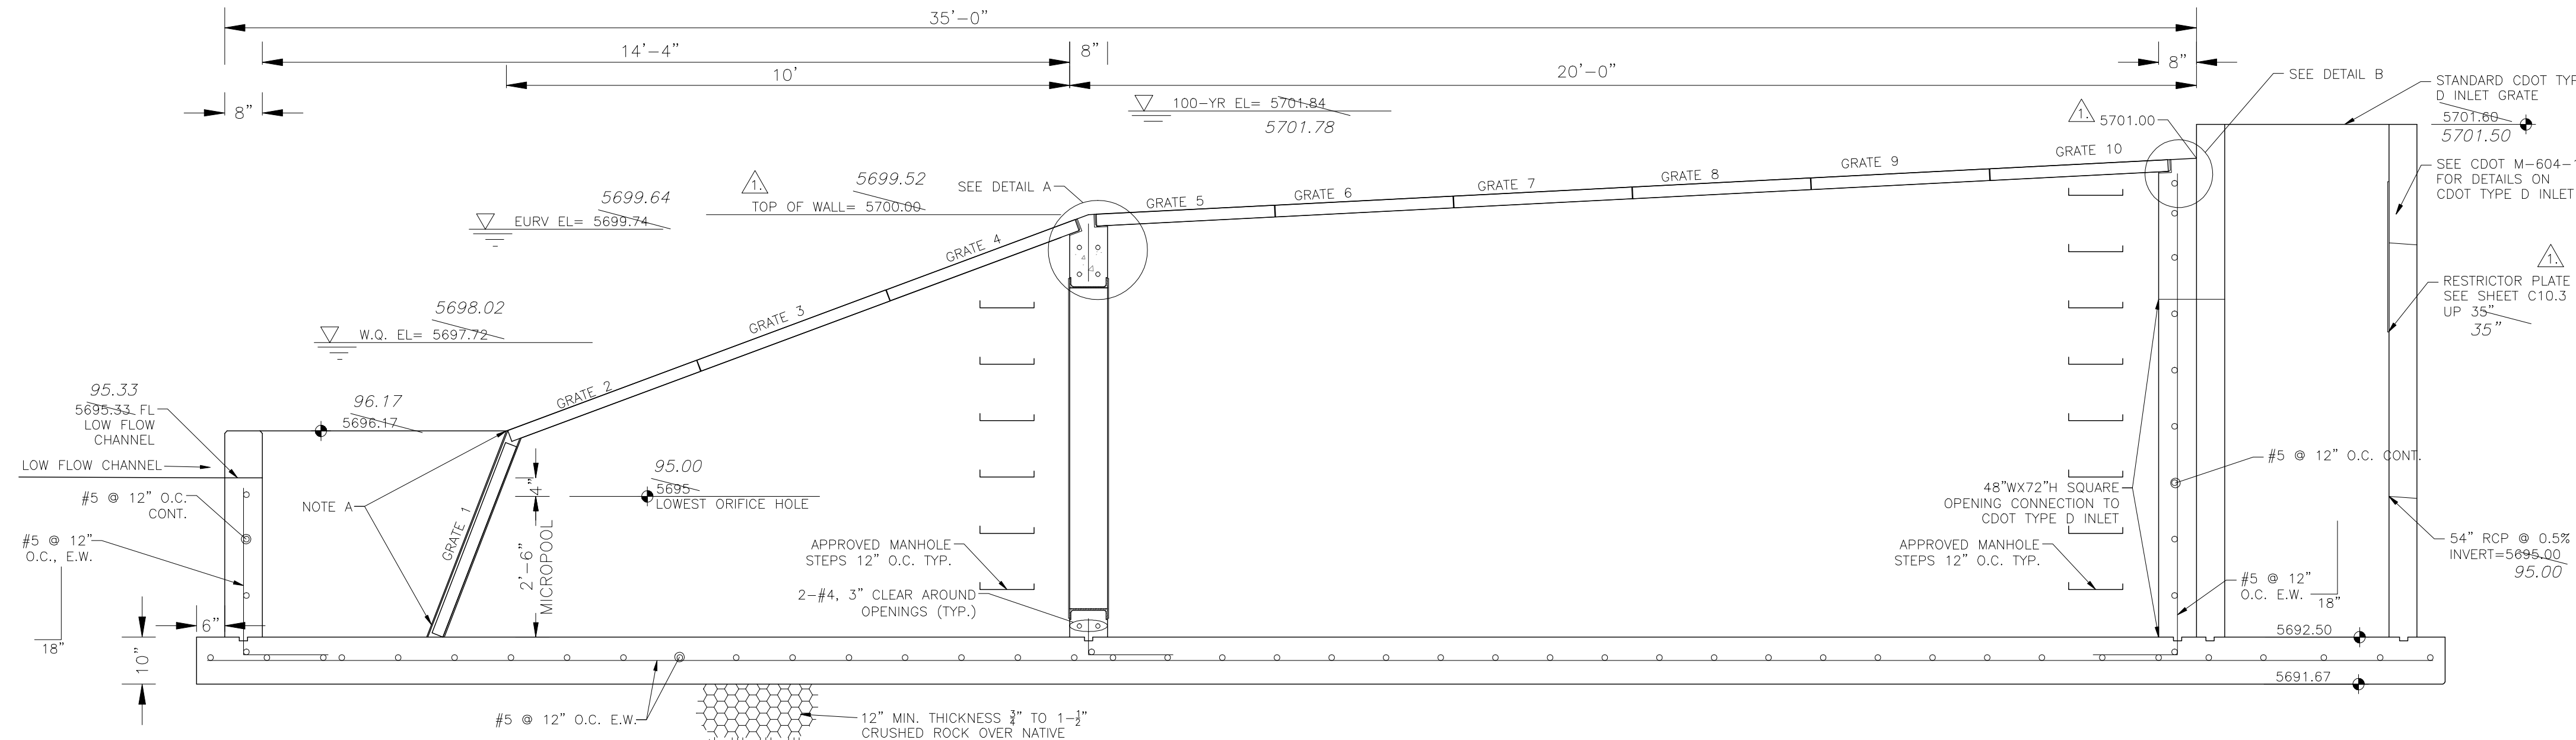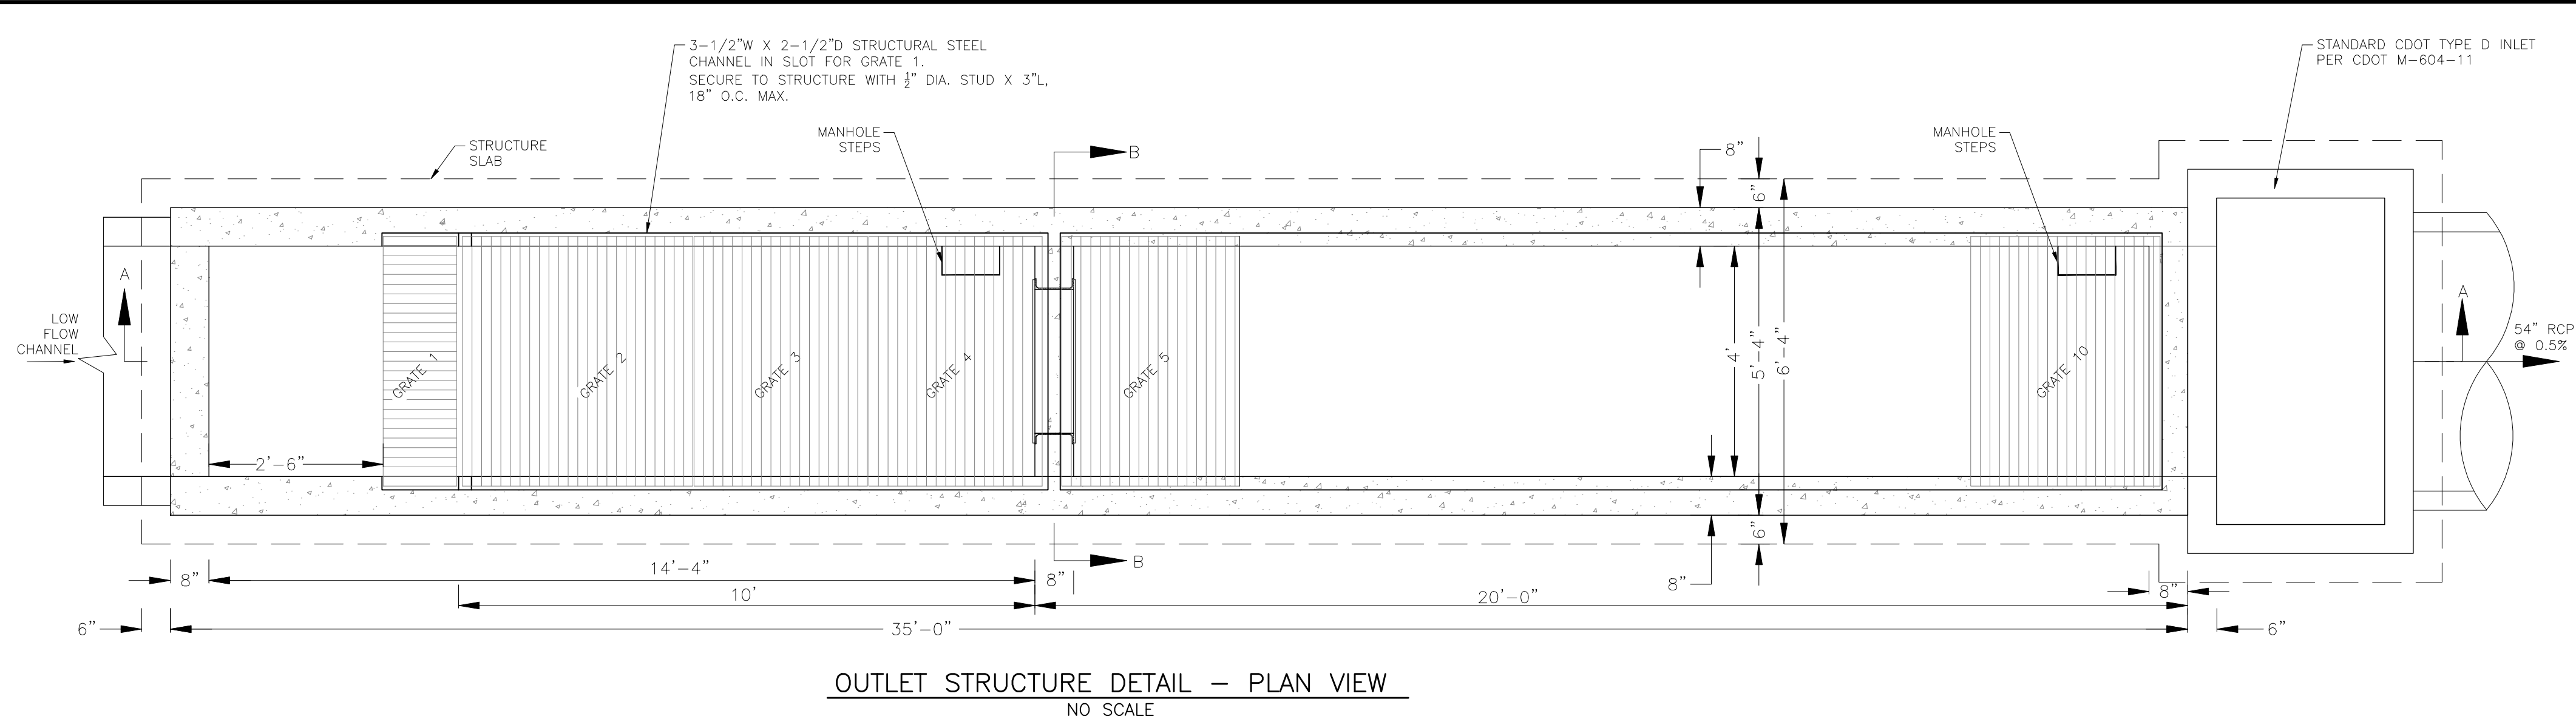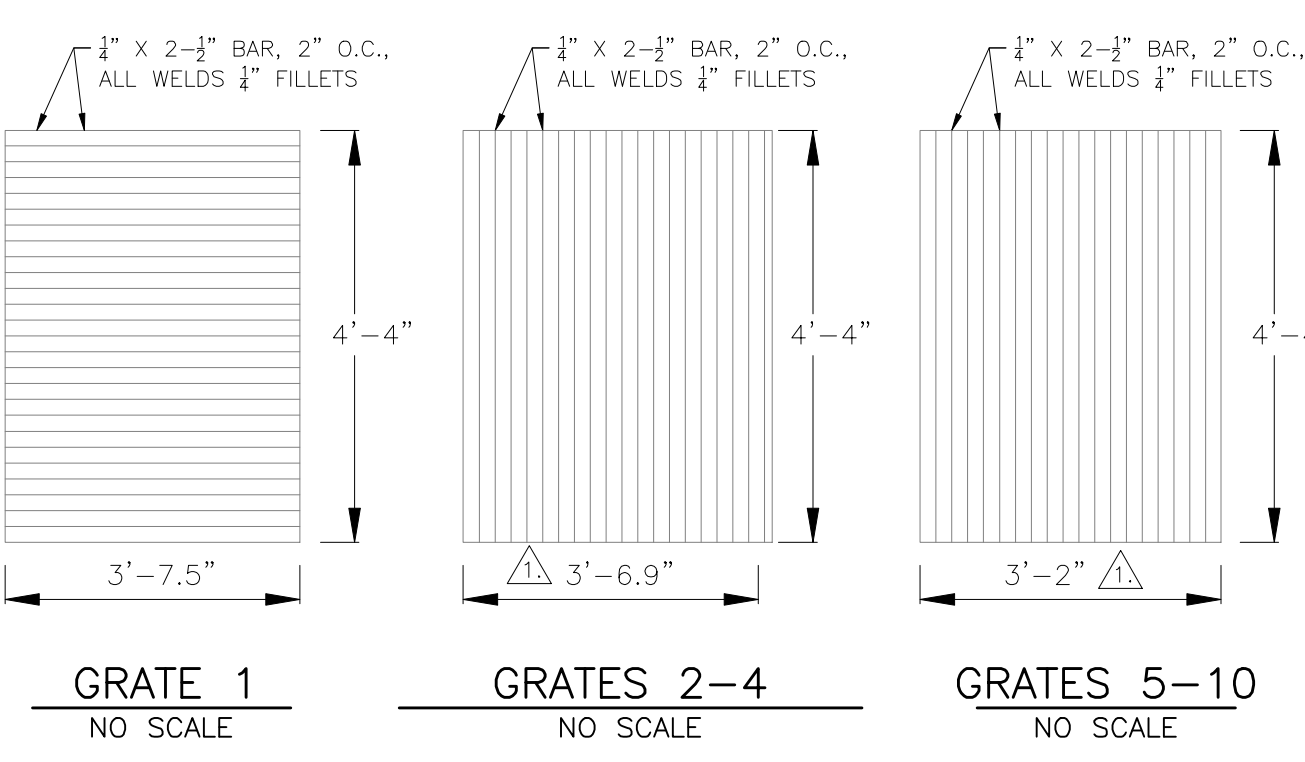


NOTE A:  
3-1/2\"/>

OUTLET STRUCTURE, FOREBAY, AND DRAIN CHANNEL NOTES:

- PRIOR TO CONSTRUCTION, CONTRACTOR SHALL PROVIDE SHOP DRAWINGS FOR ALL COMPONENTS OF THE OUTLET STRUCTURE.
- GRADE 60 REINFORCING STEEL REQUIRED. SEE TABLE FOR THE MINIMUM LAP SPLICE LENGTH FOR REINFORCING BARS. ALL REINFORCING STEEL SHALL HAVE A TWO-INCH MINIMUM CLEARANCE FROM EDGE OF CONCRETE, UNLESS OTHERWISE NOTED.
- CONCRETE FOR THE OUTLET STRUCTURE AND FOREBAY SHALL BE CDOT CLASS D CONCRETE.
- CONCRETE FOR DRAIN CHANNELS SHALL BE CDOT CLASS B CONCRETE
- EXPANSION JOINT MATERIAL SHALL MEET AASHTO SPECIFICATION M-213. EXPANSION JOINT MATERIAL SHALL BE 1/2\"/>

BAR SIZE	#4	#5	#6
MIN. SPLICE LENGTH	1'-3"	1'-7"	2'-0"

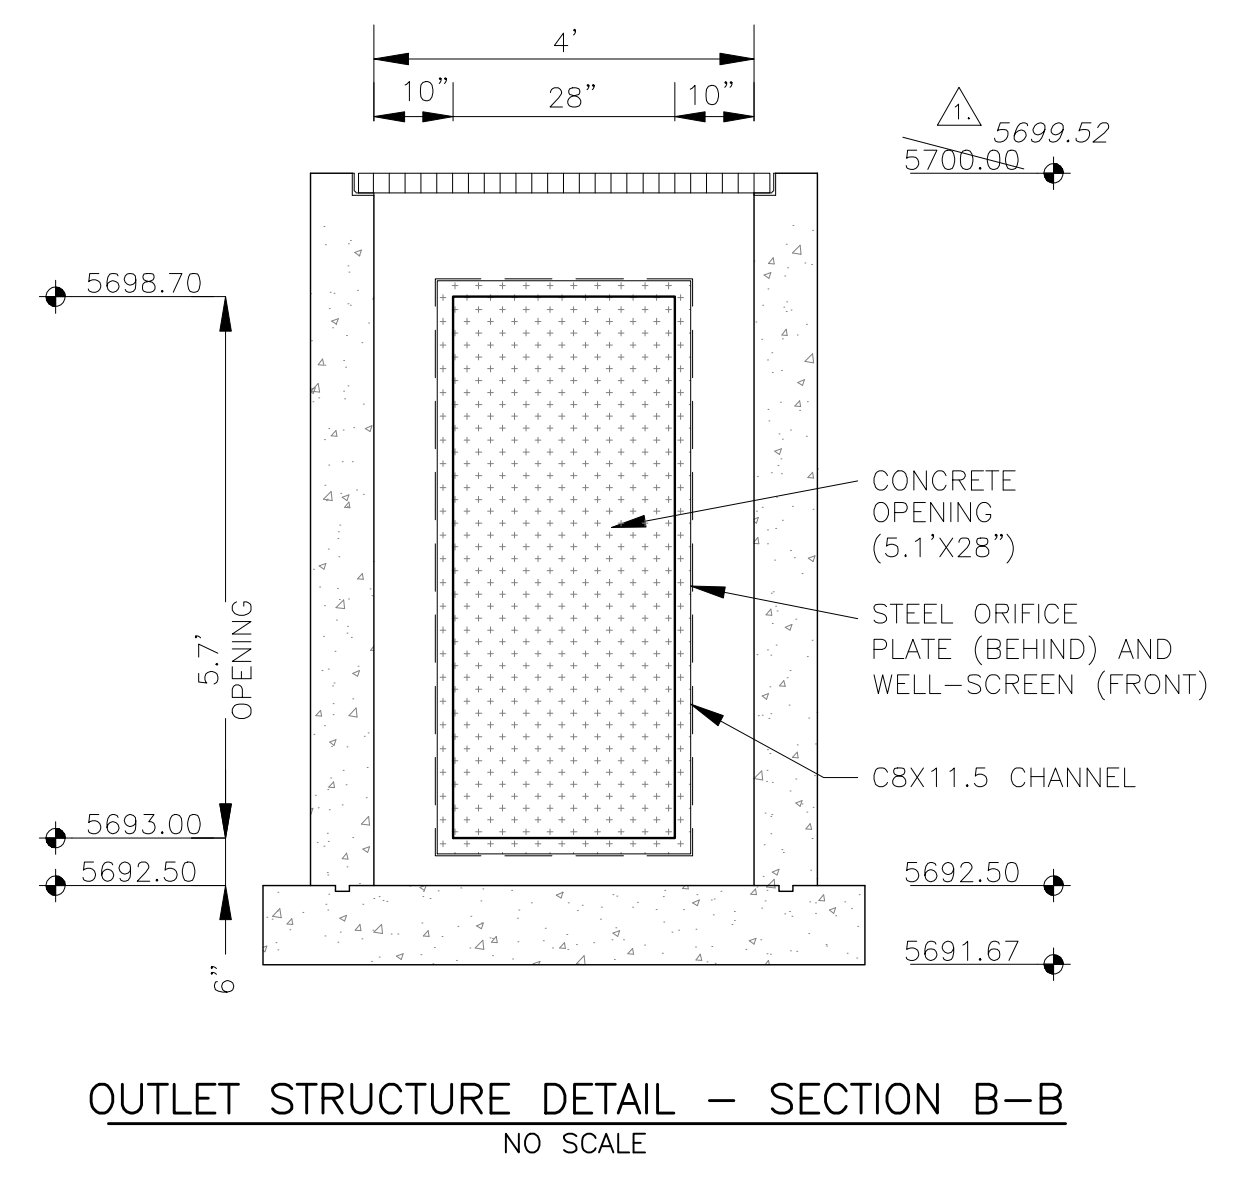

**CORE ENGINEERING GROUP**  
15004 1ST AVENUE S.  
BURNSVILLE, MN 55306  
CONTACT: RICHARD L. SCHINDLER, P.E.  
EMAIL: Rich@cegi.com

DATE: 7-2-2018  
DESCRIPTION: MODIFY OUTLET, CHANGE GRATE SIZES

PREPARED FOR:  
**LORSON RANCH EAST**  
212 N. WAHSATCH AVE. SUITE 301  
COLORADO SPRINGS, COLORADO 80903  
CONTACT: JEFF MARK

DRAWN: RLS  
DESIGNED: RLS  
CHECKED: RLS

**LORSON RANCH EAST FILING NO. 1**  
**FULL SPECTRUM POND D2**  
**OUTLET STRUCTURE**



DATE: JUNE 12, 2018  
PROJECT NO: 100.042  
SHEET NUMBER: **C9.6**  
TOTAL SHEETS: 45

**AS-BUILT**  
DATE: 07/19/2022