### KNOW ALL MEN BY THESE PRESENTS:

THAT LORSON LLC A COLORADO LIMITED LIABILITY COMPANY, AS NOMINEE FOR LORSON CONSERVATION INVEST I, LLLP A COLORADO LIMITED LIABILITY LIMITED PARTNERSHIP AND LORSON LLC A COLORADO LIMITED LIABILITY COMPANY.AS NOMINEE FOR MURRAY FOUNTAIN LLC, A COLORADO LIMITED LIABILITY COMPANY, AND EAGLE DEVELOPMENT COMPANY, A COLORADO COMPANY AND WIDEFIELD SCHOOL DISTRICT 3 BEING THE OWNERS OF THE FOLLOWING DESCRIBED TRACT OF LAND:

#### TO WIT:

A PARCEL OF LAND IN THE SW 1/4 SECTION 13, AND THE SE 1/4 SECTION 14, AND THE NE 1/4 SECTION 23, AND THE NW 1/4 SECTION 24, AND A REPLAT OF TRACTS I AND J OF "PIONEER LANDING AT LORSON RANCH FILING NO. 2" AS RECORDED UNDER RECEPTION NO. 217719888 ALL IN TOWNSHIP 15 SOUTH, RANGE 65 WEST OF THE SIXTH PRINCIPAL MERIDIAN, EL PASO COUNTY, COLORADO, MORE PARTICULARLY DESCRIBED AS FOLLOWS:


BEGINNING AT THE SOUTHEAST CORNER OF "THE MEADOWS AT LORSON RANCH FILING NO. 3" AS RECORDED UNDER RECEPTION NO. 213713396 IN THE EL PASO COUNTY, COLORADO RECORDS;

THENCE ALONG THE EASTERLY AND NORTHERLY LINES THEREOF THE FOLLOWING FOURTEEN (14) COURSES; (1) THENCE N16°02'05"E A DISTANCE OF 99.98 FEET; (2) THENCE N27°12'00"E A DISTANCE OF 50.51 FEET; (3) THENCE N04°51'02"E A DISTANCE OF 216.25 FEET; (4) THENCE ALONG THE ARC OF A CURVE TO THE RIGHT, SAID CURVE HAVING A RADIUS OF 269.76 FEET, A CENTRAL ANGLE OF 64°17'38", (THE CHORD OF WHICH BEARS N34°59'15"E, 287.07 FEET), AN ARC DISTANCE OF 302.71 FEET; (5) THENCE ALONG THE ARC OF A CURVE TO THE LEFT, SAID CURVE HAVING A RADIUS OF 30.49 FEET, A CENTRAL ANGLE OF 56°05'16", (THE CHORD OF WHICH BEARS N38°38'30"E, 28.67 FEET), AN ARC DISTANCE OF 29.85 FEET; (6) THENCE ALONG THE ARC OF A CURVE TO THE RIGHT, SAID CURVE HAVING A RADIUS OF 349.56 FEET, A CENTRAL ANGLE OF 44°40'09", (THE CHORD OF WHICH BEARS N41°02'29"E, 265.68 FEET), AN ARC DISTANCE OF 272.52 FEET; (7) THENCE N44°09'22"E A DISTANCE OF 20.09 FEET; (8)THENCE N06°46'17"E A DISTANCE OF 174.77 FEET; (9) THENCE N00°18'56"E A DISTANCE OF 51.25 FEET; (10) THENCE N54°40'55"W A DISTANCE OF 36.93 FEET; (11) THENCE N20°11'44"E A DISTANCE OF 214.88 FEET; (12) THENCE N10°51'52"E A DISTANCE OF 291.59 FEET; (13) THENCE N00°24'27"W A DISTANCE OF 232.81 FEET; (14) THENCE S89°35'58"W A DISTANCE OF 492.32 FEET; THENCE N00°23'47"W A DISTANCE OF 15.00 FEET TO THE SOUTHWEST CORNER OF TRACT I "PIONEER LANDING AT LORSON RANCH FILING NO. 2" AS RECORDED UNDER RECEPTION NO. 217713888 IN THE EL PASO COUNTY, COLORADO RECORDS; THENCE N00°23'47"W ALONG THE WESTERLY LINE THEREOF 115.00 FEET TO THE SOUTHWEST CORNER OF TRACT B, "PIONEER LANDING AT LORSON RANCH FILING NO. 2"; THENCE N89°35'58"E ALONG THE SOUTH LINES OF TRACTS B, A AND E "PIONEER LANDING AT LORSON RANCH FILING NO. 2" A DISTANCE OF 774.09 FEET; THENCE N03°27'32"E ALONG THE EASTERLY LINE OF TRACT E, "PIONEER LANDING AT LORSON RANCH FILING NO. 2" A DISTANCE OF 397.12 FEET; THENCE N49°33'34"E ALONG SAID EASTERLY LINE OF TRACT E, 447.72 FEET; THENCE N89°54'29"E A DISTANCE OF 221.60 FEET; THENCE S00°06'29"E A DISTANCE OF 663.07 FEET TO THE NORTH LINE OF AFORESAID TRACT I, "PIONEER LANDING AT LORSON RANCH FILING NO. 2"; THENCE N89°35'58"E ALONG THE NORTH LINE THEREOF 621.14 FEET; THENCE N52°37'06"E A DISTANCE OF 48.31 FEET; THENCE N00°24'02"W A DISTANCE OF 94.82 FEET; THENCE N04°23'45"E A DISTANCE OF 101.66 FEET; THENCE N00°24'02"W A DISTANCE OF 41.44 FEET; THENCE ALONG THE ARC OF A CURVE TO THE RIGHT SAID CURVE HAVING A RADIUS OF 595.00 FEET, A CENTRAL ANGLE OF 16°13'33", (THE CHORD OF WHICH BEARS N07°42'45"E, 167.94 FEET), AN ARC DISTANCE OF 168.50 FEET; THENCE N16°33'16"W A DISTANCE OF 33.97 FEET; THENCE N20°50'17"E A DISTANCE OF 50.00 FEET; THENCE N58°27'30"E A DISTANCE OF 33.75 FEET; THENCE ALONG THE ARC OF A CURVE TO THE RIGHT, SAID CURVE HAVING A RADIUS OF 595.00 FEET, A CENTRAL ANGLE OF 56°56'49", (THE CHORD OF WHICH BEARS N54°17'59"E, 567.33 FEET), AN ARC DISTANCE OF 591.38 FEET; IFHENCE N71°26'26''E A DISTANCE OF 46.20 FEET; THENCE N02°33'09''W A DISTANCE OF 19.24 FEET; THENCE N87°26'51"E A DISTANCE OF 50.00 FEET; THENCE S02°33'09"E A DISTANCE OF 16.93 FEET; THENCE S47°33'09"E A DISTANCE OF 18.48 FEET; THENCE N87°26'51"E A DISTANCE OF 466.93 FEET; THENCE N42°26'51"E A DISTANCE OF 28.28 FEET; THENCE N02°33'09"W A DISTANCE OF 14.59 FEET; THENCE N87°26'51"E A DISTANCE OF 50.00 FEET; THENCE S02°33'09"E A DISTANCE OF 34.59 FEET; THENCE N87°26'51"E A DISTANCE OF 15.33 FEET; THENCE S02°33'09"E A DISTANCE OF 60.00 FEET TO THE NORTHERLY EXTENSION OF THE EAST LINE OF TRACT J, "PIONEER LANDING AT LORSON RANCH FILING NO. 2"; THENCE S00°00'00"E ALONG SAID EAST LINE IN PART A DISTANCE OF 440.98 FEET; THENCE S43°26'13"E A DISTANCE OF 336.42 FEET TO THE NORTHEASTERLY LINE OF SAID TRACT J; THENCE S58°24'10"E ALONG SAID NORTHEASTERLY LINE 314.29 FEET TO THE MOST EASTERLY CORNER THEREOF; THENCE S38°22'35"W ALONG THE EAST LINE OF TRACT J A DISTANCE OF 345.18 FEET; THENCE CONTINUING ALONG SAID EAST LINE, S18°59'47"W A DISTANCE OF 99.98 FEET TO THE SOUTHEAST CORNER THEREOF; THENCE N70°06'29"W ALONG THE SOUTH LINE OF TRACT J IN PART, 73.85 FEET; THENCE S64°26'39"W A DISTANCE OF 28.50 FEET; THENCE N70°01'19"W A DISTANCE OF 50.01 FEET; THENCE N71°00'13"W A DISTANCE OF 377.73 FEET; THENCE ALONG THE ARC OF A CURVE TO THE LEFT, SAID CURVE HAVING A RADIUS OF 1434.92 FEET, A CENTRAL ANGLE OF 19°23'49", (THE CHORD OF WHICH BEARS N80°42'08"W, 483.46 FEET), AN ARC DISTANCE OF 485.78 FEET; THENCE S89°35'58"W A DISTANCE OF 299.70 FEET; THENCE S79°04'57"W A DISTANCE OF 43.60 FEET; THENCE S49°44'55"W A DISTANCE OF 63.21 FEET; THENCE S00°42'26"E A DISTANCE OF 206.65 FEET; THENCE S03°59'22"W A DISTANCE OF 60.18 FEET; THENCE S00°24'02"E A DISTANCE OF 309.91 FEET; THENCE S38°57'34"E A DISTANCE OF 32.09 FEET; THENCE S00°23'49"E A DISTANCE OF 50.00 FEET; THENCE S37°56'32"W A DISTANCE OF 32.24 FEET; THENCE S00°24'02"E A DISTANCE OF 339.66 FEET; THENCE S39°00'02"E A DISTANCE OF 32.06 FEET; THENCE S00°24'02"E A DISTANCE OF 50.00 FEET; THENCE S38°14'24"W A DISTANCE OF 32.03 FEET; THENCE S00°24'02"E A DISTANCE OF 589.11 FEET; THENCE S33°38'32"E A DISTANCE OF 36.48 FEET; THENCE N89°35'58"E A DISTANCE OF 64.05 FEET; THENCE S38°22'41"W A DISTANCE OF 95.57 FEET; THENCE S89°35'58"W A DISTANCE OF 554.18 FEET; THENCE S50°57'37"W A DISTANCE OF 32.03 FEET; THENCE S89°35'57"W A DISTANCE OF 50.00 FEET; THENCE N52°06'10"W A DISTANCE OF 32.27 FEET; THENCE S89°35'58"W A DISTANCE OF 924.41 FEET; THENCE S51°38'32"W A DISTANCE OF 49.80 FEET; THENCE S00°24'02"E A DISTANCE OF 41.57 FEET; THENCE S89°35'58"W A DISTANCE OF 60.00 FEET; THENCE N00°24'02"W A DISTANCE OF 38.12 FEET; THENCE N47°05'26"W A DISTANCE OF 38.26 FEET; THENCE S89°35'58"W A DISTANCE OF 125.90 FEET; THENCE N86°49'28"W A DISTANCE OF 128.25 FEET; THENCE S89°35'58"W A DISTANCE OF 693.52 FEET; THENCE S51°59'14"W A DISTANCE OF 29.49 FEET; THENCE S89°35'58"W A DISTANCE OF 60.00 FEET; THENCE N45°24'02"W A DISTANCE OF 14.14 FEET; THENCE S89°35'58"W A DISTANCE OF 14.76 FEET; THENCE N00°24'02"W A DISTANCE OF 80.00 FEET TO THE SOUTH LINE OF LOT 138, "THE MEADOWS AT LORSON RANCH FILING NO. 3"; THENCE N89°35'58"E ALONG THE SOUTH LINE THEREOF AND ALONG THE SOUTH LINE OF 60 FOOT WIDE STINGRAY LANE AND ALONG THE SOUTH LINE OF TRACT A AND TRACT C, A DISTANCE OF 568.94 FEET TO THE POINT OF BEGINNING.

SAID PARCEL CONTAINS A CALCULATED AREA OF 126.255 ACRES MORE OR LESS.

drawing.

Legal may need to be revised to include tracts. Tract table does not match

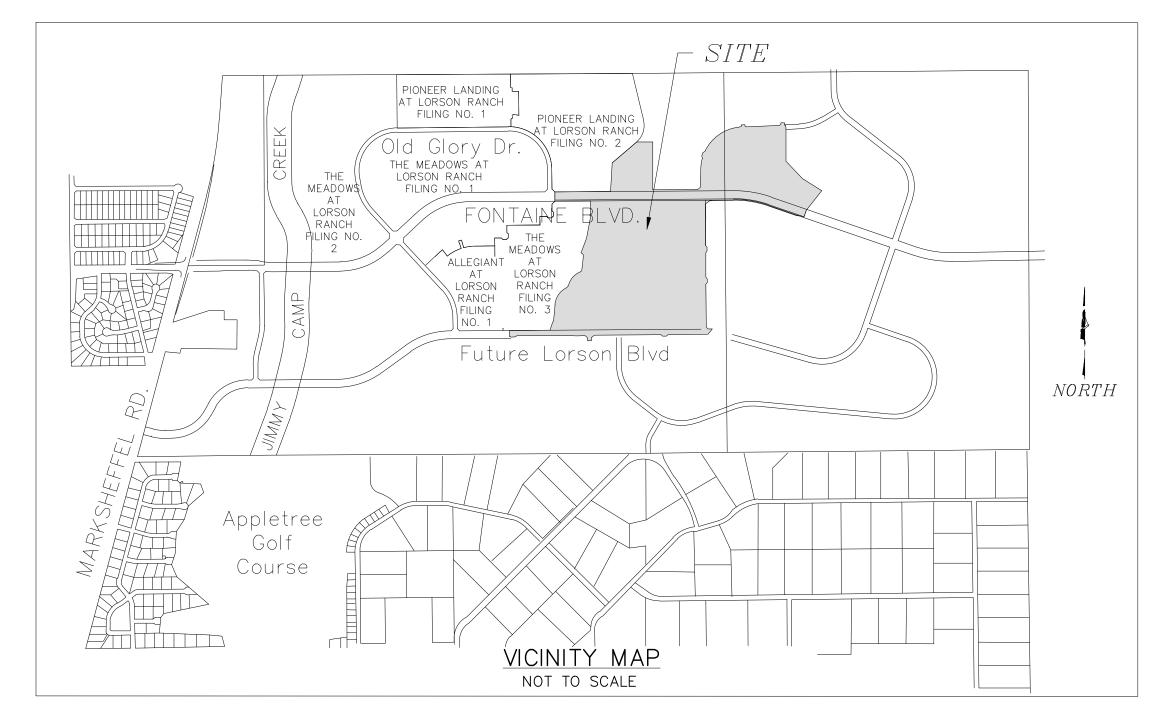

### **OWNERS CERTIFICATE:**

THE UNDERSIGNED, BEING ALL THE OWNERS, MORTGAGEES, BENEFICIARIES OF DEEDS OF TRUST AND HOLDERS OF OTHER INTERESTS IN THE LAND DESCRIBED HEREIN, HAVE LAID OUT, SUBDIVIDED, AND PLATTED SAID LANDS INTO LOTS, TRACTS, PUBLIC STREETS, AND EASEMENTS AS SHOWN HEREON UNDER THE NAME AND SUBDIVISION OF "LORSON RANCH EAST FILING NO. 1". ALL PUBLIC IMPROVEMENTS SO PLATTED ARE HEREBY DEDICATED TO PUBLIC USE AND SAID OWNER DOES HEREBY COVENANT AND AGREE THAT THE PUBLIC IMPROVEMENTS WILL BE CONSTRUCTED TO EL PASO COUNTY STANDARDS AND THAT PROPER DRAINAGE AND EROSION CONTROL FOR SAME WILL BE PROVIDED AT SAID OWNER'S EXPENSE. ALL TO THE SATISFACTION OF THE BOARD OF COUNTY COMMISSIONERS OF EL PASO COUNTY, COLORADO. UPON ACCEPTANCE BY RESOLUTION, ALL PUBLIC IMPROVEMENTS SO DEDICATED WILL BECOME MATTERS OF MAINTENANCE BY EL PASO COUNTY, COLORADO. THE UTILITY EASEMENTS SHOWN HERON ARE HEREBY DEDICATED FOR PUBLIC UTILITIES AND COMMUNICATION SYSTEMS AND OTHER PURPOSES AS SHOWN HEREON. THE ENTITIES RESPONSIBLE FOR PROVIDING THE SERVICES FOR WHICH THE EASEMENTS ARE ESTABLISHED ARE HEREBY GRANTED THE PERPETUAL RIGHT OF INGRESS AND EGRESS FROM AND TO ADJACENT PROPERTIES FOR INSTALLATION, MAINTENANCE, AND REPLACEMENT OF UTILITY LINES AND RELATED FACILITIES.

BY: JEFF MARK, AUTHORIZED SIGNING AGENT, FOR LORSON LLC A COLORADO LIMITED LIABILITY COMPANY, AS NOMINEE FOR LORSON CONSERVATION INVEST I, LLLP A COLORADO LIMITED LIABILITY LIMITED PARTNERSHIP AND LORSON LLC A COLORADO LIMITED LIABILITY COMPANY, AS NOMINEE FOR MURRAY FOUNTAIN LLC, A COLORADO LIMITED LIABILITY COMPANY, AND EAGLE DEVELOPMENT COMPANY, A COLORADO COMPANY

#### ATTEST:

SECRETARY/TREASURER

STATE OF COLORADO ) COUNTY OF EL PASO

ACKNOWLEDGED BEFORE ME THIS DAY OF JEFF MARK, AUTHORIZED SIGNING AGENT, LORSON LLC, A COLORADO LIMITED LIABILITY COMPANY

WITNESS MY HAND AND OFFICIAL SEAL:

MY COMMISSION EXPIRES:

NOTARY PUBLIC:

WIDEFIELD SCHOOL DISTRICT 3

NAME:

TITLE:

STATE OF COLORADO ) COUNTY OF EL PASO

ACKNOWLEDGED BEFORE ME THIS DAY OF , TITLE: WIDEFIELD SCHOOL DISTRICT 3.

WITNESS MY HAND AND OFFICIAL SEAL:

MY COMMISSION EXPIRES: NOTARY PUBLIC:

# LORSON RANCH EAST FILING NO. 1

A PORTION OF THE SOUTHWEST QUARTER (SW 1/4) SECTION 13, AND A PORTION OF THE SOUTHEAST QUARTER (SE 1/4) SECTION 14, PI A PORTION OF THE NORTHEAST QUARTER (NE 1/4) SECTION 23, AND A PORTION OF THE NORTHWEST QUARTER (NW 1/4) SECTION 24, co TOWNSHIP 15 SOUTH. RANGE 65 WEST OF THE SIXTH PRINCIPAL MERIDIAN. EL PASO COUNTY. COLORADO

### EASEMENTS:

OWNER ADDRESS:

212 N. WAHSATCH AVENUE SUITE 301 COLORADO SPRINGS, CO 80903 PHONE: (719) 635-3200

FAX: (719) 635-3244

, 2018, A.D. BY

OWNER ADDRESS: 1820 MAIN STREET COLORADO SPRINGS, CO 8091 PHONE: (719) 391-3000 FAX: (719) 390-4372

> , 2018, A.D. BY FOR

UNLESS OTHERWISE SHOWN, ALL SIDE LOT LINES ARE HEREBY PLATTED WITH A FIVE FOOT (5') PUBLIC UTILITY AND DRAINAGE EASEMENT, ALL REAR LOT LINES ARE HEREBY PLATTED WITH A TEN FOOT (10') PUBLIC UTILITY AND DRAINAGE EASEMENT, ALL FRONT LOT LINES AND ALL FRONT TRACT LINES ARE HEREBY PLATTED WITH A TEN FOOT (10') PUBLIC UTILITY AND DRAINAGE EASEMENT. THE SOLE RESPONSIBILITY FOR MAINTENANCE OF ALL HEREIN DESCRIBED EASEMENTS IS VESTED WITH THE INDIVIDUAL PROPERTY OWNERS. A TWENTY FOOT (20') PUBLIC UTILITY EASEMENT IS HEREBY PLATTED ALONG THE

SUBDIVISION BOUNDARY LINES.

FLOOD PLAIN CERTIFICATION:

A PORTION OF THIS PROPERTY IS LOCATED WITHIN A DESIGNATED FEMA FLOODPLAIN AS DETERMINED BY THE FLOOD INSURANCE RATE MAP (FIRM) PANEL NO. 08041CO957F AND PANEL NO. 08041CO1000F. BOTH DATED MARCH 17. 1997 REVISED TO REFLECT CLOMR CASE NO. 06-08-8425R, EFFECTIVE DATE JANUARY 17, 2007 AND LOMC 14-08-053P, EFFECTIVE DATE JANUARY 28, 2015 HAS BEEN EXAMINED AS IT RELATES TO THE PROPERTY BEING PLATTED. THE REVISED AND AMENDED FLOODPLAIN LIMITS ARE AS SHOWN HEREON.

ACCEPTANCE CERTIFICATE FOR TRACTS:

## LORSON RANCH METROPOLITAN DISTRICT

THE DEDICATION OF TRACTS A, B, C, D, E, F, G, H, I, K, L, M, N, O, P, Q, R, S, AND T FOR THE PURPOSES SPECIFIED IN THE TRACT TABLE ARE HEREBY ACCEPTED FOR OWNERSHIP AND MAINTENANCE BY THE LORSON RANCH METROPOLITAN DISTRICT . APPROVAL IS GRANTED FOR THIS PLAT OF LORSON RANCH EAST FILING NO. 1.

## Add a note addressing underdrain maintenance.

BY: JEFF MAR	RK. DIRECTOR	R, LORSON, LLC

STATE OF COLORADO ) ss COUNTY OF EL PASO
ACKNOWLEDGED BEFORE ME THISAYOF, 2018, A.D. BY JEFF MARK, DIRECTOR, LORSON, LLC WITNESS BY HAND AND OFFICIAL SEAL: Ranch Metropolitan District No. 1
MY COMMISSION EXPIRES:
NOTARY PUBLIC:
WIDEFIELD SCHOOL DISTRICT 3
THE DEDICATION OF TRACT J FOR THE PURPOSES SPECIFIED IN THE TRACT TABLE ARE HEREBY ACCEPTED FOR OWNERSHIP AND MAINTENANCE BY WIDEFIELD SCHOOL DISTRICT 3. APPROVAL IS GRANTED FOR THIS PLAT OF LORSON RANCH EAST FILING NO. 1.
STATE OF COLORADO ) ) SS
COUNTY OF EL PASO
ACKNOWLEDGED BEFORE ME THIS DAY OF, 2018, A.D. BY
NAME, TITLE:, FOR
WIDEFIELD SCHOOL DISTRICT 3.

WITNESS MY HAND AND OFFICIAL SEAL:

MY COMMISSION EXPIRES:

NOTARY PUBLIC:

Please use a varyir line type for the plat boundary. It is very difficult to delineate what is in this plat and what is not.

### SURVEYORS CERTIFICATE

I VERNON P. TAYLOR, A DULY REGISTERED PRO STATE OF COLORADO, DO HEREBY CERTIFY TH REPRESENTS THE RESULTS OF A SURVEY MADI UNDER MY DIRECT SUPERVISION AND THAT ALL HEREON; THAT MATHEMATICAL CLOSURE ERRO THAT SAID PLAT HAS BEEN PREPARED IN FULL LAWS OF THE STATE OF COLORADO DEALING W SURVEYING OF LAND AND ALL APPLICABLE PRC LAND DEVELOPMENT CODE.

I ATTEST THE ABOVE ON THIS \_\_\_\_\_ DAY OF \_\_\_\_

VERNON P. TAYLOR DATE COLORADO PLS NO. 25966, FOR AND ON BEHALF OF M&S CIVIL CONSULTANTS, INC 20 BOULDER CRESCENT, SUITE 110 COLORADO SPRINGS, COLORADO 80903

NOTICE:

ACCORDING TO COLORADO LAW, YOU MUST COMMENCE AI THIS SURVEY WITHIN THREE YEARS AFTER YOU FIRST DISC ACTION BASED UPON ANY DEFECT IN THIS SURVEY BE COM DATE OF THE CERTIFICATION SHOWN HEREON.

### BOARD OF COUNTY COMMISSION

THIS PLAT FOR "LORSON RANCH EAST FILING N THE EL PASO COUNTY, COLORADO BOARD OF ( DAY OF , 2018, A.D., SUE HEREON AND ANY CONDITIONS INCLUDED IN TH DEDICATIONS OF LAND TO THE PUBLIC INCLUDI EASEMENTS ARE ACCEPTED. BUT PUBLIC IMPRO BECOME THE MAINTENANCE RESPONSIBILITY O PRELIMINARY ACCEPTANCE OF THE PUBLIC IMP THE REQUIREMENTS OF THE LAND DEVELOPME MANUAL, AND THE SUBDIVISION IMPROVEMENT

PRESIDENT, BOARD OF COUNTY COMMISSIONE

APPROVAL IS GRANTED FOR THIS PLAT OF "LOR DAY OF THIS

EL PASO COUNTY DIRECTOR OF PLANNING AND

EL PASO COUNTY ASSESSOR

### **RECORDING:**

STATE OF COLORADO ) COUNTY OF EL PASO

I HEREBY CERTIFY THAT THIS INSTRUMENT WAS AT O'CLOCK .M., THIS DAY AND IS DULY RECORDED UNDER RECEPTION NU OF THE RECORDS OF EL PASO COUNTY, COLOR

CHUCK BROERMAN, RECORDER

FEE:	B`

DEPUTY

licable.			TRACT	TABLE	
$\searrow$	TRACT	SIZE (ACRES)	OWNERSHIP/ MAINTENANCE	USE	
	A	0.265	LRMD/LRMD	DRAINAGE/PUBLIC IMPROVEMENT/PUBLIC UTILITY/LANDSCAPING/SIGNAGE	
	В	0.040	LRMD/LRMD	DRAINAGE/PUBLIC IMPROVEMENT/PUBLIC UTILITY/LANDSCAPING/SIGNAGE	
	С	3.703	LRMD/LRMD	DRAINAGE/PUBLIC IMPROVEMENT/PUBLIC UTILITY/DETENTION POND/OPEN SPACE	
	D	1.106	LRMD/LRMD	DRAINAGE/PUBLIC IMPROVEMENT/PUBLIC UTILITY/OPEN SPACE/SIGNAGE	
	E	11.106	LRMD/LRMD	DRAINAGE/PUBLIC IMPROVEMENT/PUBLIC UTILITY/OPEN SPACE	
0.225 —	F	0.485	LRMD/LRMD	DRAINAGE/PUBLIC IMPROVEMENT/PUBLIC UTILITY/LANDSCAPING/SIGNAGE	
IONAL LAND SURVEYOR IN THE	C	7.823	LRMD/LRMD	DRAINAGE/PUBLIC IMPROVEMENT/PUBLIC UTILITY/DETENTION POND/OPEN SPACE	
HIS PLAT TRULY AND CORRECTLY NOVEMBER 02, 2017 BY ME OR NUMENTS EXIST AS SHOWN	Н	0.228	LRMD/LRMD	DRAINAGE/PUBLIC IMPROVEMENT/PUBLIC UTILITY/LANDSCAPING/SIGNAGE	
RE LESS THAN 1:10,000 ; AND PLIANCE WITH ALL APPLICABLE	I	25.265	LRMD/LRMD	DRAINAGE/PUBLIC IMPROVEMENT/PUBLIC UTILITY/LANDSCAPING/SIGNAGE	
ONUMENTS, SUBDIVISION, OR NS OF THE EL PASO COUNTY	J	26.265	WIDEFIELD SCHOOL DISTRICT 3	FUTURE SCHOOL	
<b>0.228</b> — , 2018.	K	0.555	LRMD/LRMD	DRAINAGE/PUBLIC IMPROVEMENT/PUBLIC UTILITY/LANDSCAPING/SIGNAGE	
25.265 —	L	0.052	LRMD/LRMD	DRAINAGE/PUBLIC IMPROVEMENT/PUBLIC UTILITY/OPEN SPACE	
	М	0.152	LRMD/LRMD	DRAINAGE/PUBLIC IMPROVEMENT/PUBLIC UTILITY/OPEN SPACE	
	N	0.303	LRMD/LRMD	DRAINAGE/PUBLIC IMPROVEMENT/PUBLIC UTILITY/OPEN SPACE	
	0	0.303	LRMD/LRMD	DRAINAGE/PUBLIC IMPROVEMENT/PUBLIC UTILITY/OPEN SPACE	
	P	0.234	LRMD/LRMD	DRAINAGE/PUBLIC IMPROVEMENT/PUBLIC UTILITY/OPEN SPACE	
AL ACTION BASED UPON ANY DEFECT IN SUCH DEFECT. IN NO EVENT, MAY ANY	Q	0.234	LRMD/LRMD	DRAINAGE/PUBLIC IMPROVEMENT/PUBLIC UTILITY/OPEN SPACE	
D MORE THAN TEN YEARS FROM THE	R	0.303	LRMD/LRMD	DRAINAGE/PUBLIC IMPROVEMENT/PUBLIC UTILITY/OPEN SPACE	
	S	0.303	LRMD/LRMD	DRAINAGE/PUBLIC IMPROVEMENT/PUBLIC UTILITY/OPEN SPACE	
	Т	0.145	LRMD/LRMD	DRAINAGE/PUBLIC IMPROVEMENT/PUBLIC UTILITY/OPEN SPACE	
CERTIFICATE:	LRMD = LC	DRSON RANCH I	METRO DISTRICT		
TO ANY NOTES SPECIFIED SOLUTION OF APPROVAL. THE IREETS, <b>TRACTS A</b> ND ENTS THEREON WILL NOT PASO COUNTY UNTIL EMENTS IN ACCORDANCE WITH ODE AND ENGINEERING CRITERIA REEMENT.		Provide tota in table as a correct the t acreage.	tool to		
KEEMENT.		nty is not epting these t	racts		
DATE					
RANCH EAST FILING NO. 1" ON , 2018, A.D.	<u>SUMMAR</u>				
MMUNITY DEVELOPMENT	303 LOTS 20 TRACTS RIGHTS-OF- TOTAL	<mark>5</mark> WAY 3	1.500 ACRES       32.8         2.830 ACRES       41.8         1.925 ACRES       25.2         6.255 ACRES       100.0	34%I averaged about 7929%acres in tracts	
	FEES:			and drainage tracts please.	
	DRAINAGE F		CREDITS USED TH		
	JIMMY CAMI SURETY FEI				
	BRIDGE FEE			CREDITS USED THIS FILING \$ 44,433.00	
		<b>_</b> ·		RECEPTION NO. 212042170	
FOR RECORD AT MY OFFICE	SCHOOL FE PARK FEE:				
	JIMMY CAMI SURETY FEI	P CREEK E:	CREDITS USED TH	IIS FILING \$ 44,433.00 IR THE SCHOOL LAND AGREEMENT	

CIVIL CONSULTANTS, INC.

SHEET 1 OF 11

### SURVEY NOTES:

1. BASIS OF BEARING: THE SOUTH LINE OF SECTION 14, T15S, R65W, OF THE 6TH P.M. EL PASO COUNTY, COLORADO AS MONUMENTED. THE QUARTER CORNER COMMON TO SECTION14 AND SECTION 23 IS A 3.25 INCH ALUMINUM CAP STAMPED "KM, T15S R65W, 1/4 S14 S23, 2004, PLS 16109" FROM WHICH THE SOUTHEAST CORNER OF SECTION 14 BEARS N89°43'11"E, 2647.09 FEET AND IS MONUMENTED BY A 3.25 IN ALUMINUM CAP STAMPED "KM, T15S R65W, 14, 13, 23,24, 2004, LS 16109". THE UNIT OF MEASUREMENTS IS THE U.S. SURVEY FOOT.

2. THE FLOOD INSURANCE RATE MAP (FIRM) PANEL NO. 08041CO957F AND PANEL NO. 08041CO1000F, BOTH DATED MARCH 17, 1997 REVISED TO REFLECT CLOMR CASE NO. 06-08-8425R, EFFECTIVE DATE JANUARY 17, 2007 AND LOMC 14-08-053P, EFFECTIVE DATE JANUARY 28, 2015 HAS BEEN EXAMINED AS IT RELATES TO THE PROPERTY BEING PLATTED. THE REVISED AND AMENDED FLOODPLAIN LIMITS ARE AS SHOWN HEREON.

3. A COMMITMENT FOR TITLE INSURANCE ISSUED BY UNIFIED TITLE COMPANY, LLC AS AGENT FOR STEWART TITLE GUARANTY COMPANY WITH AN EFFECTIVE DATE OF FEBRUARY 22, 2018 AT 7:30AM, FILE NO. 55463 UTC, AMENDMENT NO. 1, HAS BEEN EXAMINED AS IT RELATES TO THE PROPERTY BEING PLATTED.

i. A RESERVATION BY THE LEAGUE LAND COMPANY, FOR ITSELF, ITS SUCCESSORS AND ASSIGNS, OF A RIGHT OF WAY ACROSS ALL OF THE LAND FOR SUCH LATERAL DITCHES AS MAYBE NECESSARY TO ENABLE THE COMPANY AND ITS SUCCESSORS AND ASSIGNS TO CONVEY AND SUPPLY WATER FROM ITS RESERVOIRS, CANALS AND MAIN LATERALS TO LANDS LYING BEYOND THE DESCRIBED TRACT, AS DESCRIBED IN DEED RECORDED AUGUST 28, 1922 IN BOOK 683 AT PAGE 88.

ii. THE PROPERTY MAY BE SUBJECT TO ANY ASSESSMENT OR LIEN OF FOUNTAIN VALLEY SOIL CONSERVATION DISTRICT AS DISCLOSED BY THE INSTRUMENT RECORDED JUNE 21, 1943 AT RECEPTION NO. 683031.

iii. THE PROPERTY MAY BE SUBJECT TO TERMS, AGREEMENTS, PROVISIONS, CONDITIONS, OBLIGATIONS AND EASEMENTS AS CONTAINED IN EASEMENT TO PUBLIC SERVICE COMPANY OF COLORADO, RECORDED AUGUST 20, 1964 IN BOOK 2030 AT PAGE 238.

iv. THE PROPERTY MAY BE SUBJECT TO TERMS, AGREEMENTS, PROVISIONS, CONDITIONS. OBLIGATIONS AND EASEMENTS AS CONTAINED IN EASEMENT. RECORDED APRIL 1, 1974 IN BOOK 2665 AT PAGE 715 AND ASSIGNMENT RECORDED JULY 27, 1976 IN BOOK 2846 AT PAGE 719.

v. THE PROPERTY MAY BE SUBJECT TO TERMS, AGREEMENTS, PROVISIONS, CONDITIONS, OBLIGATIONS AND EASEMENTS AS CONTAINED IN RIGHT-OF-WAY EASEMENT TO MOUNTAIN VIEW ELECTRIC ASSOCIATION, INC., RECORDED MARCH 7, 1983 IN BOOK 3684 AT PAGE 492. (DESCRIPTION IS VAGUE, LOCATION IS UNKNOWN)

VI. THE PROPERTY MAY BE SUBJECT TO ANY ASSESSMENT OR LIEN, BY REASON OF INCLUSION WITHIN THE SECURITY FIRE PROTECTION DISTRICT AS DISCLOSED BY ORDER OF INCLUSION RECORDED IN BOOK 5258 AT PAGE 1049 AND RECORDED JULY 31, 2013 AT RECEPTION NO. 213098578.

VII. THE PROPERTY MAY BE SUBJECT TO ANY ASSESSMENT OR LIEN OF WIDEFIELD WATER & SANITATION DISTRICT AS DISCLOSED BY THE INSTRUMENT RECORDED JUNE 20, 2005 AT RECEPTION NO. 205091663.

viii. THE PROPERTY MAY BE SUBJECT TO TERMS, AGREEMENTS, PROVISIONS, CONDITIONS AND OBLIGATIONS AS CONTAINED IN RESOLUTION NO. 04-366. BY AND BEFORE THE BOARD OF COUNTY COMMISSIONERS, COUNTY OF EL PASO, STATE OF COLORADO, RECORDED SEPTEMBER 3, 2004 AT RECEPTION NO. 204150548. RESOLUTION NO. 05-336, APPROVING DEVELOPMENT AGREEMENT, BY AND BEFORE THE BOARD OF COUNTY COMMISSIONERS, COUNTY OF EL PASO, STATE OF COLORADO, RECORDED AUGUST 24, 2005 AT RECEPTION NO. 205131973. CORRECTED VERSION OF SAID RESOLUTION NO. 05-336 IN CONNECTION THEREWITH RECORDED AUGUST 25, 2005 AT RECEPTION NC 205132869. RESOLUTION NO. 07-223, APPROVING AMENDED SERVICE PLAN, LORSON RANCH METROPOLITAN DISTRICTS 1-7, BY AND BEFORE THE BOARD OF COUNTY COMMISSIONERS, COUNTY OF EL PASO, STATE OF COLORADO, RECORDED JULY 17, 2007 AT RECEPTION NO. 207095523. RESOLUTION NO. 07-356 RECORDED SEPTEMBER 11, 2007 AT RECEPTION NO. 207118189. DEVELOPMENT AGREEMENT NO. 1 LORSON RANCH, IN CONNECTION THEREWITH RECORDED AUGUST 19, 2005 AT RECEPTION NO. 205128925. DEVELOPMENT AGREEMENT NO. 2, LORSON RANCH, IN CONNECTION THEREWITH RECORDED MAY 22, 2010 AT RECEPTION NO. 210025931 AND RERECORDED APRIL 20, 2010 AT RECEPTION NO. 210036301. RESOLUTION NO. 10-94 TO REVISE DEVELOPMENT AGREEMENT, BY AND BEFORE THE BOARD OF COUNTY COMMISSIONERS, COUNTY OF EL PASO, STATE OF COLORADO, RECORDED OCTOBER 12, 2010 AT RECEPTION NO. 210101176. RESOLUTION NO. 12-335 APPROVING INTERGOVERNMENTAL AGREEMENT CONCERNING THE MARKSHEFFEL ROAD/FONTAINE BOULEVARD INTERSECTION, RECORDED SEPTEMBER 26, 2012 AT RECEPTION NO. 212112804. ANNUAL REPORT AND DISCLOSURE FORM RECORDED SEPTEMBER 7, 2007 AT RECEPTION NO. 207116859; RECORDED OCTOBER 30, 2013 AT RECEPTION NO. 213134075, GENERAL DISCLOSURE RECORDED JULY 11, 2017 AT RECEPTION NO. 217080960.

ix. THE PROPERTY MAY BE SUBJECT TO ANY FEE, TAX, LIEN OR ASSESSMENT BY REASON OF INCLUSION WITHIN THE LORSON RANCH METROPOLITAN DISTRICT NO. 3, AS SET FORTH IN ORDER AND DECREE ORGANIZING SAID DISTRICT RECORDED DECEMBER 2, 2004 AT RECEPTION NO. 204197513. AMENDED ORDER AND DECREE IN CONNECTION THEREWITH RECORDED DECEMBER 2, 2004 AT RECEPTION NO. 204197520. ORDER OF INCLUSION IN CONNECTION THEREWITH RECORDED DECEMBER 28, 2004 AT RECEPTION NO. 204209874; RECORDED APRIL 15, 2005 AT RECEPTION NO. 205053570, RECORDED APRIL 21, 2005 AT RECEPTION NO. 205056110 AND AT RECEPTION NO. 205056116; AND RECORDED APRIL 21, 2005 AT RECEPTION NO. 205056117. NOTICE OF SPECIAL DISTRICT AUTHORIZATION OF ISSUANCE OF GENERAL OBLIGATION INDEBTEDNESS, IN CONNECTION THEREWITH RECORDED NOVEMBER 23, 2004 AT RECEPTION NO. 204192908. ORDER AND DECREE OF CORRECTION RECORDED JUNE 17, 2015 AT RECEPTION NO. 215062852, RECORDED MAY 26, 2016 AT RECEPTION NO. 216056939, RECORDED SEPTEMBER 11, 2017 AT RECEPTION NO. 217109165.

X. THE PROPERTY MAY BE SUBJECT TO ANY FEE, TAX, LIEN OR ASSESSMENT BY REASON OF INCLUSION WITHIN THE LORSON RANCH METROPOLITAN DISTRICT NO. 4, AS SET FORTH IN ORDER AND DECREE ORGANIZING SAID DISTRICT AS EVIDENCED BY INSTRUMENTS RECORDED DECEMBER 2, 2004 AT RECEPTION NO. 204197514, RECORDED DECEMBER 28, 2004 AT RECEPTION NO. 204209875, RECORDED APRIL 15, 2005 AT RECEPTION NO. 205053571, RECORDED APRIL 21, 2005 AT RECEPTION NO. 205056111 AND AT RECEPTION NO. 205056117 AND RECORDED SEPTEMBER 11, 2017 AT RECEPTION NO. 217109166.

XI. THE PROPERTY MAY BE SUBJECT TO ANY FEE, TAX, LIEN OR ASSESSMENT BY REASON OF INCLUSION WITHIN THE LORSON RANCH METROPOLITAN DISTRICT NO. 5, AS SET FORTH IN ORDER AND DECREE ORGANIZING SAID DISTRICT AS EVIDENCED BY INSTRUMENTS RECORDED DECEMBER 2, 2004 AT RECEPTION NO. 204197515, RECORDED DECEMBER 28, 2004 AT RECEPTION NO. 204209876, RECORDED APRIL 15, 2005 AT RECEPTION NO. 205053572, RECORDED APRIL 21, 2005 AT RECEPTION NO. 205056112 AND AT RECEPTION NO. 205056118, RECORDED MAY 9, 2006 AT RECEPTION NO. 206068332,

xii. THE PROPERTY MAY BE SUBJECT TO TERMS, CONDITIONS, PROVISION, AGREEMENTS AND OBLIGATIONS CONTAINED IN THE INCLUSION & SERVICE AGREEMENT BETWEEN WIDEFIELD WATER & SANITATION DISTRICT AND LORSON LLC RECORDED ON MAY 31, 2005 AT RECEPTION NO. 205078708. xiii. THE PROPERTY MAY BE SUBJECT TO TERMS, AGREEMENTS, PROVISIONS, CONDITIONS, OBLIGATIONS AND EASEMENTS AS CONTAINED IN SANITARY SEWER EASEMENT AGREEMENT, RECORDED MAY 14, 2008 AT RECEPTION NO. 208055334.

#### SURVEY NOTES: (CONT.)

XIV. THE PROPERTY MAY BE SUBJECT TO TERMS CONDITIONS, OBLIGATIONS AND EASEMENTS AS CO EASEMENT, RECORDED APRIL 23, 2013 AT RECEPT XV. THE PROPERTY MAY BE SUBJECT TO TERMS, CONDITIONS, OBLIGATIONS AND EASEMENTS AS CO DELIVERY SYSTEM EASEMENT AGREEMENT, RECOR AT RECEPTION NO. 215101175 AND AT RECEPTION

xvi. THE PROPERTY MAY BE SUBJECT TO MATTERS CONTAINED IN THE LORSON RANCH OVERALL DEVE PLAN MAP RECORDED MAY 9, 2006 AT RECEPTION RECORDED DECEMBER 28, 2006 AT RECEPTION NO. xvii. THE PROPERTY MAY BE SUBJECT TO TERMS, CONDITIONS, OBLIGATIONS AND EASEMENTS AS CO SANITARY SEWER EASEMENT AGREEMENT(S), REC RECEPTION NO. 208067502; AT RECEPTION NO. 2080 208067532: AT RECEPTION NO. 208067534: AT RECEPTION AT RECE RECEPTION NO. 208067648 AND THE TERMS, AGRE CONDITIONS, OBLIGATIONS AND EASEMENTS AS CO CONSTRUCTION EASEMENT AGREEMENT(S), RECOR RECEPTION NO. 208067652: AT RECEPTION NO. 2080 208067657: AT RECEPTION NO. 208067667: AT RECEPTION NO. 208067657: AT RECEPTION NO. 208067667: AT RECEPTION AT RE RECEPTION NO. 208067676.

xviii. TERMS, AGREEMENTS, PROVISIONS, CONDITIO CONTAINED IN PIONEER LANDING AT LORSON RANG UNIT DEVELOPMENT GUIDELINES RECORDED DECE RECEPTION NO. 209141654.

xix. THE PROPERTY MAY BE SUBJECT TO TERMS, A CONDITIONS, OBLIGATIONS AND EASEMENTS AS CO ENTRY TO THE COLORADO SPRINGS UTILITIES (SOL RECORDED FEBRUARY 24, 2012 AT RECEPTION NO. RECEPTION NO. 212020137. CITY OF COLORADO SPE AGREEMENT (SOUTHERN DELIVERY SYSTEM), RECO RECEPTION NO. 213027535.

XX. THE PROPERTY MAY BE SUBJECT TO TERMS. AC CONDITIONS AND OBLIGATIONS AS CONTAINED IN F AND BEFORE THE BOARD OF COUNTY COMMISSION STATE OF COLORADO, REGARDING SCHOOL SITE D RECORDED APRIL 13, 2012 AT RECEPTION NO. 21204 xxi. THE PROPERTY MAY BE SUBJECT TO TERMS, A CONDITIONS AND OBLIGATIONS AS CONTAINED IN AGREEMENT RECORDED JULY 27, 2012 AT RECEPT XXII. THE PROPERTY MAY BE SUBJECT TO TERMS, CONDITIONS AND OBLIGATIONS AS CONTAINED IN AND BEFORE THE BOARD OF COUNTY COMMISSION STATE OF COLORADO, ADOPTING THE EL PASO CO PROGRAM, RECORDED NOVEMBER 15, 2012 AT REC xxiii. THE PROPERTY MAY BE SUBJECT TO TERMS. CONDITIONS AND OBLIGATIONS AS CONTAINED IN AND BEFORE THE BOARD OF COUNTY COMMISSION STATE OF COLORADO RECORDED APRIL 13, 2016 AT xxiv THE PROPERTY MAY BE SUBJECT TO TERMS, CONDITIONS AND OBLIGATIONS AS CONTAINED IN

AND BEFORE THE BOARD OF COUNTY COMMISSIO STATE OF COLORADO, APPROVAL OF REZONE, REC RECEPTION NO. 216070955.

XXV THE PROPERTY MAY BE SUBJECT TO TERMS, A CONDITIONS AND OBLIGATIONS AS CONTAINED IN F AND BEFORE THE BOARD OF COUNTY COMMISSION STATE OF COLORADO, APPROVAL OF PRELIMINARY 2016 AT RECEPTION NO. 216070956; RESOLUTION NO. THE BOARD OF COUNTY COMMISSIONERS, COUNTY COLORADO, APPROVAL OF FINAL PLAN, RECORDED RECEPTION NO. 216098747.

xxvi THE PROPERTY MAY BE SUBJECT TO MATTERS CONTAINED IN THE LORSON RANCH, PIONEER LAND PUD DEVELOPMENT PLAN MAP RECORDED JULY 14, 216077631 AND RECORDED FEBRUARY 2, 2017 AT RE xxvii THE PROPERTY MAY BE SUBJECT TO TERMS, CONDITIONS AND OBLIGATIONS AS CONTAINED IN F RECORDED AUGUST 24, 2016 AT RECEPTION NO. 21

SEPTEMBER 30, 2016 AT RECEPTION NO. 216113012. xxviii THE PROPERTY MAY BE SUBJECT TO TERMS, CONDITIONS AND OBLIGATIONS AS CONTAINED IN F AND BEFORE THE BOARD OF COUNTY COMMISSION STATE OF COLORADO, APPROVING A PETITION FOR WITHIN THE DISTRICT - PIONEER LANDING FILING N 15, 2016 AT RECEPTION NO. 216145947.

xxix. THE PROPERTY MAY BE SUBJECT TO TERMS, CONDITIONS, OBLIGATIONS AND EASEMENTS AS CO OF WAY MAILBOX LICENSE AGREEMENT, RECORDED RECEPTION NO. 217001494.

XXX. THE PROPERTY MAY BE SUBJECT TO TERMS, CONDITIONS, OBLIGATIONS AND EASEMENTS AS CO OF WAY LANDSCAPE LICENSE AGREEMENT, RECOR RECEPTION NO. 217001495.

xxxi. THE PROPERTY MAY BE SUBJECT TO TERMS, CONDITIONS, OBLIGATIONS AND EASEMENTS AS CO DETENTION BASIN/STORMWATER QUALITY BEST MA MAINTENANCE AGREEMENT AND EASEMENT, RECO RECEPTION NO. 217001496.

XXXII. THE PROPERTY MAY BE SUBJECT TO TERMS, CONDITIONS AND OBLIGATIONS AS CONTAINED IN S AGREEMENT RECORDED JANUARY 5, 2017 AT RECE XXXIII. THE PROPERTY MAY BE SUBJECT TO COVENA RESTRICTIONS AND EASEMENTS, IF ANY, WHICH DC FORFEITURE OR REVERTER CLAUSE, (DELETING AN ANY PREFERENCE, LIMITATION OR DISCRIMINATION RELIGION, SEX, HANDICAP, FAMILIAL STATUS OR NA CONTAINED IN INSTRUMENT RECORDED JANUARY 217001508 AND ANY AND ALL AMENDMENTS AND/OR xxxiv. THE PROPERTY MAY BE SUBJECT TO EASEME AS SET FORTH ON THE PLAT OF SUBDIVISION RECC RECEPTION NO. 217713888.

XXXV. THE PROPERTY MAY BE SUBJECT TO TERMS, CONDITIONS AND OBLIGATIONS AS CONTAINED IN F RECORDED JANUARY 24, 2018 AT RECEPTION NO. 2 XXXVI. THE PROPERTY MAY BE SUBJECT TO MATTER LORSON RANCH EAST PUD DEVELOPMENT & PREL FEBRUARY 15, 2018 AT RECEPTION NO. 218018251.

# LORSON RANCH EAST FILING NO. 1

A PORTION OF THE SOUTHWEST QUARTER (SW 1/4) SECTION 13, AND A PORTION OF THE SOUTHEAST QUARTER (SE 1/4) SECTION 14, A PORTION OF THE NORTHEAST QUARTER (NE 1/4) SECTION 23, AND A PORTION OF THE NORTHWEST QUARTER (NW 1/4) SECTION 24, TOWNSHIP 15 SOUTH, RANGE 65 WEST OF THE SIXTH PRINCIPAL MERIDIAN, EL PASO COUNTY, COLORADO

	SURVEY NOTES: (CONT.)	Are these survey notes?	
S, AGREEMENTS, PROVISIONS, CONTAINED IN DRAINAGE		SHALL BE LOCATED AND DESIGNED BY A ITLY REGISTERED IN THE STATE OF COLORADO.	
TION NO. 213052476.	5. THE FOLLOWING REPORTS HAVE I	BEEN SUBMITTED AND ARE ON FILE AT THE EL	
CONTAINED IN WATER ORDED SEPTEMBER 16, 2015 N NO. 215101176.	NUMBER PUD, SO WATER RESOURCES REPORT, FIRE I	<b>TEES DEPARTMENT; PRELIMINARY PLAN FILE</b> ILS AND GEOLOGICAL STUDY, DRAINAGE REPOR PROTECTION REPORT, NATURAL FEATURES LTS, EROSION CONTROL REPORT AND TRAFFIC	łΤ,
RS AS SET FORTH AND	IMPACT ANALYSIS.	ON RANCH EAST FILING NO. 1" SHALL COMPLY	correct name and
N NO. 206035127 AND IO. 206187069.	WITH THE PUD DEVELOPMENT GUID	ELINES ON FILE FOR LORSON RANCH EAST ELINES AS RECORDED AT RECEPTION NO.	
S, AGREEMENTS, PROVISIONS, CONTAINED IN WATER AND	OF THE RECORDS OF	THE EL PASO COUNTY CLERK AND RECORDER, SO COUNTY FOLLOWING APPROPRIATE PUBLIC	
ECORDED JUNE 12, 2008 AT 08067503; AT RECEPTION NO.	HEARINGS.	/	
EPTION NO. 208067645; AT EEMENTS, PROVISIONS,	DESIGNATED DRAINAGE EASEMENTS	FORAGE ACTIVITIES ARE PERMITTED WITHIN / S, FLOODPLAIN, OR PARK AND OPEN SPACE	
CONTAINED IN TEMPORARY CORDED JUNE 12, 2008 AT		E RUNOFF FROM REACHING DRAINAGE SWALES. HIS PLAT ARE FOR INFORMATIONAL PURPOSES	Gazebos are not
08067656; AT RECEPTION NO. CEPTION NO. 208067672; AND AT	ONLY. THEY ARE NOT THE LEGAL DE	ESCRIPTION AND ARE SUBJECT TO CHANGE.	allowed? as shown? in accordance
FIONS AND OBLIGATIONS AS		S <del>SHALL BE MAINTAINED AT THE INTERSECTIONS</del> 8" IN HEIGHT IS ALLOWED IN THESE AREAS.	with EPC ECM?
NCH SUBDIVISION PLANNED CEMBER 10, 2009 AT	10. ALL PROPERTY OWNERS ARE RE WATER DRAINAGE IN AND THROUGH	SPONSIBLE FOR MAINTAINING PROPER STORM	
, AGREEMENTS, PROVISIONS,		AND UNITED STATES POSTAL SERVICE	
CONTAINED IN RIGHT OF OUTHERN DELIVERY SYSTEM),	REGULATIONS.	<i></i> ۲۲	Public Works
O. 212020136; AND AT SPRINGS POSSESSION AND USE ECORDED MARCH 1, 2013 AT	WHETHER BY DEED OR BY CONTRAC UNTIL AND UNLESS THE REQUIRED F	SHALL BE SOLD, CONVEYED OR TRANSFERRED CT, NOR SHALL BUILDING PERMITS BE ISSUED, PUBLIC IMPROVEMENTS HAVE BEEN ACCORDANCE WITH THE SUBDIVISION	
AGREEMENTS, PROVISIONS,		EEN THE APPLICANT AND EL PASO COUNTY AS	
N RESOLUTION NO. 12-126, BY ONERS, COUNTY OF EL PASO,	RECORDS OF THE EL PASO COUNTY	CLERK AND RECORDER, OR IN THE ALTERNATIV /HICH IS SUFFICIENT IN THE JUDGMENT OF THE	′Ε,
E DEDICATION AGREEMENT 2042170.		S, TO MAKE PROVISION FOR THE COMPLETION C	)F
, AGREEMENTS, PROVISIONS, N SCHOOL SITE DEDICATION	13. THE DECLARATION OF COVENAN	TS, CONDITIONS AND RESTRICTIONS FOR	
PTION NO. 212047863. S, AGREEMENTS, PROVISIONS,	UNDER RECEPTION NO.	HOMEOWNERS ASSOCIATION, INC. IS RECORDE	:D
N RESOLUTION NO. 12-382, BY ONERS, COUNTY OF EL PASO,	COUNTY CLERK AND RECORDER. 14. THE PROPERTY IS SUBJECT TO T	ERMS, AGREEMENTS, PROVISIONS, CONDITIONS	5,
COUNTY ROAD IMPACT FEE ECEPTION NO. 212136575.		CONTAINED IN PRIVATE DETENTION BASIN/ GEMENT PRACTICE MAINTENANCE AGREEMENT	
S, AGREEMENTS, PROVISIONS, N RESOLUTION NO. 16-118, BY	AND EASEMENT RECORDED UNDER	RECEPTION NO	
ONERS, COUNTY OF EL PASO, AT RECEPTION NO. 216037512.		DPMENT GUIDELINES AND DESIGN GUIDELINES	– Parks and
S, AGREEMENTS, PROVISIONS, N RESOLUTION NO. 16-228, BY		H FEDERAL AND STATE LAWS <del>, RE</del> GULATIONS, REQUIREMENTS <del>, AND</del> OTHER AGENCY	
ONERS, COUNTY OF EL PASO, ECORDED JUNE 29, 2016 AT	REQUIREMENTS, IF ANY, OF APPEIC	ABLE AGENCIES INCLUDING, BUT NOT LIMITED TO ILDLIFE, COLORADO DEPARTMENT OF	),
, AGREEMENTS, PROVISIONS, N RESOLUTION NO. 16-229, BY	TRANSPORTATION, U.S. ARMY CORP	. OF ENGINEERS, THE U.S. FISH AND WILDLIFE RTMENT OF WILDLIFE REGARDING THE	
ONERS, COUNTY OF EL PASO, RY PLAN, RECORDED JUNE 29,	ENDANGERED SPECIES ACT, AS IT R	ELATES TO THE LISTED SPECIES.  SERVICES DEPARTMENT ENGINEERING MUST E	
NO. 16-313, BY AND BEFORE ITY OF EL PASO, STATE OF	CONTACTED PRIOR TO THE ESTABLI	SHMENT OF ANY DRI∀E₩AY.	
ED AUGUST 30, 2016 AT	A. DEVELOPMENT AGREEMENT N	HE FOLLOWING DEVELOPMENT AGREEMENTS:	
RS AS SET FORTH AND NDING FILING NO. 2 AND NO. 3,	APPROVED BY RESOLUTION NO. 0 CORRECTED - RECEPTION NO. 205	5-336, RECEPTION NO. 205131973 AS 5132869.	
14, 2016 AT RECEPTION NO. RECEPTION NO. 217013429.	B. DEVELOPMENT AGREEMENT NO RE-RECORDED RECEPTION NO. 21	,	
S, AGREEMENTS, PROVISIONS, N RESOLUTION NO. 16-307		O. 3 RECEPTION NO	
216095697 AND RE-RECORDED 12.			D.A. No. 6
S, AGREEMENTS, PROVISIONS, N RESOLUTION NO. 16-456, BY	E. DEVELOPMENT AGREEMENT NO F. SCHOOL SITE DEDICATION AGR	2.5 RECEPTION NO. 214007624. REEMENT RECEPTION NO. 212047863.	(Contract 2015-091a
ONERS, COUNTY OF EL PASO, OR INCLUSION OF PROPERTY	18. PURSUANT TO RESOLUTION BOARD OF DIRECTORS. EL PASO CO	, APPROVED BY THE UNTY PUBLIC IMPROVEMENT DISTRICT 2 AND	3/3/2015)
NO. 2 RECORDED DECEMBER		E EL PASO COUNTY CLERK AND RECORDER AT , THE PARCELS WITHIN THE PLATTED	,
S, AGREEMENTS, PROVISIONS, CONTAINED IN PUBLIC RIGHT		AST FILING NO. 1" ARE INCLUDED WITHIN THE	
DED JANUARY 5, 2017 AT	SUCH IS SUBJECT TO APPLICABLE R	OAD IMPACT FEES AND MILL LEVY.	
S, AGREEMENTS, PROVISIONS, CONTAINED IN PUBLIC RIGHT	Add:		
ORDED JANUARY 5, 2017 AT		rson Boulevard and Fontaine I	
S, AGREEMENTS, PROVISIONS, CONTAINED IN PRIVATE		d K) are reserved for potential roads. The Lorson Ranch Me	· · · · · · · · · · · · · · · · · · ·
MANAGEMENT PRACTICE CORDED JANUARY 5, 2017 AT		and maintain these tracts until	
S, AGREEMENTS, PROVISIONS,		quests the deeds conveying th	
N SUBDIVISION IMPROVEMENTS CEPTION NO. 217001497.	-	for right-of-way purposes to El	-
NANTS, CONDITIONS, DO NOT CONTAIN A	-	<ol> <li>El Paso County, its agent(s) and construct roadway improv</li> </ol>	<b>.</b>
ANY RESTRICTIONS INDICATING ON BASED ON RACE, COLOR,		at the County's sole discretion	
NATIONAL ORIGIN) AS Y 5, 2017 AT RECEPTION NO.	-	n the acquired right-of-way sha	
OR SUPPLEMENTS THERETO. EMENTS, NOTES AND NOTICES	-	n Ranch Metropolitan District I	
CORDED JANUARY 5, 2017 AT	•	eement allowing maintenance of-way within Lorson Ranch E	
IS, AGREEMENTS, PROVISIONS, N RESOLUTION NO. 18-038	1.	or way within LUISUI NAIICH E	
. 218009074. TERS AS SHOWN ON THE			
LIMINARY PLAN RECORDED 1.			




FINAL PLAT LORSON RANCH EAST FILING NO. 1 JOB NO. 70-055 DATE PREPARED: 12/06/2017 DATE REVISED: 01/29/2018




20 BOULDER CRESCENT, SUITE 11 COLORADO SPRINGS, CO 80903 PHONE: 719.955.5485

CIVIL CONSULTANTS, INC.


SHEET 2 OF 11

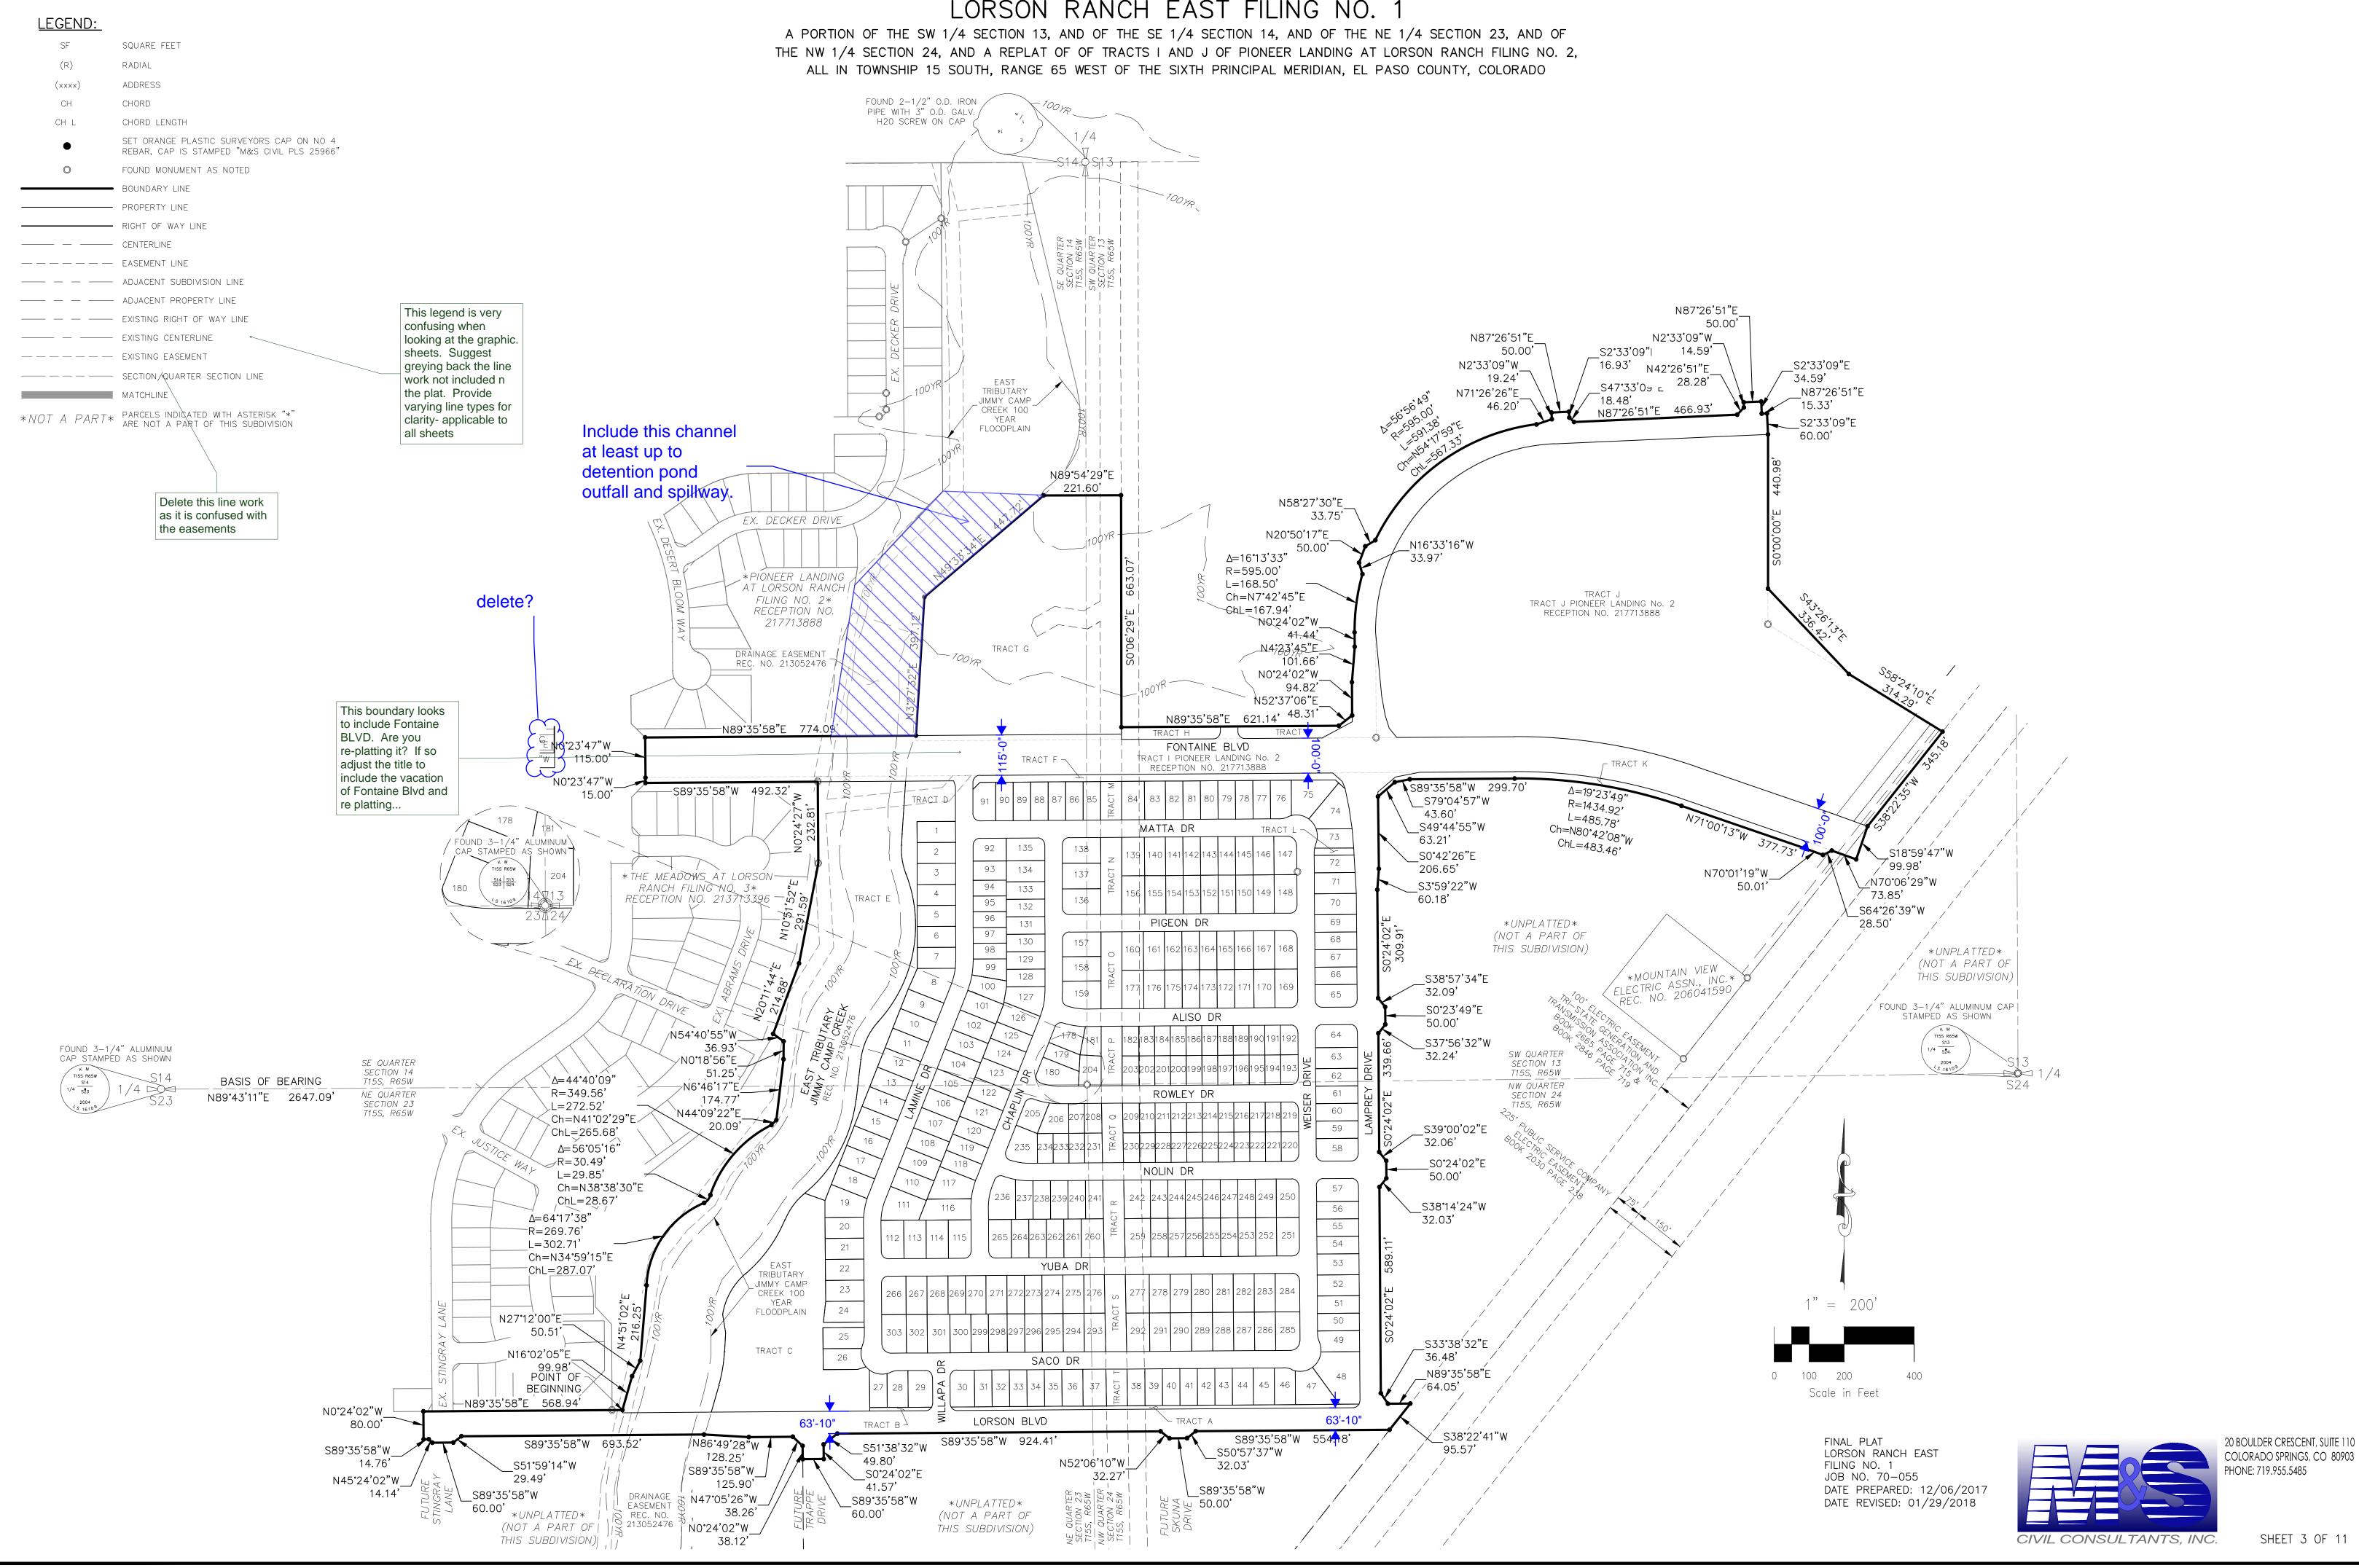

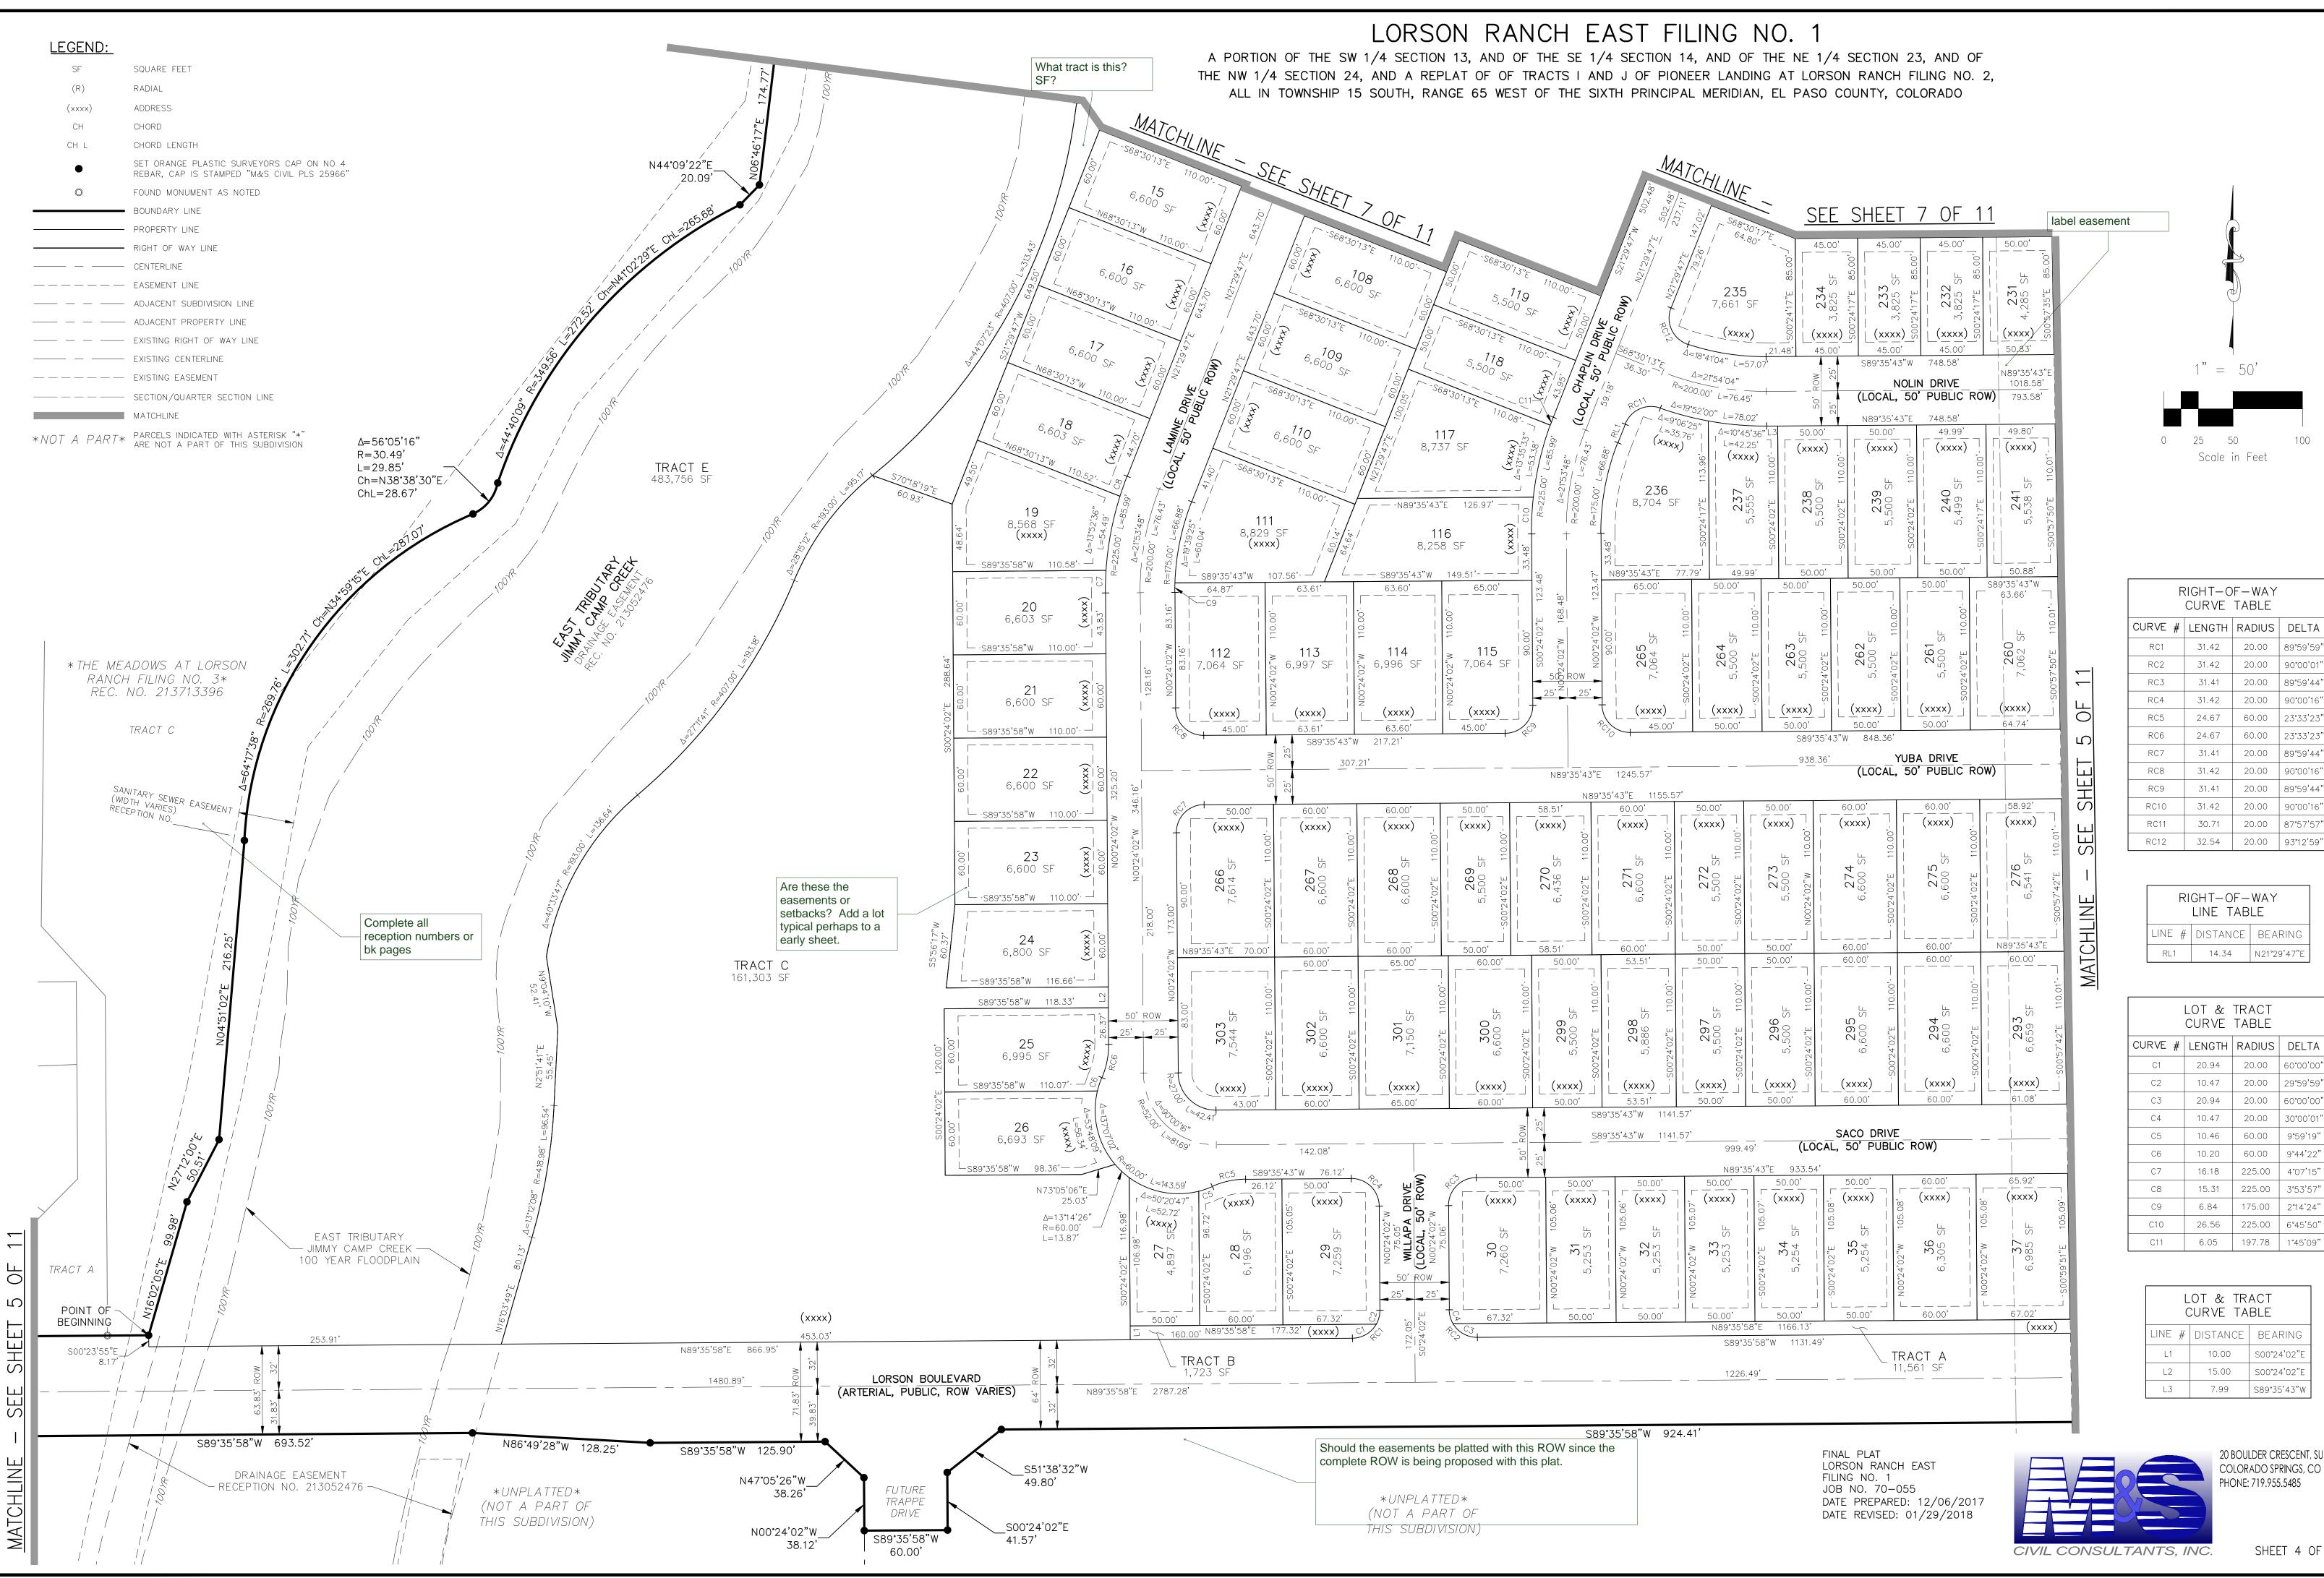

20 BOULDER CRESCENT, SUITE 11 COLORADO SPRINGS, CO 80903 PHONE: 719.955.5485


100

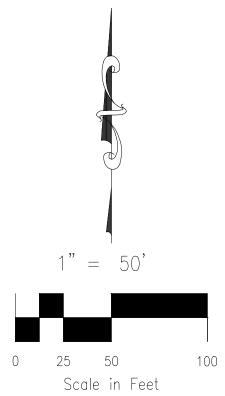

RIGHT-OF-WAY CURVE TABLE					
CURVE #	LENGTH	RADIUS	DELTA		
RC13	31.42	20.00	89°59'59"		
RC14	24.67	60.00	23°33'23"		
RC15	24.67	60.00	23°33'23"		
RC16	31.42	20.00	90°00'16"		
RC17	31.41	20.00	89°59'44"		
RC18	31.42	20.00	90°00'16"		
RC19	31.41	20.00	89°59'44"		
RC20	31.42	20.00	90°00'16"		
RC21	31.41	20.00	89°59'44"		
RC22	31.42	20.00	90°00'16"		
RC23	31.41	20.00	89°59'44"		

LOT & TRACT CURVE TABLE					
CURVE #	LENGTH	RADIUS	DELTA		
C12	20.94	20.00	60°00'00"		
C13	10.47	20.00	29°59'59"		
C14	10.22	60.00	9°45'33"		
C15	29.67	60.00	28°19'56"		

<u>LEGEND:</u>		
SF	SQUARE FEET	
(R)	RADIAL	
(xxxx)	ADDRESS	
СН	CHORD	
CH L	CHORD LENGTH	
٠	SET ORANGE PLASTIC SURVEYORS CAP ON I REBAR, CAP IS STAMPED "M&S CIVIL PLS 2	
0	FOUND MONUMENT AS NOTED	
	BOUNDARY LINE	
	PROPERTY LINE	
	RIGHT OF WAY LINE	
	CENTERLINE	
	EASEMENT LINE	
	ADJACENT SUBDIVISION LINE	
	ADJACENT PROPERTY LINE	
	EXISTING RIGHT OF WAY LINE	
	EXISTING CENTERLINE	
	EXISTING EASEMENT	where is this? I discern where tis
	SECTION/QUARTER SECTION LINE	section of road i
	MATCHLINE	relation to these
*NOT A PART*	PARCELS INDICATED WITH ASTERISK "*"	

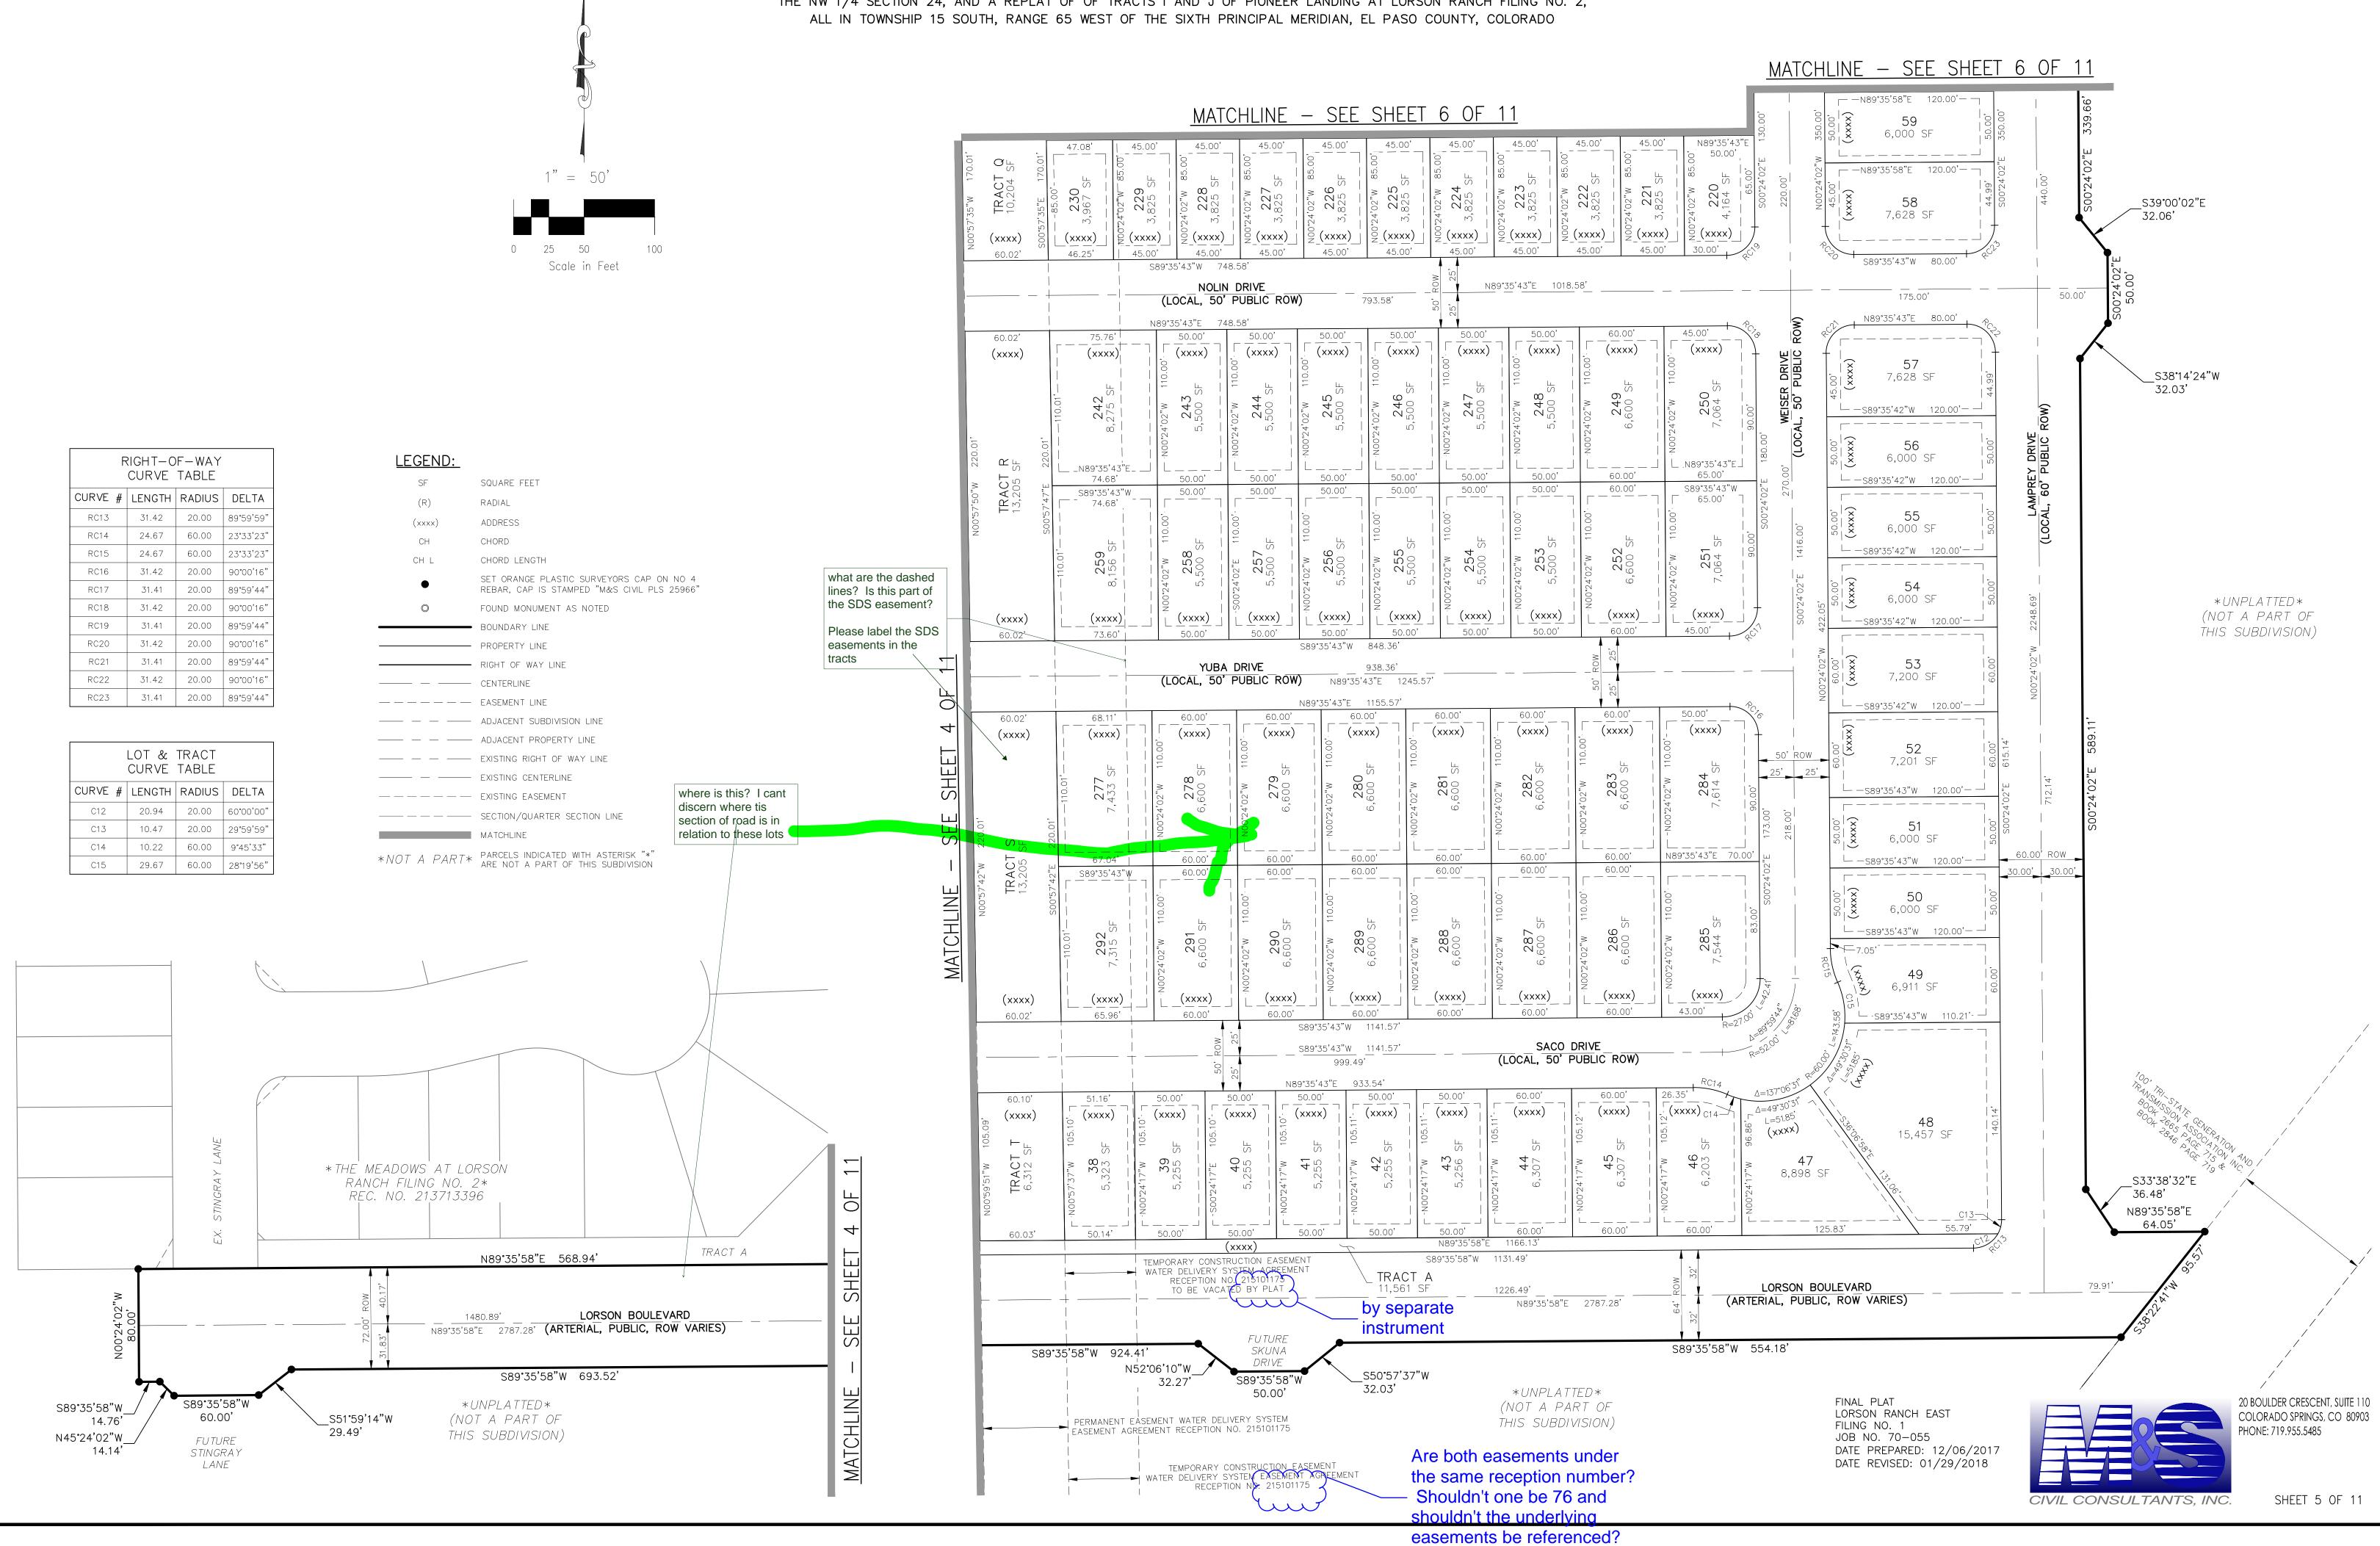

A PORTION OF THE SW 1/4 SECTION 13, AND OF THE SE 1/4 SECTION 14, AND OF THE NE 1/4 SECTION 23, AND OF THE NW 1/4 SECTION 24, AND A REPLAT OF OF TRACTS I AND J OF PIONEER LANDING AT LORSON RANCH FILING NO. 2,

LEGEND:	
SF	SQUARE FEET
(R)	RADIAL
(xxxx)	ADDRESS
СН	CHORD
CH L	CHORD LENGTH
٠	SET ORANGE PLASTIC SURVEYORS CAP ON NO 4 REBAR, CAP IS STAMPED "M&S CIVIL PLS 25966"
$\bigcirc$	FOUND MONUMENT AS NOTED
	BOUNDARY LINE
	PROPERTY LINE
	RIGHT OF WAY LINE
	CENTERLINE
	EASEMENT LINE
	ADJACENT SUBDIVISION LINE
	ADJACENT PROPERTY LINE
	EXISTING RIGHT OF WAY LINE
<u> </u>	EXISTING CENTERLINE
	EXISTING EASEMENT
	SECTION/QUARTER SECTION LINE
	MATCHLINE
*NOT A PART*	PARCELS INDICATED WITH ASTERISK "*" ARE NOT A PART OF THIS SUBDIVISION

RIGHT-OF-WAY CURVE TABLE						
CURVE #	LENGTH	RADIUS	DELTA			
RC24	31.42	20.00	90°00'16"			
RC25	31.41	20.00	89°59'44"			
RC26	31.42	20.00	90°00'16"			
RC27	31.41	20.00	89°59'44"			
RC28	31.42	20.00	90°00'16"			
RC29	31.41	20.00	89°59'44"			
RC30	31.42	20.00	90°00'16"			
RC31	31.41	20.00	89°59'44"			
RC32	31.42	20.00	90°00'16"			
RC33	31.41	20.00	89°59'44"			

	N00°06'29"W 220.00'	<b>TRACT</b> N 13,205 SF 205 SF	S00°06'29"E 220.00'	65.40 <sup>°</sup> 921 2522 <sup>°</sup> 2,222 <sup>°</sup> 2,222 <sup>°</sup> 2,222 <sup>°</sup>	→ → → → → → → → → → → → → → → → → → →	2.00' 	0.00, 154 (xxxx) 5,500 SF	
	(LOCAL, 50' PUBLIC ROW)							
		60.02' (xxxx)	110.00'	6,764 SF (xxxx) 6,764 SF		SF SF SF SF SF SF SF SF SF SF SF SF SF S	22"w 110.00 <sup>°</sup> . <b>162</b> 500 SF (xxxx)	02."W 110.00' Z
UF 11	00°06'29"W 220.00'	<b>TRACT O</b> 13,205 SF	S00°06'29"E 220.00' — —	<u>61.78'</u>		    00'	000, <sup>2</sup> 00, <sup>2</sup> 00, <sup>2</sup> 00, <sup>2</sup> 0, <sup>2</sup>	00'
<u>-E SHEEL /</u>	ON	<b>(xxxx)</b> 60.02'	S0 	62.34, CF	□ □ □ □ □ □ □ □ □ □ □ □ □ □ □ □ □ □ □	6,600 SF	0000   X 175 0000   X 5,500 SF	
MAICHLINE - SE	170.00'	60.02' (xxxx)	170.00' 	4,062 SF (xxxx) (xxxx)	100°24'02"W 85.00" 183 3,825 SF XX 00" 1,		<u>SO DRIVE</u> 0' PUBLIC N8 	9°35' 0'
	N00°07'36"W	-(506 S (xxxx) (706 S	S00°08°02"E 1	47.98' 47.98' 47.98' 500 500 600 4 4 500 500 4 4 8.38' 47.98' 1 1 1 1 1 1 1 1 1 1 1 1 1 1 1 1 1 1 1	100 <sup>24</sup> <sup>100</sup> <sup>24</sup> <sup>102</sup> <sup>w</sup> 85.00 <sup>1</sup> + 100 <sup>24</sup> <sup>102</sup> <sup>w</sup> 85.00 <sup>1</sup> + 202 <sup>1</sup> <sup>10</sup> <sup>10</sup> <sup>10</sup> <sup>10</sup> <sup>10</sup> <sup>10</sup> <sup>10</sup> <sup>10</sup> <sup>10</sup> <sup></sup>	A 200°24'02"W 85.00° 4201 85.00° 4201 85.00° 7.00°24'02"W 85.00° 7.00°24'00"W 85.00° 7.00°24'00"W 85.00° 7.00°24'00"W 85.00° 7.00°24'00"W 85.00° 7.00°24'0"W 85.00° 7.00° 7.00°24'0"W 85.00° 7.	45.0 45.0 45.0 45.0 2 45.0 2 45.0 2 45.0 2 45.0 2 45.0 45.0 45.0 45.0 45.0 45.0 45.0 45.0	, 3,825 SF 0
						ROWLEY L, 50' F	DRIVE PUBLIC ROV	(V)
	N00°57'35"W 170.01'	TRACT Q (xxxx) 10,204 SF	S00°57'35"E 170.01'	47.91' (xxxx) 6002 6020 4	42:00, 40:00, 40	45.00 [S00*24'02"E 85.00 3 875 5F 4211 7 85.00	212 (×	3,825 SF <b>x</b> >
						M	атсні І	NF

<u>MATCHLINE – SEE SHEET 5 OF 11</u>

# LORSON RANCH EAST FILING NO. 1

A PORTION OF THE SW 1/4 SECTION 13, AND OF THE SE 1/4 SECTION 14, AND OF THE NE 1/4 SECTION 23, AND OF THE NW 1/4 SECTION 24, AND A REPLAT OF OF TRACTS I AND J OF PIONEER LANDING AT LORSON RANCH FILING NO. 2, ALL IN TOWNSHIP 15 SOUTH, RANGE 65 WEST OF THE SIXTH PRINCIPAL MERIDIAN, EL PASO COUNTY, COLORADO



\*UNPLATTED\*

(NOT A PART OF THIS SUBDIVISION)

\_\_\_\_\_

1" = 50' 0 25 50 100 Scale in Feet

FINAL PLAT LORSON RANCH EAST FILING NO. 1 JOB NO. 70–055 DATE PREPARED: 12/06/2017 DATE REVISED: 01/29/2018



20 BOULDER CRESCENT, SUITE 11 COLORADO SPRINGS, CO 80903 PHONE: 719.955.5485

CIVIL CONSULTANTS, INC.

SHEET 6 OF 11


LEGEND:	
SF	SQUARE FEET
(R)	RADIAL
(xxxx)	ADDRESS
СН	CHORD
CH L	CHORD LENGTH
٠	SET ORANGE PLASTIC SURVEYORS CAP ON NO 4 REBAR, CAP IS STAMPED "M&S CIVIL PLS 25966"
$\bigcirc$	FOUND MONUMENT AS NOTED
	BOUNDARY LINE
	PROPERTY LINE
	RIGHT OF WAY LINE
	CENTERLINE
	EASEMENT LINE
	ADJACENT SUBDIVISION LINE
	ADJACENT PROPERTY LINE
	EXISTING RIGHT OF WAY LINE
	EXISTING CENTERLINE
	EXISTING EASEMENT
	SECTION/QUARTER SECTION LINE
	MATCHLINE
*NOT A PART*	PARCELS INDICATED WITH ASTERISK "*" ARE NOT A PART OF THIS SUBDIVISION


RIGHT-OF-WAY CURVE TABLE			
CURVE #	LENGTH	RADIUS	DELTA
RC34	30.71	20.00	87°57'57"
RC35	32.54	20.00	93°12'59"
RC36	29.18	20.00	83°35'02"
RC37	27.72	20.00	79°24'58"
RC38	18.08	225.00	4°36'16"

RIGHT-OF-WAY LINE TABLE		
LINE #	DISTANCE	BEARING
RL2 8.06		S74°55'11"E
RL3	8.71	N74°55'11"W

LOT & TRACT CURVE TABLE			
LENGTH	RADIUS	DELTA	
C16 31.86 225.00 8*06'52			
4.38	225.00	1°06'59"	
C18 19.94 175.00 6°31'38"			
	CURVE LENGTH 31.86 4.38	CURVE         TABLE           LENGTH         RADIUS           31.86         225.00           4.38         225.00	

LOT & TRACT CURVE TABLE			
LINE #	DISTANCE	BEARING	
L4	4.06	N21°29'47"E	
L5	17.02	N00°06'29"W	
L6 6.57		S00°06'29"E	

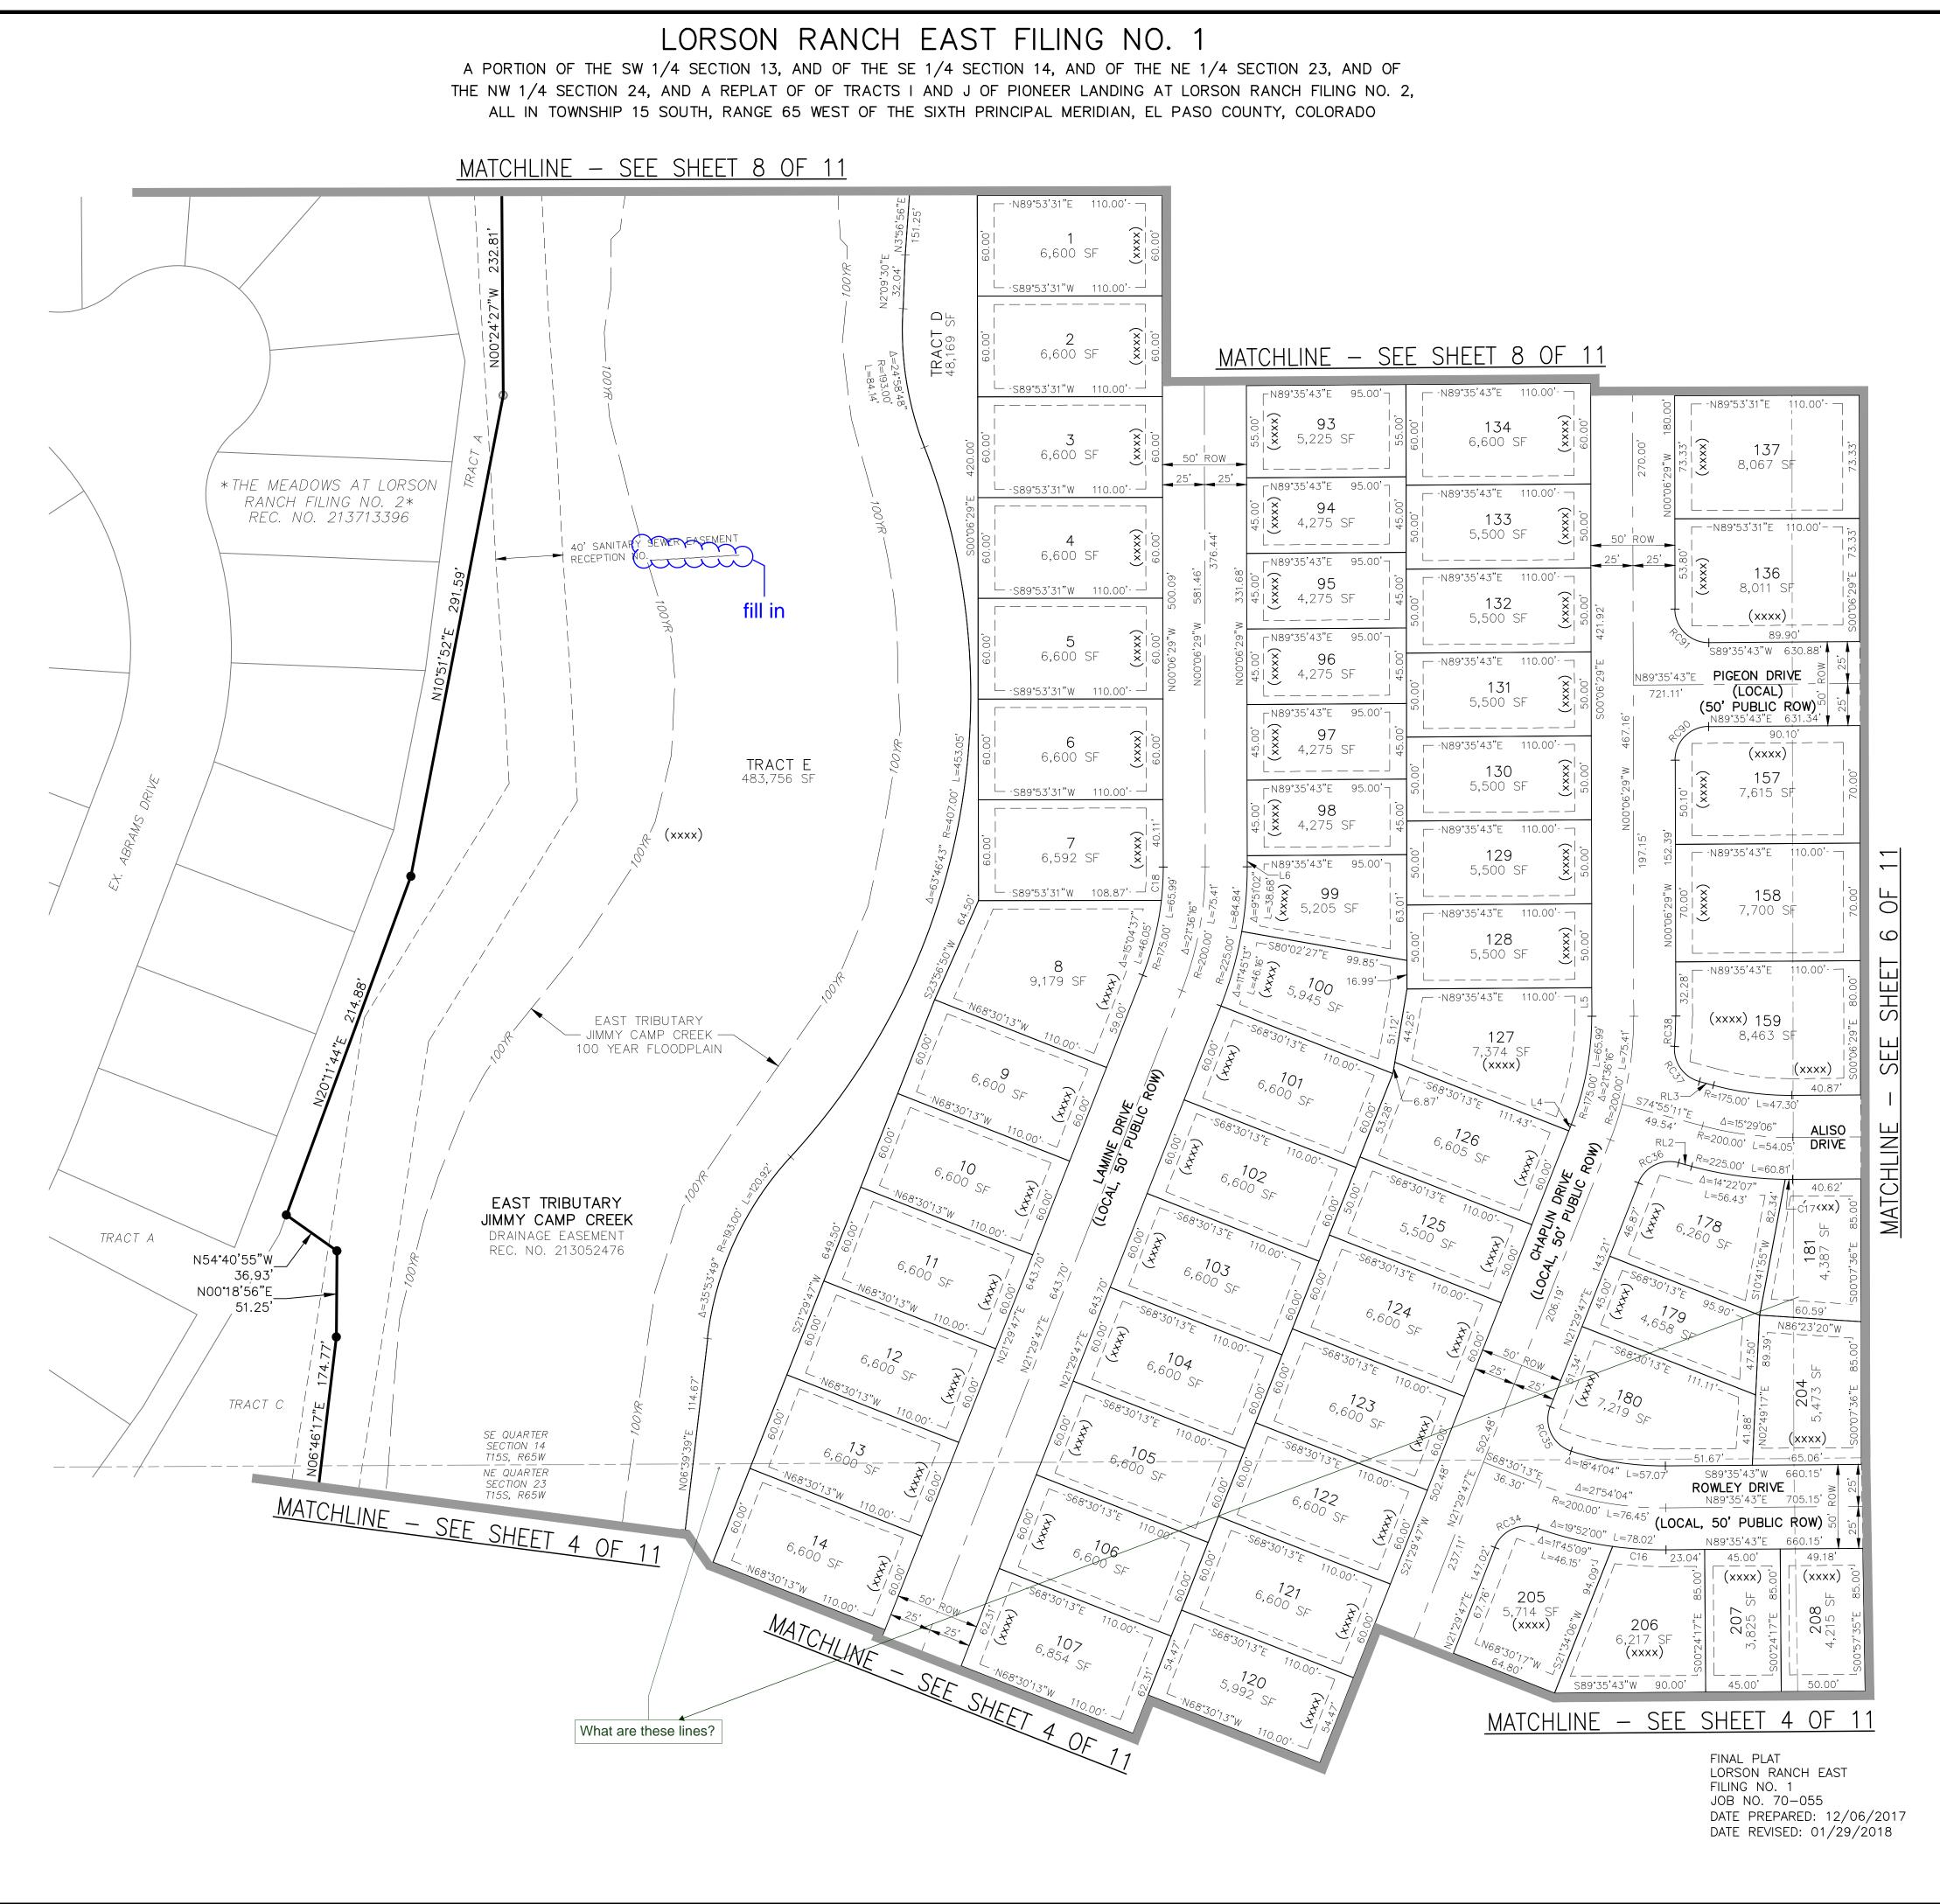

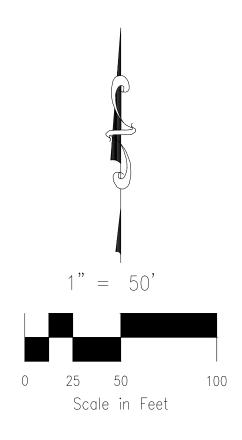





20 BOULDER CRESCENT, SUITE 110 COLORADO SPRINGS, CO 80903 PHONE: 719.955.5485

CIVIL CONSULTANTS, INC.

SHEET 7 OF 11

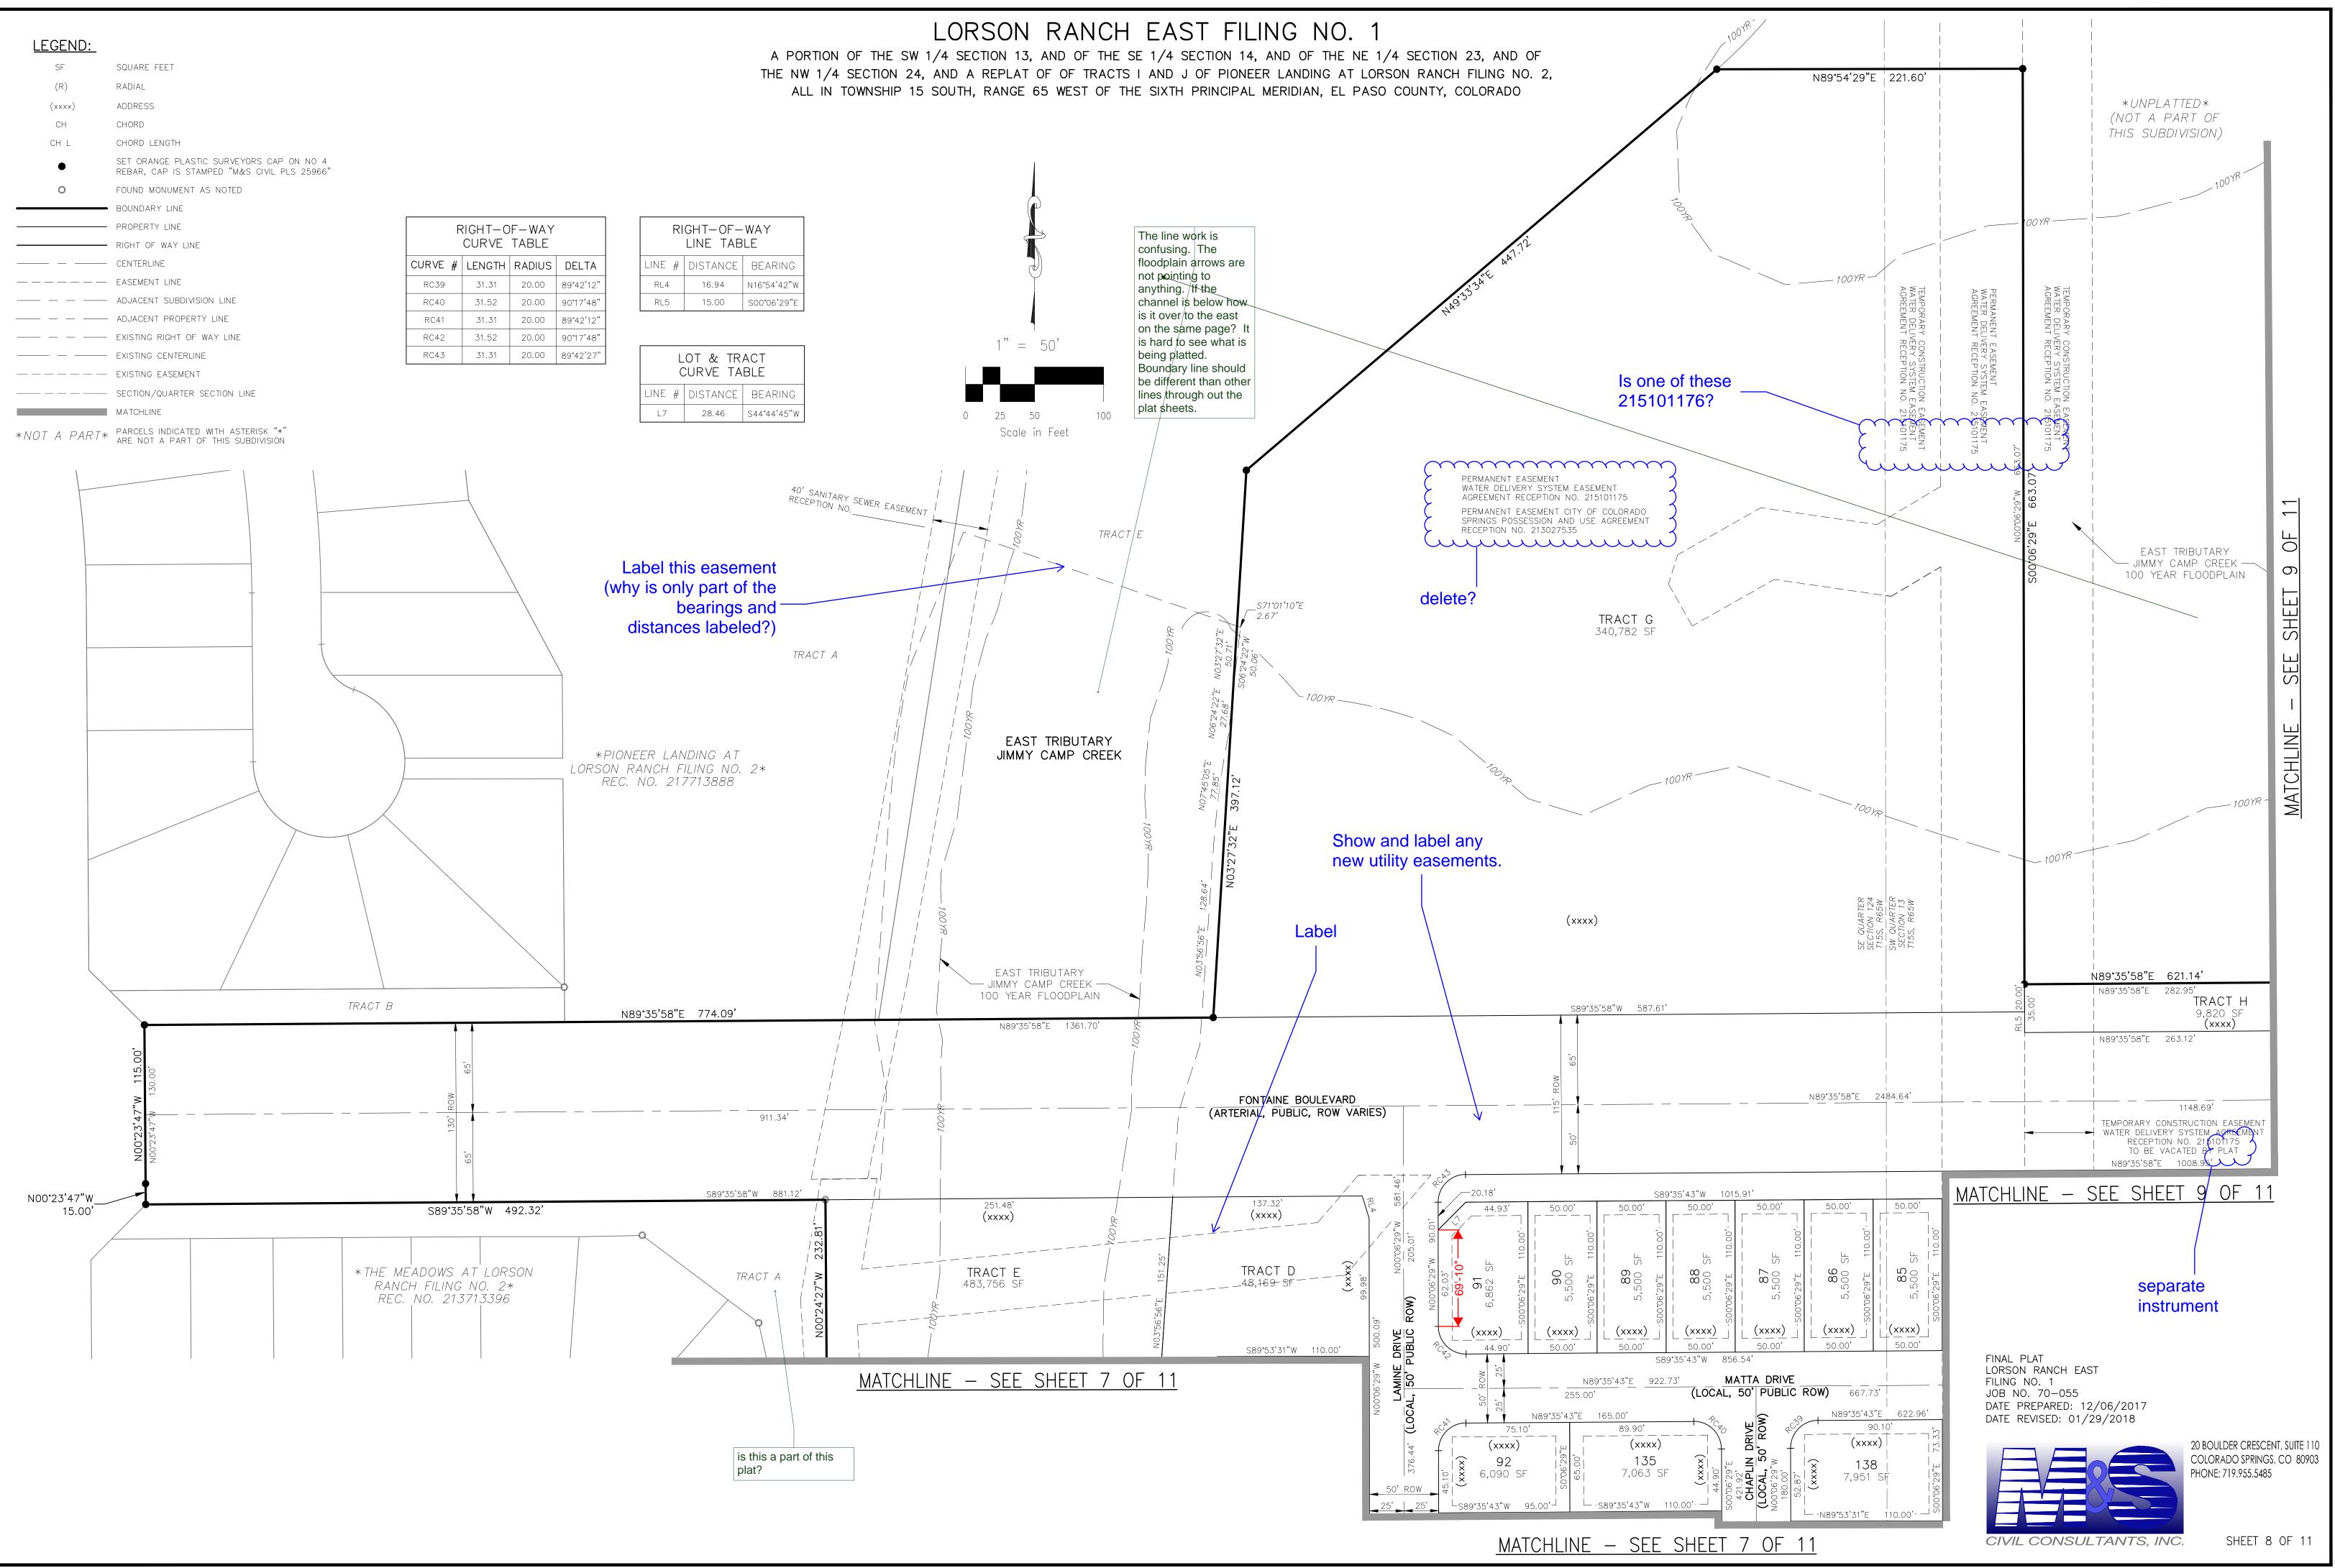




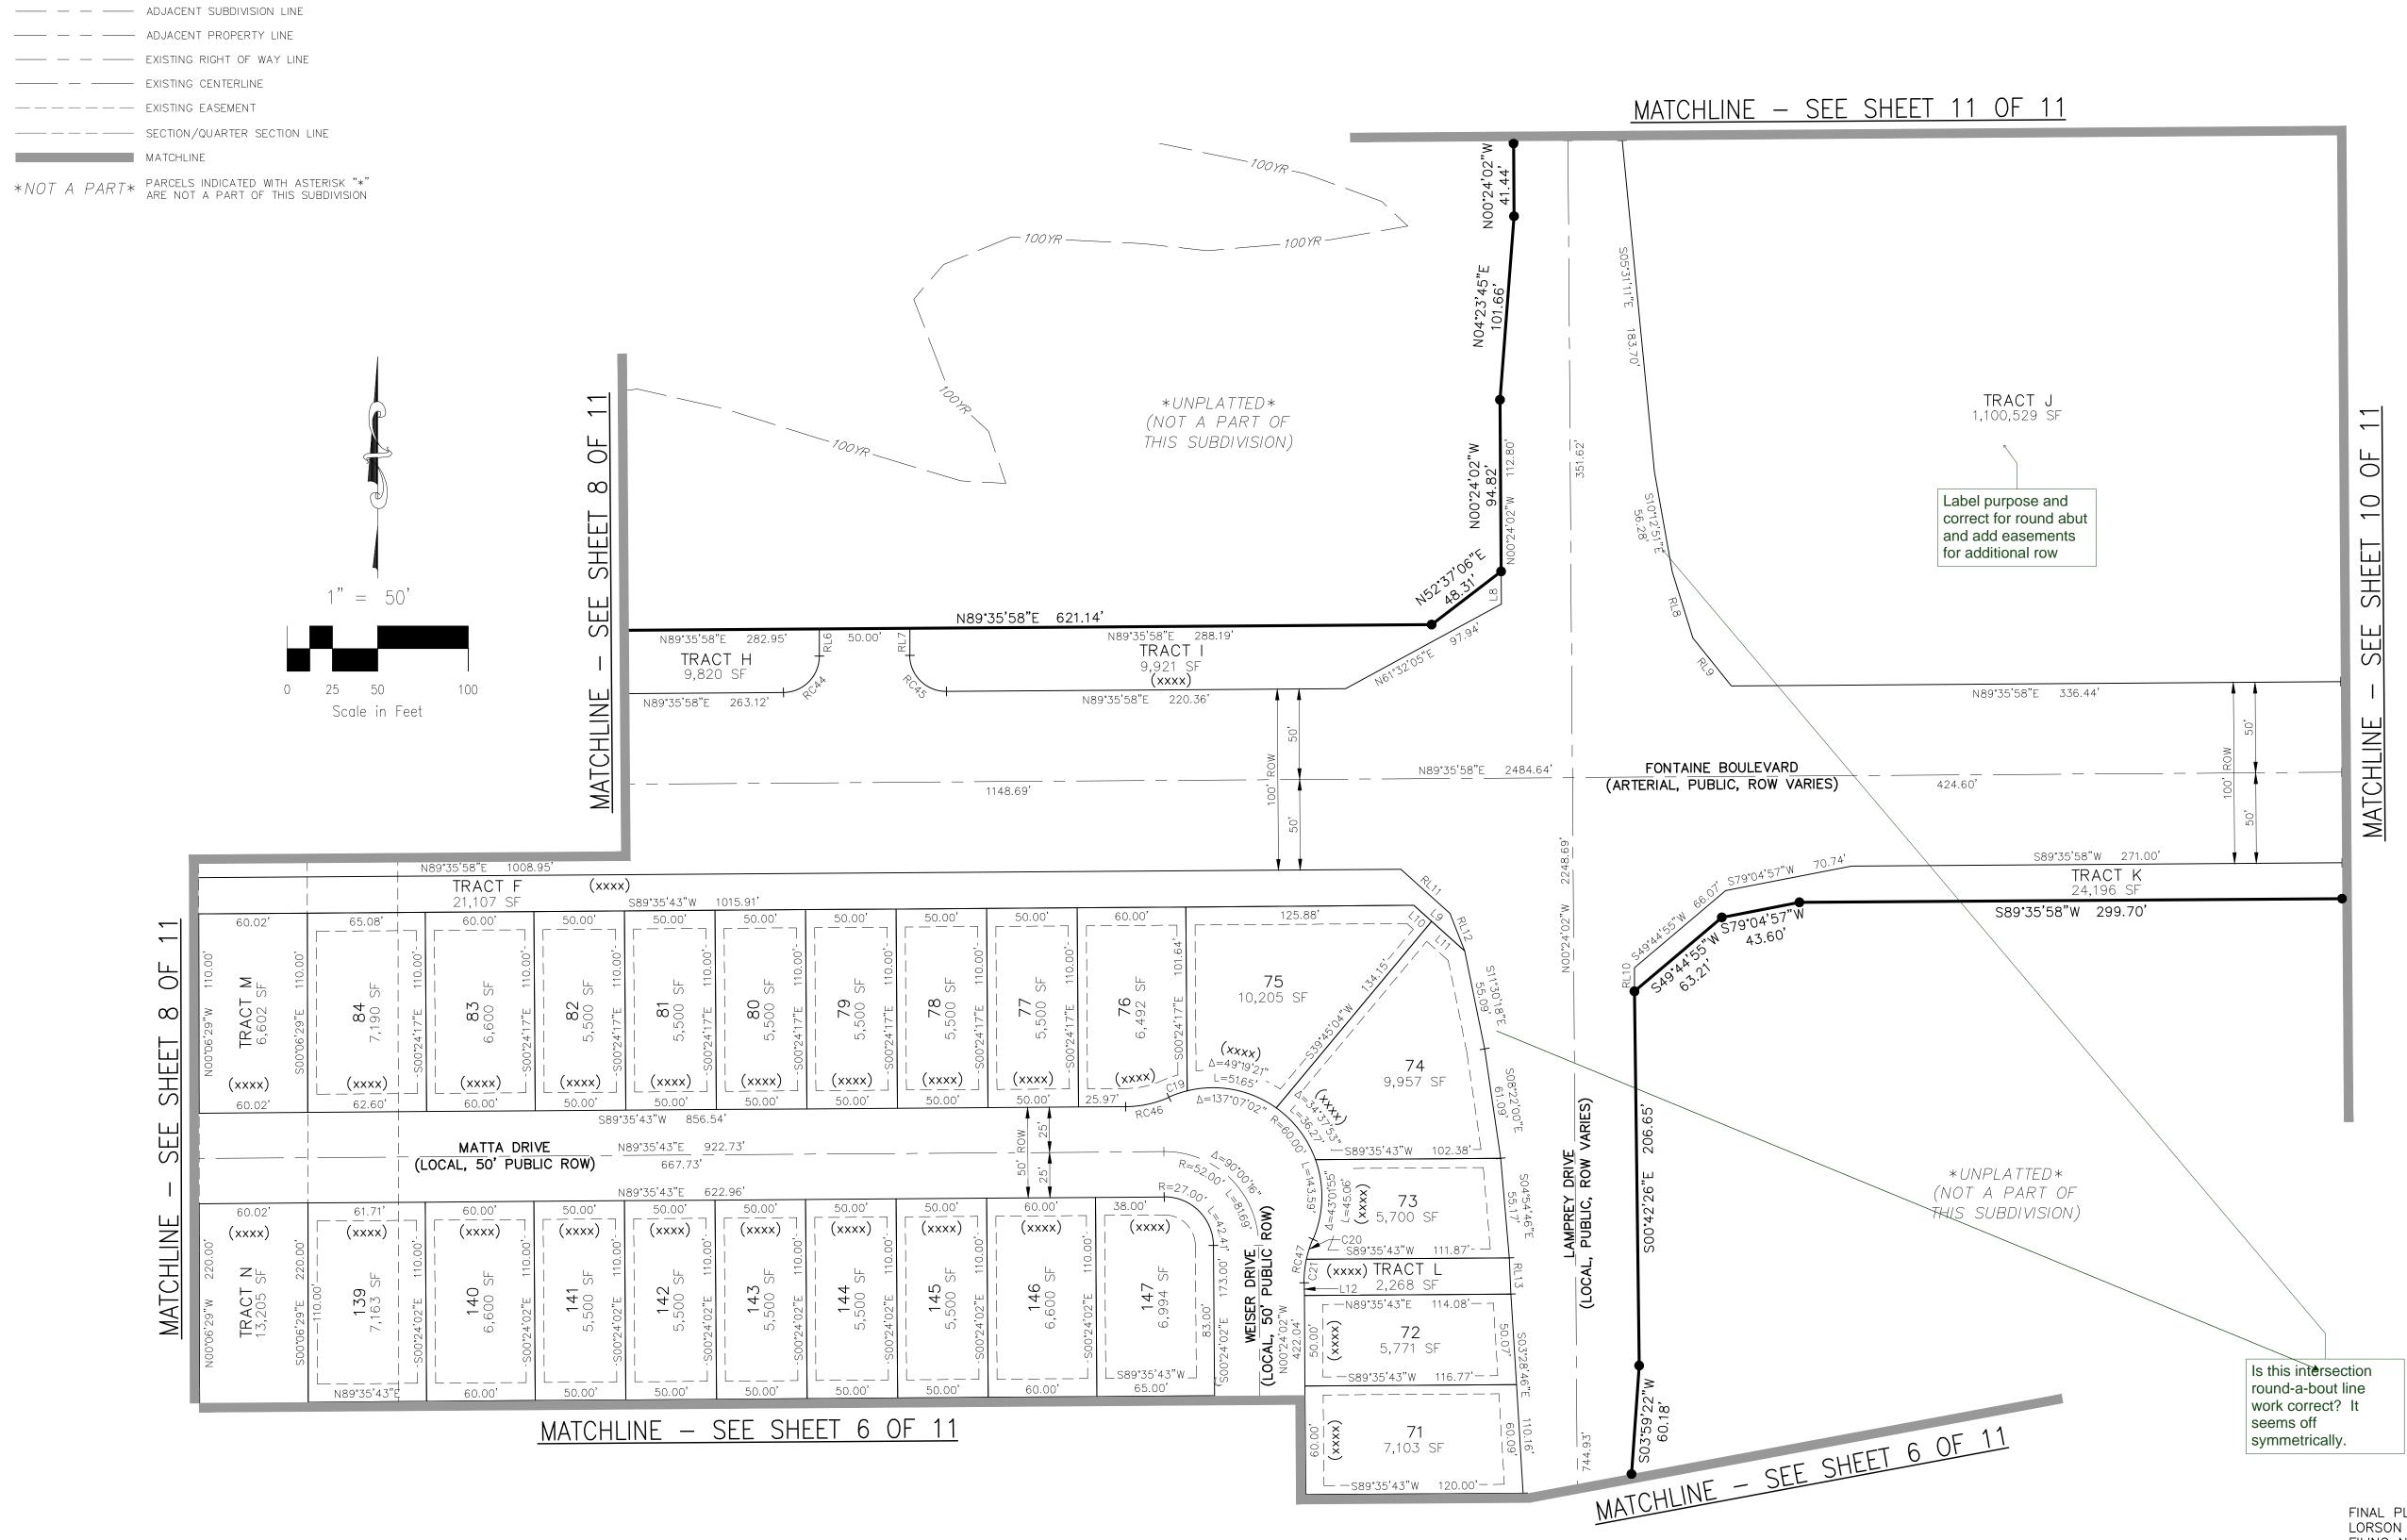

LEGEND:	
SF	SQUARE FEET
(R)	RADIAL
(xxxx)	ADDRESS
СН	CHORD
CH L	CHORD LENGTH
٠	SET ORANGE PLASTIC SURVEYORS CAP ON NO 4 REBAR, CAP IS STAMPED "M&S CIVIL PLS 25966"
$\bigcirc$	FOUND MONUMENT AS NOTED
	BOUNDARY LINE
	PROPERTY LINE
	RIGHT OF WAY LINE
	CENTERLINE
	EASEMENT LINE
	ADJACENT SUBDIVISION LINE
	ADJACENT PROPERTY LINE
	EXISTING RIGHT OF WAY LINE
	EXISTING CENTERLINE
	EXISTING EASEMENT
	SECTION/QUARTER SECTION LINE
	MATCHLINE
*NOT A PART*	PARCELS INDICATED WITH ASTERISK "*"

A PORTION OF THE SOUTHWEST QUARTER (SW 1/4) SECTION 13, AND A PORTION OF THE SOUTHEAST QUARTER (SE 1/4) SECTION 14, A PORTION OF THE NORTHEAST QUARTER (NE 1/4) SECTION 23, AND A PORTION OF THE NORTHWEST QUARTER (NW 1/4) SECTION 24, TOWNSHIP 15 SOUTH, RANGE 65 WEST OF THE SIXTH PRINCIPAL MERIDIAN, EL PASO COUNTY, COLORADO

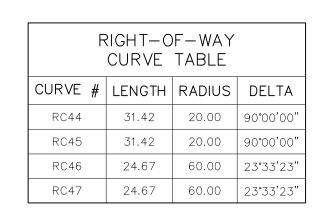

RI	RIGHT-OF-WAY LINE TABLE		
LINE #	DISTANCE	BEARING	
RL6	15.00	N00°24'02"W	
RL7	15.00	S00°24'02"E	
RL8	38.27	S17°11'10"E	
RL9	33.94	S38°53'40"E	
RL10	13.03	S00°23'55"E	
RL11	36.47	S48°04'43"E	
RL12	22.31	S21°26'32"E	
RL13	20.02	S02°40'46"E	

LOT & TRACT CURVE TABLE			
CURVE # LENGTH RADIUS DELTA		DELTA	
C19 10.61 60.00 10°07'53"		10°07'53"	
C20	11.60	60.00	11°04'48"
C21 13.07 60.00 12°28'35"			

LOT & TRACT CURVE TABLE				
LINE #	LINE # DISTANCE BEARING			
L8	17.98	N00°24'02"W		
L9	37.78	N48°04'43"W		
L10	13.17	N48°04'43"W		
L11	24.61	N48°04'43"W		
L12	7.04	S00°24'02"E		


FINAL PLAT LORSON RANCH EAST FILING NO. 1 JOB NO. 70–055 DATE PREPARED: 12/06/2017 DATE REVISED: 01/29/2018




20 BOULDER CRESCENT, SUITE 110 COLORADO SPRINGS, CO 80903 PHONE: 719.955.5485

CIVIL CONSULTANTS, INC.


SHEET 9 OF 11

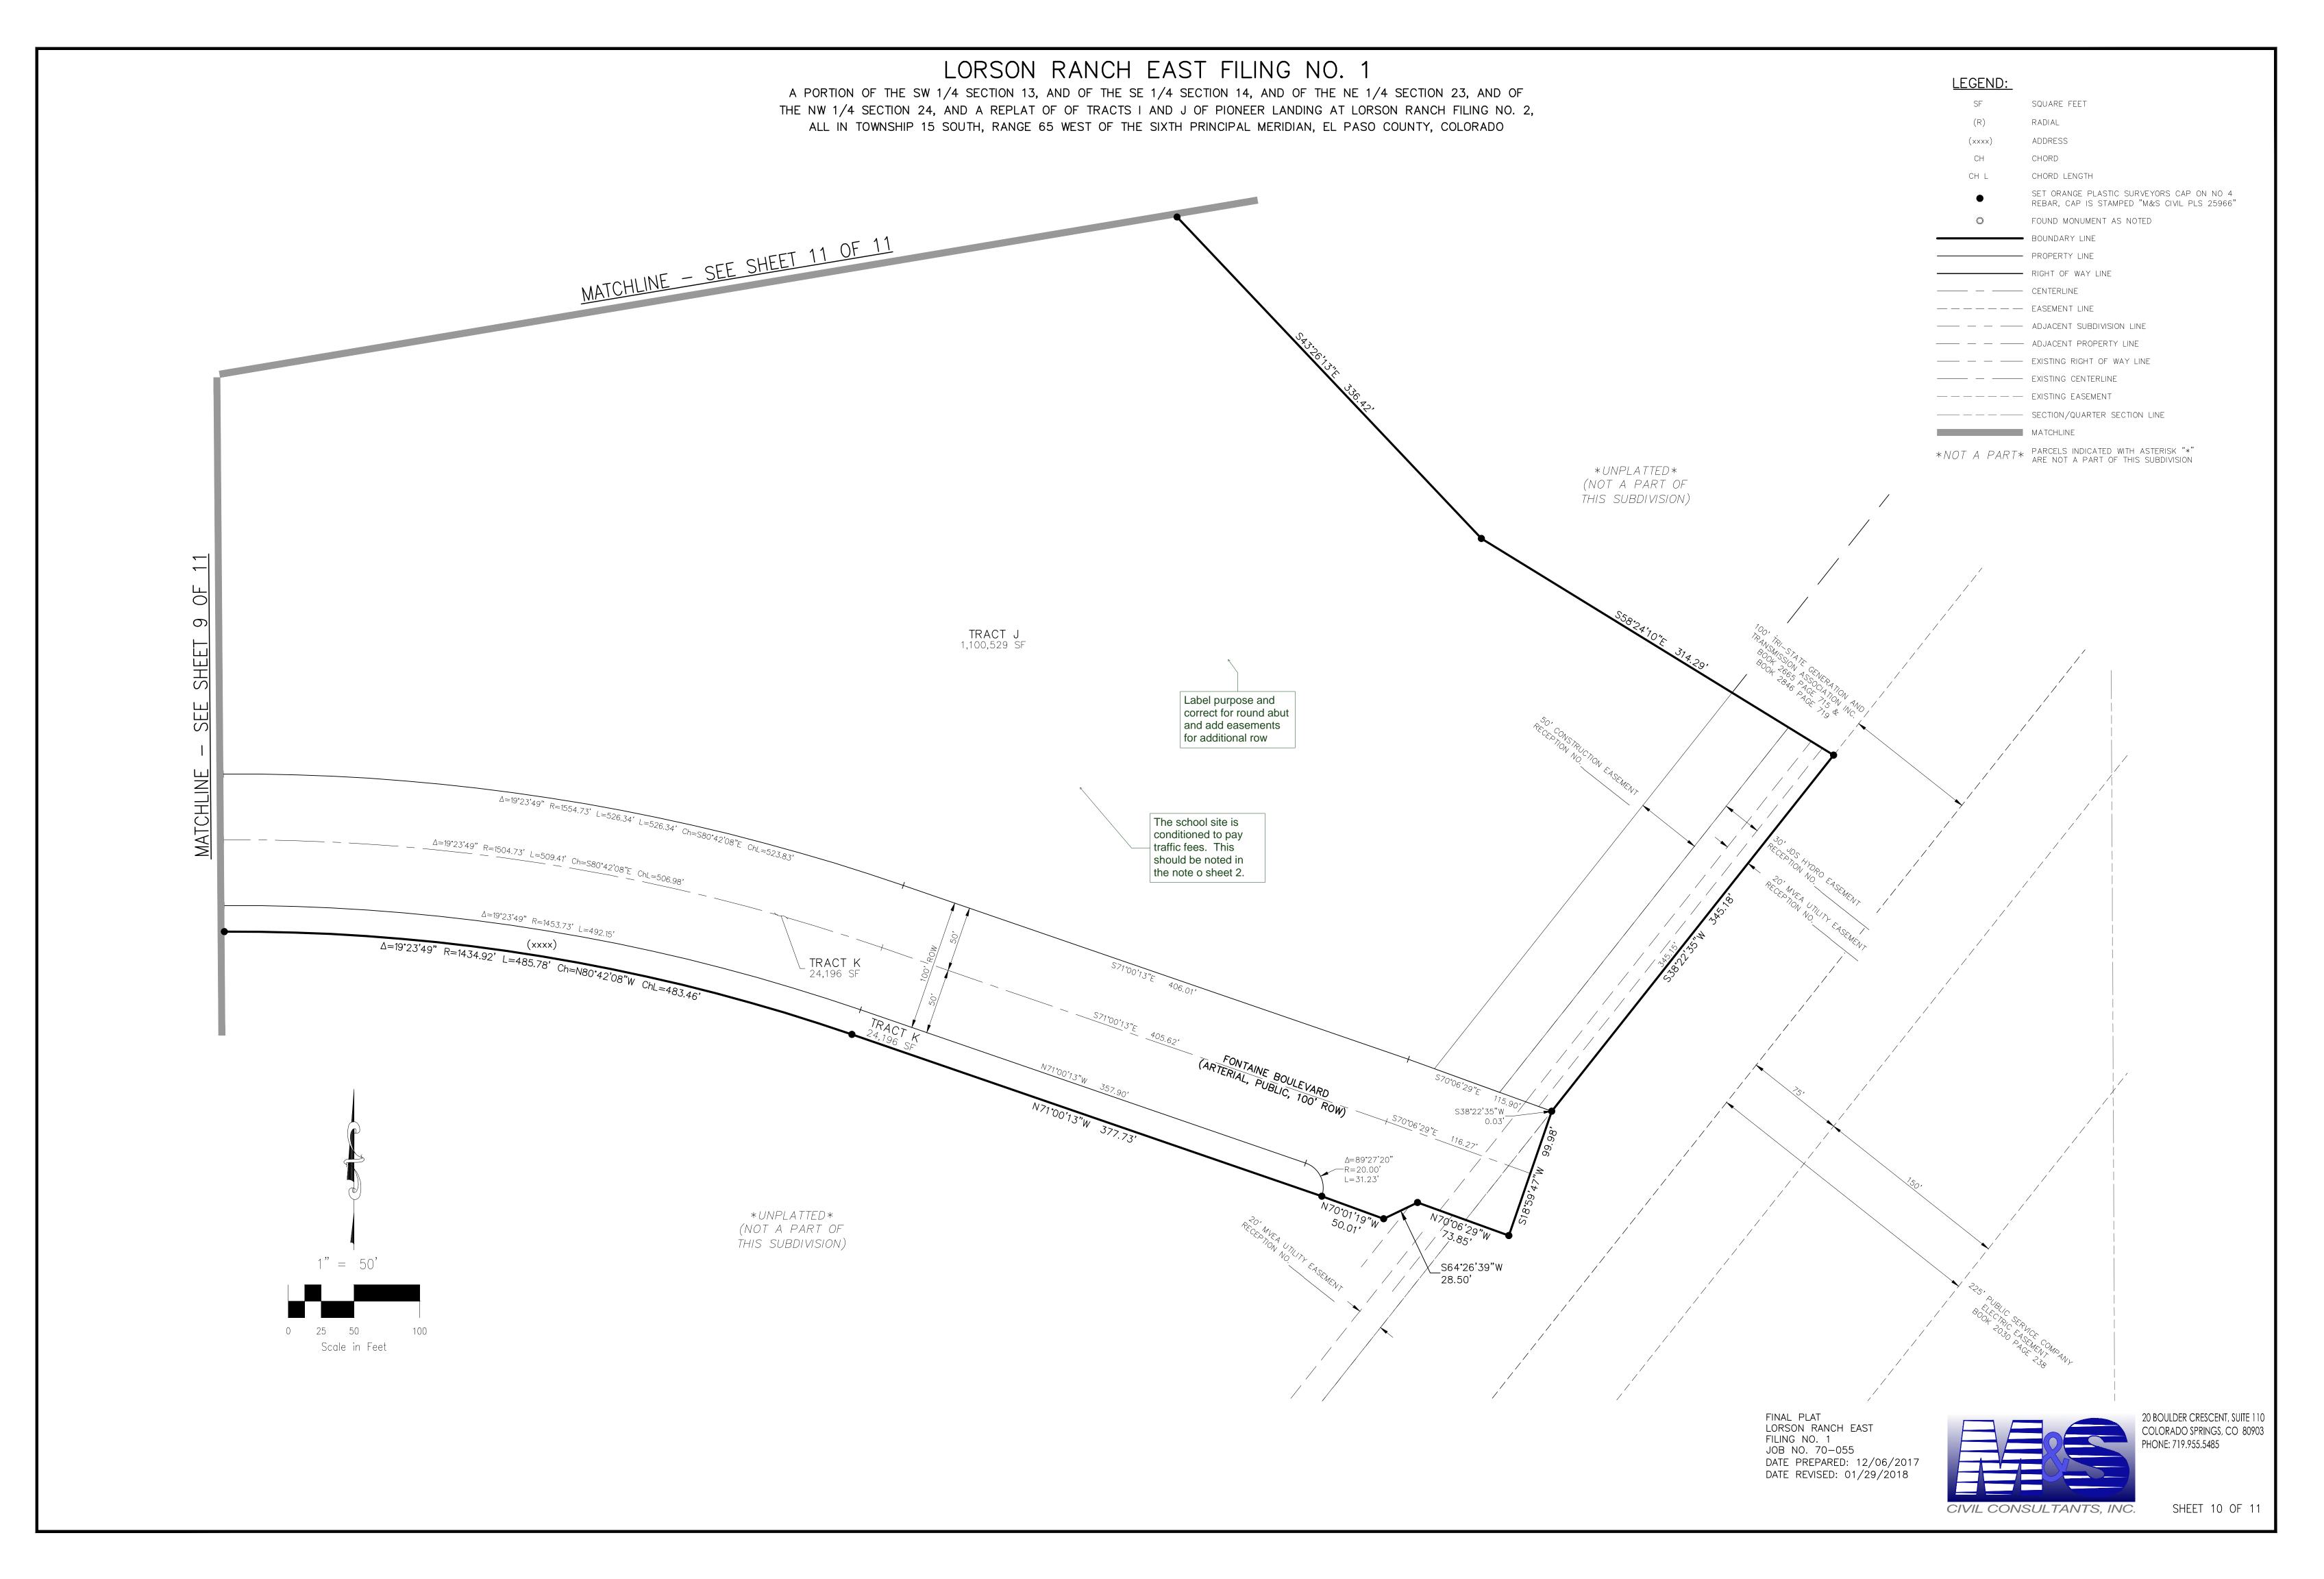

LEGEND:	
SF	SQUARE FEET
(R)	RADIAL
(xxxx)	ADDRESS
СН	CHORD
CH L	CHORD LENGTH
٠	SET ORANGE PLASTIC SURVEYORS CAP ON NO 4 REBAR, CAP IS STAMPED "M&S CIVIL PLS 25966"
$\bigcirc$	FOUND MONUMENT AS NOTED
	BOUNDARY LINE
	PROPERTY LINE
	RIGHT OF WAY LINE
	CENTERLINE
	EASEMENT LINE
	ADJACENT SUBDIVISION LINE
	ADJACENT PROPERTY LINE
	EXISTING RIGHT OF WAY LINE
	EXISTING CENTERLINE
	EXISTING EASEMENT
	SECTION/QUARTER SECTION LINE
	MATCHLINE
*NOT A PART*	PARCELS INDICATED WITH ASTERISK "*" ARE NOT A PART OF THIS SUBDIVISION

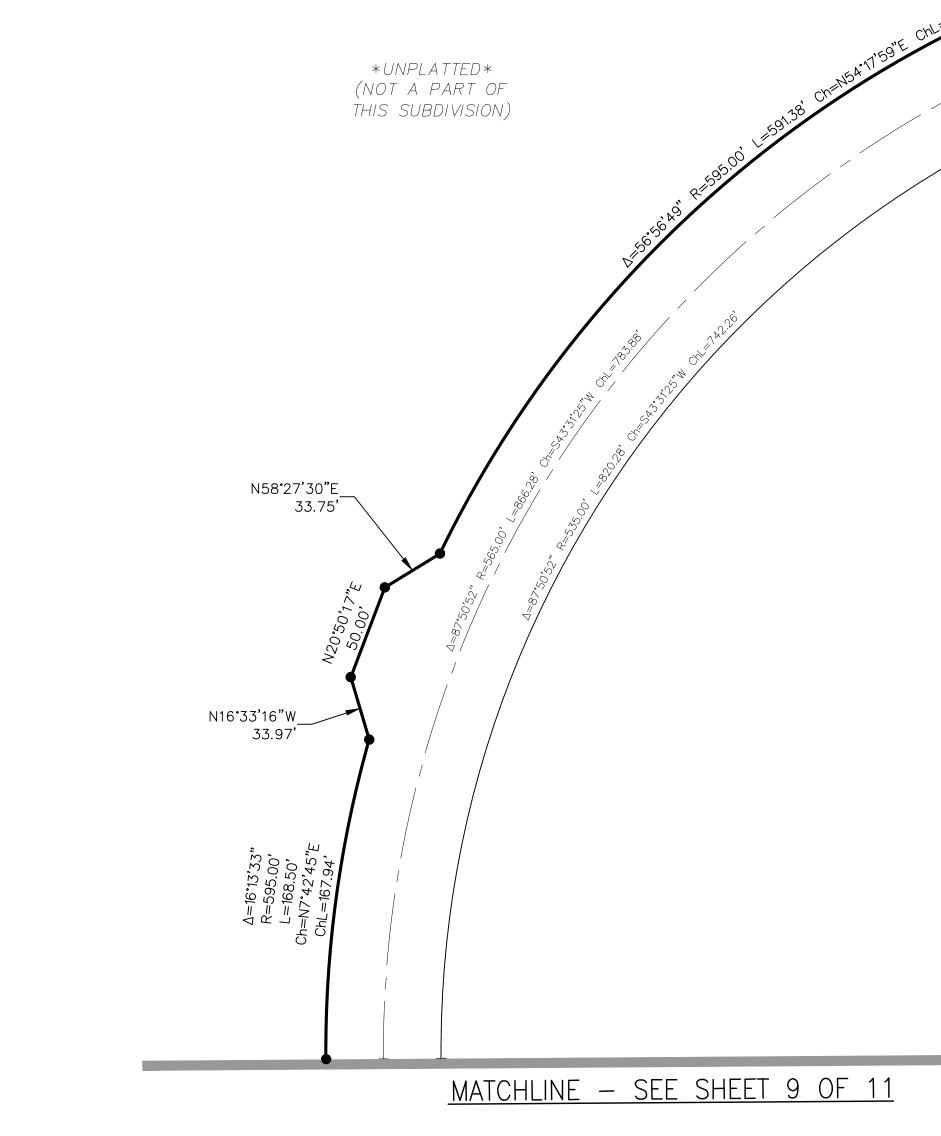

A PORTION OF THE SW 1/4 SECTION 13, AND OF THE SE 1/4 SECTION 14, AND OF THE NE 1/4 SECTION 23, AND OF THE NW 1/4 SECTION 24, AND A REPLAT OF OF TRACTS I AND J OF PIONEER LANDING AT LORSON RANCH FILING NO. 2, ALL IN TOWNSHIP 15 SOUTH, RANGE 65 WEST OF THE SIXTH PRINCIPAL MERIDIAN, EL PASO COUNTY, COLORADO

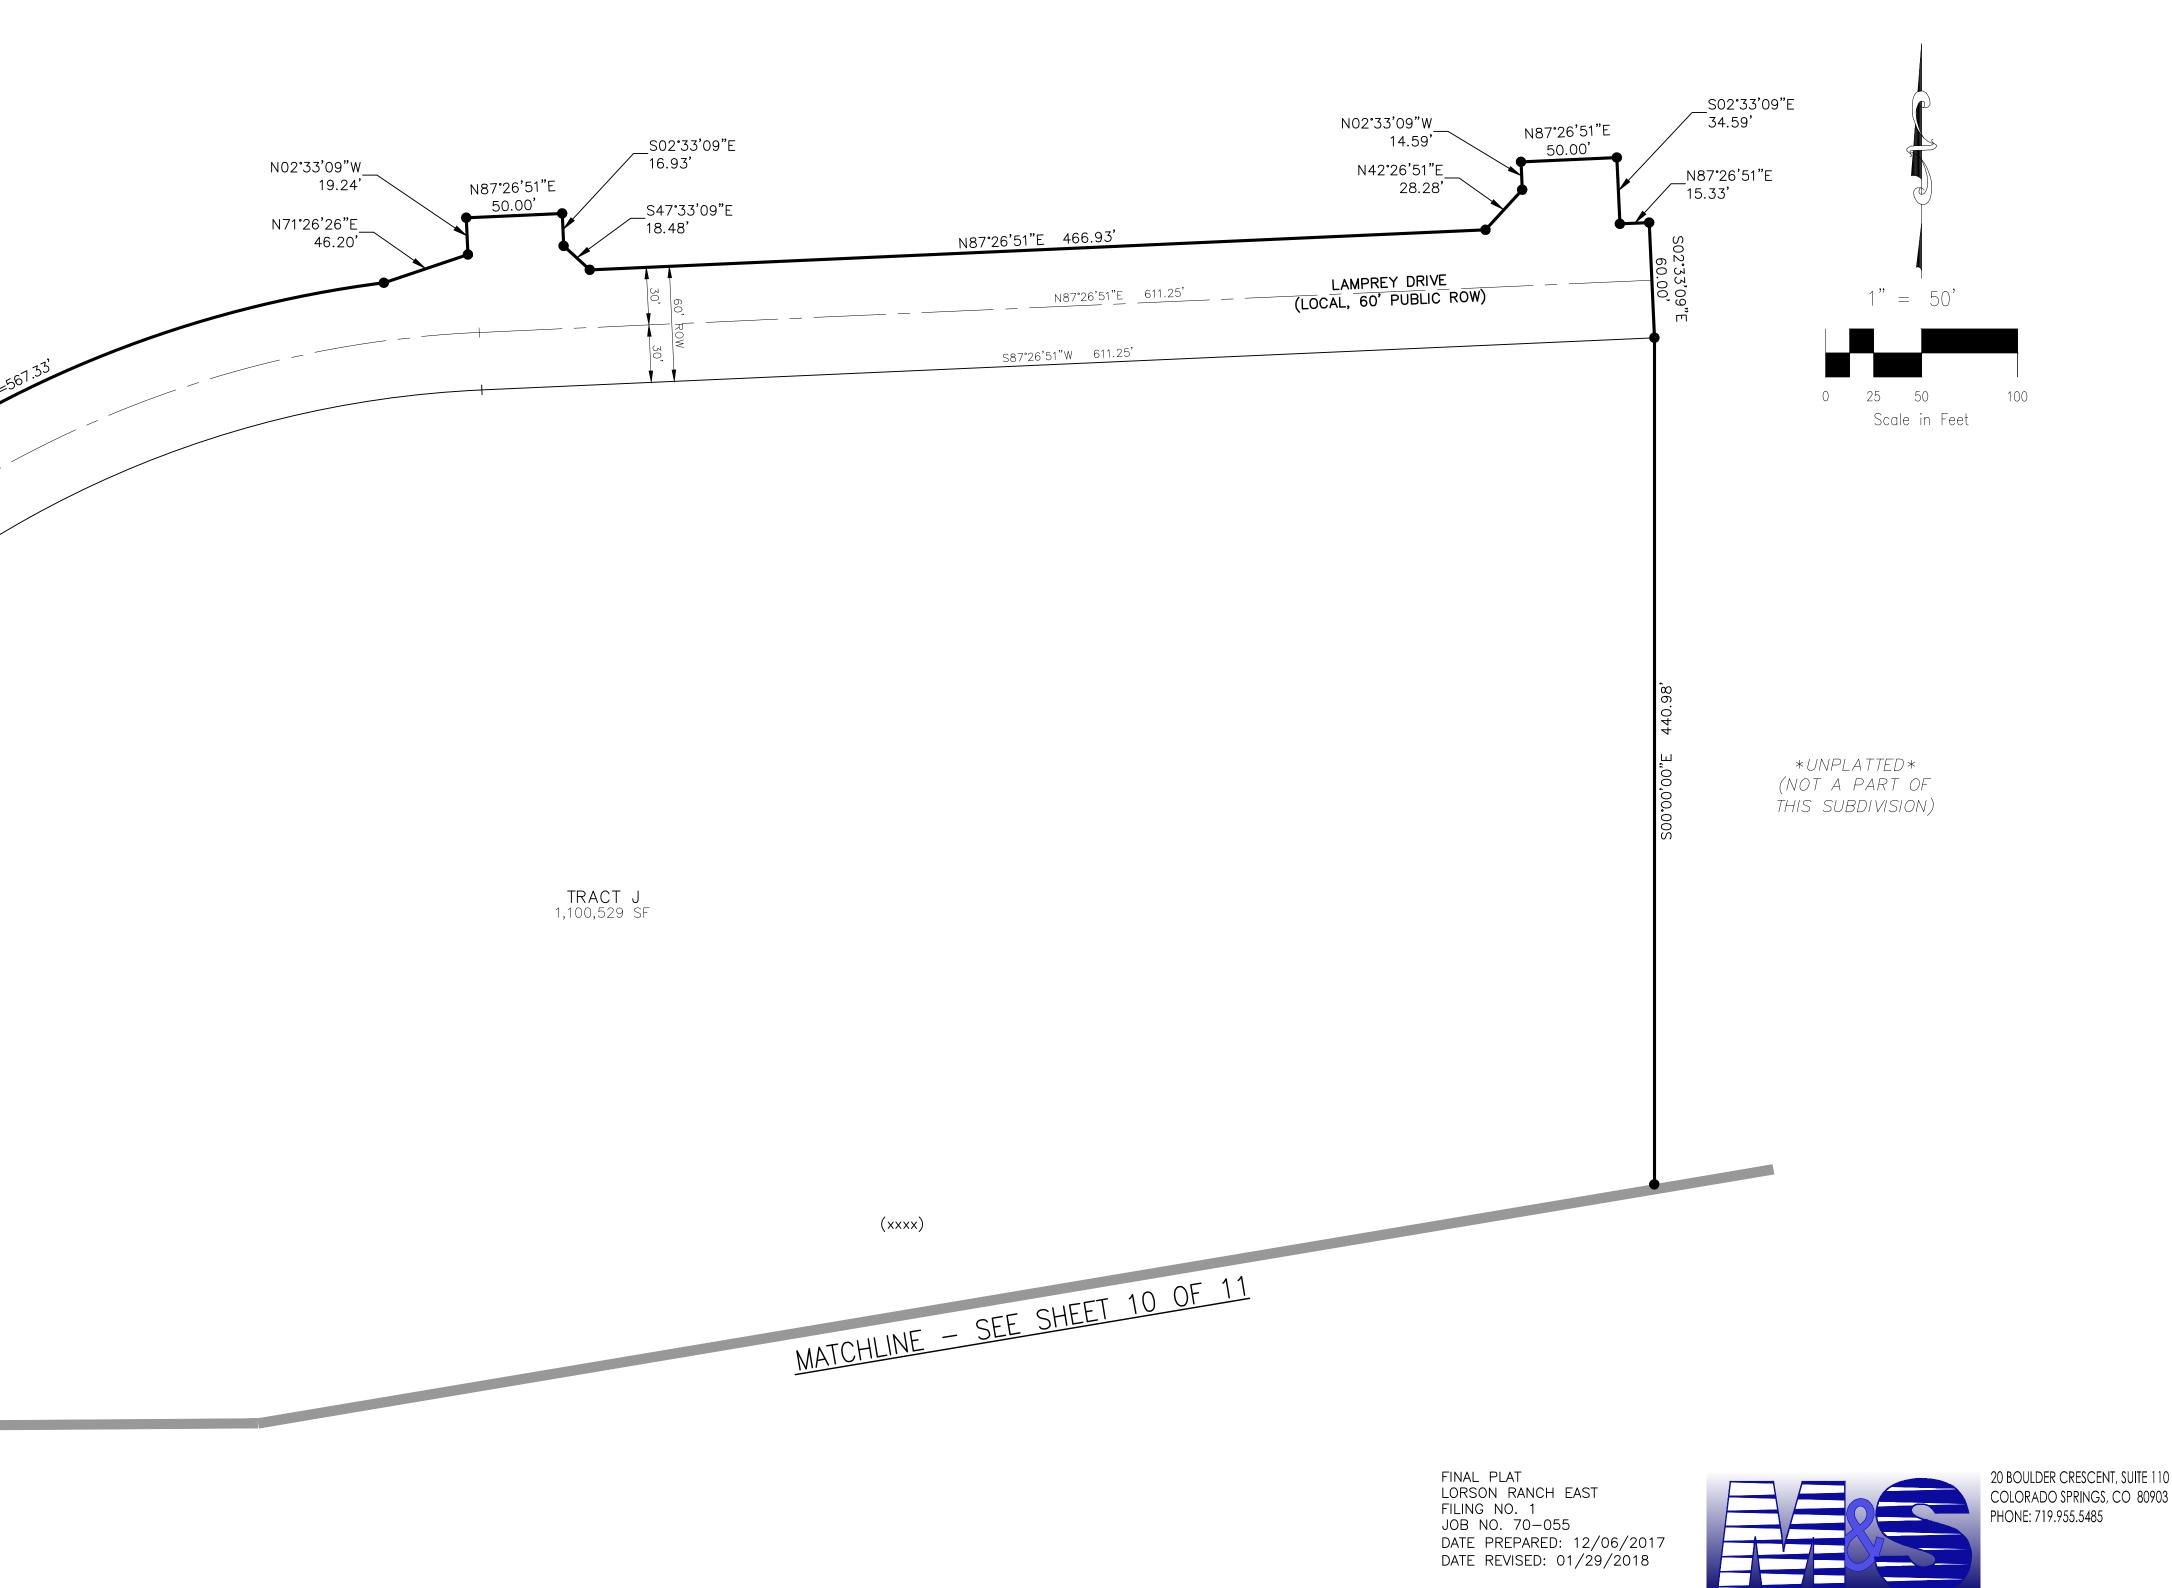

CIVIL CONSULTANTS, INC.

SHEET 11 OF 11