DATE:May 1, 2018TO:Kari Parsons, PCD-Project ManagerFROM:Richard Schindler, Core EngineeringSUBJECT:SE 18,008

SUBJECT: SF-18-008 – Lorson Ranch East Filing No. 1 Response to Comments - First Submittal

<u>Final Plat</u>

- 1. Provide documentation of separate easements and vacation/termination documents removing encumbrances on proposed rights-of-way, when available.
- 2. A segment of the Jimmy Camp Creek East Tributary north of Fontaine Blvd. needs to be included in this plat, with perpetual maintenance of the channel by the Lorson Ranch Metro District, since it serves the detention basin outfall.
- 3. See final plat and title commitment redlines for clarification of these comments and additional comments.
- 4. Add to Easement Paragraph: All easements that are dedicated hereon for public utility purposes shall be subject to those terms and conditions as specified in the instrument recorded at Reception Number 212112548 of the records of El Paso County, Colorado. All other easements or interests of record affecting any of the platted property depicted hereon shall not be affected and shall remain in full force and effect.
- 5. Amend Note 19 to include Reception # 216055186.
- 6. Show and label the Permanent Easements granted under Reception Number 216055186

Transportation / Traffic Impact Study

- 1. See TIS redlines requesting additional information.
- 2. Note: Fontaine Blvd., including roundabout details, is being reviewed under a separate submittal, CDR183.
- 3. Please attach the November 2017/January 2018 PUD/Preliminary Plan TIS as an appendix to this Filing 1 TIS.
- 4. Update Figure 3 from the previous report to include all roads in Phase 1/Filing 1.
- 5. Provide a noise study for the lots along Fontaine Blvd., assuming the ultimate Principal Arterial cross-section.

Letter of Intent

- 1. Address whether there will be landscaping needing maintenance within the roundabout center island and, if so, if the Lorson Ranch Metro District will maintain that landscaping. *Response: lorson ranch metro will maintain the landscaping in the center of the roundabout. Sentence added.*
- 2. See Construction Plans comment #4. *Response: sentence added for vacating those easements*

Final Drainage Report / Drainage Plans

Additional comments may be generated based on the extent of additional information and revisions required. (Report text, calculations and plans were not cross-checked in detail.)

- 1. Note: For the purposes of the FDR, all drainage facilities necessary for Filing 1 and the surrounding roads need to be included in this report. Separate approved reports may be placed in the appendix for reference. *Response: We tried to insert the Fontaine Blvd FDR into the report but it was so big that anyone reading this report would not be able to distinguish what report is what. We highly recommend not inserting Fontaine FDR and keeping it as a reference.*
- 2. The report and plans need to address what overlot grading, drainage facilities and utilities have been completed (or assumed to be by the time of final plat approval). Address how construction is proceeding from there, including interim stormwater collection of flows from the undeveloped areas east of Filing No. 1 (construction required with Filing 1). *Response: Section 3.1 has been added to address interim conditions.*
- 3. Detention pond narrative and calculations need to address both interim (undeveloped upstream with no ponds) and ultimate future conditions. Include estimated school site pond design in series to ensure proper Pond C5 functions. *Response: Section 3.1 has been added to address interim conditions including an appendix with the interim pond calculations. We did not add the school pond yet since it isn't constructed or approved at this time. The school pond will be added with Filing 2 that we are currently working on.*
- 4. The drainage fee calculations seem much too high. Adjust for the included channel tract north of Fontaine Blvd. and verify calculations. *Response: drainage fees are adjusted*
- 5. The drainage plans need to account for interim and ultimate future conditions. Additional sheets may be necessary to show this clearly. *Response: additional sheet inserted for interim conditions.*
- 6. See FDR redlines for additional comments and clarification of these comments. *Response: noted*
- 7. See redlines on deviation request. Response: noted

Construction Plans

- 1. Show grading tying in at the end of all profiles. If necessary, show the overlot grading as such. *Response: tie-ins shown*
- 2. Note: The following associated CDs are being reviewed under separate submittals.
 - a. Fontaine Blvd., including roundabout and Lamprey Drive, CDR183
 - b. Lorson Blvd. bridge, CDR182
 - c. Fontaine Blvd. bridge and EFJCC channel improvements, CDR169 (approved Feb 6, 2018) *Response: noted*

The portions of these separated projects necessary to serve Lorson Ranch East Filing No. 1 (including the school site) need to be approved and permitted prior to scheduling this plat for BoCC hearing. *Response: noted*

- 3. Include all maintenance access roads for ponds and the EFJCC channel on the plans. *Response: access roads to ponds shown on these plans. See Kiowa plans for other access roads.*
- 4. Note: The portions of existing and proposed easements (utility, access, etc.) that overlap proposed/future public road rights-of-way, if any, need to be vacated/terminated prior to platting and County acceptance of the proposed roads. Address this situation specifically in the letter of intent. *Response: noted in letter of intent*
- 5. See CD redlines for additional comments and clarification of these comments.

Grading and Erosion Control Plan / SWMP

1. GEC Plan:

- a. The limits of construction need to include all work. Limits of disturbance need to include the stripping/grading, etc. *Response: we excluded Fontaine and Lamprey north of Fontaine. We included all the other areas including the concrete washout.*
- b. The GEC Plan should show existing contours as those post-overlot grading. *Response: new cut out the existing contours where they overlap with the overlot grading areas. We also shaded back Fontaine and a portion of Lamprey to show that there were other construction plans that cover those areas.*
- c. Show and label sizes/types of all curb and gutter, storm drains, etc. *Response: storm* sewer and curb/gutter shown and added to legend. Curb types and inlet types labeled on construction plans. Inlet protection shown
- d. See GEC redlines for additional comments and clarification of these comments.
- 2. Note: A Floodplain Development Permit issued by the Regional Floodplain Administrator will be required for work in the floodplain for any necessary East Tributary channel improvements, if not already obtained. *Response: noted*
- 3. Note: Permission will be required from XCEL Energy and other utility easement grantee(s) where applicable prior to approval of the grading plans and CDs to allow grading and location of improvements within the existing utility easement(s) east of the site. *Response: noted*
- 4. Note: Ensure that all GEC Plan and SWMP checklist items (attached) are provided. GEC and SWMP checklists will be reviewed in detail with the next submittal. *Response: noted*

Forms/SIA/FAE

- 1. Provide the MS4 Post-Construction Documentation Form for both ponds. The template can be provided electronically.
- 2. Private Detention Basin/BMP maintenance agreement and easement:
 - a. Change "one" to "two" in Recitals paragraph I. Response: text changed
 - b. Change "El Paso County Development Services Department" to "El Paso County Planning and Community Development Department" in Agreement paragraph 3. *Response: text changed*
 - c. Replace the County signature block with the following: *Response: text changed* "BOARD OF COUNTY COMMISSIONERS OF EL PASO COUNTY, COLORADO

By: ____

Craig Dossey, Executive Director Planning and Community Development Department Authorized signatory pursuant to LDC

The foregoing instrument was acknowledged before me this _____ day of _____, 2018, by ______, Executive Director of El Paso County Planning and Community Development Department.

Witness my hand and official seal." (The latest template for the Agreement can be e-mailed upon request.)

- 3. FAE:
 - a. 5-inch sidewalk unit cost should be about \$58. Response: price changed
 - b. Include underdrains. *Response: underdrains included in san swr*
 - c. Verify that all inlets are included (there are 19 calculation sheets in FDR). *Response:* added inlets

- d. If a noise wall is to be constructed along Fontaine Blvd. include on the FAE. *Response:* noise wall not required since Fontaine is a non-res collector
- 4. Note: Any proposed trees/plantings in proposed county rights-of-way will require written approval from the ECM Administrator, through a license/maintenance agreement. Issues such as mature tree size and height, high maintenance requirements, destructive root systems and potential leaf litter will need to be addressed. The landscaping shall be appropriate for the conditions and easily maintainable. Draft license agreements for landscaping and mailboxes will be provided when available. (If applicant has a recent version that can be updated for the proposed improvements, applicant may provide the draft on the next review.) *Response: will submit landscaping for center of roundabout*
- 5. Regarding the SIA and FAE, all offsite improvements reviewed separately that are necessary to serve Filing No. 1, including the two EFJCC bridges, Fontaine Blvd., Lorson Blvd., and any utilities need to be accounted for in the SIA. Separate FAEs may be utilized for the various offsite improvements as long as all are referenced and accounted for in the SIA. *Response: noted*

911 AUTHORITY – ELPASO/TELLER COUNTY

Hello, All street names previously approved Thank you Justin

PIKES PEAK REGIONAL BUILDING DEPARTMENT

Enumerations:

1. The area has sat for some time and has never been addressed. *Response: we are getting addresses*

2. Since the area has been reconfigured I can no longer use the large scale copy of all the phases; please provide the entire Lorson Ranch East phases to Enumerations again at larger scale copy for addressing purposes. *Response: noted*

3. A new email from El Paso/Teller County 9-11 Authority is required approving the street names. *Response: see above response from Justin*

4. Standard Development comments: contact enumerations department for addressing. <u>Amy@pprbd.org</u> *Response: noted*

5. Standard final plat comments: enumerations/floodplain will review the mylar prior to plat for address placement, road naming, title block, & floodplain statement. \$10.00 per lot & tract fee will be due at the time of the review of the mylar. If an address in not needed on a tract then no fee applies. Check should be made out to Pikes Peak regional building department. Paid directly to enumerations department. A copy of the final recorded plat is required prior to plan submittal for residential.

Final Submittal Checklist Response: noted

LETTER OF INTENT

Marksl Creek, approx not match corrected legal Schoo detent Distric the sit	heffel Road, north/S located generally e kimately 126.25 ac inary Plan area an I District 3, detention ion pond and buffer t. The previously p te requirements of ship of the school	r/open space tracts w latted school site parc the school and for tract will remain as V	evard, and east of th ado and south of the 255 ates a port hool site pr acts for buf ill be owned/maintain cel is included in this ROW requirements Videfield School Dist	e East Tributary of Jin Colorado Springs Air ion of the Lorson R reviously dedicated to fer/open space purp ned by the Lorson Ra plat and is modified s at the proposed re	nmy Camp port and is anch East widefield oses. The anch Metro lightly to fit oundabout.
RESPONSE: FILE NUMBER UPDATE Owner Dennis Engine	LICANT A Dwner = Lors ings, CO 809 r = Widefield School s Neal, 719-391-353 pering Consultant =	Deen assigned to this p ND CONSULTANT, Son LLC & Eagle Deve 203 (attn: Jeff Mark, 7 District No. 3; 1820 M 30) = Core Engineering G ndler, 719-659-7800).	INCLUDING ADD elopment Corp; 212 N 19-635-3200) lain Street; Colorado	North Wahsatch Ave., Springs, CO 80911 (Suite 301; attn:
previou entire Lorson continu to deve no exi Metrop installe Distric waterli East F of 4.18 were r includi site lay SF); at	usly submitted and a Lorson Ranch Eas a Ranch, east of the uation of the Lorson elopment as new ro isting building struc- politan District. The ed in portions of the t currently owns and ne crosses the pro- illing 1 Plat includes 3 DU/ Acre. The second included in the of ng the Sketch Plan, yout for Lorson Rar nd 60' x 110' (6,600 creased corner lot ucted across the Ji 1. No access neighbor Policy 6.1.3 En	ICATION: Lorson R approved Lorson Ram t development site is he Jimmy Camp Creat adways will be design ctures or facilities cur ere are existing drain e Jimmy Camp Creek d maintains. The exis perty from north to so 303 single family det chool site and adjaced density calculations. PUD/ Preliminary Pla nch East includes three 'SF). Corner lots wer setback requirement immy Camp Creek E ss to the south three choods is proposed RESPONSE: NO	ch East PUD/ Prelim 274.59 acres locate eek East Tributary. and will open the ea ed and constructed b rrently owned or manage and channel in a East Tributary that ting SDS (Southern buth which shall rem ached lots on approximation this density is in line n and the Overall De ee lot types: 45' x 8 re designed with add s. Both Fontaine F ast Tributary offering ough existing d. h is contig	inary Plan PUDSP-16 ed within the eastern Lorson Ranch East astern portions of Lor oridging East & West. aintained by the Lorson provement features the Lorson Ranch M Delivery System) east ain in place. The pr kimately 72.5 acres for Blvd, Lorson Blvd, La e with existing approvelopment & Phasing 5' (3,825 SF); 50' x itional lot width to acc Blvd. and Lorson Bl g two access points bridges	5-003. The portion of will be a son Ranch There are son Ranch that were letropolitan ement and posed LR or a density amprey Dr) vals on file Plan. The 10' (5,500 commodate vd. will be as part of RESPONSE: REVISED
Address how the	previously dev 🖌	ACCESS NOTE AI	DDED. such as d	density, land use and	access.
outreach has been going with the		pproved Lorson Rancl -16-003).			
existing community. 2. This was brought up at the BOCC hearing amndPC hearing with the PUD. RESPONSE: A S WAS ADDED TO 6.1.3 SECTION R ADJACENT COM	Policy 6.1.6 Direct supporting facilit LR East Filing 1 is community eastware existing residentia SOLICES ARE COMPARED ENTENCE THE POLICY EGARDING	ct development towa ties and services are s within the overall Lors ard. The proposed de il development within L ble of supporting the p ype of density. Page 1	available or will be son Ranch developm nsity and lot sizes are orson Ranch. The p proposed housing uni You could mention lines to better set the south as a be	developed concurrent ent and is a continua e similar and compati proposed facilities and ts as these services w on the upgrading or erve the communit	ently. The tion of the ole to public vere
				RESPONSE: NO	

TO POLICY 6.1.6 SECTION.

- 3. Policy 6.1.8 Encourage incorporating buffers or transitions between areas of varying use or density where possible. - Buffers are provided per the PUD/Preliminary Plan as well as additional areas of open space and transitions to the south and north. To the west the Jimmy Camp Creek East Tributary creates a natural amenity and buffer between Lorson Ranch neighborhoods.
- 4. Policy 6.1.15 Recognize the need for new development and redevelopment to respond to changes in demographic, market and technological conditions. - Lorson Ranch East is in response to the market demand for single family residential lots

	_	is in response to the market demand i	
with the			
previously		EXISTING AND PROPOSED FACILITIES S	TRUCTURES, ROADS, ETC: Existing facilities consist
approved			Boulevard and watermain in Fontaine Boulevard at Old
modificati			cal residential roads, watermain, sanitary sewer, storm
ons. If			I a detention/WQ ponds to serve the site. All proposed punty design standards.
any deviations		RESPONSE: grass	unty design standards.
are now			D JUSTIFICATION: there are no waivers requested
being		first submittal so it is	ANGE IN ZONE CLASSIFICATION: The Final Plat
requested			ite.
in			
addition			QUESTED AREA: Lorson Ranch East Filing No. 1
to those		comprises 126.25 acres.	
approved			AND DENSITIES FOR EACH DWELLING TYPE: 303
identify			72.5 acres (4.18 Du/ Acre). We did not include the
here and justify.		school site, Fontaine Bivd, Loison Bivd, Fond	C5, and Lamprey Drive for calculating density, are the tracts
justity.		NUMBER OF INDUSTRIAL OR COMMERCIA	AL SITE OF fontaine will be Containing the
			NDUSTR included in Ire2 final plat JSES: None.
			that we are currently
		NUMBER OF MOBILE HOME UNITS AND D	ENSITIE
		TYPICAL LOT SIZES (Length and width):	Single Family Residential average lot size 5500 sq. ft.
		(50' x 110' min)	
			isn't adding up OF LAND TO BE SET ASIDE AS OPEN SPACE,
		DETENTION, and PARK: Final Plat = 126-23	Sacres. Open Space, det RESPONSE: acreages
		Tributary of Jimmy Camp Creek as open space	checked
		TYPE OF PROPOSED RECREATIONAL FA	CILITIES: Public sidewalks will be constructed along
			maintained by the Lorson Ranch Metropolitan District.
			ED, HOW WILL IT BE PHASED? This plat will be for
		the entire Lorson Ranch East Filing No. 1 RE	
		be	ded here
		HOW WATER AND SEWER WILL BE	ugh the Widefield Water &
		Provide entity responsi	ble for maintaining underdrains.
			EEN USES AND DENSITIES: The proposed use is
		Residential Single Family.	
		AREAS OF REQUIRED LANDSCAPING:	

The proposed Lorson Ranch East Final Plat Filing 1 includes a landscape plan for streetscape plantings along both Fontaine Blvd. and Lorson Blvd. There are no landscape modifications being requested at this time. The proposed landscaping along Fontaine Blvd. includes 1 tree per 20 linear feet of frontage for a total of 63 trees as part of this first filing. The proposed landscaping along Lorson Blvd. includes 1 tree per 30 linear feet of frontage for a total of 48 trees as part of this first filing. The planting design incorporates a mix of evergreen and deciduous trees in addition to a 6' wood screen fence proposed along the back of the individual lots. Additional areas of open space include the existing SDS easement and the open space provided along the east tributary of Jimmy Camp Creek.

Is a noise wall being constructed along Fontaine?

- PROPOSED ACCESS LOCATIONS: Lorson Boulevard
- Boulevard and **RESPONSE: A NOISE WALL IS** NOT BEING PROVIDED AS ONE **TRAFFIC IMPACT FEE:** This final plat for IT NOT REQUIRED. A NOTE aso County PID HAS BEEN ADDED.
- No. 2 and will pay the associated fee.
- MAILBOX LOCATION: Lorson Ranch East Filing No. 1 will utilize several centralized location (cluster) for mailboxes which is shown on the construction drawings. The mailbox clusters will be located within the street ROW.
- SCHOOL SITE DEDICATION: Dedication of a school site was completed as part of the Pioneer Landing at Lorson Ranch Filing No. 2 Final Plat which will satisfied the school dedication requirement for final plats within Lorson Ranch and in accordance with the recorded Lorson Ranch School Land Bank Agreement. In recent months, Widefield School District 3 has completed an updated school site plan and wants to modify the school site boundary slightly to fit the new site plan. This plat adjusts the previously platted school site to accommodate school site plan changes and ROW requirements for the roundabout at Fontaine/Lamprey. The modified school site is a 25.11acre site (Tract J) located East of the East Tributary of Jimmy Camp Creek. The modified school site size is over the 25-acre minimum size.

Markup Summary

dsdrice (2)		
<list-item><list-item><list-item><list-item><list-item><list-item><list-item><list-item><list-item><list-item><list-item><list-item><list-item></list-item></list-item></list-item></list-item></list-item></list-item></list-item></list-item></list-item></list-item></list-item></list-item></list-item>	Subject: Text Box Page Label: 2 Lock: Unlocked Status: Checkmark: Unchecked Author: dsdrice Date: 4/15/2018 4:44:59 PM Color:	Provide entity responsible for maintaining underdrains.
An experience of a difference of a difference of a second	Subject: Text Box Page Label: 3 Lock: Unlocked Status: Checkmark: Unchecked Author: dsdrice Date: 4/15/2018 4:46:57 PM Color:	Is a noise wall being constructed along Fontaine?
dsdparsons (9)		
It example approvants on the protect S, Phasing Plant. The original set of the secons product of the secons product of the secons product and the secons product and the secons product and the secons product and the secons product of the secons of the sec	Subject: Callout Page Label: 1 Lock: Unlocked Status: Checkmark: Unchecked Author: dsdparsons Date: 4/4/2018 12:50:29 PM Color:	bridges
2 EUROVESION IMM Minishells Road, or Acreage doe not match corrected legal School Galacia, 8 at corrected legal School Galacia, 4 at corrected legal School Galacia, 4 at Balacia, 1 The previo Galacia, 1 The previo Balacia, 1 The previo Balacia, 1 The previo Balacia, 1 The previo Balacia, 1 The previous Balacia, 1 The previous Balacia, 1 The previous Balacia, 1 The previous Balacia, 1 The previous Balacia, 1 The previous Balacia, 1 The	Subject: Callout Page Label: 1 Lock: Unlocked Status: Checkmark: Unchecked Author: dsdparsons Date: 4/4/2018 12:48:53 PM Color:	Acreage does not match corrected legal
Art Hits, Pitrominal Stapping stress that a sprage stress that a spra	Subject: Callout Page Label: 1 Lock: Unlocked Status: Checkmark: Unchecked Author: dsdparsons Date: 4/4/2018 12:50:59 PM Color:	No access to the south through existing neighborhoods is proposed.
Preinteary Plan ar School District 3, d detention pond and Date of the plante SF-10-8 Number 914-60.co. Owner4914-60.co. Owner4914-60.co. Owner492-0.co. Owner492-0.co. Owner492-0.co. Owner492-0.co. Owner492-0.co. Owner492-0.co. Owner492-0.co. Owner492-0.co. Owner492-0.co.	Subject: Callout Page Label: 1 Lock: Unlocked Status: Checkmark: Unchecked Author: dsdparsons Date: 4/4/2018 12:42:14 PM Color:	SF-18-8

------Subject: Callout You could mention the upgrading of lines to better Page Label: 1 serve the community to the south as a benefit. Lock: Unlocked Status: Checkmark: Unchecked Author: dsdparsons Date: 4/4/2018 12:52:54 PM Color: Subject: Callout Address how the outreach has been going with the Page Label: 1 existing community. This was brought up at the Lock: Unlocked BOCC hearing amndPC hearing with the PUD. Status: Checkmark: Unchecked Author: dsdparsons Date: 4/4/2018 12:52:04 PM Color: Subject: Callout something isn't adding up.... Page Label: 2 Lock: Unlocked Status: Checkmark: Unchecked Author: dsdparsons Date: 4/4/2018 12:59:03 PM Color: _____ Subject: Callout are the tracts containing the channel included? Page Label: 2 Lock: Unlocked Status: Checkmark: Unchecked Author: dsdparsons Date: 4/4/2018 12:55:28 PM Color: Subject: Callout with the previously approved modifications. If any Page Label: 2 deviations are now being requested in addition to Lock: Unlocked those approved identify here and justify. Status: Checkmark: Unchecked Author: dsdparsons Date: 4/4/2018 12:54:50 PM Color:

DRAINAGE REPORT COMMENTS

	Subject: Polygonal Line Page Label: 33 Lock: Unlocked Status: Checkmark: Unchecked Author: RSchindler Date: 2/13/2018 1:16:50 PM Color: ■	
	Subject: Text Box Page Label: 33 Lock: Unlocked Status: Checkmark: Unchecked Author: RSchindler Date: 6/28/2017 8:52:33 AM Color: ■	SITE
MATTA DR	Subject: Text Box Page Label: 85 Lock: Unlocked Status: Checkmark: Unchecked Author: RSchindler Date: 2/13/2018 7:39:58 AM Color: ■	MATTA DR
	Subject: Text Box Page Label: 85 Lock: Unlocked Status: Checkmark: Unchecked Author: RSchindler Date: 2/13/2018 7:40:54 AM Color:	LAMINE DR
dsdrice (59)		
CH EAST FILING NO. 1 ARGH 1, 2018 SF-100000 0008	Subject: Cloud+ Page Label: 1 Lock: Unlocked Status: Checkmark: Unchecked Author: dsdrice Date: 4/11/2018 9:46:58 AM Color:	008 title changed
and is refe le forebays Grading Pla	Subject: Delete Page Label: 4 Lock: Unlocked Status: Checkmark: Unchecked Author: dsdrice Date: 4/11/2018 10:39:49 AM Color:	Delete text updated

Martin de la construction de	Subject: Callout Page Label: 4 Lock: Unlocked Status: Checkmark: Unchecked Author: dsdrice Date: 4/11/2018 10:42:05 AM Color:	improvements north of fontaine called out	Address improvements north of Fontaine.
The analy. The steels of the fact of the start relation of the fact of the start of	Subject: Callout Page Label: 4 Lock: Unlocked Status: Checkmark: Unchecked Author: dsdrice Date: 4/11/2018 10:37:32 AM Color:	text updated	and PDR
In particular, see continued a 2014.	Subject: Cloud+ Page Label: 4 Lock: Unlocked Status: Checkmark: Unchecked Author: dsdrice Date: 4/11/2018 10:43:42 AM Color:	text updated to "graded"	graded (?)
A set of the set of th	Subject: Callout Page Label: 4 Lock: Unlocked Status: Checkmark: Unchecked Author: dsdrice Date: 4/11/2018 10:36:57 AM Color:	text updated	south of Fontaine Blvd.
oup ast which covers this final n East and is referenced in des (the forebays for Dete Early Grading Plans for Lo	Subject: Highlight Page Label: 4 Lock: Unlocked Status: Checkmark: Unchecked Author: dsdrice Date: 4/11/2018 10:49:56 AM Color:	text deleted	Delete
A story on not calculate dramping lines to sprane 12 Mar. The story of the story o	Subject: Cloud+ Page Label: 4 Lock: Unlocked Status: Checkmark: Unchecked Author: dsdrice Date: 4/11/2018 10:39:08 AM Color:	text added	final plat

which 1400 kink menotokina with the 190 kink hardword advance macket with 1 kink with hardword advance macket with 1 kink with hardword advance with the 100 kink with 100 kink with 100 kink with 100 kink with 100 kink with 100 kink with 100 kink with 100 kink with 100 kink with 100 kink with 100 kink with 100 kink with 100 kink with 100 kink with 100 kink with 100	Subject: Callout Page Label: 4 Lock: Unlocked Status: Checkmark: Unchecked Author: dsdrice Date: 4/11/2018 10:38:21 AM Color:	and PDR text updated
 A state of the sta	Subject: Callout Page Label: 4 Lock: Unlocked Status: Checkmark: Unchecked Author: dsdrice Date: 4/11/2018 10:43:28 AM Color:	address bridges
s adjacent space in th	Subject: Delete Page Label: 5 Lock: Unlocked Status: Checkmark: Unchecked Author: dsdrice Date: 4/11/2018 10:48:25 AM Color:	Delete text deleted
t, the soil of each basin are ass rs, is galacent to this sile on the ren space in the future. It is the towers for detention of storm fic at Tributary through this site	Subject: Highlight Page Label: 5 Lock: Unlocked Status: Checkmark: Unchecked Author: dsdrice Date: 4/11/2018 10:49:41 AM Color:	Delete text deleted
to be wholly comprised of tr An existing electrical easen side of this portion of the dr of this drainage report to uti The FMIC (irrigation can decommissioned in 2006 ¢ existing drainage calculatic	•	future Lorson East development?
Not an any end of the state of	Subject: Callout Page Label: 5 Lock: Unlocked Status: Checkmark: Unchecked Author: dsdrice Date: 4/11/2018 10:46:05 AM Color:	(prior to early grading) text updated

As while a distribution is used as the second secon	Subject: Text Box Page Label: 6 Lock: Unlocked Status: Checkmark: Unchecked Author: dsdrice Date: 4/15/2018 1:53:04 PM Color:	Address interim condition offsite flows and future conditions. interim analysis
A structure The Constructure of the Construct	Subject: Text Box Page Label: 6 Lock: Unlocked Status: Checkmark: Unchecked Author: dsdrice Date: 4/15/2018 1:51:44 PM Color:	Address early grading and conditions when that is complete. This report should pick up from there. new section added for interim conditions
set Metada and an	Subject: Callout Page Label: 6 Lock: Unlocked Status: Checkmark: Unchecked Author: dsdrice Date: 4/13/2018 4:20:21 PM Color:	and offsite undeveloped areas (EX1-EX3?) offsite areas added in the interim section
<text><text><text><text><text></text></text></text></text></text>	Subject: Callout Page Label: 6 Lock: Unlocked Status: Checkmark: Unchecked Author: dsdrice Date: 4/11/2018 3:29:12 PM Color:	north of Fontaine Blvd.
 An appropriate of schedule are sub-schedule and schedule and schedule are scheduled and spin schedule and schedule are scheduled and spin schedule and schedule are scheduled are schedu	Subject: Callout Page Label: 6 Lock: Unlocked Status: Checkmark: Unchecked Author: dsdrice Date: 4/13/2018 3:45:44 PM Color:	Add: "update (see Appendix B.)" text added for table 6-6
	Subject: Cloud+ Page Label: 6 Lock: Unlocked Status: Checkmark: Unchecked Author: dsdrice Date: 4/13/2018 3:44:05 PM Color:	This is the FDR!

And the the design and the design an	Subject: Callout Page Label: 7 Lock: Unlocked Status: Checkmark: Unchecked Author: dsdrice Date: 4/15/2018 1:27:11 PM Color:	text updated	Address sub-basin D1-ex
<text><text><text><text><text><text><text><text><text></text></text></text></text></text></text></text></text></text>	Subject: Cloud+ Page Label: 7 Lock: Unlocked Status: Checkmark: Unchecked Author: dsdrice Date: 4/15/2018 1:04:46 PM Color:	basin included	Include
Land to specify the second sec	Subject: Cloud+ Page Label: 7 Lock: Unlocked Status: Checkmark: Unchecked Author: dsdrice Date: 4/13/2018 4:19:28 PM Color:	basin included	include in this report also
	Subject: Cloud+ Page Label: 7 Lock: Unlocked Status: Checkmark: Unchecked Author: dsdrice Date: 4/15/2018 1:05:17 PM Color:	map included	Include
rive, Weiser Drive, and Lamprey [50 to a proposed Type 'R' Inlet in : ns. provide flows I Lamine Drive. Runoff is directed er 'R' inlet in Lamine Drive. Ser m this basin is 1.7cfs and 3.8cfs fc	Subject: Text Box Page Label: 8 Lock: Unlocked Status: Checkmark: Unchecked Author: dsdrice Date: 4/15/2018 1:15:31 PM Color:	flows added	provide flows
e v me i umor umo de no s his bain is 17th and 38th for me off a directed out is outlighter to control to the second second second provides flows of chash one, candi second second type 1% relativity and second second second second second type 1% relativity and second secon	Subject: Text Box Page Label: 8 Lock: Unlocked Status: Checkmark: Unchecked Author: dsdrice Date: 4/15/2018 1:14:50 PM Color:	flows added	provide flows

a, Lamine Drive, and Yuba Drive. Ive. See the appendix for detailed provide flows we. Runoff is directed south in ine Drive. See the appendix for 3cfs and 5.8cfs for the 5/100-vear	Subject: Text Box Page Label: 9 Lock: Unlocked Status: Checkmark: Unchecked Author: dsdrice Date: 4/15/2018 1:15:44 PM Color:	flows added	provide flows
ıt,	Subject: Highlight Page Label: 9 Lock: Unlocked Status: Checkmark: Unchecked Author: dsdrice Date: 4/15/2018 1:16:31 PM Color:		
	Subject: Text Box Page Label: 9 Lock: Unlocked Status: Checkmark: Unchecked Author: dsdrice Date: 4/15/2018 1:28:27 PM Color:	text added for interim flow conditions	Address interim and future conditions flows and conveyances for each of the basins below.
r the electric easement, th and west in curb/gutter ons. provide flows noff is directed south in The peak developed flow	Subject: Text Box Page Label: 9 Lock: Unlocked Status: Checkmark: Unchecked Author: dsdrice Date: 4/15/2018 1:17:06 PM Color:	flows added	provide flows
in fs	Subject: Highlight Page Label: 10 Lock: Unlocked Status: Checkmark: Unchecked Author: dsdrice Date: 4/15/2018 1:24:13 PM Color:		
	Subject: Highlight Page Label: 10 Lock: Unlocked Status: Checkmark: Unchecked Author: dsdrice Date: 4/15/2018 1:55:58 PM Color:		

S	Subject: Highlight Page Label: 10 Lock: Unlocked Status: Checkmark: Unchecked Author: dsdrice Date: 4/15/2018 1:56:05 PM Color:		
1	Subject: Highlight Page Label: 12 Lock: Unlocked Status: Checkmark: Unchecked Author: dsdrice Date: 4/15/2018 2:10:00 PM Color:		
	Subject: Cloud+ Page Label: 22 Lock: Unlocked Status: Checkmark: Unchecked Author: dsdrice Date: 4/15/2018 3:43:38 PM Color:	section 3.1 added for interim flow analysis	This needs to be designed and modeled completely for the interim condition. Provide calculations for both interim (Filing 1 plus undeveloped offsite) and ultimate conditions.
	Subject: Cloud+ Page Label: 22 Lock: Unlocked Status: Checkmark: Unchecked Author: dsdrice Date: 4/15/2018 3:42:40 PM Color:	pond removed from text	Is this pond really necessary for Filing 1? Include details in report if so.
<section-header><text><text><section-header><text><list-item><list-item><list-item><section-header><section-header></section-header></section-header></list-item></list-item></list-item></text></section-header></text></text></section-header>	Subject: Callout Page Label: 22 Lock: Unlocked Status: Checkmark: Unchecked Author: dsdrice Date: 4/15/2018 3:44:47 PM Color:	Interim ponds in Section 3.1	Provide undeveloped/developed area for interim condiiton.
	Subject: Cloud+ Page Label: 23 Lock: Unlocked Status: Checkmark: Unchecked Author: dsdrice Date: 4/15/2018 3:46:56 PM Color:	text added for clarity	? Explain.


 when any the factors when you'ry an observations of the distribution between the sectors of the distribution of t	Subject: Text Box Page Label: 23 Lock: Unlocked Status: Checkmark: Unchecked Author: dsdrice Date: 4/15/2018 3:46:36 PM Color:	Provide interim and ultimate modeling and narrative. section 3.1 added
<text></text>	Subject: Cloud+ Page Label: 24 Lock: Unlocked Status: Checkmark: Unchecked Author: dsdrice Date: 4/13/2018 12:45:52 PM Color:	re-calculate
Large surface to exercise and a surface of the surf	Subject: Callout Page Label: 24 Lock: Unlocked Status: Checkmark: Unchecked Author: dsdrice Date: 4/15/2018 2:56:58 PM Color:	Is this buffer to be constructed and maintained in accordance with DCM2?
Enderströmmer Bergenstein auf der Bergenstein Ber	Subject: Text Box Page Label: 26 Lock: Unlocked Status: Checkmark: Unchecked Author: dsdrice Date: 4/15/2018 2:58:04 PM Color:	Address maintenance access to EFJCC. text added to explain access to etrib
	Subject: Text Box Page Label: 43 Lock: Unlocked Status: Checkmark: Unchecked Author: dsdrice Date: 4/15/2018 3:02:10 PM Color:	Provide interim off-site basin calculations.
•	Subject: Highlight Page Label: 73 Lock: Unlocked Status: Checkmark: Unchecked Author: dsdrice Date: 4/15/2018 3:35:15 PM Color:	

why not?	Subject: Cloud+ Page Label: 73 Lock: Unlocked Status: Checkmark: Unchecked Author: dsdrice Date: 4/15/2018 3:21:31 PM Color:	text changed to be clearer	why not?
Provide a state of st	Subject: Text Box Page Label: 84 Lock: Unlocked Status: Checkmark: Unchecked Author: dsdrice Date: 4/15/2018 4:05:49 PM Color:	section 3.1 added. interim flows do not exceed design flows	Provide for all storm systems serving Filing No. 1, including interim conditions accommodating offsite flows.
	Subject: Cloud+ Page Label: 88 Lock: Unlocked Status: Checkmark: Unchecked Author: dsdrice Date: 4/15/2018 4:03:41 PM Color:	text added	Address interim condition
Line Handreicher Stehnen und eine Herricher Stehnen und	Subject: Cloud+ Page Label: 97 Lock: Unlocked Status: Checkmark: Unchecked Author: dsdrice Date: 4/13/2018 11:47:04 AM Color:	text changed for cl	Include in this report as if that report doesn't exist. (See comment 1.a on that project.) arity
	Subject: Cloud+ Page Label: 97 Lock: Unlocked Status: Checkmark: Unchecked Author: dsdrice Date: 4/13/2018 3:59:03 PM Color:	basins included on ne map	Where is boundary (aren't basins EX1 through EX3 included)? ew
	Subject: Callout Page Label: 97 Lock: Unlocked Status: Checkmark: Unchecked Author: dsdrice Date: 4/13/2018 11:30:38 AM Color:	storm sewer adde	Show storm sewer


Subject: Callout Page Label: 97 Lock: Unlocked Status: Checkmark: Unchecked Author: dsdrice Date: 4/13/2018 3:59:54 PM Color:	bridges labeled, design points are on map from pdr that is inserted in map pocket.	Label bridges and provide channel design points and flows.
Subject: Text Box Page Label: 97 Lock: Unlocked Status: Checkmark: Unchecked Author: dsdrice Date: 4/13/2018 4:00:48 PM Color:	linetype added	Add storm drain linetypes.
Subject: Area Measurement Page Label: 97 Lock: Unlocked Status: Checkmark: Unchecked Author: dsdrice Date: 4/13/2018 3:55:58 PM Color:		3,846,826 sf
Subject: Text Box Page Label: 98 Lock: Unlocked Status: Checkmark: Unchecked Author: dsdrice Date: 4/15/2018 4:37:50 PM Color:	note added addressing fontaine sub-basins.	Include Fontaine sub-basins
Subject: Callout Page Label: 98 Lock: Unlocked Status: Checkmark: Unchecked Author: dsdrice Date: 4/13/2018 11:35:27 AM Color:	note added address system to the east	Provide complete plan with system to the east
Subject: Cloud+ Page Label: 98 Lock: Unlocked Status: Checkmark: Unchecked Author: dsdrice Date: 4/13/2018 11:32:38 AM Color:	note added. interim map shows flows.	Show stub, TSB(?) as part of Filing 1 construction. Provide interim design point.

Thing Development	Subject: Text Box Page Label: 99 Lock: Unlocked Status: Checkmark: Unchecked Author: dsdrice Date: 4/15/2018 1:29:32 PM Color:	text added	Future Development
Forure Desconnent 222	Subject: Text Box Page Label: 99 Lock: Unlocked Status: Checkmark: Unchecked Author: dsdrice Date: 4/15/2018 1:29:45 PM Color:	text added	Future Development
	Subject: Cloud+ Page Label: 99 Lock: Unlocked Status: Checkmark: Unchecked Author: dsdrice Date: 4/15/2018 1:48:02 PM Color:	ext added	Show and label per CDs; address riser capacity, overflow path
alex.dabdub (2)			
January 29, 2015 - 957 OF 1300 NDEX FOR PANELS NOT PRINTED)	Subject: Text Box Page Label: 33 Lock: Unlocked Status: Checkmark: Unchecked Author: alex.dabdub Date: 9/16/2014 1:47:49 PM Color:		January 29, 2015
COLORADO AND INCORPORATED AI REVISED TO REFLECT LOMR EFFECTIVE: PANEL 957 OF 1300 ISEE MAINING FOR DIMELS AN	Subject: LOMR Stamp Page Label: 33 Lock: Unlocked Status: Checkmark: Unchecked Author: alex.dabdub Date: 9/16/2014 1:47:49 PM Color:		

Markup Summary - GRADING PLAN

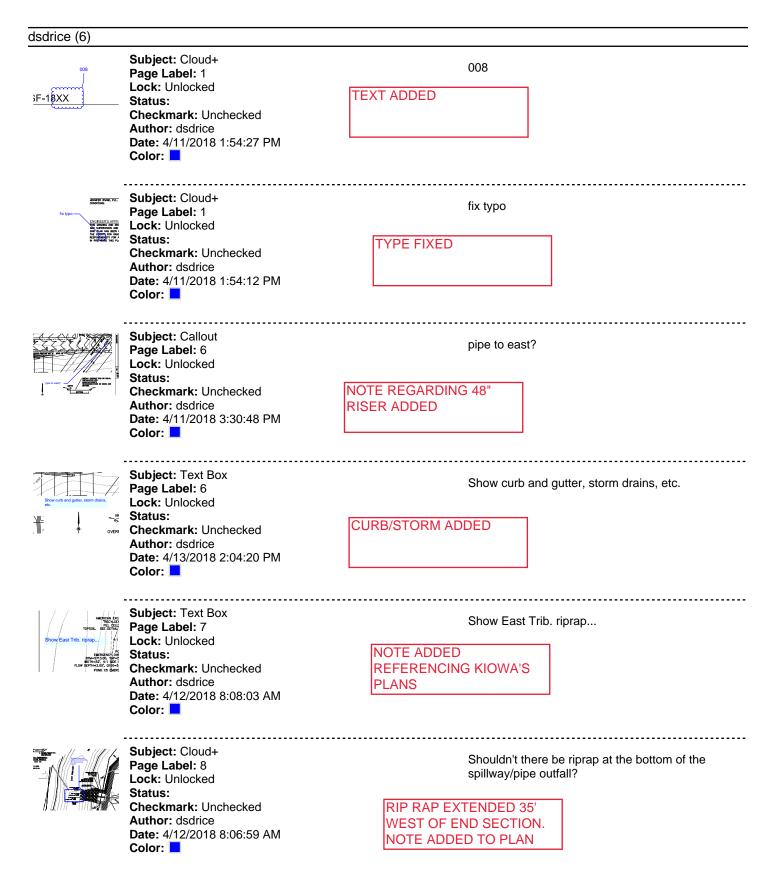

Markup Summary - STREET/STORM CD'S

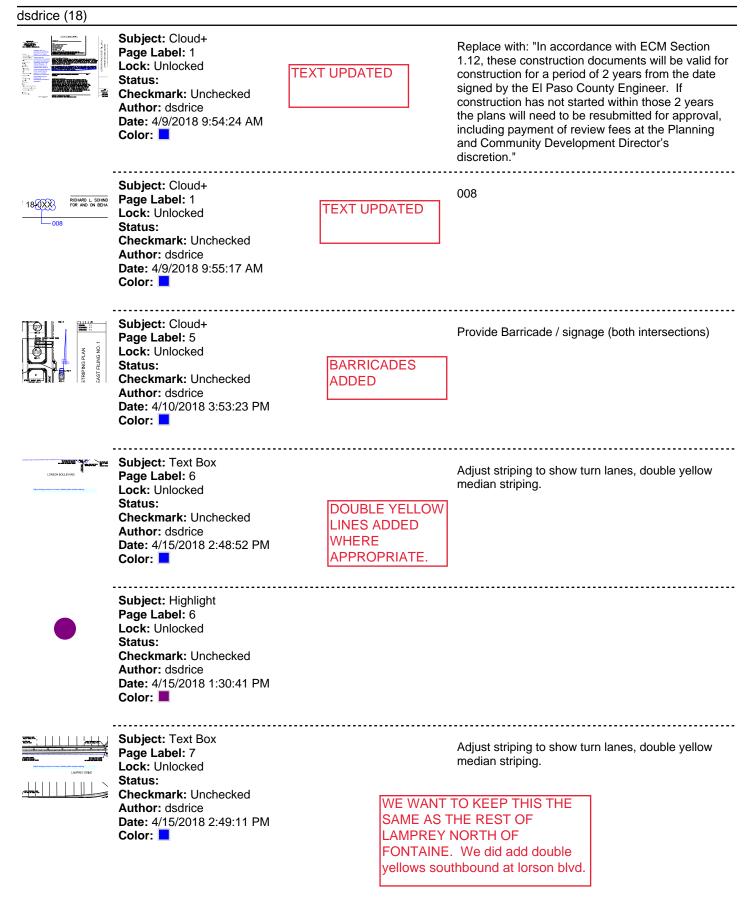

	Subject: Text Box Page Label: 24 Lock: Unlocked Status: Checkmark: Unchecked Author: dsdrice Date: 4/15/2018 1:37:08 PM Color:	Here? KEY MAP UDPATED
	Subject: Cloud+ Page Label: 27 Lock: Unlocked Status: Checkmark: Unchecked Author: dsdrice Date: 4/15/2018 1:35:35 PM Color:	show grading tie-ins GRADING TIE-INS ADDED
	Subject: Callout Page Label: 31 Lock: Unlocked Status: Checkmark: Unchecked Author: dsdrice Date: 4/15/2018 2:47:01 PM Color:	Provide vertical curve data VERTICAL CURVE DATA ADDED
	Subject: Cloud+ Page Label: 32 Lock: Unlocked Status: Checkmark: Unchecked Author: dsdrice Date: 4/11/2018 1:50:15 PM Color:	correct the flow direction FLOW DIRECTION CHANGED
LAUPERT IN	Subject: Callout Page Label: 33 Lock: Unlocked Status: Checkmark: Unchecked Author: dsdrice Date: 4/11/2018 1:48:41 PM Color:	Is there a temporary curb to keep flow in the street?
	Subject: Highlight Page Label: 33 Lock: Unlocked Status: Checkmark: Unchecked Author: dsdrice Date: 4/15/2018 2:40:52 PM Color:	

Show access roads.	Subject: Text Box Page Label: 36 Lock: Unlocked Status: Checkmark: Unchecked Author: dsdrice Date: 4/11/2018 2:44:47 PM Color:	Show access roads. ACCESS ROAD SHOWN
NSTRUCTION FLAND REF: ORROX 183	Subject: Cloud+ Page Label: 36 Lock: Unlocked Status: Checkmark: Unchecked Author: dsdrice Date: 4/11/2018 2:44:12 PM Color:	183 TEXT UPDATED
Show botting pattern	Subject: Callout Page Label: 38 Lock: Unlocked Status: Checkmark: Unchecked Author: dsdrice Date: 4/11/2018 3:00:50 PM Color:	Show bolting pattern BOLT PATTERN SHOWN
TRACT C Show access roads.	Subject: Text Box Page Label: 39 Lock: Unlocked Status: Checkmark: Unchecked Author: dsdrice Date: 4/11/2018 3:01:37 PM Color:	Show access roads. ACCESS ROAD SHOWN
Show bolting pattern THUCTURE HARDING WITH 5 GA	Subject: Callout Page Label: 41 Lock: Unlocked Status: Checkmark: Unchecked Author: dsdrice Date: 4/11/2018 3:02:54 PM Color:	Show bolting pattern BOLT PATTERN SHOWN
	Subject: Cloud+ Page Label: 44 Lock: Unlocked Status: Checkmark: Unchecked Author: dsdrice Date: 4/15/2018 2:26:03 PM Color:	delete?

TRIP GENERATION

Estimates of the traffic volumes expected to be generated by the site have been made using the nationally published trip generation rates found in *Trip Generation*,10th Edition, 2017 by the Institute of Transportation Engineers (ITE). Table 1 shows the results of the trip generation estimates.

As shown in Table 1, Lorson Ranch East Filing 1 is projected to generate about 2,860 new vehicletrips on the average weekday, with about one-half of the vehicles entering and one-half of the vehicles exiting in a 24-hour period. During the morning peak hour, which generally occurs for one hour between 6:30 and 8:30 a.m., about 56 vehicles would enter and 168 vehicles would exit the site. During the afternoon peak hour, which generally occurs for one hour between 4:30 and 6:30 p.m., about 189 vehicles would enter and 111 vehicles would exit the site.

SHORT-TERM AND 2040 TOTAL TRAFFIC Address school site, its requirements, and separate traffic study to be submitted.

Please refer to Preliminary Plan TIS for the short-term and 2040 total traffic volumes, level of service analysis, and traffic signal warrant analysis.

TRAFFIC SIGNAL ESCROW AMOUNTS

The Lorson Ranch Preliminary Plan TIS estimated a fair share contribution towards a future signal at the intersection of Marksheffel/Lorson would be \$93,950 for Lorson Ranch East Phase 1. Filing 1 is planned to contain 303 of the 331 lots assumed in Phase 1. Based on the proposed number of lots in Filing 1, the contribution for Filing 1 would be \$86,003.

ROADWAY CLASSIFICATIONS

As shown on Figure 15 of the Lorson Ranch East Preliminary Plan TIS, all of the internal streets within Lorson Ranch East Filing 1 should be classified as Urban Local.

ROADWAY IMPROVEMENT FEE PROGRAM

This project will be required to participate in the El Paso County Road Improvement Fee Program. Lorson Ranch East Filing 1 will join the ten-mil PID. The ten-mil PID building permit fee portion associated with this option is \$923 per single-family dwelling unit. Based on 303 lots, the total building permit fee would be \$279,669.

* * * *

Provide a paragraph stating what roads and intersections are being constructed with Filing No. 1. Reference Phasing Plan for Phase 1.

3

Summary of Comments on traffic redline 1.pdf

Page: 3

Number: 1 Author: dsdrice Date: 4/10/2018 3:43:21 PM Subject: Text Box

Address school site, its requirements, and separate traffic study to be submitted.

OK

Status jchodsdon Completed Number: 2 Author: dsdrice

4/25/2018 8:17:59 AM Date: 4/11/2018 9:35:11 AM Subject: Highlight

Number: 3 Author: dsdrice Subject: Text Box Date: 4/10/2018 3:45:17 PM

Provide a paragraph stating what roads and intersections are being constructed with Filing No. 1. Reference Phasing Plan for Phase 1.


Status jchodsdon Completed

4/25/2018 8:18:10 AM

LORSON RANCH EAST FILING NO. 1

A PORTION OF THE SOUTHWEST QUARTER (SW 1/4) SECTION 13, AND A PORTION OF THE SOUTHEAST QUARTER (SE 1/4) SECTION 14, Please note: A A PORTION OF THE NORTHEAST QUARTER (NE 1/4) SECTION 23, AND A PORTION OF THE NORTHWEST QUARTER (NW 1/4) SECTION 24. TOWNSHIP 15 SOUTH, RANGE 65 WEST OF THE SIXTH PRINCIPAL MERIDIAN, EL PASO COUNTY, COLORADO



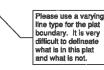

SURVEYORS CERTIFICATE

I VERNON P. TAYLOR, A DULY REGISTERED PROFESSIONAL LAND SURV STATE OF COLORADO, DO HEREBY CERTIFY THAT THIS PLAT TRULY AN REPRESENTS THE RESULTS OF A SURVEY MADE ON NOVEMBER 02, 201 UNDER MY DIRECT SUPERVISION AND THAT ALL MONUMENTS EXIST AS HEREON: THAT MATHEMATICAL CLOSURE ERRORS ARE LESS THAN 1:10 THAT SAID PLAT HAS BEEN PREPARED IN FULL COMPLIANCE WITH ALL LAWS OF THE STATE OF COLORADO DEALING WITH MONUMENTS, SUBD SURVEYING OF LAND AND ALL APPLICABLE PROVISIONS OF THE EL PAS LAND DEVELOPMENT CODE

ATTEST THE ABOVE ON THIS	DAY OF	 2018.

VERNON P. TAYLOR DATE COLORADO PLS NO. 25986, FOR AND ON BEHALF OF M&S CIVIL CONSULTANTS, INC 20 BOULDER CRESCENT, SUITE 110 COLORADO SPRINGS, COLORADO 80903

OTICE:

ACCORDING TO COLORADO LAW, YOU MUSIT COMMENCE ANY LEGAL ACTION BASED UPC THIS SURVEY WITHIN THREE YEARS AFTER YOU FIRST DISCOVER SUCH DEFECT. IN NO B ACTION BASED UPON ANY DEFECT IN THIS SURVEY BE COMMENCED MORE THAN THEN YE

DENCATIONAL OF LAND TO THE PUBLIC MICLUDING BRREETS, EASEMENTS ARE ACCEPTED, BUT PUBLIC IMPROVEMENTS THEREON WI BECOME THE MAINTENANCE RESPONSIBILITY OF EL PASO COUNTY UNT PRELIMINARY ACCEPTANCE OF THE PUBLIC IMPROVEMENTS IN ACCORD THE REQUIREMENTS OF THE LAND DEVELOPMENT CODE AND ENGINEE MANUAL, AND THE SUBDIVISION IMPROVEMENTS AGR

D

PRESIDENT, BOARD OF COUNTY COMMISSIONERS	-
ec76 Z	

PPROVAL IS GRANTED FOR THIS PLAT OF "LORSON RANCH EAST FILM DAY OF . 2018. A

ASO COUNT	/ DIRECTOR	OF DI AMNU	AG AND COL	AM INITY I	OEVELO
000000	DIRECTOR	OL LIPHUM	0 1410 001		

ECORDING:	
TATE OF COLORADO	3

HEREBY CERTIFY THAT THIS INSTRUMENT WAS FILED FOR RECORD AT

AT O'CLOCK .M., THIS DAY OF AND IS DULY RECORDED UNDER RECEPTION NUMBER OF THE RECORDS OF EL PASO COUNTY, COLORADO,

SHOCK DROCHWAR, RECORDER	CHUCK	BROERMAN,	RECORDER
--------------------------	-------	-----------	----------

FEE: ___

BY-	
 DEPUTY	•

KNOW ALL MEN BY THESE PRESENTS:

THAT LORSON LLC A COLORADO LIMITED LIABILITY COMPANY,AS NOMINEE FOR LORSON CONSERVATION INVESTI, LLP A COLORADO LIMITED LIABILITY LIMITED PARTNERSHIP AND LORSON LLC A COLORADO LIMITED LIABILITY COMPANY,AS NOMINEE FOR MURRAY FOUNTAIN LLC, A COLORADO LIMITED LIABILITY COMPANY, AND EAGLE DEVELOPMENT COMPANY, A COLORADO COMPANY AND WIDEFIELD SCHOOL DISTRICT 3 BEING THE OWNERS OF THE FOLLOWING DESCRIBED TRACT OF LAND:

TO WIT:


A PARCEL OF LAND IN THE SW 1/4 SECTION 13, AND THE SE 1/4 SECTION 14, AND THE NE 1/4 SECTION 23, AND THE NW 1/4 SECTION 24, AND A REPLAT OF TRACTS I AND J OF "PIONEER LANDING AT LORSON RANCH FILING NO. 2" AS RECORDED LINDER RECEPTION NO. 217719638 ALL IN TOWNSHIP 15 SOUTH, RANGE 65 WEST OF THE SIXTH PRINCIPAL MERIDIAN, EL PASO COUNTY, COLORADO, MORE PARTICULARLY DESCRIBED AS FOLLOWS:

BEGINNING AT THE SOUTHEAST CORNER OF "THE MEADOWS AT LORSON RANCH FILING NO. 3" AS RECORDED UNDER RECEPTION NO. 213713396 IN THE EL PASO COUNTY, COLORADO RECORDS:

THENCE ALONG THE EASTERLY AND NORTHERLY LINES THEREOF THE FOLLOWING FOURTEEN (14) COURSES; (1) THENCE MI6'0205'E A DISTANCE OF 99.88 FEET; (2) THENCE N27*12'00'E A DISTANCE OF 50.51 FEET; (3) THENCE N04'51'02'E A DISTANCE OF 216.25 FEET; (4) THENCE ALONG THE ARC OF A CURVE TO THE RIGHT, SAID CURVE HAVING A RADIUS OF 203.76 FEET, A CENTRAL ANGLE OF 64"17'38", (THE CHORD OF WHICH BEARS N34"59"15"E. 287.07 FEET), AN ARC DISTANCE OF 302.71 FEET; (5) THENCE ALONG THE ARC OF A CURVE TO THE LEFT, SAID CURVE HAVING A RADIUS OF 30.49 FEET, A CENTRAL ANGLE OF 56'05'16', (THE CHORD OF WHICH BEARS N38°38'38'38'E, 28.57 FEET) AN ARC DISTANCE OF 29.85 FEET (6) THENCE ALONG THE ARC OF A CURVE TO THE RIGHT, SAID CURVE HAVING A RADIUS OF 348.56 FEET, A CENTRAL ANGLE OF 44'40'09", (THE CHORD OF WHICH BEARS N11'02'29"E. 265.68 FEET), AN ARC DISTANCE OF 272.52 FEET; (7) THENCE NA4'09/22 A DISTANCE OF 20.09 FEET; (8) THENCE N06'46'17'E A DISTANCE OF 174.77 FEET; (9) THENCE N00'18'56'E A DISTANCE OF 51.25 FEET; (10) THENCE N54*40'55"W A DISTANCE OF 36.93 FEET; (11) THENCE N20"11"44"E A DISTANCE OF 214.88 FEET; (12) THENCE N10"51"52"E A DISTANCE OF 291.59 FEET: (13) THENCE N00°24'27'W A DISTANCE OF 232.61 FEET: (14) THENCE \$69'35'58"W A DISTANCE OF 492.32 FEET; THENCE NOV2247"W A DISTANCE OF 15.00 FEET TO THE SOUTHWEST CORNER OF TRACT I "PIONEER LANDING AT LORSON RANCH FILING NO. 2" AS RECORDED UNDER RECEPTION NO. 217713883 IN THE EL PASO COUNTY, COLORADO RECORDS; THENCE N00°2347"W ALONG THE WESTERLY LINE THEREOF 115.00 FEET TO THE SOUTHWEST CORNER OF TRACT B. "PIONEER LANDING AT LORSON RANCH FILING NO. 2": THENCE N89*35/58*E ALONG THE SOUTH LINES OF TRACTS B, A AND E *PIONEER LANDING AT LORSON RANCH FILING NO. 2* A DISTANCE OF 774.09 FEET; THENCE N03*27*32*E ALONG THE EASTERLY LINE OF TRACT E, "PIONEER LANDING AT LORSON RANCH FILING NO. 2" A DISTANCE OF 397.12 FEET; THENCE N49°33'34" ALONG SAID EASTERLY LINE OF TRACT E, 447.72 FEET; THENCE N89'54'29'E A DISTANCE OF 221.60 FEET; THENCE 500'06'29"E A DISTANCE OF 663.07 FEET TO THE NORTH LINE OF AFORESAID TRACT I, "PIONEER LANDING AT LORSON RANCH FILING NO. 2"; THENCE N89"35'58"E ALONG THE NORTH LINE THEREOF 621.14 FEET; THENCE N52'37'06"E A DISTANCE OF 48.31 FEET; THENCE N00'24'02"W A DISTANCE OF 94.82 FEET; THENCE N04'23'45"E A DISTANCE OF 101.66 FEET; THENCE N00"24"02"W A DISTANCE OF 41.44 FEET; THENCE ALONG THE ARC OF A CURVE TO THE RIGHT, SAID CURVE HAVING A RADIUS OF \$95.00 FEET, A CENTRAL ANGLE OF 16"13"33", (THE CHORD OF WHICH BEARS N07*42*45"E, 167.94 FEET), AN ARC DISTANCE OF 168.50 FEET; THENCE N16*33*16"W A DISTANCE OF 33.97 FEET; THENCE N20*50*17"E A DISTANCE OF 50.00 FEET; THENCE N58"27'30"E A DISTANCE OF 33.75 FEET: THENCE ALONG THE ARC OF A CURVE TO THE RIGHT, SAID CURVE HAVING A RADIUS OF \$95.00 FEET, A CENTRAL ANGLE OF 56*56*49", (THE CHORD OF WHICH BEARS N64*17'59"E, 567.33 FEET), AN ARC DISTANCE OF 691.38 FEET; THENCE N71*26'26'E A DISTANCE OF 46.20 FEET; THENCE N02*33'09'W A DISTANCE OF 19.24 FEET; THENCE N87*26'51'E A DISTANCE OF 50.00 FEET; THENCE S02*33'09'E A DISTANCE OF 16.93 FEET: THENCE S47'33'09'E A DISTANCE OF 18.48 FEET; THENCE N07'25'51'E A DISTANCE OF 466.93 FEET; THENCE N42'26'51'E A DISTANCE OF 28.28 FEET; THENCE N02'33'09'W A DISTANCE OF 14.59 FEET: THENCE N87'26'51"E A DISTANCE OF 50.00 FEET: THENCE S02"33'09"E A DISTANCE OF 34.59 FEET; THENCE N87"26'51"E A DISTANCE OF 15.33 FEET; THENCE S02"33'09"E A DISTANCE OF 60.00 FEET TO THE NORTHERLY EXTENSION OF THE EAST LINE OF TRACT J, "PIONEER LANDING AT LORSON RANCH FILING NO. 2"; THENCE S00'00'00'E ALONG SAID EAST LINE IN PART A DISTANCE OF 440.98 FEET; THENCE 843'26'13"E A DISTANCE OF 336.42 FEET TO THE NORTHEASTERLY LINE OF SAID TRACT 1 THENCE SSP3410"E ALONG SAE DORTHEASTERLY LINE 314.29 FEET TO THE MOST EASTERLY CORNER THEREOF; THENCE \$38"22"35"W ALONG THE EAST LINE OF TRACT JA DISTANCE OF 345.18 FEET; THENCE CONTINUING ALONG SAID EAST LINE, 818*5947*W A DISTANCE OF 99,98 FEET TO THE SOUTHEAST CORNER THEREOF; THENCE N70*05/29*W ALONG THE SOUTH LINE OF TRACT J IN PART, 73.85 FEET; THENCE \$64*26'39"W A DISTANCE OF 28.50 FEET; THENCE N70*01'19"W A DISTANCE OF 50.01 FEET; THENCE N71*00'13"W A DISTANCE OF 377.73 FEET; THENCE ALONG THE ARC OF A CURVE TO THE LEFT, SAID CURVE HAVING A RADIUS OF 1434.92 FEET, A CENTRAL ANGLE OF 19*2349", (THE CHORD OF WHICH BEARS N80*4208"W, 483.46 FEET), AN ARC DISTANCE OF 485.78 FEET; THENCE 689*3558"W A DISTANCE OF 299.70 FEET; THENCE S79'04'57"W A DISTANCE OF 43.60 FEET; THENCE 643'44'55"W A DISTANCE OF 63.21 FEET; THENCE 800'42'26'E A DISTANCE OF 206.65 FEET; THENCE 803'59'22"W A DISTANCE OF 60.18 FEET; THENCE S00'24'02'E A DISTANCE OF 309.91 FEET; THENCE S38'57'34'E A DISTANCE OF 32.09 FEET; THENCE S00'24'02'E A DISTANCE OF 50.00 FEET; THENCE S37'56'32'W A DISTANCE OF 32.24 FEET; THENCE S00'24'02'E A DISTANCE OF 339.66 FEET; THENCE S38*00027E A DISTANCE OF 32.00 FEET; THENCE S00*24027E A DISTANCE OF 50.00 FEET; THENCE S38*14'24'W A DISTANCE OF 32.03 FEET; THENCE S00*24'027E A DISTANCE OF 589.11 FEET; THENCE \$33"38'32"E A DISTANCE OF 36.46 FZET; THENCE N89"36'56"E A DISTANCE OF 64.05 FEET; THENCE \$38"22'41"W A DISTANCE OF 95.57 FEET; THENCE \$89"35"58"W A DISTANCE OF 554.18 FEET; THENCE \$50"57"37"W A DISTANCE OF 32.03 FEET; THENCE S89"35'57"W A DISTANCE OF 50.00 FEET; THENCE N52"06'10"W A DISTANCE OF 32.27 FEET: THENCE \$89'35'58'W A DISTANCE OF \$24.41 FEET: THENCE \$51'38'32'W A DISTANCE OF 49.00 FEET; THENCE 800°24'02"E A DISTANCE OF 41.67 FEET; THENCE S80°35'58"W A DISTANCE OF 60.00 FEET; THENCE N00°24'02"W A DISTANCE OF 38,12 FEET; THENCE M0°52'0"W A DISTANCE OF 38.26 FEET; THENCE S89'35'58'W A DISTANCE OF 125.90 FEET; THENCE N86'49'28'W A DISTANCE OF 128.25 FEET; THENCE S89'35'58'W A DISTANCE OF 693.52 FEET; THENCE S51'59'14"W A DISTANCE OF 28.49 FEET; THENCE S89'35'58"W A DISTANCE OF 60.00 FEET; THENCE N45"24'02"W A DISTANCE OF 14.14 FEET; THENCE \$89'35'58"W A DISTANCE OF 14.76 FEET; THENCE NO0"24"02"W A DISTANCE OF 80.00 FEET TO THE SOUTH LINE OF LOT 138 "THE MEADOWS AT LORSON RANCH FILING NO. 3"; THENCE N89"35'58"E ALONG THE SOUTH LINE THEREOF AND ALONG THE SOUTH LINE OF 60 FOOT WIDE STINGRAY LANE AND ALONG THE SOUTH LINE OF TRACT A AND TRACT C, A DISTANCE OF 568.94 FEET TO THE POINT OF

SAID PARCEL CONTAINS & CALCULATED AREA OF 126,255 ACRES MORE OR LESS.



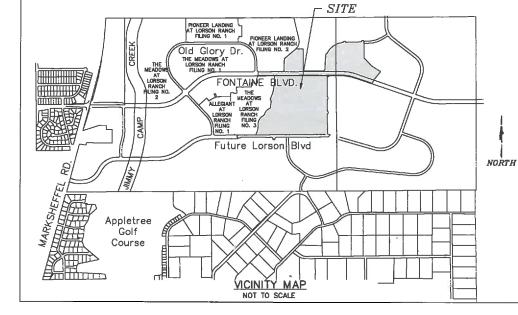

OWNERS CERTIFICATE:

OWNERS CERTIFICATE: THE UNDERSIGNED, BEING ALL THE OWNERS, MORTGAGEES, BENEFICIARIES OF DEEDS OF TRUST AND HOLDERS OF OTHER INTERESTS IN THE LAND DESCRIBED HEREIN, HAVE LAD OUT, SUBDIVIDED, AND FLATTED BAID LANDS INTO LOTS, TRACTS, HEREIN, HAVE LAD OUT, SUBDIVIDED, AND FLATTED BAID LANDS INTO LOTS, TRACTS, SUBDIVISION OF 'LORSON RANCH EAST FILING NO. 1'. ALL PUBLIC IMPROVEMENTS SO PLATTED ARE HEREBY DEDCATED TO PUBLIC USE AND BAID OWNER DOES HEREBY COVENANT AND AGREE THAT THE PUBLIC IMPROVEMENTS WILL BE CONSTRUCTED TO EL PASO COUNTY STANDARDS AND THAT PROPER DRAINAGE AND EROSION CONTROL FOR BAIE WILL BE PROVIDED TA SAD OWNERS OF EL PASO COUNTY, COLORADO. UPON ACCEPTANCE BY RESOLUTION, ALL PUBLIC IMPROVEMENTS BO DEDICATED TO UPON ACCEPTANCE BY RESOLUTION, ALL PUBLIC IMPROVEMENTS BO DEDICATED TO UPON ACCEPTANCE BY RESOLUTION, ALL PUBLIC IMPROVEMENTS BO DEDICATED TO UPON ACCEPTANCE BY RESOLUTION, ALL PUBLIC IMPROVEMENTS BO DEDICATED ON ULL BECOME MATTERS OF MAINTENANCE BY EL PASO COUNTY, COLORADO. UPON ACCEPTANCE BY RESPONSIBLE FOR NON THE REPEY DEDICATED FOR PUBLIC UTILITIES AND COMMUNICATION SYSTEMS AND OTHER PURPOSES AS SHOWN HERERON. THE ENTITIES RESPONSIBLE FOR PROVIDING THE SERVICES FOR WHICH THE EASEMENTS ARE ESTABLISHED ARE HEREBY GRANTED THE PERPETUAL RIGHT OF INGERSIAND EASID DEGRESS AND COMENT PROPERTIES FOR INSTALLATION, MANTENANCE, AND REPLACEMENT OF UTILITY LINES AND RELATED FOR RUSTALLATION, MANTENANCE, AND REPLACEMENT OF UTILITY LINES AND RELATED FACILITES.

OWNER ADDRESS: 212 N. WAHSATCH AVENUE BUITE 301 COLORADO BPRINGS, CO 80903 PHONE: (719) 835-3200 FAX: (719) 835-3244

OWNER ADDRESS:

1820 MAIN STREET

5. CO 8091

(719) 391-3000 (719) 390-4372

BY: JEFF MARK, AUTHORIZED SIGNING AGENT, FOR: LORSON LLC A COLORADO LIMITED LIABILITY COMPANY, AS NOMINEE FOR LORSON CONSERVATION INVEST I, LLP A COLORADO LIMITED LIABILITY LIMITED PARTHERSHIP AND LORSON LLC A COLORADO LIMITED LIABILITY COMPANY, AS NOMINEE FOR MURRAY FOUNTAIN LLC, A COLORADO LIMITED LIABILITY COMPANY, AS NOMINEE FOR MURRAY FOUNTAIN LLC, A COLORADO LIMITED LIABILITY COMPANY, AND EAGLE DEVELOPMENT COMPANY, A COLORADO COMPANY ATTEST:

SECRETARY/TREASURER

TATE	DF	COL	ORA	DO	۱.	

COUNTY OF EL PASO

ACKNOWLEDGED BEFORE ME THIS DAY OF . 2018. A.D. BY JEFF MARK, AUTHORIZED SIGNING AGENT, LORSON LLC, A COLORADO LIMITED LIABILITY COMPANY.

WITNESS MY HAND AND OFFICIAL SEAL:

MY COMMISSION EXPIRES:

NOTARY PUBLIC:

WIDEFIELD SCHOOL DISTRICT 3

NAME: TITLE: STATE OF COLORADO)

COUNTY OF EL PASO

ACKNOWLEDGED BEFORE ME THIS ____ DAY OF _____ , 2018, A.D. BY WIDEFIELD SCHOOL DISTRICT 3.

WITNESS MY HAND AND OFFICIAL SEAL:

1	MY COMIN	AISSION	EXPIRES:	
	NOTARY			

LORSON RANCH METROPOLITAN DISTRICT THE DEDICATION OF TRACTS A. B. C. D. E. F. G. H. L.K. L. M. N. O. P. Q. R. S. AND T. FOR THE PURPOSES SPECIFIED IN THE TRACT TABLE ARE HEREBY ACCEPTED FOR

UNLESS OTHERWISE SHOWN, ALL SIDE LOT LINES ARE HEREBY PLATTED WITH A FIVE FOOT (5) PUBLIC UTILITY AND DRAINAGE EASEMENT, ALL REAR LOT LINES ARE HEREBY PLATTED WITH A TEN FOOT (10) PUBLIC UTILITY AND DRAINAGE EASEMENT, ALL FRONT LOT LINES AND ALL FRONT TRACT LINES ARE HEREBY PLATTED WITH A TEN FOOT (10) PUBLIC UTILITY AND DRAINAGE EASEMENT. THE SOLE RESPONSIBILITY FOR MAINTENANCE OF ALL HEREIN DESCRIBED EASEMENTS IS VESTED WITH THE INDIVIDUAL PROPERTY OWNERS. A TWENTY FOOT (20) PUBLIC UTILITY FASEMENT IS HEREBY PLATTED ALONG THE SUBDIVISION BOUNDARY LINES.

A PORTION OF THIS PROPERTY IS LOCATED WITHIN A DESIGNATED FEMA FLOODPLAIN AS DETERMINED BY THE FLOOD INSURANCE RATE MAP (FINA) PANEL NO. 08041C0957F AND PANEL NO. 08041C01000F, BOTH DATED MARCH 17, 1997 REVISED TO REFLECT CLOMR CASE NO. 08-08-4025R, EFFECTIVE DATE JANUARY 17, 2007 AND LOMC 14-08-053P, EFFECTIVE DATE JANUARY 28, 2015 HAS BEEN EXAMINED AS IT RELATES TO THE PROPERTY BEING PLATTED. THE REVISED AND AMENDED FLOODPLAIN LIMITS ARE AS SHOWN HEREON.

OWNERSHIP AND MAINTENANCE BY THE LORSON RANCH METROPOLITAN DISTRICT APPROVAL IS GRANTED FOR THIS PLAT OF LORSON RANCH EAST FILING NO. 1. Add a note addressing underdrain maintenance.

BY: JEFF MARK, DIRECTOR, LORSON, LLC STATE OF COLORADO

FLOOD PLAIN CERTIFICATION:

ACCEPTANCE CERTIFICATE FOR TRACTS:

COUNTY OF EL PASO

EASEMENTS:

ACKNOWLEDGED BEFORE ME THIS A.D. BY JEFF MARK, DIRECTOR, LORSON, LLC Ranch Metropolitan V WITNESS BY HAND AND OFFICIAL SEAL: District No. 1

MY COMMISSION EXPIRES: NOTARY PUBLIC:

WIDEFIELD SCHOOL DISTRICT 3

THE DEDICATION OF TRACT J. FOR THE PURPOSES SPECIFIED IN THE TRACT TABLE ARE HEREBY ACCEPTED FOR OWNERSHIP AND MAINTENANCE BY WIDEFIELD SCHOOL DISTRICT 3.

APPROVAL IS GRANTED FOR THIS PLAT OF LORSON RANCH EAST FILING NO. 1. STATE OF COLORADO 1 SS

COUNTY OF EL PASO

ACKNOWLEDGED BEFORE ME THIS _____ DAY OF _____, 2018, A.D. BY NAME _, TITLE: _____ , FOR WIDEFIELD SCHOOL DISTRICT 3.

WITNESS MY HAND AND OFFICIAL SEAL.

MY COMMISSION EXPIRES: ____

NOTARY PUBLIC:

DATE OF THE CERTIFICATION SH

BOARD OF COUNTY COMMISSIONERS CERTIFICATE

THIS PLAT FOR "LORSON RANCH EAST FILING NO. 1" WAS APPROVED FO

COUNTY APPROVAL:

EL PASO	COUNTY	DIRECTOR	OF PL	ANNING	AND	COMMU	NITY	DE

EL PASO COUNTY ASSESSOR

COUNTY OF EL PASO

V			TRACT	
	TRACT	SIZE	OWNERSHIP/	USE
		(ACRES)		DRAINAGE/PUBLIC IMPROVEMENT/PUBLIC
		0.265		UTILITY/LANDSCAPING/SIGNAGE DRAINAGE/PUBLIC IMPROVEMENT/PUBLIC
	8	0.040		UTILITY/LANDSCAPING/SIGNAGE DRAINAGE/PUBLIC IMPROVEMENT/PUBLIC
	c	3.703		UTILITY/DETENTION POND/OPEN SPACE
	E	1.106		UTILITY/OPEN SPACE/SIGNAGE DRAINAGE/PUBLIC IMPROVEMENT/PUBLIC
0.225	F	11.106		UTILITY/OPEN SPACE DRAINAGE/PUBLIC IMPROVEMENT/PUBLIC
	-	7.823		UTILITY/LANDSCAPING/SIGNAGE DRAINAGE/PUBLIC IMPROVEMENT/PUBLIC
OR IN THE CORRECTLY	н	0.228		UTILITY/DETENTION POND/OPEN SPACE
iy me or Iown 10 ; and		25.265		UTILITY/LANDSCAPING/SIGNAGE
PLICABLE SION, OR COUNTY		26.265	WIDEFIELD SCHOOL	UT:LITY/LANDSCAPING/SIGNAGE
0.228		un	DISTRICT 3	FUTURE SCHOOL DRAINAGE/PUBLIC IMPROVEMENT/PUBLIC
5.265	ĸ	0.555		UTILITY/LANDSCAPING/SIGNAGE
.200	L	0.052		UTILITY/OPEN SPACE
	м	0.152		UTILITY/OPEN SPACE
	N ·	0.303	LRMD/LRMD	UTILITY/OPEN SPACE
	0	0.303	LRMD/LRMD	DRAINAGE/PUBLIC IMPROVEMENT/PUBLIC UTILITY/OPEN SPACE
	Р	0.234		DRAINAGE/PUBLIC IMPROVEMENT/PUBLIC UTILITY/OPEN SPACE
NY DEFECT IN NT, MAY ANY	Q	0.234	LRMD/LRMD	DRAINAGE/PUBLIC IMPROVEMENT/PUBLIC UTILITY/OPEN SPACE
S FROM THE	R	0.303		DRAINAGE/PUBLIC IMPROVEMENT/PUBLIC UTUTY/OPEN SPACE
	s	C.303	LRYD/LPMD	DRAWAGE/PUBLIC IMPROVEMENT/PUBLIC
	τ	10,345	LRMC/LINID	BRAINAGE/PUBLIC INPROVEMENT/PUBLIC BTILITY/OPEN SPACE
ON THE _ STEED VAL. THE NOT NOE WITH. NG CRITERIA		Provide tota in table as a correct the t acreage. nty is not pting these t	sool to racts	
NO. 1" ON ENT	SUMMAR 303 LOTS RIGHTS-OF- TOTAL	4 WAY 3	1.500 ACRES 32. 1.925 ACRES 25. 5.255 ACRES 100.	l averaged about 79 acres in tracts Separate the school development tract from the open space
	FEES: DRAINAGE F JIMMY CAMI SURETY FEI BRIDGE FEE SCHOOL FE	P CREEK E:	CREDITS USED TH	115 FILING \$ 44,433.00
IY OFFICE	PARK FEE:		AS RECORDED AT	R THE SCHOOL LAND AGREEMENT RECEPTION NO. 212042170
, 2018, A.D.,	URBAN PAR	K FEE:		
FILING N JOB NO. DATE PR	RANCH EAS	2/06/2017		20 BOULDER CRESCENT, SUITE I COLORADO SPRINGS, CO 809 PHONE 719,955.5485

CIVIL CONSULTANTS, INC.

SHEET 1 OF 11

LORSON RANCH EAST FILING NO. 1

A PORTION OF THE SOUTHWEST QUARTER (SW 1/4) SECTION 13, AND A PORTION OF THE SOUTHWEST QUARTER (SE 1/4) SECTION 14,

A PORTION OF THE NORTHEAST QUARTER (NE 1/4) SECTION 23, AND A PORTION OF THE NORTHWEST QUARTER (NW 1/4) SECTION 24, TOWNSHIP 15 SOUTH, RANGE 65 WEST OF THE SIXTH PRINCIPAL MERIDIAN, EL PASO COUNTY, COLORADO

SURVEY NOTES:

1. BASIS OF BEARING: THE SOUTH LINE OF SECTION 14, T155, R65W, OF THE 6TH P.M. EL PASO COUNTY, COLORADO AS MONUMENTED. THE QUARTER CORNER COMMON TO SECTION14 AND SECTION 23 IS A 3.25 INCH ALUMINUM CAP STAMPED 'KM, T155 R65W, 1/4 S14 S23, 2004, PLS 16109" FROM WHICH THE SOUTHEAST CORNER OF SECTION 14 BEARS N89'43'11'E, 2847.09 FEET AND IS MONUMENTED BY A 3.25 IN ALUMINUM CAP STAMPED 'KM, T15S R65W, 14, 13, 23,24, 2004, LS 16109'. THE UNIT OF MEASUREMENTS IS THE U.S. SURVEY FOOT

2. THE FLOOD INSURANCE RATE MAP (FIRM) PANEL NO. 08041CO957F AND PANEL NO. 08041CO1000F, BOTH DATED MARCH 17, 1997 REVISED TO REFLECT CLOMR CASE NO. 06-08-4425R, EFFECTIVE DATE JANUARY 17, 2007 AND LONC 14-08-063P, EFFECTIVE DATE JANUARY 28, 2015 NAS BEEN EXAMINED AS IT RELATES TO THE PROPERTY BEING PLATTED. THE REVISED AND AMENDED FLOODPLAIN LIMITS ARE AS SHOWN

3. A COMMITMENT FOR TITLE INSURANCE ISSUED BY UNIFIED TITLE COMPANY, LLC AS AGENT FOR STEWART TITLE GUARANTY COMPANY WITH AN EFFECTIVE DATE OF FERULARY 22, 2018 AT 7304M, FILE NO. 56463 UTC, AMENDMENT NO. 1, HAS BEEN EXAMINED AS IT RELATES TO THE PROPERTY BEING PLATTED.

DAMINED AS II ACLAILES ID THE PROPERTY BEING PLATTED. I. A RESERVATION BY THE LEAGUE LAND COMPANY, FOR ITSELF, ITS SUCCESSORS AND ASSIGNS, OF A RIGHT OF WAY ACROSS ALL OF THE LAND FOR SUCH LATERAL DITCHES AS MAYBE NECESSARY TO ENABLE THE COMPANY AND ITS SUCCESSORS AND ASSIGNS TO CONVEY AND SUPPLY WATER FROM ITS RESERVORS, CANALS AND MAIN LATERALS TO LANDS LYING BEYOND THE DESCRIBED TRACT, AS DESCRIBED IN DEED RECORDED AUGUST 28, 1922 IN POOK RB3 AT PAGE AS

BOOK 683 AT PAGE 88.

II. THE PROPERTY MAY BE SUBJECT TO ANY ASSESSMENT OR LIEN OF FOUNTAIN

II. THE PROPERTY MAY BE SUBJECT TO ANY ASSESSMENT OR LIEN OF FOUNTAIN VALLEY SOLL CONSERVATION DISTRICT AS DISCLOSED BY THE INSTRUMENT RECORDED JUNE 21, 1943 AT RECEPTION NO. 633031. III. THE PROPERTY MAY BE SUBJECT TO TERMS, AGREEMENTS, PROVISIONS, CONDITIONS, OBLIGATIONS AND EASEMENTS AS CONTAINED IN EASEMENT TO PUBLIC SERVICE COMPANY OF COLORADO, RECORDED ALIGUST 20, 1984 IN BOOK 2030 AT PAGE 238.

No. THE PROPERTY MAY BE SUBJECT TO TERMS, AGREEMENTS, PROVISIONS, CONDITIONS, OBLIGATIONS AND EASEMENTS AS CONTAINED IN EASEMENT, RECOREDD APPILI. 11874 IN BOOK 2865 AT PAGE 715 AND ASSIGNMENT RECOREDD JULY 27, 1976 IN BOOK 2846 AT PAGE 719.

V. THE PROPERTY MAY BE SUBJECT TO TERMS, AGREEMENTS, PROVISIONS

CONDITIONS, OBLIGATIONS AND EASEMENTS AS CONTAINED IN RIGHT OF V EASEMENT TO MOUNTAIN VIEW ELECTRIC ASSOCIATION, INC., RECORDED 7, 1963 IN BOOK 3684 AT PAGE 492. (DESCRIPTION IS VAGUE, LOCATION IS

VI. THE PROPERTY MAY BE SUBJECT TO ANY ASSESSMENT OR LIEN, BY REASON OF INCLUSION WITHIN THE SECURITY FIRE PROTECTION DISTRICT AS DISCLOSED BY ORDER OF INCLUSION RECORDED IN BOOK 5258 AT PAGE 1049 AND

BT UNDER UT INCLUSION RECORDED IN BUOK 200 AT PAGE 1949 AND RECORDED JULY 31, 2013 A TRECEPTION NO. 21309878. VI. THE PROPERTY MAY BE SUBJECT TO ANY ASSESSMENT OR LIEN OF WIDEFIELD WATTER & SANITATION DISTRICT AS DISCLOSED BY THE INSTRUMENT RECORDED JUNE 20, 2006 AT RECEPTION NO. 205091663.

VIII. THE PROPERTY MAY BE SUBJECT TO TERMS, AGREEMENTS, PROVISIONS VIII. THE PROPERTY MAY BE SUBJECT TO TERMS, AGREEMENTS, PROVISIONS, CONDITIONS AND OBLIGATIONS AS CONTAINED IN RESOLUTION NO. 04-366, BY AND BEFORE THE BOARD OF COUNTY COMMISSIONERS, COUNTY OF EL PASO, STATE OF COLORADO, RECORDED SEPTEMBER 3, 2004 AT RECEPTION NO. 204150548, RESOLUTION NO. 05-338, APPROVING DEVELOPMENT AGREEMENT, BY AND BEFORE THE BOARD OF COUNTY COMMISSIONERS, COUNTY OF EL PASO, STATE OF COLORADO, RECORDED AUGUST 24, 2005 AT RECEPTION NO. 205131973. CORRECTED VERSION OF SAID RESOLUTION NO. 05-336 IN CONNECTION THEREWITH RECORDED AUGUST 25, 2005 AT RECEPTION NO. 205132678. RESOLUTION NO. 07-233 ABPROVING AMEINED SEPTION FOR 205132869. RESOLUTION NO. 07-223, APPROVING AMENDED SERVICE PLAN LORSON RANCH METROPOLITAN DISTRICTS 1-7, BY AND BEFORE THE BOARD OF LORSON RANCH METROPOLITAN DISTRICTS 1-7, BY AND BEFORE THE BOARD OF COUNTY COMMISSIONERS, COUNTY OF EL PASO, STATE OF COLORADO, RECORDED JULY 17, 2007 AT RECEPTION NO. 20705523. RESOLUTION NO. 07-358 RECORDED SEPTEMBER 11, 2007 AT RECEPTION NO. 2071B188. DEVELOPMENT AGREEMENT NO. 1 LORSON RANCH, IN CONNECTION THEREWITH RECORDED JULIOS 11, 2005 AT RECEPTION NO. 205128255. DEVELOPMENT ARCEEMENT NO. 2. LORSON RANCH, IN CONNECTION THEREWITH RECORDED AUGUST 19, 2005 AT RECEPTION NO. 205128255. DEVELOPMENT ARCEEMENT NO. 2. LORSON RANCH, IN CONNECTION THEREWITH RECORDED AND 422, 2010 AT INC. RECEPTION NO. 210026931 AND RERECORDED APRIL 20, 2010 AT RECEPTION NO. 210036301. RESOLUTION NO. 10-94 TO REVISE DEVELOPMENT AGREEMENT, BY AND BEFORE THE BOARD OF COUNTY COMMISSIONERS, COUNTY OF EL PASO, AND BE-ORE THE BOARD OF COUNTY COMMISSIONERS, COUNTY OF EL PASO, STATE OF COLORADO, RECORDED OCTOBER 12, 2010 AT RECEPTION NO. 210101176. RESOLUTION NO. 12-335 APPROVING INTERGOVERNMENTAL AGREEMENT CONCERNING THE MARKSHEFFEL ROAD/FONTAINE BOULEVARD INTERSECTION, RECORDED SEPTEMBER 26, 2012 AT RECEPTION NO. 21212804. ANNUAL REPORT AND DISCLOSURE FORM RECORDED SEPTEMBER 7, 2007 AT RECEPTION NO. 20711686; RECORDED OCTOBER 30, 2013 AT RECEPTION NO. 213134075, GENERAL DISCLOSURE RECORDED OCTOBER 30, 2013 AT RECEPTION NO.

217/00960. 127/00 RECEPTION NO. 204197520. ORDER OF INCLUSION IN CONNECTION THEREWITH RECORDED DECEMBER 28, 2004 AT RECEPTION NO. 204209874; RECORDED APRIL RECORDED DECEMBER 28, 2004 AT RECEPTION NO. 204209874; RECORDED APRIL 15, 2005 AT RECEPTION NO. 20505570, RECORDED APRIL 21, 2005 AT RECEPTION NO. 205056110 AND AT RECEPTION NO. 205056116; AND RECORDED APRIL 21, 2005 AT RECEPTION NO. 205056117, NOTICE OF SPECIAL DISTRICT AUTHORIZATION OF ISSUANCE OF GENERAL OBLIGATION NODESTEDNESS, IN CONNECTION THEREWITH RECORDED NOVEMBER 23, 2004 AT RECEPTION NO. 204192908. ORDER AND DECREE OF CORRECTION RECORDED JUNE 17, 2015 AT RECEPTION NO. 215052652, RECORDED MAY 26, 2016 AT RECEPTION NO. 21492908. RECORDED SEPTEMBER 11, 2017 AT RECEPTION NO. 21709185. A THE PROPERTY MAY BE SUBJECT TO ANY FEE, TAX, LIEN OR ASSESSMENT BY REASON OF INCLUSION WITHIN THE LORSON RANCH METROPOLITAN DISTRICT NO. 4, AS SET FORTH IN ORDER AND DECREE ORGANIZING SAID DISTRICT AS EVIDENCED BY INSTRUMENTS RECORDED DECEMBER 2, 2004 AT RECEPTION NO. 204197514, RECORDED DECEMBER 2, 2004 AT RECEPTION NO. 2040547 BEFORT IN 15, 2005 AT RECEPTION NO. 235958571, RECORDED APRIL 15, 2005 AT RECEPTION NO. 235958571, RECORDED APRIL 21, 2005 AT BEFORTIN IN OUTS AND AT RECEPTION NO. 235958571, RECORDED APRIL 21, 2005 AT RECEPTION NO. 205056111 AND AT RECEPTION NO. 205056117 AND RECORDED SEPTEMBER 11, 2017 AT RECEPTION NO. 217109166.

RECORDED SEPTEMBER 11, 2017 AT RECEPTION NO. 217/09166. X1 THE PROPERTY MAY BE SUBJECT TO ANY FEE TAX, LEEN OR ASSESSMENT BY REASON OF INCLUSION WITHIN THE LORSON RANCH METROPOLITAN DISTRICT NO. 6, AS SET FORTH IN ORDER AND DECREE ORGANIZING SAID DISTRICT AS EVIDENCED BY INSTRUMENTS RECORDED DECEMBER 2, 2004 AT RECEPTION NO. 204197515, RECORDED DECEMBER 2, 2004 AT RECEPTION NO. 2005 AT BEFCEPTION NO. 20565372, RECORDED APRIL 21, 1005 AT BEFCEPTION NO. 205663572, RECORDED APRIL 21, 1005 AT BEFCEPTION NO. 20567372, RECORDED APRIL 21, 1005 AT BEFCEPTION NO. 20567572, RECORDED APRIL 2 2005 AT RECEPTION NO. 205056112 AND AT RECEPTION NO. 206056118, RECORDED MAY 9, 2006 AT RECEPTION NO. 206068332. ACCORDED WIT 5, 2009 AT RECEPTION NO. 20006352, with THE PROPERTY MAY BE SUBJECT TO TERMS, CONDITIONS, PROVISION, AGREEMENTS AND OBLIGATIONS CONTAINED IN THE INCLUSION & SERVICE AGREEMENT BETWEEN WIDEFIELD WATER & SANITATION DISTRICT AND LORSON LLC RECORDED ON MAY 31, 2005 AT RECEPTION NO. 205078708,

XII. THE PROPERTY MAY BE SUBJECT TO TERMS, AGREEMENTS, PROVISIONS, CONDITIONS, OBLIGATIONS AND EASEMENTS AS CONTAINED IN SANITARY SEWER EASEMENT AGREEMENT, RECORDED MAY 14, 2008 AT RECEPTION NO.

SURVEY NOTES: (CONT.)

XIV. THE PROPERTY MAY BE SUBJECT TO TERMS, AGREEMENTS, PROVISIONS, CONDITIONS, OBLIGATIONS AND EASEMENTS AS CONTAINED IN DRAINAGE EASEMENT, RECORDED APRIL 23, 2013 AT RECEPTION NO. 213052476. XX. THE PROPERTY MAY BE SUBJECT TO TERMS, AGREEMENTS, PROVISIONS, CONDITIONS, OBLICATIONS AND EASEMENTS AS CONTAINED IN WATER DELIVERY SYSTEM EASEMENT AGREEMENT, RECORDED SEPTEMBER 16, 2015 AT RECEPTION NO. 215101175 AND AT RECEPTION NO. 215101176.

XVI. THE PROPERTY MAY BE SUBJECT TO MATTERS AS SET FORTH AND CONTAINED IN THE LORSON RANCH OVERALL DEVELOPMENT AND PHASING PLAN MAP RECORDED MAY 9, 2006 AT RECEPTION NO. 206035127 AND RECORDED DECEMBER 28, 2006 AT RECEPTION NO. 206187063.

AVIT THE PROPERTY MAY BE SUBJECT TO TEMS, AGREEMENTS, PROVISIONS, CONDITIONS, OBLIGATIONS AND EASEMENTS AS CONTAINED IN WATER AND SANITARY SEWER EASEMENT AGREEMENT(S), RECORDED JUNE 12, 2008 AT RECEPTION NO. 208067502: AT RECEPTION NO. 208067503: AT RECEPTION NO. RECEPTION NO. 208067502; AT RECEPTION NO. 208067503; AT RECEPTION NO. 208067503; AT RECEPTION NO. 208067545; AT RECEPTION NO. 208067547; AT RECEPTION NO. 20807547; AT RECEPTION NO. 208067676.

WII. TERMS, AGREEMENTS, PROVISIONS, CONDITIONS AND ORI IGATIONS AS CONTAINED IN PIONEER LANDING AT LORSON RANCH SUBDIVISION P UNIT DEVELOPMENT GUIDELINES RECORDED DECEMBER 10, 2009 AT

XX. THE PROPERTY MAY BE SUBJECT TO TERMS, AGREEMENTS, PROVISIONS CONDITIONS, OBLIGATIONS AND EASEMENTS AS CONTAINED IN RIGHT OF CONDITIONS, OBLICATIONS AND EASEMENTS AS CONTAINED IN RIGHT OF ENTRY TO THE COLORADO SPRINGS UTILITIES (SOLUTHERN DELIVERY SYSTEM), RECORDED FEBRUARY 24, 2012 AT RECEPTION NO. 212020136; AND AT RECEPTION NO. 212020137. CITY OF COLORADO BPRINGS POSSESSION AND USE AGREEMENT (SOUTHERN DELIVERY SYSTEM), RECORDED MARCH 1, 2013 AT RECEPTION NO. 213027535. XX. THE PROPERTY MAY BE SUBJECT TO TERMS, AGREEMENTS, PROVISIONS.

CONDITIONS AND OBLIGATIONS AS CONTAINED IN RESOLUTION NO. 12-126, BY CONDITIONS AND OBLIGHT INTO BO CONTRINES IN RESIDENT OF EL PASO AND BEFORE THE BOARD OF COUNTY COMMISSIONERS, COUNTY OF EL PASO STATE OF COLORADO, REGARDING SCHOOL SITE DEDICATION AGREEMENT DED APRIL 13, 2012 AT RECEPTION NO. 212042170.

xd. THE PROPERTY MAY BE SUBJECT TO TERMS, AGREEMENTS, PROVISIONS CONDITIONS AND OBLIGATIONS AS CONTAINED IN SCHOOL SITE DEDICATION AGREEMENT RECORDED JULY 27, 2012 AT RECEPTION NO. 212047633. NOTEMENT THE POPERTY MAY BE SUBJECT TO TERMS, ARREEMENTS, PROVISIONS, CONDITIONS AND OBLIGATIONS AS CONTAINED IN RESOLUTION NO. 12-382, BY AND BEFORE THE BOARD OF COUNTY COMMISSIONERS, COUNTY OF EL PASO, STATE OF COLORADO, ADOPTING THE EL PASO COUNTY ROAD IMPACT FEE PROGRAM, RECORDED NOVEMBER 15, 2012 AT RECEPTION NO. 212136575. xxiii. THE PROPERTY MAY BE SUBJECT TO TERMS, AGREEMENTS, PROVISIONS, CONDITIONS AND OBLIGATIONS AS CONTAINED IN RESOLUTION NO. 16-118, BY AND BEFORE THE BOARD OF COUNTY COMMISSIONERS, COUNTY OF EL PASO, STATE OF COLORADO RECORDED APRIL 13, 2016 AT RECEPTION NO. 216037512 XXY THE PROPERTY MAY BE SUBJECT TO TERMS, AGREEMENTS, PROVISIONS CONDITIONS AND OBLIGATIONS AS CONTAINED IN RESOLUTION NO. 16-228 BY AND REFORE THE BOARD OF COUNTY COMMISSIONERS, COUNTY OF STATE OF COLORADO, APPROVAL OF REZONE, RECORDED JUNE 29, 2016 AT RECEPTION NO. 216070955.

NOW THE PROPERTY MAY BE SUBJECT TO TERMS, AGREEMENTS, PROVISIONS, XW THE PROPENT WAY BE SUBJECT TO TERMS, AGREEMENTS, PROVISIONS, CONDITIONS AND OBLICATIONS AS CONTINIED IN RESOLUTION NO. 16-228, BY AND BEFORE THE BOARD OF COUNTY COMMISSIONERS, COUNTY OF EL PASO, STATE OF COLORADO, APPROVAL OF PRELIMINARY PLAN, RECORDED JUNE 28, 2016 AT RECEPTION NO. 2160/70956; RESOLUTION NO. 18-313, BY AND BEFORE THE BOARD OF COUNTY COMMISSIONERS, COUNTY OF EL PASO, STATE OF COLORADO, APPROVAL OF FINAL PLAN, RECORDED AUGUST 30, 2016 AT RECEPTION NO. 216006747.

2001 THE PROPERTY MAY BE SUBJECT TO MATTERS AS SET FORTH AND AND THE THOUSEN IN THE LORSON RANCH, PIONEER LANDING EIFLOR THAND CONTAINED IN THE LORSON RANCH, PIONEER LANDING FILMS NO. 2 AND NO. 3, PUD DEVELOPMENT PLAN MAP RECORDED JULY 14, 2016 AT RECEPTION NO. 216077631 AND RECORDED FEBRUARY 2, 2017 AT RECEPTION NO. 217013429. XXXXII THE PROPERTY MAY BE SUBJECT TO TERMS, AGREEMENTS, PROVISIONS, CONDITIONS AND OBLIGATIONS AS CONTAINED IN RESOLUTION NO. 16-307 RECORDED AUGUST 24, 2016 AT RECEPTION NO. 216095697 AND RE-RECORDED SEPTEMBER 30, 2016 AT RECEPTION NO. 216113012.

2011 THE PROPERTY MAY BE SUBJECT TO TERMS, AGREEMENTS, PROVISIONS CONDITIONS AND OBLIGATIONS AS CONTAINED IN RESOLUTION NO. 18456, BY AND BEFORE THE BOARD OF COUNTY COMMISSIONERS, COUNTY OF EL PASO, STATE OF COLORADO, APPROVING A PETITION FOR INCLUSION OF PROPERTY WITHIN THE DISTRICT - PIONEER LANDING FILING NO. 2 RECORDED DECEMBEI 15, 2016 AT RECEPTION NO. 216145947.

xxix. THE PROPERTY MAY BE SUBJECT TO TERMS, AGREEMENTS, PROVISIONS CONDITIONS, OBLIGATIONS AND EASEMENTS AS CONTAINED IN PUBLIC RIGHT OF WAY MALBOX LICENSE AGREEMENT, RECORDED JANUARY 5, 2017 AT **RECEPTION NO. 217001494**


XXX. THE PROPERTY MAY BE SUBJECT TO TERMS AGREEMENTS, PROVISIONS CONDITIONS, OBLIGATIONS AND EASEMENTS AS CONTAINED IN PUBLIC RIGH OF WAY LANDSCAPE LICENSE AGREEMENT, RECORDED JANUARY 5, 2017 AT


XXXI. THE PROPERTY MAY BE SUBJECT TO TERMS, AGREEMENTS, PROVISIONS, CONDITIONS, OBLIGATIONS AND EASEMENTS AS CONTAINED IN PRIVATE DETENTION BASIN/STORMWATER QUALITY BEST MANAGEMENT PRACTICE MAINTENANCE AGREEMENT AND EASEMENT, RECORDED JANUARY 5, 2017 AT RECEPTION NO 21700149


ocdi. THE PROPERTY MAY BE SUBJECT TO TERMS, AGREEMENTS, PROVISIONS, CONDITIONS AND ORIJGATIONS AS CONTAINED IN SUBDIVISION IMPROVEMENTS AGREEMENT RECORDED JANUARY 5, 2017 AT RECEPTION NO. 217001497. AGREEMENT RECORDED JANUARY 5, 2017 AT RECEPTION NO. 217001497. 2008L THE PROPERTY MAY BE SUBJECT TO COVENANTS, CONDITIONS, RESTRICTIONS AND EASEMENTS, IF ANY, WHICH DO NOT CONTAIN A FORFEITURE OR REVERTER CLAUSE, (DELETING ANY RESTRICTIONS INDICATING ANY PREFERENCE, LIMITATION OR DISCRIMINATION BASED ON RACE, COLOR, RELIGION, SEX, MANDICAP, FAMILIAL STATUS OR NATIONAL ORIGIN) AS CONTAINED IN INSTRUMENT RECORDED JANUARY 5, 2017 AT RECEPTION NO. 217001508 AND ANY AND ALL AMENDMENTS AND/OR SUPPLEMENTS THERETO 2000 THE PROPERTY AND ALL AMENDMENTS AND/OK SUPPLEMENTS THERETO. 2000 THE PROPERTY MAY BE SUBJECT TO EASEMENTS, NOTES AND NOTICES AS SET FORTH ON THE PLAT OF SUBDIVISION RECORDED JANUARY 5, 2017 AT RECEPTION NO. 217713868.


DOWN, THE PROPERTY MAY BE SUBJECT TO TERMS AGREEMENTS, PROVISIONS CONDITIONS AND OBLIGATIONS AS CONTAINED IN RESOLUTION ND. 18-038 RECORDED JANUARY 24, 2018 AT RECEPTION NO. 218009074. sond. THE PROPERTY MAY BE SUBJECT TO MATTERS AS SHOWN ON THE


LORSON RANCH EAST PUD DEVELOPMENT & PRELIMINARY PLAN RECORDED FEBRUARY 15, 2018 AT RECEPTION NO. 218018251.

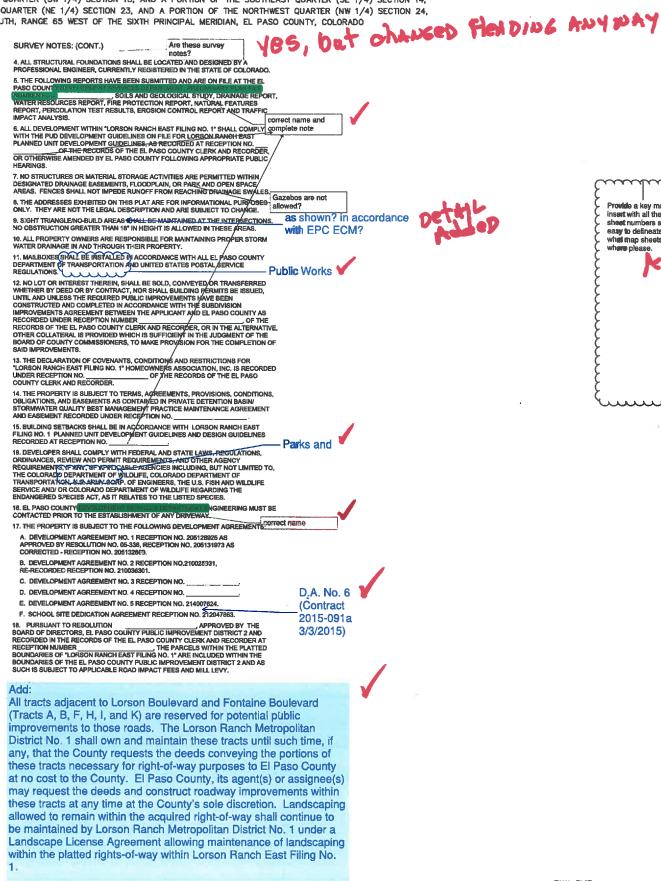

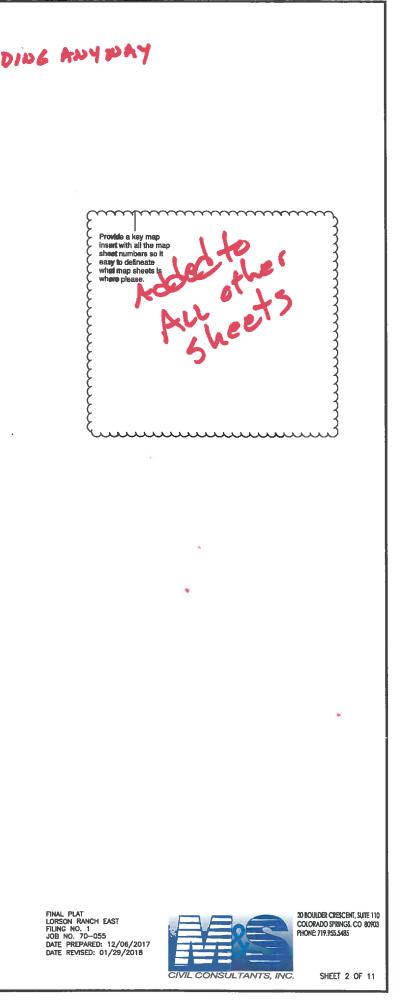

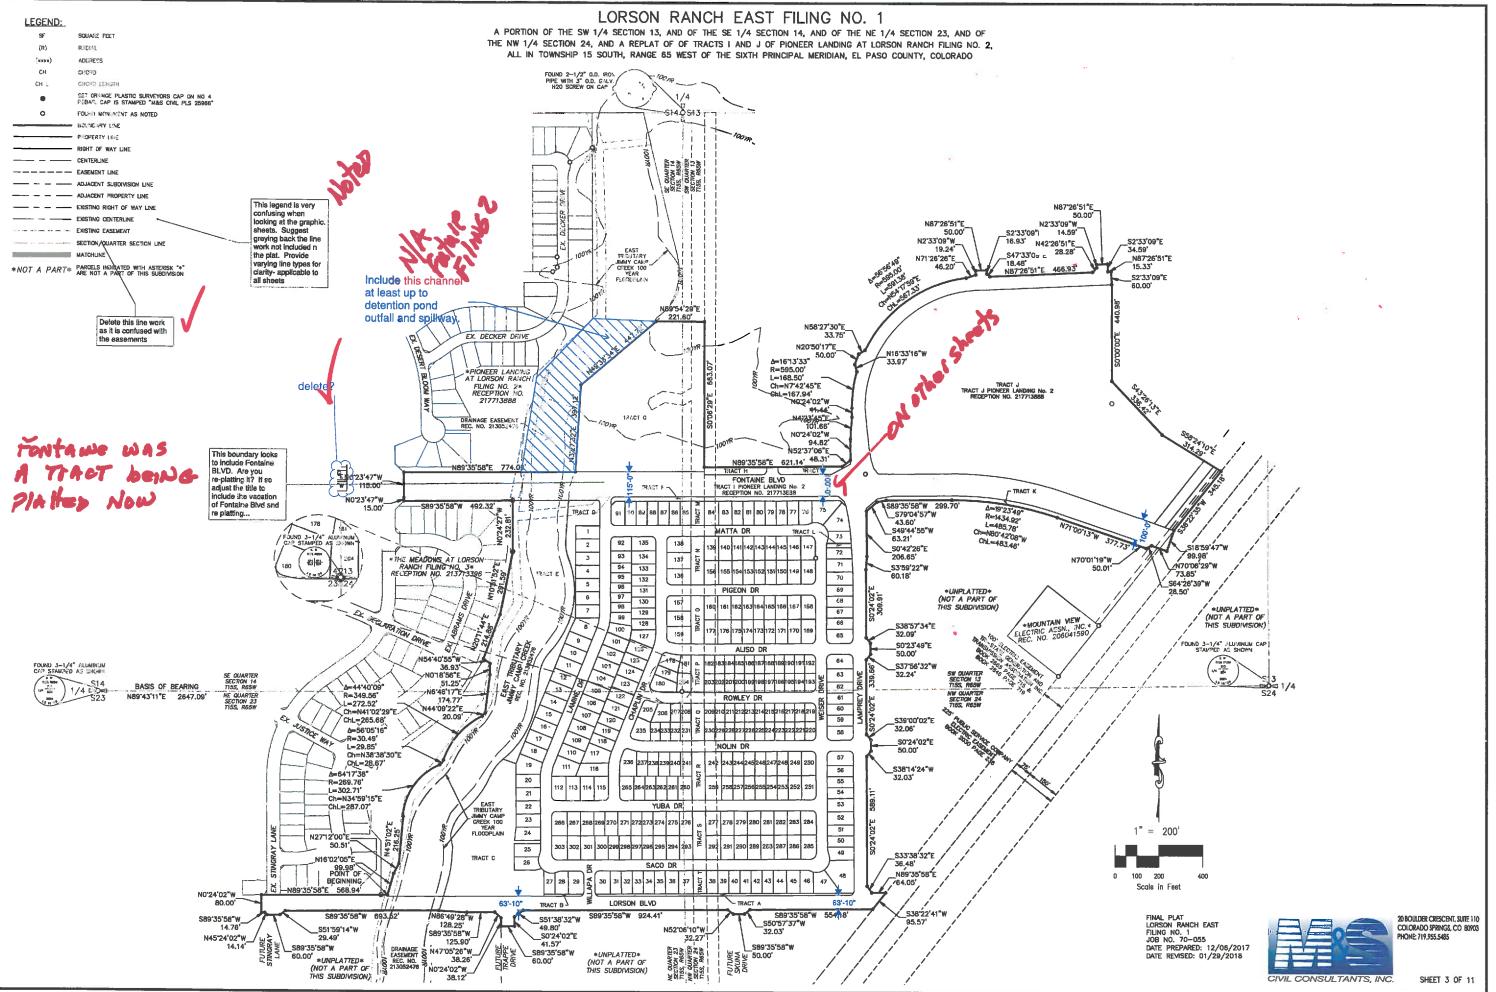

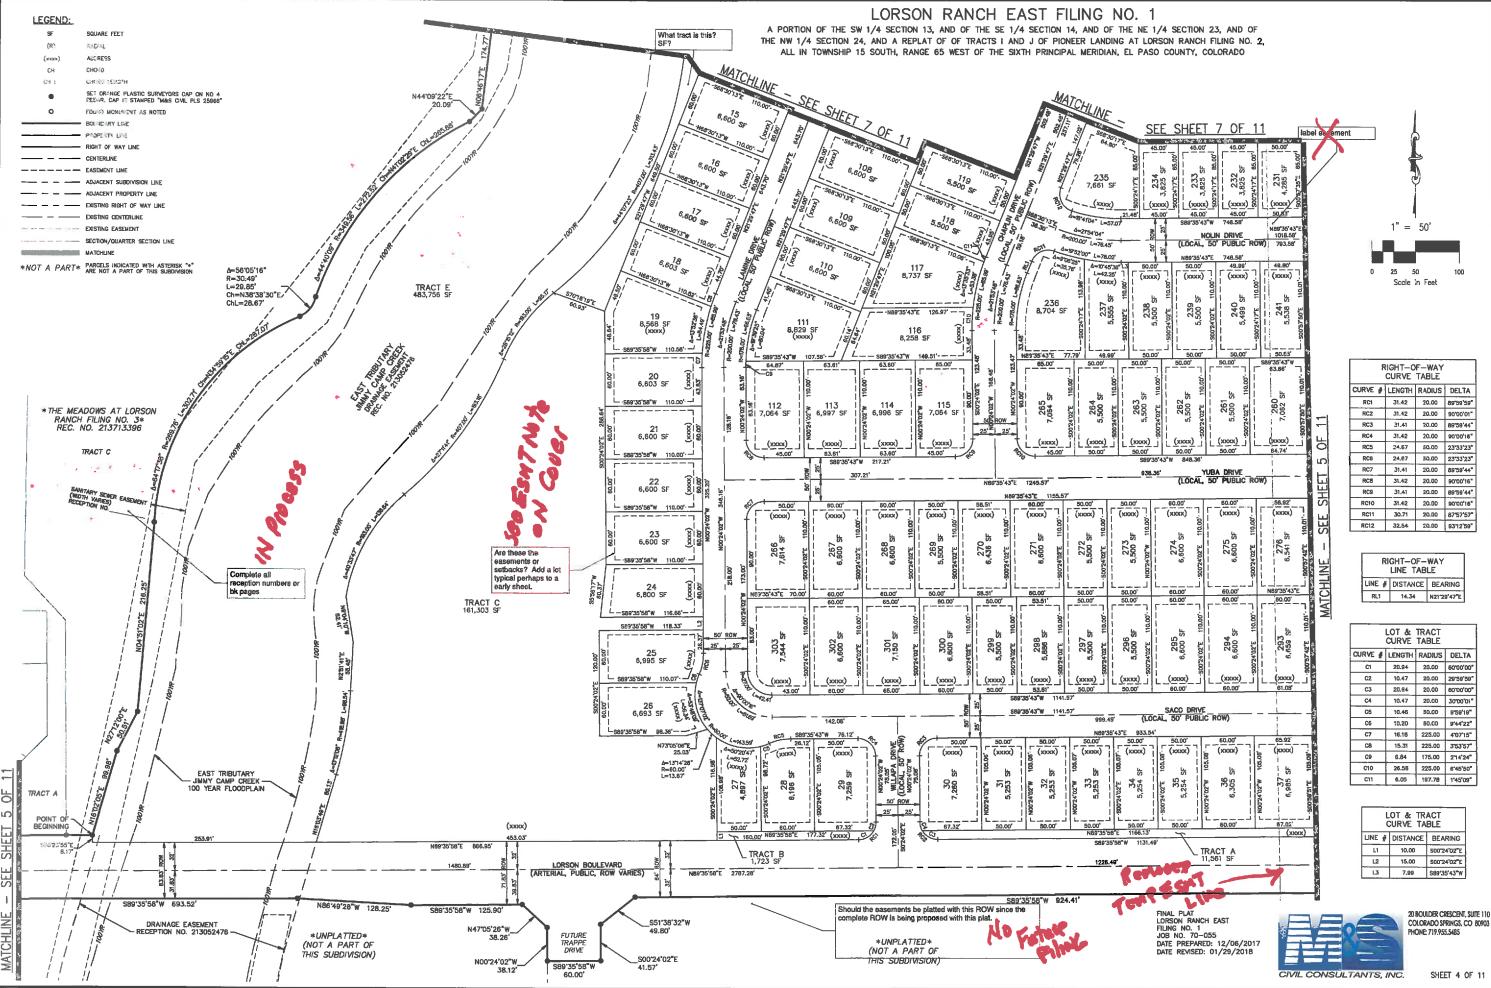

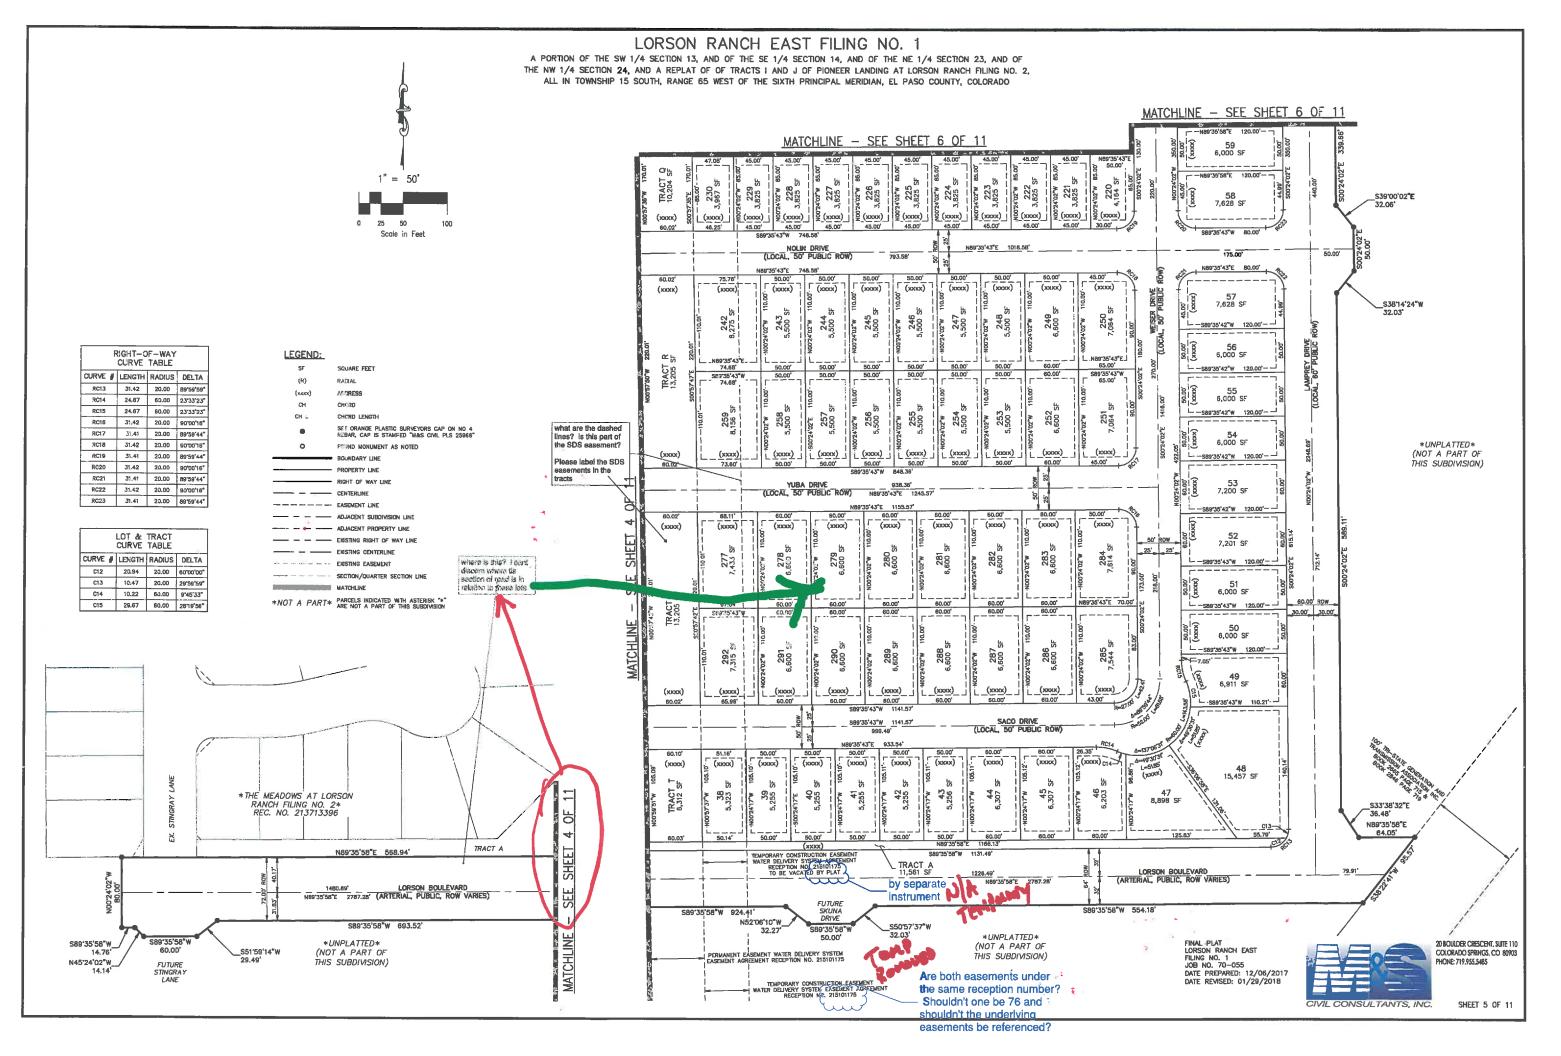

3/2/2018 4:15 PM - Be E Ē

	RIGHT-C		
CURVE	LENGTH	RADIUS	DELTA
RC24	31.42	20.00	90'00'16"
RC25	31.41	20.00	89'59'44"
RC26	31.42	20.00	90*00*16*
RC27	31.41	20.00	89'59'44"
RC2B	31.42	20.00	90'00'16"
RC29	31.41	20.00	£3'59'44°
RC30	31.42	20.00	90'00'16"
RC31	31.41	20.00	89'59'44"
RC32	31.42	20.00	90'00'16"
RC33	31.41	20.00	89'59'44"

ت میں الاتحاد میں الاتحاد ال	(XXXX) 13,205 SF 205 SF	80006287E 220.00 80006287E 220.00 110.00	$\begin{array}{c c c c c c c c c c c c c c c c c c c $	MAILTIEILE
SHEET 7 OF 11	TRACT 0 13,205 SF 0 70000	-110.00	PRECENT DRIVE Neargetation Neargetation Source	→ → </th
MATCHLINE - SEE S	(xxxx) 80.02' 60.02' (xxxx) d L 50.02' (xxxx)	(xxxx) 62.34'	B B	Image: Subscription of the su
N 1 2 2 2 2 2 2 2 2 2 2 2 2 2 2 2 2 2 2	(хоок) 	80037355 178.01 	Image: Signed	Image: Ser 35 Ser W 120.00' 000 Sw QUARTER SCROW 13 STORY Image: Ser 35 Ser W 120.00' 000 Sw QUARTER SCROW 13 STORY Image: Ser 35 Ser W 120.00' 000 Sr Scrow 12 Story Image: Ser 35 Ser W 120.00' 000 Sr Scrow 12 Story Image: Ser 35 Ser W 120.00' 000 Sr Scrow 12 Story Image: Ser 35 Ser W 120.00' 000 Sr Scrow 12 Story Image: Ser 35 Ser W 120.00' 000 Sr Scrow 12 Story Image: Ser 35 Ser W 120.00' 000 Sr Scrow 12 Story Image: Ser 35 Ser W 120.00' 000 Sr Scrow 12 Story Image: Ser 35 Ser W 120.00' 1000 000 Image: Ser 35 Ser W 120.00' 1000 Image: Ser 35 Ser W 120.00' 1000' Image: Ser 35 Ser W 120.00' 1000' Image: Ser 35 Ser W 120.00' 1000' Image: Ser 35 Ser W 120.00' 100'
	1999 - N.Y.	1945	MATCHLINE - SEE SHEET 5 OF 11	

1 (1) (P)

LORSON RANCH EAST FILING NO. 1

A PORTION OF THE SW 1/4 SECTION 13, AND OF THE SE 1/4 SECTION 14, AND OF THE NE 1/4 SECTION 23, AND OF THE NW 1/4 SECTION 24, AND A REPLAT OF OF TRACTS I AND J OF PIONEER LANDING AT LORSON RANCH FILING NO. 2. ALL IN TOWNSHIP 15 SOUTH, RANGE 65 WEST OF THE SIXTH PRINCIPAL MERIDIAN, EL PASO COUNTY, COLORADO

CH

CH 1

• 0

SF SQUARE FEET

----- PHOREN LINE RIGHT OF WAY LINE CENTERLINE ---- EASEMENT LINE _____ ADJACENT PROPERTY LINE

MATCHLINE

----- EXISTING RIGHT OF WAY LINE ------ EXISTING CENTERLINE EXISTING EASEMENT SECTION/QUARTER SECTION LINE

NOT A PART PARCELS INDICATED WITH ASTERISK **"


- (R) PADIAL.
- (хякх)
 - ALCREUS

 - LH640 CHC LO LEMOTH

SET ORANGE FLASTIC SURVEYORS CAP ON NO 4 REBAR, CAP IS STAMPED "M&S CIVIL PLS 25966"

FOUSD MONOMENT AS NOTED BOUNDARY LINE

F_11

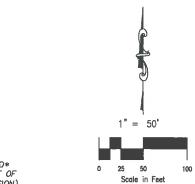


INPLATTED* A PART OF SUBDIVISION)



FINAL PLAT LORSON RANCH EAST FILING NO. 1 JOB NO. 70-055 DATE PREPARED: 12/05/2017 DATE REVISED: 01/29/2018



20 BOULDER CRESCENT, SUITE 110 COLORADO SPRINGS, CO 80903 PHONE 719,955,5485

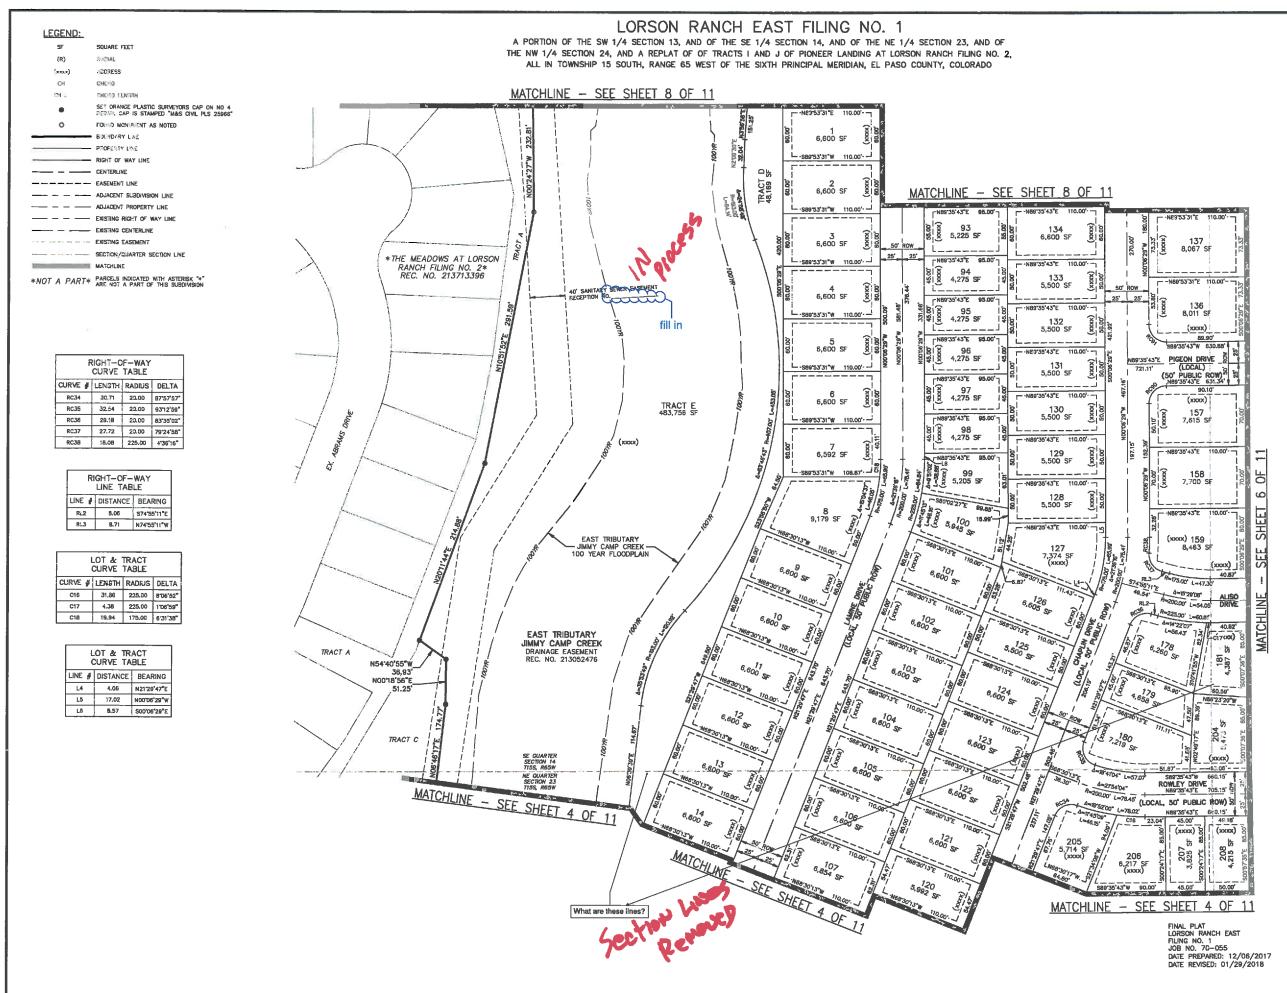



1" = 50'


Scale in Feet


100

D 25 50

20 BOULDER CRESCENT, SUITE 110 COLORADO SPRINGS, CO 80903 PHONE: 719.955.5485

SHEET 7 OF 11

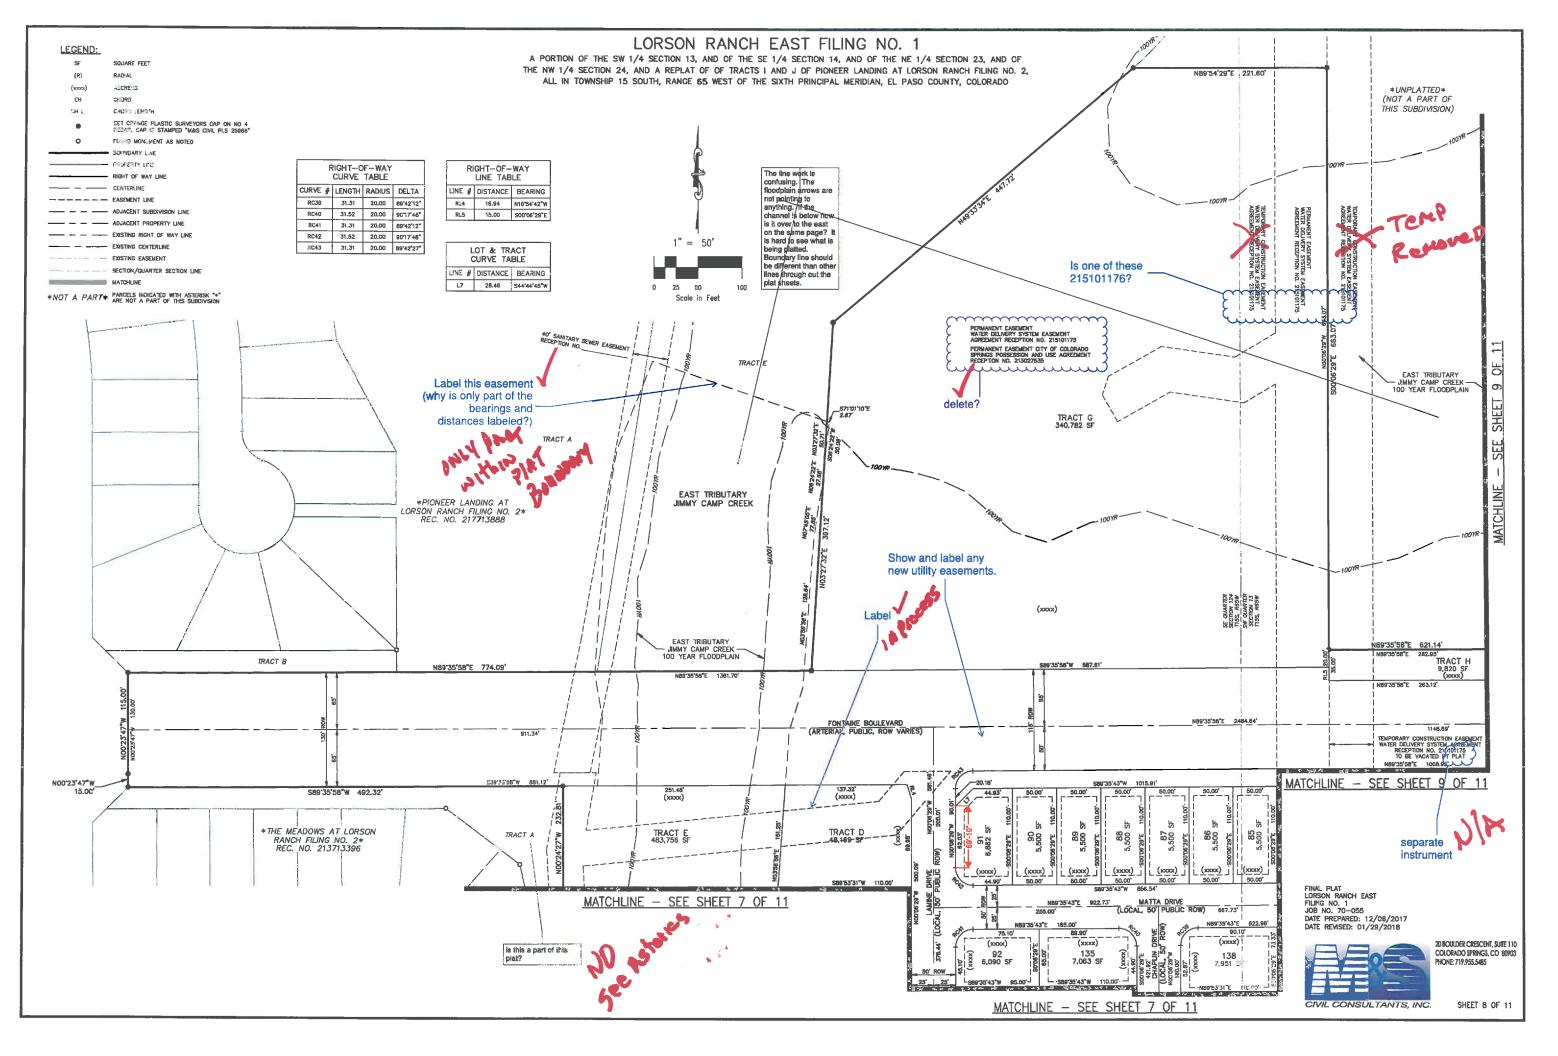

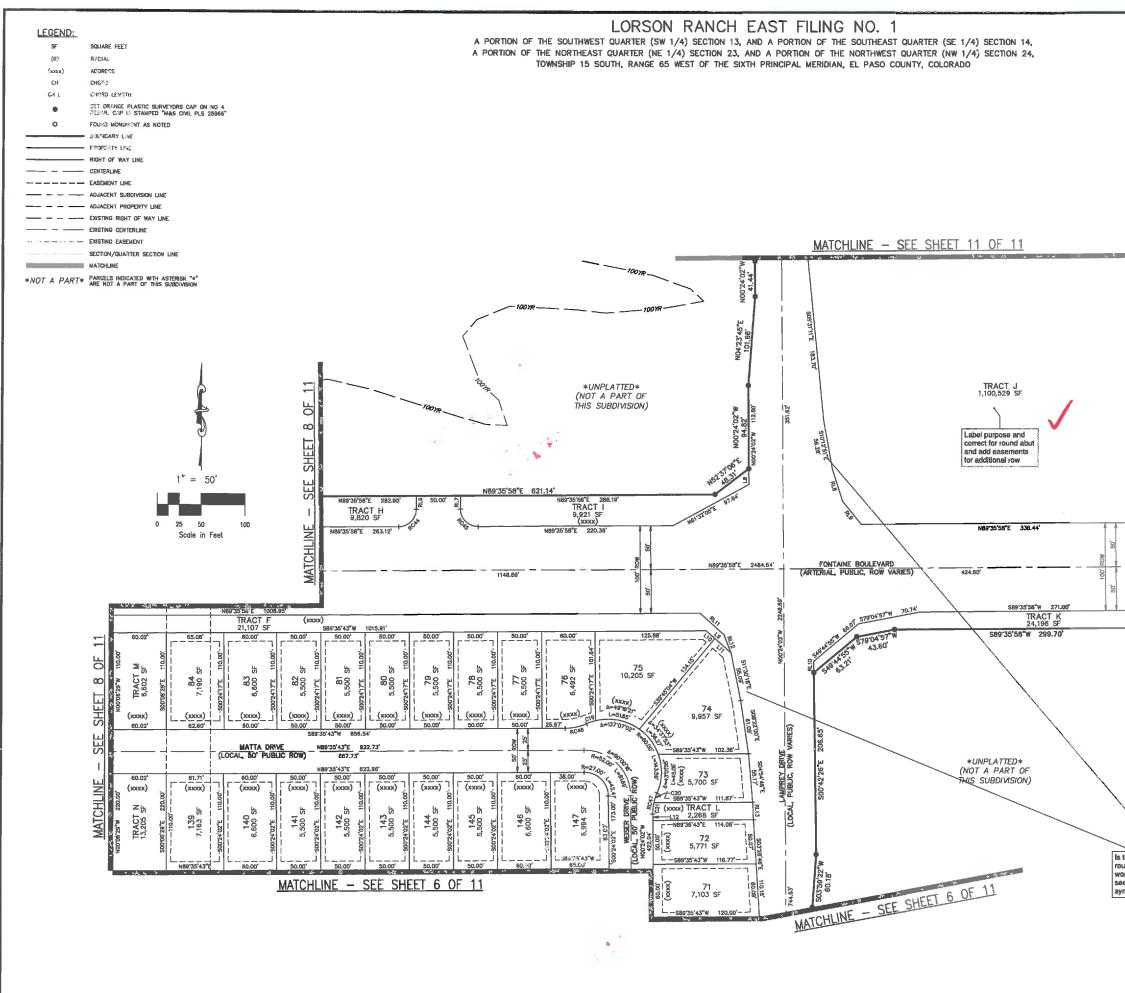

RIGHT-OF-WAY CURVE TABLE				
CURVE #	LENGTH	RADIUS	DELTA	
RC44	31.42	20.00	90,00,00	
RC45	31.42	20.00	\$0.00,00,	
RC46	24.67	60.00	23'33'23"	
RC47	24.67	60.00	23'33'23"	

RIGHT-OF-WAY LINE TABLE				
LINE #	DISTANCE	BEARING		
RL6	15.00	N00"24"02"W		
RL7	15.00	S00'24'02"E		
RL8	38.27	S1711'10"E		
RL9	33.84	S38'53'40"E		
RL10	13.03	S00"23"55"E		
RL11	36.47	\$48'04'43"E		
RL12	22.31	\$21'26'32"E		
RL13	20.02	S02"40'46"E		

LOT & TRACT CURVE TABLE				
CURVE #	LENGTH	RADIUS	DELTA	
019	10.61	60.00	10'07'53"	
C20	11.60	60.00	11'04'48"	
021	13.07	60.00	12'28'35"	

LOT & TRACT CURVE TABLE				
LINE #	DISTANCE	BEARING		
L8	17.98	N00"24"02"W		
L9	37.78	N48'04'43"W		
L10	13.17	N48'04'43"W		
L11	24.61	N48'04'43"W		
L12 7.04		S00'24'02"E		

SHEET SEE 1 MATCHLINE

1

Ь

0

Is this intersection round-a-bout line work correct? It seems off symmetrically.




FINAL PLAT LORSON RANCH EAST FILING NO. 1 JOB NO. 70-055 DATE PREPARED: 12/06/2017 DATE REVISED: 01/29/2018




20 BOULDER CRESCENT, SUITE 110 COLORADO SPRINGS, CO 80903 PHONE: 719,955,5485

SHEET 9 OF 11

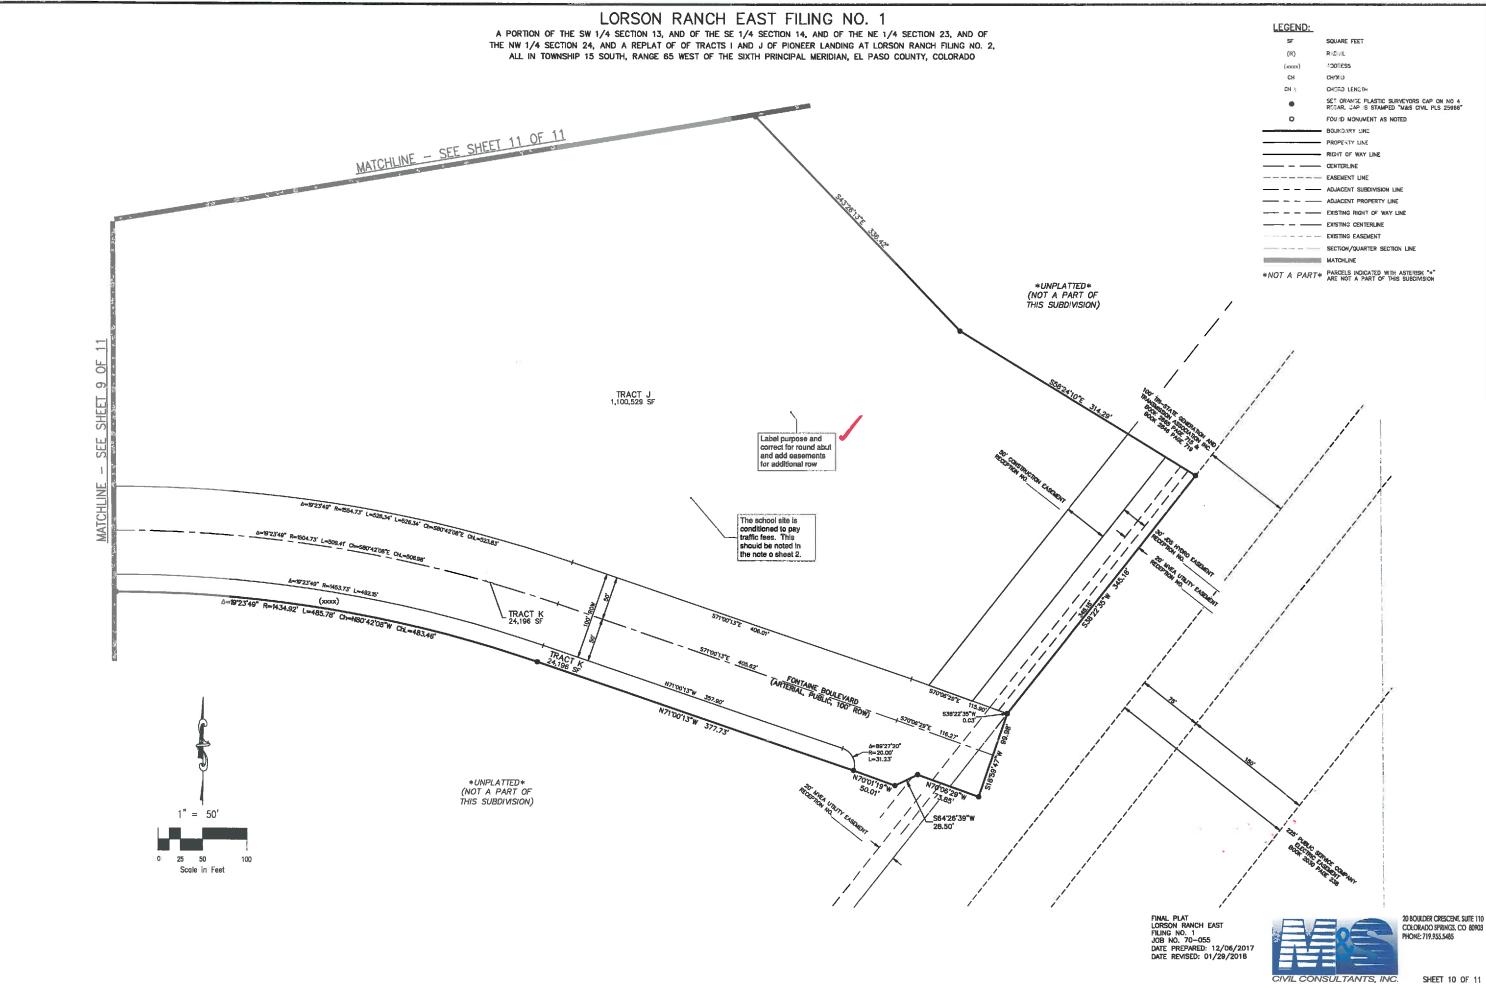



SF	SQUARE FEET
(R)	REDUL
(REER)	DDRESS
СН	CHOLD
CH 1	CHORD LENGTH
•	SET ORANGE PLASTIC SURVEYORS CAP ON NO 4 REDAR, CAP IS STAMPED "Mars CIVIL PLS 25966"
0	FOU ID NONUMENT AS NOTED
	BOUNDARY LINE
	PROPERTY LINE
	RICHT OF WAY LINE
	CENTERLINE
	EASEMENT LINE
	ADJACENT SUBDIVISION LINE
<u> </u>	ADJACENT PROPERTY LINE
	EXISTING RIGHT OF WAY LINE
	EXISTING CENTERLINE
	EXISTING EASEMENT
174 - 18 - 184	SECTION/QUARTER SECTION LINE
	MATCHLINE
NOT A PART	PARCELS INDICATED WITH ASTERISK "*"

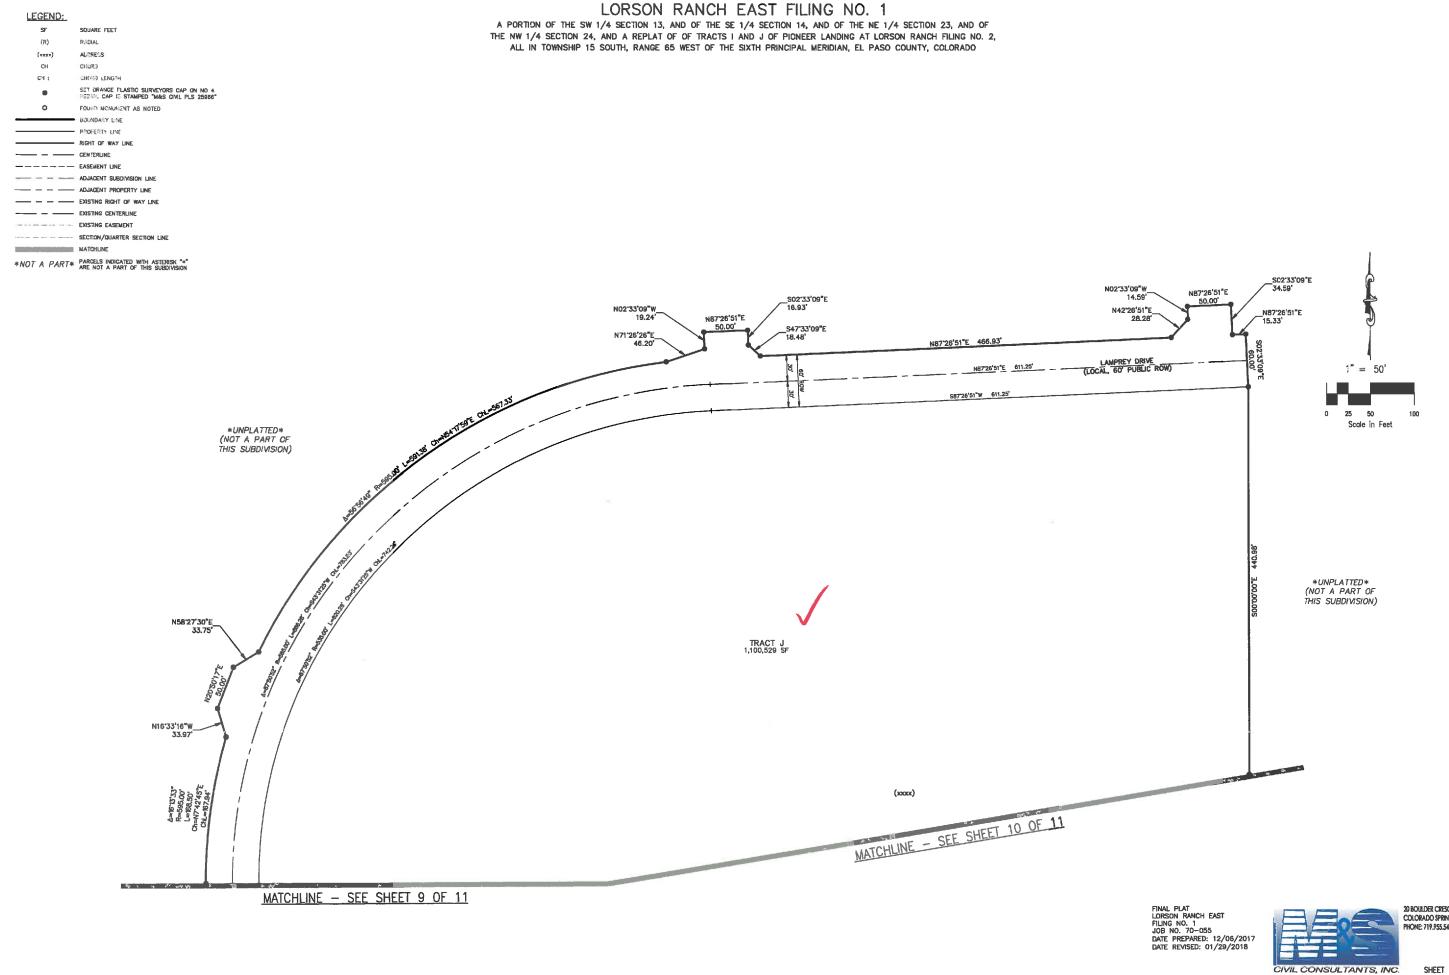

2

20 BOULDER CRESCENT, SUITE 110 COLORADO SPRINGS, CO 80903 PHONE: 719.955.5485

Stewart Title Guaranty Company

COMMITMENT FOR TITLE INSURANCE

SCHEDULE B - SECTION II EXCEPTIONS

Effective Date: February 22, 2018 at 7:30am

The Policy or Policies to be issued will contain exceptions to the following matters unless the same are disposed of to the satisfaction of the Company:

- 1. Rights or claims of parties in possession not shown by the Public Records.
- 2. Easements or claims of easements not shown in the Public Records.
- 3. Any encroachment, encumbrance, violation, variation, or adverse circumstance affecting the Title that would be disclosed by an accurate and complete land survey of the Land and not shown by the Public Records.
- 4. Any lien, or right to a lien, for services, labor or material heretofore or hereafter furnished, imposed by law and not shown by the public records.
- 5. Defects, liens, encumbrances, adverse claims or other matters, if any, created, first appearing in the public records or attaching subsequent to the effective date hereof but prior to the date the proposed insured acquires of record for value the estate or interest or mortgage thereon covered by this Commitment.
- 6. Unpatented mining claims; reservations or exceptions in patents or in Acts authorizing the issuance thereof.
- 7. Any water rights or claims or title to water, in or under the land, whether or not shown by the public records.
- 8. Taxes due and payable; and any tax, special assessments, charge or lien imposed for water or sewer service, or for any other special taxing district. Note: Upon verification of payment of all taxes the above exception will be amended to read, "Taxes and assessments for the current year, and subsequent years, a lien not yet due and payable."
- 9. Resolution of the Board of County Commissioners dated and recorded October 2, 1897 in Road Book A at Page 78, which provided that all Section lines, Township lines on the public Domain East of the Range line separating ranges 85 West and 86 West are declared to be public highways having a width of 60 feet, being 30 feet on each side of said Section lines, Township lines or Range lines. NOTE: Resolution No. 04-507 regarding Road Order recorded November 24, 2004 at Reception No.

204193597 and Disclaimer recorded November 24, 2004 at Reception No. 204193598.

- 10. Reservation by The League Land Company, for itself, its successors and assigns, of a right of way across all of the land for such lateral ditches as maybe necessary to enable the Company and its successors and assigns to convey and supply water from its reservoirs, canals and main laterals to lands lying beyond the described tract, as described in Deed recorded August 28, 1922 in Book 683 at Page 88.
- 11. Any question, dispute or adverse claims as to any loss or gain of land as a result of any change in the river bed location by other than natural causes, or alteration through accretion, reliction, erosion or avulsion of the center thread, bank, channel or flow of waters in Jimmy Camp Creek lying within subject land; and any question as to the location of such center thread, bed bank or channel as a legal description monument or marker for purposes of describing or locating subject lands.

NOTE: There are no documents in the land records of the office of the Clerk and Recorder of El Paso, accurately locating past or present location(s) of the center thread, bank, bed or channel of the above Jimmy Camp Creek or indicating any alterations of the same as from time to time may have occurred.

- 12. The lawful consequences of the existance of any portion of the subject property of any ponds, reservoirs, irrigation canals, ditches or laterals, including, but not limited to, any of such structures owned and/or used by the Fountain Mutual Irrigation Company.
- 13. Any assessment or lien of Fountain Valley Soil Conservation District as disclosed by the instrument recorded June 21, 1943 at Reception No. 683031.
- 14. Terms, agreements, provisions, conditions, obligations and easements as contained in Easement to Public Service Company of Colorado, recorded August 20, 1964 in Book 2030 at Page 238.
- 15. Terms, agreements, provisions, conditions, obligations and easements as contained in Grant of Right of Way to Public Service Company of Colorado, recorded September 16, 1968 in Book 2030 at Page 238.
- 16. Terms, agreements, provisions, conditions, obligations and easements as contained in Consent to Easement, recorded August 20, 1964 in Book 2030 at Page 239.
- 17. Terms, agreements, provisions, conditions, obligations and easements as contained in Consent to Easement, recorded August 20, 1964 in Book 2030 at Page 240.
- 18. Terms, agreements, provisions, conditions, obligations and easements as contained in Consent to Easement, recorded December 22, 1966 in Book 2160 at Page 111.
- 19. Terms, agreements, provisions, conditions, obligations and easements as contained in Easement, recorded April 1, 1974 in Book 2665 at Page 715 and Assignment recorded July 27, 1976 in Book 2846 at Page 719.
- 20. Terms, agreements, provisions, conditions, obligations and easements as contained in Right-of-Way Easement to Mountain View Electric Association, Inc., recorded March 7, 1983 in Book 3684 at Page 492.
 - 21. Any assessment or lien, by reason of inclusion within the Security Fire Protection District as disclosed by Order of Inclusion recorded in Book 5258 at Page 1049 and recorded July 31, 2013 at Reception No. 213098578.

- 22. INTENTIONALLY DELETED: <u>Terms, agreements, provisions, conditions, obligations and casements as</u> contained in Permanent Utility Easement to the City of Colorado Springs, recorded March 23, 1992 in Book 5951 at Page 291.
- 23. Terms, agreements, provisions, conditions and obligations as contained in Resolutions recorded January 3, 1996 at Reception No. 96001104 and recorded December 20, 1996 at Reception No. 96156842.
- 24. Terms, agreements, provisions, conditions and obligations as contained in Resolution No. 04-119, by and before the Board of County Commissioners, County of El Paso, State of Colorado, recorded April 6, 2004 at Reception No. 204055084. Resolution No. 12-196, by and before the Board of County Commissioners, County of El Paso, State of Colorado, in connection therewith recorded August 6, 2012 at Reception No. 212090407. Fifth Amended Development Agreement, in connection therewith recorded January 29, 2014 at Reception No. 214007624. Resolution No. 15-091, by and before the Board of County Commissioners, County of El Paso, State of Colorado, in connection therewith recorded March 4, 2015 at Reception No. 215020531.
- 25. Any assessment or lien of Widefield Water & Sanitation District as disclosed by the instrument recorded June 20, 2005 at Reception No. 205091663.
- Terms, agreements, provisions, conditions and obligations as contained in Resolution No. 04-366, by and 26. before the Board of County Commissioners, County of El Paso, State of Colorado, recorded September 3, 2004 at Reception No. 204150548. Resolution No. 05-336, Approving Development Agreement, by and before the Board of County Commissioners, County of El Paso, State of Colorado, recorded August 24, 2005 at Reception No. 205131973. Corrected Version of said Resolution No. 05-336 in connection therewith recorded August 25, 2005 at Reception No. 205132869. Resolution No. 07-223, Approving Amended Service Plan, Lorson Ranch Metropolitan Districts 1-7, by and before the Board of County Commissioners, County of El Paso, State of Colorado, recorded July 17, 2007 at Reception No. 207095523. Resolution No. 07-356 recorded September 11, 2007 at Reception No. 207118189. Development Agreement No. 1 Lorson Ranch, in connection therewith recorded August 19, 2005 at Reception No. 205128925. Development Agreement No. 2, Lorson Ranch, in connection therewith recorded May 22, 2010 at Reception No. 210025931 and rerecorded April 20, 2010 at Reception No. 210036301. Resolution No. 10-94 to Revise Development Agreement, by and before the Board of County Commissioners, County of El Paso, State of Colorado, recorded October 12, 2010 at Reception No. 210101176. Resolution No. 12-335 Approving Intergovernmental Agreement concerning the Marksheffel Road/Fontaine Boulevard Intersection, recorded September 26, 2012 at Reception No. 212112804. Annual Report and Disclosure Form recorded September 7, 2007 at Reception No. 207116859; recorded October 30, 2013 at Reception No. 213134075, General Disclosure recorded July 11, 2017 at Reception No. 217080960.
- 27. Any fee, tax, lien or assessment by reason of inclusion within the Lorson Ranch Metropolitan District No. 3, as set forth in Order and Decree organizing said district recorded December 2, 2004 at Reception No. 204197513. Amended Order and Decree in connection therewith recorded December 2, 2004 at Reception No. 204197520. Order of Inclusion in connection therewith recorded December 28, 2004 at Reception No. 204209874; recorded April 15, 2005 at Reception No. 205053570, recorded April 21, 2005 at Reception No. 205056110 and at Reception No. 205056116; and recorded April 21, 2005 at Reception No. 205056117. Notice of Special District Authorization of Issuance of General Obligation Indebtedness, in connection therewith recorded November 23, 2004 at Reception No. 204192908. Order and Decree of Correction recorded June 17, 2015 at Reception No. 215062852, recorded May 26, 2016 at Reception No. 216056939,

recorded September 11, 2017 at Reception No. 217109165.

- 28. Any fee, tax, lien or assessment by reason of inclusion within the Lorson Ranch Metropolitan District No. 4, as set forth in Order and Decree organizing said district as evidenced by instruments recorded December 2, 2004 at Reception No. 204197514, recorded December 28, 2004 at Reception No. 204209875, recorded April 15, 2005 at Reception No. 205053571, recorded April 21, 2005 at Reception No. 205056111 and at Reception No. 205056117 and recorded September 11, 2017 at Reception No. 217109166.
- 29. Any fee, tax, lien or assessment by reason of inclusion within the Lorson Ranch Metropolitan District No. 5, as set forth in Order and Decree organizing said district as evidenced by instruments recorded December 2, 2004 at Reception No. 204197515, recorded December 28, 2004 at Reception No. 204209876, recorded April 15, 2005 at Reception No. 205053572, recorded April 21, 2005 at Reception No. 205056112 and at Reception No. 205056118, recorded May 9, 2006 at Reception No. 206068332,
- 30. Terms, conditions, provision, agreements and obligations contained in the Inclusion & Service Agreement between Widefield Water & Sanitation District and Lorson LLC recorded on May 31, 2005 at Reception Number 205078708.
- 31. Terms, conditions, provisions, agreements and obligations contained in the Development Agreement No. 1 -Lorson Ranch recorded on August 18, 2005 at Reception Number 205128925.

NOTE: Resolution No. 05-336 to approve a development agreement recorded August 24, 2005 at Reception No. 205131973 and correction Resolution recorded August 25, 2005 at Reception No. 205132869.

- 32. INTENTIONALLY DELETED: Terms, agreements, provisions, conditions, obligations and easements as contained in Grant of Right of Way to Mountain View Electric Association, Inc., recorded November 21, 2005 at Reception No. 205186520.
- 33. INTENTIONALLY DELETED: Terms, agreements, provisions, conditions and obligations as contained in Resolution No. 05-434 recorded November 29, 2005 at Reception No. 205190016.
- 34. Subject to the effect of the Lorson Ranch Overall Development and Phase Plan Maps recorded March 9, 2006 at Reception No. 206035127.
- 35. INTENTIONALLY DELETED: Terms, condition, provisions, agreements and obligations contained in the Ditch Relocation, Improvement and Easement Agreement recorded on August 8, 2006 at Reception No. 206127024. Quit Claim Deeds from Fountain Mutual Irrigation Company recorded September 28, 2006 at Reception No. 206143884, at Reception No. 206143885 and at Reception No. 206143886, purport torelinquish the existing casement to the present property owners.
- 36. Terms, conditions, provisions, agreements and obligations contained in the Resolution No. 06-028 (rezone) recorded on March 1, 2007 at Reception No. 207028942.
- 37. INTENTIONALLY DELETED: Terms, agreements, provisions, conditions, obligations and easements as contained in Resolution No. 07-119, recorded July 18, 2007 at Reception No. 207095753.
- 38. INTENTIONALLY DELETED: Terms, agreements, provisions, conditions, obligations and easements as contained in Private Detention Basin/Stormwater Quality Best Management Practice Maintenance

ALTA Commitment - Schedule B - Section II NOTE: This commitment consists of insert pages labeled in Schedule A, Schedule B-Section 1, and Schedule B-Section 2. This commitment is of no force and effect unless all schedules are included, along with any Rider pages incorporated by reference in the insert pages

Agreement and Easement, recorded September 7, 2007 at Reception No. 207116858.

- 39. INTENTIONALLY DELETED: Terms, agreements, rights, provisions, conditions, obligations and casements as contained in Right of Entry, recorded April 16, 2008 at Reception No. 208043428.
- 40. NA poos Not PAL with PIAT Terms, agreements, provisions, conditions, obligations and easements as contained in Sanitary Sewer Easement Agreement, recorded May 14, 2008 at Reception No. 208055334.
- 41. INTENTIONALLY DELETED: Terms, agreements, provisions, conditions, obligations and easements ascontained in Water and Sanitation Sewer Easement Agreement to Widefield Water and Sanitation-District, recorded June 12, 2008 at Reception No. 208067533.
- 42. INTENTIONALLY DELETED: Terms, agreements, provisions, conditions, obligations and casements ascontained in Temporary Construction Easement Agreement, recorded June 12, 2008 at Reception No.-208067660.
- 43. INTENTIONALLY DELETED: Terms, agreements, provisions, conditions and obligations as contained in-Carriage Meadows at Lorson Ranch Subdivision Planned Unit Development Guidelines and Design-Guidelines recorded July 23, 2008 at Reception No. 208083051.
- 44. INTENTIONALLY DELETED: Notes, casements and restrictions as shown on the plat of Carriage-Meadows at Lorson Ranch Subdivision PUD Rezone Development Plan recorded July 23, 2008 at Reception No. 208083052.
- 45. Terms, conditions, provisions, agreements and obligations contained in the Resolution No. 05-526 (rezone) recorded on November 5, 2008 at Reception No. 208120452.
- 46. INTENTIONALLY DELETED: Terms, agreements, provisions, conditions, obligations and easements as contained in Water and Sanitary Sewer Easement Agreement, recorded December 9, 2009 at Reception - No. 209141053 and at Reception No. 209141158.
- 47. INTENTIONALLY DELETED: Terms, agreements, provisions, conditions, obligations and casements ascontained in Water and Sanitary Sewer Easement Agreement, recorded December 9, 2009 at Reception-No. 209141164.
- 48. INTENTIONALLY DELETED: Terms, conditions and provisions of Park Lands Agreement recorded April 19, 2011 at Reception No. 211039089.
- 49. INTENTIONALLY DELETED: Terms, conditions, provisions, agreements and obligations contained in the Resolution No. 12-288, by and before the Board of County Commissioners, County of El Paso, State of Colorado recorded August 24, 2011 at Reception No. 211079059.
- 50. Terms, agreements, provisions, conditions and obligations as contained in Mineral Quit Claim Deeds November 16, 2012 at Reception No. 212137047 and recorded December 5, 2012 at Reception No. 212145159.
- 51. Terms, agreements, provisions, conditions, obligations and easements as contained in Drainage Easement, recorded April 23, 2013 at Reception No. 213052476.

As shown Permanent Easements on Ly

- 52. Terms, agreements, provisions, conditions, obligations and easements as contained in Water Delivery System Easement Agreement, recorded September 16, 2015 at Reception No. 215101175 and at Reception No. 215101176.
- 53. INTENTIONALLY DELETED: Terms, agreements, provisions, conditions, obligations and easements as contained in Grant of Right of Way to Mountain View Electric Association Inc., recorded January 19, 2016 at Reception No. 216005098.
- 54. INTENTIONALLY DELETED: Terms, agreements, provisions, conditions, obligations and easements as contained in Grant of Right of Way to Mountain View Electric Association Inc., recorded January 19, 2016 at Reception No. 216005099.
- 55. INTENTIONALLY DELETED: Terms, agreements, provisions, conditions, obligations and easements as contained in Resolution No. 16-065, recorded March 4, 2016 at Reception No. 216022298.
- 56. INTENTIONALLY DELETED: Terms, agreements, provisions, conditions, obligations and easements as contained in El Paso County, Colorado Possession and Use Agreement, recorded March 4, 2016 at Reception No. 216022299.
- 57. INTENTIONALLY DELETED: Notes, easements and restrictions as shown on the ALTA/ACSM Land-Title Survey recorded April 4, 2016 at Reception No. 216900032.
- 58. INTENTIONALLY DELETED: Terms, agreements, provisions, conditions and obligations as contained in-Resolution No. 17-96 recorded March 14, 2017 at Reception No. 217029448 and Map recorded April 5, 2017 at Reception No. 217038741.
- 59. INTENTIONALLY DELETED: Terms, agreements, provisions, conditions and obligations as contained in Resolution No. 17-262 recorded September 27, 2017 at Reception No. 217116463.

PARCELS C AND D:

- 60. Terms, agreements, provisions, conditions and obligations as contained in Inclusion & Service Agreement between Widefield Water & Sanitation District and Lorson, LLC recorded May 31, 2005 at Reception No. 205078708.
- 61. Matters as set forth and contained in the Lorson Ranch Overall Development and Phasing Plan Map recorded May 9, 2006 at Reception No. 206035127 and recorded December 28, 2006 at Reception No. 206187069.
- 62. Terms, agreements, provisions, conditions, obligations and easements as contained in Water and Sanitary Sewer Easement Agreement(s), recorded June 12, 2008 at Reception No. 208067502; at Reception No. 208067503; at Reception No. 208067532; at Reception No. 208067534; at Reception No. 208067645; at Reception No. 208067648.

63. Terms, agreements, provisions, conditions, obligations and easements as contained in Temporary Construction Easement Agreement(s), recorded June 12, 2008 at Reception No. 208067652; at Reception No. 208067656; at Reception No. 208067657; at Reception No. 208067667; at Reception No. 208067672; and

Blue dots = verify shown and labeled on plat.

File No: 55463UTC Amendment No: 1

at Reception No. 208067676.

- 64. Terms, agreements, provisions, conditions and obligations as contained in Pioneer Landing at Lorson Ranch Subdivision Planned Unit Development Guidelines recorded December 10, 2009 at Reception No. 209141654.
- 65. Terms, agreements, provisions, conditions, obligations and easements as contained in Right of Entry to the Colorado Springs Utilities (Southern Delivery System), recorded February 24, 2012 at Reception No. 212020136; and at Reception No. 212020137. City of Colorado Springs Possession and Use Agreement (Southern Delivery System), recorded March 1, 2013 at Reception No. 213027535.
- 66. Terms, agreements, provisions, conditions and obligations as contained in Resolution No. 12-126, by and before the Board of County Commissioners, County of El Paso, State of Colorado, regarding School Site Dedication Agreement recorded April 13, 2012 at Reception No. 212042170.
- 67. Terms, agreements, provisions, conditions and obligations as contained in School Site Dedication Agreement recorded July 27, 2012 at Reception No. 212047863.
- 68. Terms, agreements, provisions, conditions and obligations as contained in Resolution No. 12-382, by and before the Board of County Commissioners, County of El Paso, State of Colorado, Adopting the El Paso County Road Impact Fee Program, recorded November 15, 2012 at Reception No. 212136575.
- 69. Terms, agreements, provisions, conditions and obligations as contained in Resolution No. 16-118, by and before the Board of County Commissioners, County of El Paso, State of Colorado recorded April 13, 2016 at Reception No. 216037512.
- 70. Terms, agreements, provisions, conditions and obligations as contained in Resolution No. 16-228, by and before the Board of County Commissioners, County of El Paso, State of Colorado, Approval of Rezone, recorded June 29, 2016 at Reception No. 216070955.
- 71. Terms, agreements, provisions, conditions and obligations as contained in Resolution No. 16-229, by and before the Board of County Commissioners, County of El Paso, State of Colorado, Approval of Preliminary Plan, recorded June 29, 2016 at Reception No. 216070956; Resolution No. 16-313, by and before the Board of County Commissioners, County of El Paso, State of Colorado, Approval of Final Plan, recorded August 30, 2016 at Reception No. 216098747.
- 72. Matters as set forth and contained in the Lorson Ranch, Pioneer Landing Filing No. 2 and No. 3, PUD Development Plan Map recorded July 14, 2016 at Reception No. 216077631 and recorded February 2, 2017 at Reception No. 217013429.
- 73. Terms, agreements, provisions, conditions and obligations as contained in Resolution No. 16-307 recorded August 24, 2016 at Reception No. 216095697 and re-recorded September 30, 2016 at Reception No. 216113012.
- 74. Terms, agreements, provisions, conditions and obligations as contained in Resolution No. 16-456, by and before the Board of County Commissioners, County of El Paso, State of Colorado, Approving a Petition for Inclusion of property within the District - Pioneer Landing Filing No. 2 recorded December 15, 2016 at Reception No. 216145947.

- 75. Terms, agreements, provisions, conditions, obligations and easements as contained in Public Right of Way Mailbox License Agreement, recorded January 5, 2017 at Reception No. 217001494.
- 76. Terms, agreements, provisions, conditions, obligations and easements as contained in Public Right of Way Landscape License Agreement, recorded January 5, 2017 at Reception No. 217001495.
- 77. Terms, agreements, provisions, conditions, obligations and easements as contained in Private Detention Basin/Stormwater Quality Best Management Practice Maintenance Agreement and Easement, recorded January 5, 2017 at Reception No. 217001496.
- 78. Terms, agreements, provisions, conditions and obligations as contained in Subdivision Improvements Agreement recorded January 5, 2017 at Reception No. 217001497.
- 79. Covenants, conditions, restrictions and easements, if any, which do not contain a forfeiture or reverter clause, (deleting any restrictions indicating any preference, limitation or discrimination based on race, color, religion, sex, handicap, familial status or national origin) as contained in instrument recorded January 5, 2017 at Reception No. 217001508 and any and all amendments and/or supplements thereto.
- 80. Easements, notes and notices as set forth on the plat of subdivision recorded January 5, 2017 at Reception No. 217713888.
- 81. Any and all unrecorded leases or tenancies and any and all parties claiming by, through, or under such leases or tenancies.
- 82. Terms, agreements, provisions, conditions and obligations as contained in Resolution No. 18-038 recorded January 24, 2018 at Reception No. 218009074.
- 83. Matters as shown on the Lorson Ranch East PUD Development & Preliminary Plan recorded February 15, 2018 at Reception No. 218018251.

FOR INFORMATIONAL PURPOSES ONLY:

Lis Pendens recorded December 9, 2013 at Reception No. 213146131 and Amended Rule and Order recorded May 23, 2016 at Reception No. 216055186

Deed recorded December 9, 2004 at Reception No. 204201648. Deed recorded December 13, 2017 as Reception No. 217150656. Deed recorded April 28, 2016 at Reception No. 216044802.

NOTE: The policy(s) of insurance may contain a clause permitting arbitration of claims at the request of either the Insured or the Company. Upon request, the Company will provide a copy of this clause and the accompanying arbitration rules prior to the closing of the transaction.