

## **Drainage Letter**

For:

# Reigning Hope Indoor Arena

May 9, 2019

### **Prepared for**

Reigning Horse Indoor Arena  
14489 Holmes Rd  
Black Forest, CO 80905

### **Prepared By:**

Wallace Engineering, Structural Consultants, Inc.  
Structural and Civil Consultants  
Scott Rodehaver, P.E.  
9800 Pyramid Court, Suite 350  
Englewood, Colorado 80112  
303.350.1690  
[srodehaver@wallacesc.com](mailto:srodehaver@wallacesc.com)  
Wallace Project #1975017

### **Purpose:**

The purpose of this report is to explore the existing and proposed drainage conditions on the Reigning Hope Project site at 15589 Holmes Rd, Black Forest, Colorado 80908

Add PCD File No. PPR1935



**Wallace Engineering**  
Structural Consultants, Inc.  
9800 Pyramid Court, Suite 350  
Englewood, Colorado 80112  
303.350.1690, 800.364.5858  
[www.wallacesc.com](http://www.wallacesc.com)

**Engineer's Statement**

The attached drainage plan and letter were prepared under by direction and supervision and are correct to the best of my knowledge and belief. Said drainage letter has been prepared according to the criteria established by the County for drainage letters and said letter is in conformity with the master plan of the drainage basin. I accept responsibility for any liability caused by any negligent acts, errors or omissions on my part in preparing this report.



\_\_\_\_\_  
Name: Scott Rodehaver, P.E.



Seal

**Developer's Statement**

05/16/2019

I, the developer have read and will comply with all of the requirements specified in this drainage letter.

\_\_\_\_\_  
Business Name

By: \_\_\_\_\_

Title: \_\_\_\_\_

Address: \_\_\_\_\_

Please revise to state the following:  
Filed in accordance with the requirements of  
the Drainage Criteria Manual, Volumes 1 and  
2, El Paso County Engineering Criteria Manual  
and Land Development Code as amended.

**El Paso County Only:**

Filed in accordance with Section 51.1 of the El Paso County Land Development Code, amended

\_\_\_\_\_  
Director of Public Works

\_\_\_\_\_  
Date

Conditions:

Please revise to the following:  
Jennifer Irvine, P.E.  
County Engineer/ECM Administrator

## TABLE OF CONTENTS

I. General Description.....	4
II. Existing Drainage .....	4
III. Proposed Drainage.....	4
IV. Hydrologic Calculations.....	4
V. Conclusion.....	4

## APPENDICES

Vicinity Map.....	A
Existing Drainage Plan.....	B
Existing Hydrology Results.....	C
Proposed Drainage Plan.....	D
Proposed Hydrology Results.....	E
Culvert Calculations.....	F

The lot size is 4.15 acres.

Please provide a floodplain statement indicating whether or not any portion of the development is in a designated FEMA floodplain.

### General Description

Reigning Hope Project is a 1.6 acre lot in Black Forest, Colorado. The lot is located at the north end of Holmes Rd as shown in Appendix A. The site has three buildings currently, and is covered by gravel roads, some scattered trees, and grass area. A new indoor horse area is proposed on the north side of the property.

Please indicate what drainage basins the site is located in (i.e. Black Squirrel Creek and East Cherry Creek)

### Existing Drainage

The drainage from the site flows in two directions. The south half flows to the south and the north half flows north off the site. The south end of the site drains from the east to west, toward the center of the site, and then to the south and off the site. There is a drainage ditch along Holmes Rd where the drainage from the south end of the property flows. The north half of the site flows to the north, towards an existing gravel road. It then flows off the property and into a channel to the north. See existing drainage plan in Appendix B.

What is the ultimate outfall of this runoff? Discuss the impacts to the adjacent properties.

### Proposed Drainage

The proposed site will have a new indoor horse-riding arena on the north end of the site. The flow from the north of the property will be directed around the new arena towards the north. The drainage to the south of the proposed arena will be collected in a swale and directed around the existing building, and towards the existing drainage swale along Holmes Road. There is a proposed 18" culvert under the existing driveway for the drainage of subbasin B. The calculations for the culvert design are included in appendix F. The drainage pattern will be similar to the existing drainage pattern, with the addition of the new arena, and the associated swales and channels. See the proposed drainage plan in Appendix D.

### Hydrologic Calculations:

Please state whether the increase in flow is negligible or not.

This site was analyzed using the rational method, and a full spreadsheet of calculations is included in appendix C and E for the existing and proposed peak flowrate on the site. The peak flowrate for the 100 year storm on the existing site is 2.31 cfs for the north subbasin (A), and 1.58 cfs for the south subbasin (B). The proposed site also has a peak runoff for the 100 year storm of 1.93 for north subbasin (A) in the north and 2.01 for the south subbasin (B).

see comment above

### Conclusion

The Reigning Hope Indoor Arena project is a 1.6-acre site in Black Forest, Colorado. It will consist of a new arena addition, and the corresponding drainage and swales for the new arena. The drainage patterns and volumes will be very similar to the existing site at Reigning Hope.


Please indicate in the report whether or not there will be any adverse affects to the surrounding or downstream properties due to this development.

please see comments in the proposed conditions calculations.

Please include the evaluation of the 4-step process per ECM Section I.7.2.


**Appendix A**  
**Vicinity Map**



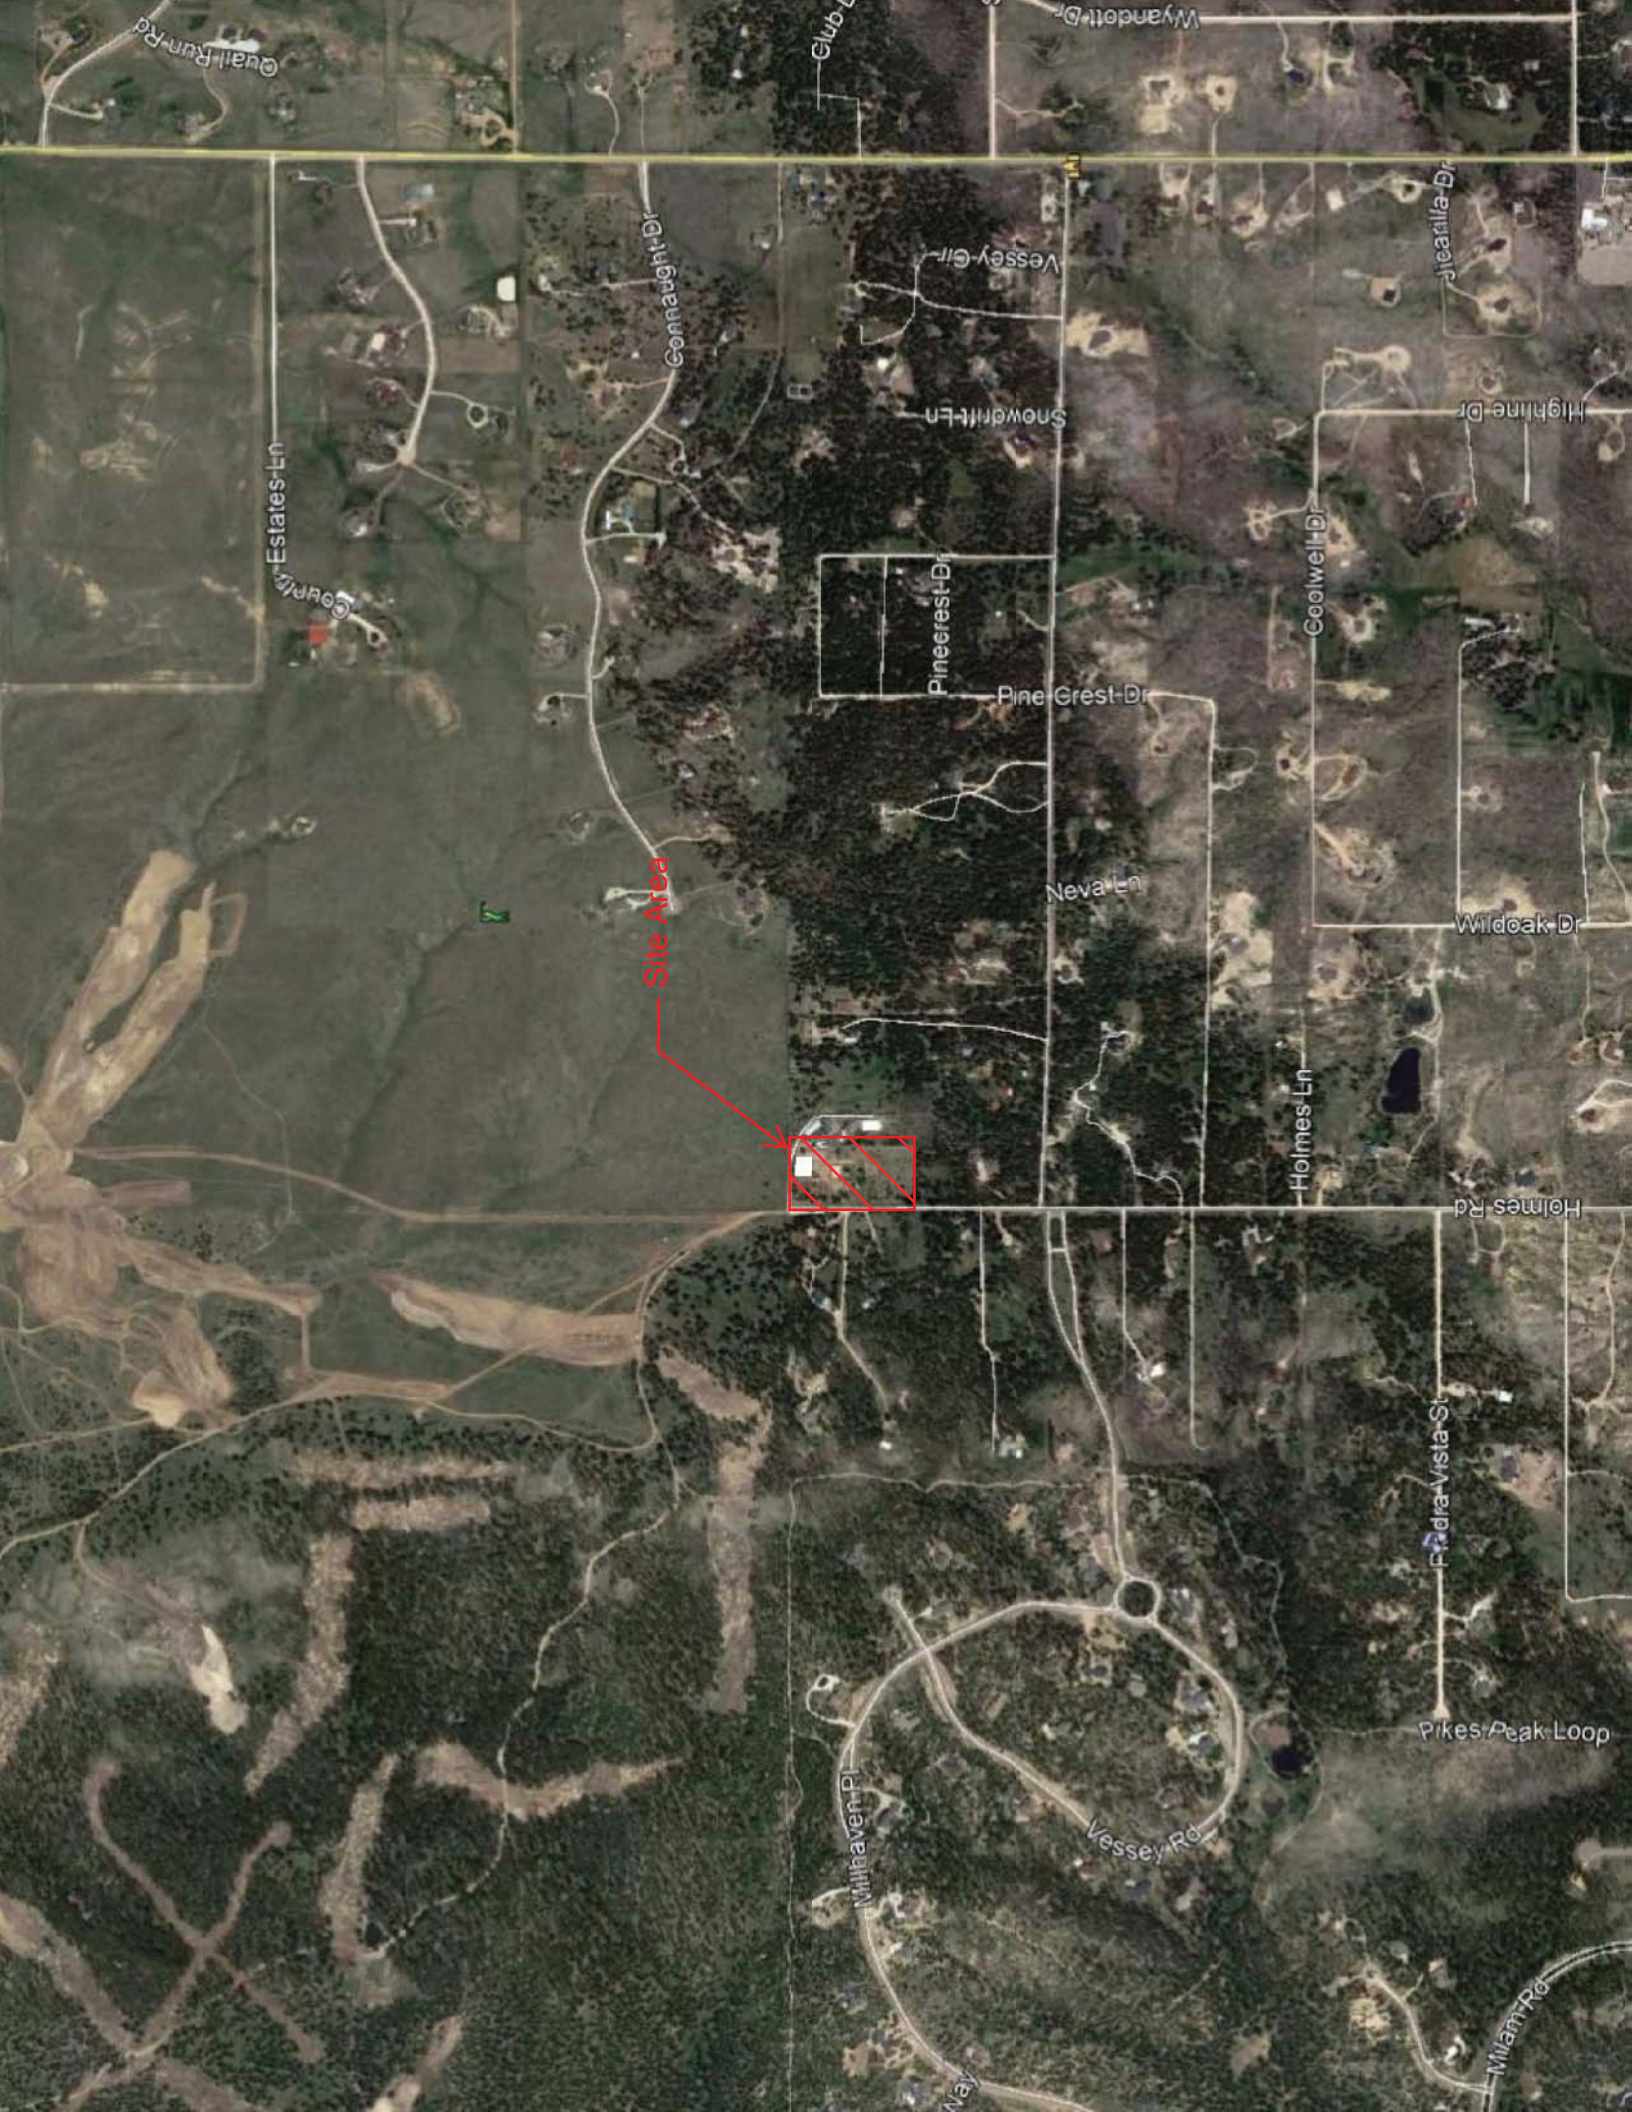

**Appendix B**  
**Existing Drainage Plan**



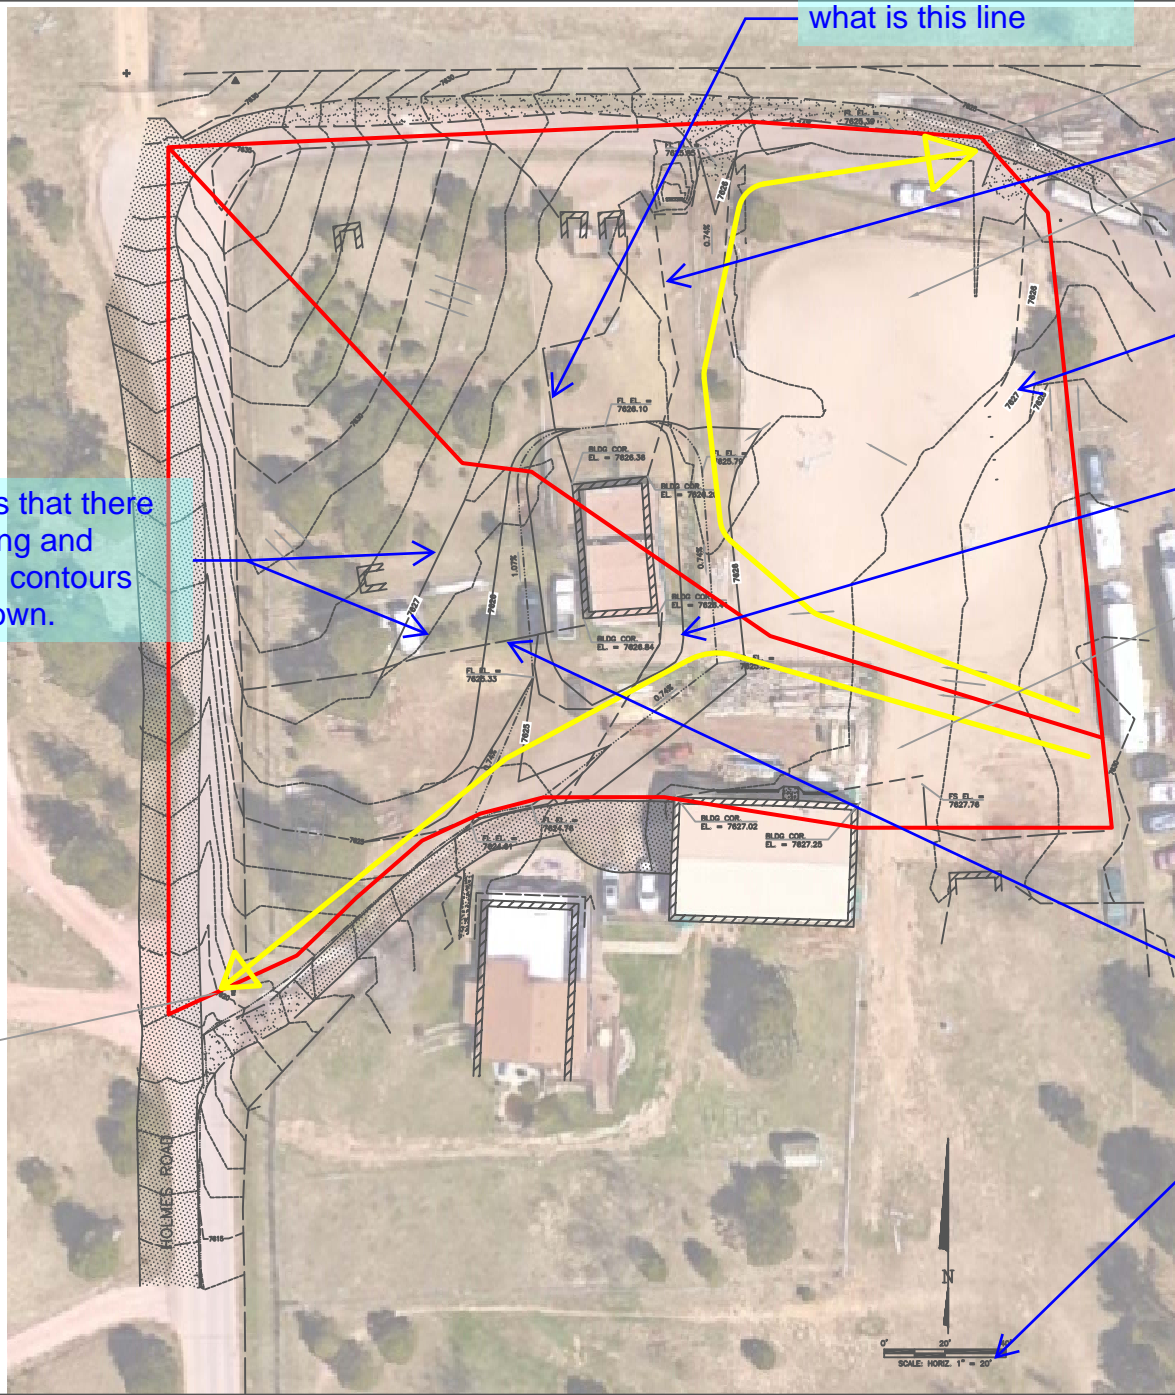

what is this line

POA-1

It appears as there are layers from the proposed plan being shown on the existing plan. Please update drawing accordingly.

Please fix the floating contour labels accordingly.

assuming this is a contour line, please add a contour label.

SUBBASIN-B

Please provide a legend for the various line types and hatches shown.

what is this line?

Please verify the scale as it does not appear to be correct

EXISTING DRAINAGE PLAN

FILED: \\gms-corp\project\110000209\110000209.dwg  
DATE: 11/11/2010  
TIME: 10:00 AM  
USER: C:\Users\craigo\Documents\110000209.dwg

SITE OVERVIEW  
HOFFMAN RANCH GRADING PLAN  
CRAIG HOFFMAN

THIS DRAWING IS THE  
PROPERTY OF GMS, INC.,  
AND IS NOT TO BE RE-  
PRODUCED, MODIFIED OR  
USED FOR ANY OTHER  
PROJECT OR EXTENSION  
OF THIS PROJECT EXCEPT  
BY AGREEMENT WITH THIS  
COMPANY.

DRAWN: JLB  
DESIGNED: JLB  
CHECKED: JLB  
DATE: 11/11/2010  
PROJECT NO.: 110000209  
GMS FILE NO.: 110000209

GMS, INC.  
CONSULTING ENGINEERS  
611 N. WEBER, SUITE 300  
COLORADO SPRINGS, COLORADO 80903

SHEET  
X  
OF  
X

It appears that there are existing and proposed contours being shown.



**Appendix C**  
**Existing Hydrology Results**

EXISTING CONDITIONS

Date	4/29/2019	Sheet No.	1	of	3
Job#	1975017 Reigning Hope Indoor Arena				
Subject	Existing Drainage Calculations				

Composite Runoff Coefficients

Land Use Or Surface Characteristics	% Imp.	Runoff Coefficients (HSG A&B)**			
		C <sub>2</sub>	C <sub>5</sub>	C <sub>10</sub>	C <sub>100</sub>
Hardscape (Asph & Conc)	100.0%	0.89	0.90	0.92	0.96
Roofs	90.0%	0.71	0.73	0.75	0.81
Gravel	80.0%	0.57	0.59	0.63	0.70
Lawns (A & B Soils, 2-7%)	0.0%	0.02	0.08	0.15	0.35
Lawns (C & D Soils, 2-7%)	0.0%	0.04	0.15	0.25	0.50

Design Layout

Subbasin	Total Area (acres)	Total Area (sf)	Land Use Area per Subbasin											Weighted Imperviousness	Total Weighted Runoff Coefficients			
			Hardscaping		Roofs		Gravel		Lawns (A&B Soils)		Lawns (C&D Soils)		% Check		2-year	5-year	10-year	100-year
			Area (sf)	%	Area (sf)	%	Area (sf)	%	Area (sf)	%	Area (sf)	%						
A	0.83	36,344	0	0.0%	283	0.8%	13,773	37.9%	22571	62.1%	0	0.0%	100.8%	31.02%	0.23	0.28	0.34	0.49
B	0.77	33,680	0	0.0%	791	2.3%	1,179	3.5%	31710	94.2%	0	0.0%	100.0%	4.91%	0.06	0.11	0.18	0.37
Total	1.61	70,024	0	0.0%	1,074	1.5%	14,952	21.4%	54281	77.5%	0	0.0%	100.4%	18.5%	0.15	0.20	0.26	0.43

\*\* Colorado Springs Drainage Manual, Chapter 6, Table 6-6.

XB = Existing Basin

XOS = Existing Off-Site Basin

EXISTING CONDITIONS

Date

4/29/2019

Sheet No.

2

of

3

Job#

1975017 Reigning Hope Indoor Arena

Subject

Existing Drainage Calculations

Time of Concentration

Rational Method

Subbasin Data			Initial / Overland, t <sub>i</sub> Time (Ti) = 0.395(1.1-C <sub>s</sub> )L <sup>1/2</sup> /(S <sup>1/3</sup> )*				Travel Time, t <sub>t</sub> (Tt) = (L)/(V*60) where (V = C <sub>v</sub> Sw <sup>1/2</sup> ) **						Urban Basins Tc Check			Final Tc (min.)	Remarks
																	Contributing Basins
Design Point	Coeff. C <sub>s</sub>	Area (Ac)	Length (ft)	Δ Elev. (ft)	Slope (ft/ft)	Ti (min.)	Length (ft)	Δ Elev. (ft)	Slope (ft/ft)	Conveyance Coefficient (C <sub>v</sub> )***	Velocity (fps)	Tt (min.)	Computed Tc (min.)	Total Length (ft)	Tc=(L/180)+10 (min.)		
POA-1	0.28	0.83	130.00	2.7	0.021	13.45	192	2.1	0.011	10	1.05	3.06	16.51	322.00	11.79	16.51	XA
POA-2	0.11	0.77	122.00	2.5	0.020	15.73	222	6.5	0.029	10	1.71	2.16	17.90	344.00	11.91	17.90	XB
-																	-
-																	-
-																	-

\*

Colorado Springs Drainage Manual, Chapter 6, Eq. 6-8

\*\*

Colorado Springs Drainage Manual, Chapter 6, Eq. 6-9  
and table 6-7 for Cv Coefficients

\*\*\*

Colorado Springs Drainage Manual, Chapter 6, Table 6-7

## EXISTING CONDITIONS

**Date** 4/29/2019    **Sheet No.** 3    of    3  
**Job#** 1975017 Reigning Hope Indoor Arena  
**Subject** Existing Drainage Calculations

### Hydrologic Analysis

Basin	Design Point	Area (ac)	Time of Concentration Tc (min)	Runoff Coefficients				Rainfall Intensity*				Peak Discharge			
				C <sub>2</sub>	C <sub>5</sub>	C <sub>10</sub>	C <sub>100</sub>	I 2-yr (in/hr)	I 5-yr (in/hr)	I 10-yr (in/hr)	I 100-yr (in/hr)	Q 2-yr (cfs)	Q 5-yr (cfs)	Q 10-yr (cfs)	Q 100-yr (cfs)
A	POA-1	0.83	16.51	0.23	0.28	0.34	0.49	2.70	3.38	3.94	5.67	0.53	0.79	1.11	2.31
B	POA-2	0.77	17.90	0.06	0.11	0.18	0.37	2.60	3.26	3.80	5.47	0.11	0.28	0.53	1.58

\* IDF Equations From Colorado Springs Drainage Manual, Chapter 6, Figure 6-5

$$I_{100} = -2.52 \ln(t_c) + 12.735$$

$$I_{50} = -2.25 \ln(t_c) + 11.375$$

$$I_{25} = -2.00 \ln(t_c) + 10.111$$

$$I_{10} = -1.75 \ln(t_c) + 8.847$$

$$I_5 = -1.50 \ln(t_c) + 7.583$$

$$I_2 = -1.19 \ln(t_c) + 6.035$$



**Appendix D**  
**Proposed Drainage Plan**

what is this line?

POA-1

SUBBASIN-A

Please verify that the location of the new building matches what is shown on the site plan. The site plan shows a 25' setback on the north. Update the drainage plan as necessary.

is this a corrugated metal pipe or concrete pipe?

SUBBASIN-B

Please provide a legend for the various line types and hatches shown. It is not clear what some of the line types are and what the hatches represent. Also some of the text is not readable. Revise accordingly.

Please verify the scale as it does not appear to be correct

POA-2

18" CMP CONCRETE CULVERT

## PROPOSED DRAINAGE PLAN

DATE: 10/10/2019  
DRAWN: J. HOFFMAN  
CHECKED: J. HOFFMAN  
SCALE: 1" = 20'

THIS DRAWING IS THE PROPERTY OF GMS, INC., AND IS NOT TO BE REPRODUCED, MODIFIED OR USED FOR ANY OTHER PROJECT OR EXTENSION OF THIS PROJECT EXCEPT BY AGREEMENT WITH THIS COMPANY.

SITE OVERVIEW  
HOFFMAN RANCH GRADING PLAN  
CRAIG HOFFMAN

GMS, INC.

CONSULTING ENGINEERS  
611 N. WEBER, SUITE 300  
COLORADO SPRINGS, COLORADO 80903

SHEET  
X  
OF  
X

**Appendix E**  
**Proposed Hydrology Results**

PROPOSED CONDITIONS

Date	4/29/2019	Sheet No.	1	of	3
Job#	1975017 Reigning Hope Indoor Arena				
Subject	Proposed Drainage Calculations				

Composite Runoff Coefficients

Land Use Or Surface Characteristics	% Imp.	Runoff Coefficients (HSG A&B)**			
		C <sub>2</sub>	C <sub>5</sub>	C <sub>10</sub>	C <sub>100</sub>
Hardscape (Asph & Conc)	100.0%	0.89	0.90	0.92	0.96
Roofs	90.0%	0.71	0.73	0.75	0.81
Gravel	80.0%	0.57	0.59	0.63	0.70
Lawns (A & B Soils, 2-7%)	0.0%	0.02	0.08	0.15	0.35
Lawns (C & D Soils, 2-7%)	0.0%	0.04	0.15	0.25	0.50

The proposed gravel area has been reduced considerably compared to the existing conditions yet more imperviousness will be added with the proposed drive and parking areas. Please revise accordingly.

Design Layout

Subbasin	Total Area (acres)	Total Area (sf)	Land Use Area per Subbasin											Weighted Imperviousness	Total Weighted Runoff Coefficients			
			Hardscaping		Roofs		Gravel		Lawns (A&B Soils)		Lawns (C&D Soils)		% Check		2-year	5-year	10-year	100-year
			Area (sf)	%	Area (sf)	%	Area (sf)	%	Area (sf)	%	Area (sf)	%						
A	0.75	32,671	0	0.0%	4,956	15.2%	2,258	6.9%	25457	77.9%	0	0.0%	100.0%	19.18%	0.16	0.21	0.27	0.44
B	0.86	37,353	0	0.0%	791	2.1%	7,261	19.4%	29301	78.4%	0	0.0%	100.0%	17.46%	0.14	0.19	0.26	0.43
Total	1.61	70,024	0	0.0%	5,747	8.2%	9,519	13.6%	54758	78.2%	0	0.0%	100.0%	18.3%	0.15	0.20	0.26	0.44

\*\* Colorado Springs Drainage Manual, Chapter 6, Table 6-6.

XB = Existing Basin

XOS = Existing Off-Site Basin

The letter of intent indicates a paved driveway. Please account for this in your design. Comments have been made on the site plan to identify the surface material of the drive and parking areas.



PROPOSED CONDITIONS

Date 4/29/2019 Sheet No. 2 of 3  
Job# 1975017 Reigning Hope Indoor Arena  
Subject Proposed Drainage Calculations

Time of Concentration  
Rational Method

Subbasin Data			Initial / Overland, $t_i$ Time (Ti) = $0.395(1.1-C_s)L^{1/2}/(S^{1/3})^*$				Travel Time, $t_t$ (Tt) = $(L)/(V*60)$ where $(V = C_vSw^{1/2})^{**}$						Urban Basins Tc Check			Final Tc (min.)	Remarks
																	Contributing Basins
Design Point	Coeff. $C_s$	Area (Ac)	Length (ft)	$\Delta$ Elev. (ft)	Slope (ft/ft)	Ti (min.)	Length (ft)	$\Delta$ Elev. (ft)	Slope (ft/ft)	Conveyance Coefficient ( $C_v$ )***	Velocity (fps)	Tt (min.)	Computed Tc (min.)	Total Length (ft)	Tc=(L/180)+10 (min.)		
POA-1	0.21	0.75	29.00	0.217	0.007	9.64	260	1.33	0.005	10	0.72	6.06	15.70	289.00	11.61	15.70	XA
POA-2	0.19	0.86	67.00	0.81	0.012	12.78	392	6.5	0.017	10	1.29	5.07	17.85	459.00	12.55	17.85	XB
-																	-
-																	-
-																	-

\* Colorado Springs Drainage Manual, Chapter 6, Eq. 6-8  
\*\* Colorado Springs Drainage Manual, Chapter 6, Eq. 6-9 and table 6-7 for Cv Coefficients  
\*\*\* Colorado Springs Drainage Manual, Chapter 6, Table 6-7

**PROPOSED CONDITIONS**

**Date** 4/29/2019    **Sheet No.** 3    of    3

**Job#** 1975017 Reigning Hope Indoor Arena

**Subject** Proposed Drainage Calculations

**Hydrologic Analysis**

Basin	Design Point	Area (ac)	Time of Concentration Tc (min)	Runoff Coefficients				Rainfall Intensity*				Peak Discharge			
				C <sub>2</sub>	C <sub>5</sub>	C <sub>10</sub>	C <sub>100</sub>	I 2-yr (in/hr)	I 5-yr (in/hr)	I 10-yr (in/hr)	I 100-yr (in/hr)	Q 2-yr (cfs)	Q 5-yr (cfs)	Q 10-yr (cfs)	Q 100-yr (cfs)
A	POA-1	0.75	15.70	0.16	0.21	0.27	0.44	2.76	3.45	4.03	5.80	0.34	0.55	0.83	1.93
B	POA-2	0.86	17.85	0.14	0.19	0.26	0.43	2.61	3.26	3.80	5.47	0.32	0.54	0.83	2.01

\* IDF Equations From Colorado Springs Drainage Manual, Chapter 6, Figure 6-5

$$I_{100} = -2.52 \ln(t_c) + 12.735$$

$$I_{50} = -2.25 \ln(t_c) + 11.375$$

$$I_{25} = -2.00 \ln(t_c) + 10.111$$

$$I_{10} = -1.75 \ln(t_c) + 8.847$$

$$I_5 = -1.50 \ln(t_c) + 7.583$$


$$I_2 = -1.19 \ln(t_c) + 6.035$$

**Appendix F**  
**Culvert Calculations**

## CIRCULAR CONDUIT FLOW (Normal & Critical Depth Computation)

Project: Blue cells are for user data entry

Pipe ID: Green cells are calculated values

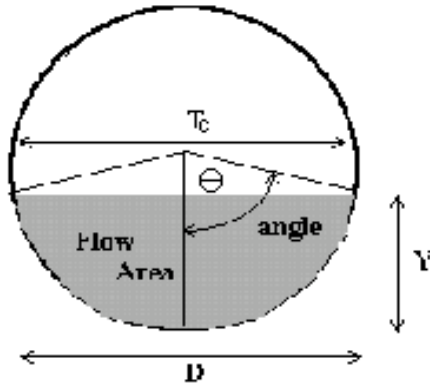

### Design Information (Input)

Pipe Invert Slope	$S_o =$	0.0520	ft/ft
Pipe Manning's n-value	$n =$	0.0120	
Pipe Diameter	$D =$	18.00	inches
Design discharge	$Q =$	1.84	cfs

### Full-flow Capacity (Calculated)

Full-flow area	$A_f =$	1.77	sq ft
Full-flow wetted perimeter	$P_f =$	4.71	ft
Half Central Angle	$\Theta =$	3.14	radians
Full-flow capacity	$Q_f =$	26.02	cfs

### Calculation of Normal Flow Condition

Half Central Angle ( $0 < \Theta < 3.14$ )	$\Theta =$	0.88	radians
Flow area	$A_n =$	0.22	sq ft
Top width	$T_n =$	1.15	ft
Wetted perimeter	$P_n =$	1.31	ft
Flow depth	$Y_n =$	0.27	ft
Flow velocity	$V_n =$	8.50	fps
Discharge	$Q_n =$	1.84	cfs
Percent Full Flow	$\text{Flow} =$	7.1%	of full flow
Normal Depth Froude Number	$Fr_n =$	3.46	supercritical

### Calculation of Critical Flow Condition

Half Central Angle ( $0 < \Theta_c < 3.14$ )	$\Theta_c =$	1.25	radians
Critical flow area	$A_c =$	0.53	sq ft
Critical top width	$T_c =$	1.42	ft
Critical flow depth	$Y_c =$	0.51	ft
Critical flow velocity	$V_c =$	3.47	fps
Critical Depth Froude Number	$Fr_c =$	1.00	