






1620 ELEVATION (E MODERN) AVERAGE FINISH GRADE = (AFG) AFG = (90.6+90.6+89.7+89.1)(4) = 90.0 BUILDING HEIGHT = 16.4+ (TF - AFG) = BUILDING HEIGHT = 16.4+ (91.3-90.0) = 17.7



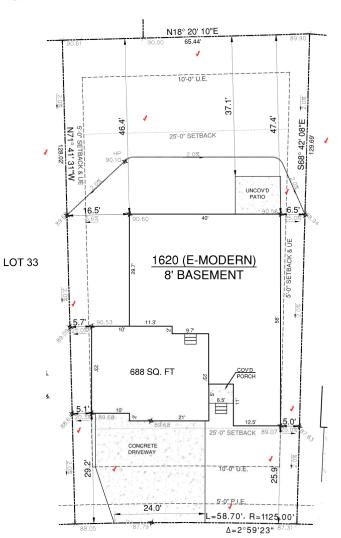

LOT 35



PENNYCRESS DRIVE

			SCALE: 1"=20'	
SITE & GRADING PLAN			ELEVATIONS TABLE	
LEGEND: SWALE:		DUE	TOP OF FOUNDATION	91.27
PROPERTY LINE:	SETBACK: FRONT - 25' SIDE - 5' REAR - 25' CORNER SIDE - 15'	P.U.E: FRONT - 10' FRONT P.I.E 5' SIDE - 5' REAR - 10'	MAX FINISHED GRADE ELEV @ FOUNDATION WALL	90.60
DRAINAGE DIRECTION: ELECTRIC PEDESTAL:			MAIN FLOOR FINISHED FLOOR	92.45
RISER			DRIVEWAY SLOPE	7.0%
SITE DATA	HOUSE AND DRIVEWAY COVERAGE		FRONT GARAGE FLOOR	89.68
TAX SCHEDULE #: 55223-16-009 ZONING PUD	LOT SQ. FT: 7979 HOUSE SQ. FT: 2341	SETBACK SQ. FT.: 1465 DRIVE SQ. FT.: 630	GARAGE FLOOR AT ENTRY DOOR	90.14
BUILDING HEIGHT: 17.7'	COVERAGE: 29%	COVERAGE: 43%	GRADE BEAM ELEVATION	89.18
ASPEN WIEW HOMES ASPEN VIEW HOMES ASPEN VIEW HOMES 555 MIDDLE CREEK PKWY STE 380 COLORADO SPRINGS, CO 719-659-0859	LEGAL DESCRIPTION LOT 34 THE GLEN AT WILDFIELD FILING NO. 11 9827 PENNYCRESS DRIVE COLORADO SPRINGS, COLORADO EL PASO COUNTY PLAN-ELEV: 1620 (E-MODERN)		York Engineering 7208 S. TUCSON WAY #195 CENTENNIAL, CO 80112 720-990-5900	

SITE



2023 PPRBC

Parcel: 5522316009

2021 IECC Amended

Address: 9827 PENNYCRESS DR, COLORADO SPRINGS

Received: 14-May-2024 (BRENT)

Description:

Required PPRBD Departments (2)

RESIDENCE

Type of Unit:

Lower Level 2	Garage
2330	488

Main Level

4438 1620

Total Square Feet

Enumeration

APPROVED

BRENT

5/14/2024 2:16:49 PM

Floodplain

(N/A) RBD GIS

Required Outside Departments (1)

County Zoning

APPROVED

Plan Review

05/16/2024 2:39:57 PM *Isdarchuleta*

EPC Planning & Community Development Department

Release of this plan does not preclude compliance with all applicable codes, ordinances and other pertinent regulations. This plan set must be present on the job site for every inspection.