

19 E. Willamette Ave. Colorado Springs, CO 80903 (719)-477-9429 www.jpsengr.com

November 30, 2020

El Paso County Planning and Community Development Department 2880 International Circle Colorado Springs, CO 80910

**SUBJECT:** Settlers View Subdivision

**Detention Basin Certification Letter** 


## Ladies and Gentlemen:

Drainage improvements for this project include one on-site private Detention Basin. Based upon information gathered from periodic site visits to the project, JPS Engineering, Inc. is of the opinion that the Detention Basin has been constructed in general compliance with the approved design plans as filed with El Paso County. The As-Built drawings accurately depict the final installation of the Detention Basin improvements and verify the detention volume provided.

Sincerely, **JPS Engineering, Inc.** 

John P. Schwab, P.E. Colorado P.E. No. 29891




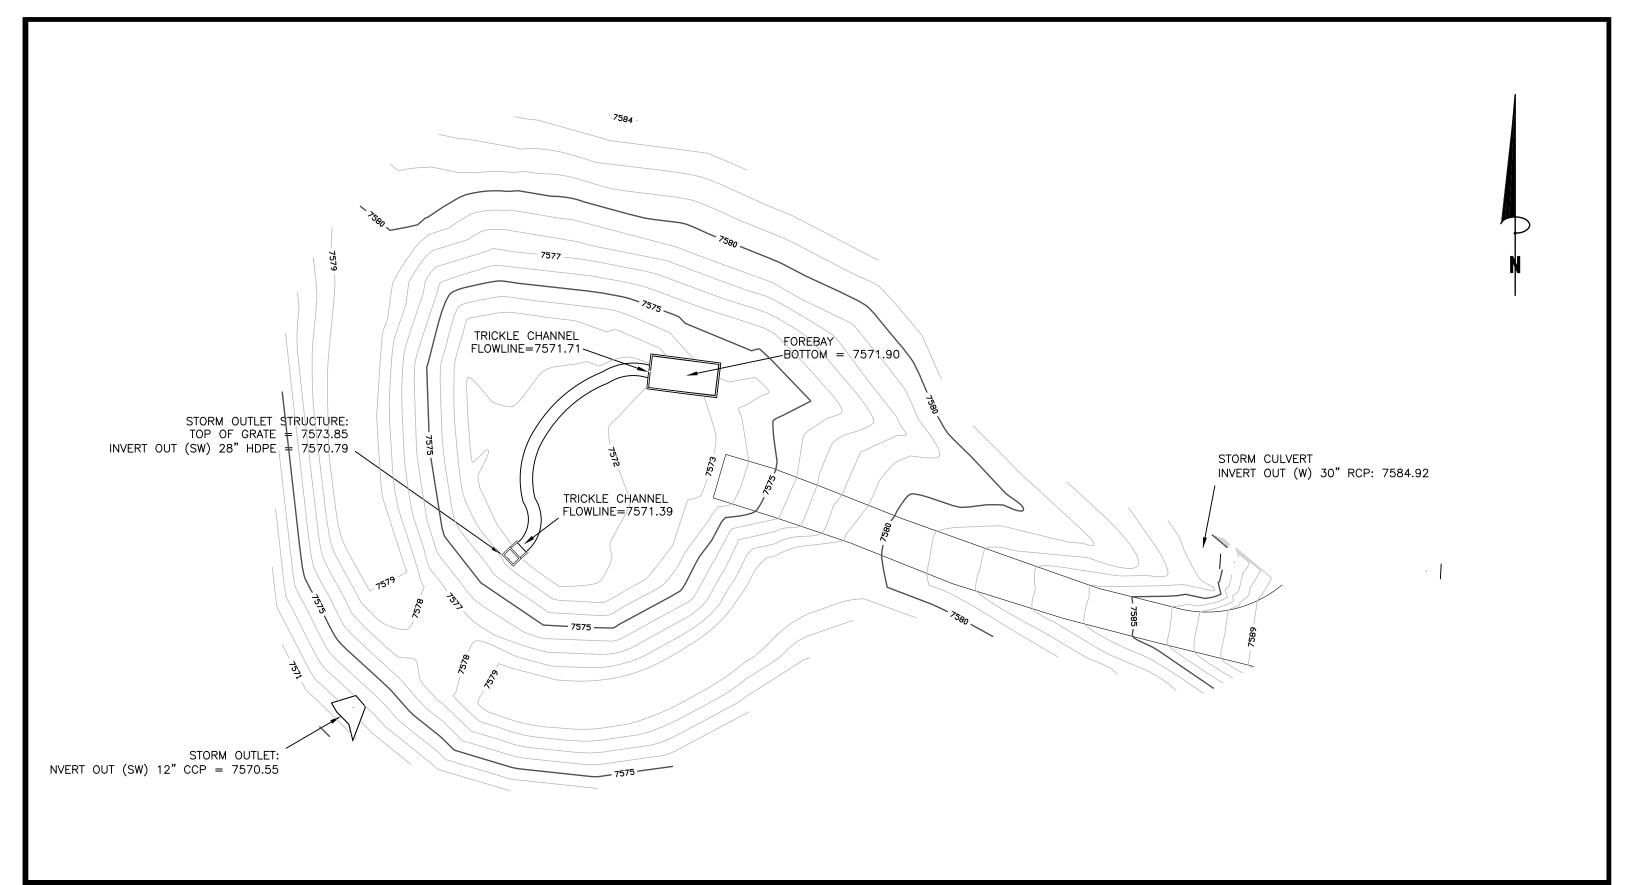



COMPASS SURVEYING & MAPPING, LLC 721 SOUTH 23RD STREET, SUITE B COLORADO SPRINGS, CO 80904 719-354-4120 WWW.CSAMLLC.COM

Detention Pond
As Constructed
2,936 Cubic Yards

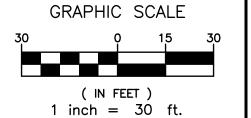

PROJECT No. 19078 NOVEMBER 23, 2020 SHEET 1 OF 1