


SEEGER HOMES INC. - SALES OFFICE

SITE DEVELOPMENT PLANS LOT 3, APPALOOSA HIGHWAY 24 SUBDIVISION

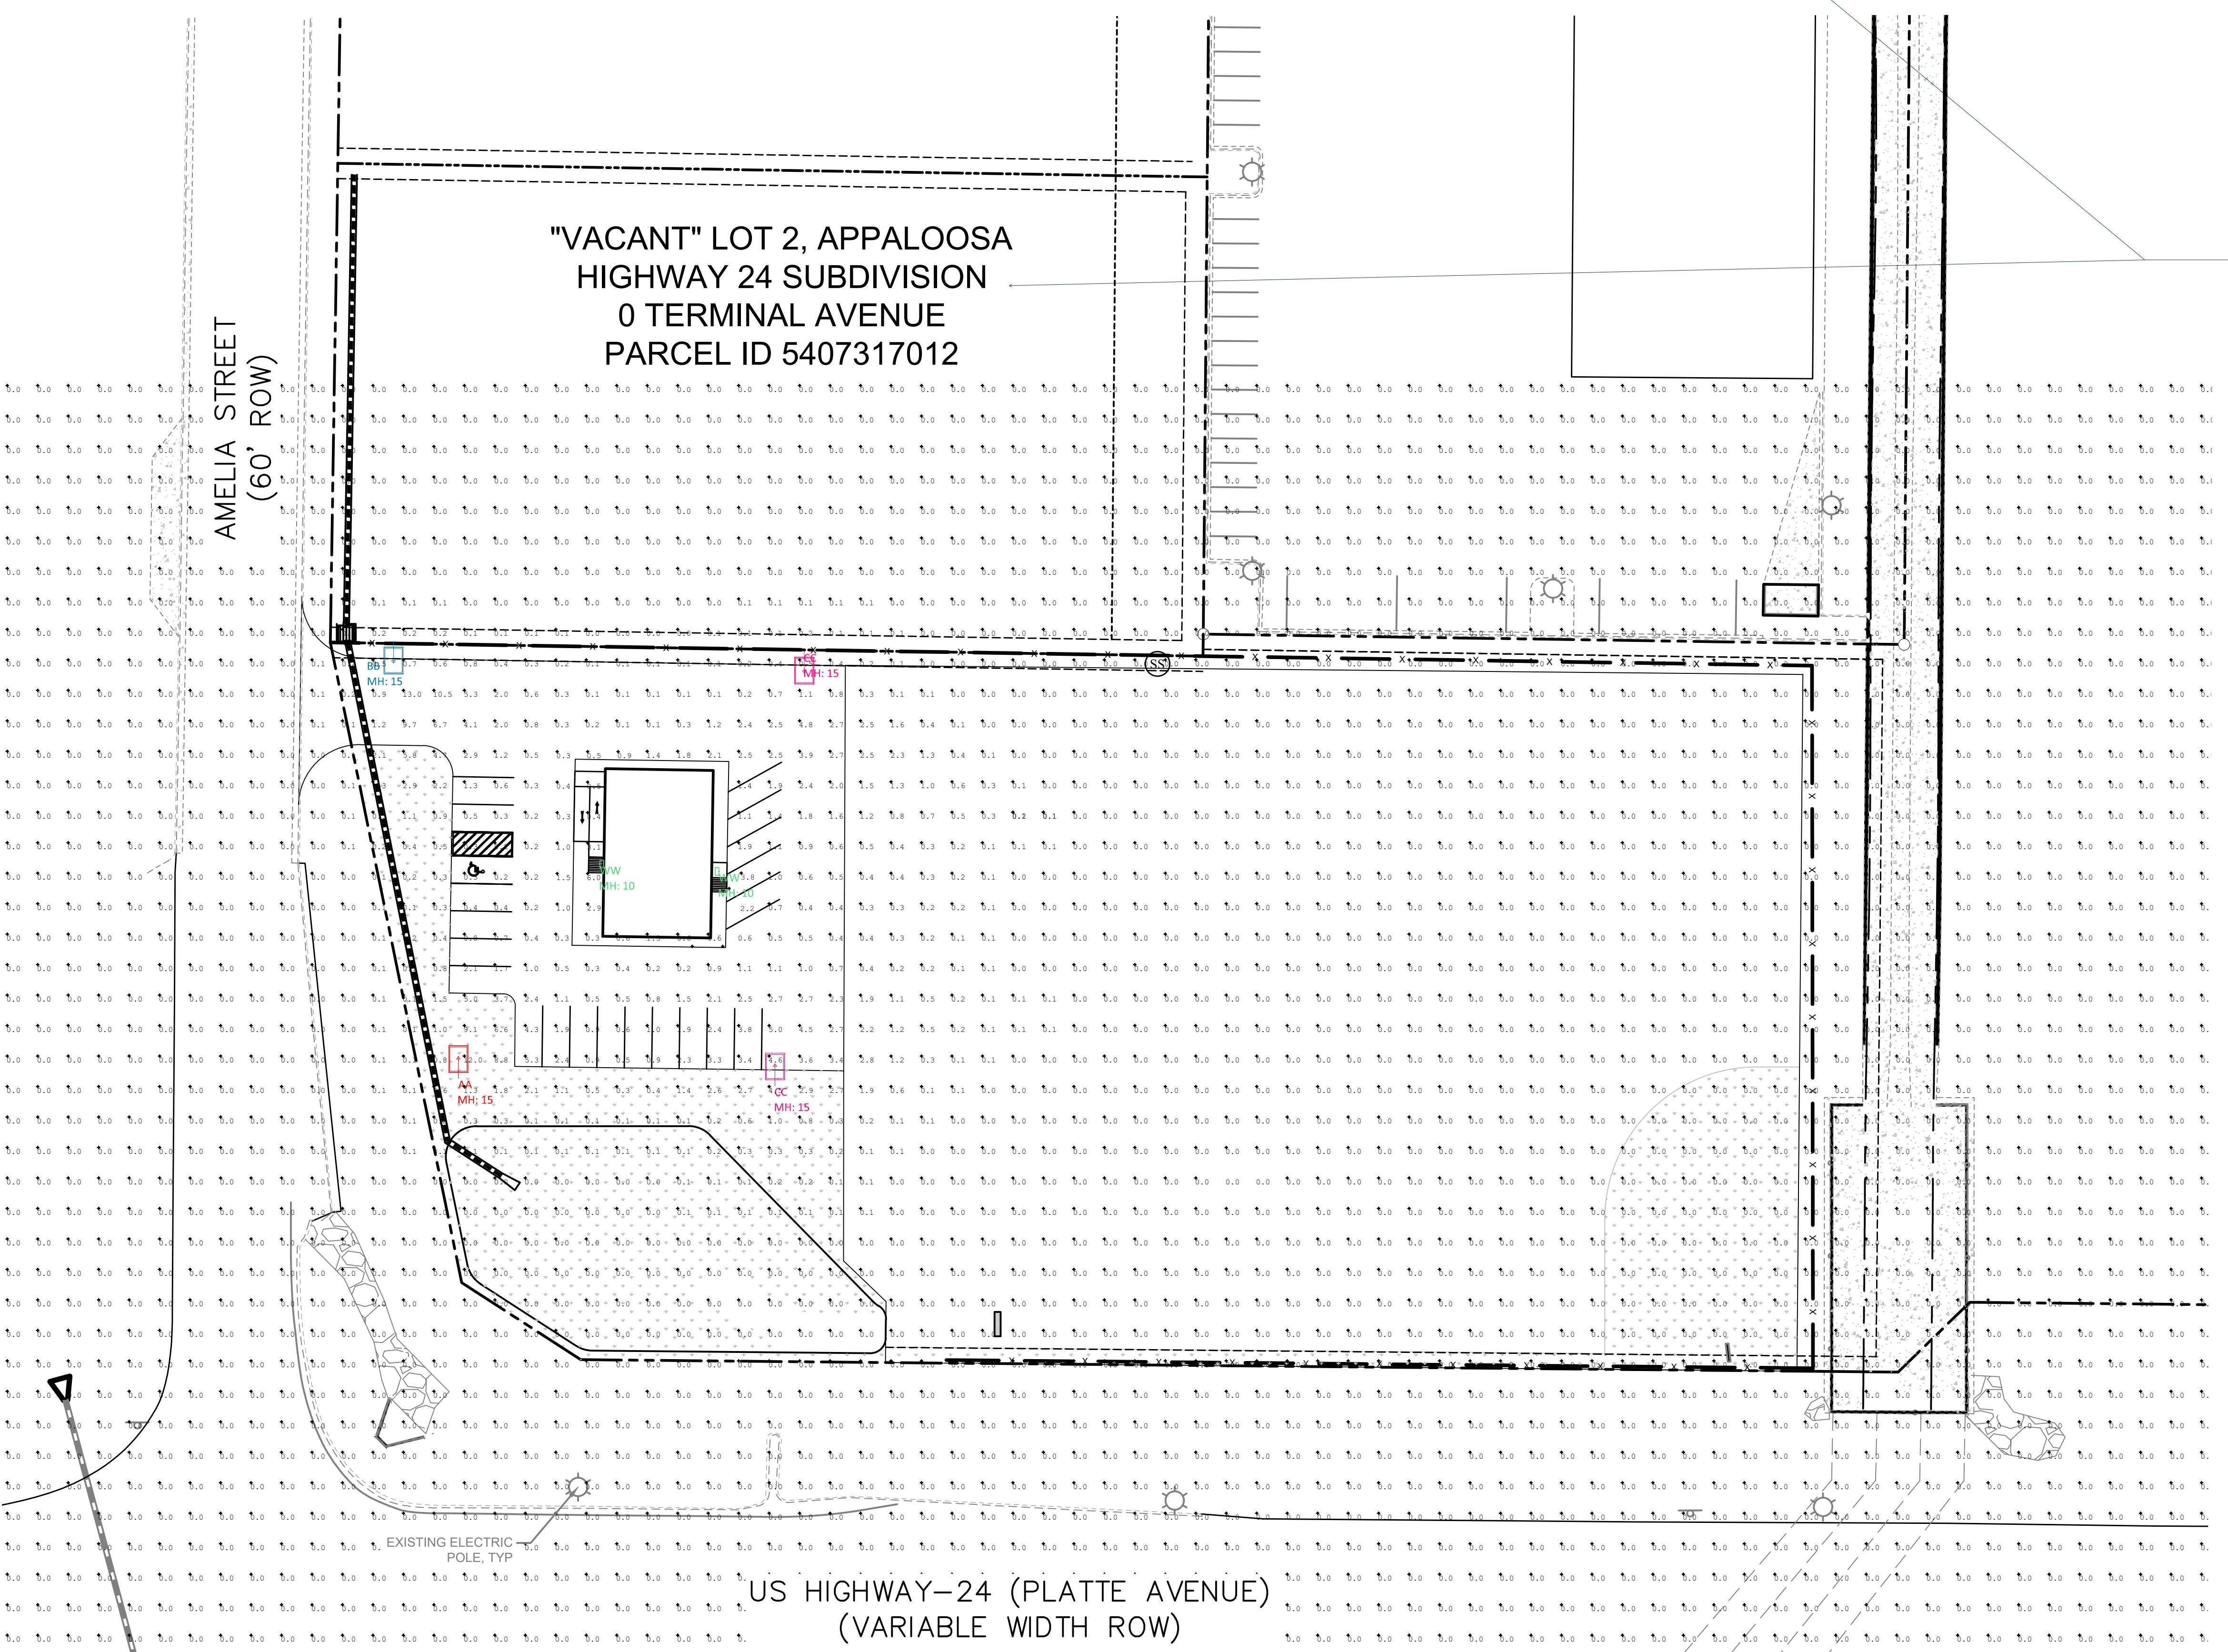

Calculation Summary						
Label	Units	Avg	Max	Min	Avg/Min	Max/Min
Site	Fc	0.15	6.7	0.0	N.A.	N.A.
Gravel Surface	Fc	0.17	6.7	0.0	N.A.	N.A.
Parking and Drive	Fc	1.39	6.1	0.3	4.63	20.33


Luminaire Schedule							
Symbol	Qty	Label	Lum. Watts	Lum. Lumens	LLF	Description	Pole/Mounting Height
■	1	AA	113	10703	0.900	GLEON-AF-02-LED-E1-SLR	15 Feet
□	1	BB	113	10703	0.900	GLEON-AF-02-LED-E1-SLL	15 Feet
■	2	CC	113	12094	0.900	GLEON-AF-02-LED-E1-T4W	15 Feet
□	2	WW	18.2	2103	0.900	XTOR2B-W	10 Feet

GRAPHIC SCALE
0' 15' 30' 60' 90'
Scale: 1"=30'

SALES OFFICE - SPECIAL USE	OWNER	PROJECT NO. _____
	SEEGER HOMES	DRAWN _____
		DESIGNED _____
		APPROVED _____
		QC'd _____
FORSGREN Associates Inc.		
56 Inverness Drive East, Suite 112, Englewood, CO 80112		
PH: 720.214.5884 FAX: 720.000.0000		
LIGHTING PLAN		
SHEET NO: LP-01		
DATE: 09/28/18		
PAGE NO: 1 OF 1		

Lighting Plan_v4-redline.pdf Markup Summary

dsdkendall (1)

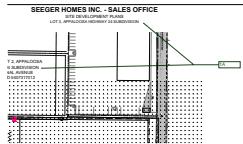

Subject: Callout
Page Label: [1] C-01
Lock: Unlocked
Author: dsdkendall
Date: 7/18/2019 9:27:49 AM
Status:
Color: 
Layer:
Space:

1A