

The map displays the proposed site location in Woodmen Hills, St. Louis. The site is marked with a hatched rectangle at the intersection of E Woodmen Rd and McLaughlin Rd. A black arrow points from the word "SITE" to this location. The map shows the following streets and landmarks:

- Major Roads:** I-24 (orange line), E Woodmen Rd, McLaughlin Rd, Meridian Rd, N Condor Rd.
- Local Streets:** Falcon Meadows Blvd, Rolling Thunder Way, Antelope Meadows Cir, Bridle Path Way, Birch Hollow Way, Hedgecroft Cir, Chief Rd, Rig Rd, W Condor, Sunset Trl, Sunny Slope Rd, Buckboard Dr, Carriage Dr, Blue Gill Dr, Naylor Dr, Sissy Way, Frost Dr, Meadow Lake Airport.
- Landmarks:** Woodmen Hills Dr, Meadow Lake Airport.
- Other Features:** A north arrow in the bottom right corner.

APPLICANT/DEVELOPER
KING SOOPERS INC.
65 TEJON STREET
DENVER, COLORADO 80223
TEL: (303) 778-3123
CONTACT: LOWELL GOOD

GALLOWAY & COMPANY, INC.
6162 SOUTH WILLOW DRIVE, SUITE 320
GREENWOOD VILLAGE, COLORADO 80111
TEL: (303) 770-8884
FAX: (303) 770-3636
CONTACT: JENNY ROMANO, P.E.
EMAIL: JennyRomano@gallowayus.com

CR ARCHITECTURE & DESIGN
600 VINE STREET, SUITE 2210
CINCINNATI, OHIO 45202
TEL: (513) 721-8080
CONTACT: ANTHONY FREY, AIA
EMAIL: a.frey@cr-architects.com

GALLOWAY & COMPANY, INC.
6162 SOUTH WILLOW DRIVE, SUITE 320
GREENWOOD VILLAGE, COLORADO 80111
TEL: (303) 770-8884
FAX: (303) 770-3636
CONTACT: TIM NELSON
EMAIL: TimNelson@gallowayus.com

CLARK SURVEYING
119 N. WAHSATCH AVE.
COLORADO SPRINGS, CO 80903
TEL: (719) 633-8533
CONTACT: CAMERON FORTH

2880 INTERNATIONAL CIRCLE
COLORADO SPRINGS, CO 80910
TEL: (719) 520-6306
CONTACT: KARI PARSONS
EMAIL: kari@parsonselpasoco.com

** CART CORRALS NOT INCLUDED AS A PARKING SPACE

SHEET NO.	TITLE
C0.0	COVER SHEET
C1.0	SITE PLAN
C1.1	SITE DETAILS
C1.2	SITE DETAILS
-	PHOTOMETRIC PLAN (BY EATON)
C5.1	PHOTOMETRIC DETAILS
L1.0	SITE LANDSCAPE PLAN
L1.1 – L1.5	LANDSCAPE PLAN
L1.6	LANDSCAPE DETAILS & NOTES
A1.1	ARCHITECTURAL ELEVATIONS
A1.2	CANOPY ELEVATIONS

CURRENT ZONING: CR

1. SURVEY INFORMATION AND TOPOGRAPHIC CONTOURS WERE PROVIDED BY OTHERS. GALLOWAY & COMPANY INC. CANNOT BE HELD LIABLE FOR ANY INACCURACY IN THE SURVEY INFORMATION.
2. EL PASO COUNTY SHALL NOT BE LIABLE FOR THE MAINTENANCE OF PRIVATE IMPROVEMENTS AS SHOWN ON THESE PLANS.
3. APPROVED BASE FLOOD ELEVATIONS (BFEs) WILL BE ESTABLISHED THROUGH THE LOMR PROCESS.

LOTS 2 AND 3, BLOCK 1 OF FALCON MARKETPLACE SUBDIVISION, A PORTION OF SECTION 1,
TOWNSHIP 13 SOUTH, RANGE 65 WEST OF THE 6TH P.M., EL PASO COUNTY, COLORADO.

THESE DETAILED PLANS AND SPECIFICATIONS WERE PREPARED UNDER MY DIRECTION AND SUPERVISION. SAID PLANS AND SPECIFICATIONS HAVE BEEN PREPARED ACCORDING TO THE CRITERIA ESTABLISHED BY THE COUNTY FOR DETAILED ROADWAY, DRAINAGE, GRADING AND EROSION CONTROL PLANS AND SPECIFICATIONS, AND SAID PLANS AND SPECIFICATIONS ARE IN CONFORMITY WITH APPLICABLE MASTER DRAINAGE PLANS AND MASTER TRANSPORTATION PLANS. SAID PLANS AND SPECIFICATIONS MEET THE PURPOSES FOR WHICH THE PARTICULAR ROADWAY AND DRAINAGE FACILITIES ARE DESIGNED AND ARE CORRECT TO THE BEST OF MY KNOWLEDGE AND BELIEF. I ACCEPT RESPONSIBILITY FOR ANY LIABILITY CAUSED BY ANY NEGLIGENT ACTS, ERRORS OR OMISSIONS ON MY PART IN PREPARATION OF THESE DETAILED PLANS AND SPECIFICATIONS.

JENNIFER ROMANO, P.E. #44401 DATE

I, THE OWNER/DEVELOPER HAVE READ AND WILL COMPLY WITH ALL OF THE REQUIREMENTS SPECIFIED IN THESE DETAILED PLANS AND SPECIFICATIONS.

DETAILED PLANS AND SPECIFICATIONS.

DILLON REAL ESTATE CO., INC. A KANSAS CORPORATION

DILLON REAL ESTATE CO., INC, A KANSAS CORPORATION

6162 S. Willow Drive, Suite 320
Greenwood Village, CO 80111
303.770.8884
GallowayUS.com

THESE PLANS ARE AN INSTRUMENT OF SERVICE AND ARE THE PROPERTY OF GALLOWAY, AND MAY NOT BE DUPLICATED, DISCLOSED, OR REPRODUCED WITHOUT THE WRITTEN CONSENT OF GALLOWAY. COPYRIGHTS AND INFRINGEMENTS WILL BE ENFORCED AND PROSECUTED.



KING SOOPERS #1147
FALCON MARKETPLACE
LOTS 2 & 3, BLOCK 1

7530 & 7595 FALCON MARKET PL.
FALCON, CO

[illegible]

Project No:	KSS00014
Drawn By:	AC
Checked By:	JR
Date:	8/29/1

COVER SHEET

CO.0

THESE PLANS ARE AN INSTRUMENT OF SERVICE AND ARE THE PROPERTY OF GALLOWAY, AND MAY NOT BE DUPLICATED, DISCLOSED, OR REPRODUCED WITHOUT THE WRITTEN CONSENT OF GALLOWAY. COPYRIGHTS AND INFRINGEMENTS WILL BE ENFORCED AND PROSECUTED.


King Soopers
Supermarket / Petroleum
55 Tejon Street
Denver, CO 80223
Phone (303) 778-3053
Fax (303) 871-9262

KING SOOPERS #147
FALCON MARKETPLACE
LOTS 2 & 3, BLOCK 1



7530 & 7595 FALCON MARKET PL.
FALCON, CO

Project No:	KSS000147
Drawn By:	ACJ
Checked By:	JRR
Date:	8/29/19

C1.0

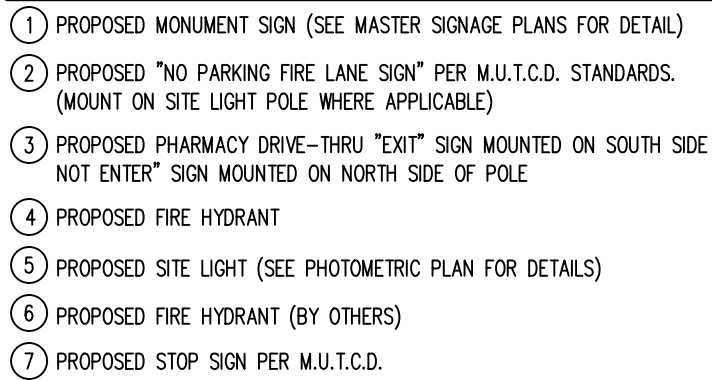

1. ALL PERMANENT STRIPING ON ASPHALT TO BE THERMOPLASTIC.
2. ALL STRIPING ON CONCRETE TO BE EPOXY FOR LANE LINES, TAPE 380I-5 FOR SKIP DASH, PREFORMED COLD PLASTIC SYMBOLS, LEGEND AND CROSSWALKS.
3. ALL PAVEMENT MARKINGS AND SIGNS ON PRIVATE ROADWAYS SHOULD CONFORM TO THE MANUAL OF UNIFORM TRAFFIC DESIGN.
4. ON-SITE PAVEMENT MARKINGS AND ARROWS WILL NOT BE MAINTAINED BY EL PASO COUNTY.
5. APPROVED BASE FLOOD ELEVATIONS (BFES) WILL BE ESTABLISHED THROUGH THE LOWR PROCESS.

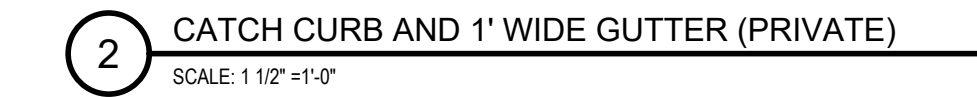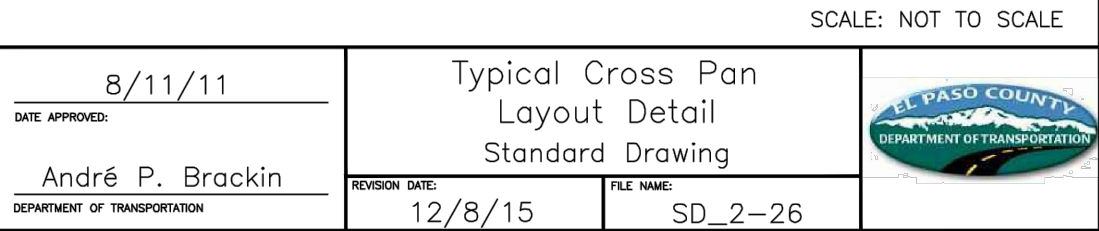

603 Series Cart Corral


Cart Corrals ensure the safety and simplicity of gathering your carts while decreasing damage to customers' vehicles from stray carts. Strategically place our corrals throughout your parking lot to reduce the labor costs of cart retrieval and enhance the shopping experience of your customers.



8030160 Shown

- FEATURES**
- Heavy gauge flow coat galvanized mechanical steel tubing provides superior durability
- Interior corrosion resistant coating
- Hot dipped, galvanized bar base plates
- 18-gauge galvanized steel signs with durable powder coated finish and silk screen printing
- Easily assembled and can be anchored for maximum stability
- OPTIONS**
- Siderail Length: 10 ft, 14 ft
- Single Entry or Double Entry
- Standard Sign Size/Style: 2448/1424, 2448/0597B (custom signage available)
- Anchors
- Powder coat finish available (Inquire with your sales representative)

Optional Anchor

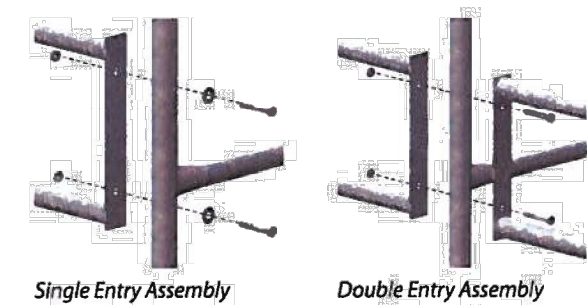

Single Entry Assembly

Double Entry Assembly




NE NATIONAL CART CO PH: 800-455-3802 FAX: 636-723-4477 www.nationalcart.com

NE NATIONAL CART CO PH: 800-455-3802 FAX: 636-723-4477 www.nationalcart.com

1 CART CORRAL DETAIL


NOT TO SCALE

8030160 Shown

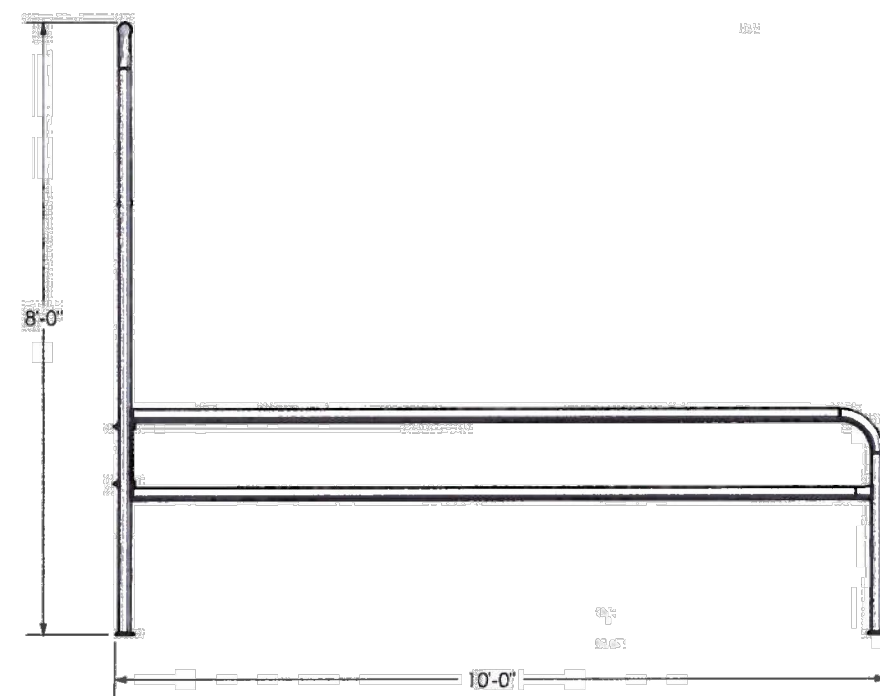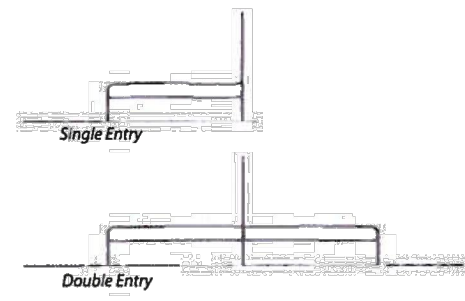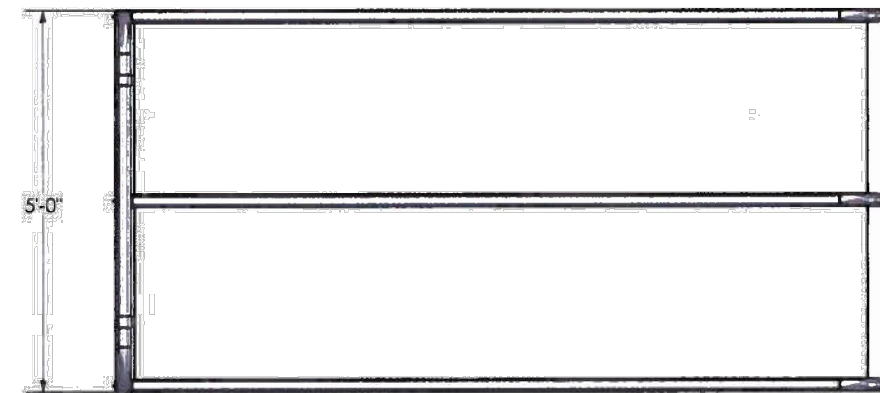

Order #	Model #	W	L	H	Entry	Ship Wt	List Price
8030160	CC-603-10	5'	10'	8'	Single	246#	\$627.00
8030161	CC-603-14	5'	14'	8'	Single	298#	\$718.00
8030163	CC-603-20	5'	20'	8'	Double	407#	\$940.00
8030164	CC-603-28	5'	28'	8'	Double	512#	\$1,111.00
B000108	5" Lag Bolt	-	-	-	-	-	\$9.00

NE NATIONAL CART CO PH: 800-455-3802 FAX: 636-723-4477 www.nationalcart.com

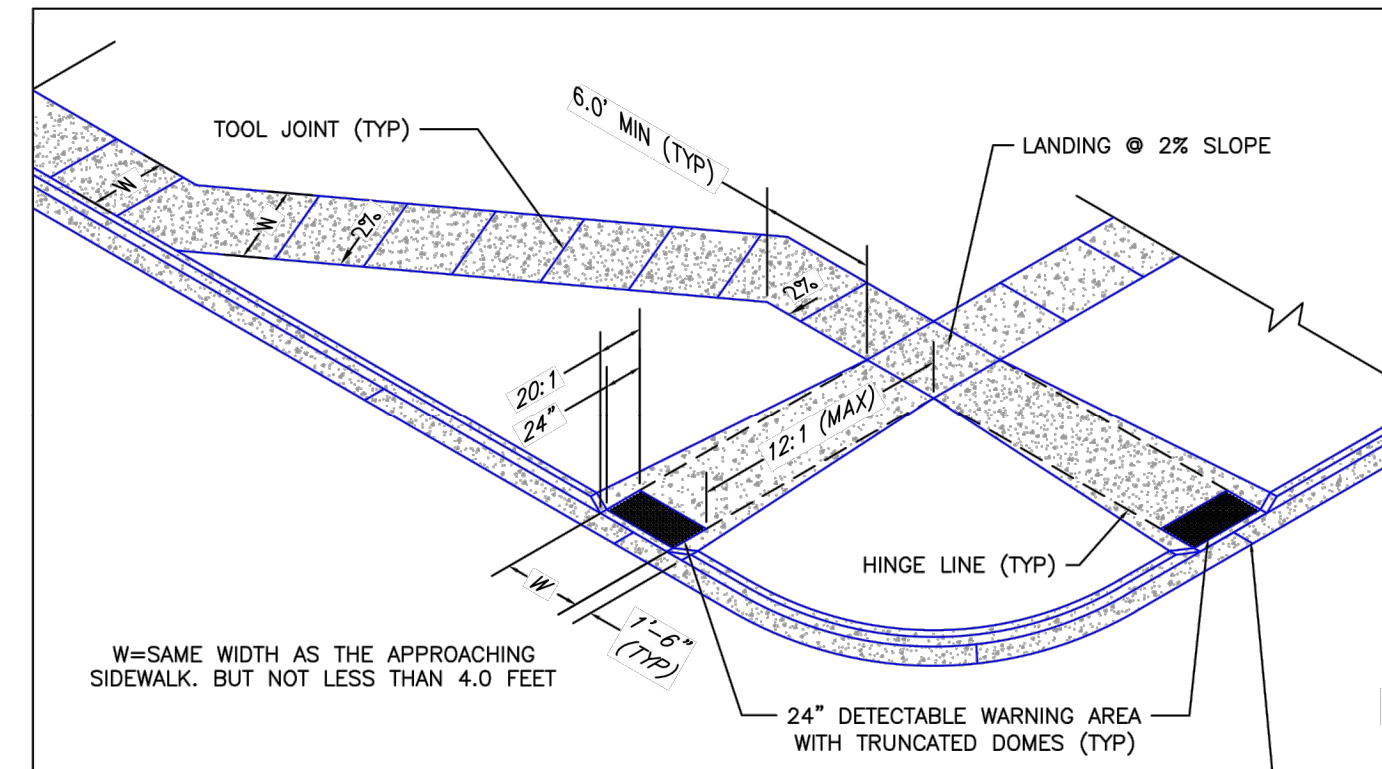

PEDESTRIAN RAMP NOTES

- ALL WORK SHALL BE DONE IN ACCORDANCE WITH THE CURRENT ENGINEERING CRITERIA MANUAL AND ADA REQUIREMENTS.
- CONTRACTOR TO NOTIFY ENGINEERING DIVISION INSPECTION STAFF 48 HOURS PRIOR TO CONCRETE PLACEMENT.
- PEDESTRIAN RAMP CONSTRUCTION SHALL BE A MINIMUM 4,500 PSI CONCRETE, MINIMUM 4" THICK, NON-COLORED, NON-SCORED, COARSE BROOM FINISH.
- RAMP LOCATION AND LENGTH MAY REQUIRE MODIFICATION TO MAINTAIN THE 12:1 MAXIMUM RUNNING RAMP SLOPE AND 20:1 DETECTABLE WARNING AREA DUE TO STREET INTERSECTION GRADES AND/OR ALIGNMENTS.
- DETECTABLE WARNING AREA SHALL START A MINIMUM OF 6" BUT NOT MORE THAN 8" FROM THE FLOWLINE OF THE CURB AT ANY POINT.
- DETECTABLE WARNING AREA SHALL BE PREFABRICATED, REDDISH INTEGRALLY COLORED, TRUNCATED-DOME, PAVERS. THERMOPLASTIC TRUNCATED DOMES WILL NOT BE ACCEPTED.
- THE DETECTABLE WARNING AREA SHALL BE 24" IN LENGTH AND THE FULL WIDTH OF THE RAMP.
- RAMP WIDTH REQUIRED IS SAME AS APPROACHING SIDEWALK; 4' MINIMUM.
- ALL RAMP SHALL BE PERPENDICULAR TO TRAFFIC WITH THE EXCEPTION OF MID-BLOCK OR TERMINAL RAMP WHICH MAY BE PARALLEL. SUBJECT TO APPROVAL.
- AVOID PLACING ORANGE STRUCTURES, TRAFFIC SIGNAL/SIGNAGE, UTILITIES/JUNCTION BOXES, OR OTHER OBSTRUCTIONS WITHIN PROPOSED RAMP AREAS.

GENERAL NOTES


- WHERE THE 1'-6" FLARED SIDES OF A PERPENDICULAR CURB RAMP IS (ARE) CONTIGUOUS WITH A PEDESTRIAN OR HARD SURFACE AREA, THE MAXIMUM FLARE SLOPE SHALL NOT EXCEED 10:1.
- PEDESTRIAN WALKWAY AND/OR LOCATION OF EXISTING OR FUTURE PEDESTRIAN RAMPS ON OPPOSITE CORNERS SHALL BE REVIEWED BEFORE CONSTRUCTING NEW RAMPS.
- AT MARKED PEDESTRIAN CROSSINGS, THE BOTTOM OF THE RAMPS, EXCLUSIVE OF THE FLARE SIDES, SHALL BE TOTALLY CONTAINED WITHIN THE MARKINGS.

LAYOUT CURB SECTIONS SO THAT AT LEAST ONE TOOL JOINT IS WITHIN RAMP THROAT

7/9/09	Pedestrian Intersection Ramp	
DATE APPROVED:	Standard Drawing	
André P. Brackin DEPARTMENT OF TRANSPORTATION	REVISION DATE: 12/8/15 FILE NAME: SD_2-41	

2 ADA RAMP DETAIL

NOT TO SCALE

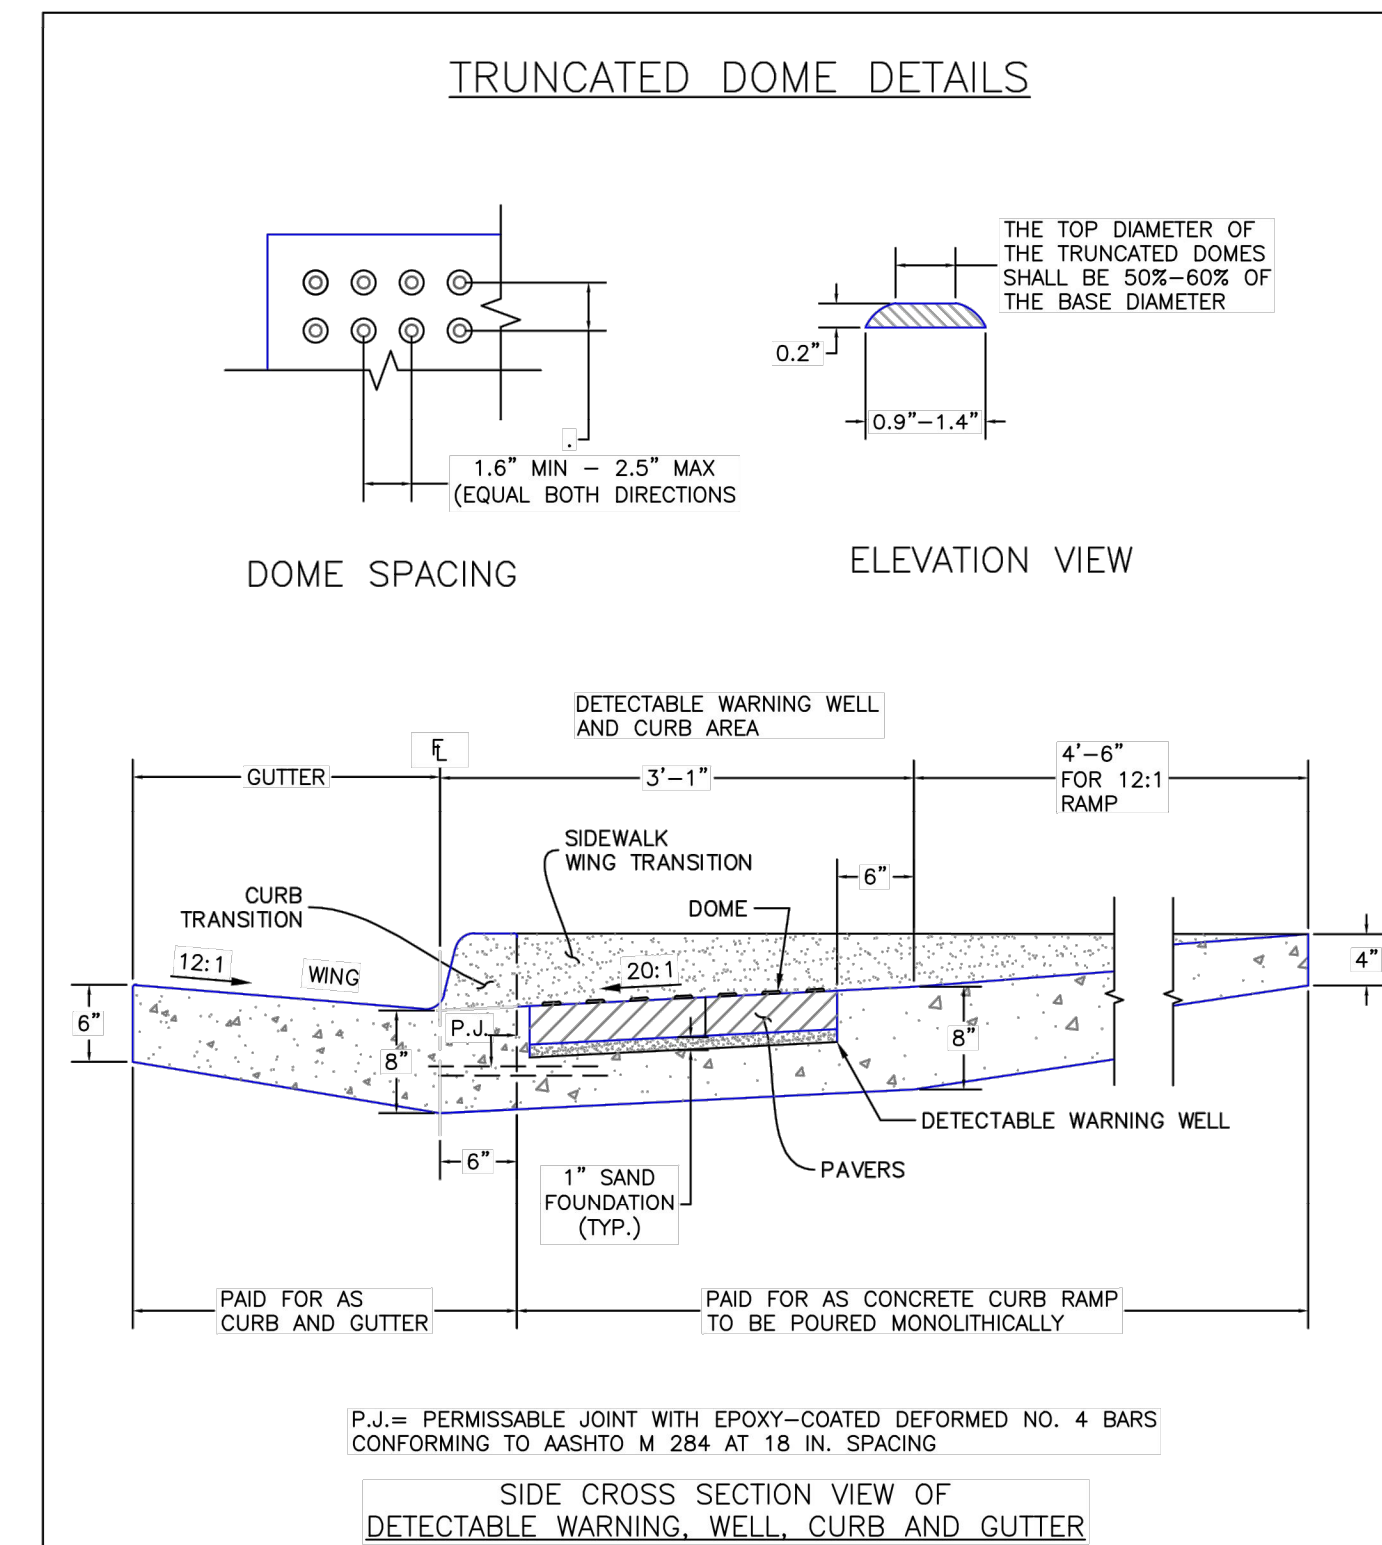

1/1/08	Truncated Dome Details	
DATE APPROVED:	Standard Drawing	
John A. McCarty DEPARTMENT OF TRANSPORTATION	REVISION DATE: 11/25/15 FILE NAME: SD_2-42	

3 TRUNCATED DOME DETAIL

NOT TO SCALE

Galloway

6162 S. Willow Drive, Suite 320
Greenwood Village, CO 80111
303.770.8884
GallowayUS.com

COPYRIGHT

THESE PLANS ARE AN INSTRUMENT OF SERVICE AND ARE THE PROPERTY OF GALLOWAY, AND MAY NOT BE DUPLICATED, DISCLOSED, OR REPRODUCED WITHOUT THE WRITTEN CONSENT OF GALLOWAY. COPYRIGHTS AND INFRINGEMENTS WILL BE ENFORCED AND PROSECUTED.



King Soopers
Supermarket / Petroleum
65 Tejon Street
Denver, CO 80223
Phone (303) 778-3053
Fax (303) 871-9262

KING SOOPERS #147
FALCON MARKETPLACE
LOTS 2 & 3, BLOCK 1
7530 & 7595 FALCON MARKET PL.
FALCON, CO

#	Date	Issue / Description	Init.
1	12/16/19	2ND SDF Sub.	ACJ
2	03/30/20	3RD SDF Sub.	ACJ

Project No:	KSS000147
Drawn By:	ACJ
Checked By:	JRR
Date:	8/29/19

SITE DETAILS

C1.2

GENERATION 3 LED FOCUS CANOPY LIGHT (CR03)

US patents 5566109 & 5674995 & 7828456 and US & Int'l. patents pending

LEDs - Select high-brightness LEDs. 5300K color temperature, 70 CRI (nominal).

DRIVE CURRENT - Choice of Super Saver (SS) or High Output (HO).

OPTICS / DISTRIBUTION - Ultra-High efficiency optics provide precise beam placement for optimal retail surface illumination. Each bank of LEDs in a light cartridge is independently adjustable between +45° allowing targeted zone illumination. Regardless of light cartridge position luminaire provides cutoff.

OPTICAL UNIT - Featuring a slim 2" profile aluminum housing is die-formed aluminum with independently adjustable extruded aluminum light cartridges. Each light cartridge is provided with a gasketed clear tempered glass lens providing a water-resistant seal.

DRIVER - State-of-the-art technology designed specifically for LED light sources provides unsurpassed system efficiency. Input power 5-50 watts. Components are fully enclosed in potting for moisture resistance. Driver complies with IEC and FCC standards.

DRIVER HOUSING - Weather-tight aluminum die-electrical enclosure is elevated above canopy deck to ensure no water entry and providing "knock-out" entry for primary wiring.

FINISH - Standard color is white. Fixture is finished with LSi's DuraGrip® polyester powder coat process. DuraGrip withstands extreme weather changes without cracking or peeling.

OPERATING TEMPERATURE - -40°F to +60°C (-40°F to +122°F)

ELECTRICAL - Universal voltage power supply 120-277V VAC, (50/60 Hz) input. Two-stage surge protection (including separate surge protection built into electronic driver) meets IEEE C92.41-2-2002, Scenario 1, Location Category C.

INSULATION - Holes in 1/2" x 16" deck can. Deck penetration consists of 5 drilled holes simplifying installation and water sealing. Unit is designed to retrofit existing Scottsdale® (4") hole as well as openings for Encore® and Encore® Top Access and to reconnect wiring from the SCS2CA without having to relocate conduit. Retrofit panels are available for existing Scottsdale and Encore (see back page) as well as kits for recessed and 2x2 installations (see separate spec sheets).

EXPECTED LIFE - Minimum 60,000 hours to 100,000 hours depending upon the ambient temperature of the installation location. See US web site for specific guidance.

WARRANTY - Limited 5-year warranty

LISTING - ETL listed to UL1598, UL 8750 and other U.S. and International safety standards. Suitable for wet locations.

PHOTOMETRICS - Application layouts are available upon request. Contact LSI Petroleum Lighting or petroleum.apps@lsi-industries.com

Light Output (Lumens) 3372
Watts per Watt (Efficiency) 36.1
Color Accuracy (CRI) 67
Life Expectancy (hrs) 52500 (Daylight)
Warranty 5 Year

Light Output - CR03 - FO
SS - Super Saver 2.24 36 74
HO - High Output 3.28 51 96

This product, or selected versions of this product, meet the standards listed below. Please consult factory for your specific requirements.

Project Name Catalog # Fixture Type 04/2016 LSI INDUSTRIES INC.

Light Output - CR03 - FO	Lumens	Watts	LPW
SS - Super Saver	2.24	36	74
HO - High Output	3.28	51	96

This product, or selected versions of this product, meet the standards listed below. Please consult factory for your specific requirements.



Project Name Catalog # Fixture Type 04/2016 LSI INDUSTRIES INC.

1 FIXTURE "FC2" NOT TO SCALE

DESCRIPTION

The Galloway "wall LED luminaire's appearance is complementary with the Galloway area and site luminaires bringing a modern architectural style to lighting applications. Flexible mounting options accommodate wall surfaces in both an upward and downward configuration. The Galloway family of LED products deliver exceptional performance with patented, high-efficiency AccuLED Optics™, providing uniform and energy conscious lighting for parking lots, building and security lighting applications.

SPECIFICATION FEATURES

Construction
Driver enclosure thermally isolated from optics for optimal thermal performance. Heavy wall aluminum housing die-cast with integral extruded heat sinks to provide superior structural rigidity and an IP66 rated housing. Overall construction passes a 1.5g vibration test to ensure mechanical integrity. UPLIGHTING: Specify with the UPL option for inverted mount optic housing with additional protection to maintain IP rating.

Options
Choice of thirteen patented, high-efficiency AccuLED Optics. The optics are precisely designed to shape the distribution maximizing efficiency and application spacing. AccuLED Optics create consistent distributions with the availability to meet customized application requirements. Offered standard in 4000K to 2700K CCT and minimum 70 CRI. Optional 5000K, 6000K CCT. Greater than 90%.

Mounting
Gasketed and zinc plated rigid steel mounting attachment fits directly to 4" hole or wall with the Galloway "Hook-N-Lock" mechanism for quick installation. Secured with two captive corrosion resistant 304 stainless steel screws. Standard color is black, bronze, grey, white, dark platinum and graphite metallic. RAL and custom color matches available. Consult the McGraw-Edison Architectural Colors brochure for the complete selection.

Electrical
LED drivers are mounted for ease of maintenance. 120-277V 50/60Hz, 347V or 480V 50Hz operating. 480V Wye systems only. Drivers are provided standard with a 10W dimming. An optional AccuLED proprietary surge protection module is available and designed to withstand 10kV of transient line surge. The Galloway Wall LED luminaire is suitable for operation in 30°C to 40°C ambient environments. For applications with ambient temperatures exceeding 40°C, specify the HA (High Ambient) option. Emergency signaling and occupancy sensor available.

Warranty
Five-year warranty.




McGraw-Edison

Product #	Type
FC2	Wall Mount
FC1	Wall Mount
FC3	Wall Mount
FC4	Wall Mount
FC5	Wall Mount
FC100	Wall Mount

GWC GALLEON WALL LUMINAIRE

1-2 Light Squares Solid State LED

WALL MOUNT LUMINAIRE

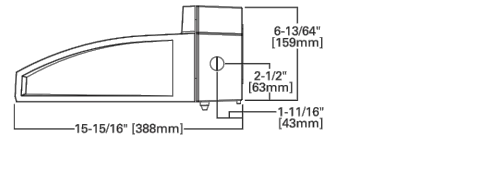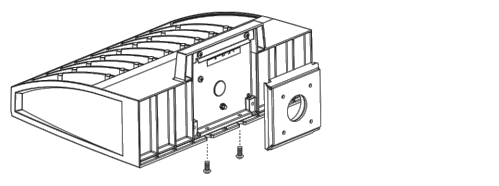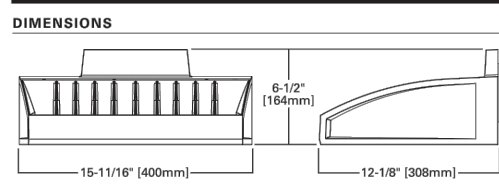

SHIPPING DATA

Approximate Net Weight: 17 lbs. (7.7 kg)

Approximate Gross Weight: 20 lbs. (9.1 kg)

Approximate Shipping Weight: 22 lbs. (10.0 kg)

Approximate Shipping Weight: 24 lbs. (10.9 kg)

Approximate Shipping Weight: 26 lbs. (11.8 kg)

Approximate Shipping Weight: 326 lbs. (146.8 kg)


Approximate Shipping Weight: 328 lbs. (147.7 kg)

Approximate Shipping Weight: 330 lbs. (148.6 kg)

Approximate Shipping Weight:


SDP V_3 redlines.pdf Markup Summary

Ryan Howser (2)

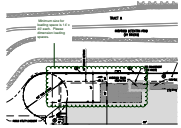

Subject: Cloud+
Page Label: [2] 2 SITE PLAN
Author: Ryan Howser
Date: 4/30/2020 1:40:24 PM
Status:
Color: ■
Layer:
Space:

Minimum size for loading space is 14' x 40' each.
Please dimension loading spaces.

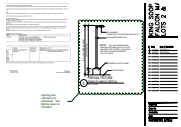

Subject: Cloud+
Page Label: [5] 5 PHOTOMETRIC DETAILS
Author: Ryan Howser
Date: 4/30/2020 1:41:37 PM
Status:
Color: ■
Layer:
Space:

Lighting plan comment not addressed. See
lighting plans for comment.