## TO WIT (DEED DESCRIPTION):

That portion of the Northwest quarter of Section 6 in Township 12 South, Range 65 West of the 6th P.M., described as follows;

Commencing at a point on the West line of said Section 6 that is 3979.50 feet North on said West line from the Southwest corner of said Section 6; thence South 88°52'30" East 1954 feet to the point of beginning of the tract to be described hereby: Thence continue South 88°52'30" East 495 feet, being on the center line of said Vessey Road; thence South 160 feet parallel with the West line of said Northwest quarter; thence South 88°52'30" East 165 feet; then South 320 feet, parallel with the West line of said Northwest quarter; thence North 88°52'30" West 634 feet to a point on the East line of the tract described in deed to Verda Marine Hanson, recorded in Book 1752 at Page 76 of the records of El Paso County, Colorado, under Reception No. 117650, that is 10 feet North on said East line from the Southeast corner thereof; thence North 00°7'30" West 320 feet; thence North 88°52'30" West 26 feet; thence North 00°7'30" East 160 feet to the point of beginning, except the Northerly 30 feet and the Easterly 15 feet thereof, in El Paso County, Colorado. with all its appurtenances and warrant the title to the same.

County of El Paso and State of Colorado.

## TO WIT (SURVEYED DESCRIPTION):

A tract of land in the Northwest Quarter of Section 6, Township 12 South, Range 65 West of the Sixth Principal Meridian, El Paso County, Colorado described as follows:

Beginning at a point that is N 00°07'30" E 3979.50 feet and S 88°52'30" E 1981.48 feet from the Southwest Corner of said Section 6; thence

N 88°55'06" E 466.84 feet: thence S 00°27'57" E 160.00 feet to a found 1/2" rebar with Surveyor's Cap, P.L.S. #37631; thence

N 88°55'06" E 165.00 feet to a found <sup>1</sup>/<sub>2</sub>" rebar with Surveyor's Cap, P.L.S. #37631; thence

S 00°01'52" W 315.08 feet to a found 1/2" rebar with Surveyor's Cap, P.L.S. #37631; thence N 86°26'11" W 292.91 feet to a found <sup>1</sup>/<sub>2</sub>" rebar with Surveyor's Cap, P.L.S. #37631; thence

S 84°24'14" W 245.64 feet to a found ½" rebar with Surveyor's Cap, P.L.S. #37631; thence

S 77°52'51" W 99.26 feet to a found <sup>3</sup>/<sub>4</sub>" iron pipe; thence

N 00°02'37" E 10.00 feet to a found 1/2" rebar with Surveyor's Cap, P.L.S. #37631; thence N 00°01'06" E 175.09 feet to a found ½" rebar with Surveyor's Cap, P.L.S. #37631; thence

N 00°14'10" E 145.17 feet to a found ½" rebar with Surveyor's Cap, P.L.S. #30106; thence N 00°07'33" E 159.48 feet to the point of beginning, containing 6.2 acres.

Subject to easements and restrictions of record.

be depicted on the map

existing easements need to

DOLES LIVING TRUST SCH. NO. 5206000030 ZONED RR-SINGLE FAMILY RESI POINT OF BEGINNING S 88° 52'30" E 198 48

MARY & VINCENT PIRRONE SCH. NO. 5206000051 ZONED RR-5 SINGLE FAMILY RESIDENTIAL

SW CORNER S6, T12S, R65W MONUMENT FOUND

Ē

RANDY & ANGELA BUCKLEY SCH. NO. 5206000076 ZONED RR-5 SINGLE FAMILY RESIDENTIAL


EAST LINE BOOK 1752, PAGE 26 & ----WEST LINE OF BOOK 1786, PAGE 348

ROBERT C. JR. & BARBARA METZGEI SCH. NO. 5206000050 ZONED RR-5 SINGLE FAMILY RESIDENTIAL

> LS 3763(1 CAP N 00°02'45" E 10,00' (S)-N 00°02'38" E 10.00' (R5 & R6)

lot configuration does

not match our records, please revise, if correct please have a surveyor stamp and sign off on this

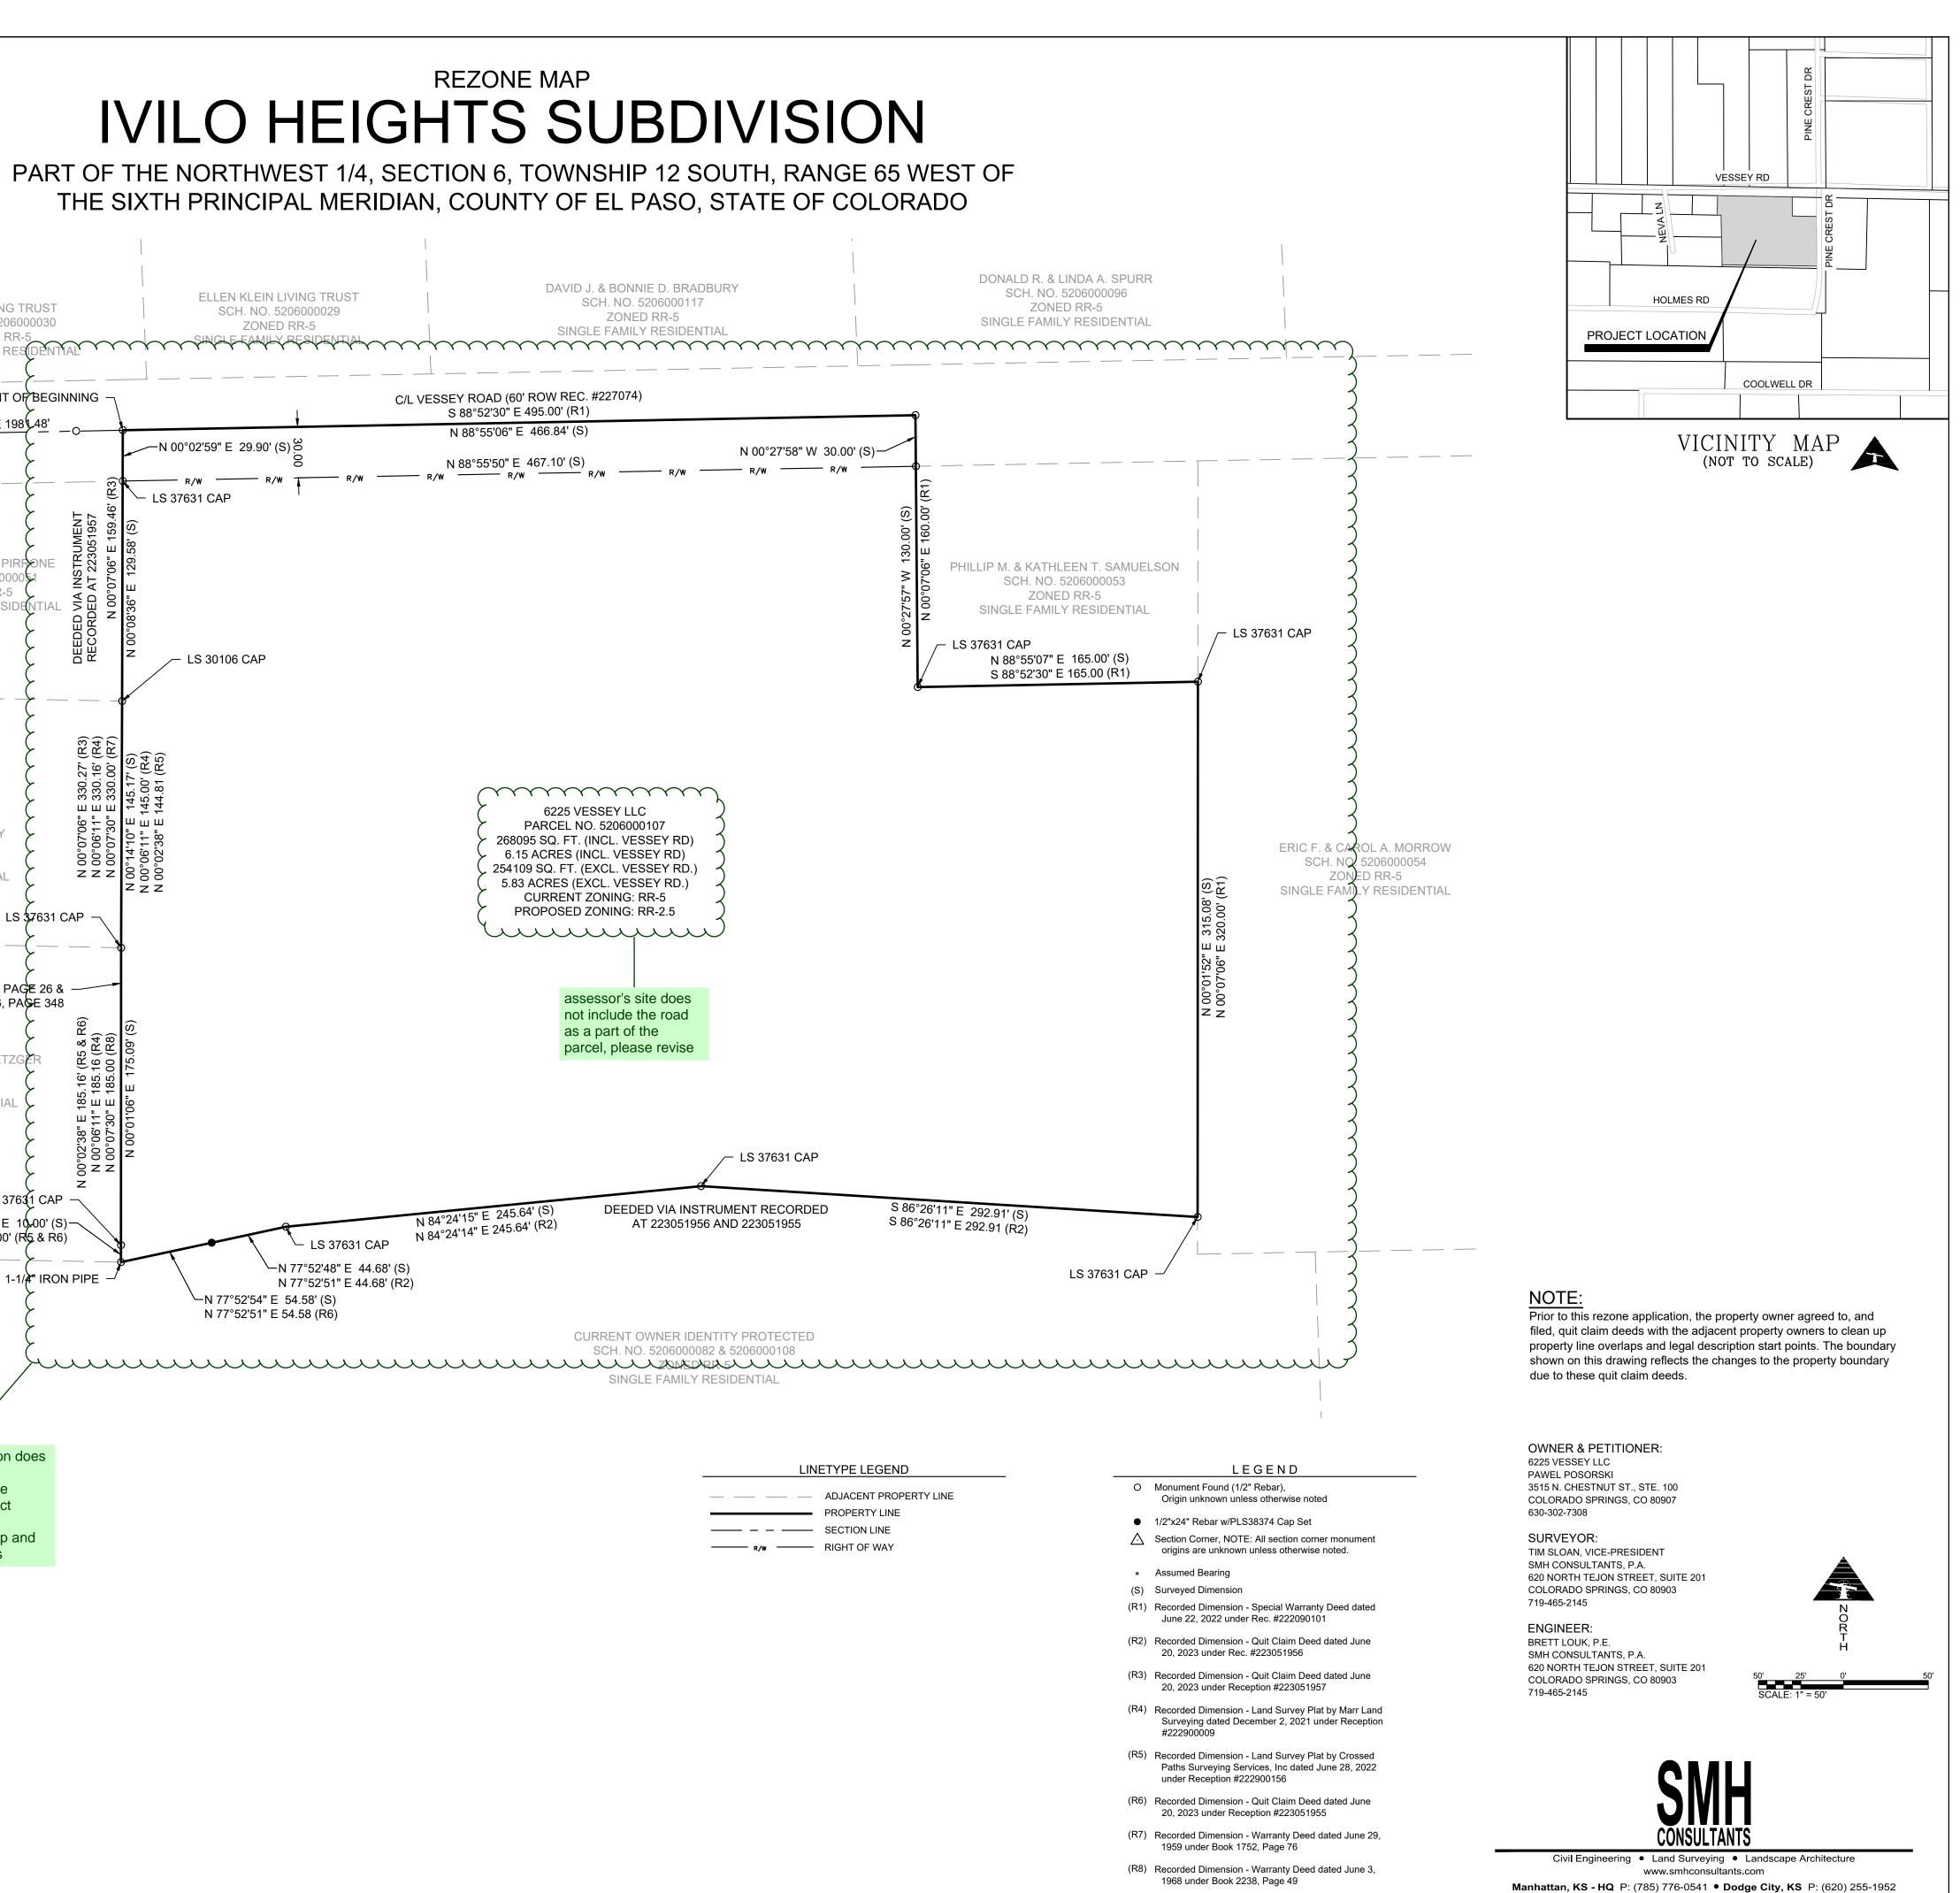

LINETYPE LEGEND	
	ADJACENT PROPERTY LINE
	PROPERTY LINE
	SECTION LINE
R/W	RIGHT OF WAY

**Overland Park, KS** P: (913) 444-9615 • Colorado Springs, CO P: (719) 465-2145 Drawn By: JAM Project #2209-0355 DD #TDS86 PCD FILE P241

**JANUARY 2024**