

• END VIEW •


13'-0 3/4"  
**38.39 SQ. FT.**

# GLEN EAGLE SELF STORAGE

• 5" DEEP PAN/CHAN LETTERS W/ RETURNS PAINTED TO MATCH #3630-106 BRILLIANT GREEN VINYL. FACES TO BE WHITE ACRYLIC W/ 1" TRIM CAP PAINTED TO MATCH #3630-106 BRILLIANT GREEN VINYL. #3630-106 BRILLIANT GREEN INSET VINYL LEAVING WHITE BORDER ON FACE. ILLUMINATE W/ WHITE L.E.D.'S AS REQUIRED.


• RACEWAY PAINTED TO MATCH FASCIA DOVE 3003L (53) STUCCO.

<b>A</b>	SIGN TYPE	ILLUMINATED PAN/CHAN LETTERS	SCALE	1/2"=1'-0"
	QUANTITY	1	JOB TYPE	MANUFACTURE & INSTALL
<b>R5</b>	Added Raceways			

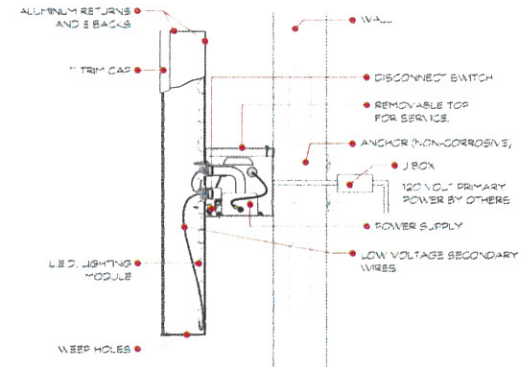

• TYPICAL LETTER DETAIL •  
- WALL CONDITIONS VARY -

In order to calculate size allowances, the building frontage length needs to be shown for each side of the building that a sign is present

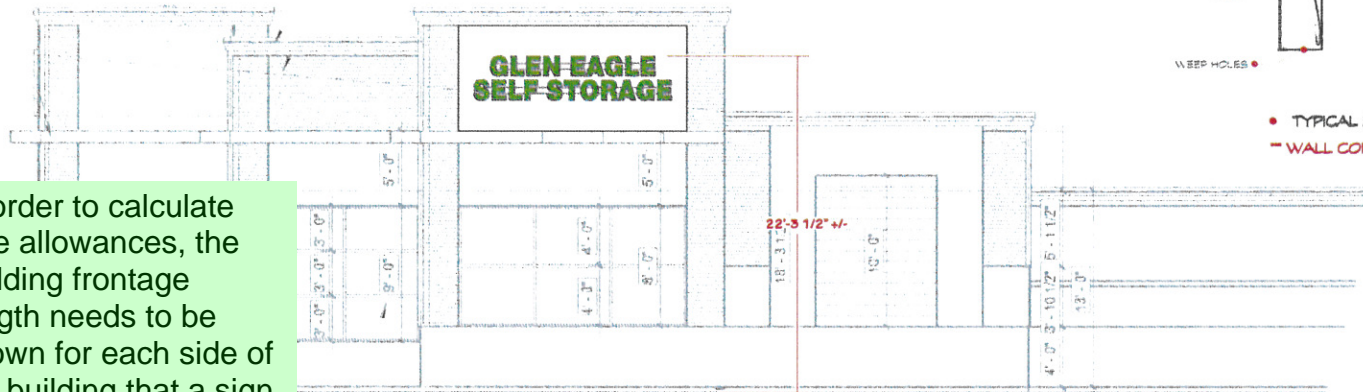

• EAST ELEVATION BUILDING A 1/8"=1'-0" •

This design is the property of Artform and is submitted for your use in conjunction with a project being planned for you by Artform. It cannot be reproduced either in whole or in part without their written consent.

The boxes below must be initialed and dated prior to manufacturing	
CLIENT APPROVAL:	DATE:
PROD. APPROVAL:	DATE:


CLIENT:	Glen Eagle Self Storage
LOCATION:	

REVISIONS
REV#5: REVISE SIGN A, B & C.
REV#6: REMOVE SIGN C.
REV#4: REVISE SIGN A, B & C.

Artist:	J.D. Easton
Artwork Phase:	<input type="radio"/> Conceptual <input type="radio"/> Design Development <input type="radio"/> Revision <input type="radio"/> Final Production

DESIGN #	REF. DATE
17830	0910
PAGE #	OF
1	4



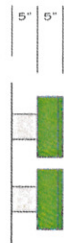

• END VIEW •



21.36 SQ. FT.

**GLEN EAGLE  
SELF STORAGE**


- 5" DEEP PAN/CHAN LETTERS W/ RETURNS PAINTED TO MATCH #3630-106 BRILLIANT GREEN VINYL. FACES TO BE WHITE ACRYLIC W/ 1" TRIM CAP PAINTED TO MATCH #3630-106 BRILLIANT GREEN VINYL. #3630-106 BRILLIANT GREEN INSET VINYL LEAVING WHITE BORDER ON FACE. ILLUMINATE W/ WHITE L.E.D.'S AS REQUIRED.

- RACEWAY PAINTED TO MATCH FASCIA DOVE 3003L (53) STUCCO.

<b>B</b>	SIGN TYPE	ILLUMINATED PAN/CHAN LETTERS	SCALE	1/2" = 1'-0"
	QUANTITY	2	JOB TYPE	MANUFACTURE & INSTALL
<b>R7</b>	Changed Install Location			



• CONCEPTUAL NIGHT VIEW •

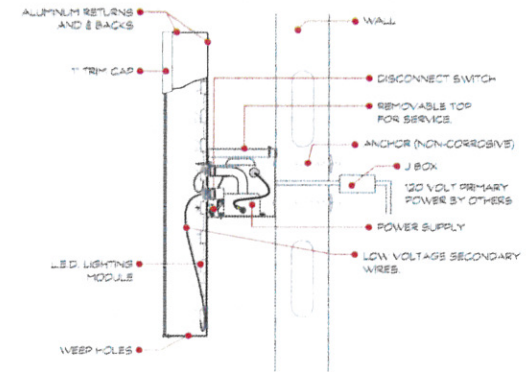

• TYPICAL LETTER DETAIL •  
- WALL CONDITIONS VARY -

This design is the property of Artform and is submitted for your use in conjunction with a project being planned for you by Artform. It cannot be reproduced either in whole or in part without their written consent.

The boxes below must be initialed and dated prior to manufacturing.	
CLIENT APPROVAL:	DATE:
PROD. APPROVAL:	DATE:

CLIENT:	Glen Eagle Self Storage
LOCATION:	


REVISIONS	REV#5: REVISE SIGN A, B & C.
REV#7: REVISE SIGN B.	
REV#4: REVISE SIGN A, B & C.	

Artist:	J.D. Easton
Artwork Phase:	<input checked="" type="checkbox"/> Conceptual <input checked="" type="checkbox"/> Design Development <input type="checkbox"/> Revision <input type="checkbox"/> Final Production

DESIGN #	REF. DATE
17830	0910
PAGE #	3 OF 4




In order to calculate size allowances, the building frontage length needs to be shown for each side of the building that a sign is present

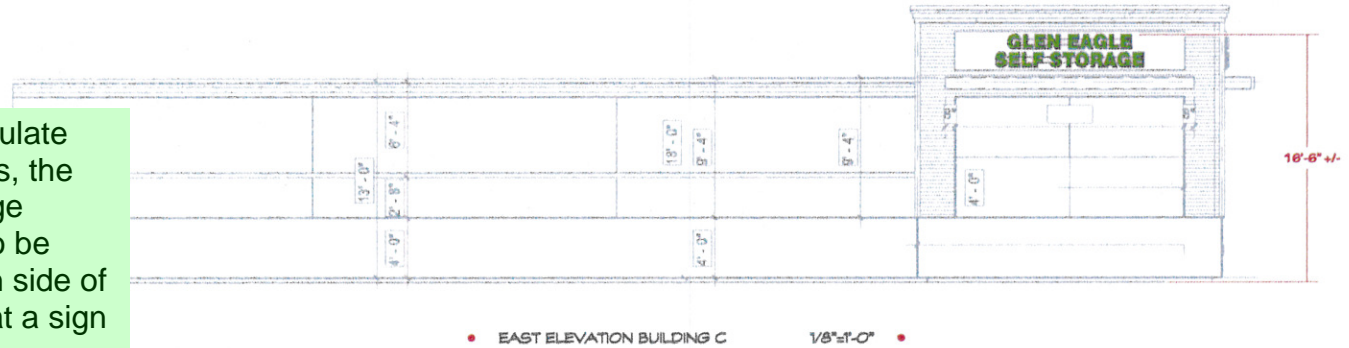

• EAST ELEVATION BUILDING C 1/8"=1'-0" •

In order to calculate size allowances, the building frontage length needs to be shown for each side of the building that a sign is present

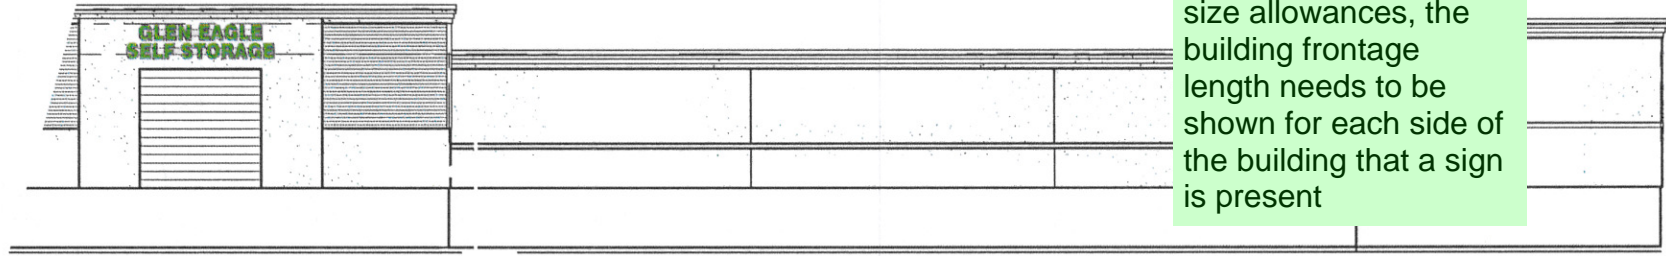

• EAST ELEVATION BUILDING B 1/8"=1'-0" •

This design is the property of Artform and is submitted for your use in conjunction with a project being planned for you by Artform. It cannot be reproduced either in whole or in part without their written consent.

The boxes below must be initialed and dated prior to manufacturing.

CLIENT APPROVAL:	DATE:
PROD. APPROVAL:	DATE:

CLIENT:  
Glen Eagle Self Storage

LOCATION:

REVISIONS
REV#5: REVISE SIGN A, B & C.
REV#6: REMOVE SIGN C.
REV#7: REVISE SIGN B.
REV#4: REVISE SIGN A, B & C.

Artist:  
J.D. Easton

Artwork Phase:


- Conceptual
- Design Development
- Revision
- Final Production

DESIGN #	REF. DATE
17830	0910
PAGE #	OF
4	4






• END VIEW •

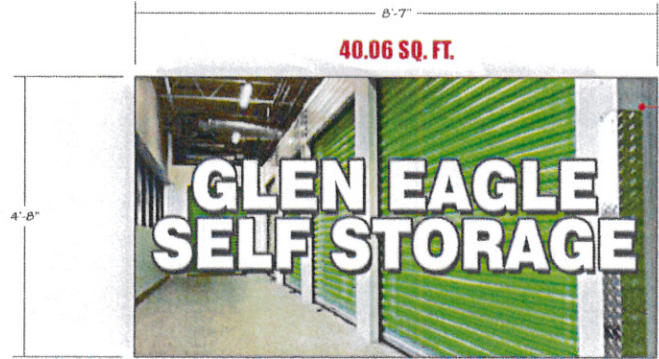

• S/F L.E.D. UNIT.

D	SIGN TYPE	S/F L.E.D. DISPLAY	SCALE	1/2"=1'-0"
	QUANTITY	1	JOB TYPE	MANUFACTURE & INSTALL
RE	Added this sign.			

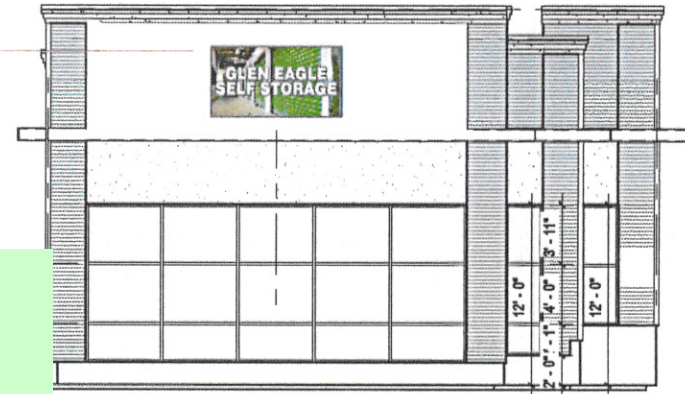

• SOUTH ELEVATION BUILDING A 1/8"=1'-0" •

In order to calculate size allowances, the building frontage length needs to be shown for each side of the building that a sign is present

This design is the property of Artform and is submitted for your use in conjunction with a project being planned for you by Artform. It cannot be reproduced either in whole or in part without their written consent.

The boxes below must be initialed and dated prior to manufacturing.	
CLIENT APPROVAL:	DATE:
PROD. APPROVAL:	DATE:

CLIENT:	Glen Eagle Self Storage
LOCATION:	

REVISIONS
REV#5: REVISE SIGN A, B & C.
REV#6: REMOVE SIGN C.
REV#7: REVISE SIGN B.
REV#4: REVISE SIGN A, B & C.


Artist:	J.D. Easton
Artwork Phase:	<input checked="" type="radio"/> Conceptual <input checked="" type="radio"/> Design Development <input type="radio"/> Revision <input type="radio"/> Final Production

DESIGN #	REF. DATE
17830	0910
PAGE #	2 OF 4




# Markup Summary

dsdKendall (4)

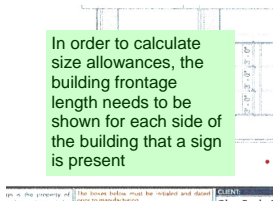


**Subject:** Text Box  
**Page Label:** 1  
**Lock:** Unlocked  
**Author:** dsdKendall  
**Date:** 10/24/2018 3:45:53 PM  
**Color:** ■

In order to calculate size allowances, the building frontage length needs to be shown for each side of the building that a sign is present

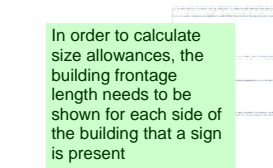


**Subject:** Text Box  
**Page Label:** 3  
**Lock:** Unlocked  
**Author:** dsdKendall  
**Date:** 10/24/2018 3:46:20 PM  
**Color:** ■

In order to calculate size allowances, the building frontage length needs to be shown for each side of the building that a sign is present

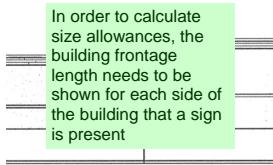

**Subject:** Text Box  
**Page Label:** 3  
**Lock:** Unlocked  
**Author:** dsdKendall  
**Date:** 10/24/2018 3:46:24 PM  
**Color:** ■

In order to calculate size allowances, the building frontage length needs to be shown for each side of the building that a sign is present

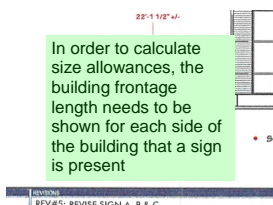

**Subject:** Text Box  
**Page Label:** 4  
**Lock:** Unlocked  
**Author:** dsdKendall  
**Date:** 10/24/2018 3:46:42 PM  
**Color:** ■

In order to calculate size allowances, the building frontage length needs to be shown for each side of the building that a sign is present