

# WILLOW SPRINGS RANCH FILING NO. 2

## MONUMENT, COLORADO


### CONSTRUCTION DRAWINGS

#### GENERAL NOTES

- ALL WORK SHALL BE DONE IN ACCORDANCE WITH THE TOWN OF MONUMENT ENGINEERING STANDARDS AND SPECIFICATIONS AND CDOT STANDARD SPECIFICATIONS, LATEST REVISION.
- APPROVAL OF THESE PLANS BY THE CITY ENGINEER DOES NOT AUTHORIZE ANY WORK TO BE PERFORMED UNTIL ANY REQUIRED PERMITS HAVE BEEN ISSUED.
- THE CONTRACTOR SHALL OBTAIN ALL NECESSARY PERMITS TO COMPLETE THE PROPOSED WORK AND SHALL COMPLY WITH ALL LOCAL, STATE AND FEDERAL REGULATIONS.
- THE CONTRACTOR SHALL OBTAIN AN APPROVED TRAFFIC CONTROL PLAN PRIOR TO COMMENCING CONSTRUCTION ACTIVITIES IN THE PUBLIC RIGHT-OF-WAY.
- IT SHALL BE THE CONTRACTOR'S RESPONSIBILITY TO ENSURE THAT ALL WORK IS PERFORMED IN ACCORDANCE WITH APPLICABLE STANDARDS AND REGULATIONS AS SET FORTH BY THE OCCUPATIONAL SAFETY AND HEALTH ADMINISTRATION (O.S.H.A.).
- THE APPROVAL OF THESE PLANS OR ISSUANCE OF A PERMIT BY THE TOWN OF MONUMENT DOES NOT AUTHORIZE THE OWNER OR CONTRACTOR TO VIOLATE ANY FEDERAL, STATE OR CITY LAWS, ORDINANCES, REGULATIONS, OR POLICIES.
- NO FIELD CHANGES SHALL BE MADE WITHOUT PRIOR WRITTEN APPROVAL OF THE PROJECT ENGINEER.
- ANY DISCREPANCY WITHIN THESE PLANS SHOULD BE BROUGHT TO THE IMMEDIATE ATTENTION OF THE ENGINEER AND WORK SHALL STOP UNTIL THE DISCREPANCY IS DISCUSSED AND A RESOLUTION HAS BEEN DETERMINED.
- THE PHYSICAL FEATURES WITHIN THE LIMITS OF THE PROJECT HAVE BEEN SHOWN BASED ON THE BEST AVAILABLE INFORMATION AT THE TIME OF DESIGN. THE PROJECT ENGINEER ASSUMES NO RESPONSIBILITY FOR THE ACCURACY OF THE FEATURES SHOWN. THE CONTRACTOR SHALL REVIEW AND VERIFY EXISTING PHYSICAL FEATURES AND ELEVATIONS AND INFORM THE ENGINEER OF THE CONDITIONS TO BE ENCOUNTERED DURING THE CONSTRUCTION.
- ALL WORK SHALL BE DONE TO THE LINES, GRADES, SECTIONS, AND ELEVATIONS SHOWN ON THE PLANS UNLESS OTHERWISE NOTED OR APPROVED BY THE ENGINEER.
- ALL MATERIALS AND WORKMANSHIP IN THE PUBLIC RIGHT-OF-WAY SHALL BE SUBJECT TO INSPECTION AND APPROVAL BY THE TOWN OF MONUMENT AND THE ENGINEER/OWNER.
- SUBMITTALS SHALL BE MADE FOR ALL MATERIALS TO BE INCORPORATED INTO THIS PROJECT.
- THE CONTRACTOR SHALL NOT STOCKPILE MATERIAL WITHIN 10 FT. OF THE EDGE OF THE TRAVELED WAY.
- SHOULD THE CONSTRUCTION ACTIVITY CONTINUE PAST 7:00 P.M., THE CONTRACTOR SHALL ENSURE THAT THE NOISE LEVEL DOES NOT EXCEED THE LIMITS SPECIFIED IN THE CITY ORDINANCE.
- DIMENSIONS AND RADII ARE SHOWN TO THE CURB FLOWLINE UNLESS OTHERWISE NOTED.
- ALL STATIONS REFER TO THE CENTERLINE OR FLOWLINE OF ROADWAY, UNLESS OTHERWISE NOTED.
- STORM INLET STATIONING AND ELEVATION REFERENCE TOP FRONT MIDDLE OF BOX. STORM MANHOLE STATIONING REFERENCE CENTER OF MANHOLE.
- THE CONTRACTOR SHALL BE RESPONSIBLE FOR ALL SURVEYING AND CONSTRUCTION STAKING FOR THE PROJECT. ALL GRADING AND SURFACING SHALL BE IN ACCORDANCE WITH THE PLAN SHEETS AND THE CITY OF COLORADO SPRINGS STANDARD SPECIFICATIONS.
- THE CONTRACTOR SHALL VERIFY ALL UTILITY LOCATIONS PRIOR TO BIDDING THE PROJECT. ALL UTILITY LOCATIONS SHOWN ARE APPROXIMATE.
- ALL CONTRACTORS UTILIZING THIS PLAN AND THE INFORMATION CONTAINED THEREON ARE CAUTIONED TO COMPLY WITH THE REQUIREMENTS OF COLORADO CODE TITLE 9, ARTICLE 1.5, AS AMENDED, CONCERNING PREVENTION OF DAMAGE TO UNDERGROUND FACILITIES RESULTING FROM EXCAVATIONS (Utility Notification Act). LOCATION OF EXISTING AND PROPOSED UNDERGROUND UTILITIES AND FACILITIES SHOWN ON THE DRAWINGS HAVE BEEN DEVELOPED FROM INFORMATION MADE AVAILABLE. COMPLETENESS AND ACCURACY OF LOCATION AND DEPTH OF UTILITIES AND FACILITIES SHOWN ON THESE PLANS CANNOT BE GUARANTEED. OTHER UTILITIES MAY BE PRESENT AT THIS LOCATION NOT SHOWN ON THIS PLANS. THE CONTRACTOR IS TO VERIFY THE DEPTH AND LOCATION OF ALL UTILITIES AND FACILITIES BEFORE THE START OF WORK. UTILIZE HAND EXCAVATION AS REQUIRED. WORK SHALL BE DONE IN ACCORDANCE WITH THE STANDARDS OF THE UTILITY COMPANIES WHOSE FACILITIES ARE IN THE PROXIMITY OF THE WORK, PURSUANT TO THE REQUIREMENTS OF COLORADO CODE, THE CONTRACTOR SHALL CONTACT THE UTILITY NOTIFICATION CENTER OF COLORADO AT 811, (1-800-922-1987) AT LEAST 2 DAYS PRIOR TO EXCAVATION.
- THE CONTRACTOR SHALL HAVE ONE (1) SIGNED COPY OF THESE APPROVED PLANS AND ONE (1) COPY OF THE APPROPRIATE DESIGN AND CONSTRUCTION STANDARDS AND SPECIFICATIONS AT THE JOB SITE AT ALL TIMES.
- CONTRACTOR SHALL SCHEDULE A PRE-CONSTRUCTION MEETING WITH OWNER, ARCHITECT & ENGINEER PRIOR TO MOBILIZING ON SITE.
- CONTRACTORS SHALL VERIFY ALL DIMENSIONS, INVERTS, ELEVATIONS, AND EXISTING CONDITIONS PRIOR TO PROCEEDING WITH THE WORK. VARIATIONS BETWEEN DRAWINGS AND ACTUAL FIELD CONDITIONS SHALL BE BROUGHT TO THE ATTENTION OF THE ENGINEER AND RESOLVED PRIOR TO PROCEEDING WITH THE WORK.
- THE CONTRACTOR SHALL BE RESPONSIBLE FOR MAINTENANCE AND PROTECTION OF VEHICULAR AND PEDESTRIAN TRAFFIC. ALL TRAFFIC CONTROL MEASURES SHALL BE IN ACCORDANCE WITH LOCAL, STATE, AND OSHA REGULATIONS.
- PROFESSIONAL INSPECTION AND ACCEPTANCE OF CONSTRUCTION FOR CONFORMANCE TO THE APPLICABLE STANDARDS AND CODES IS THE RESPONSIBILITY OF THE OWNER. SITE OBSERVATION OF THE GEOTECHNICAL ASPECTS OF THE PROJECT IS TO BE DONE UNDER THE DIRECT SUPERVISION OF A PROFESSIONAL ENGINEER. THE OWNER OR THE OWNER'S CONSTRUCTION REPRESENTATIVE RESERVES THE RIGHT TO INSPECT ANY PORTION OF THE WORK AND REQUEST CORRECTION TO THE OWNER'S SATISFACTION FOR ALL WORK NOT COMPLETED IN ACCORDANCE WITH THE SPECIFICATIONS AND DRAWINGS. INSPECTION OR SITE OBSERVATION OF WORK BY THE ENGINEER DOES NOT RELIEVE THE CONTRACTOR FROM THE RESPONSIBILITY OF CONFORMING TO THE DRAWINGS AND SPECIFICATIONS FOR ALL CONSTRUCTION.
- PROPOSED LANDSCAPING AND IRRIGATION SHALL CONFORM TO THE APPROVED FINAL LANDSCAPE AND IRRIGATION PLANS.
- ALL MATERIALS AND WORKMANSHIP SHALL BE SUBJECT TO INSPECTION BY THE OWNER OR ITS REPRESENTATIVES. THE OWNER OR ITS REPRESENTATIVES RESERVE THE RIGHT TO ACCEPT OR REJECT ANY SUCH MATERIALS AND WORKMANSHIP THAT DOES NOT CONFORM TO ITS STANDARDS AND SPECIFICATIONS.

#### NOTES

- PER COLORADO STATE SENATE BILL 18-167, ALL UNDERGROUND UTILITIES, INCLUDING STORM SEWER, MUST BE INSTALLED WITH A DETECTABLE MATERIAL SO IT CAN BE TRACED AT GROUND LEVEL. ENSURE ALL PIPES INSTALLED ARE EQUIPPED WITH A MEANS OF BEING DETECTED, AS PER FORTHCOMING CITY STANDARD. EFFECTIVE JANUARY 1, 2020.
- MAINTENANCE OF CURB RETURNS, CROSS PANS AND PEDESTRIAN RAMPS IN THE FOREST LAKES DRIVE ROW SHALL BE RESPONSIBILITY OF THE TOWN OF MONUMENT.

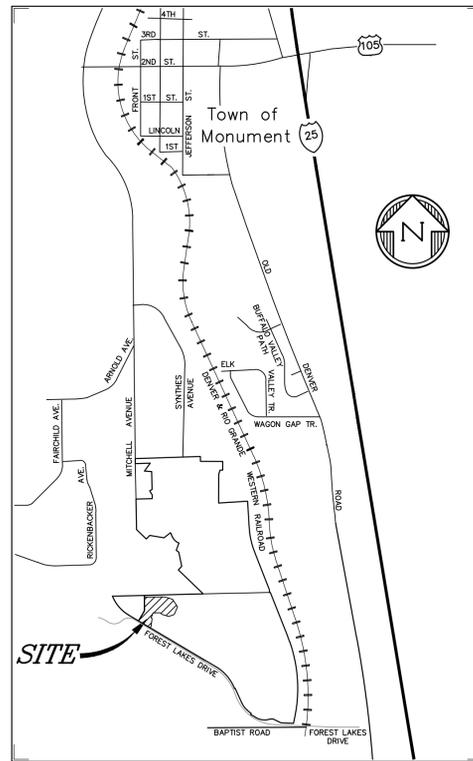

Vicinity Map  
Not to Scale

#### SHEET INDEX

SHT 1	CV	COVER SHEET	
SHT 2	MMD.	MOUNTAIN MUHLY DR.	PLAN & PROFILE
SHT 3	S&D	SECTIONS & DETAILS	
SHT 4	S&D	SECTIONS & DETAILS	

#### FLOODPLAIN STATEMENT

THE PROPERTY IS INDICATED AS BEING LOCATED IN ZONE "AE" ON THE NFIP FLOOD INSURANCE RATE MAP FOR UNINCORPORATED EL PASO COUNTY, COLORADO, PANEL NUMBER'S 08041C0278G AND 08041C0278S, BOTH DATED DECEMBER 07, 2018 AND ON THE LETTER OF MAP REVISION TO PANEL NUMBER'S 08041C0278G AND 08041C0278S, CASE NUMBER 16-08-1035R HAVING AN EFFECTIVE DATE OF APRIL 18, 2019. ZONE "AE" IS DESCRIBED AS THOSE AREAS FOR WHICH BASE FLOOD ELEVATIONS HAVE BEEN DETERMINED.

#### PROJECT BENCHMARK

A #5 REBAR WITH A 2" ALUMINUM CAP STAMPED "D.B. & CO." / "CONTROL POINT". POINT IS LOCATED 610 FEET +/- EAST OF THE EAST EDGE OF ASPHALT OF MITCHELL ROAD, 390 FEET +/- SOUTHWESTERLY OF THE CENTER OF THE CUL-DE-SAC AT THE SOUTH END OF SYNTHES ROAD AND 25 FEET SOUTH OF A SPLIT RAIL FENCE AT THE SOUTHERLY BOUNDARY OF THE SYNTHES USA PROPERTY.  
ELEVATION = 6880.06. VERTICAL DATUM - NAVD88.

#### CONTACTS

DEVELOPER: POLO BROWN COMPANY  
514 PIKE AVENUE  
CANON CITY, COLORADO 81212  
DANIEL BROWN  
(303) 999-5533

CIVIL ENGINEER: DREXEL BARRELL & COMPANY  
3 S. 7TH STREET  
COLORADO SPRINGS, CO 80905  
TIM MCCONNELL, P.E. (719) 260-0887

#### LOCAL UTILITY PROVIDERS

FIRE DEPARTMENT  
TRI-LAKES MONUMENT FIRE PROTECTION DISTRICT  
JAMEY BUMGARDNER  
BATTALION CHIEF  
15455 GLENEAGLE DR., STE. 230  
COLORADO SPRINGS, COLORADO 80921  
Phone (719) 484-0911  
jbumgarner@timfire.org

ELECTRIC  
MOUNTAIN VIEW ELECTRIC ASSOC.  
LES ULFERS  
11140 E. WOODMEN ROAD  
FALCON, COLORADO 80831  
Phone (719) 495-2283

NATURAL GAS:  
BLACK HILLS ENERGY  
BOB SWATEK  
18965 BASE CAMP RD. #A7  
MONUMENT, COLORADO 80132  
Phone (303) 566-3405  
TELEPHONE COMPANY:  
CENTURY LINK  
MELISSA SPENCER  
Phone: (719) 636-4748  
(LOCATORS) (719) 597-8418

CABLE COMPANY:  
COMCAST  
DALE STEWART  
213 N. UNION BLVD.  
COLORADO SPRINGS, COLORADO 80909  
Phone: 9719) 442-4733

WATER  
TOWN OF MONUMENT  
TOM THARNISH  
645 BEACON LITE ROAD  
MONUMENT, COLORADO 80132  
PHONE: (719) 481-2954

WASTEWATER  
MONUMENT SANITATION DISTRICT  
130 2ND ST.  
MONUMENT, COLORADO 80132  
PHONE: (719) 481-4886

#### LOCAL OFFICIALS

TOWN OF MONUMENT  
TOWN MANAGER  
MIKE FOREMAN  
645 BEACON LITE ROAD  
MONUMENT, COLORADO 80132  
Phone (719) 884-8023  
mforeman@tomgov.org

TOWN OF MONUMENT PUBLIC WORKS  
DIRECTOR OF PUBLIC WORKS  
TOM THARNISH  
645 BEACON LITE ROAD  
MONUMENT, COLORADO 80132  
Phone (719) 884-8039  
ttharnish@tomgov.org

TOWN OF MONUMENT PLANNING DEPARTMENT  
LARRY MANNING  
PLANNING DIRECTOR  
645 BEACON LITE ROAD  
MONUMENT, COLORADO 80132  
lmanning@tomgov.org

#### TOWN OF MONUMENT ACCEPTANCE

THESE PLANS HAVE BEEN REVIEWED BY THE TOWN OF MONUMENT STAFF AND FOUND TO BE IN GENERAL COMPLIANCE WITH TOWN OF MONUMENT AND TRIVEW STANDARDS. IT IS THE RESPONSIBILITY OF THE SITE ENGINEER AND GENERAL CONTRACTOR TO ENSURE CONSTRUCTION IS IN COMPLIANCE WITH THESE PLANS AND IN CONFORMANCE WITH THE TOWN OF MONUMENT DESIGN CRITERIA & CONSTRUCTION SPECIFICATIONS, REGULATIONS, TRIVEW METROPOLITAN DISTRICT DESIGN CRITERIA CONSTRUCTION SPECIFICATIONS, AND THE CITY OF COLORADO SPRINGS DRAINAGE CRITERIA MANUALS VOLUMES 1 AND 2 SHALL PREVAIL IN ANY INSTANCES WHERE THESE PLANS DIFFER WITH THOSE REQUIREMENTS.

THE DEVELOPMENT SERVICES DEPARTMENT SHALL BE NOTIFIED IF ANY CHANGES NEED TO BE MADE.

TOWN OF MONUMENT \_\_\_\_\_ DATE \_\_\_\_\_

#### ENGINEER'S STATEMENT

THIS EROSION AND STORMWATER QUALITY CONTROL/GRADING PLAN WAS PREPARED UNDER MY DIRECTION AND SUPERVISION AND IS CORRECT TO THE BEST OF MY KNOWLEDGE AND BELIEF. IF SUCH WORK IS PERFORMED IN ACCORDANCE WITH THE GRADING AND EROSION CONTROL PLAN, THE WORK WILL NOT BECOME AND HAZARD TO LIFE AND LIMB, ENDANGER PROPERTY, OR ADVERSELY AFFECT THE SAFETY, USE, OR STABILITY OF A PUBLIC WAY, DRAINAGE CHANNEL, OR OTHER PROPERTY.

ENGINEER \_\_\_\_\_ DATE \_\_\_\_\_

#### OWNER'S STATEMENT

THE OWNER WILL COMPLY WITH THE REQUIREMENTS OF THE EROSION AND STORMWATER QUALITY CONTROL PLAN INCLUDING TEMPORARY BMP INSPECTION REQUIREMENTS AND FINAL STABILIZATION REQUIREMENTS. I ACKNOWLEDGE THE RESPONSIBILITY TO DETERMINE WHETHER THE CONSTRUCTION ACTIVITIES ON THESE PLANS REQUIRE COLORADO DISCHARGE PERMIT SYSTEM (CDPS) PERMITTING FOR STORMWATER DISCHARGES ASSOCIATED WITH CONSTRUCTION ACTIVITY.

DEVELOPER/OWNER SIGNATURE \_\_\_\_\_ DATE \_\_\_\_\_

DANIEL BROWN  
POLO BROWN COMPANY  
514 PIKE AVENUE  
CANON CITY, CO 81212  
(303) 999-5533

#### EL PASO COUNTY

COUNTY PLAN REVIEW IS PROVIDED ONLY FOR GENERAL CONFORMANCE WITH COUNTY DESIGN CRITERIA. THE COUNTY IS NOT RESPONSIBLE FOR THE ACCURACY AND ADEQUACY OF THE DESIGN, DIMENSIONS, AND/OR ELEVATIONS WHICH SHALL BE CONFIRMED AT THE JOB SITE. THE COUNTY THROUGH THE APPROVAL OF THIS DOCUMENT ASSUMES NO RESPONSIBILITY FOR THE COMPLETENESS AND/OR ACCURACY OF THIS DOCUMENT.

FILED IN ACCORDANCE WITH THE REQUIREMENTS OF THE EL PASO COUNTY LAND DEVELOPMENT CODE, DRAINAGE CRITERIA MANUAL, AND ENGINEER Add "PCD File No. \_\_\_\_\_ AS AMENDED.  
CDR224"

THIS REVIEW IS ONLY FOR THE \_\_\_\_\_ IN FOREST-LAKES DRIVE.

JENNIFER IRVINE, P.E. \_\_\_\_\_ DATE \_\_\_\_\_  
COUNTY ENGINEER

PREPARED BY:



DREXEL, BARRELL & CO.  
Engineers-Surveyors  
3 SOUTH 7TH STREET  
COLORADO SPGS, COLORADO 80905  
CONTACT: TIM D. MCCONNELL, P.E.  
(719) 260-0887  
BOULDER • COLORADO SPRINGS • GREELEY

CLIENT:



514 PIKE AVENUE  
CANON CITY, COLORADO 81212  
(303) 999-5533

CONSTRUCTION DOCUMENTS FOR:  
WILLOW SPRINGS RANCH  
FILING NO. 2  
BAPTIST ROAD & FOREST LAKES DRIVE  
MONUMENT, COLORADO

ISSUE	DATE
INITIAL ISSUE	2-22-22
DESIGNED BY:	KGV
DRAWN BY:	SDM
CHECKED BY:	TDM
FILE NAME:	20876-05CV

DRAWING SCALE:  
HORIZONTAL: N/A  
VERTICAL: N/A

STREET  
PLAN COVER

PROJECT NO. 20876-05CSCV  
DRAWING NO.

CV

SHEET: 1 OF 4

PREPARED BY:

**DREXEL, BARRELL & CO.**  
 Engineers • Surveyors  
 3 SOUTH 7TH STREET  
 COLORADO SPRINGS, COLORADO 80905  
 CONTACT: TIM D. McCONNELL, P.E.  
 (719)260-0887  
 BOULDER • COLORADO SPRINGS • GREELEY

CLIENT:

**POLO BROWN COMPANY**  
 514 PIKE AVENUE  
 CANON CITY, COLORADO 81212  
 (303) 999-5533

CONSTRUCTION DOCUMENTS FOR:  
**WILLOW SPRINGS RANCH**  
**FILING NO. 2**  
**BAPTIST ROAD & FOREST LAKES DRIVE**  
**MONUMENT, COLORADO**

ISSUE	DATE
INITIAL ISSUE	2-22-22
DESIGNED BY:	KGV
DRAWN BY:	SDM
CHECKED BY:	TDM
FILE NAME:	20876-05RD

DRAWING SCALE:  
 HORIZONTAL: 1" = 50'  
 VERTICAL: 1" = 10'

**MOUNTAIN MUHLY DRIVE**  
**PLAN & PROFILE**



PROJECT NO. 20876-05CSCV  
 DRAWING NO.

**MMD**


SHEET: 2 OF 4

**LEGEND**

- PROPERTY LINE .....
- PROPOSED LOT LINE .....
- PROPOSED R.O.W. LINE .....
- PROPOSED STORM SEWER ..... X" RCP
- PROPOSED INTERMEDIATE CONTOUR ..... 6203
- PROPOSED INDEX CONTOUR ..... 6205
- EX. INTERMEDIATE CONTOUR ..... 6203
- EX. INDEX CONTOUR ..... 6205

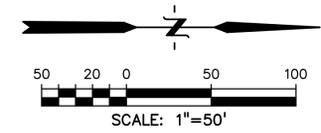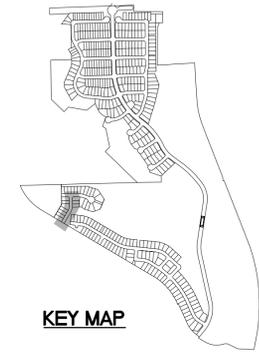


6895	6895	6870	6870
6890	6890	6865	6865
6885	6885	6860	6860
6880	6880	6855	6855
6875	6875	6850	6850
6870	6870	6845	6845
6865	6865	6840	6840
0+25	1+00	2+00	2+75

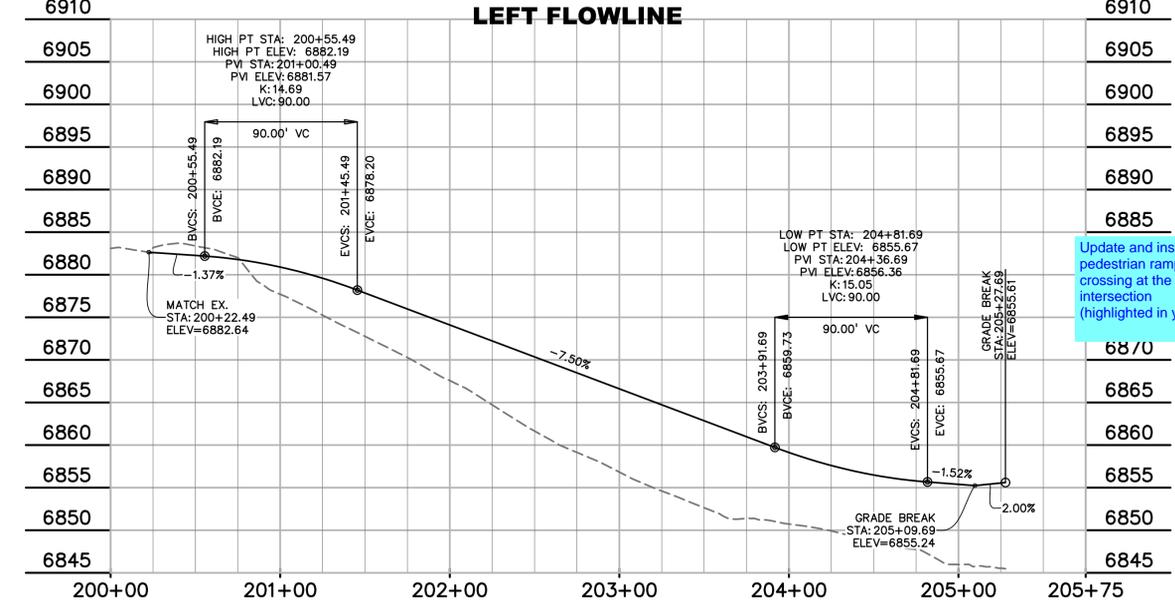


6900	6900	6870	6870
6895	6895	6865	6865
6890	6890	6860	6860
6885	6885	6855	6855
6880	6880	6850	6850
6875	6875	6845	6845
6870	6870	6840	6840
6865	6865	6835	6835
0+25	1+00	2+00	2+75

**RIGHT FLOWLINE**

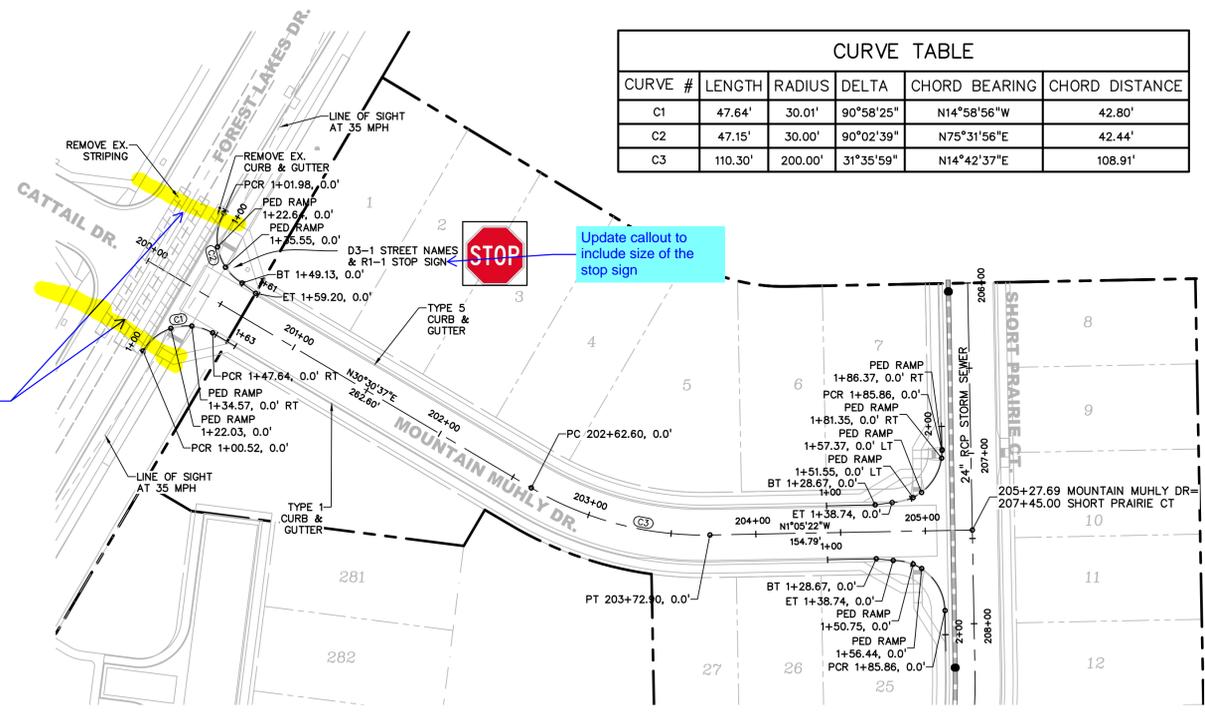

CURVE #	LENGTH	RADIUS	DELTA	CHORD BEARING	CHORD DISTANCE
C1	47.64'	30.01'	90°58'25"	N14°58'56"W	42.80'
C2	47.15'	30.00'	90°02'39"	N75°31'56"E	42.44'
C3	110.30'	200.00'	31°35'59"	N14°42'37"E	108.91'

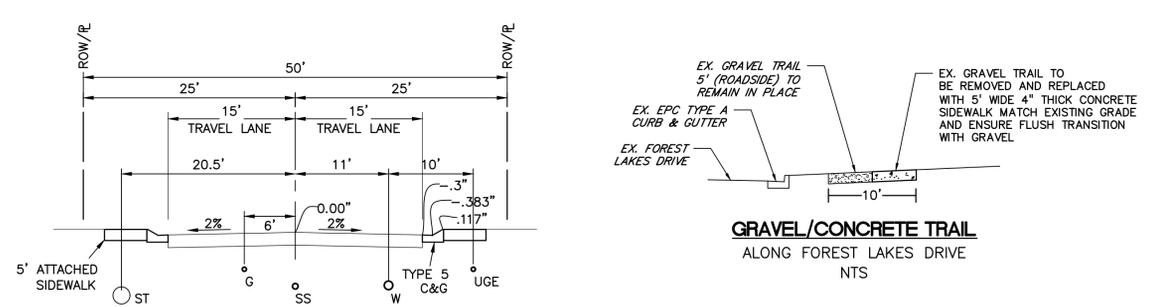

**TYPICAL SECTION - RESIDENTIAL STREET**

**NOTES**

1. COMBINE ALL STOP SIGNS AND D3 STREET NAME SIGNS ON ONE POLE.
2. ALL D3 SIGNS TO BE 4" FONT WHITE LETTERS ON GREEN BACKGROUND (PUBLIC RD).









# CD\_V1 redline.pdf Markup Summary

dsdlaforce (9)

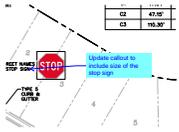


**Subject:** Callout  
**Page Label:** [2] 2 20876-05RD - MMD  
**Author:** dsdlaforce  
**Date:** 3/10/2022 4:49:37 PM  
**Status:**  
**Color:** ■  
**Layer:**  
**Space:**


Update callout to include size of the stop sign

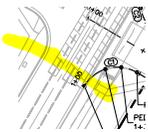

**Subject:** Highlight  
**Page Label:** [2] 2 20876-05RD - MMD  
**Author:** dsdlaforce  
**Date:** 3/10/2022 4:54:48 PM  
**Status:**  
**Color:** ■  
**Layer:**  
**Space:**

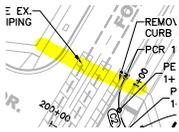

**Subject:** Highlight  
**Page Label:** [2] 2 20876-05RD - MMD  
**Author:** dsdlaforce  
**Date:** 3/10/2022 4:55:45 PM  
**Status:**  
**Color:** ■  
**Layer:**  
**Space:**

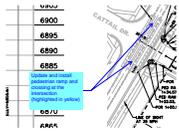

**Subject:** Callout  
**Page Label:** [2] 2 20876-05RD - MMD  
**Author:** dsdlaforce  
**Date:** 3/10/2022 4:55:49 PM  
**Status:**  
**Color:** ■  
**Layer:**  
**Space:**

Update and install pedestrian ramp and crossing at the intersection (highlighted in yellow)



**Subject:** File Attachment  
**Page Label:** [4] 4 20876-05S&D - DT2  
**Author:** dsdlaforce  
**Date:** 3/10/2022 5:05:17 PM  
**Status:**  
**Color:** ■  
**Layer:**  
**Space:**



**Subject:** File Attachment  
**Page Label:** [4] 4 20876-05S&D - DT2  
**Author:** dsdlaforce  
**Date:** 3/10/2022 5:05:19 PM  
**Status:**  
**Color:** ■  
**Layer:**  
**Space:**

PAVERS

Add the County standard signage and striping notes and County standard construction notes. (attached to the left)  
These are applicable for improvements located within the Forest Lake ROW.

**Subject:** Text Box  
**Page Label:** [4] 4 20876-05S&D - DT2  
**Author:** dsdlaforce  
**Date:** 3/10/2022 5:05:24 PM  
**Status:**  
**Color:** ■  
**Layer:**  
**Space:**

Add the County standard signage and striping notes and County standard construction notes. (attached to the left)

These are applicable for improvements located within the Forest Lake ROW.

PEDESTRIAN/RAMP FOR DETECTABLE

Insert the following county details:  
- SD\_2-40 Pedestrian Curb Ramp Detail  
- SD\_2-41 Pedestrian Curb Ramp Detail  
- SD\_2-42 Detectable Warning Surface Details

**Subject:** Text Box  
**Page Label:** [4] 4 20876-05S&D - DT2  
**Author:** dsdlaforce  
**Date:** 3/10/2022 5:05:37 PM  
**Status:**  
**Color:** ■  
**Layer:**  
**Space:**

Insert the following county details:  
- SD\_2-40 Pedestrian Curb Ramp Detail  
- SD\_2-41 Pedestrian Curb Ramp Detail  
- SD\_2-42 Detectable Warning Surface Details

Update the P&P sheet to reference these details for the pedestrian ramps located within the Forest Lakes ROW.

CALLOUT

Add "PCD File No. CDR224"

**Subject:** Callout  
**Page Label:** [2] 2 20876-05RD - MMD  
**Author:** dsdlaforce  
**Date:** 3/10/2022 5:13:41 PM  
**Status:**  
**Color:** ■  
**Layer:**  
**Space:**

Add "PCD File No. CDR224"