

# BENT GRASS EAST COMMERCIAL FILING 3

## A PORTION OF THE NORTHEAST QUARTER OF SECTION 1, TOWNSHIP 13 SOUTH, RANGE 65 WEST OF THE SIXTH PRINCIPAL MERIDIAN, EL PASO COUNTY, COLORADO

### LEGAL DESCRIPTION

TRACT BB AS PLATTED IN BENT GRASS EAST COMMERCIAL FILING NO. 2B RECORDED UNDER RECEPTION NO. 218714172, RECORDS OF EL PASO COUNTY, COLORADO

CONTAINING A CALCULATED AREA OF 219,877 SF, 5.048 ACRES

### GENERAL NOTES

- Private roads are to be paved asphalt with concrete curbs.
- Landscaping in public-rights-of-way, western landscape buffer will be maintained by the Bent Grass Commercial Merchants Association or designee.
- Landscaping along Bent Grass Market View will be provided and maintained by site specific private property owners.
- All streets shall be named and constructed to El Paso County Standards and any approved deviations. Upon acceptance by El Paso County, public streets shall be maintained by the County.
- There shall be no direct lot access to Bent Grass Meadows Drive or Meridian Park Drive.
- Notwithstanding anything depicted in this plan in words or graphic representation, all design and construction related to roads, storm drainage and erosion control shall conform to the standards and requirements of the most recent version of the relevant adopted El Paso County standards, including the Land Development Code (LDC), the ECM, the Drainage Criteria Manual (DCM), and the DCM Volume 2. Any deviations from these standards must be specifically requested and approved in writing to be acceptable. The approval of this Preliminary Plan does not implicitly allow any deviations or waivers that have not been otherwise approved through the deviation approval process.
- The following utility providers will serve the Bent Grass East Commercial Filing 3 Preliminary Plan area:  
Water: Woodmen Hills Metropolitan District  
Wastewater: Woodmen Hills Metropolitan District  
Gas: CSU  
Electric: MVEA
- Easements: Unless otherwise indicated, all side, front, and rear lot lines are hereby platted on either side with a 10 foot (5 feet for lots smaller than 2.5 acres) public utility and drainage easement unless otherwise indicated. All exterior subdivision boundaries are hereby platted with a 20 foot (7 feet for lots smaller than 2.5 acres) public utility and drainage easement. The sole responsibility for maintenance of these easements is hereby vested with the individual property owners.
- All access driveways, drivers, aisles, maneuvering and parking areas, and easement shall be for the common use and maintenance of all users, public or private, and owners of this development. Free and unimpeded vehicular and pedestrian movements shall be maintained and permitted across all property lines at all times regardless of future ownership or platting actions.
- All property within this subdivision is within the boundaries of the Woodmen Road Metropolitan District and, as such, is subject to a mill levy, platting fees and building permit fees for the purpose of financing construction of specified improvements to Woodmen Road.
- The private roads as shown on this plat will not be maintained by El Paso County until and unless the streets are constructed in conformance with El Paso County standards in effect at the date of the request for dedication and maintenance.
- Pedestrian ramp locations may change subject to lot access on individual site development plan.
- All lots will be required to provide adequate pedestrian facilities with individual site development plans.

### FEMA FLOODPLAIN NOTE

- Floodplain Statement: This site located at 8090 MERIDIAN PARK DR is not within a designated F.E.M.A. Floodplain as determined by the flood insurance rate map, community panel number 08041C0553G, effective December 07, 2018.


### GEOLOGIC HAZARD DISCLOSURE STATEMENT

The following lots have been found to be impacted by geologic hazards. Mitigation measures and a map of the hazard area can be found in the Geohazard Evaluation Report prepared by Entech Engineering Inc., dated 10 15, 2020. These reports are held in the Bent Grass Commercial Preliminary Plan File (SP2010) at the El Paso County Planning and Community Development Department.


- Potentially Seasonally High Groundwater: Lots 1-6
- Other Hazard:
  - Artificial Fill: Eastern portion of the site.
  - Loose Soils: Lots 1-6.

In Areas of High Groundwater: Lots 1-6

All foundations shall comply with recommendations in the Soils & Geology Report. Where necessary, interceptor drains or underslab drains may be necessary where foundations encroach the ground water table.

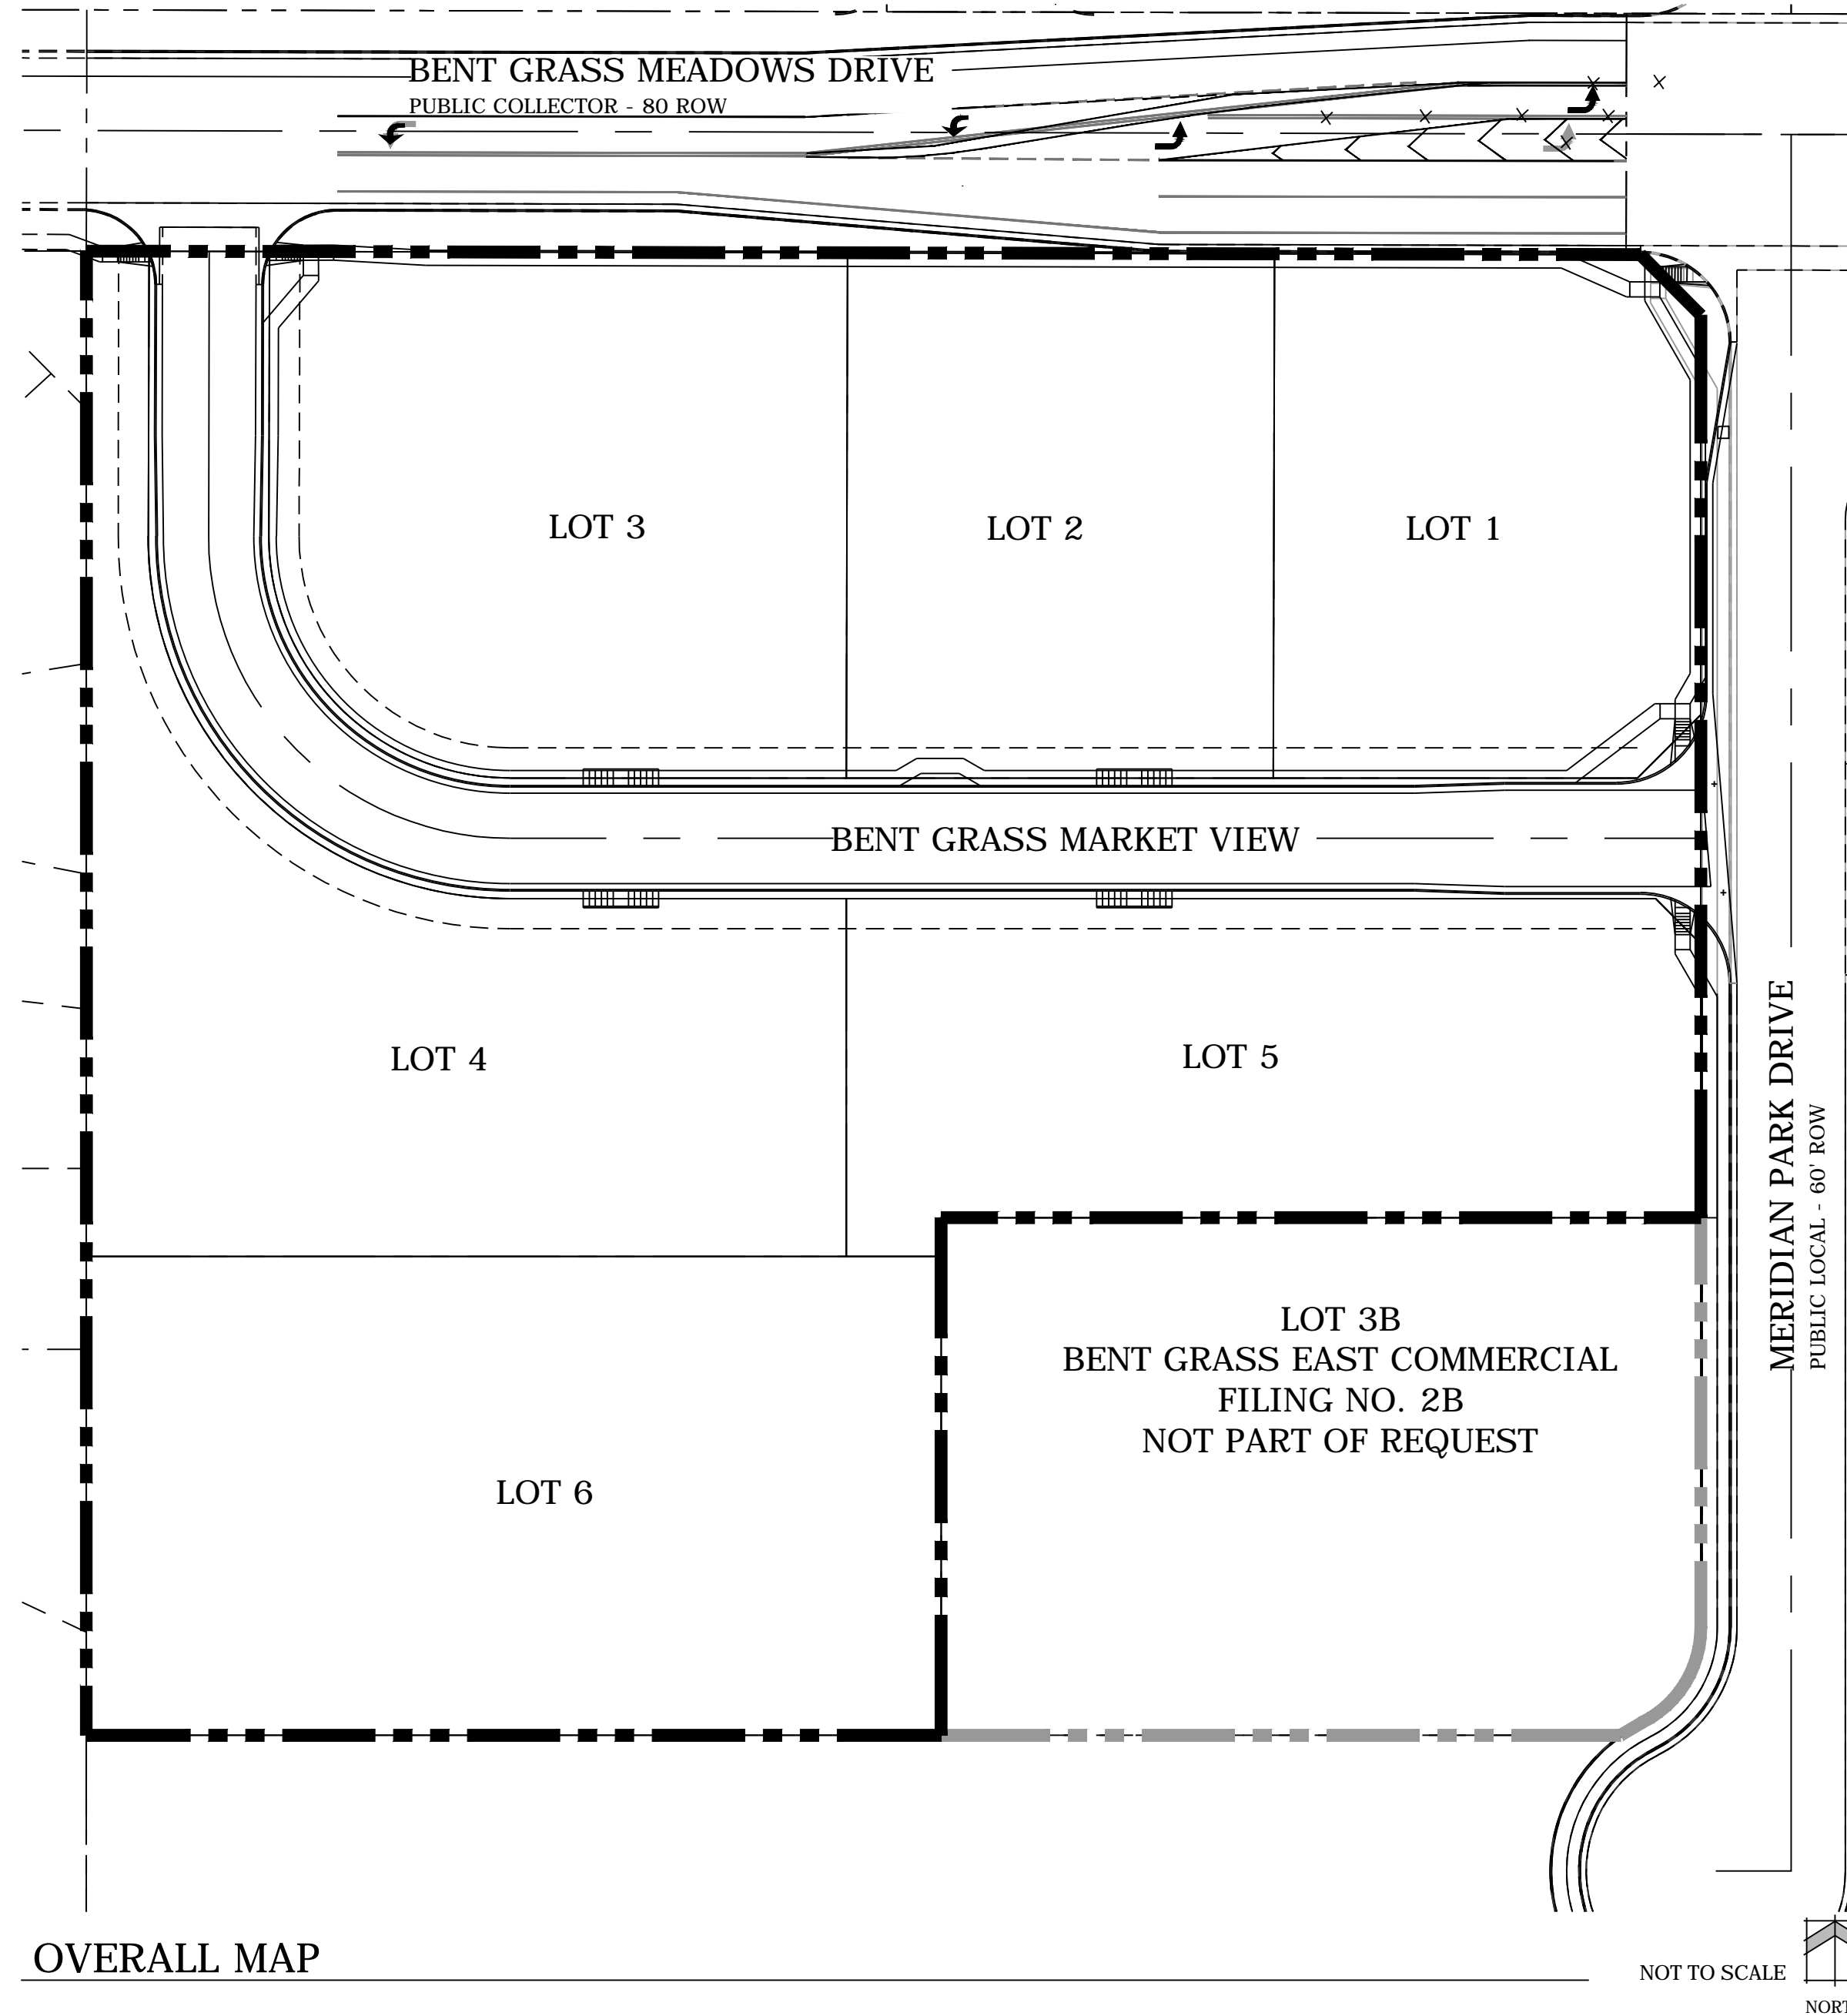

### VICINITY MAP

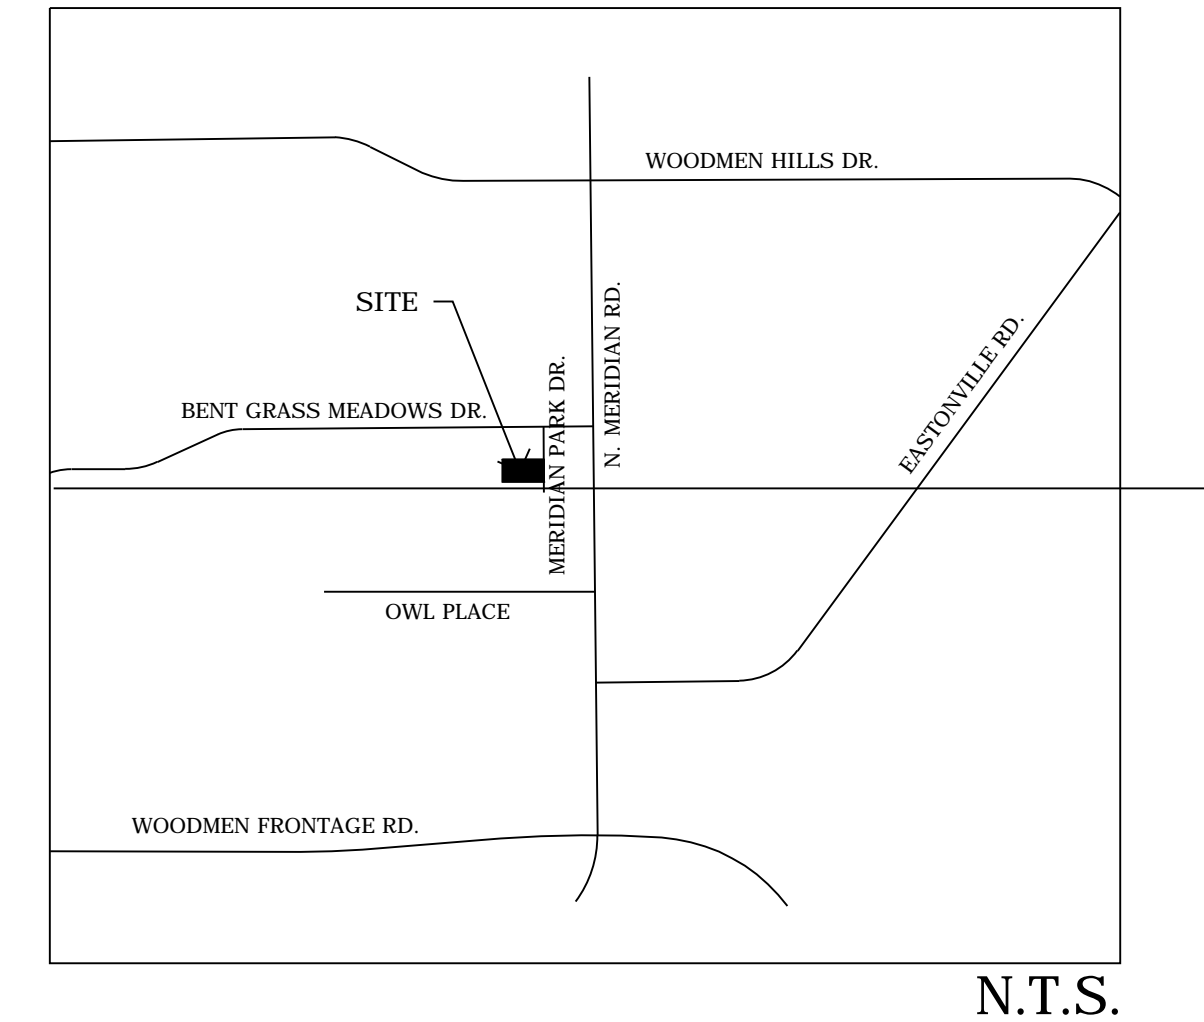

### SITE DATA

**OWNER:**  
LAND FIRST INC.  
1378 PROMONTORY BLUFF VW  
COLORADO SPRINGS CO 80921-3945

**PREPARED BY:**  
NES INC.  
619 N. CASCADE AVE STE 200  
COLORADO SPRINGS, CO 80903

Tax ID Number: 5301101060

Current Zoning: CS

**Building Setbacks**  
Front: 25'  
Side: 25'  
Rear: 25'  
Maximum Height: 45'

**Landscape Setback:**  
Bent Grass Meadows Drive: 10'  
Bent Grass Market View: 10'  
Meridian Park Drive: 10'

**Landscape Buffer:**  
West Boundary: 15'  
North Boundary: 15'

Development Schedule: Fall 2021


Proposed Land Use: Commercial

**Land Use:**  
Lots: 4.54 ac - 6 Lots (90%)  
Tract A (Private Road): 0.51 ac (10%)  
Total Area: 5.05 ac (219,875 SF)

\*Tracts are to be maintained by the Bent Grass Merchants Association

### SHEET INDEX

Sheet 1 of 7:	COVER SHEET
Sheet 2 of 7:	ADJACENT PROPERTIES & TRACT MAP
Sheet 3 of 7:	PRELIMINARY PLAN
Sheet 4 of 7:	PRELIMINARY GRADING PLAN
Sheet 5 of 7:	PRELIMINARY UTILITIES
Sheet 6 of 7:	LANDSCAPE NOTES AND DETAILS
Sheet 7 of 7:	LANDSCAPE PLAN

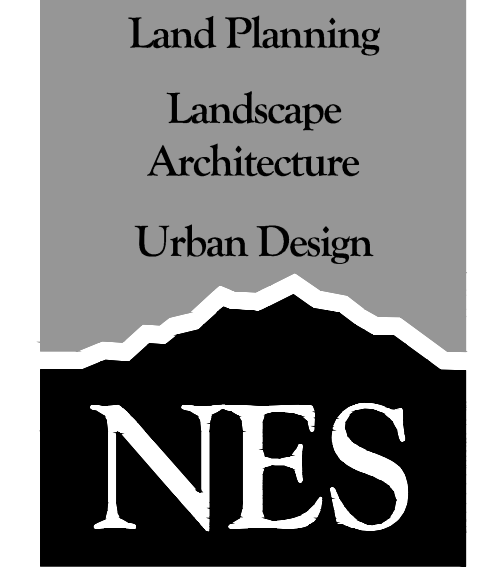

N.E.S. Inc.  
619 N. Cascade Avenue, Suite 200  
Colorado Springs, CO 80903

Tel. 719.471.0073  
Fax 719.471.0267

www.nescolorado.com

© 2012 All Rights Reserved

## BENT GRASS EAST COMMERCIAL FILING 3

### PRELIMINARY PLAN

8090 MERIDIAN PARK DR  
EL PASO COUNTY, CO

DATE: 11.18.20  
PROJECT MGR: A. BARLOW  
PREPARED BY: J. SHAGIN

### ENTITLEMENT

DATE: BY: DESCRIPTION:

### COVER SHEET


# 1

1 OF 7

PCD#: SP-20-010

# BENT GRASS EAST COMMERCIAL FILING 3

## A PORTION OF THE NORTHEAST QUARTER OF SECTION 1, TOWNSHIP 13 SOUTH, RANGE 65 WEST OF THE SIXTH PRINCIPAL MERIDIAN, EL PASO COUNTY, COLORADO

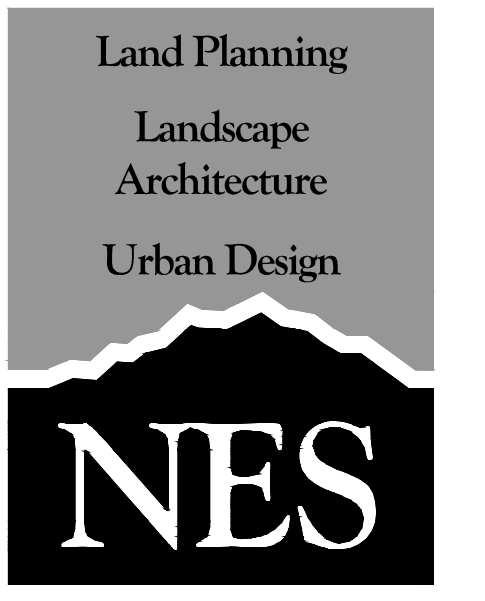


N.E.S. Inc.  
619 N. Cascade Avenue, Suite 200  
Colorado Springs, CO 80903  
Tel. 719.471.0073  
Fax 719.471.0267  
www.nescolorado.com  
© 2012 All Rights Reserved

**ADJACENT OWNER'S TABLE:**

Name	Mailing Address	City, State, Zip	Subdivision
1 GLEESON, MATTHEW R GRUBESIC, ABIGAIL L	11739 SEDGE CT	PEYTON CO, 80831-6739	BENTGRASS RESIDENTIAL FILING NO. 1 PUD
2 CHASE, BRUCE L CHASE, LINDA S	11745 SEDGE CT	PEYTON CO, 80831-6739	BENTGRASS RESIDENTIAL FILING NO. 1 PUD
3 BOGSTAD, DEVAN M MARKLE, ALYSSA M	11751 SEDGE CT	PEYTON CO, 80831-6739	BENTGRASS RESIDENTIAL FILING NO. 1 PUD
4 JIMENEZ-DIAZ, ANDRES A ACOSTA-ORTIZ, KARLA J	11757 SEDGE CT	PEYTON CO, 80831-6739	BENTGRASS RESIDENTIAL FILING NO. 1 PUD
5 MARCZYK JEREMY THOMAS	11763 SEDGE CT	PEYTON CO, 80831-6739	BENTGRASS RESIDENTIAL FILING NO. 1 PUD
6 GROSS JAMES	11769 SEDGE CT	PEYTON CO, 80831-6739	BENTGRASS RESIDENTIAL FILING NO. 1 PUD
7 WAWRZYNIAK, KEITH P WAWRZYNIAK, NANCY A	15620 EASTONVILLE RD	ELBERT CO, 80106-8818	BENTGRASS RESIDENTIAL FILING NO. 1 PUD
8 GUDGEON DAVID GUDGEON KELSEY	11781 SEDGE CT	PEYTON CO, 80831-6739	BENTGRASS RESIDENTIAL FILING NO. 1 PUD
9 WILMORE JUNCTION LLC	7850 N MERIDIAN RD	PEYTON CO, 80831-6739	UNPLATTED
10 INTERNATIONAL DEVELOPMENT COMPANY	102 E PIKES PEAK AVE STE 201	COLORADO SPRINGS CO, 80903-1823	UNPLATTED
11 MDC COAST 6 LLC	11995 EL CAMINO REAL	SAN DIEGO CA, 92130-2539	BENTGRASS EAST COMMERCIAL FILING NO. 1
12 REILLY, RAYMOND L JR REILLY, TANYA T CASE, LINDSAY J CASE, R W II	102 E. PIKES PEAK AVE #201	COLORADO SPRINGS CO, 80903-1823	BENTGRASS EAST COMMERCIAL FILING NO. 2A
13 8011 PROPERTIES LLC	8011 MERIDIAN PARK DR	PEYTON, CO 80831-8128	BENTGRASS EAST COMMERCIAL FILING NO. 2A
14 CLARK, AMY DVM PROPERTIES LLC	8036 MERIDIAN PARK DRIVE	PEYTON, CO 80831-8128	BENTGRASS EAST COMMERCIAL FILING NO. 2B
15 BENT GRASS METRO DISTRICT	660 SOUTHPOINTE CT STE 210	COLORADO SPRINGS CO, 80906-3874	BENTGRASS EAST COMMERCIAL FILING NO. 2

**TRACT USE CHART:**

	AREA		USE	Ownership/Maintenance
	SQ. FT.	AC.		
Bent Grass Market View	22,099	0.51	Private Road, Drainage and Utility Access	Bent Grass Commercial Merchants Association

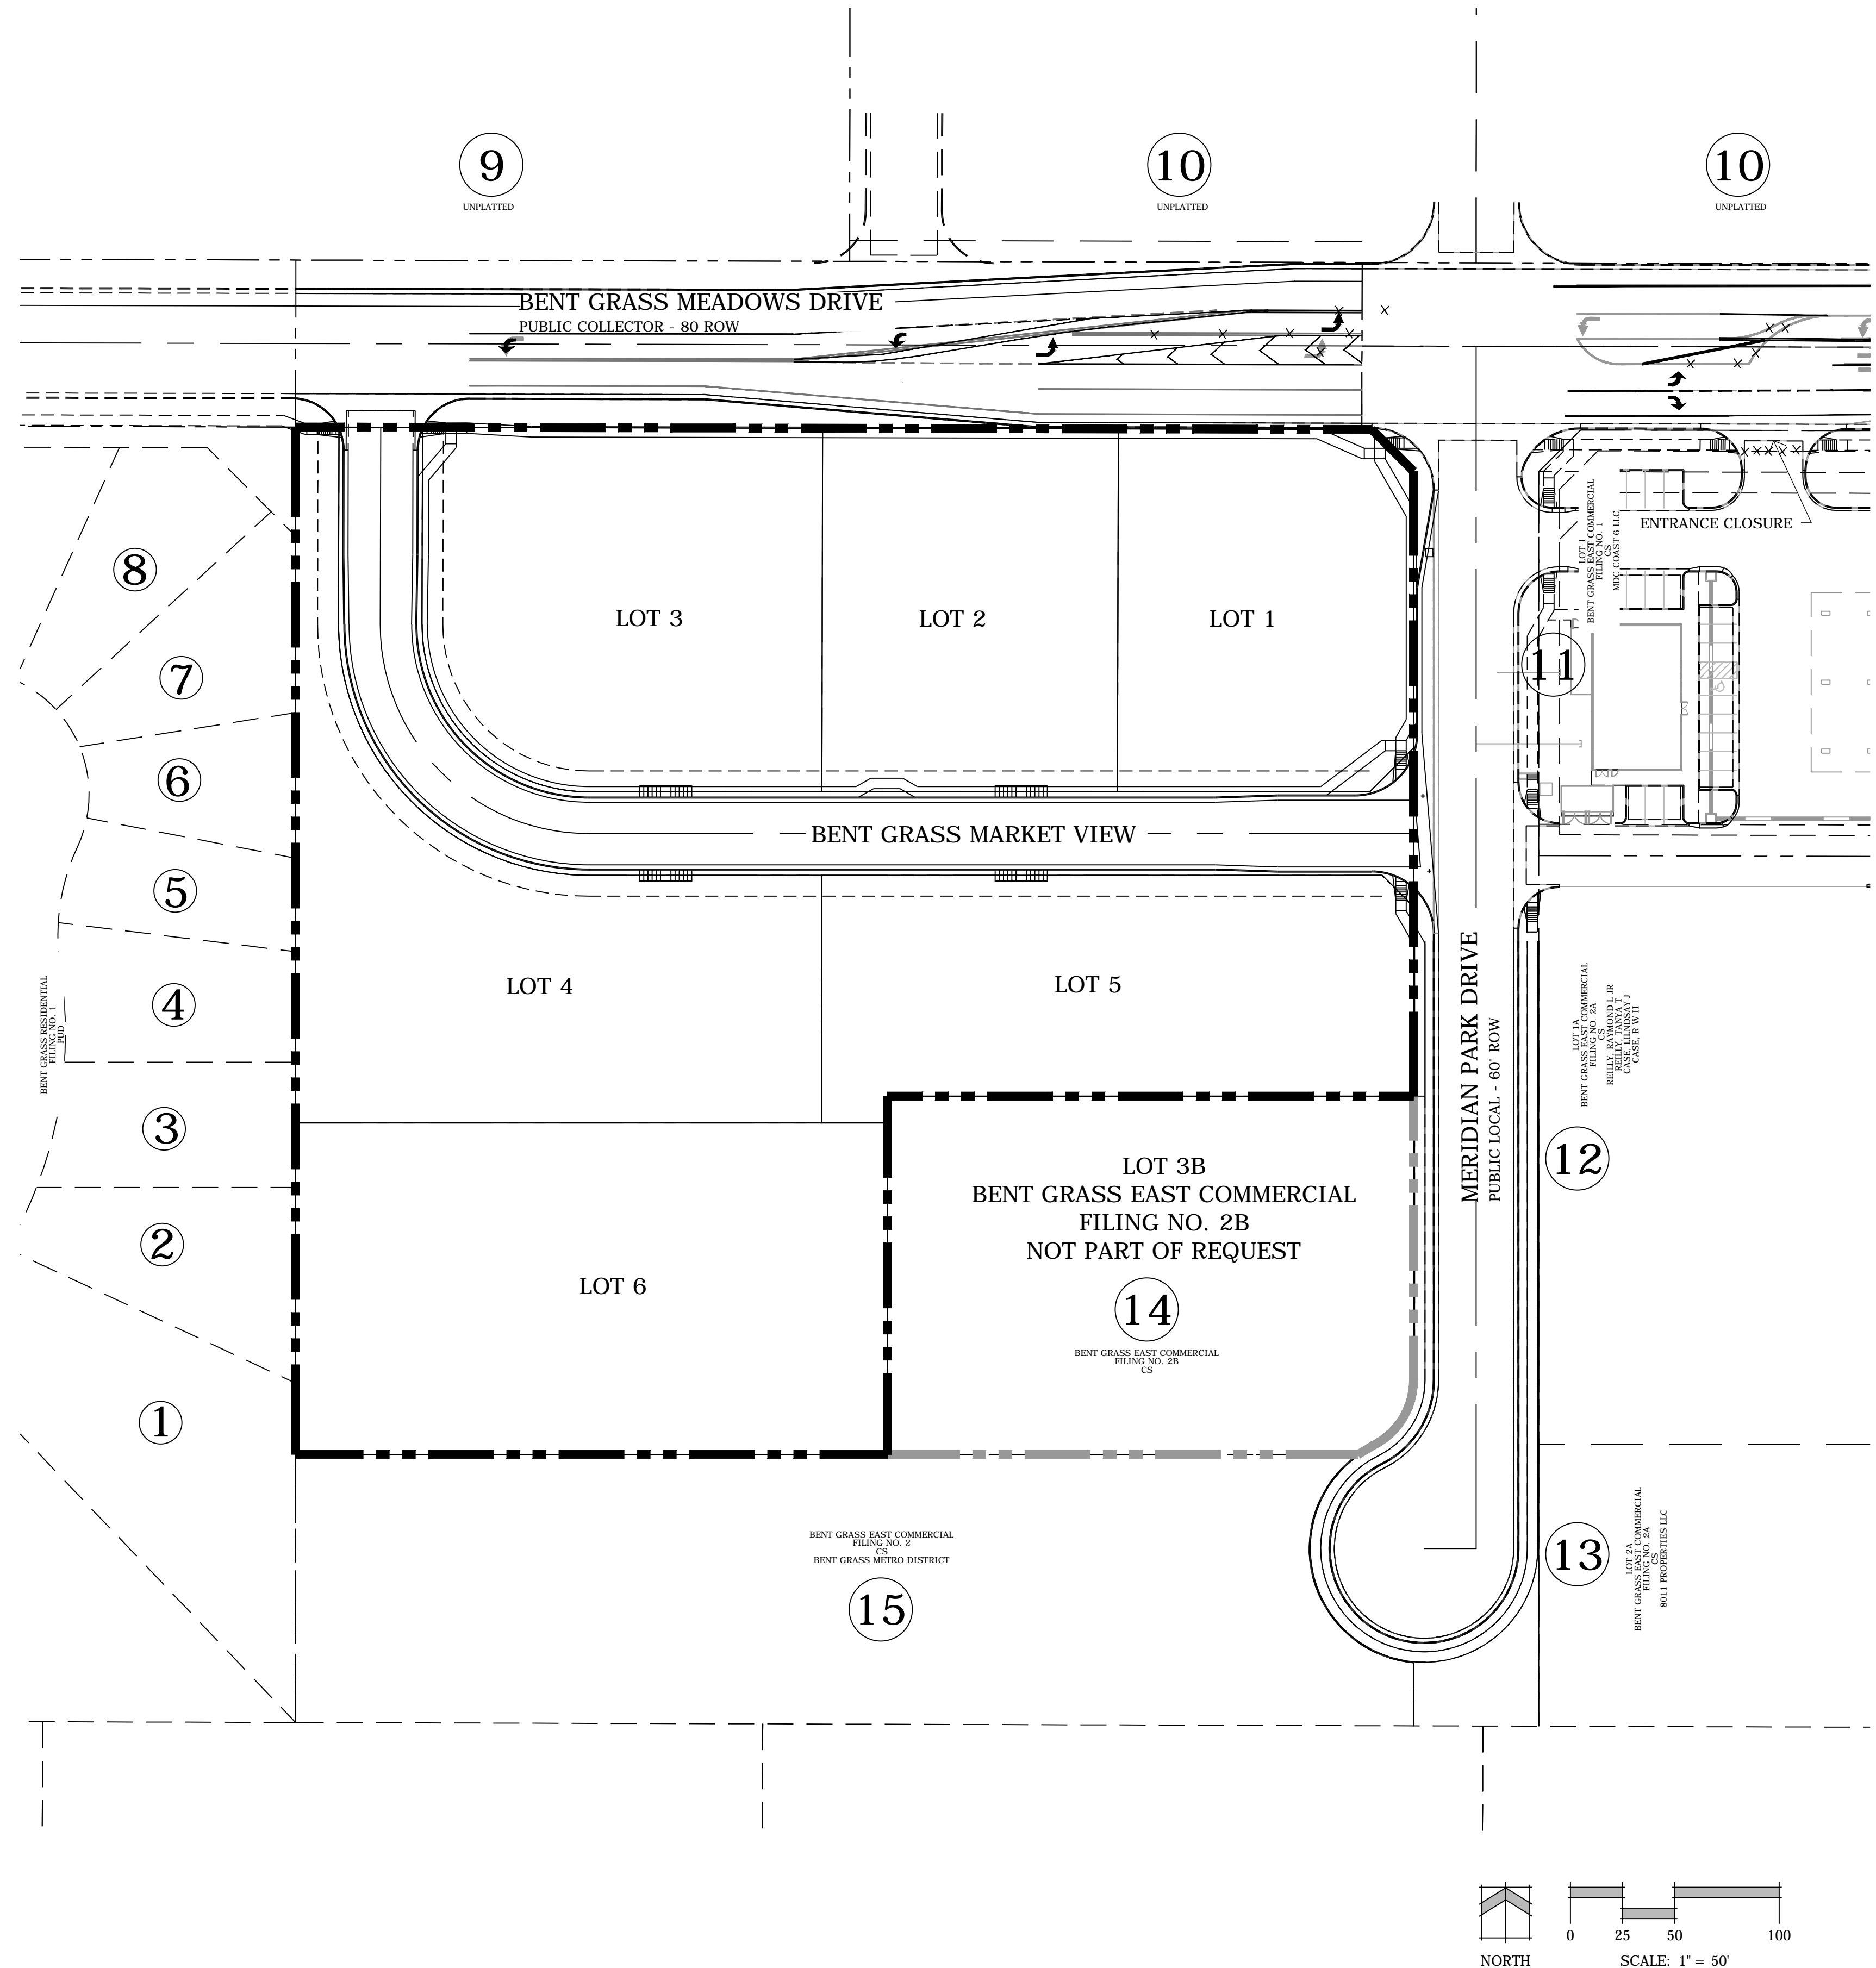

**BENT GRASS  
EAST  
COMMERCIAL  
FILING 3  
PRELIMINARY PLAN**

8090 MERIDIAN PARK DR  
EL PASO COUNTY, CO

DATE: 11.16.20  
PROJECT MGR: A. BARLOW  
PREPARED BY: J. SHAGIN

**ENTITLEMENT**

DATE:	BY:	DESCRIPTION:

**ADJACENT PROPERTY  
OWNERS AND TRACT  
MAP**

2

2 OF 7


PCD#: SP-20-010

P:\Land Plans\Bent Grass East Commercial Filing 3 Drawings\Planning\Develop\Bentgrass Commercial\_PrelimPlan\_CONCEPT 2 - TRACT A Show\Bentgrass-Develop\Bentgrass-Property Owners & Tract Map.dwg 8/17/2021 4:55:30 PM Jennifer Shagin



# BENT GRASS EAST COMMERCIAL FILING 3

A PORTION OF THE NORTHEAST QUARTER OF SECTION 1, TOWNSHIP 13 SOUTH,  
RANGE 65 WEST OF THE SIXTH PRINCIPAL MERIDIAN,  
EL PASO COUNTY, COLORADO

Please revise the stripping to reflect the TWLT variation exhibit that LSC sent via email and incorporate staff comments. Please see the exhibit that is uploaded to EDARP (also attached)

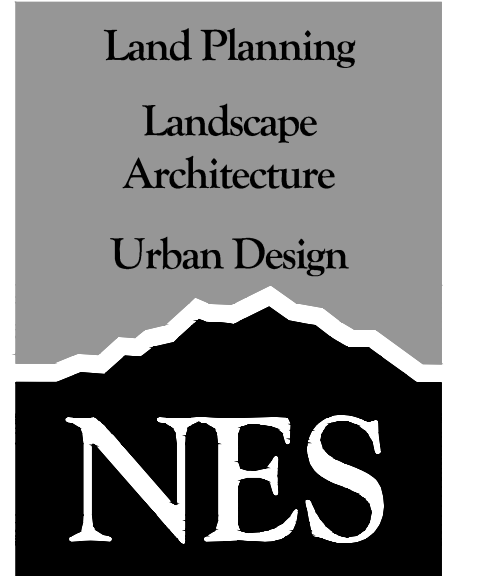

N.E.S. Inc.  
619 N. Cascade Avenue, Suite 200  
Colorado Springs, CO 80903  
Tel. 719.471.0073  
Fax 719.471.0267  
www.nescolorado.com  
© 2012 All Rights Reserved

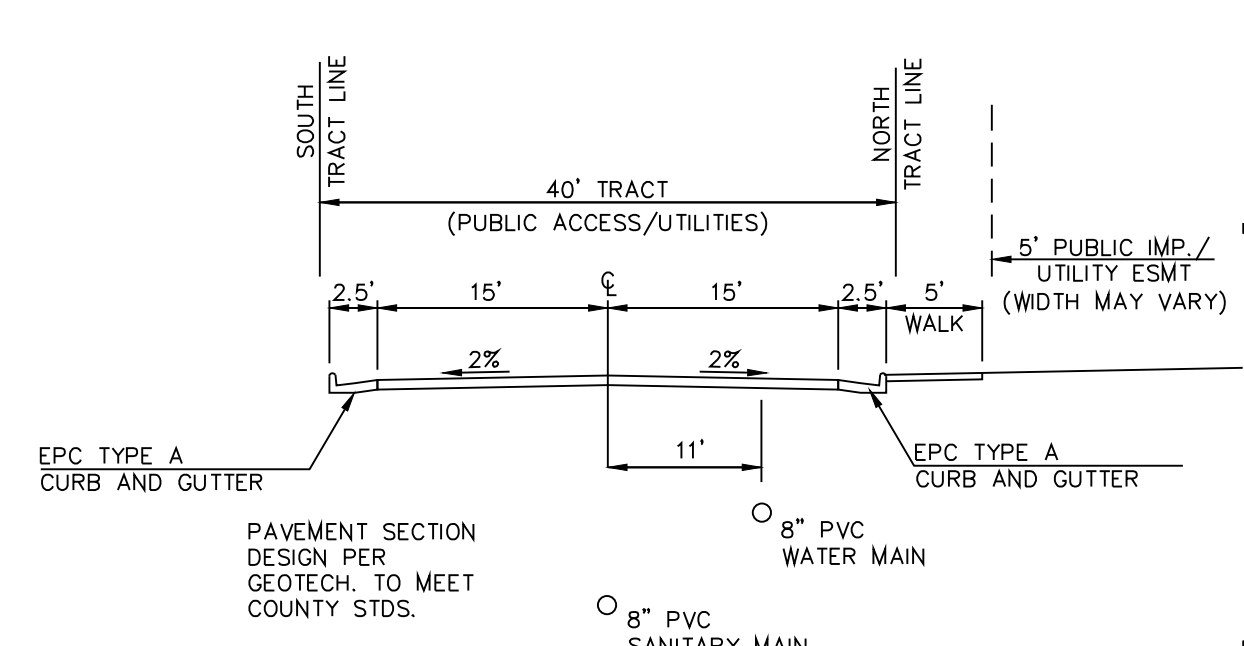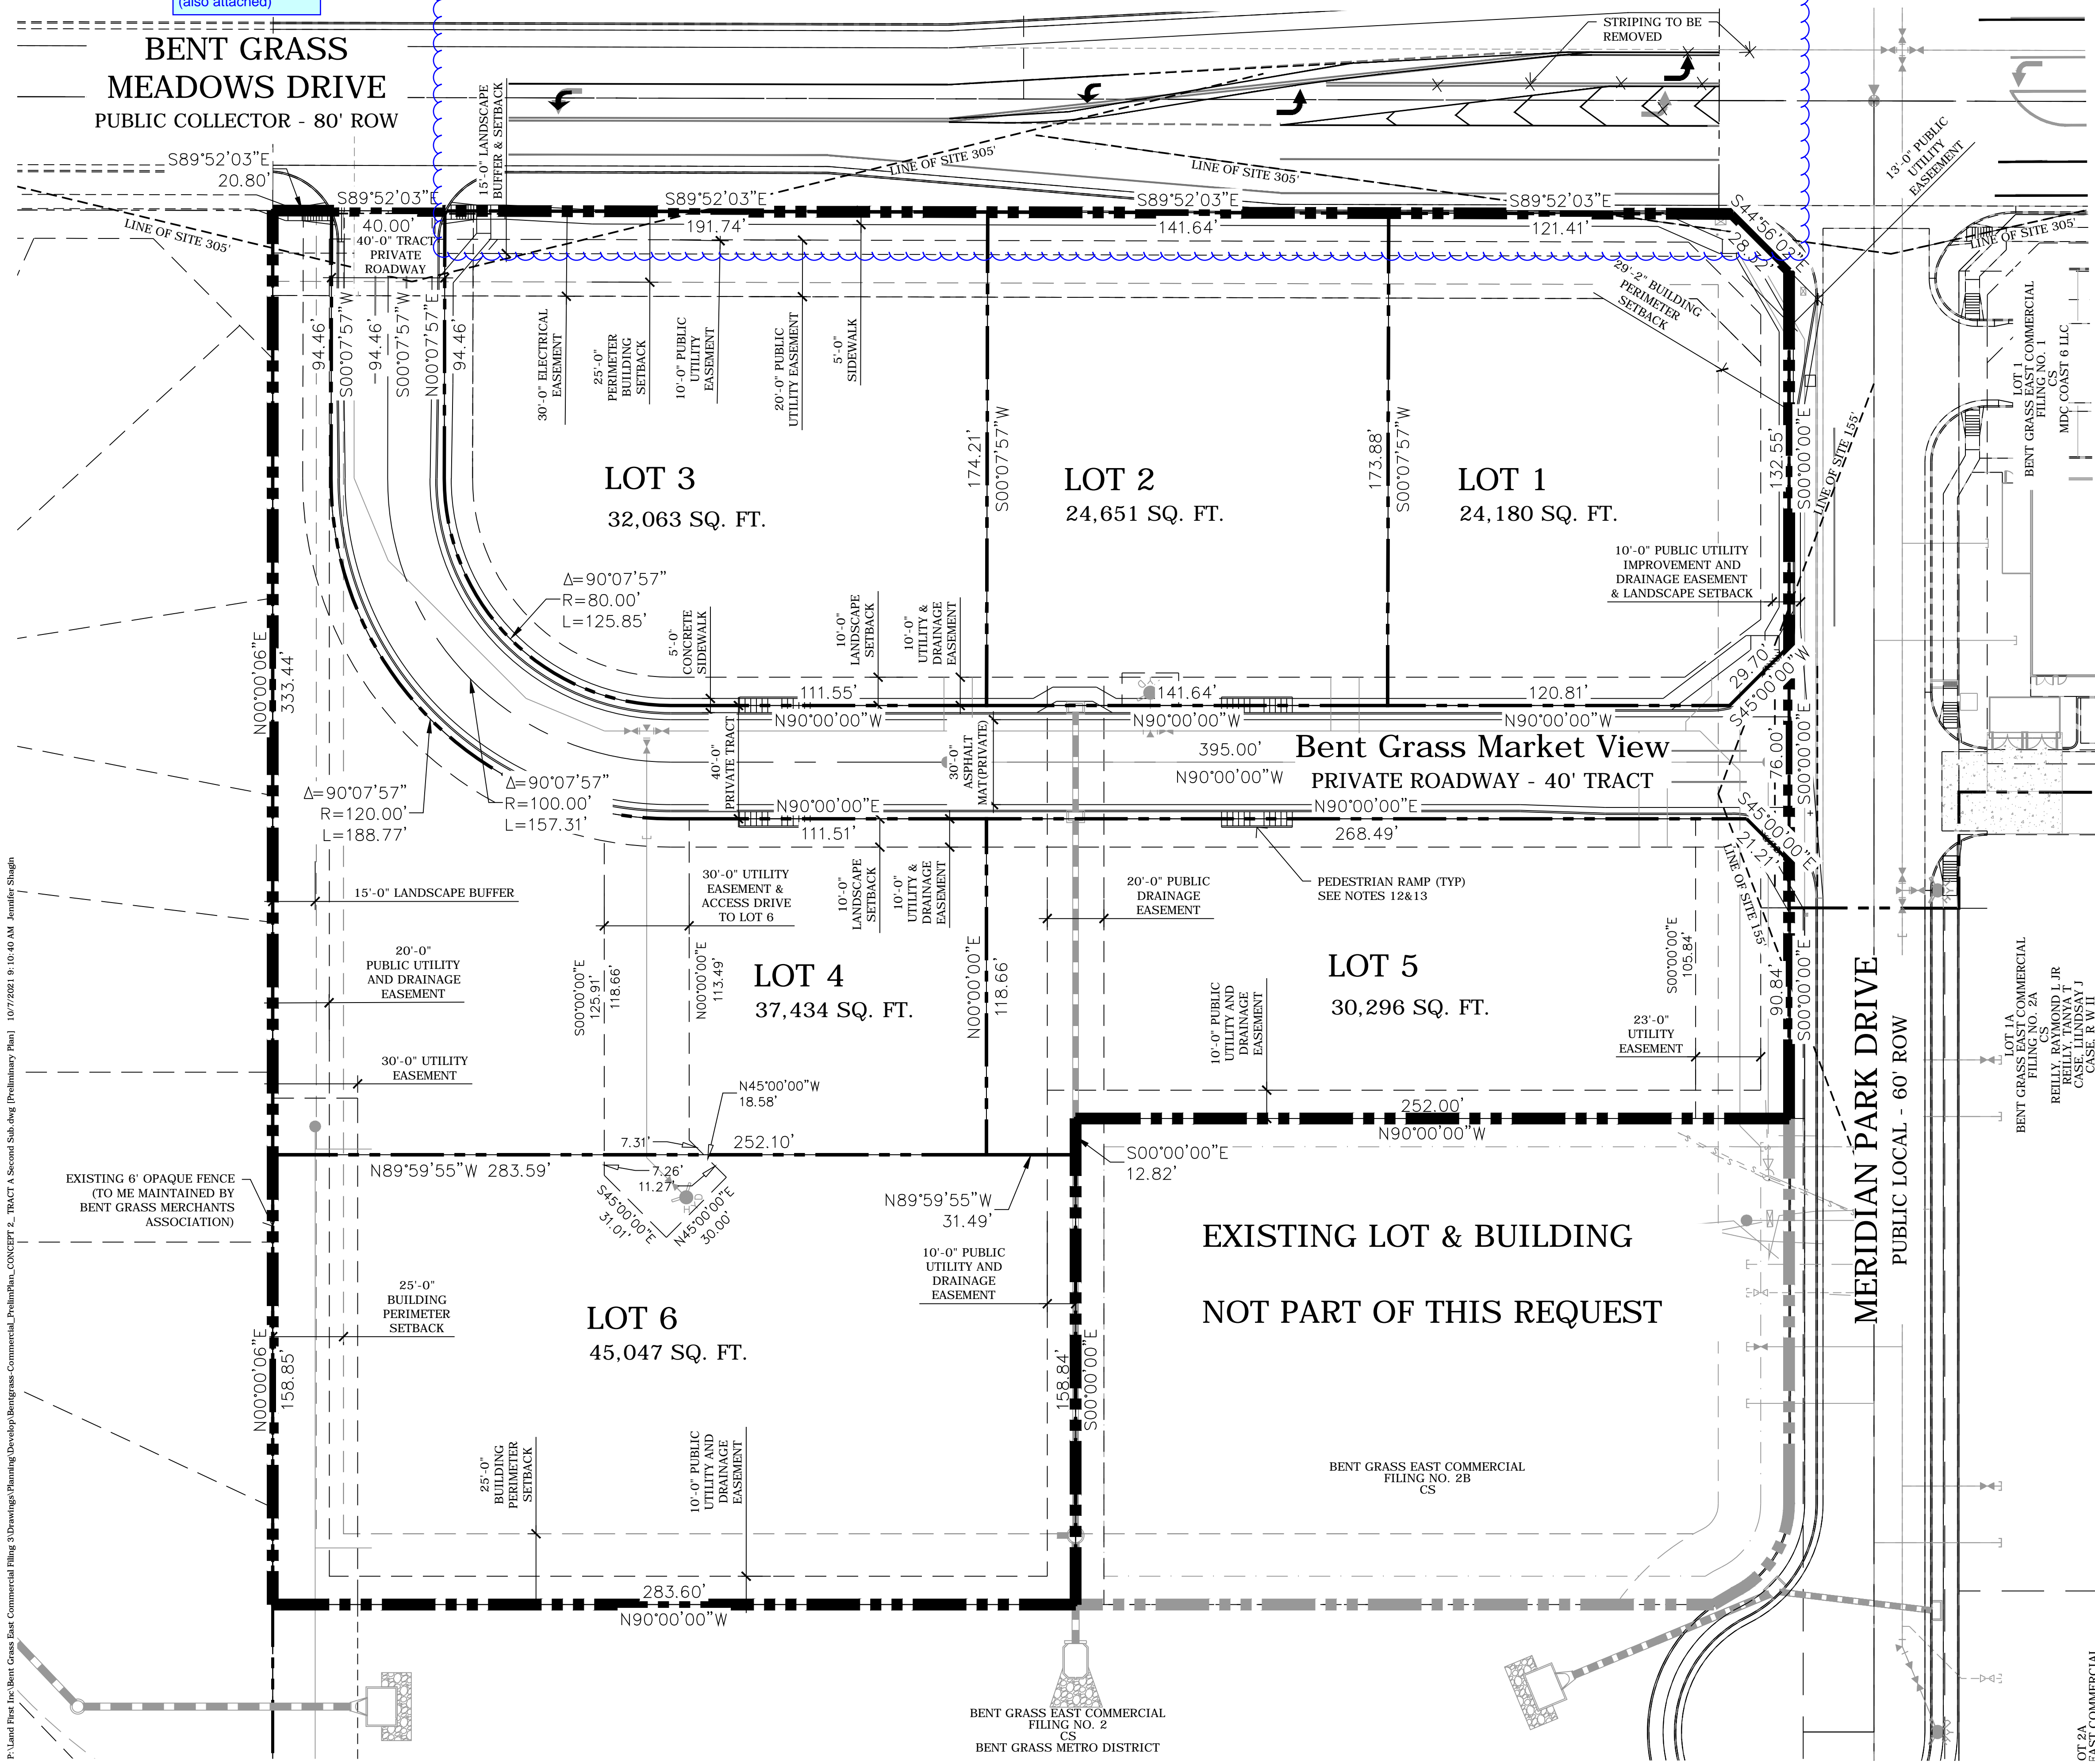

**BENT GRASS EAST COMMERCIAL FILING 3**  
PRELIMINARY PLAN  
8090 MERIDIAN PARK DR  
EL PASO COUNTY, CO

DATE: 11.16.20  
PROJECT MGR: A. BARLOW  
PREPARED BY: J. SHAGIN

ENTITLEMENT


DATE:	BY:	DESCRIPTION:

PRELIMINARY PLAN


**3**  
3 OF 7  
PCD#: SP-20-010

P:\Land Plans\Bent Grass East Commercial\Filing 3\Drawings\Planning\Development\BentGrassCommercial\_PrelimPlan\_Concept 2 - TRACT A Second Sub.dwg [Preliminary Plan] 10/7/2021 10:40 AM Jennifer Shagin

Please update per comment on the preliminary plan.

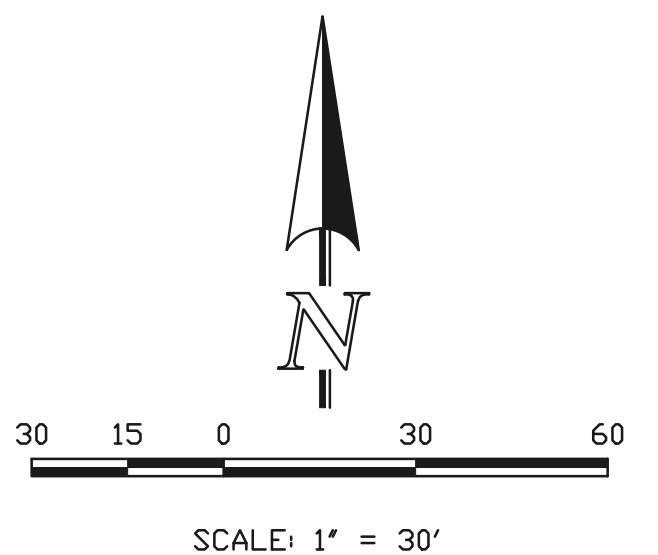



DESCRIPTION	SYMBOL
PROPOSED CONTOUR-10	
PROPOSED CONTOUR-2	
EXISTING CONTOUR-10	
EXISTING CONTOUR-2	
PROPERTY LINE	
BOUNDARY LINE	
PROPOSED PRIVATE STORM SEWER	
PROPOSED STORM INLET	
EXISTING STORM SEWER	
EXISTING STORM INLET	
EXISTING FIRE HYDRANT	
EXISTING WATER MAIN	
EXISTING SANITARY SEWER MAIN W/ MANHOLE	
PROPOSED SANITARY	
PROPOSED WATER	
LIMITS OF DISTURBANCE	
EXISTING FLOW DIRECTION	
PROPOSED FLOW	
HIGH POINT	HP
LOW POINT	LP
OVERFLOW ROUTE	

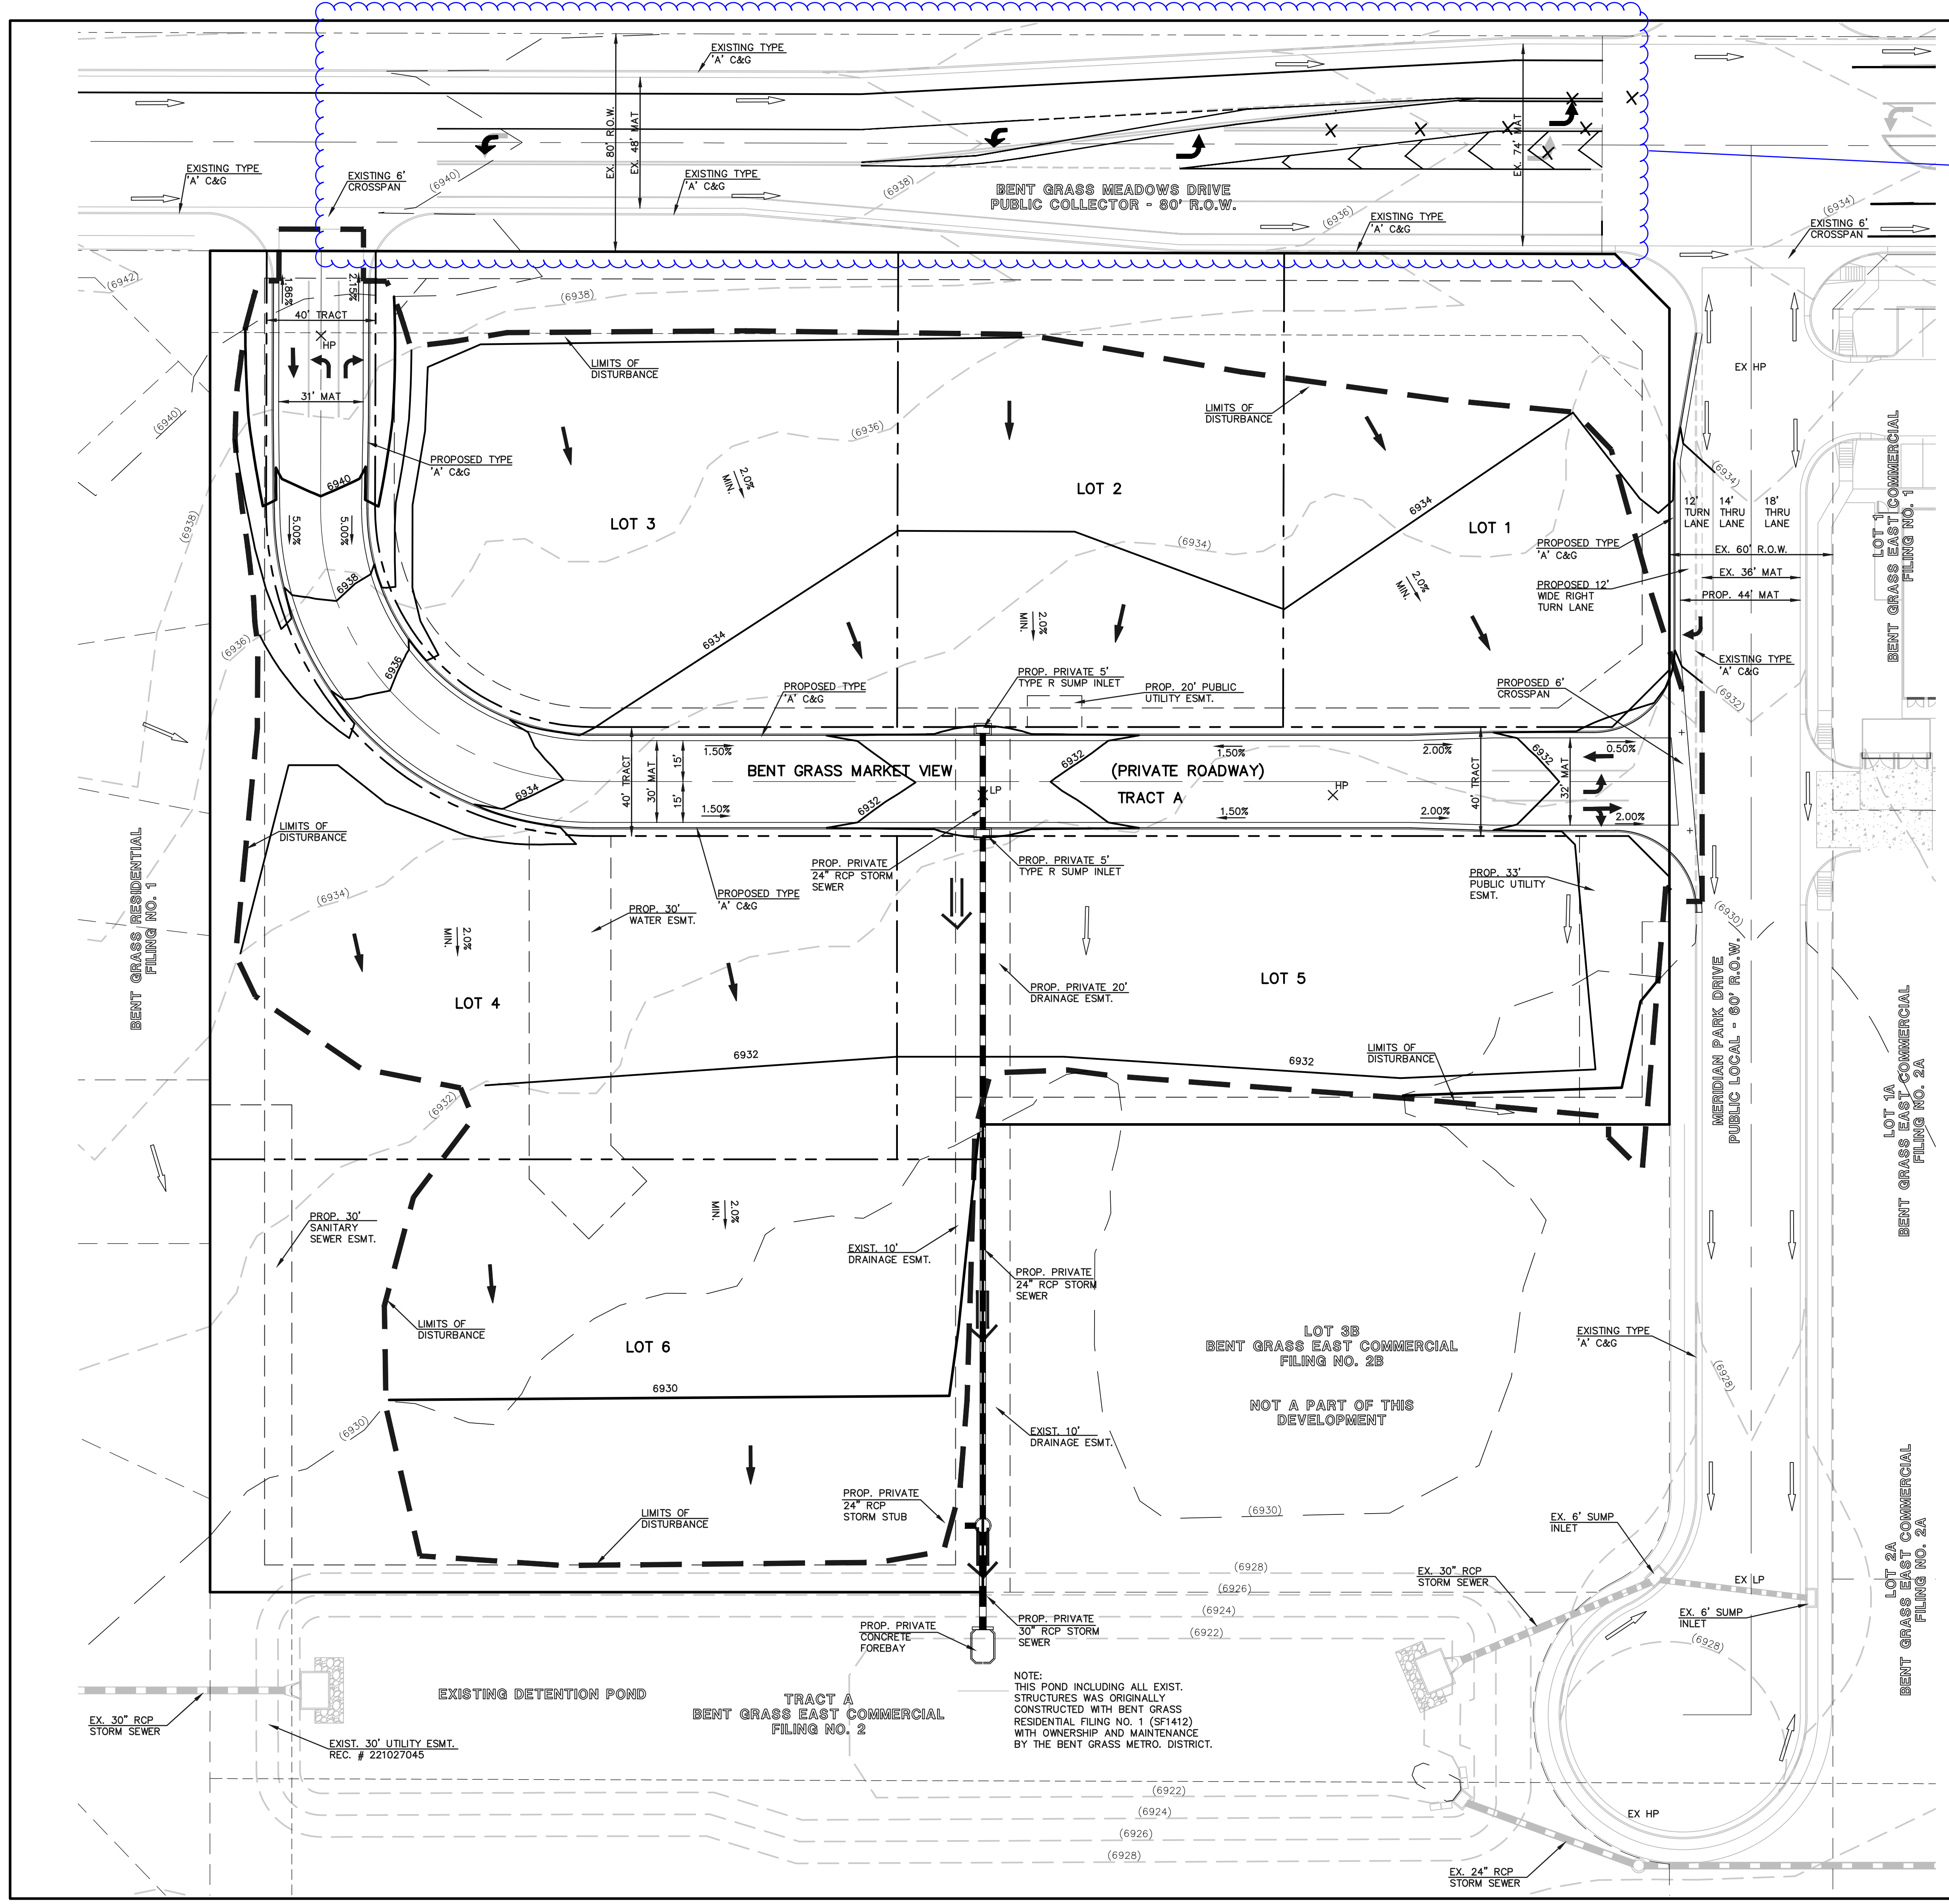


<b>BENT GRASS EAST COMMERCIAL FILING NO. 3</b>			
PRELIMINARY PLAN			
PRELIMINARY GRADING PLAN			
DESIGNED BY	PRA	SCALE	DATE 10-27-20
DRAWN BY	PRA	(H) 1" = 30'	SHEET 4 OF 7
CHECKED BY	(V) 1" = N/A	JOB NO.	2177.64

619 N. Cascade Avenue, Suite 200  
 Colorado Springs, Colorado 80903  
 (719) 785-0790  
 (719) 785-0799 (Fax)

N:\217764\DRAWINGS\DEVELOPMENT\217764-PC-01.dwg, 8/30/2021 12:34:36 PM, 1:1

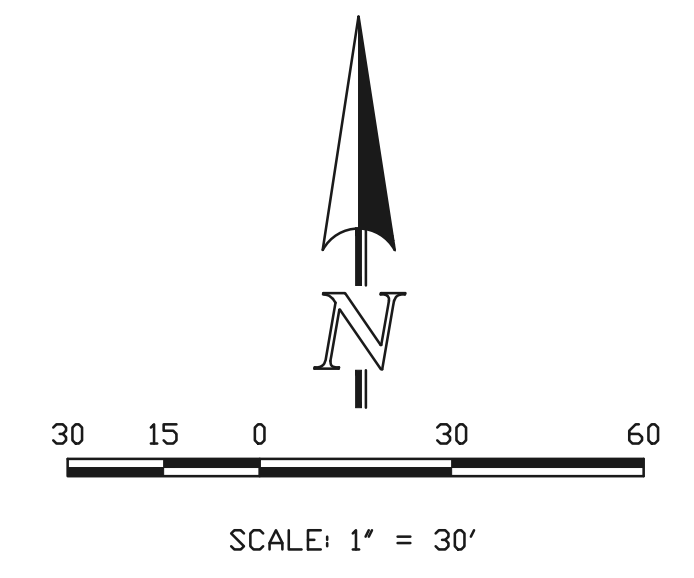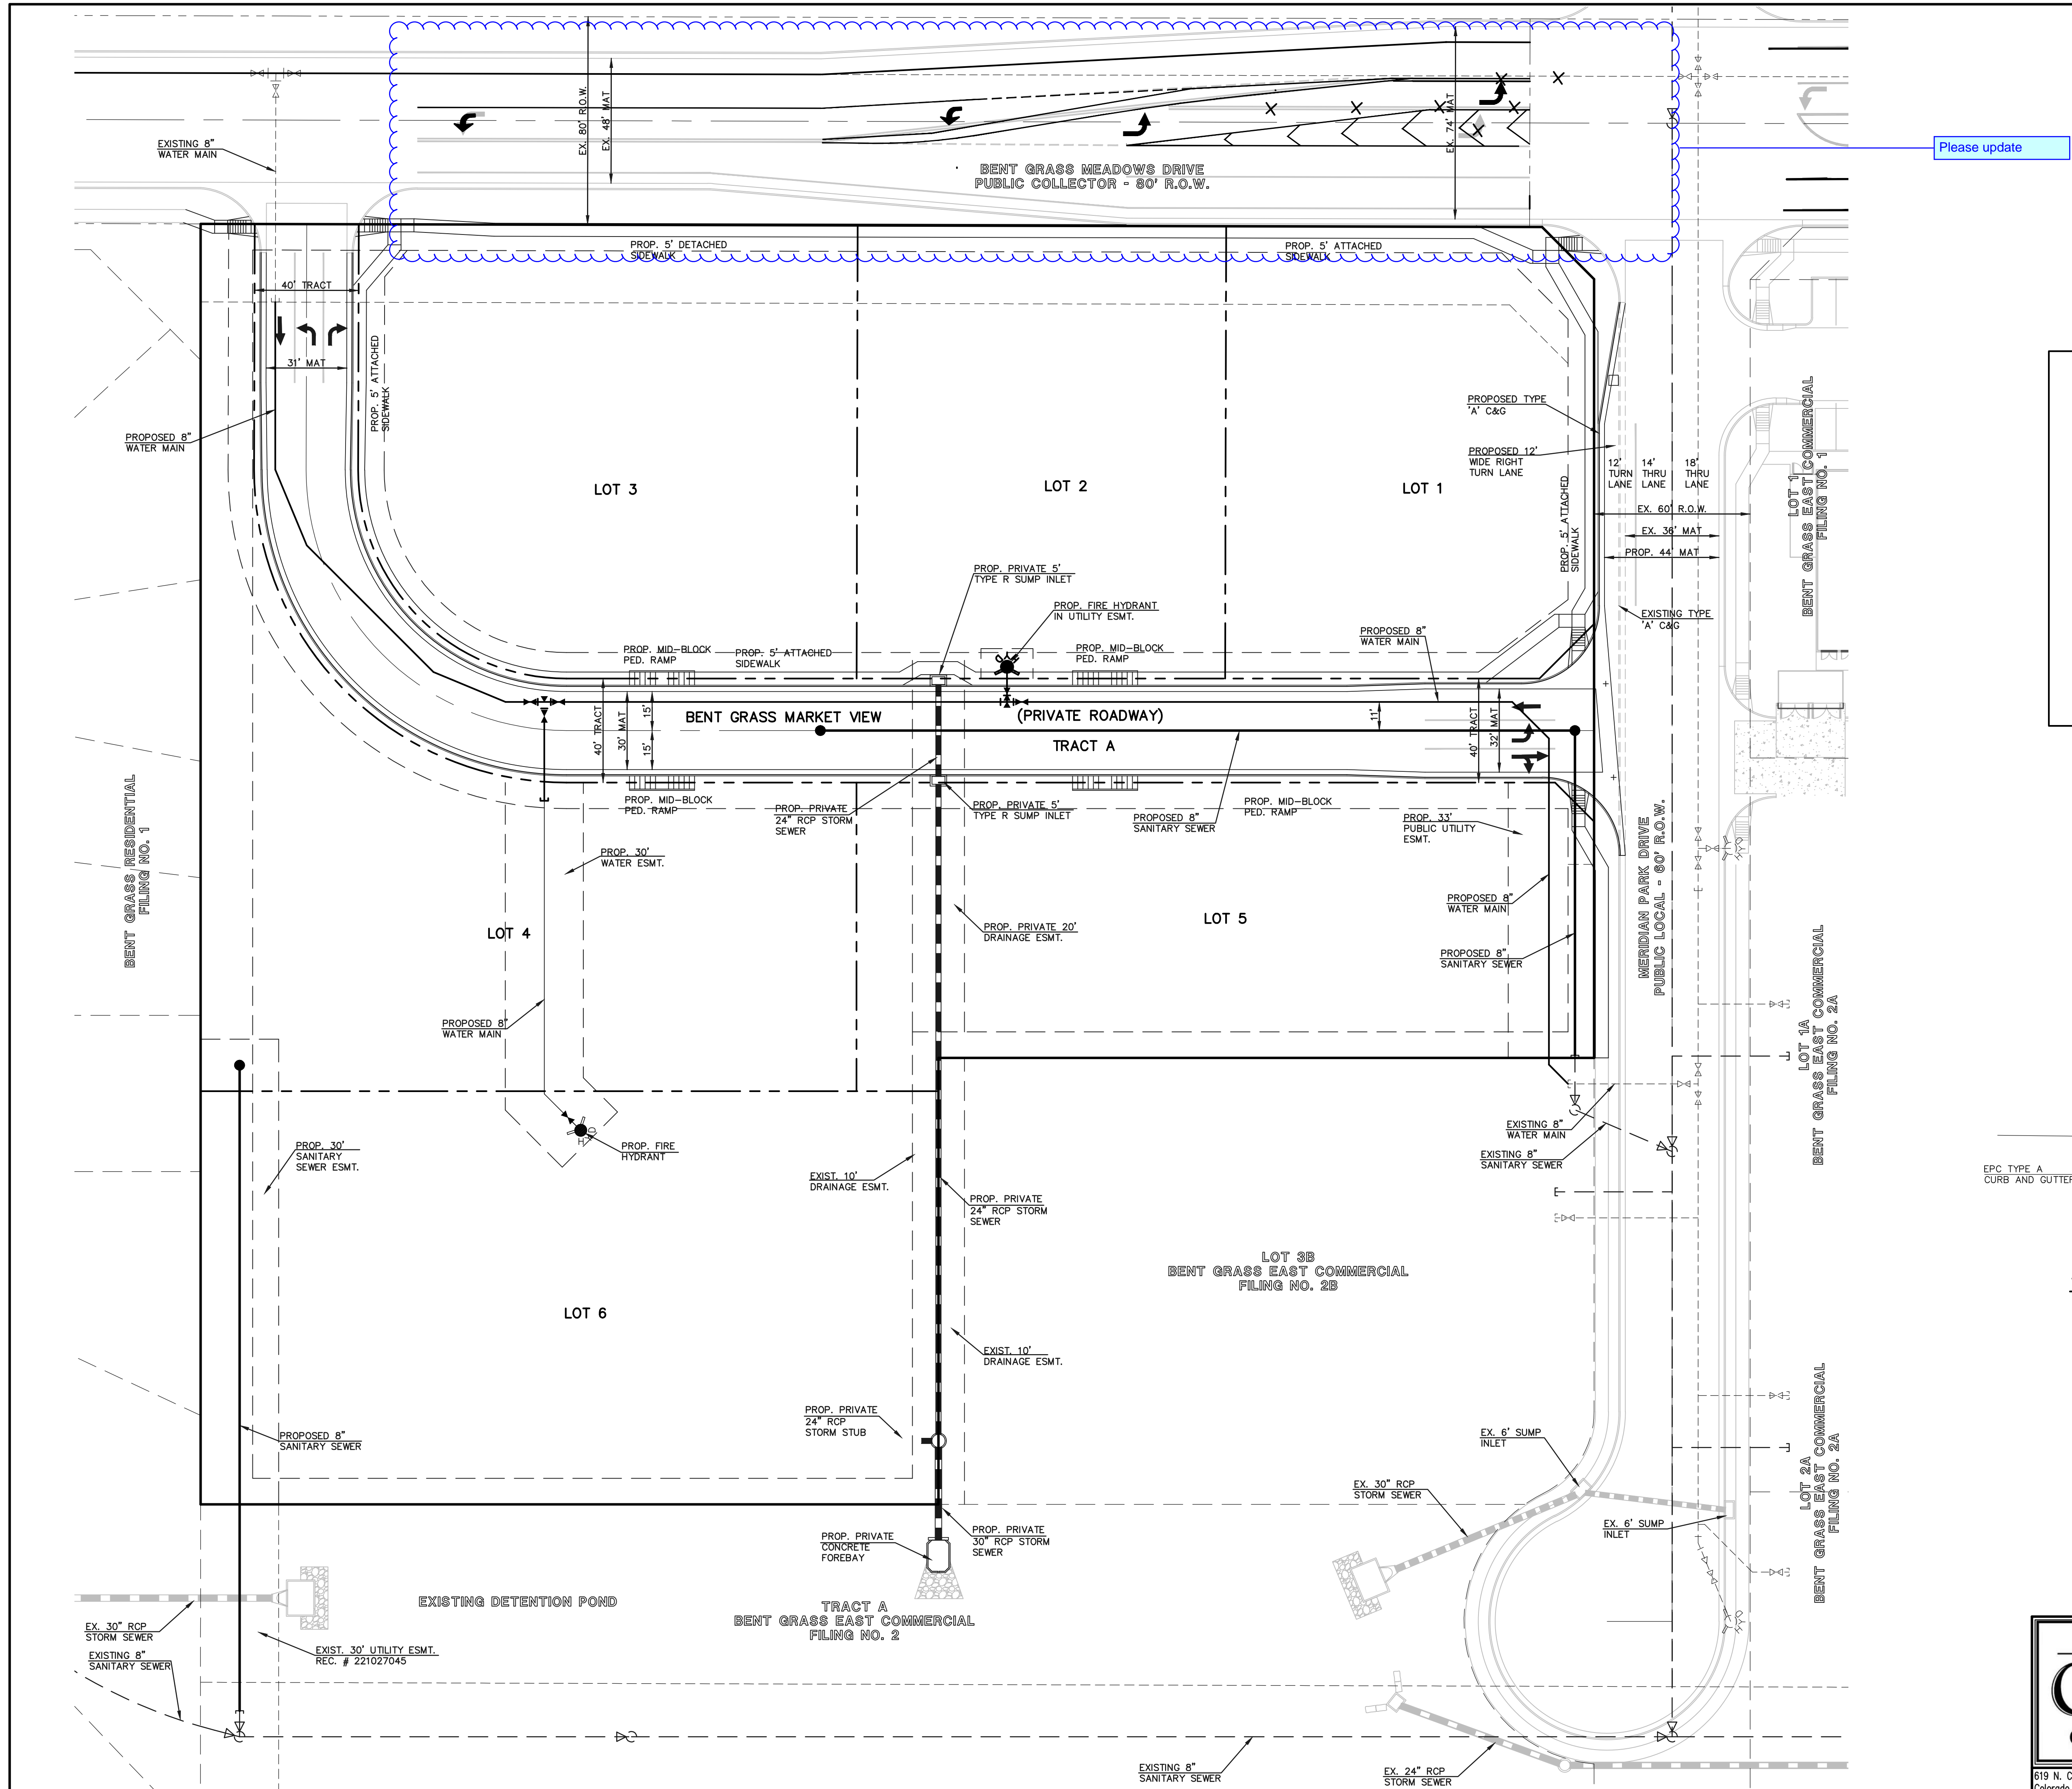

LEGEND	
DESCRIPTION	SYMBOL
PROPERTY LINE	---
BOUNDARY LINE	—
PROPOSED PRIVATE STORM SEWER	—●—●—●—●—
PROPOSED STORM INLET	□
EXISTING STORM SEWER	—●—●—●—●—
EXISTING STORM INLET	□
EXISTING FIRE HYDRANT	⊕
EXISTING WATER MAIN	—○—○—○—○—
EXISTING SANITARY SEWER MAIN W/ MANHOLE	—○—○—○—○—
PROPOSED SANITARY	—●—●—●—●—
PROPOSED WATER	—○—○—○—○—

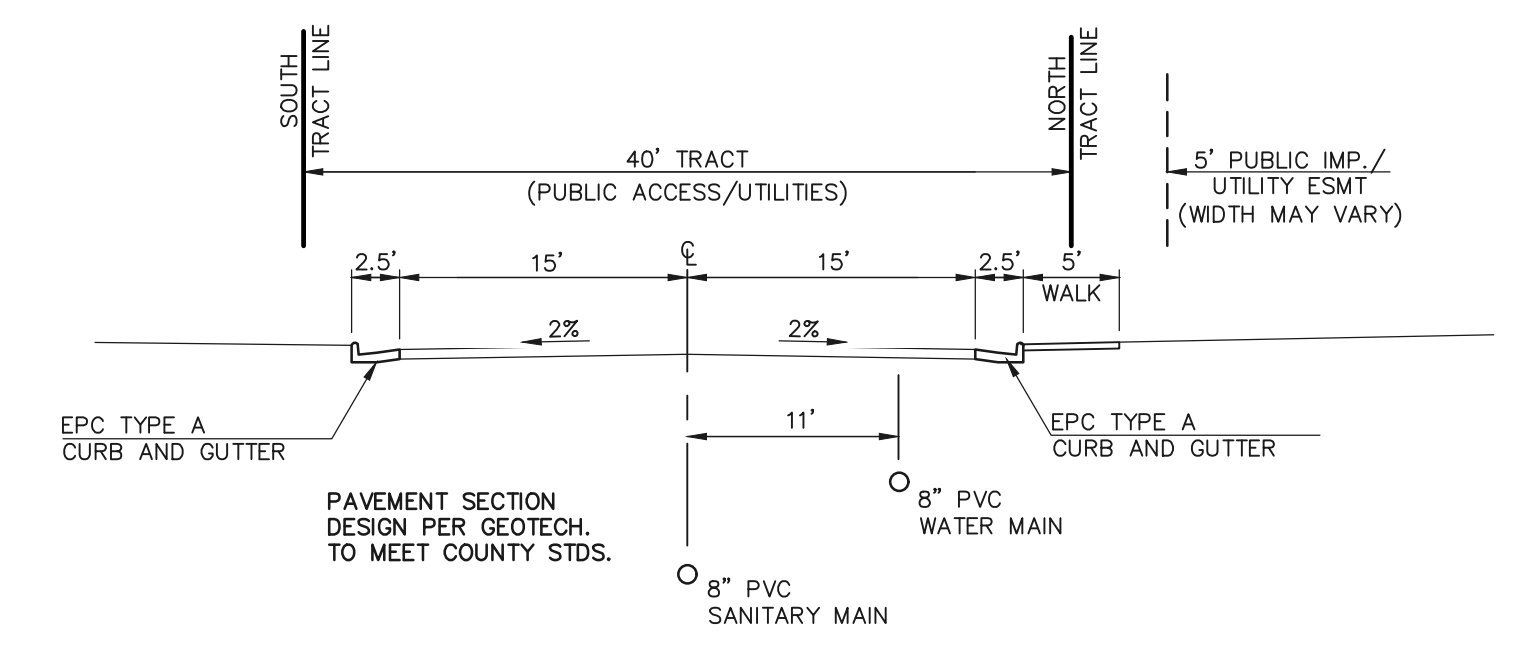


**TYPICAL PRIVATE ROAD CROSS SECTION**  
 SCALE: 1" = 10'  
 BENT GRASS MARKET VIEW  
 (PRIVATE ROADWAY)

 619 N. Cascade Avenue, Suite 200 Colorado Springs, Colorado 80903	<b>BENT GRASS EAST COMMERCIAL FILING NO. 3</b> PRELIMINARY PLAN PRELIMINARY UTILITY PLAN				
	DESIGNED BY	PRA	SCALE	DATE	
	DRAWN BY	PRA	(H) 1" = 30'	SHEET 5 OF 7	
CHECKED BY		(V) 1" = N/A	JOB NO.	2177.64	

# BENT GRASS EAST COMMERCIAL FILING 3

## A PORTION OF THE NORTHEAST QUARTER OF SECTION 1, TOWNSHIP 13 SOUTH, RANGE 65 WEST OF THE SIXTH PRINCIPAL MERIDIAN, EL PASO COUNTY, COLORADO

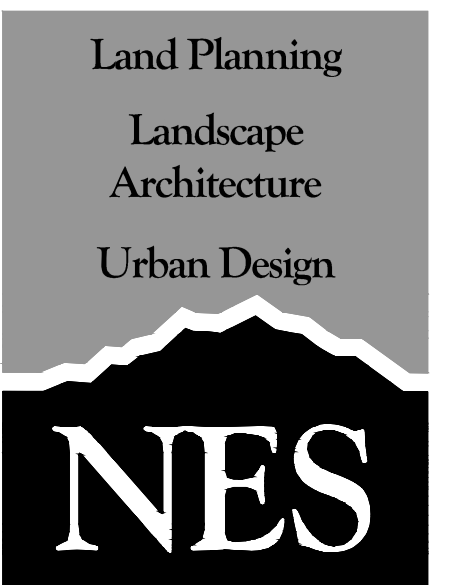

N.E.S. Inc.  
619 N. Cascade Avenue, Suite 200  
Colorado Springs, CO 80903  
Tel. 719.471.0073  
Fax 719.471.0267  
www.nescolorado.com  
© 2012 All Rights Reserved

### LANDSCAPE NOTES

- ALL PRESERVATION AREAS CONTAINING VEGETATION DESIGNATED TO BE PRESERVED, SHALL BE FENCED OFF DURING CONSTRUCTION TO MINIMIZE DISTURBANCE IN THESE AREAS. ALL FENCING SHALL BE INSTALLED AROUND PRESERVED VEGETATION PRIOR TO ANY GRADING ON THE PROPERTY. A 4-FOOT, ORANGE, CONSTRUCTION SAFETY FENCE SHALL BE USED IN THIS APPLICATION.
- SOIL AMENDMENT - INCORPORATE 3 CUBIC YARDS/1000 S.F. AREA OF CLASS 2 A1 ORGANICS PREMIUM ORGANIC COMPOST ON TALL FESCUE SOD AREAS. INCORPORATE 2 CUBIC YARDS/1000 S.F. AREA OF CLASS 3 COMPOSTED COW MANURE (AGED 1 YEAR) ORGANIC COMPOST TO ALL SEED AREAS. AMENDMENTS MAY CHANGE TO BE BASED ON SOIL ANALYSIS OF FINAL INFILL.
- FOR GRADES REFER TO CIVIL ENGINEERING DRAWINGS.
- CONTRACTOR TO UTILIZE STOCKPILED TOPSOIL FROM GRADING OPERATION AS AVAILABLE. TILL INTO TOP 6" OF SOIL.
- CONTRACTOR TO APPLY EROSION CONTROL BLANKET TO ALL AREAS WITH 3:1 SLOPES.
- ALL SOD SHALL BE TALL FESCUE BLEND.
- NO SOD SHALL BE PLANTED ON SLOPES IN EXCESS OF 6:1 GRADIENT.
- FOR ALL SEED AREAS REFER TO SEED MIXES SPECIFIED ON THIS SHEET.
- ALL NATIVE SEED AREAS SHALL HAVE A TEMPORARY ABOVE-GROUND SPRAY IRRIGATION SYSTEM UTILIZED UNTIL SEED IS ESTABLISHED, AND ALL TREES AND SHRUBS WITHIN NATIVE SEED AREAS SHALL HAVE A PERMANENT DRIP IRRIGATION SYSTEM.
- A FULLY AUTOMATED SPRINKLER IRRIGATION SYSTEM WILL DRIP IRRIGATE ALL TREE, SHRUB, AND GROUND COVER PLANTINGS, AND SPRAY ALL TALL FESCUE SOD AND LOW ALTERNATIVE TURF AREAS. AN IRRIGATION PLAN WILL BE PREPARED AT A LATER DATE AND WILL INCLUDE AN IRRIGATION SCHEDULE THAT NOTES APPLICATION RATES BASED ON TURF TYPE, RATES FOR NEWLY INSTALLED PLANTS VS. ESTABLISHED PLANTS, AND GENERAL RECOMMENDATIONS REGARDING SEASONAL ADJUSTMENTS.
- NO TREES AND NO PLANTS OVER 2 FEET TALL SHALL BE INSTALLED WITHIN 5 FEET OF ANY FIRE HYDRANTS.
- ALL PLANTS TO RECEIVE 3 INCH DEPTH OF GORILLA HAIR SHREDDED CEDAR WOOD MULCH UNLESS OTHERWISE SPECIFIED. FOLLOW PLANTING DETAILS FOR MULCH RING DIMENSIONS WITHIN ROCK, SOD, OR SEED AREAS.
- COBBLE: 2-3" CRIPPLE CREEK ORE, AT 3-4" DEPTH, AT ALL INTERSECTION CORNERS BETWEEN HANDICAP RAMPS. INSTALL GEOTEXTILE FABRIC UNDER ALL COBBLE AREAS.
- GRAVEL ROCK: 3/4" CIMARRON GRANITE, AT 3-4" DEPTH. INSTALL GEOTEXTILE FABRIC UNDER ALL ROCK AREAS.
- ALL SHRUB BEDS TO BE ENCLOSED BY SOLID STEEL EDGING, AS A SEPARATOR FROM SOD, SEED, AND ALTERNATIVE TURF. SEPARATION BETWEEN SOD AND SEED, AND BETWEEN ALTERNATIVE TURF AND SEED SHALL BE A MOWED STRIP, WITHOUT STEEL EDGING.
- SCHEDULE PLANTS SIZES IN TABLE ARE SUGGESTED. PLANTS TO BE CONSIDERED FOR FULFILLING COUNTY LANDSCAPE REQUIREMENTS SHALL HAVE A MINIMUM CALIPER SIZE (MEASURED SIX INCHES ABOVE GROUND) FOR DECIDUOUS SHADE TREES SHALL BE 1-1/2 INCHES AND FOR DECIDUOUS ORNAMENTAL TREES 1 INCH. EVERGREEN TREES SHALL BE A MINIMUM OF 6 FEET IN HEIGHT ABOVE GROUND. SHRUBS SHALL BE A MINIMUM OF 5 GALLON SIZE.
- ALL PLANTS SHOWN IN PRELIMINARY LANDSCAPE PLAN ARE FULFILLING A COUNTY LANDSCAPE REQUIREMENT. ADDITIONAL AND INTERIOR PLANTING WILL BE SHOWN IN FINAL LANDSCAPE PLAN.
- ANY FIELD CHANGES OR DEVIATIONS TO THESE PLANS WITHOUT PRIOR COUNTY APPROVAL OF AN AMENDED SITE DEVELOPMENT PLAN MAY RESULT IN A DELAY OF FINAL APPROVAL AND ISSUANCE OF A CERTIFICATE OF OCCUPANCY.
- THESE PLANS ARE FOR COUNTY APPROVALS ONLY AND ARE NOT TO BE UTILIZED FOR CONSTRUCTION.
- SITE SPECIFIC LOT LANDSCAPE WILL BE SUBMITTED WITH SITE DEVELOPMENT PLAN PER EACH LOT.

### Landscape Setbacks & Buffers

Street Name or Zone Boundary	Street Classification	Width (in Ft.) Req./Prov.	Linear Footage	Tree/Feet Required	No. of Trees Req./ Prov.	No. of Evergreen Trees Req./ Prov.
***Bent Grass Meadows Drive	Local	15	516	1 / 15'	34/34	12/21
Meridian Park Drive	Local	10	298	1 / 30'	10/5	10/5
**Bent Grass Market View	Private	10	638	1 / 30'	21/**	21/**

Shrub Substitutes	Shrub Substitutes Required / Provided	Width (in Ft.) Req./Prov.	Percent Ground Plane Veg. Req. / Provided
***Bent Grass Meadows Drive	80/80	10'	75% / 75%
Meridian Park Drive	50/50	10'	75% / 75%
** Bent Grass Market View	--/--	10'	75% / 75%

Bent Grass Market View (To be planted at time of lot development)


### Landscape Buffer & Screens

Street Name or Property Line	Width (in Ft.) Req. / Prov.	Linear Footage	Tree/Feet Required	Buffer Trees (1/25) Required / Provided	*Length of 6' Opaque Structure Req. / Prov.
West Landscape Buffer	15/15'	492	1 / 25'	20/20	492/492


\*Existing 6' Opaque Fence along West Landscape Buffer property boundary to be maintained by the Bent Grass Merchants Association  
 \*\*Bent Grass Market View to be landscaped with site specific site development plans.  
 \*\*Bent Grass Meadows Drive to be landscaped by individual lot owners and maintained by the Bent Grass Merchants Association.

### PLANT SCHEDULE


DECIDUOUS TREES	CODE	QTY	BOTANICAL / COMMON NAME	HEIGHT	WIDTH	SIZE
At	10	Acer tataricum 'GarAnn' TM / Hot Wings Tatarian Maple	25'	20'	1.5" Cal.	
Gs	9	Gleditsia triacanthos 'Skyline' / Skyline Honey Locust	45'	40'	1.5" Cal.	
EVERGREEN TREES	CODE	QTY	BOTANICAL / COMMON NAME	HEIGHT	WIDTH	SIZE
Jw	30	Juniperus scopulorum 'Wichita Blue' / Wichita Blue Juniper	15'	6'	6" HT	
Pic co2	7	Picea pungens / Colorado Spruce	30'	20'	6" HT	
Pin syl	4	Pinus sylvestris / Scotch Pine	30'	40'	6" HT	
DECIDUOUS SHRUBS	CODE	QTY	BOTANICAL / COMMON NAME	HEIGHT	WIDTH	SIZE
Cor fl2	10	Cornus sericea 'Flaviramea' / Yellow Twig Dogwood	8'	8'	#5 CONT.	
Cs	28	Cornus sericea 'Isanti' / Isanti Red Twig Dogwood	5'	7'	#5 CONT.	
Pp	26	Prunus besseyi 'P011S' TM / Pawnee Buttes Sand Cherry	1.5'	6'	#5 CONT.	
Va	23	Viburnum dentatum / Arrowwood Viburnum	10'	10'	#5 CONT.	
EVERGREEN SHRUBS	CODE	QTY	BOTANICAL / COMMON NAME	HEIGHT	WIDTH	SIZE
Jun old	54	Juniperus chinensis 'Old Gold' / Old Gold Juniper	4'	6'	#5 CONT.	
Jhw	11	Juniperus horizontalis 'Wiltonii' / Blue Rug Juniper	0.5'	8'	#5 CONT.	
Je	8	Juniperus horizontalis 'Pancake' / Pancake Creeping Juniper	0.5'	2'	#5 CONT.	
Pp2	24	Prunus besseyi 'P011S' TM / Pawnee Buttes Sand Cherry	1.5'	5'	#5 CONT.	

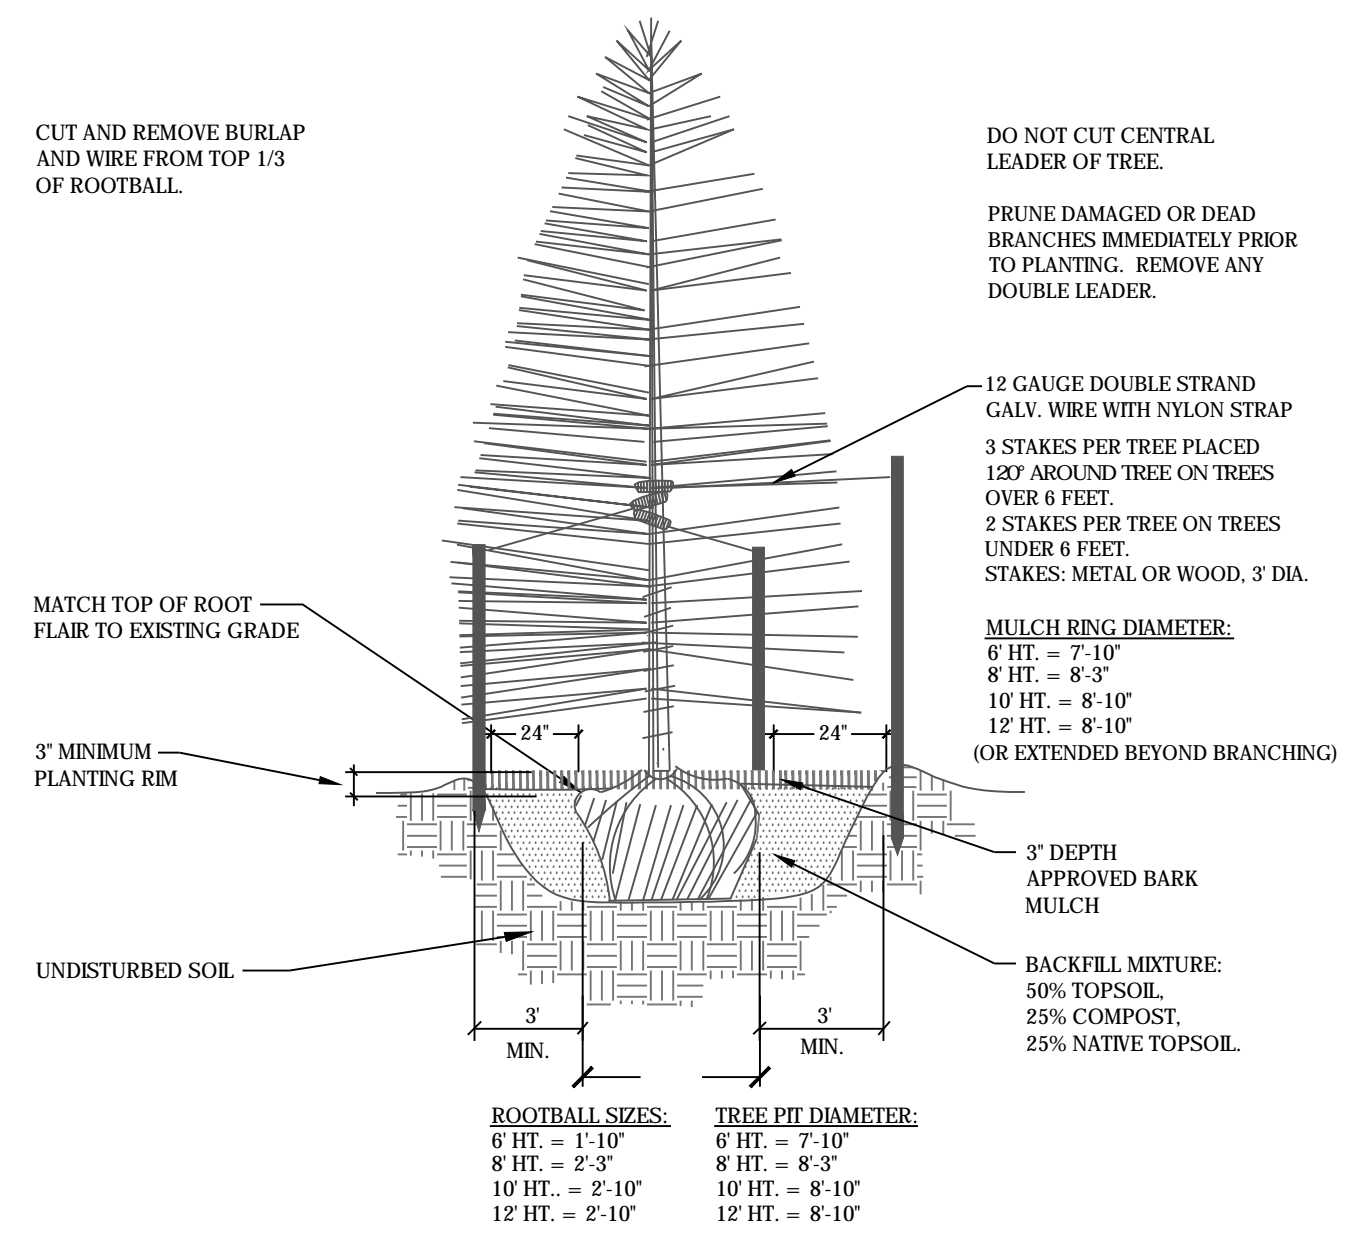

1 CONIFEROUS TREE PLANTING DETAIL  
SCALE: NOT TO SCALE

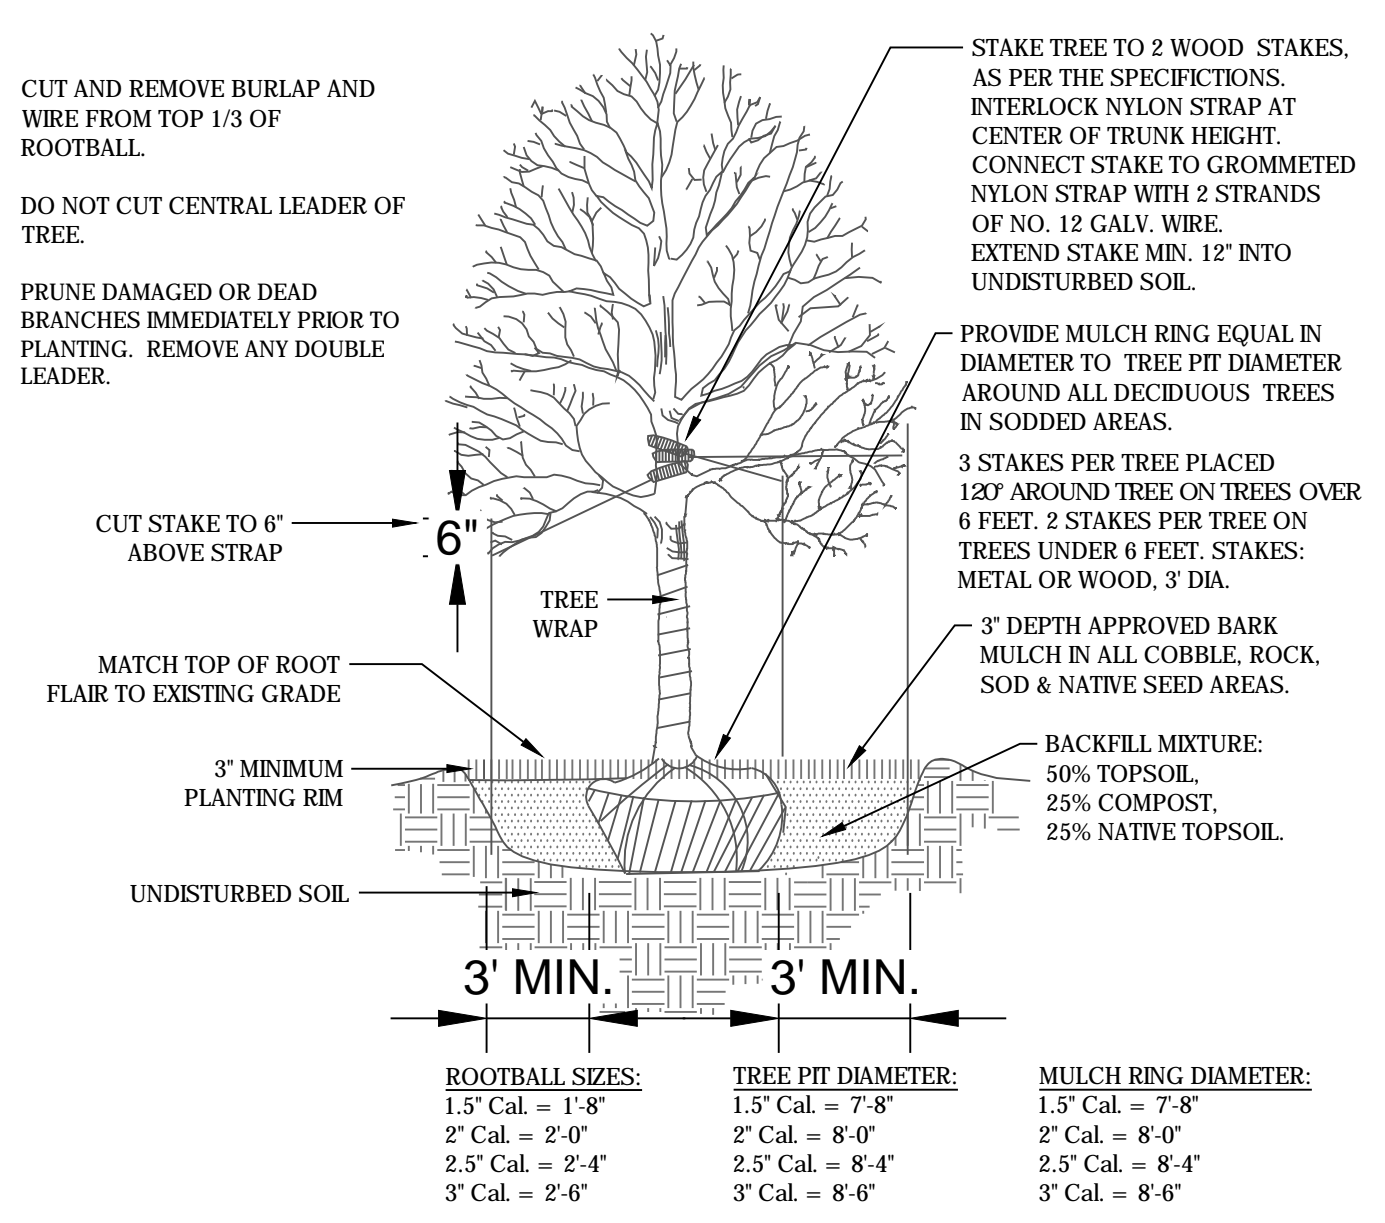

2 DECIDUOUS TREE PLANTING DETAIL  
N.T.S.

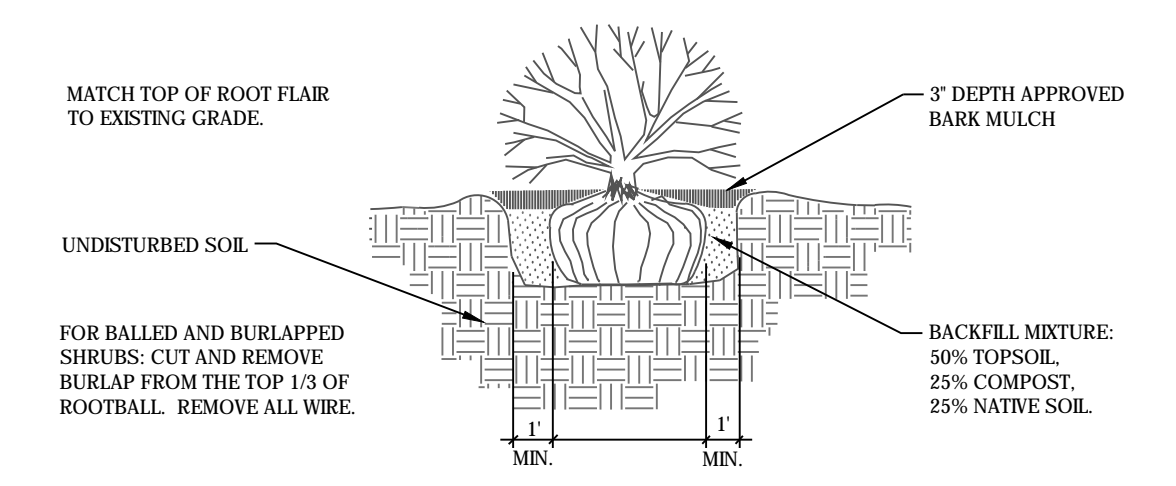

3 SHRUB PLANTING DETAIL  
SCALE: NOT TO SCALE

## BENT GRASS EAST COMMERCIAL FILING 3

### PRELIMINARY PLAN

8090 MERIDIAN PARK DR  
EL PASO COUNTY, CO

DATE: 11.16.20  
PROJECT MGR: A. BARLOW  
PREPARED BY: J. SHAGIN

### ENTITLEMENT


DATE:	BY:	DESCRIPTION:

### LANDSCAPE NOTES AND DETAILS


P:\Land Plan Inc\Bent Grass East Commercial Filing 3\Drawings\Planning\Development\Bentgrass-Commercial\_PrelimPlan\_CONCEPT\_2 - TRACT A\_Secord Sub.dwg [LS NOTES] 9/9/2021 10:30:53 AM Jennifer Shagin

# BENT GRASS EAST COMMERCIAL FILING 3

A PORTION OF THE NORTHEAST QUARTER OF SECTION 1, TOWNSHIP 13 SOUTH,  
RANGE 65 WEST OF THE SIXTH PRINCIPAL MERIDIAN,  
EL PASO COUNTY, COLORADO

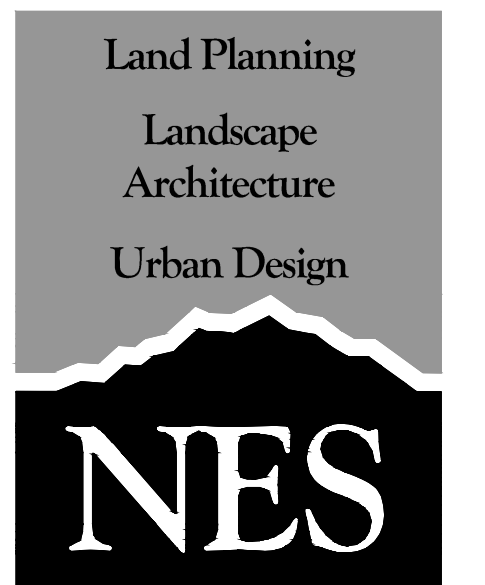

N.E.S. Inc.  
619 N. Cascade Avenue, Suite 200  
Colorado Springs, CO 80903  
Tel. 719.471.0073  
Fax 719.471.0267  
www.nescolorado.com  
© 2012 All Rights Reserved

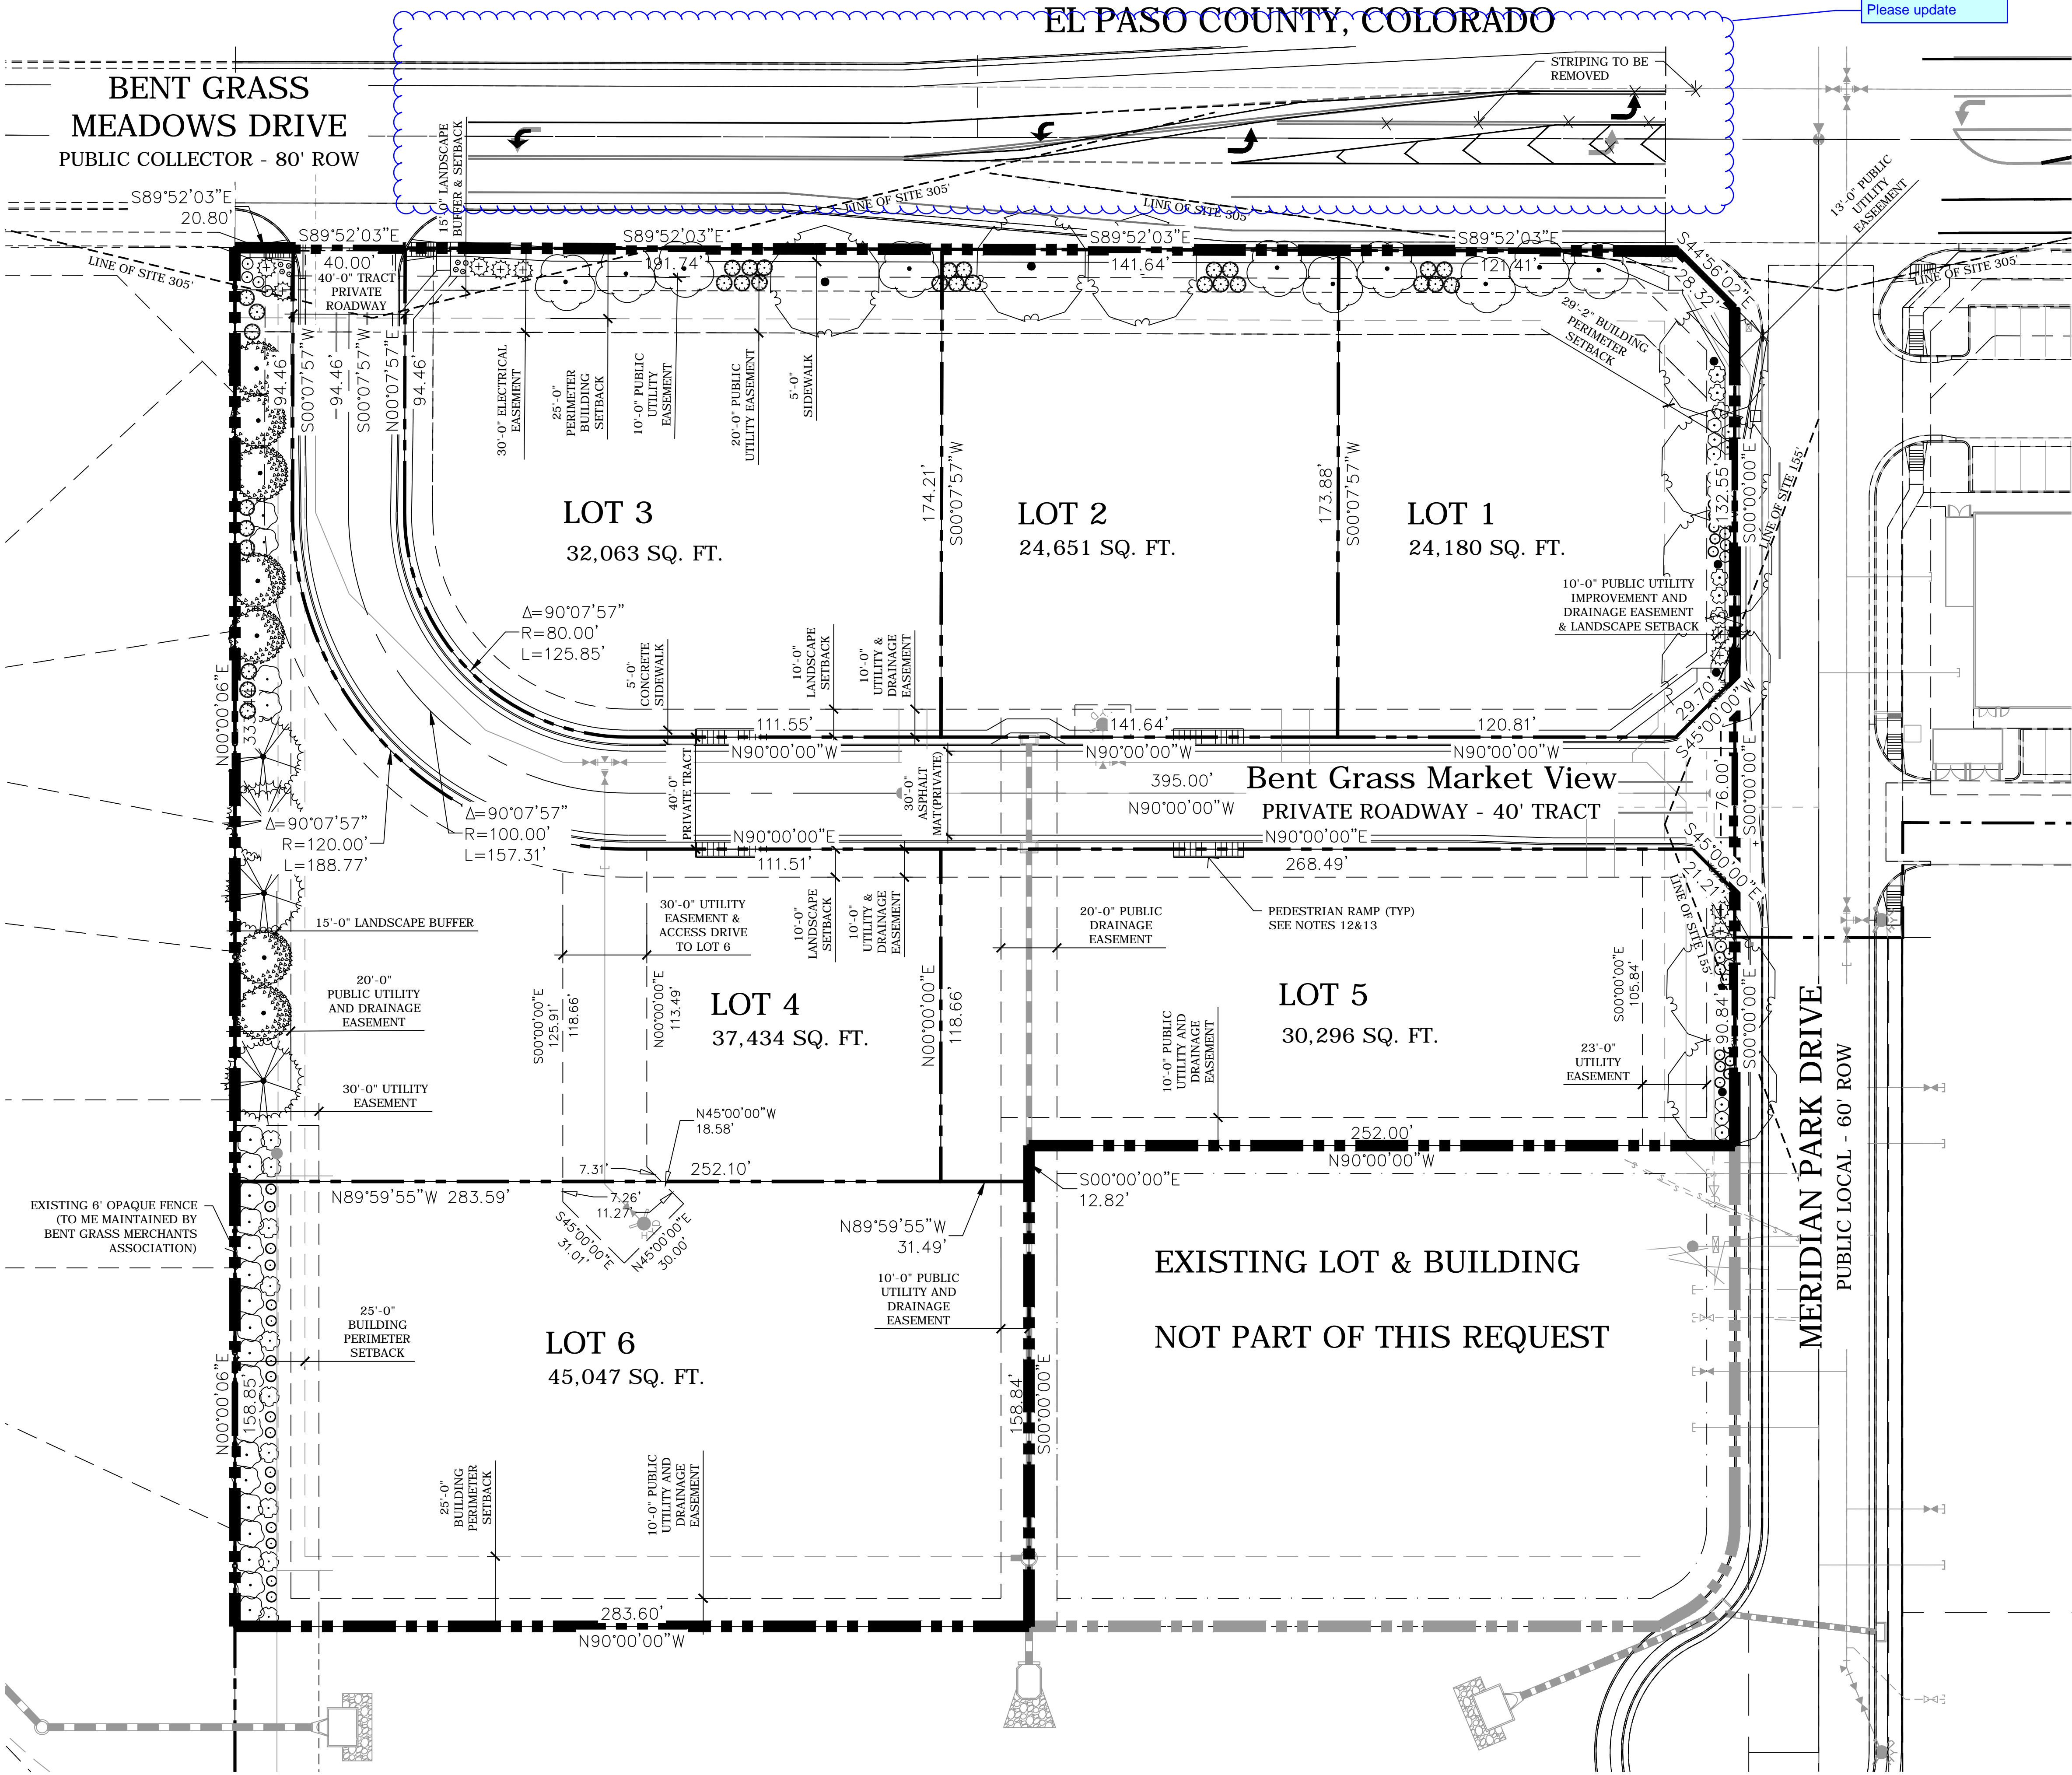

## BENT GRASS EAST COMMERCIAL FILING 3

PRELIMINARY PLAN  
8090 MERIDIAN PARK DR  
EL PASO COUNTY, CO


DATE: 11.16.20  
PROJECT MGR: A. BARLOW  
PREPARED BY: J. SHAGIN

ENTITLEMENT

DATE:	BY:	DESCRIPTION:

ALTERNATIVE LANDSCAPE PLAN

7 OF 7  
PCD#: SP-20-010

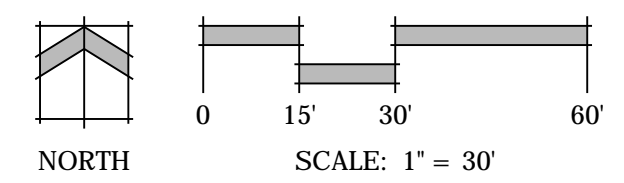

P:\Land Plan Inc\Bent Grass East Commercial Filing 3\Drawings\Planning\Development\BentGrassEastCommercial\_PrelimPlan\_CONCEPT 2 - TRACT A Second Sub.dwg (LS PLAN) 8/31/2021 6:01:14 PM Jennifer Shagin