


# BENT GRASS EAST COMMERCIAL FILING 3

## EL PASO COUNTY, COLORADO PRELIMINARY PLAN TR BB BENT GRASS EAST COMMERCIAL NO 2B

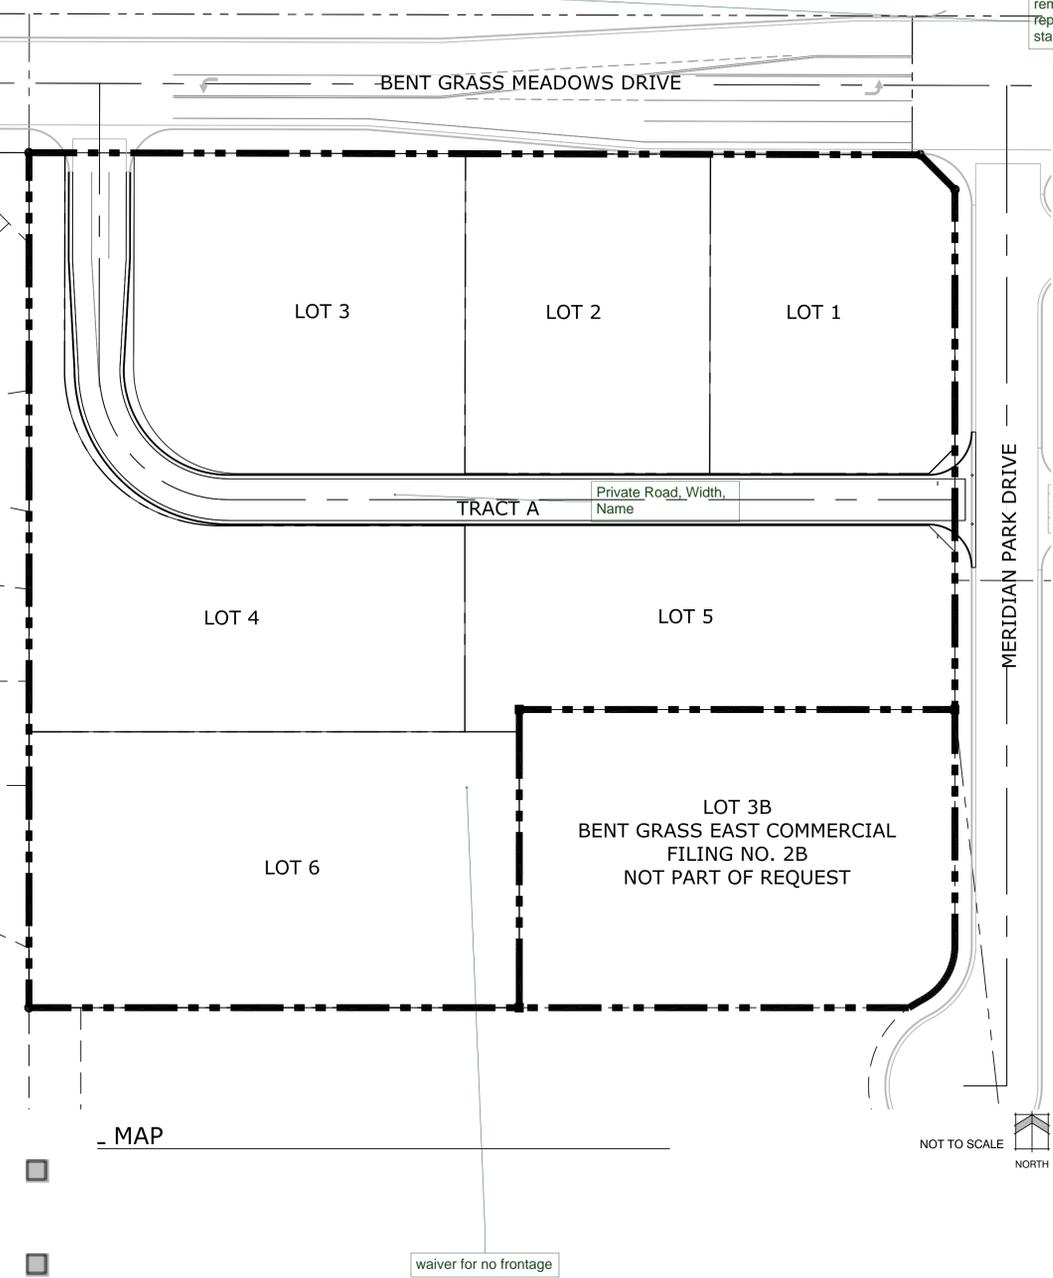

### LEGAL DESCRIPTION

TR BB BENT GRASS EAST COMMERCIAL FIL NO 2B

General Legal Description by 1/4 Section, Township, Range

Legal includes approximate survey tie to an accepted survey monument?

### GENERAL NOTES

- Private roads are to be paved asphalt with concrete curbs.
- Landscaping in public-rights-of-way will be maintained by the Bent Grass Commercial Merchants Association.
- All streets shall be named and constructed to El Paso County Standards and any approved deviations. Upon acceptance by El Paso County, public streets shall be maintained by the County.
- Notwithstanding anything depicted in this plan in words or graphic representation, all design and construction related to roads, storm drainage and erosion control shall conform to the standards and requirements of the most recent version of the relevant adopted El Paso County standards, including the Land Development Code (LDC), the ECM, the Drainage Criteria Manual (DCM), and the DCM Volume 2. Any deviations from these standards must be specifically requested and approved in writing to be acceptable. The approval of this Preliminary Plan does not implicitly allow any deviations or waivers that have not been otherwise approved through the deviation approval process.
- The following utility providers will serve the Bent Grass East Commercial Filing 3 Preliminary Plan area:  
Water: Woodmen Hills Metropolitan District  
Wastewater: Woodmen Hills Metropolitan District  
Gas: CSU  
Electric: MVEA

**Easements:**  
Unless otherwise indicated, all side, front, and rear lot lines are hereby platted on either side with a 10 foot (use 5 feet for lots smaller than 2.5 acres) public utility and drainage easement unless otherwise indicated. All exterior subdivision boundaries are hereby platted with a 20 foot (use 7 feet for lots smaller than 2.5 acres) public utility and drainage easement. The sole responsibility for maintenance of these easements is hereby vested with the individual property owners.

**Access Limitation:**  
There shall be no direct lot access to \_\_\_\_\_ Road.

**Bent Grass Meadows**  
(Please check with engineering on Meridian Park access)

### FEMA FLOODPLAIN NOTE

- Floodplain Statement: This site located at 8090 MERIDIAN PARK DR is not within a designated F.E.M.A. Floodplain as determined by the flood insurance rate map, community panel number 08041C0553G, effective September 15, 2020.

### GEOLOGIC HAZARD DISCLOSURE STATEMENT

The following lots have been found to be impacted by geologic hazards. Mitigation measures and a map of the hazard area can be found in the Geohazard Evaluation Report prepared by Entech Engineering Inc., dated 10 15, 2020. These reports are held in the Bent Grass Commercial Preliminary Plan File (xxxxx) at the El Paso County Planning and Community Development Department.

- Potentially Seasonally High Groundwater: Lots 1-6
- Other Hazard:
  - Artificial Fill: Eastern portion of the site.
  - Loose Soils: Lots 1-6.

In Areas of High Groundwater:  
All foundations shall comply with recommendations in the Soils & Geology Report

Groundwater was encountered in all of the test borings at depths ranging from 5 to 12.5 feet bgs (Reference 1, Appendix B). The borings were drilled to 20 feet. Interceptor drains or under-slab drains may be necessary where foundations encroach the groundwater table. Groundwater may affect the construction of shallow foundations proposed for this site and deeper excavations for utilities, depending on site grading and depths of excavation. Unstable conditions should be expected where excavations approach the groundwater level. Stabilization measures should be considered where necessary. It should be noted that fluctuations in groundwater levels may occur on one side of the site.

If fees are to be paid in lieu of land, the approximate amount of such fees and the concurrence of the parties involved are to be shown

Notes to indicate disposition, maintenance responsibility, and service responsibility (suppliers) for water and sanitation, energy supplies, common areas, and other services and areas which will serve the community must be shown

**Driveway** — A facility for the passage of vehicles that provides access from a public or private road to no more than 3 lots.

### 8.4.3. Division of Land, Block, Lot, and Tract Layout Standards

- (A) Division of Land Standards
- Minimum **Frontage** for Division of Land. A division of land shall have a minimum of 60 feet **frontage** on a public road.
- (B) Block Standards
- General. The lengths, widths, and shapes of blocks shall conform to the following standards:
    - Separation of Differing Land Uses. Blocks shall be used to separate distinct land uses or zoning classifications.
    - Vehicular and Pedestrian Circulation. Blocks shall be laid out and designed to provide for convenient control, safety, and access for vehicular and pedestrian circulation.
    - Topography and Natural Features. Blocks shall be laid out with respect for the existing topography, vegetation, and other natural features.
  - Block Lengths and Pedestrians. Block lengths in excess of 600 feet may require pedestrian access be provided approximately midway through the block.
- (C) Lot Design. Lot design and layout shall conform to the following standards:
- Buildable Lots. Lots shall be buildable lots, unless specifically approved and restricted by plat note.
  - Lot Area and Dimensions.
    - Minimum Lot Dimensions in Zoning District. The minimum area and dimensions of lots shall conform to the requirements of the applicable zoning district.
    - Adequate Buildable Area Required. Lots shall have sufficient buildable area to reasonably accommodate the allowed uses. Buildable areas shall be excluded from easements unless otherwise approved by the easement holder, and shall not encroach into natural hazard areas unless the natural hazards are mitigated as required by this Code.
    - Lot Area Adequate to Accommodate Parking. Lot area shall be adequate to allow for the provision of necessary parking facilities for the allowed uses.
    - Corner Lots and Building Setbacks. Corner lots shall accommodate the required setback on both frontages, which may require extra lot width.
    - Minimum Frontage. Lots shall have a minimum of 30 feet of frontage on and have access from a public road, except where private roads are approved by the BOCC pursuant to waiver granted under Section 8.4.4 (E).

### SITE DATA

**OWNER:**  
LAND FIRST INC.  
1378 PROMONTORY BLUFF VW  
COLORADO SPRINGS CO 80921-3945

**PREPARED BY:**  
NES INC.  
619 N. CASCADE AVE STE 200  
COLORADO SPRINGS, CO 80903

Tax ID Number: 5301101060

Early Assistance: EA2085

Current Zoning: CS

#### Building Setbacks

Front: 25'  
Side: 25'  
Rear: 25'  
Maximum Height: 45'

Landscape Setback: Meridian Market View and Private Road Tract A (needs a name) work with enumerations..  
Bent Grass Meadows Drive: 10'

#### Landscape Buffer:

West Boundary: 15' summer

Development Schedule: Spring 2021

Proposed Land Use: Commercial

#### Land Use:

Lots: 4.54 ac - 6 Lots (90%)  
Tracts: 0.51 ac (10%)  
Total Area: 5.05 ac (219,875 SF)

Private road tract to be owned and maintained by?

## BENT GRASS EAST COMMERCIAL FILING 3 PRELIMINARY PLAN

8090 MERIDIAN PARK DR  
EL PASO COUNTY, CO

DATE: 11.16.20  
PROJECT MGR: E. GANAWAY  
PREPARED BY: J. SHAGIN

### ENTITLEMENT

DATE: BY: DESCRIPTION:

### SHEET INDEX

- Sheet 1 of 7: COVER SHEET
- Sheet 2 of 7: ADJACENT PROPERTIES & TRACT MAP
- Sheet 3 of 7: PRELIMINARY PLAN
- Sheet 4 of 7: PRELIMINARY GRADING PLAN
- Sheet 5 of 7: PRELIMINARY UTILITIES
- Sheet 6 of 7: LANDSCAPE NOTES AND DETAILS
- Sheet 7 of 7: LANDSCAPE PLAN

### COVER SHEET

# 1

1 OF 7

CPC #

PCD Filing No.:  
SP-20-010


ADJACENT OWNER'S TABLE:

Name	Mailing Address	City, State, Zip
1 GLEESON, MATTHEW R GRUBESIC, ABIGAIL L	11739 SEDGE CT	PEYTON CO, 80831-6739
2 CHASE, BRUCE L CHASE, LINDA S	11745 SEDGE CT	PEYTON CO, 80831-6739
3 BOGSTAD, DEVAN M MARKLE, ALYSSA M	11751 SEDGE CT	PEYTON CO, 80831-6739
4 JIMENEZ-DIAZ, ANDRES A ACOSTA-ORTIZ, KARLA J	11757 SEDGE CT	PEYTON CO, 80831-6739
5 MARCZYK JEREMY THOMAS	11763 SEDGE CT	PEYTON CO, 80831-6739
6 GROSS JAMES	11769 SEDGE CT	PEYTON CO, 80831-6739
7 WAWRZYNIAK, KEITH P WAWRZYNIAK, NANCY A	15620 EASTONVILLE RD	ELBERT CO, 80106-8818
8 GUDGEON DAVID GUDGEON KELSEY	11781 SEDGE CT	PEYTON CO, 80831-6739
9 WILMORE JUNCTION LLC	7850 N MERIDIAN RD	PEYTON CO, 80831-6739
10 INTERNATIONAL DEVELOPMENT COMPANY	102 E PIKES PEAK AVE STE 201	COLORADO SPRINGS CO, 80903-1823
11 MDC COAST 6 LLC	11995 EL CAMINO REAL	SAN DIEGO CA, 92130-2539
12 REILLY, RAYMOND L JR REILLY, TANYA T CASE, LINDSAY J CASE, R W II	102 E. PIKES PEAK AVE # 201	COLORADO SPRINGS CO, 80903-1823
13 8011 PROPERTIES LLC	8011 MERIDIAN PARK DR	PEYTON, CO 80831-8128
14 CLARK, AMY DVM PROPERTIES LLC	8036 MERIDIAN PARK DRIVE	PEYTON, CO 80831-8128
15 BENT GRASS METRO DISTRICT	660 SOUTHPOINTE CT STE 210	COLORADO SPRINGS CO, 80906-3874

TRACT USE CHART:

	AREA		USE	Ownership/Maintenance
	SQ. FT.	AC.		
Tract A	22,099	0.51	Drive and Utility Access	Bent Grass Commercial Merchants Association

private road, utility and drainage

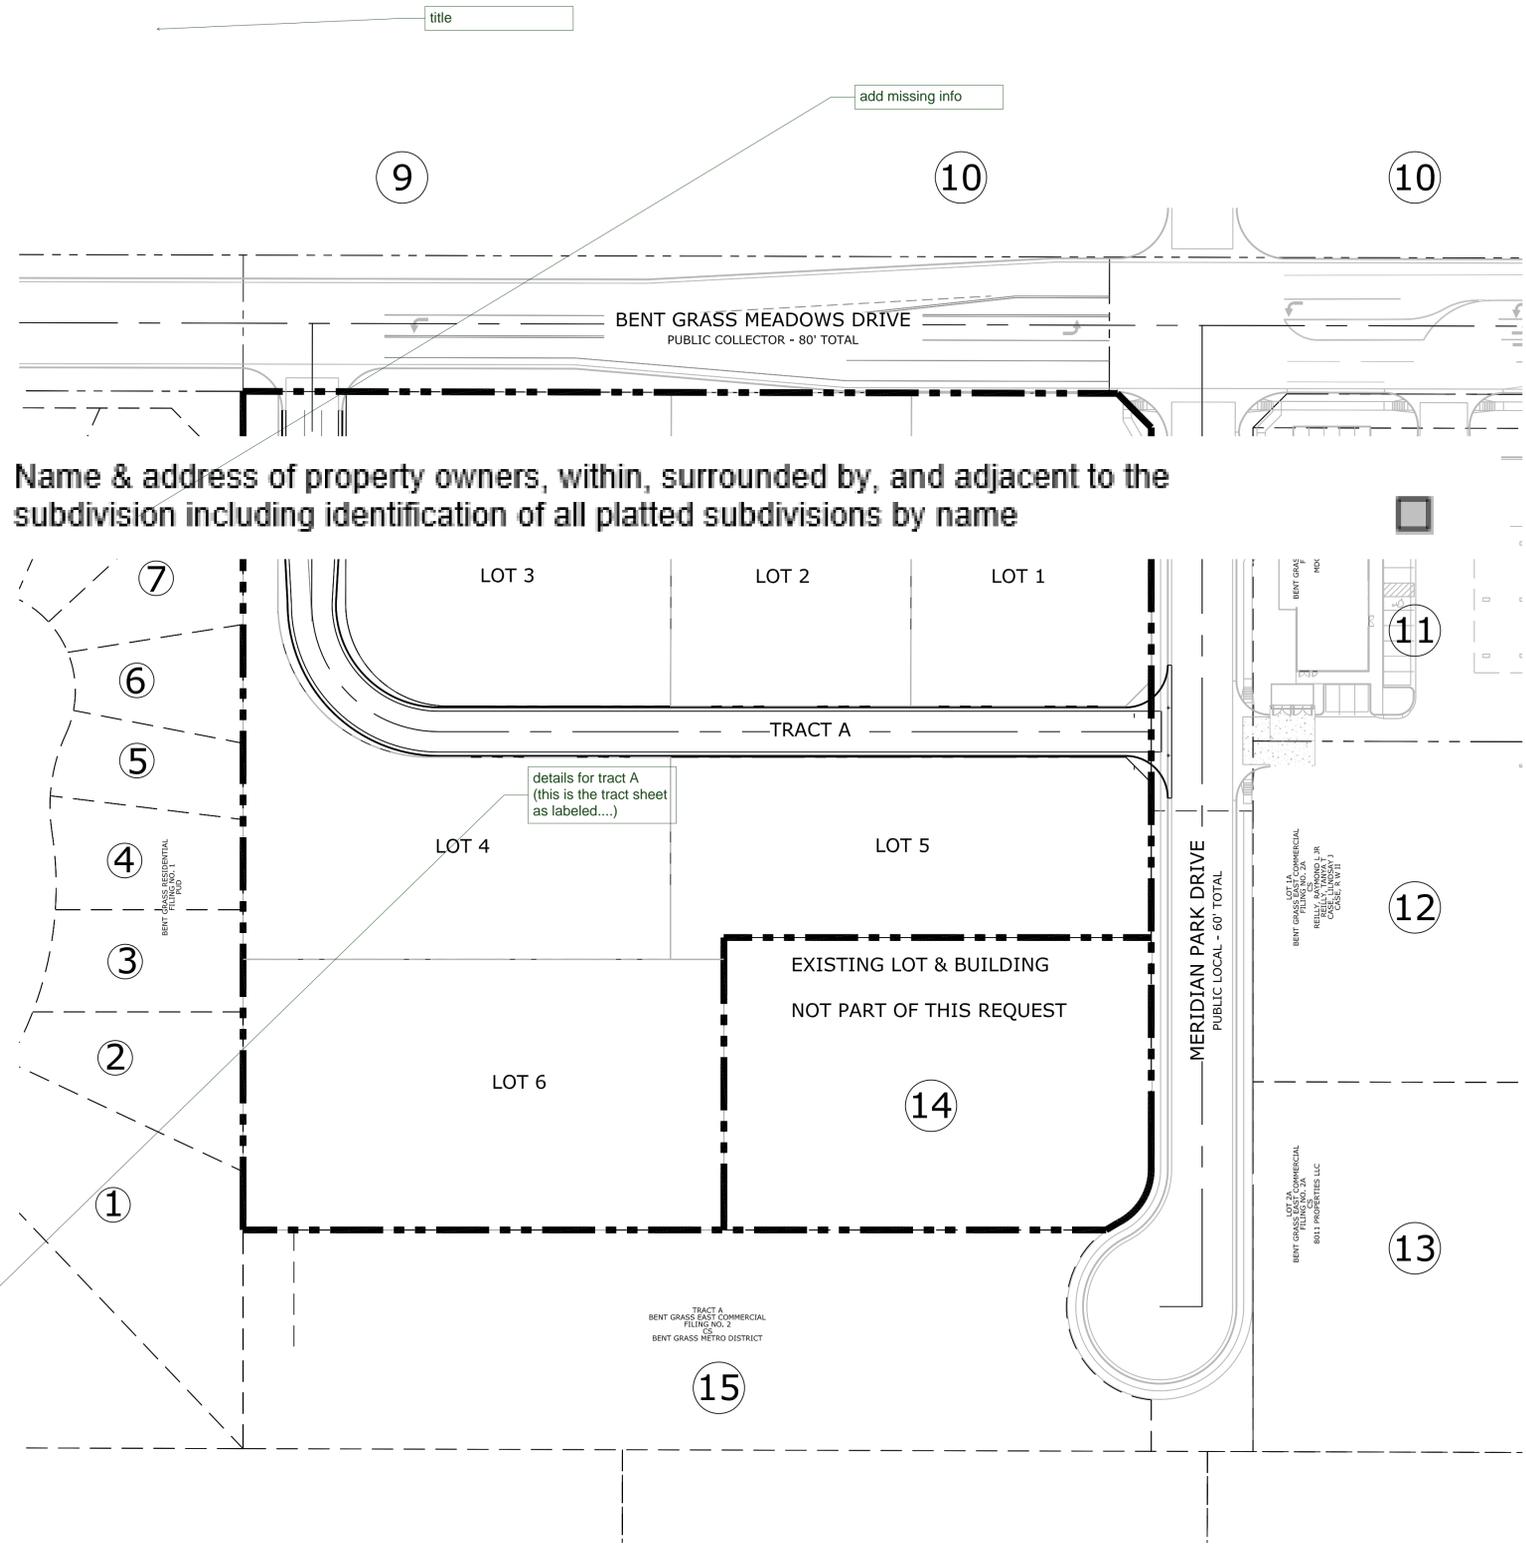

Name & address of property owners, within, surrounded by, and adjacent to the subdivision including identification of all platted subdivisions by name

Land Planning  
Landscape Architecture  
Urban Design

N.E.S. Inc.  
619 N. Cascade Avenue, Suite 200  
Colorado Springs, CO 80903  
Tel. 719.471.0073  
Fax 719.471.0267  
www.nescolorado.com  
© 2012. All Rights Reserved.

**BENT GRASS EAST COMMERCIAL FILING 3**  
PRELIMINARY PLAN  
8090 MERIDIAN PARK DR  
EL PASO COUNTY, CO

DATE: 11.16.20  
PROJECT MGR: E. GANAWAY  
PREPARED BY: J. SHAGIN


ENTITLEMENT

DATE:	BY:	DESCRIPTION:


ADJACENT PROPERTY OWNERS AND TRACT MAP

**2**  
2 OF 7  
CPC #


P:\Land Plan\Bent Grass East Commercial Filing 3\Drawings\Planning\Develop\Bentgrass-Commercial\_PrelimPlan\_CONCEPT\_2 - TRACT A.dwg (plotted) Property Owners & Tract Map 11/16/2020 2:26:31 PM jshagin

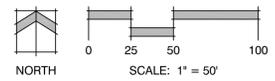

title all sheets

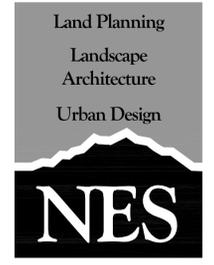

N.E.S. Inc.
619 N. Cascade Avenue, Suite 200
Colorado Springs, CO 80903
Tel. 719.471.0073
Fax 719.471.0267
www.nescolorado.com
© 2012. All Rights Reserved.

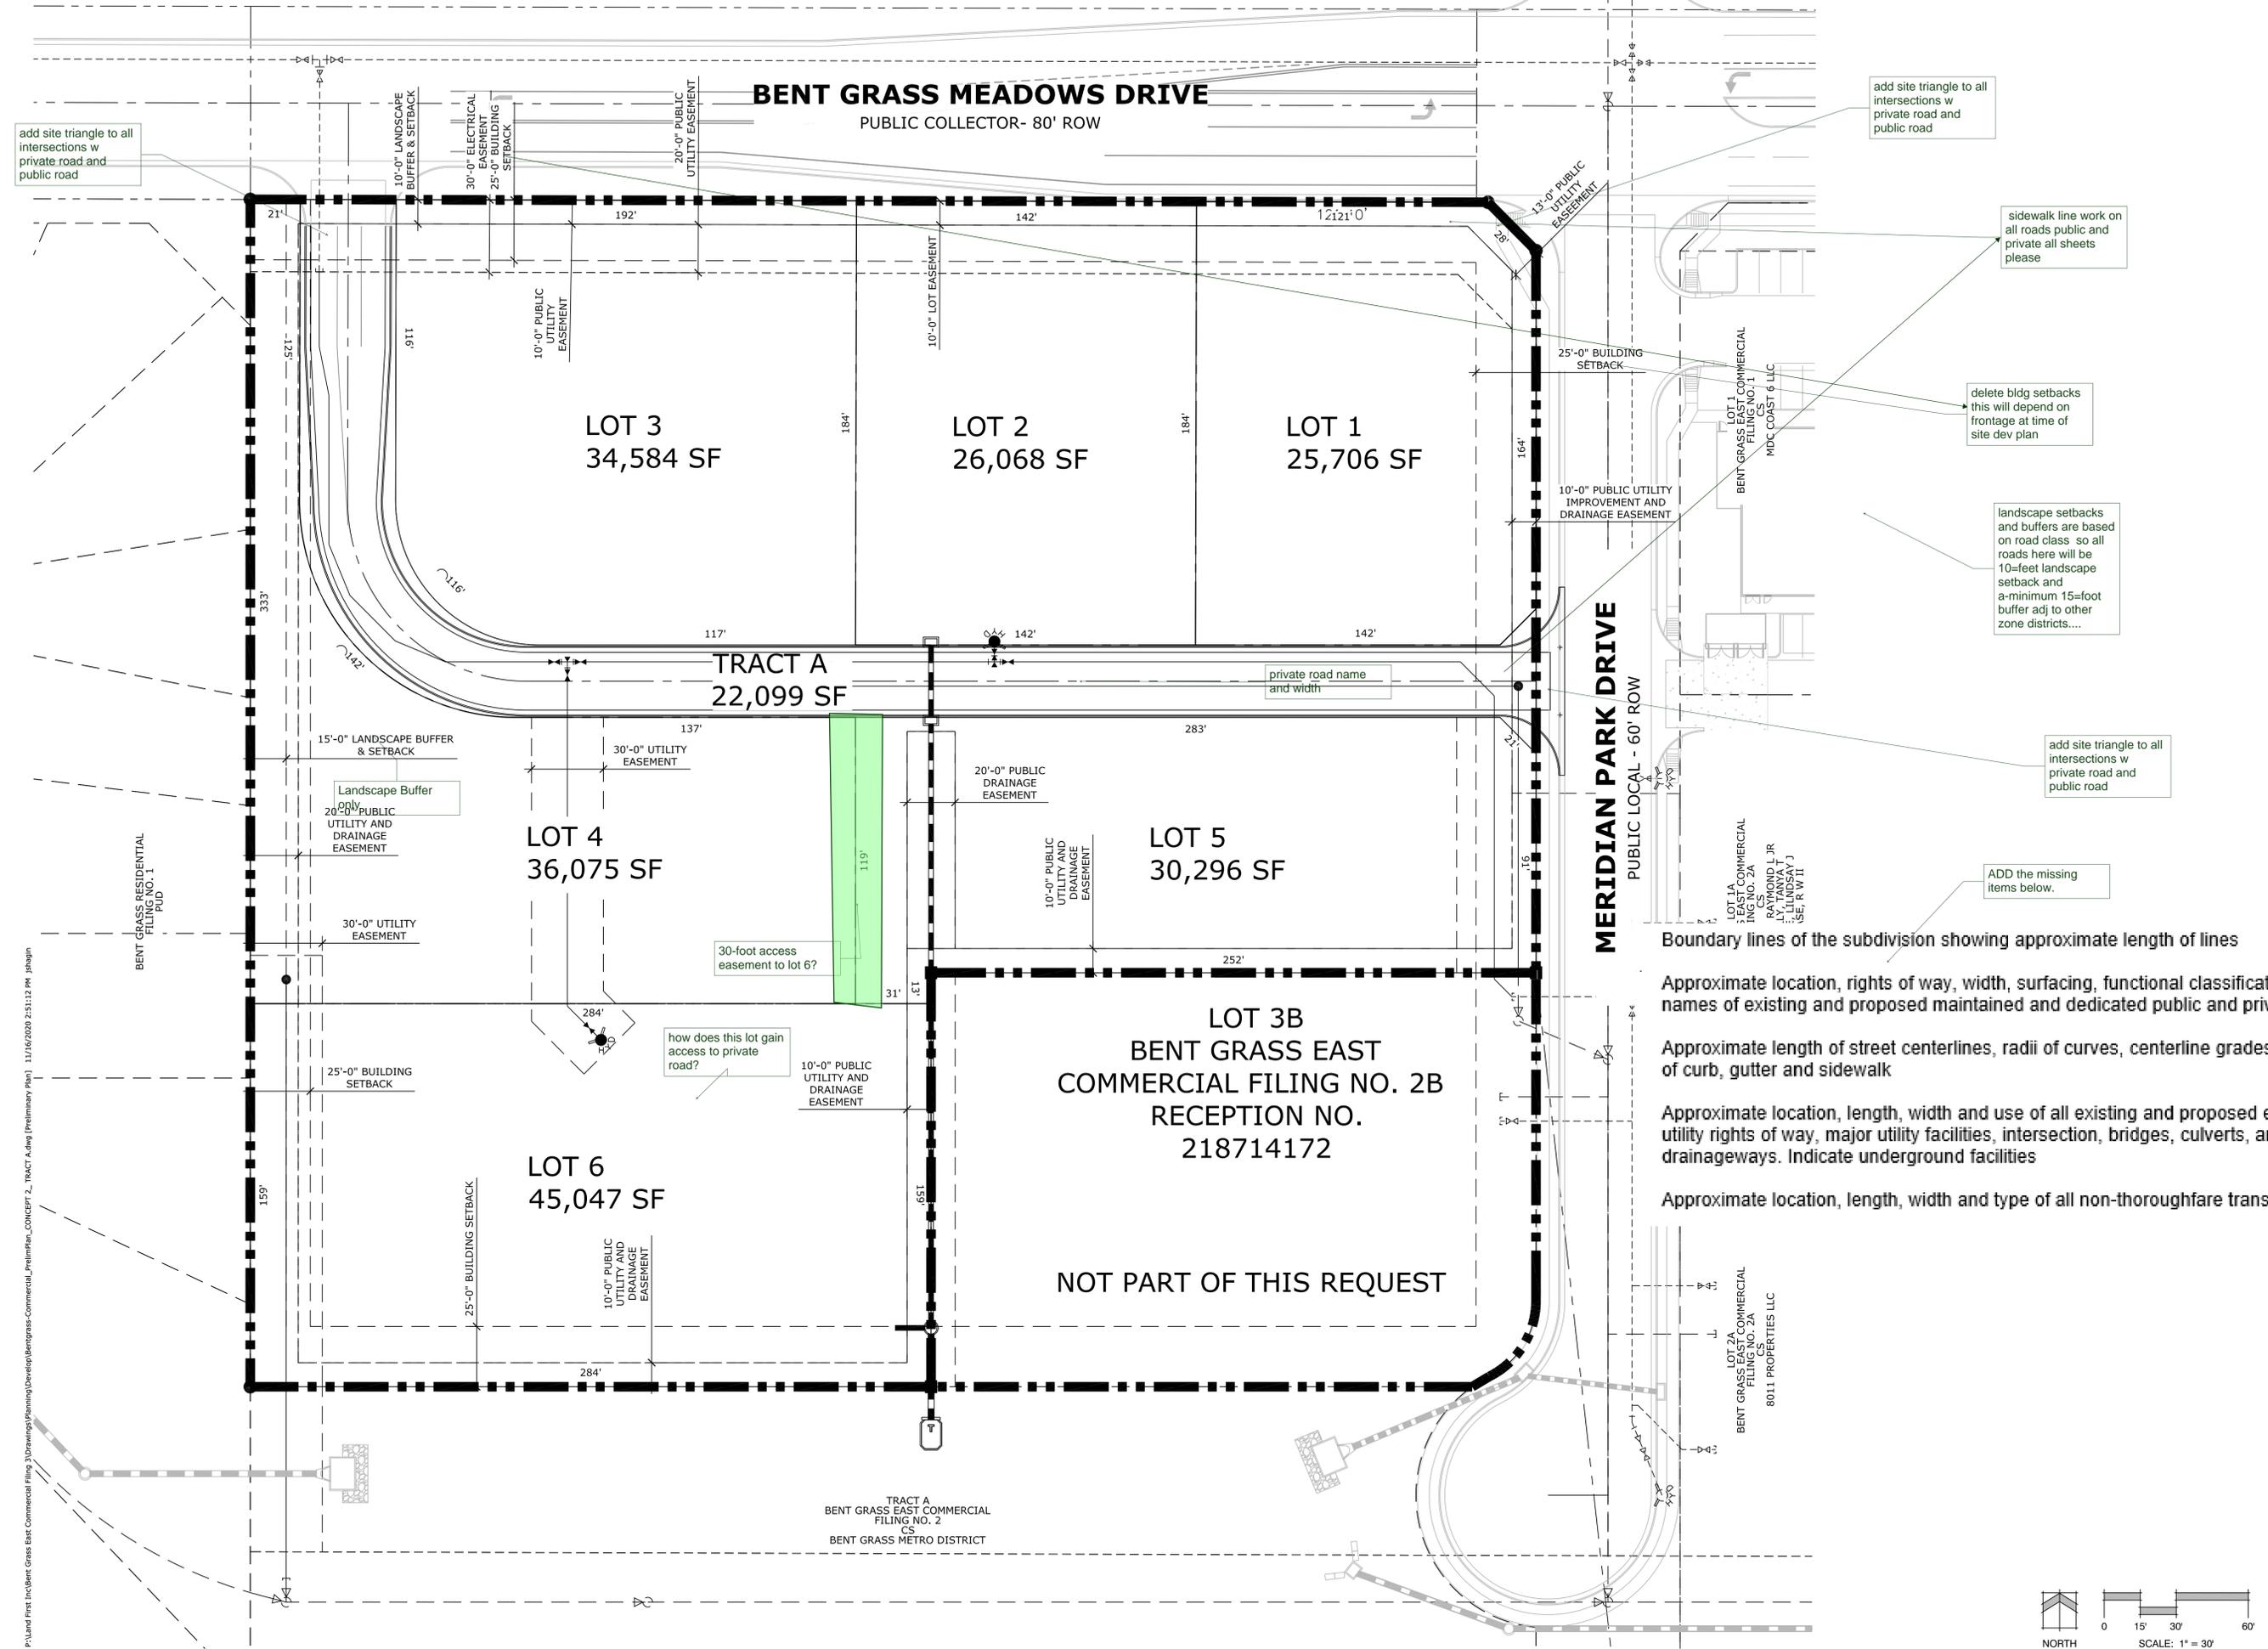

add site triangle to all intersections w private road and public road

sidewalk line work on all roads public and private all sheets please

delete bldg setbacks this will depend on frontage at time of site dev plan

landscape setbacks and buffers are based on road class so all roads here will be 10-foot landscape setback and a minimum 15-foot buffer adj to other zone districts...

add site triangle to all intersections w private road and public road

ADD the missing items below.

BENT GRASS EAST COMMERCIAL FILING 3 PRELIMINARY PLAN 8090 MERIDIAN PARK DR EL PASO COUNTY, CO


- Boundary lines of the subdivision showing approximate length of lines
Approximate location, rights of way, width, surfacing, functional classification, and names of existing and proposed maintained and dedicated public and private streets
Approximate length of street centerlines, radii of curves, centerline grades, and type of curb, gutter and sidewalk
Approximate location, length, width and use of all existing and proposed easements, utility rights of way, major utility facilities, intersection, bridges, culverts, and drainageways. Indicate underground facilities
Approximate location, length, width and type of all non-thoroughfare transportation

Table with columns: DATE, BY, DESCRIPTION


PRELIMINARY PLAN

3 OF 7


CPC #

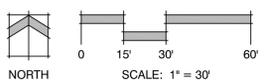

P:\Land First Inc\Bent Grass East Commercial Filing 3\Drawings\Planning\Develop\BentGrass-Commercial\_PrelimPlan\_CONCEPT\_2\_TRACT A.dwg (Preliminary Plan) 11/16/2020 2:51:12 PM jphjgn

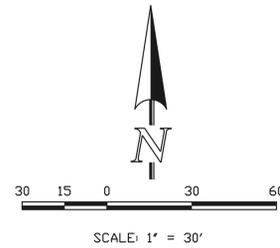

DESCRIPTION	SYMBOL
PROPOSED CONTOUR-10	
PROPOSED CONTOUR-2	
EXISTING CONTOUR-10	
EXISTING CONTOUR-2	
PROPERTY LINE	
BOUNDARY LINE	
PROPOSED STORM SEWER	
PROPOSED STORM INLET	
EXISTING STORM SEWER	
EXISTING STORM INLET	
EXISTING FIRE HYDRANT	
EXISTING WATER MAIN	
EXISTING SANITARY SEWER MAIN W/ MANHOLE	
PROPOSED SANITARY	
PROPOSED WATER	
LIMITS OF DISTURBANCE	
EXISTING FLOW DIRECTION	
PROPOSED FLOW	
HIGH POINT	HP
LOW POINT	LP
OVERFLOW ROUTE	

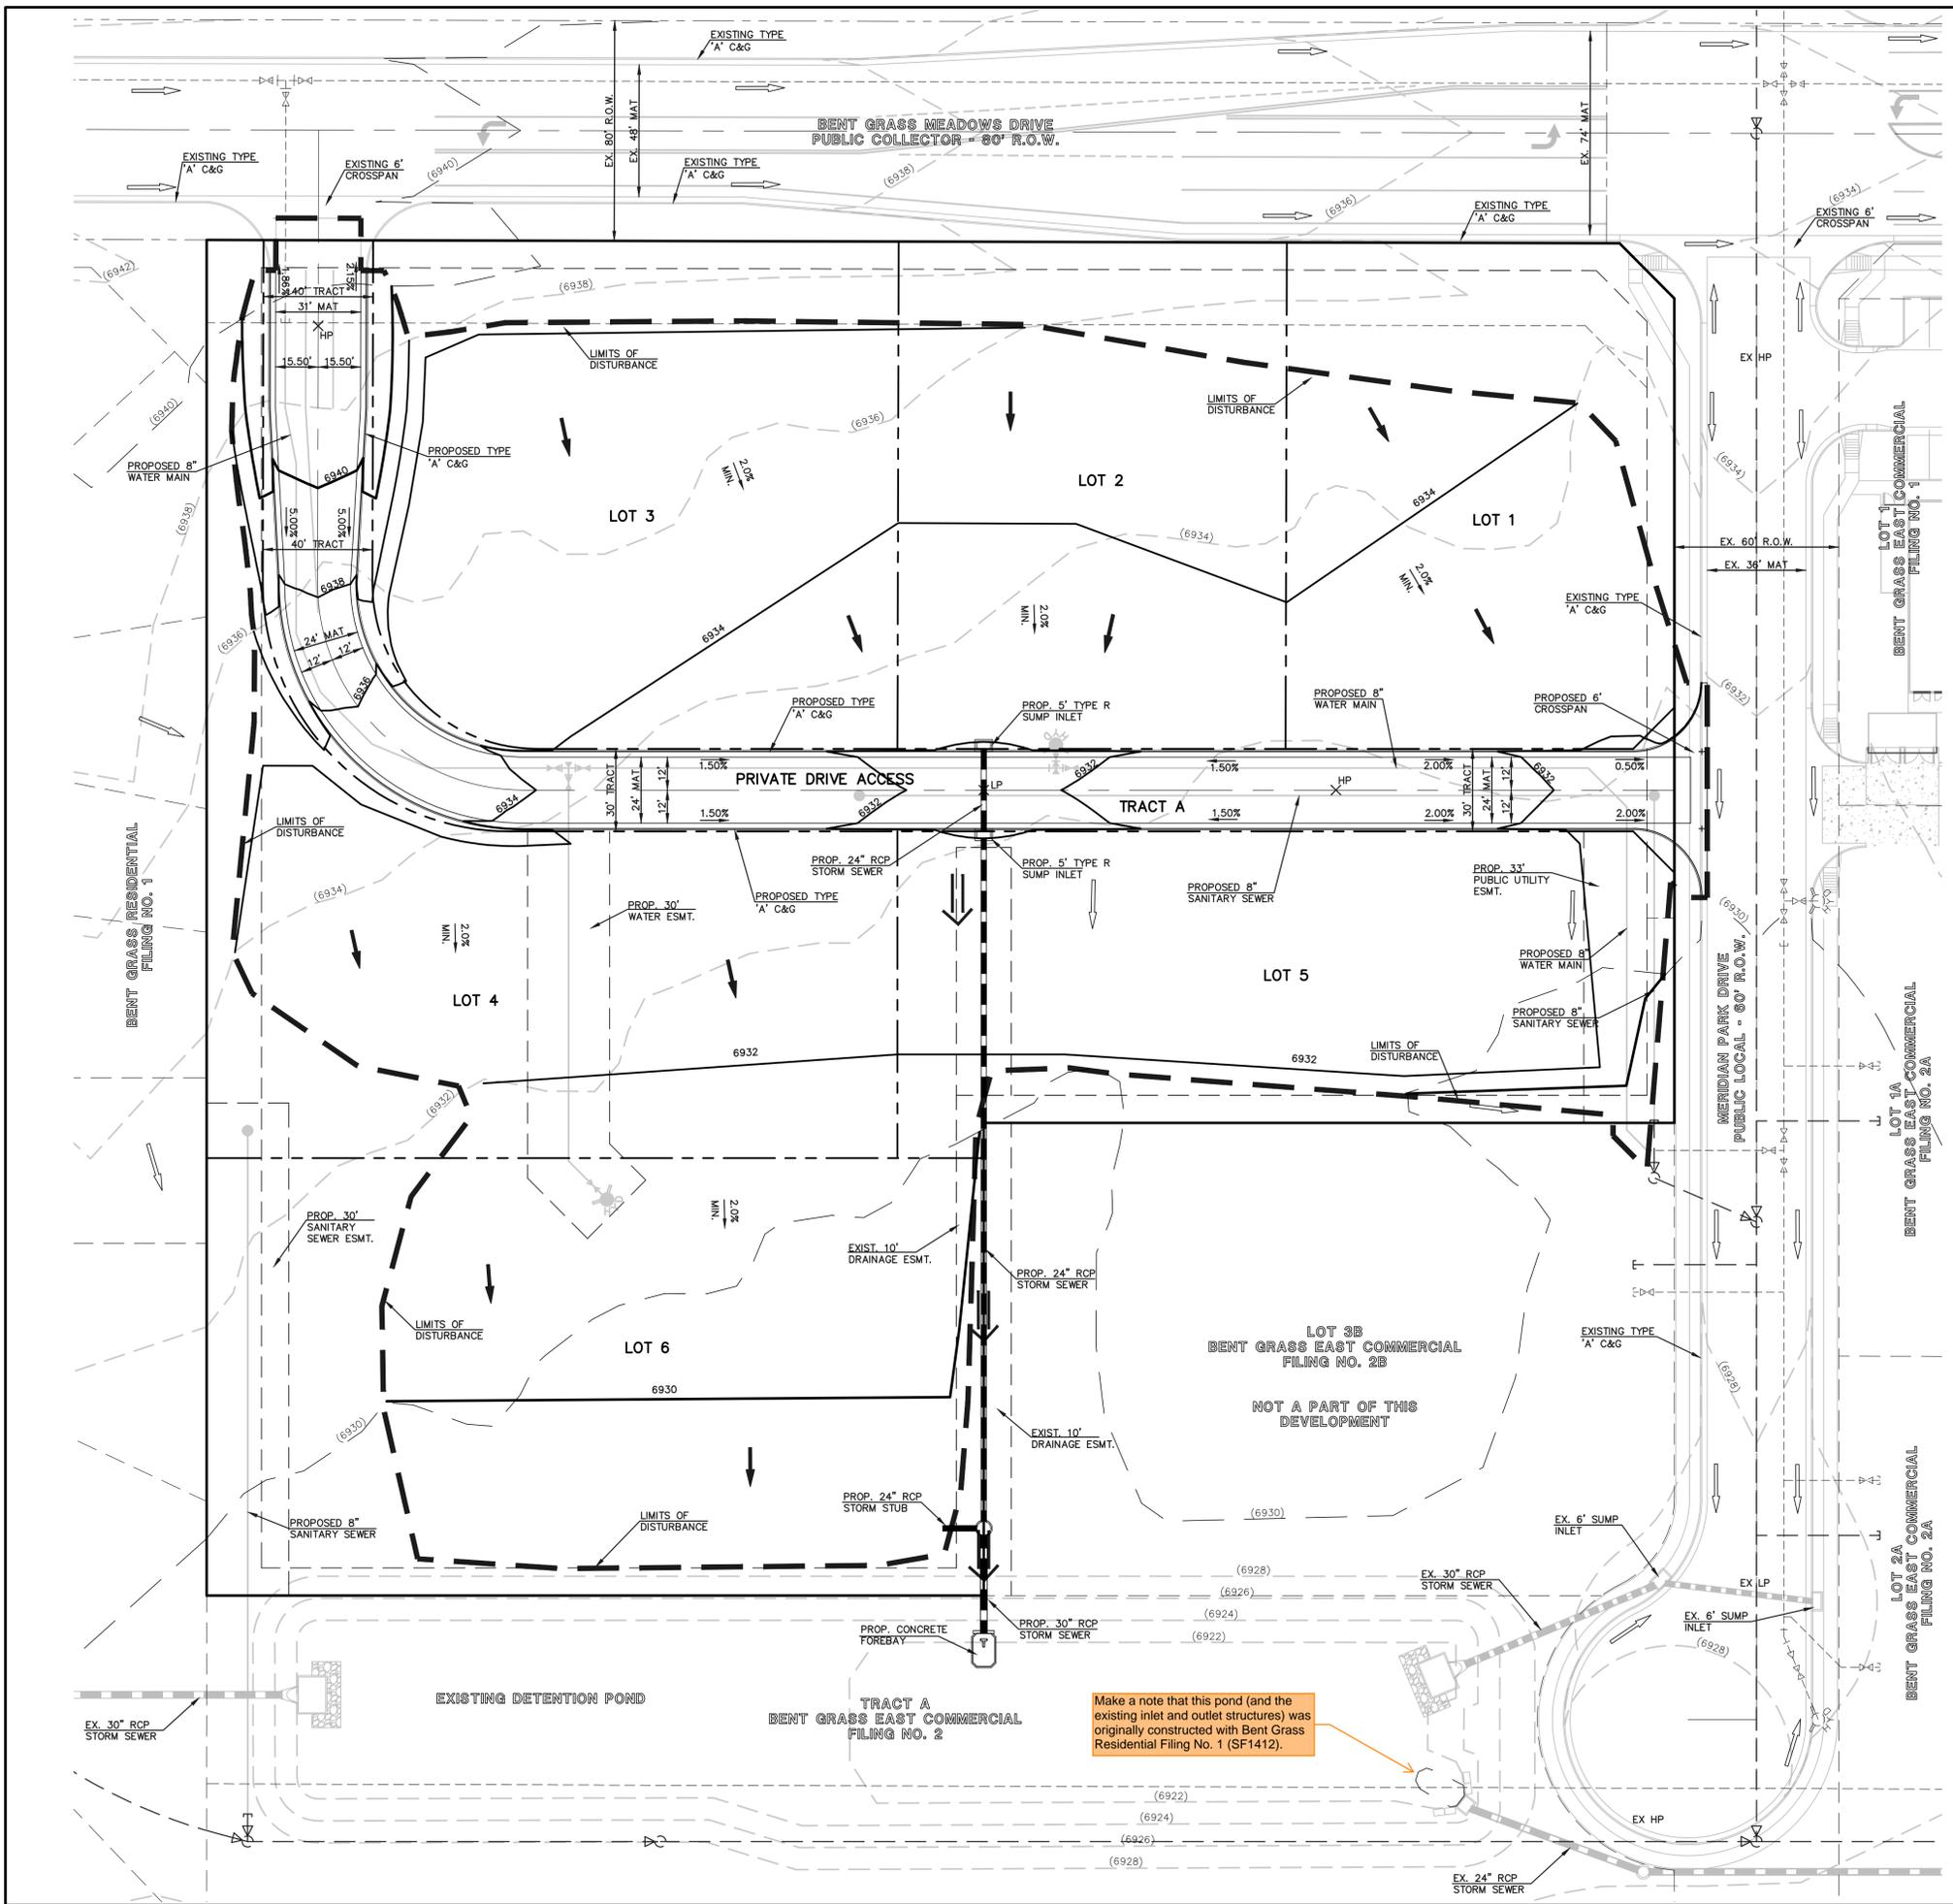

	<b>BENT GRASS EAST COMMERCIAL FILING NO. 3</b> PRELIMINARY PLAN PRELIMINARY GRADING PLAN			
	DESIGNED BY	PRA	SCALE	DATE 10-27-20
	DRAWN BY	PRA	(H) 1" = 30'	SHEET 4 OF 7
	CHECKED BY		(V) 1" = N/A	JOB NO. 2177.64

619 N. Cascade Avenue, Suite 200 (719) 785-0790  
 Colorado Springs, Colorado 80903 (719) 785-0799 (Fax)

N:\217764\DRAWINGS\DEVELOPMENT\217764-PC-01.dwg, 11/9/2020 11:24:28 AM, 1:1



DATE:	BY:	DESCRIPTION:

**LANDSCAPE NOTES**

- ALL PRESERVATION AREAS CONTAINING VEGETATION DESIGNATED TO BE PRESERVED, SHALL BE FENCED OFF DURING CONSTRUCTION TO MINIMIZE DISTURBANCE IN THESE AREAS. ALL FENCING SHALL BE INSTALLED AROUND PRESERVED VEGETATION PRIOR TO ANY GRADING ON THE PROPERTY. A 4-FOOT, ORANGE, CONSTRUCTION SAFETY FENCE SHALL BE USED IN THIS APPLICATION.
- SOIL AMENDMENT - INCORPORATE 3 CUBIC YARDS/1000 S.F. AREA OF CLASS 2 A1 ORGANICS PREMIUM ORGANIC COMPOST ON TALL FESCUE SOD AREAS. INCORPORATE 2 CUBIC YARDS/1000 S.F. AREA OF CLASS 3 COMPOSTED COW MANURE (AGED 1 YEAR) ORGANIC COMPOST TO ALL SEED AREAS. AMENDMENTS MAY CHANGE TO BE BASED ON SOIL ANALYSIS OF FINAL INFILL.
- FOR GRADES REFER TO CIVIL ENGINEERING DRAWINGS.
- CONTRACTOR TO UTILIZE STOCKPILED TOPSOIL FROM GRADING OPERATION AS AVAILABLE. TILL INTO TOP 6" OF SOIL.
- CONTRACTOR TO APPLY EROSION CONTROL BLANKET TO ALL AREAS WITH 3:1 SLOPES.
- ALL SOD SHALL BE TALL FESCUE BLEND.
- NO SOD SHALL BE PLANTED ON SLOPES IN EXCESS OF 6:1 GRADIENT.
- FOR ALL SEED AREAS REFER TO SEED MIXES SPECIFIED ON THIS SHEET.
- ALL NATIVE SEED AREAS SHALL HAVE A TEMPORARY ABOVE-GROUND SPRAY IRRIGATION SYSTEM UTILIZED UNTIL SEED IS ESTABLISHED, AND ALL TREES AND SHRUBS WITHIN NATIVE SEED AREAS SHALL HAVE A PERMANENT DRIP IRRIGATION SYSTEM.
- A FULLY AUTOMATED SPRINKLER IRRIGATION SYSTEM WILL DRIP IRRIGATE ALL TREE, SHRUB, AND GROUND COVER PLANTINGS, AND SPRAY ALL TALL FESCUE SOD AND LOW ALTERNATIVE TURF AREAS. AN IRRIGATION PLAN WILL BE PREPARED AT A LATER DATE AND WILL INCLUDE AN IRRIGATION SCHEDULE THAT NOTES APPLICATION RATES BASED ON TURF TYPE, RATES FOR NEWLY INSTALLED PLANTS VS. ESTABLISHED PLANTS, AND GENERAL RECOMMENDATIONS REGARDING SEASONAL ADJUSTMENTS.
- NO TREES AND NO PLANTS OVER 2 FEET TALL SHALL BE INSTALLED WITHIN 5 FEET OF ANY FIRE HYDRANTS.
- ALL PLANTS TO RECEIVE 3 INCH DEPTH OF GORILLA HAIR SHREDDED CEDAR WOOD MULCH UNLESS OTHERWISE SPECIFIED. FOLLOW PLANTING DETAILS FOR MULCH RING DIMENSIONS WITHIN ROCK, SOD, OR SEED AREAS.
- COBBLE: 2-3" CRIPPLE CREEK ORE, AT 3-4" DEPTH, AT ALL INTERSECTION CORNERS BETWEEN HANDICAP RAMPS. INSTALL GEOTEXTILE FABRIC UNDER ALL COBBLE AREAS.
- GRAVEL ROCK: 3/4" CIMARRON GRANITE, AT 3-4" DEPTH. INSTALL GEOTEXTILE FABRIC UNDER ALL ROCK AREAS.
- ALL SHRUB BEDS TO BE ENCLOSED BY SOLID STEEL EDGING, AS A SEPARATOR FROM SOD, SEED, AND ALTERNATIVE TURF. SEPARATION BETWEEN SOD AND SEED, AND BETWEEN ALTERNATIVE TURF AND SEED SHALL BE A MOWED STRIP, WITHOUT STEEL EDGING.
- SCHEDULE PLANTS SIZES IN TABLE ARE SUGGESTED. PLANTS TO BE CONSIDERED FOR FULFILLING COUNTY LANDSCAPE REQUIREMENTS SHALL HAVE A MINIMUM CALIPER SIZE (MEASURED SIX INCHES ABOVE GROUND) FOR DECIDUOUS SHADE TREES SHALL BE 1-1/2 INCHES AND FOR DECIDUOUS ORNAMENTAL TREES 1 INCH. EVERGREEN TREES SHALL BE A MINIMUM OF 6 FEET IN HEIGHT ABOVE GROUND. SHRUBS SHALL BE A MINIMUM OF 5 GALLON SIZE.
- ALL PLANTS SHOWN IN PRELIMINARY LANDSCAPE PLAN ARE FULFILLING A COUNTY LANDSCAPE REQUIREMENT. ADDITIONAL AND INTERIOR PLANTING WILL BE SHOWN IN FINAL LANDSCAPE PLAN.
- ANY FIELD CHANGES OR DEVIATIONS TO THESE PLANS WITHOUT PRIOR COUNTY APPROVAL OF AN AMENDED SITE DEVELOPMENT PLAN MAY RESULT IN A DELAY OF FINAL APPROVAL AND ISSUANCE OF A CERTIFICATE OF OCCUPANCY.
- THESE PLANS ARE FOR COUNTY APPROVALS ONLY AND ARE NOT TO BE UTILIZED FOR CONSTRUCTION.

**Landscape Setbacks & Buffers**

Street Name or Zone Boundary	Street Classification	Width (in Ft.) Req./Prov.	Linear Footage	Tree/Foot Required	No. of Trees Req./ Prov.
Bent Grass Meadows Drive	Local	10	516	1 / 30'	17/0
West Landscape Buffer	N/A	15	492	1 / 25'	20/10

Meridan Park and private road require 10-landscape setbacks... Do you intend to include the street landscapes and buffers as a requirement for the developer? Or is this plan for all lots to follow? what is the intent with this as it is CR zoning....

**Landscape Buffer & Screens**

Street Name or Property Line	Width (in Ft.) Req. /Prov.	Linear Footage	Buffer Trees (1/25") Required /Provided
PUD to CS Buffer	15 / 15'	492'	20 / 10

site specific lot landscape is required with Site dev plans...ADD note to this plan

Shrub Substitutes (10 SHRUBS/1 TREE) Required /Provided	Percent Ground Plane Veg. Req. / Prov.
60 / 57	75% / 75%

ROADWAY Landscape: 1 tree per30-feet 1/3 shall be evergreen

\*Alternative Landscaping is Requested

**PLANT SCHEDULE**


TREES	CODE	QTY	BOTANICAL / COMMON NAME	HEIGHT	WIDTH
	Pic co2	6	Picea pungens / Colorado Spruce	20'	
	Pin syl	4	Pinus sylvestris / Scotch Pine	20'	
SHRUBS	CODE	QTY	BOTANICAL / COMMON NAME	HEIGHT	WIDTH
	Cor fl2	12	Cornus sericea `Flaviramea` / Yellow Twig Dogwood	8'	8'
	Jun old	20	Juniperus chinensis `Old Gold` / Old Gold Juniper	4'	6'
	Phy cop	25	Physocarpus opulifolius `Coppertina` / Coppertina Ninebark	10'	10'

BUFFER Landscape West Bpoundary


(2) Buffer Between Non-Residential, Multifamily Residential and Single-Family/Duplex Uses.

- (a) **Where Required.** A buffer is required in the following situations:
- (i) Along the lot, parcel, or tract line on the non-residential use property between the non-residential use and a residential zoning district.
  - (ii) Along the lot, parcel, or tract line on the multifamily use property between the multifamily use and a single-family or duplex zoning district.
  - (iii) On the residential side of the project when use to use compatibility is a concern.
- (b) **Depth and Planting Standards.** The required buffer shall be a minimum of 15 feet deep. The minimum number of trees in the buffer shall be one tree for every 25 feet of common lot, parcel, or tract line. A minimum of 1/3 of the trees shall be evergreen trees.
- (c) **Opaque Fencing or Wall Required.** An opaque fence or wall with a minimum height of 6 feet is required along the lot, parcel, or tract line except where the adjacent single-family or duplex residential zoning district or use abuts a required **roadway landscaping** area.
- (d) **Minimum Ground Covering Required.** Bark, wood chips, rock, stone, or other natural **landscape** material shall be used as a non-living ground cover. Areas of a required buffer not covered in approved non-living ground cover material shall be covered in a living plant material.


please update to meet Code

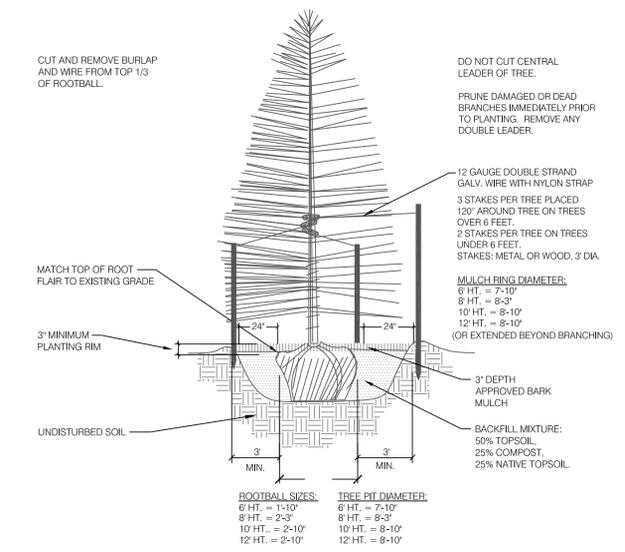

**1 CONIFEROUS TREE PLANTING DETAIL**  
SCALE: NOT TO SCALE

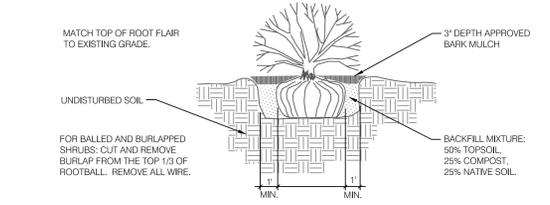

**2 SHRUB PLANTING DETAIL**  
SCALE: NOT TO SCALE

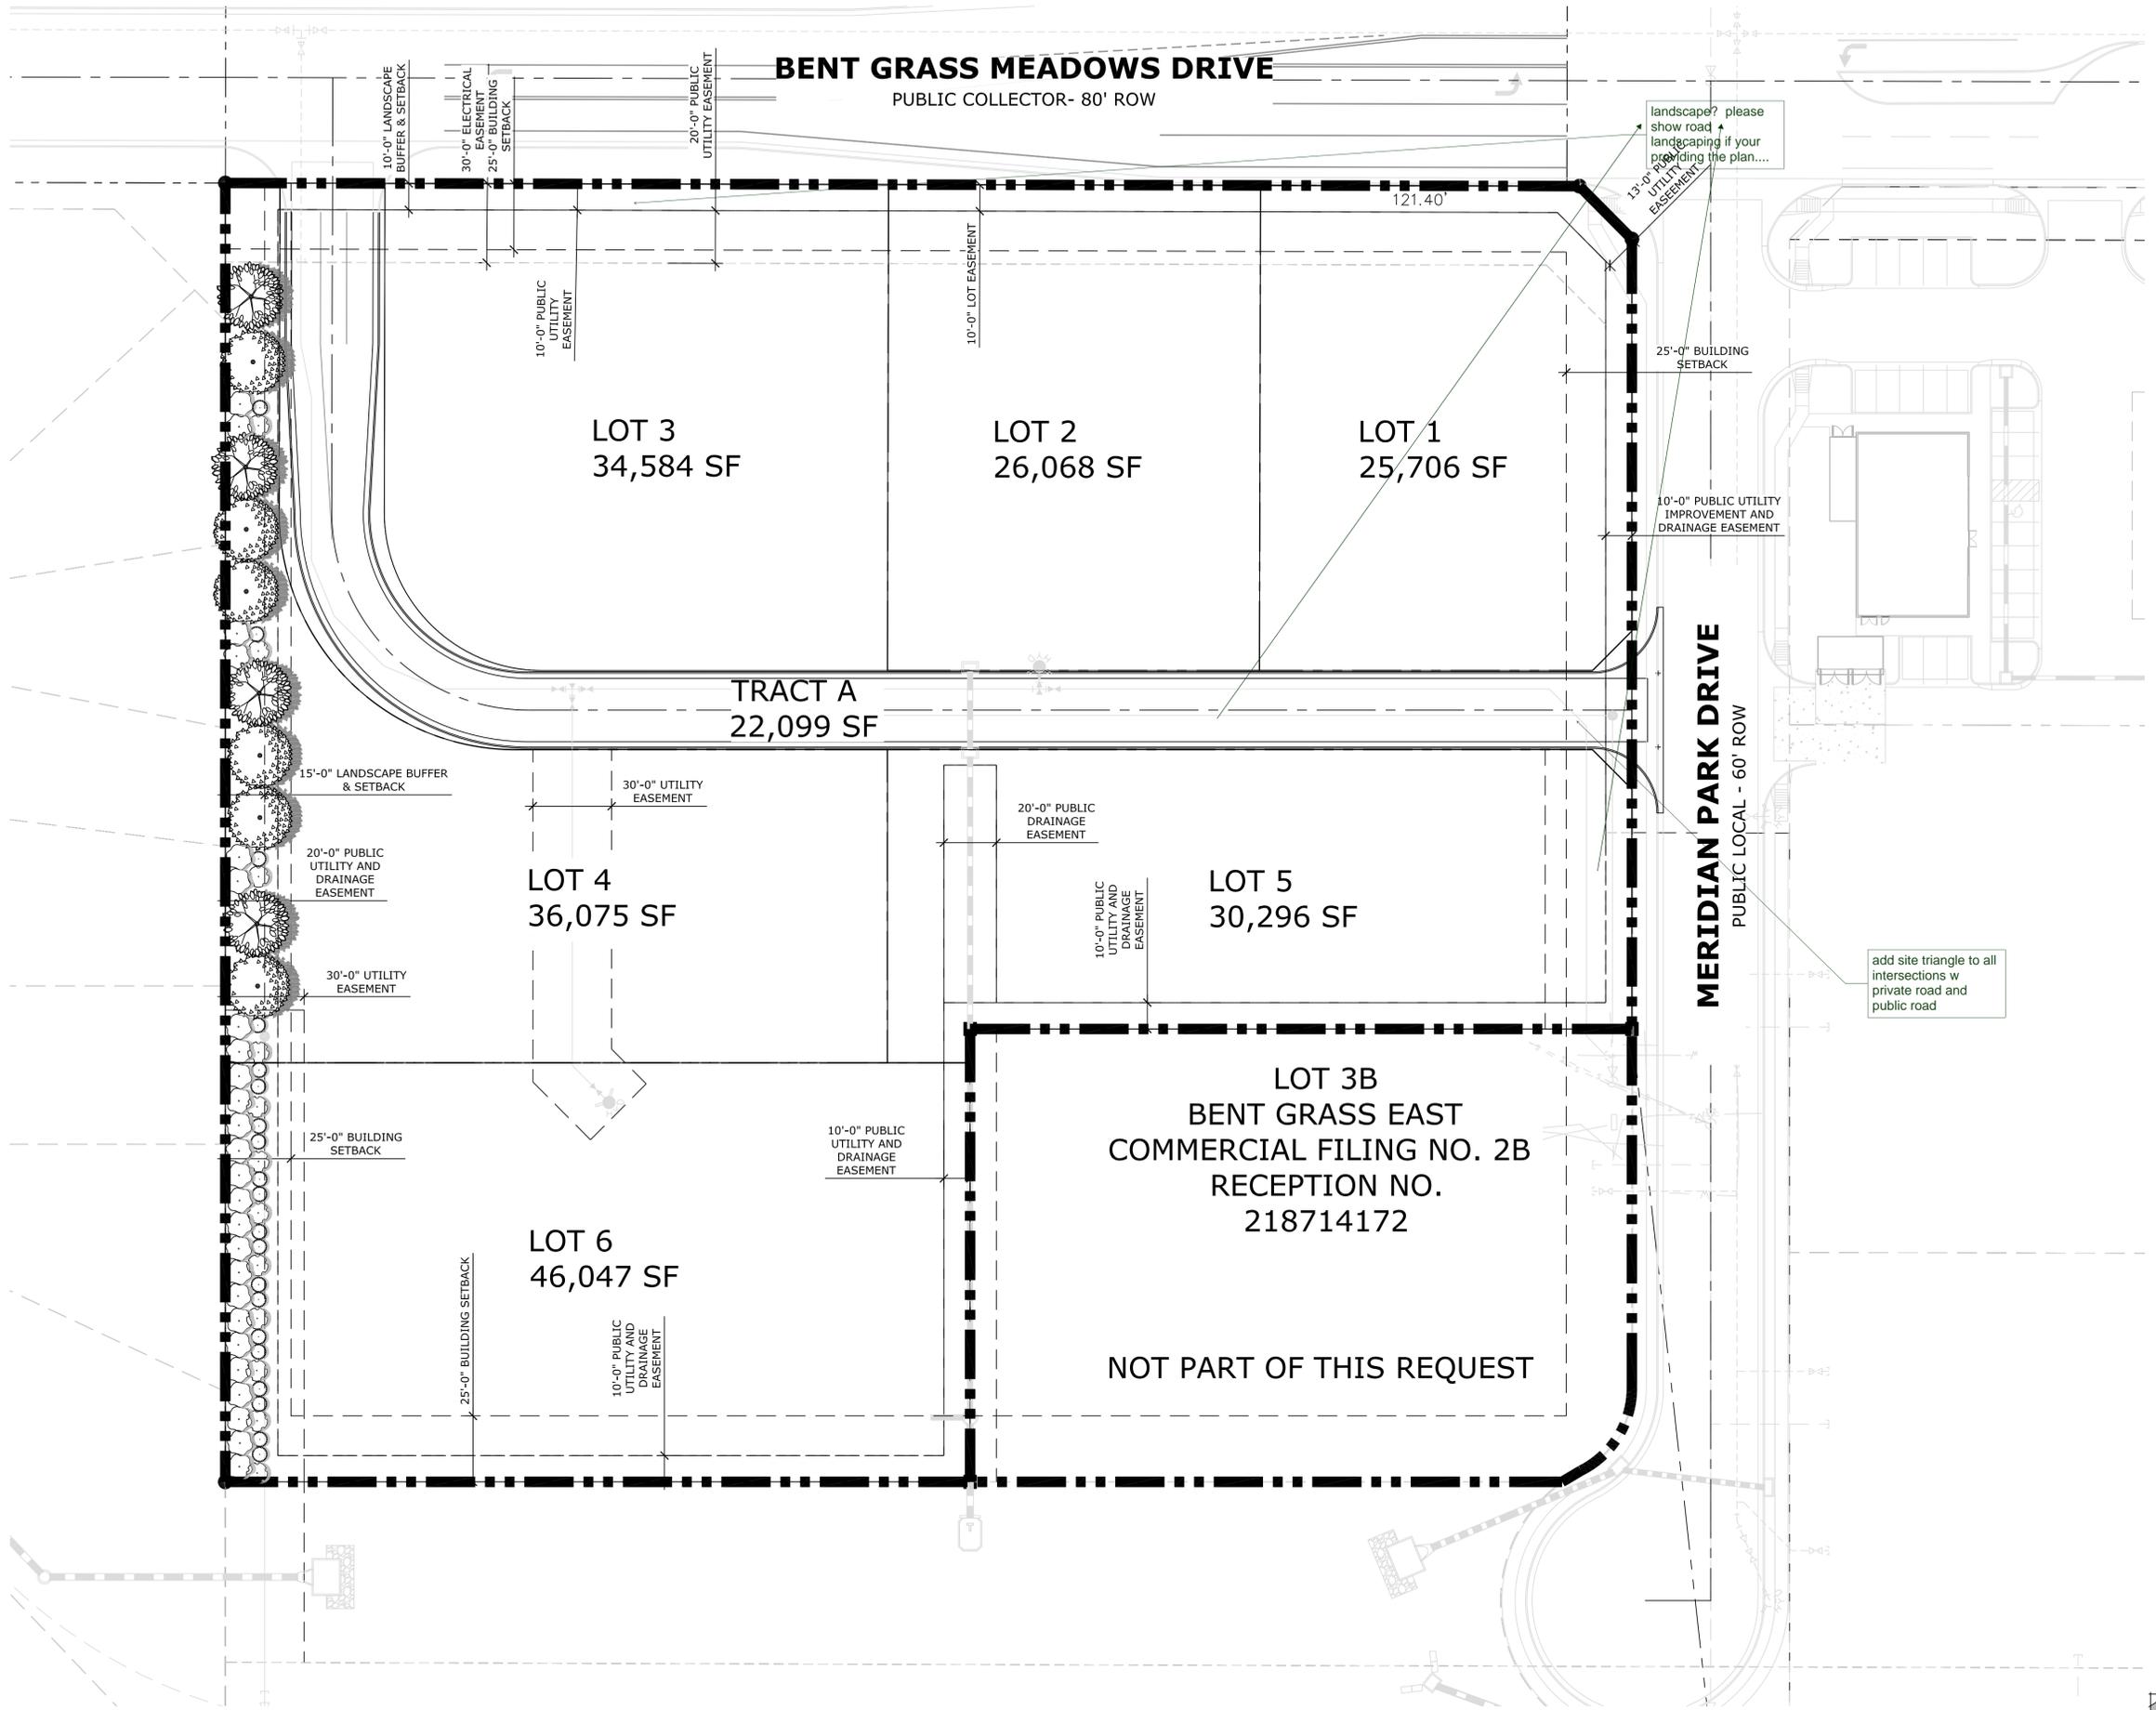

P:\land first inc\client Grass East Commercial Filing 3\Drawings\Planning\Develop\Bentgrass-Commercial\_PrelimPlan\_CONCEPT\_2\_TRACT A.dwg (LS PLAN) 11/16/2020 2:21:00 PM jshagin

**BENT GRASS EAST COMMERCIAL FILING 3**  
PRELIMINARY PLAN  
8090 MERIDIAN PARK DR  
EL PASO COUNTY, CO


DATE: 11.16.20  
PROJECT MGR: E. GANAWAY  
PREPARED BY: J. SHAGIN

ENTITLEMENT

DATE:	BY:	DESCRIPTION:

ALTERNATIVE LANDSCAPE PLAN

**7**  
7 OF 7  
CPC #

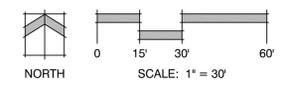


# PrelimPlan V\_1 planning comments only.pdf Markup Summary 1-13-2021

dsdparsons (53)




**Subject:** Image  
**Page Label:** 1  
**Author:** dsdparsons  
**Date:** 1/13/2021 10:53:38 AM  
**Status:**  
**Color:** ■  
**Layer:**  
**Space:**

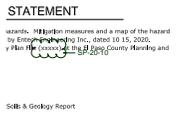


**Subject:** Cloud+ SP-20-10  
**Page Label:** 1  
**Author:** dsdparsons  
**Date:** 1/13/2021 10:54:16 AM  
**Status:**  
**Color:** ■  
**Layer:**  
**Space:**




**Subject:** Callout Private road tract to be owned and maintained by?  
**Page Label:** 1  
**Author:** dsdparsons  
**Date:** 1/13/2021 11:21:04 AM  
**Status:**  
**Color:** ■  
**Layer:**  
**Space:**

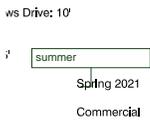


**Subject:** Callout summer  
**Page Label:** 1  
**Author:** dsdparsons  
**Date:** 1/13/2021 11:21:23 AM  
**Status:**  
**Color:** ■  
**Layer:**  
**Space:**

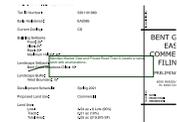

**Subject:** Callout Meridian Market View and Private Road Tract A  
(needs a name) work with enumerations..  
**Page Label:** 1  
**Author:** dsdparsons  
**Date:** 1/13/2021 11:22:11 AM  
**Status:**  
**Color:** ■  
**Layer:**  
**Space:**

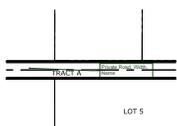

**Subject:** Callout Private Road, Width, Name  
**Page Label:** 1  
**Author:** dsdparsons  
**Date:** 1/13/2021 11:22:42 AM  
**Status:**  
**Color:** ■  
**Layer:**  
**Space:**

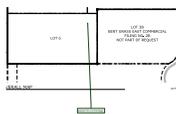

**Subject:** Callout  
**Page Label:** 1  
**Author:** dsdparsons  
**Date:** 1/13/2021 11:24:08 AM  
**Status:**  
**Color:** ■  
**Layer:**  
**Space:**

waiver for no frontage



**Subject:** Image  
**Page Label:** 1  
**Author:** dsdparsons  
**Date:** 1/13/2021 11:27:56 AM  
**Status:**  
**Color:** ■  
**Layer:**  
**Space:**



**Subject:** Image  
**Page Label:** 1  
**Author:** dsdparsons  
**Date:** 1/13/2021 11:30:01 AM  
**Status:**  
**Color:** ■  
**Layer:**  
**Space:**



**Subject:** Easements  
**Page Label:** 1  
**Author:** dsdparsons  
**Date:** 1/13/2021 11:31:18 AM  
**Status:**  
**Color:** ■  
**Layer:**  
**Space:**

**Easements:**  
 Unless otherwise indicated, all side, front, and rear lot lines are hereby platted on either side with a 10 foot (use 5 feet for lots smaller than 2.5 acres) public utility and drainage easement unless otherwise indicated. All exterior subdivision boundaries are hereby platted with a 20 foot (use 7 feet for lots smaller than 2.5 acres) public utility and drainage easement. The sole responsibility for maintenance of these easements is hereby vested with the individual property owners.



**Subject:** Limited Access  
**Page Label:** 1  
**Author:** dsdparsons  
**Date:** 1/13/2021 11:31:46 AM  
**Status:**  
**Color:** ■  
**Layer:**  
**Space:**

**Access Limitation:**  
 There shall be no direct lot access to \_\_\_\_\_ Road.




**Subject:** Text Box  
**Page Label:** 1  
**Author:** dsdparsons  
**Date:** 1/13/2021 11:33:08 AM  
**Status:**  
**Color:** ■  
**Layer:**  
**Space:**

Bent Grass Meadows (Please check with engineering on Meridian Park access)

Woodmen Road District Note:  
All property within this subdivision is within the boundaries  
of the Woodmen Road Metropolitan District and, as such, is  
subject to a mill levy, platting fees and building permit fees for the  
purpose of financing construction of specified  
improvements to Woodmen Road.

Subject: Woodmen Road  
Page Label: 1  
Author: dsdparsons  
Date: 1/13/2021 11:34:03 AM  
Status:  
Color: ■  
Layer:  
Space:

Woodmen Road District Note:  
All property within this subdivision is within the boundaries of the Woodmen Road Metropolitan District and, as such, is subject to a mill levy, platting fees and building permit fees for the purpose of financing construction of specified improvements to Woodmen Road.

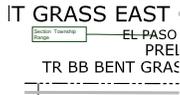


Subject: Callout  
Page Label: 1  
Author: dsdparsons  
Date: 1/13/2021 11:34:28 AM  
Status:  
Color: ■  
Layer:  
Space:

Section Township Range




Subject: Callout  
Page Label: 1  
Author: dsdparsons  
Date: 1/13/2021 11:35:08 AM  
Status:  
Color: ■  
Layer:  
Space:

remove it will be a replat of this at plat stage

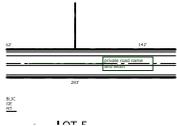

Subject: Callout  
Page Label: 3  
Author: dsdparsons  
Date: 1/13/2021 11:58:25 AM  
Status:  
Color: ■  
Layer:  
Space:

private road name and width

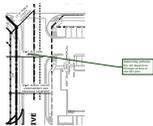

Subject: Callout  
Page Label: 3  
Author: dsdparsons  
Date: 1/13/2021 11:59:37 AM  
Status:  
Color: ■  
Layer:  
Space:

delete bldg setbacks this will depend on frontage at time of site dev plan



Subject: Callout  
Page Label: 3  
Author: dsdparsons  
Date: 1/13/2021 12:00:46 PM  
Status:  
Color: ■  
Layer:  
Space:

landscape setbacks and buffers are based on road class so all roads here will be 10-foot landscape setback and a minimum 15-foot buffer adj to other zone districts....




Subject: Arrow  
 Page Label: 3  
 Author: dsdparsons  
 Date: 1/13/2021 12:01:41 PM  
 Status:  
 Color: ■  
 Layer:  
 Space:



Subject: Callout  
 Page Label: 3  
 Author: dsdparsons  
 Date: 1/13/2021 12:02:42 PM  
 Status:  
 Color: ■  
 Layer:  
 Space:

Landscape Buffer only

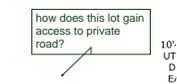


Subject: Callout  
 Page Label: 3  
 Author: dsdparsons  
 Date: 1/13/2021 12:03:15 PM  
 Status:  
 Color: ■  
 Layer:  
 Space:

how does this lot gain access to private road?



Subject: Callout  
 Page Label: 3  
 Author: dsdparsons  
 Date: 1/13/2021 12:04:04 PM  
 Status:  
 Color: ■  
 Layer:  
 Space:

title all sheets

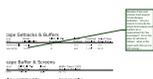


Subject: Callout  
 Page Label: 6  
 Author: dsdparsons  
 Date: 1/13/2021 12:06:30 PM  
 Status:  
 Color: ■  
 Layer:  
 Space:

Meridan Park and private road require 10-landscape setbacks.. Do you intend to include the street landscapes and buffers as a requirement for the developer? Or is this plan for all lots to follow? what is the intent with this as it is CR zoning....




Subject: Callout  
 Page Label: 6  
 Author: dsdparsons  
 Date: 1/13/2021 12:07:02 PM  
 Status:  
 Color: ■  
 Layer:  
 Space:


site specific lot landscape is required with Site dev plans...ADD note to this plan

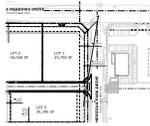

Subject: Arrow  
 Page Label: 7  
 Author: dsdparsons  
 Date: 1/13/2021 12:08:31 PM  
 Status:  
 Color: ■  
 Layer:  
 Space:

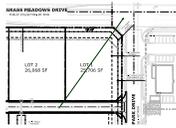

Subject: Arrow  
 Page Label: 7  
 Author: dsdparsons  
 Date: 1/13/2021 12:08:36 PM  
 Status:  
 Color: ■  
 Layer:  
 Space:

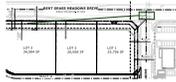

Subject: Callout  
 Page Label: 7  
 Author: dsdparsons  
 Date: 1/13/2021 12:09:17 PM  
 Status:  
 Color: ■  
 Layer:  
 Space:

landscape? please show road landscaping if your providing the plan....




Subject: Callout  
 Page Label: 6  
 Author: dsdparsons  
 Date: 1/13/2021 12:11:44 PM  
 Status:  
 Color: ■  
 Layer:  
 Space:

ROADWAY Landscape: 1 tree per30-feet 1/3 shall be evergreen



Subject: Image  
 Page Label: 6  
 Author: dsdparsons  
 Date: 1/13/2021 12:12:25 PM  
 Status:  
 Color: ■  
 Layer:  
 Space:

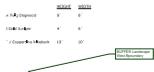

Subject: Callout  
 Page Label: 6  
 Author: dsdparsons  
 Date: 1/13/2021 12:12:50 PM  
 Status:  
 Color: ■  
 Layer:  
 Space:

BUFFER Landscape West Bpoundary

please update to meet Code


**Subject:** Callout  
**Page Label:** 6  
**Author:** dsdparsons  
**Date:** 1/13/2021 12:13:15 PM  
**Status:**  
**Color:** ■  
**Layer:**  
**Space:**

please update to meet Code



**Subject:** Callout  
**Page Label:** 7  
**Author:** dsdparsons  
**Date:** 1/13/2021 12:14:43 PM  
**Status:**  
**Color:** ■  
**Layer:**  
**Space:**

add site triangle to all intersections w private road and public road

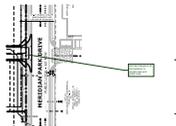


**Subject:** Callout  
**Page Label:** 3  
**Author:** dsdparsons  
**Date:** 1/13/2021 12:15:03 PM  
**Status:**  
**Color:** ■  
**Layer:**  
**Space:**

add site triangle to all intersections w private road and public road




**Subject:** Callout  
**Page Label:** 3  
**Author:** dsdparsons  
**Date:** 1/13/2021 12:15:18 PM  
**Status:**  
**Color:** ■  
**Layer:**  
**Space:**

add site triangle to all intersections w private road and public road

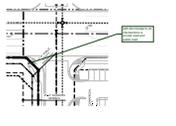


**Subject:** Callout  
**Page Label:** 3  
**Author:** dsdparsons  
**Date:** 1/13/2021 12:15:35 PM  
**Status:**  
**Color:** ■  
**Layer:**  
**Space:**

add site triangle to all intersections w private road and public road

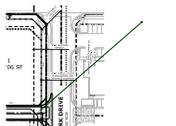

**Subject:** Arrow  
**Page Label:** 3  
**Author:** dsdparsons  
**Date:** 1/13/2021 12:16:27 PM  
**Status:**  
**Color:** ■  
**Layer:**  
**Space:**

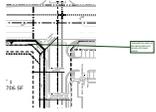

**Subject:** Callout  
**Page Label:** 3  
**Author:** dsdparsons  
**Date:** 1/13/2021 12:16:49 PM  
**Status:**  
**Color:** ■  
**Layer:**  
**Space:**


sidewalk line work on all roads public and private  
 all sheets please



**Subject:** Image  
**Page Label:** 1  
**Author:** dsdparsons  
**Date:** 1/13/2021 12:22:22 PM  
**Status:**  
**Color:** ■  
**Layer:**  
**Space:**

**Subject:** Private Road  
**Page Label:** 1  
**Author:** dsdparsons  
**Date:** 1/13/2021 12:22:30 PM  
**Status:**  
**Color:** ■  
**Layer:**  
**Space:**

Private Roads:  
 The private roads as shown on this plat will not be maintained by El Paso County until and unless the streets are constructed in conformance with El Paso County standards in effect at the date of the request for dedication and maintenance.

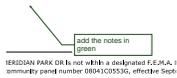


**Subject:** Callout  
**Page Label:** 1  
**Author:** dsdparsons  
**Date:** 1/13/2021 12:23:04 PM  
**Status:**  
**Color:** ■  
**Layer:**  
**Space:**

add the notes in green



**Subject:** Callout  
**Page Label:** 1  
**Author:** dsdparsons  
**Date:** 1/13/2021 12:23:19 PM  
**Status:**  
**Color:** ■  
**Layer:**  
**Space:**

prelim checklist requires this for legal

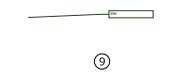


**Subject:** Callout  
**Page Label:** 2  
**Author:** dsdparsons  
**Date:** 1/13/2021 12:23:59 PM  
**Status:**  
**Color:** ■  
**Layer:**  
**Space:**

title



Subject: Image  
 Page Label: 2  
 Author: dsdparsons  
 Date: 1/13/2021 12:24:20 PM  
 Status:  
 Color: ■  
 Layer:  
 Space:

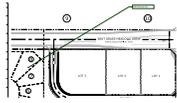

Subject: Callout  
 Page Label: 2  
 Author: dsdparsons  
 Date: 1/13/2021 12:24:32 PM  
 Status:  
 Color: ■  
 Layer:  
 Space:

add missing info




Subject: Callout  
 Page Label: 3  
 Author: dsdparsons  
 Date: 1/13/2021 12:25:32 PM  
 Status:  
 Color: ■  
 Layer:  
 Space:

ADD the missing items below.



Subject: Image  
 Page Label: 3  
 Author: dsdparsons  
 Date: 1/13/2021 12:25:52 PM  
 Status:  
 Color: ■  
 Layer:  
 Space:

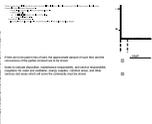

Subject: Image  
 Page Label: 1  
 Author: dsdparsons  
 Date: 1/13/2021 12:26:57 PM  
 Status:  
 Color: ■  
 Layer:  
 Space:




Subject: Callout  
 Page Label: 1  
 Author: dsdparsons  
 Date: 1/13/2021 12:27:42 PM  
 Status:  
 Color: ■  
 Layer:  
 Space:

checklist items from prelim plan checklist to be added




**Subject:** Callout  
**Page Label:** 1  
**Author:** dsdparsons  
**Date:** 1/13/2021 12:33:34 PM  
**Status:**  
**Color:** ■  
**Layer:**  
**Space:**

add mitigation note who is responsible to maintain?

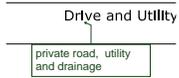

**Subject:** Callout  
**Page Label:** 2  
**Author:** dsdparsons  
**Date:** 1/13/2021 12:34:26 PM  
**Status:**  
**Color:** ■  
**Layer:**  
**Space:**

private road, utility and drainage

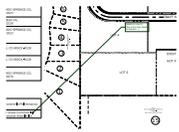

**Subject:** Callout  
**Page Label:** 2  
**Author:** dsdparsons  
**Date:** 1/13/2021 12:35:11 PM  
**Status:**  
**Color:** ■  
**Layer:**  
**Space:**

details for tract A (this is the tract sheet as labeled....)




**Subject:** Callout  
**Page Label:** 3  
**Author:** dsdparsons  
**Date:** 1/13/2021 12:36:24 PM  
**Status:**  
**Color:** ■  
**Layer:**  
**Space:**

30-foot access easement to lot 6?



**Subject:** Polygon  
**Page Label:** 3  
**Author:** dsdparsons  
**Date:** 1/13/2021 12:36:59 PM  
**Status:**  
**Color:** ■  
**Layer:**  
**Space:**

Daniel Torres (1)

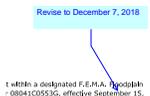


**Subject:** Callout  
**Page Label:** 1  
**Author:** Daniel Torres  
**Date:** 1/12/2021 3:51:53 PM  
**Status:**  
**Color:** ■  
**Layer:**  
**Space:**

Revise to December 7, 2018

---

GReese (2)

---

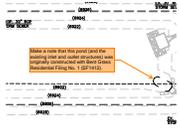

**Subject:** SW - Comment  
**Page Label:** 4  
**Author:** GReese  
**Date:** 12/21/2020 10:30:26 AM  
**Status:**  
**Color:** ■  
**Layer:**  
**Space:**

Make a note that this pond (and the existing inlet and outlet structures) was originally constructed with Bent Grass Residential Filing No. 1 (SF1412).

PCD Filing No.:  
SP-20-010

---

**Subject:** SW - Text Box  
**Page Label:** 1  
**Author:** GReese  
**Date:** 12/21/2020 12:22:57 PM  
**Status:**  
**Color:** ■  
**Layer:**  
**Space:**

PCD Filing No.: SP-20-010