


What is this?



SITE PLAN

SCALE: 1" = 10'-0"

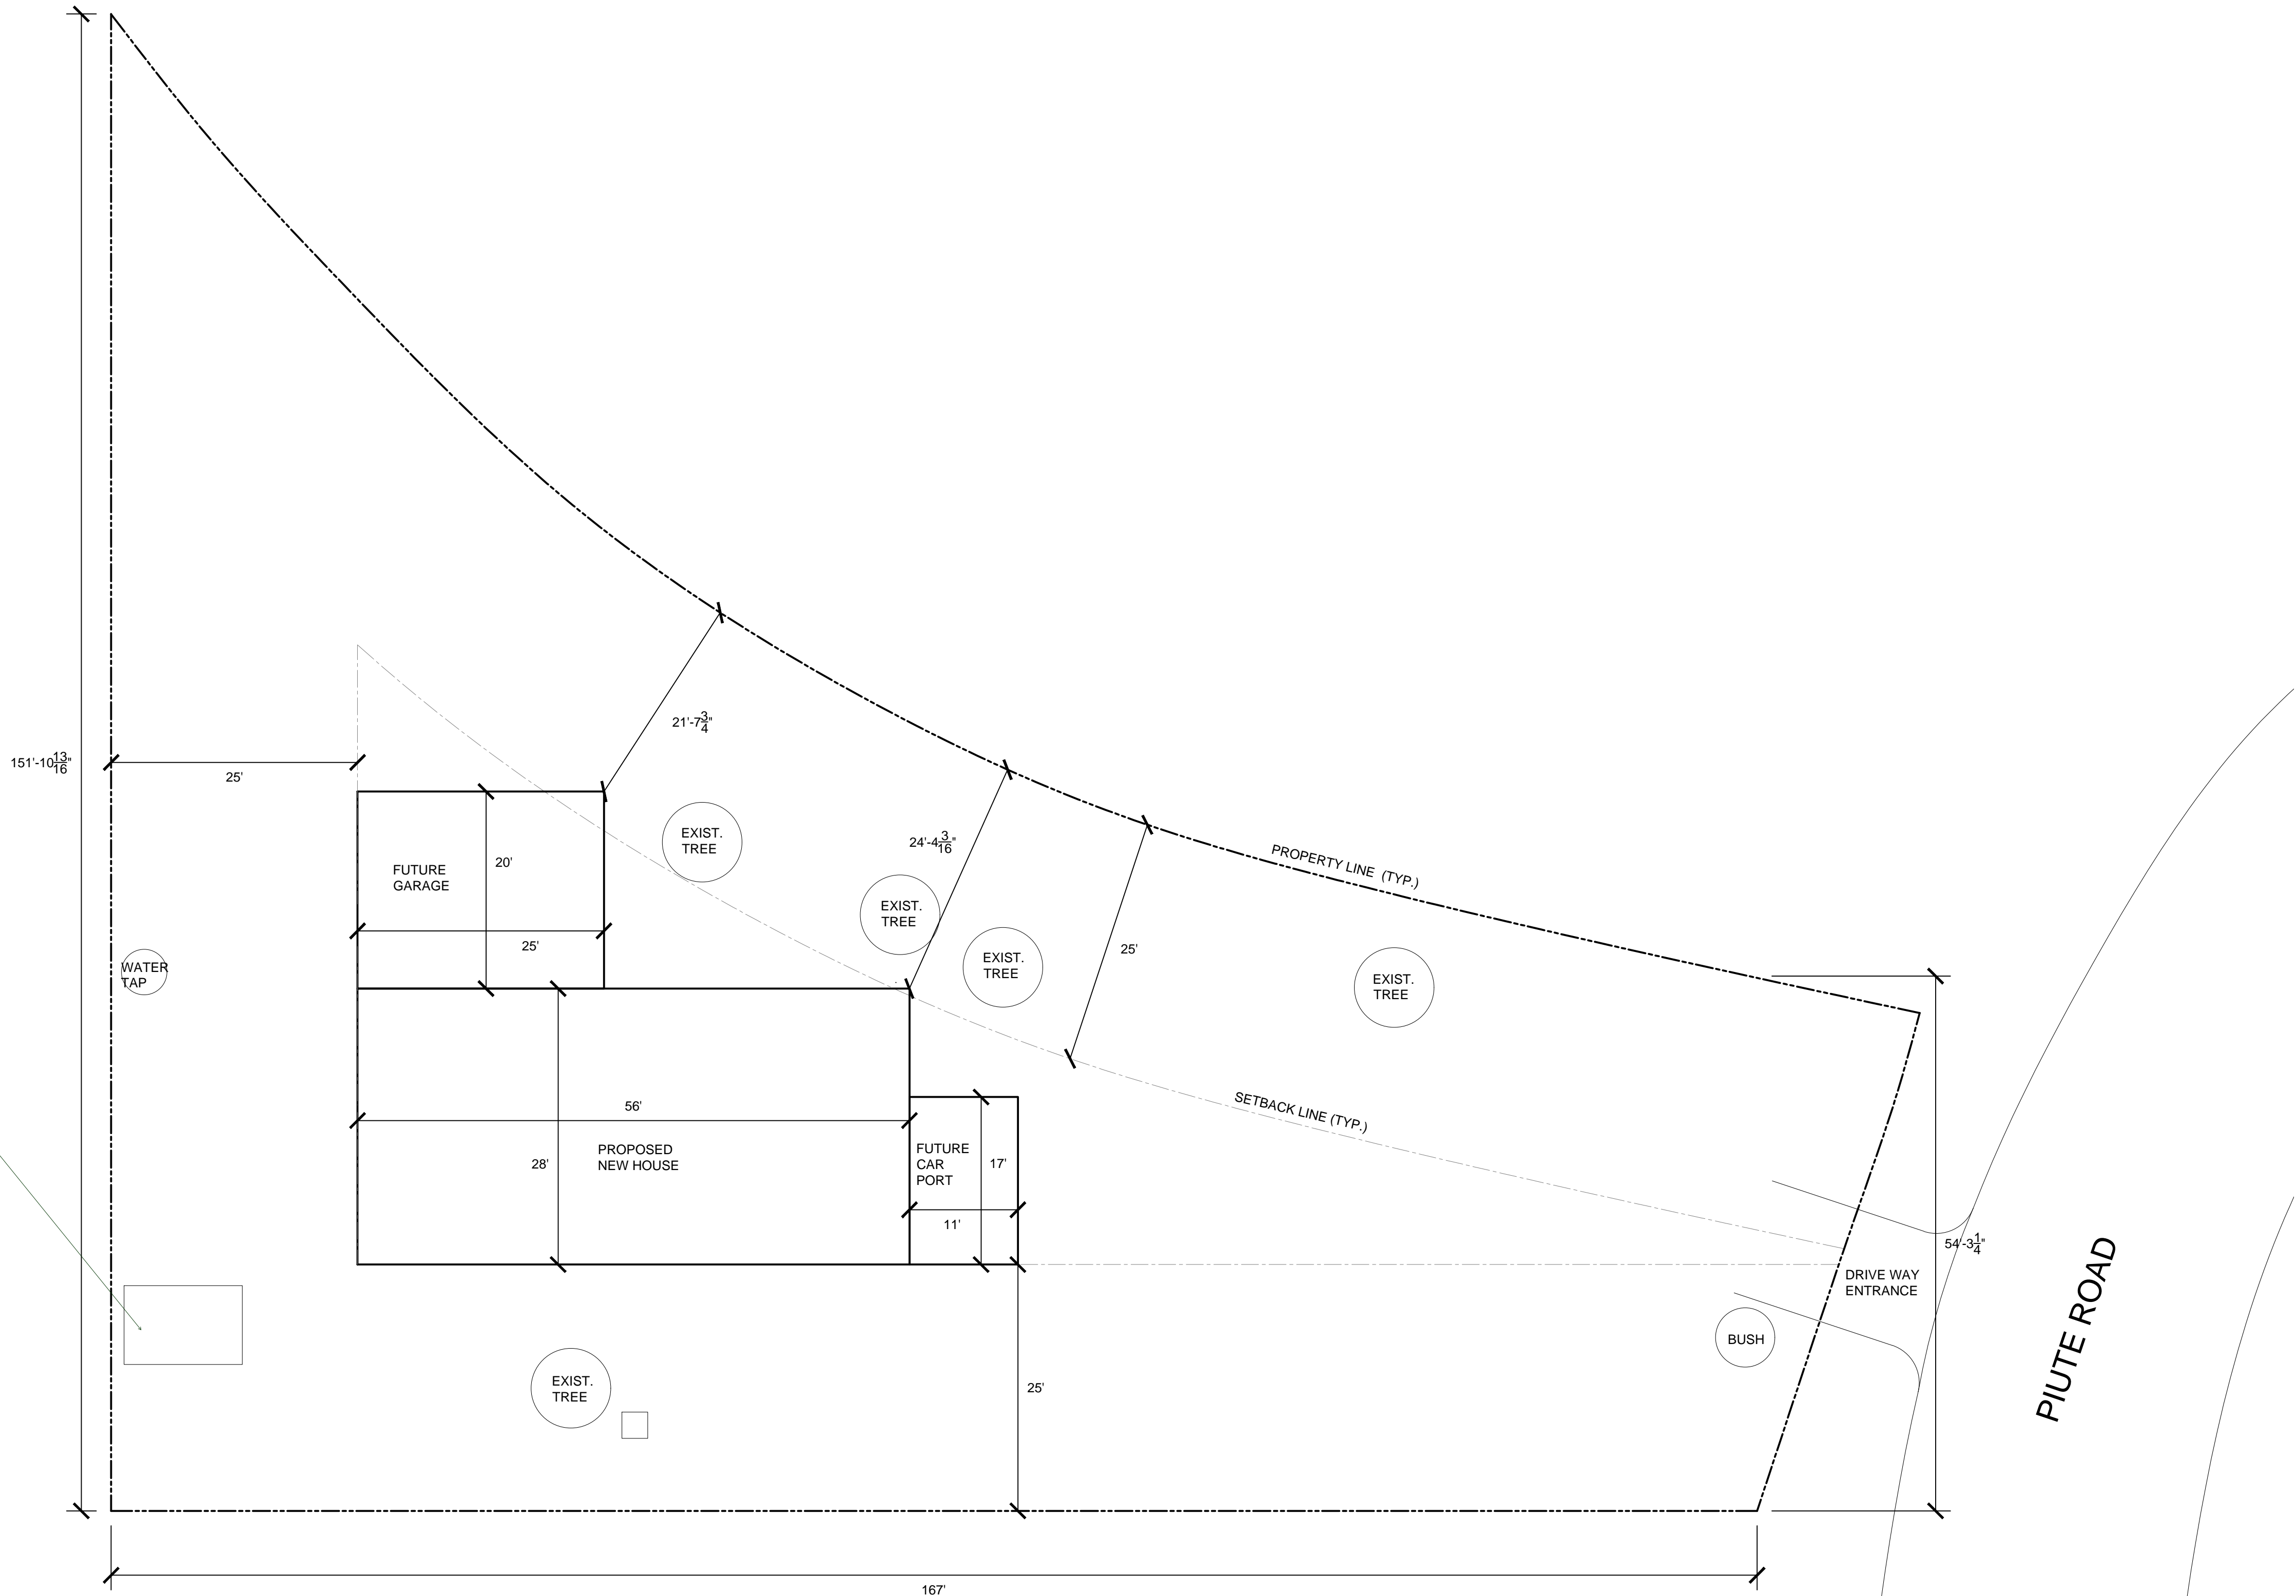

SITE DETAILS	
PARCIAL #	6530300018
LOT #	23BL CCK3
LOT SIZE:	35 ACRE = 15246 SF
TOTAL PROPOSED STRUCTURE SIZE:	2162.5 SF
MAX ALLOWED COVERAGE:	3811.5 SF

Elizabeth & Dan Ra[^] Home
8240 Piute Road
Colorado Springs, Colorado 80926

ISSUE RECORD:

SHEET DESCRIPTION:


BUILDING	SITE PLAN
DRAWN BY:	DM
SCALE:	AS NOTED

DATE OF ISSUE:

SHEET NUMBER:

Site Plan_v1-redline.pdf Markup Summary

dsdkendall (1)

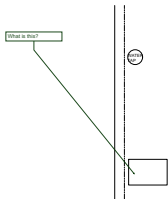

Subject: Callout
Page Label: 1
Lock: Unlocked
Author: dsdkendall
Date: 6/27/2019 8:08:49 AM
Status:
Color:
Layer:
Space:

What is this?