


C:\Users\Owner\Desktop\psprojects\040201.walden\dwg\civil\WALDEN_PRESERVE_2\FILG-A\C2.1A.dwg Dec 17, 2021 - 2:17pm

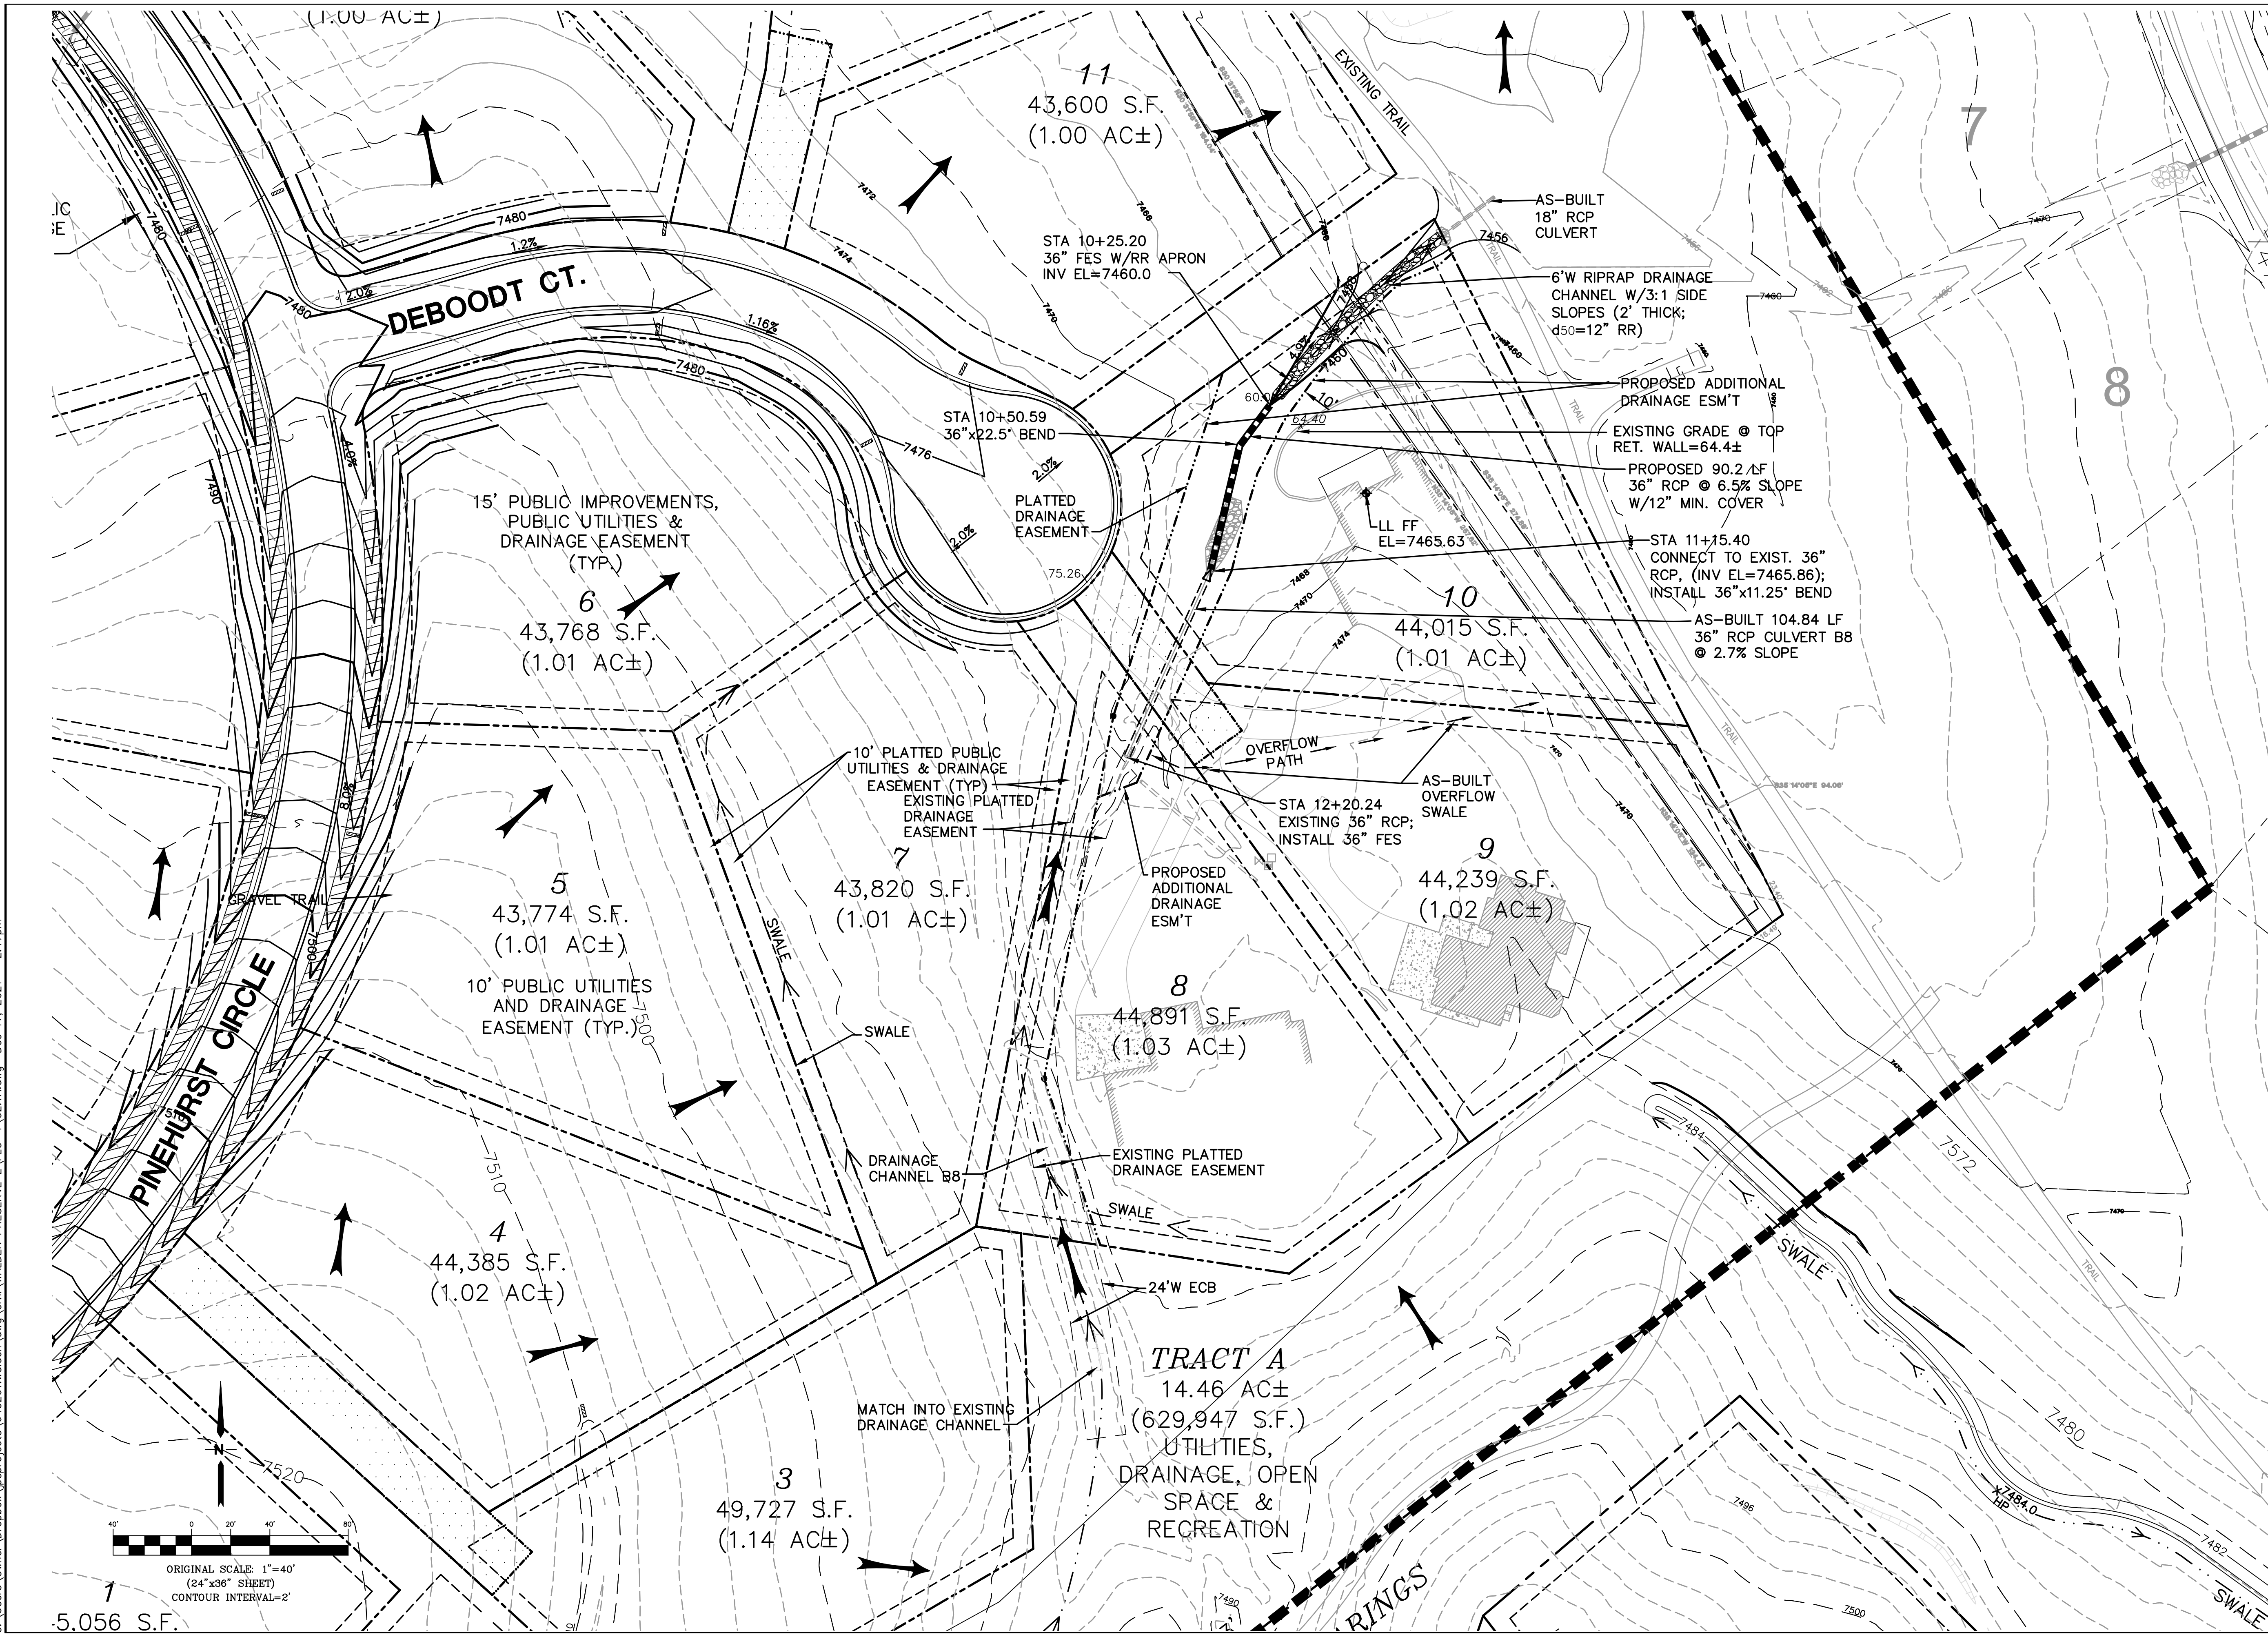

WALDEN PRESERVE 2 - FILING NO. 4

ENLARGED SITE GRADING PLAN - SOUTH

HORZ. SCALE: 1"=40'
VERT. SCALE: N/A
SURVEYED: N/A
CREATED: 11/01/21
PROJECT NO.: 040201
SHEET: C2.1A

DRAWN: RMD
DESIGNED: JPS
CHECKED: JPS
LAST MODIFIED: 12/17/21
MODIFIED BY: BJJ

JPS ENGINEERING
 19 E. Willamette Ave.
 Colorado Springs, CO 80903
 PH: 719-477-9429
 FAX: 719-471-0766
 www.jpsegr.com

CALL UTILITY NOTIFICATION CENTER OF COLORADO
1-800-922-1987
 BEFORE YOU DIG, GRADE, OR EXCAVATE FOR THE MARKING OF UNDERGROUND MEMBER UTILITIES.

NO.	REVISION	DATE
1	COUNTY COMMENTS	7/03/19
2	AS-BUILT CULVERT B8 REVISION	12/17/21

