


# Sign Type: With pole covers in Place

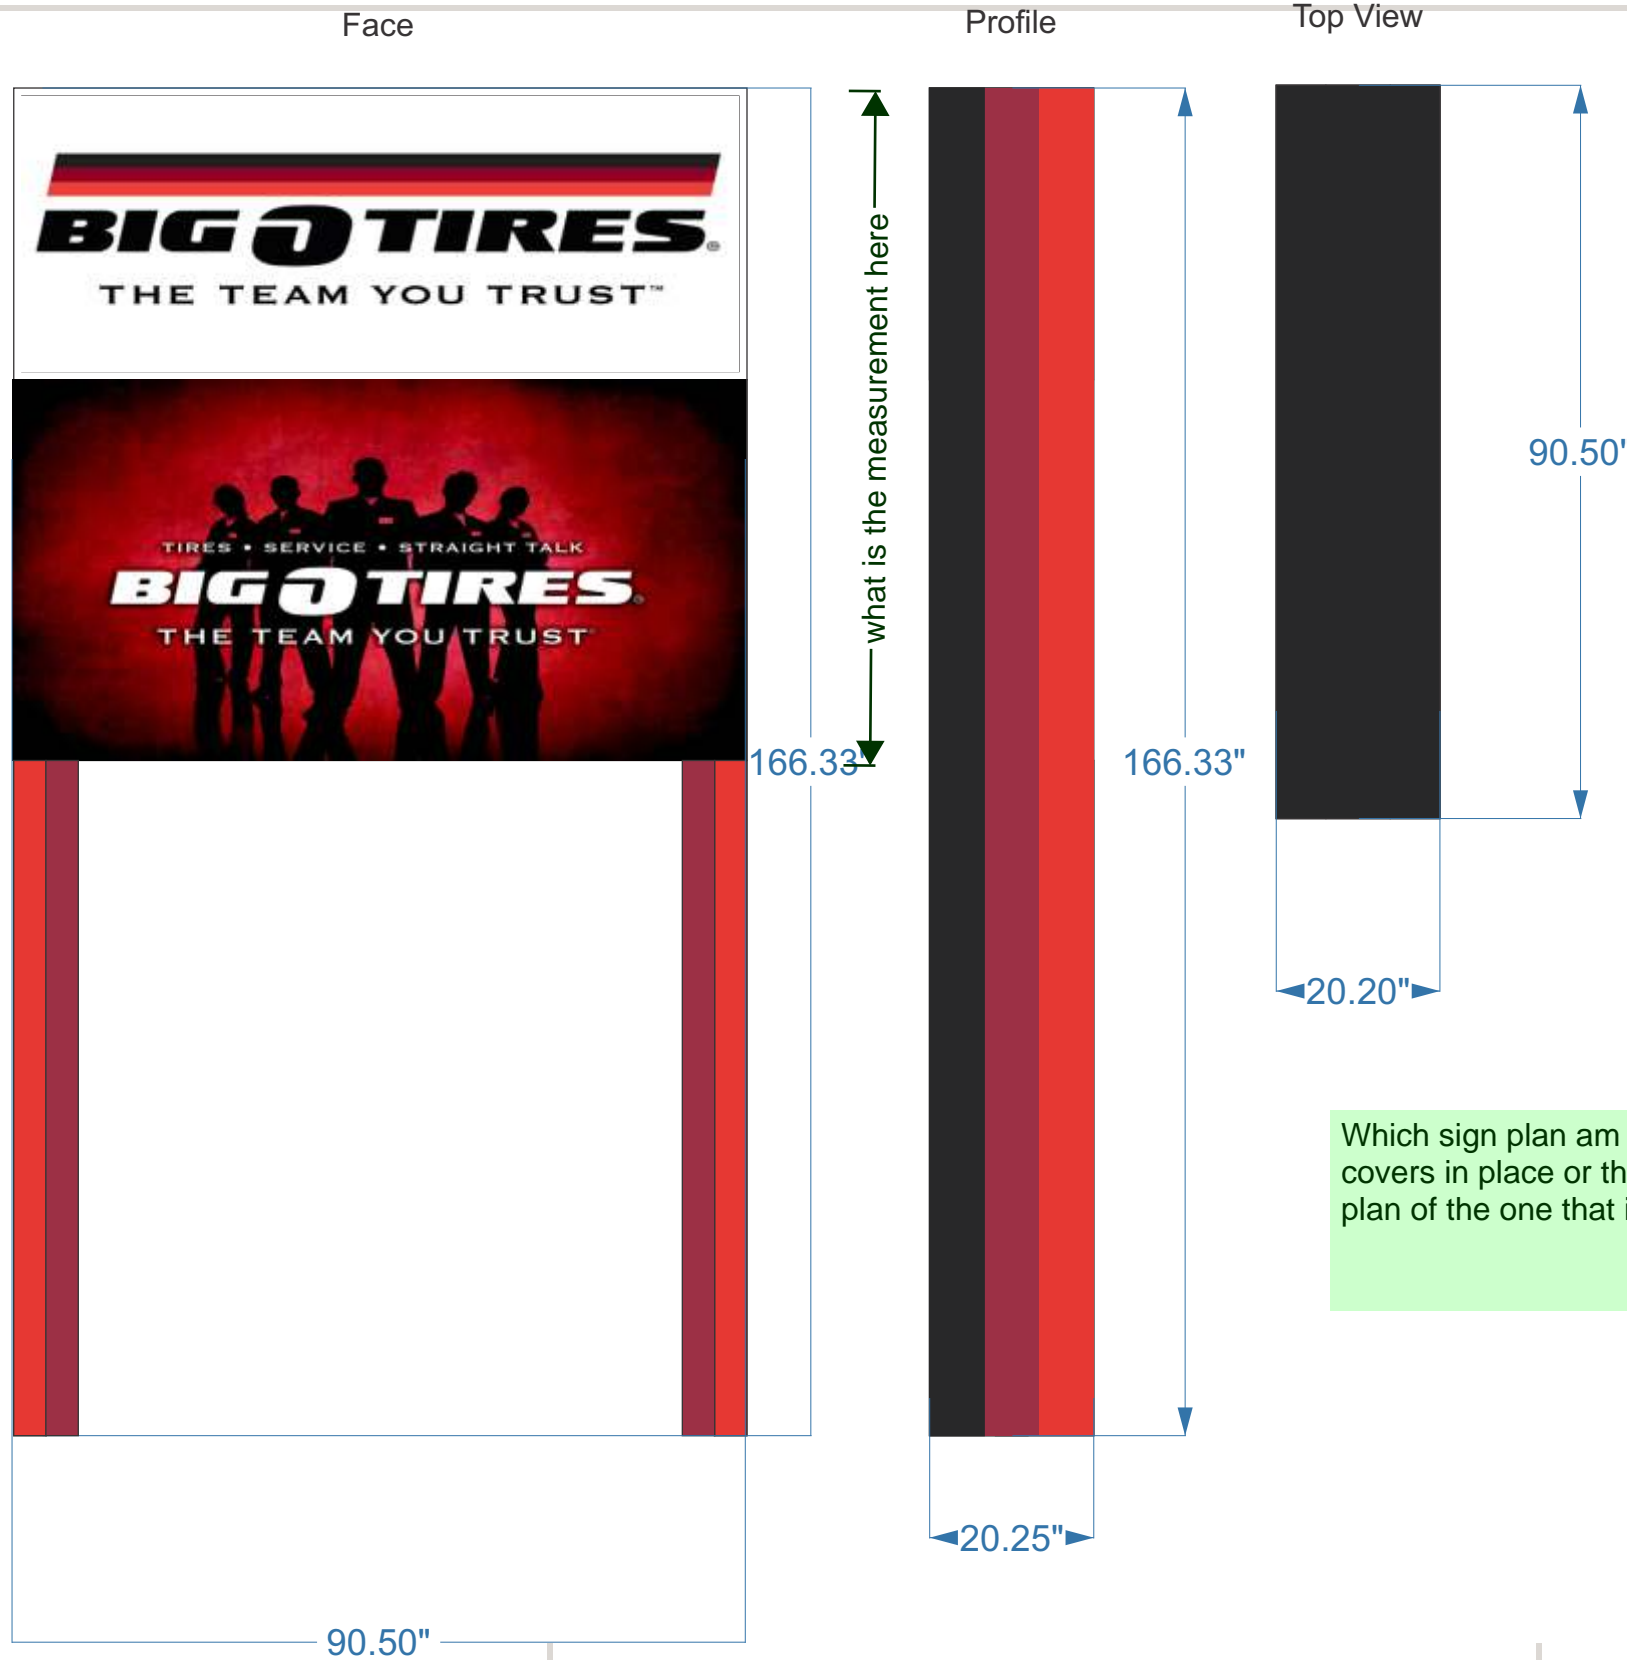

The total area of freestanding signs shall not exceed 2 square feet for each linear foot of the building wall closest to the freestanding sign or 40 square feet, whichever is smaller.

If there is an attached sign on the side of the building that is closest to the freestanding sign they combined must not be more than 40 square feet.

Because this is located on an arterial/expressway the freestanding signs allowable area shall be 125% of the sign area otherwise allowed by this code.

I need to see elevations of the structure showing height (the sign shall not be taller than the structure). I need to know if there is an attached sign on the same side that this sign is being proposed, and if there is an attached sign, I need to know the dimensions of that, in order to calculate the amount of sign area that is allowed with the 25% increase.

Which sign plan am I approving? The one with pole covers in place or the one without? Only resubmit the plan of the one that is going to be on the property.


## DESCRIPTION



## MOUNTING

- 3M® VHB, or very high bond tapes secure interior signs to a variety of surfaces.
- Added to the back or perimeter of a sign, silicone adhesive makes installation permanent.
- Sign Stand Offs protrude signs from wall adding a decorative touch to both fastener and sign.
- Stainless Steel Tamper Proof Screws enhance theft protection.
- Studs are inserted directly into elements for a flush mounted appearance without visible hardware.
- Spacers are added to protrude elements from the wall creating a floating effect.
- Elements are mechanically mounted to a rail system which reduces penetrations into walls.

## COLORS

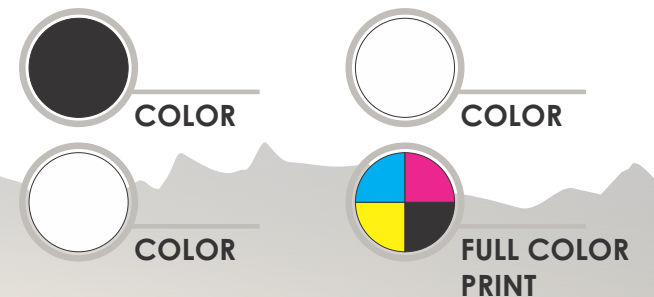


**AVALANCHE**  
SIGN CONTRACTING  
786 Hathaway Drive • Colorado Springs, CO 80915  
Phone: 719.471.9898 • Fax: 719.632.7781

Project:  
Address:  
City/State:  
Sales Rep: JB  
Artist: KF  
Date: 01.17.17

### Client Approval

Signed: \_\_\_\_\_  
Date: \_\_\_\_\_

# Sign Type: Without Poles Covers

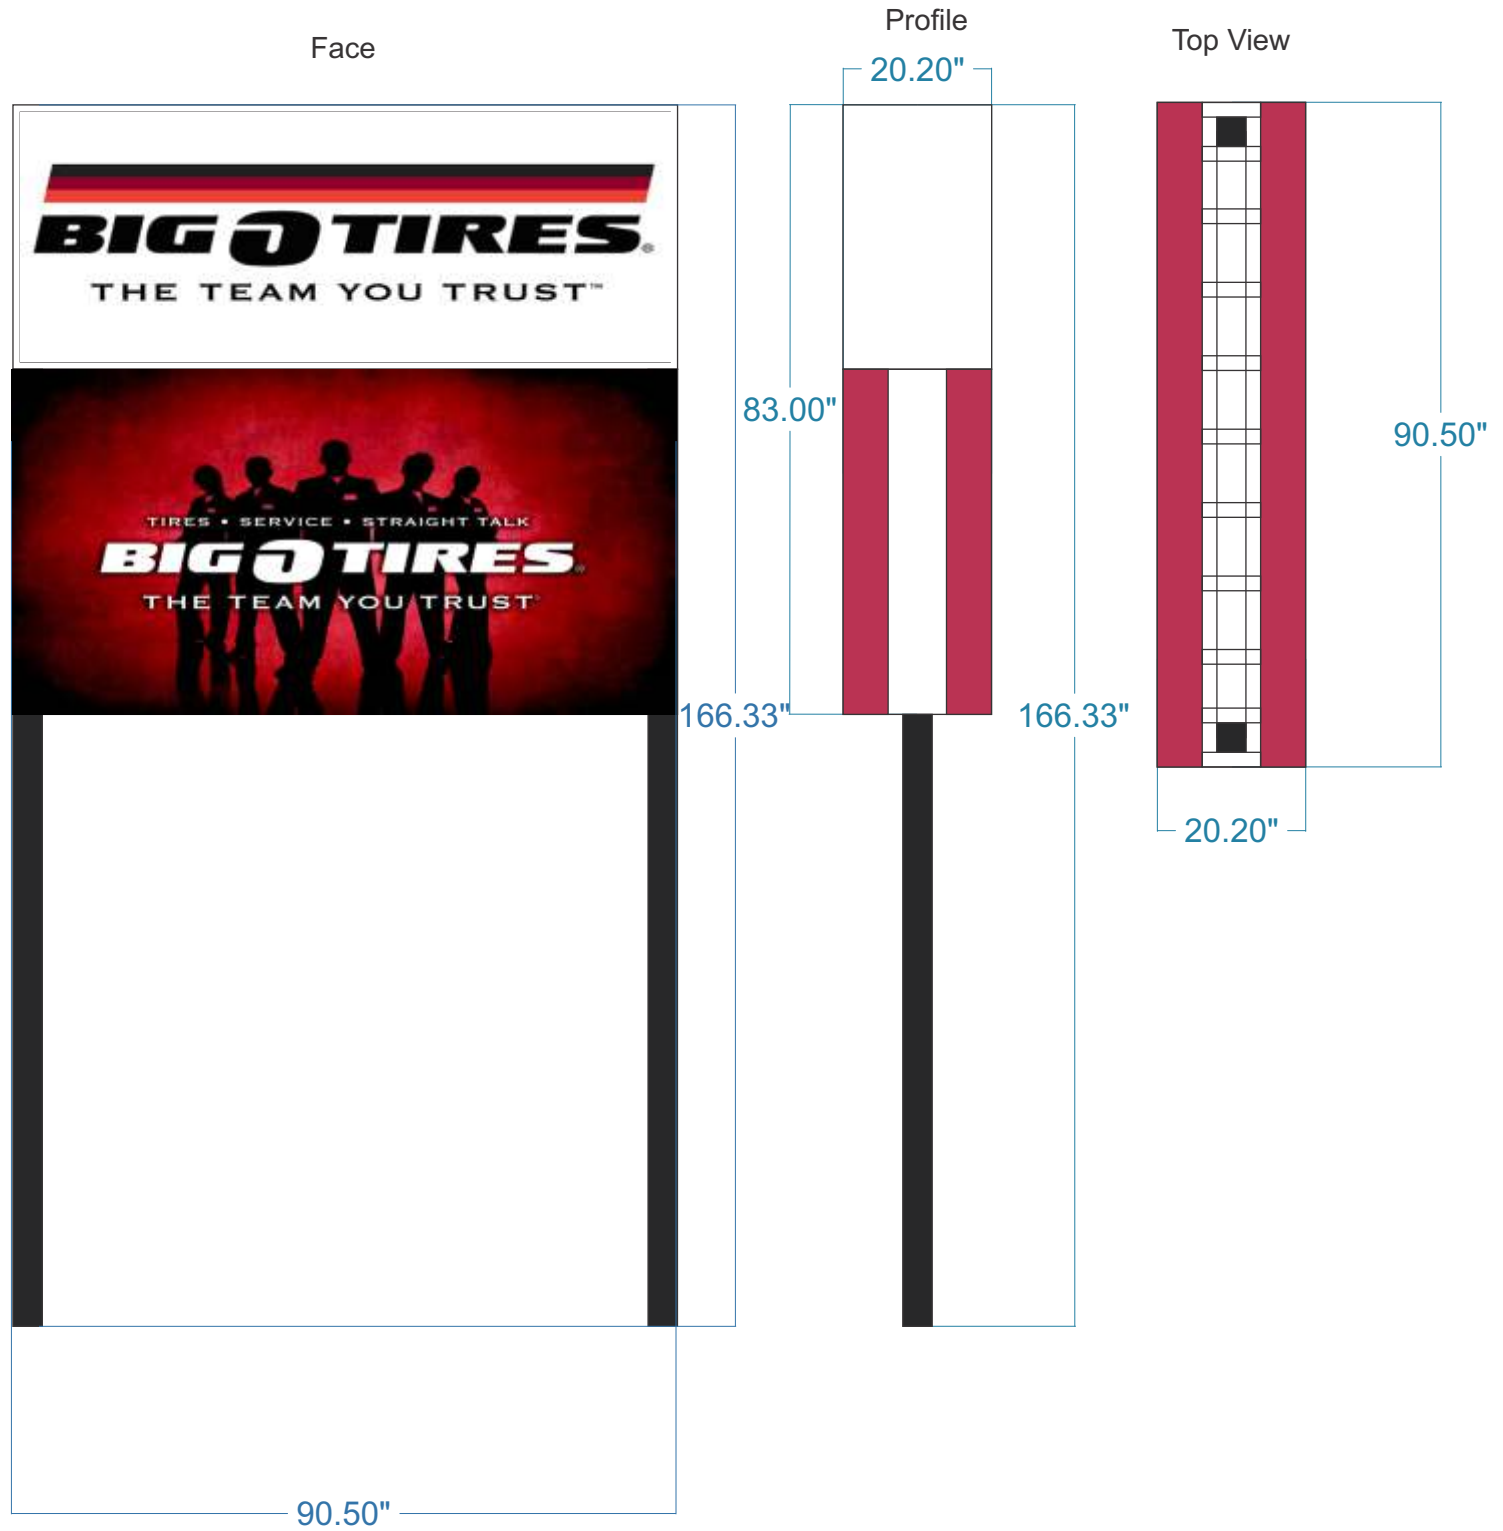


## DESCRIPTION



## MOUNTING

## COLORS

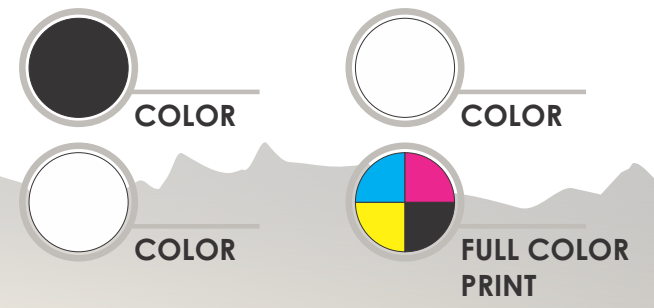

**AVALANCHE**  
SIGN CONTRACTING  
786 Hathaway Drive • Colorado Springs, CO 80915  
Phone: 719.471.9898 • Fax: 719.632.7781

Project:  
Address:  
City/State:  
Sales Rep: JB  
Artist: KF  
Date: 01.17.17

### Client Approval

Signed: \_\_\_\_\_  
Date: \_\_\_\_\_

This rendering is the property of Avalanche Sign Contracting. Any reproduction or exhibition of this rendering is strictly prohibited.

# Markup Summary

dsdkendall (3)



Which sign plan am I approving? The one with pole covers in place or the one without? Only resubmit the plan if the work has to go back to be on the property.

**Subject:** Text Box  
**Page Label:** 1  
**Lock:** Locked  
**Status:**  
**Checkmark:** Unchecked  
**Author:** dsdkendall  
**Date:** 5/4/2018 3:05:45 PM  
**Color:** ■  
**Layer:**  
**Space:**

Which sign plan am I approving? The one with pole covers in place or the one without? Only resubmit the plan of the one that is going to be on the property.



**Subject:** Text Box  
**Page Label:** 1  
**Lock:** Locked  
**Status:**  
**Checkmark:** Unchecked  
**Author:** dsdkendall  
**Date:** 5/4/2018 3:05:46 PM  
**Color:** ■  
**Layer:**  
**Space:**

The total area of freestanding signs shall not exceed 2 square feet for each linear foot of the building wall closest to the freestanding sign or 40 square feet, whichever is smaller.

If there is an attached sign on the side of the building that is closest to the freestanding sign they combined must not be more than 40 square feet.

Because this is located on an arterial/expressway the freestanding signs allowable area shall be 125% of the sign area otherwise allowed by this code.

I need to see elevations of the structure showing height (the sign shall not be taller than the structure). I need to know if there is an attached sign on the same side that this sign is being proposed, and if there is an attached sign, I need to know the dimensions of that, in order to calculate the amount of sign area that is allowed with the 25% increase.



**Subject:** Dimension  
**Page Label:** 1  
**Lock:** Locked  
**Status:**  
**Checkmark:** Unchecked  
**Author:** dsdkendall  
**Date:** 5/4/2018 3:06:34 PM  
**Color:** ■  
**Layer:**  
**Space:**

what is the measurement here