
ENG-PUDSP21002-R1-CDs-Storm.pdf Markup Summary



14 (1)

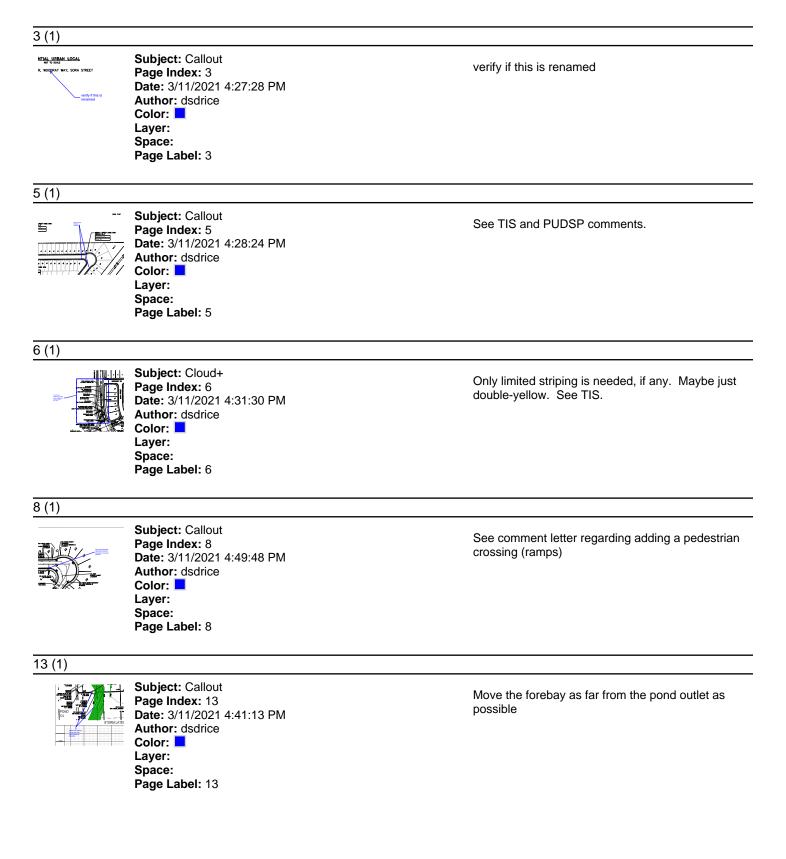

Subject: Callout Page Index: 14 Date: 3/11/2021 4:36:14 PM Author: dsdrice Color: Layer: Space: Page Label: 14

Verify that the inlets aren't too close to the ped ramps with depresssions...

15 (1)

)R EQUAL) TRASH RACK BOLTED TO STRUCTURE, SEE TAIL NEXT SHEET Subject: Page Index: 15 Date: 3/11/2021 4:34:28 PM Author: dsdrice Color: Layer: Space: Page Label: 15

16 (2)



Subject: Highlight Page Index: 16 Date: 3/11/2021 4:32:32 PM Author: dsdrice Color: Layer: Space: Page Label: 16



Subject: Highlight Page Index: 16 Date: 3/11/2021 4:32:34 PM Author: dsdrice Color: Layer: Space: Page Label: 16

.