

MELODY HOMES, INC.

GRANDVIEW RESERVE FILING NO. 1

A TRACT OF LAND BEING A PORTION OF SOUTHWEST QUARTER SECTION 21, AND A PORTION OF THE NORTHWEST QUARTER OF SECTION 28; TOWNSHIP 12 SOUTH, RANGE 64 WEST OF THE SIXTH PRINCIPAL MERIDIAN

EASTONVILLE RD & REX RD

GRADING & EROSION CONTROL PLANS

SF2311

EPC STORMWATER REVIEW COMMENTS IN ORANGE BOXES WITH BLACK TEXT

GALLOWAY RESPONSE

Galloway

1155 Kelly Johnson Blvd., Suite 305
Colorado Springs, CO 80920
719.900.7220
GallowayUS.com



COPYRIGHT
THESE PLANS ARE AN INSTRUMENT OF SERVICE AND ARE THE PROPERTY OF GALLOWAY, AND MAY NOT BE DUPLICATED, DISCLOSED, OR REPRODUCED WITHOUT THE WRITTEN CONSENT OF GALLOWAY. COPYRIGHTS AND INFRINGEMENTS WILL BE ENFORCED AND PROSECUTED.

D.R. HORTON
America's Builder

GRADING & EROSION CONTROL PLANS
GRANDVIEW RESERVE FILING NO. 1
MELODY HOMES, INC.
SF2311
EASTONVILLE RD & REX RD
EL PASO COUNTY, FALCON, CO 80831

#	Date	Issue / Description	Init.

Project No:	HRG02
Drawn By:	JDM, BLB
Checked By:	BAS, CMWJ
Date:	03/15/2024

PROJECT CONTACTS

PROPERTY OWNER

MELODY HOMES, INC.
8559 S. KINGSTON CT.
ENGLEWOOD, COLORADO 80112
TELE: (407) 375-0658
CONTACT: BILL CARLISLE
EMAIL: WMCARLISLE@BORHORTON.COM

APPLICANT

HR GREEN DEVELOPMENT, LLC
1975 RESEARCH PARKWAY SUITE 230
COLORADO SPRINGS, CO 80920
TELE: (720) 602-4965
CONTACT: KEN HUHN
EMAIL: KHUHN@HRGREEN.COM

CIVIL ENGINEER

GALLOWAY & CO., INC.
1155 KELLY JOHNSON BLVD., SUITE 305
COLORADO SPRINGS, CO 80920
TELE: (719) 900-7220
CONTACT: BRADY SHYROCK, P.E.
EMAIL: BRADYSHYROCK@GALLOWAYUS.COM

LANDSCAPE ARCHITECT

HR GREEN DEVELOPMENT, LLC
1975 RESEARCH PARKWAY SUITE 230
COLORADO SPRINGS, CO 80920
TELE: (719) 602-4965
CONTACT: KEN HUHN
EMAIL: KHUHN@HRGREEN.COM

SURVEYOR

EDWARD-JAMES SURVEYING, INC.
926 ELKTON DRIVE
COLORADO SPRINGS, CO 80907
TELE: (719) 576-1216
CONTACT: JONATHAN W. TESSIN
EMAIL: --

CITY & UTILITY CONTACTS

WATER

GRANDVIEW RESERVE METROPOLITAN DISTRICT
8559 S. KINGSTON CT.
ENGLEWOOD, COLORADO 80112
TELE: (407) 375-0658
CONTACT: BILL CARLISLE
EMAIL: WMCARLISLE@BORHORTON.COM

WASTEWATER

WOODMEN HILLS METRO DISTRICT
8046 EASTONVILLE ROAD
FALCON, CO 80831
TELE: (719) 493-2500
CONTACT: CODY RITTER
EMAIL: CODY@WHMD.ORG

ELECTRIC


MOUNTAIN VIEW ELECTRIC ASSOCIATION
11140 E. WOODMEN RD.,
FALCON, CO 80831
TELE: (800) 388-9881
CONTACT: GINA PERRY
EMAIL: GINA.P@MVEA.COOP

NATURAL GAS

BLACK HILLS ENERGY
198 COUNTY LINE RD.
PALMER LAKE, CO 80133
TELE: (719) 332-5856
CONTACT: BOB SWATEK
EMAIL: BOB.SWATEK@BLACKHILLSCORP.COM

FIRE

FALCON FIRE PROTECTION DISTRICT
7030 OLD MERIDIAN RD.,
FALCON, CO 80831
TELE: (719) 493-4050
CONTACT: TRENT HARING
EMAIL: THARING@FALCONFIREPD.ORG

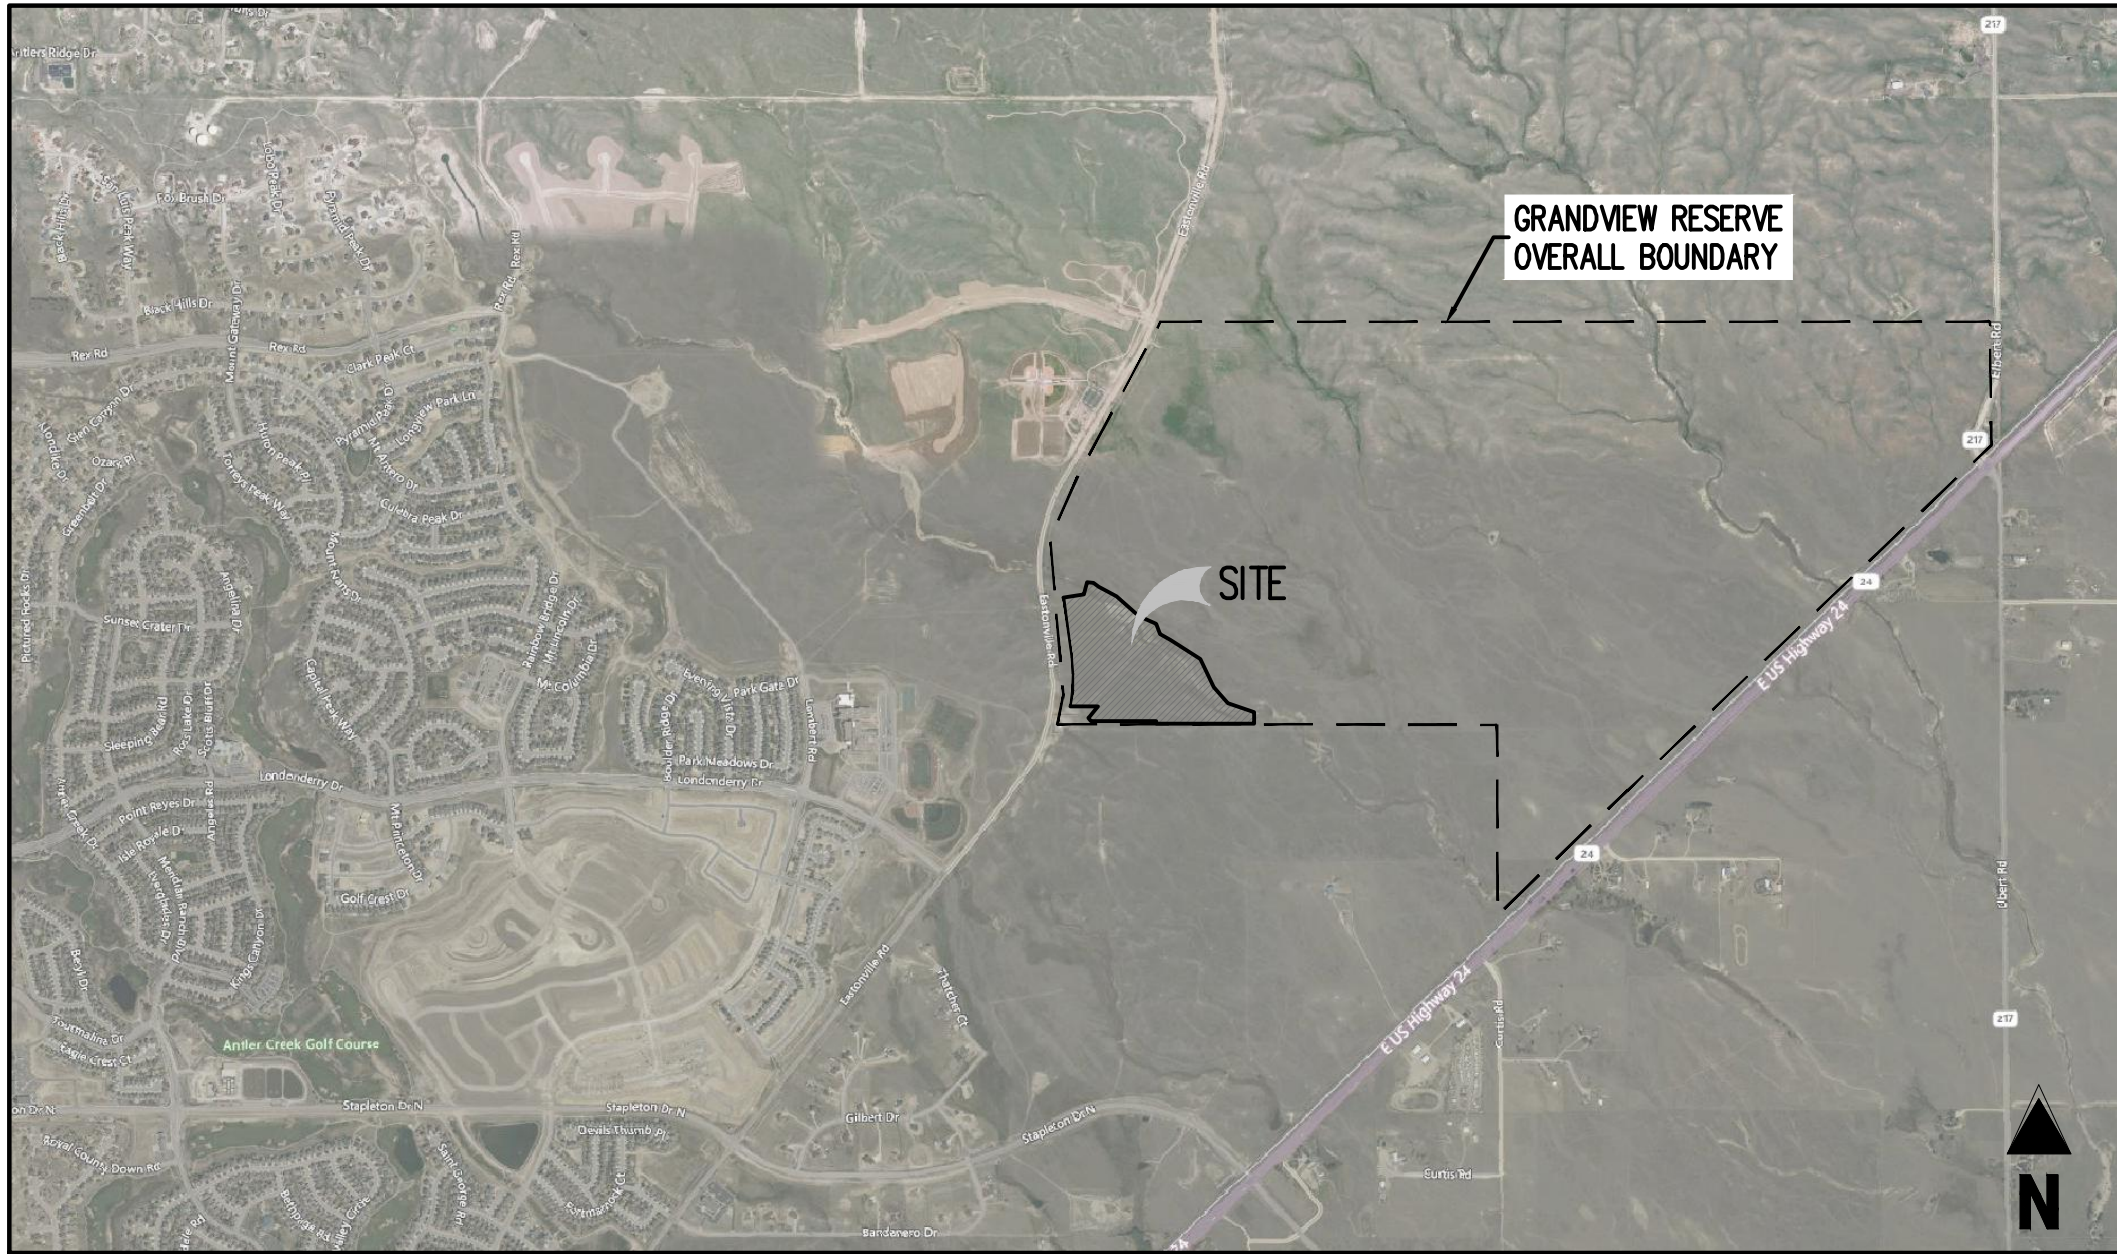

SHEET NUMBER	SHEET TITLE	SHEET DESCRIPTION
1	COVER SHEET	G0.0
2	NOTES	G0.1
3	CUT & FILL MAP	G0.2
4	INITIAL EROSION CONTROL PLAN	G1.1
5	INITIAL EROSION CONTROL PLAN	G1.2
6	INITIAL EROSION CONTROL PLAN	G1.3
7	INITIAL EROSION CONTROL PLAN	G1.4
8	INTERM EROSION CONTROL PLAN	G2.1
9	INTERM EROSION CONTROL PLAN	G2.2
10	INTERM EROSION CONTROL PLAN	G2.3
11	INTERM EROSION CONTROL PLAN	G2.4
12	FINAL EROSION CONTROL PLAN	G3.1
13	FINAL EROSION CONTROL PLAN	G3.2
14	FINAL EROSION CONTROL PLAN	G3.3
15	FINAL EROSION CONTROL PLAN	G3.4
16	EROSION CONTROL DETAILS	G4.1
17	EROSION CONTROL DETAILS	G4.2
18	EROSION CONTROL DETAILS	G4.3
19	EROSION CONTROL DETAILS	G4.4
20	EROSION CONTROL DETAILS	G4.5
21	EROSION CONTROL DETAILS	G4.6
22	OVERALL GRADING PLAN	G5.0
23	GENERAL GRADING DETAILS	G5.1
24	WINGWALL DETAILS	G5.2
24	POND E - PLAN & PROFILE	G6.1
25	POND E - OUTLET STRUCTURE DETAILS	G6.2
26	POND E - FOREBAY DETAILS	G6.3
27	POND E - POND DETAILS	G6.4
28	POND D - PLAN & PROFILE	G7.1
29	POND D - OUTLET STRUCTURE DETAILS	G7.2
30	POND D - FOREBAY DETAILS	G7.3
31	POND D - POND DETAILS	G7.4

LEGAL DESCRIPTION

GRANDVIEW RESERVE FILING NO. 1, A TRACT OF LAND BEING A PORTION OF SOUTHWEST QUARTER SECTION 21, AND A PORTION OF THE NORTHWEST QUARTER OF SECTION 28, TOWNSHIP 12 SOUTH, RANGE 64 WEST OF THE 6TH PRINCIPAL MERIDIAN, EL PASO COUNTY, COLORADO.

BENCHMARK

NGS BENCHMARK F 24
A STANDARD DISK STAMPED F 24 1929 AND SET IN THE TOP OF A CONCRETE POST PROJECTING ABOUT 6 INCHES ABOVE GROUND, ALONG THE CHICAGO, ROCK ISLAND AND PACIFIC RAILROAD, 52 FEET NORTHWEST OF THE CENTERLINE OF U.S. HIGHWAY 24, 48 FEET SOUTHWEST OF THE CENTERLINE OF THE TRACK.
NAVD88 ELEVATION = 6866.33

BASIS OF BEARING

THE NORTH LINE OF SECTION 28, TOWNSHIP 12 SOUTH, RANGE 64 WEST OF THE 6TH PRINCIPAL MERIDIAN, EL PASO COUNTY, STATE OF COLORADO BEING MONUMENTED AT EACH END BY A 3-1/4" ALUMINUM SURVEYORS CAP STAMPED "PSINC LS 30087" AND ASSUMED TO BEAR S89°47'04"E, A DISTANCE OF 5265.07 FEET.

NOTE: CONTRACTOR SHALL PROTECT ALL EXISTING SURVEY MONUMENTATION. CONTRACTOR SHALL HAVE LICENSED SURVEYOR REPLACE ANY DAMAGED OR DISTURBED MONUMENTATION AT THEIR COST.

NOTE: CONTRACTOR MUST COORDINATE WORK WITH UTILITY COMPANY AND CITY PRIOR TO BEGINNING WORK AND IS RESPONSIBLE FOR ALL MATERIALS, LABOR, REPAIRS, ETC. TO COMPLETE WORK AND RESTORE AREA TO SAME STATE PRIOR TO STARTING WORK.

CONTRACTOR RESPONSIBLE FOR AS-BUILT DRAWINGS, TESTS, REPORTS AND/OR ANY OTHER CERTIFICATES OR INFORMATION AS REQUIRED FOR ACCEPTANCE OF WORK FROM CITY, UTILITY DISTRICTS OR ANY OTHER GOVERNING AGENCY.

SURVEYOR TO OBTAIN AUTOCAD FILE FROM ENGINEER AND VERIFY ALL HORIZONTAL CONTROL DIMENSIONING PRIOR TO CONSTRUCTION STAKING. SURVEYOR MUST VERIFY ALL BENCHMARK, BASIS OF BEARING AND DATUM INFORMATION TO ENSURE IMPROVEMENTS WILL BE AT THE SAME HORIZONTAL AND VERTICAL LOCATIONS SHOWN ON THE DESIGN CONSTRUCTION DRAWINGS. PRIOR TO CONSTRUCTION STAKING ANY DISCREPANCY MUST BE REPORTED TO OWNER AND ENGINEER PRIOR TO CONTINUATION OF ANY FURTHER STAKING OR CONSTRUCTION WORK.

CAUTION - NOTICE TO CONTRACTOR

- ALL UTILITY LOCATIONS SHOWN ARE BASED ON MAPS PROVIDED BY THE APPROPRIATE UTILITY COMPANY AND FIELD SURFACE EVIDENCE AT THE TIME OF SURVEY AND IS TO BE CONSIDERED AN APPROXIMATE LOCATION ONLY. IT IS THE CONTRACTOR'S RESPONSIBILITY TO FIELD VERIFY THE LOCATION OF ALL UTILITIES, PUBLIC OR PRIVATE, WHETHER SHOWN ON THE PLANS OR NOT, PRIOR TO CONSTRUCTION. REPORT ANY DISCREPANCIES TO THE ENGINEER PRIOR TO CONSTRUCTION.
- WHERE A PROPOSED UTILITY CROSSES AN EXISTING UTILITY, IT IS THE CONTRACTOR'S RESPONSIBILITY TO FIELD VERIFY THE HORIZONTAL AND VERTICAL LOCATION OF SUCH EXISTING UTILITY, EITHER THROUGH POT-HOLING OR ALTERNATIVE METHOD. REPORT INFORMATION TO THE ENGINEER PRIOR TO CONSTRUCTION.

EL PASO COUNTY

COUNTY PLAN REVIEW IS PROVIDED ONLY FOR GENERAL CONFORMANCE WITH COUNTY DESIGN CRITERIA. THE COUNTY IS NOT RESPONSIBLE FOR THE ACCURACY AND ADEQUACY OF THE DESIGN, DIMENSIONS, AND/OR ELEVATIONS WHICH SHALL BE CONFIRMED AT THE JOB SITE. THE COUNTY THROUGH THE APPROVAL OF THIS DOCUMENT ASSUMES NO RESPONSIBILITY FOR COMPLETENESS AND/OR ACCURACY OF THIS DOCUMENT, FILED IN ACCORDANCE WITH THE REQUIREMENTS OF THE EL PASO COUNTY LAND DEVELOPMENT CODE, GRADING CRITERIA MANUAL, VOLUMES 1 AND 2, AND ENGINEERING CRITERIA MANUAL AS AMENDED.

IN ACCORDANCE WITH EGM SECTION 1.12, THESE CONSTRUCTION DOCUMENTS WILL BE VALID FOR CONSTRUCTION FOR A PERIOD OF 2 YEARS FROM THE DATE SIGNED BY THE EL PASO COUNTY ENGINEER. IF CONSTRUCTION HAS NOT STARTED WITHIN THOSE 2 YEARS, THE PLANS WILL NEED TO BE RESUBMITTED FOR APPROVAL, INCLUDING PAYMENT OF REVIEW FEES AT THE PLANNING AND COMMUNITY DEVELOPMENT DIRECTOR'S DISCRETION.

JOSHUA PALMER, P.E. DATE
COUNTY ENGINEER / EGM ADMINISTRATOR

OWNER'S STATEMENT
I, THE OWNER/DEVELOPER HAVE READ AND WILL COMPLY WITH THE REQUIREMENTS OF THE GRADING AND EROSION CONTROL PLAN.


BILL CARLISLE DATE
MELODY HOMES, INC.

ENGINEER'S STATEMENT
THIS GRADING AND EROSION CONTROL PLAN WAS PREPARED UNDER MY DIRECTION AND SUPERVISION AND IS CORRECT TO THE BEST OF MY KNOWLEDGE AND BELIEF. SAID PLAN HAS BEEN PREPARED ACCORDING TO THE CRITERIA ESTABLISHED BY THE COUNTY FOR GRADING AND EROSION CONTROL PLANS. I ACCEPT RESPONSIBILITY FOR ANY LIABILITY CAUSED BY AN NEGLIGENT ACTS, ERRORS OR OMISSIONS ON MY PART IN PREPARING THIS PLAN.

BRADY A. SHYROCK, COLORADO P.E. NO. 0038164 DATE

LIST OF ABBREVIATIONS

- SH - SHEET
- Δ - DEFLECTION ANGLE
- L - LENGTH
- R - RADIUS
- CB - CHORD BEARING
- C - CHORD LENGTH
- N - NORTH/NORTHING
- W - WEST
- E - EAST/EASTING
- S - SOUTH
- DET - DETAIL
- EX - EXISTING
- W/ - WITH
- PC - POINT OF CURVATURE/PORTLAND CEMENT
- WWF - WELDED WIRE FABRIC
- VERT - VERTICAL
- OC - ON CENTER
- FDC - FIRE DEPARTMENT CONNECTION
- CT - COURT
- DR - DRIVE
- TYP - TYPICAL
- REC - RECEPTION NUMBER
- Ø, DIA - DIAMETER
- PT - POINT OF TANGENCY
- MIN - MINIMUM
- MAX - MAXIMUM
- HDPE - HIGH DENSITY POLYETHYLENE

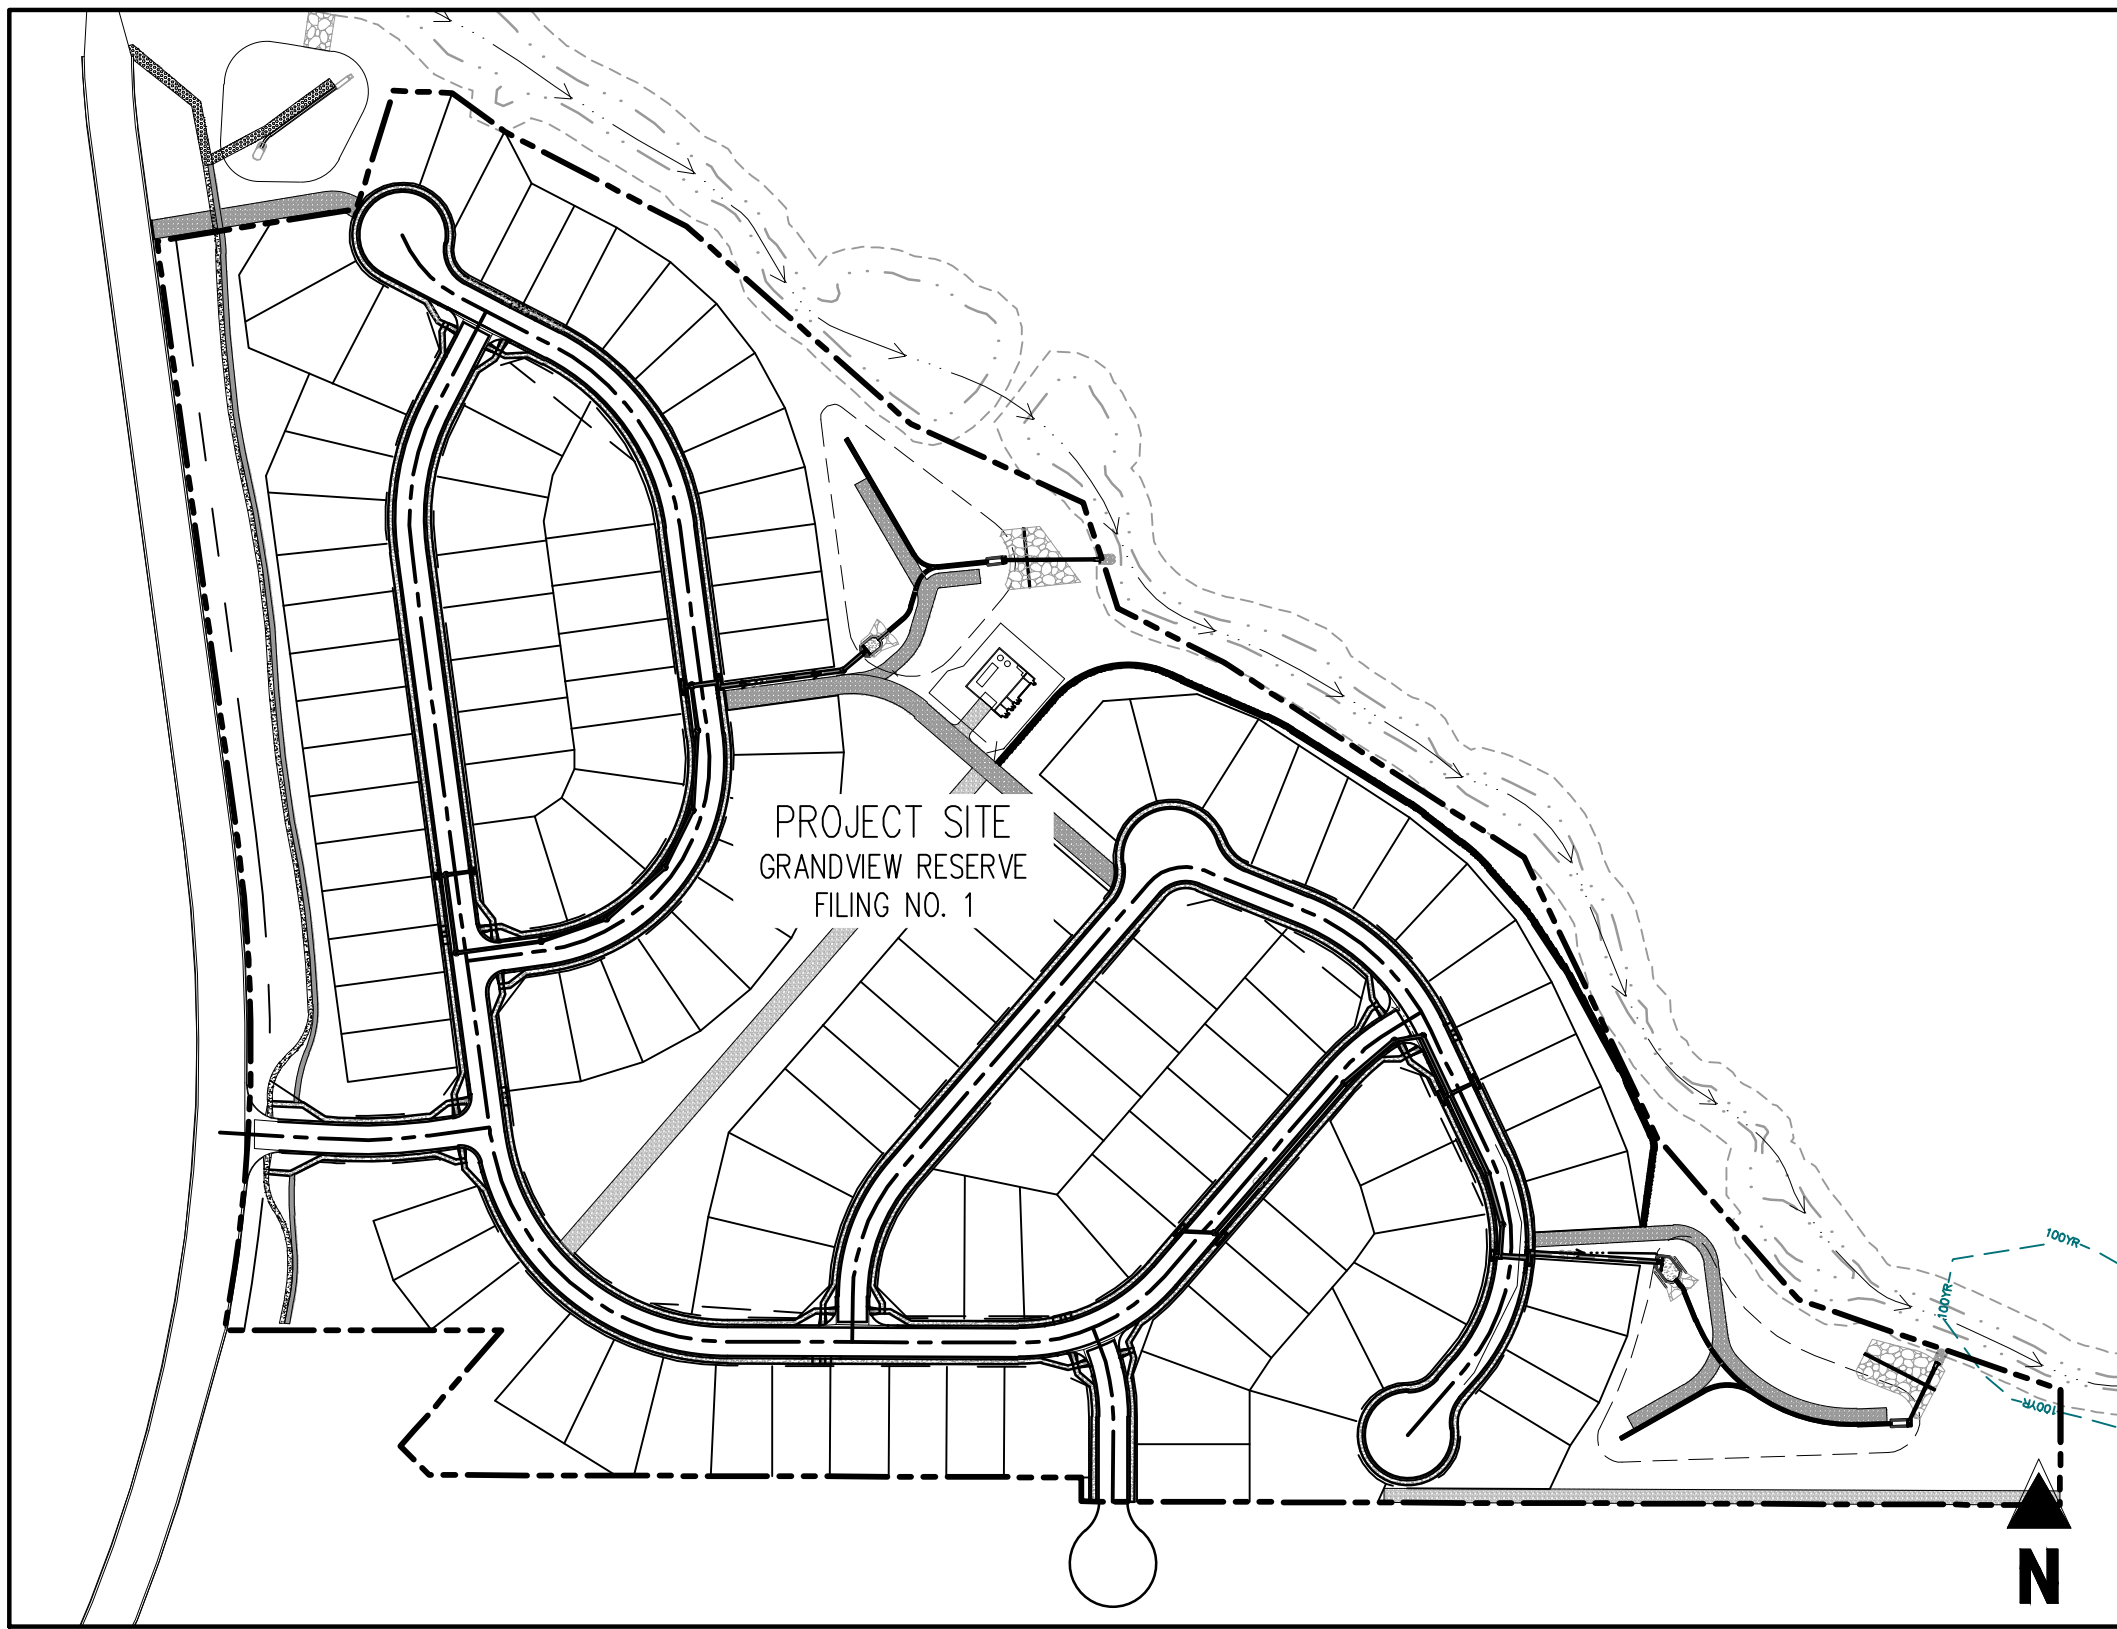

D:\Projects\2024\311-GrandViewReserve\311-GrandViewReserve_PlanSet\Drawings\311-GrandViewReserve_PlanSet.dwg (3/15/2024) - 1:2000

STANDARD NOTES FOR GEC PLANS

- 1. STORMWATER DISCHARGES FROM CONSTRUCTION SITES SHALL NOT CAUSE OR THREATEN TO CAUSE POLLUTION, CONTAMINATION, OR DEGRADATION OF STATE WATERS...
2. NOTWITHSTANDING ANYTHING DEPICTED IN THESE PLANS IN WORDS OR GRAPHIC REPRESENTATION, ALL DESIGN AND CONSTRUCTION RELATED TO ROADS, STORM DRAINAGE AND EROSION CONTROL SHALL CONFORM TO THE STANDARDS AND REQUIREMENTS OF THE MOST RECENT VERSION OF THE RELEVANT ADOPTED EL PASO COUNTY STANDARDS...
3. A SEPARATE STORMWATER MANAGEMENT PLAN (SWMP) FOR THIS PROJECT SHALL BE COMPLETED AND AN EROSION AND STORMWATER QUALITY CONTROL PERMIT (ESQCP) ISSUED PRIOR TO COMMENCING CONSTRUCTION...
4. ONCE THE ESQCP IS APPROVED AND A NOTICE TO PROCEED HAS BEEN ISSUED, THE CONTRACTOR MAY INSTALL THE INITIAL STAGE EROSION AND SEDIMENT CONTROL MEASURES AS INDICATED ON THE APPROVED GEC...
5. CONTROL MEASURES MUST BE INSTALLED PRIOR TO COMMENCEMENT OF ACTIVITIES THAT COULD CONTRIBUTE POLLUTANTS TO STORMWATER...
6. ALL TEMPORARY SEDIMENT AND EROSION CONTROL MEASURES SHALL BE MAINTAINED AND REMAIN IN EFFECTIVE OPERATING CONDITION UNTIL PERMANENT SOIL EROSION CONTROL MEASURES ARE IMPLEMENTED AND FINAL STABILIZATION IS ESTABLISHED...
7. TEMPORARY STABILIZATION SHALL BE IMPLEMENTED ON DISTURBED AREAS AND STOCKPILES WHERE GROUND DISTURBING CONSTRUCTION ACTIVITY HAS PERMANENTLY CEASED OR TEMPORARILY CEASED FOR LONGER THAN 14 DAYS...
8. FINAL STABILIZATION MUST BE IMPLEMENTED AT ALL APPLICABLE CONSTRUCTION SITES...
9. ALL PERMANENT STORMWATER MANAGEMENT FACILITIES SHALL BE INSTALLED AS DESIGNED IN THE APPROVED PLANS...
10. EARTH DISTURBANCES SHALL BE CONDUCTED IN SUCH A MANNER SO AS TO EFFECTIVELY MINIMIZE ACCELERATED SOIL EROSION AND RESULTING SEDIMENTATION...
11. COMPACTION OF SOIL MUST BE PREVENTED IN AREAS DESIGNATED FOR INFILTRATION CONTROL MEASURES...
12. ANY TEMPORARY OR PERMANENT FACILITY DESIGNED AND CONSTRUCTED FOR THE CONVEYANCE OF STORMWATER AROUND, THROUGH, OR FROM THE EARTH DISTURBANCE AREA SHALL BE A STABILIZED CONVEYANCE DESIGNED TO MINIMIZE EROSION...
13. CONCRETE WASH WATER SHALL BE CONTAINED AND DISPOSED OF IN ACCORDANCE WITH THE SWMP...
14. DURING DEWATERING OPERATIONS, UNCONTAMINATED GROUNDWATER MAY BE DISCHARGED ON-SITE...
15. EROSION CONTROL, BLANKETING OR OTHER PROTECTIVE COVERING SHALL BE USED ON SLOPES STEEPER THAN 3:1...
16. CONTRACTOR SHALL BE RESPONSIBLE FOR THE REMOVAL OF ALL WASTES FROM THE CONSTRUCTION SITE FOR DISPOSAL...
17. WASTE MATERIALS SHALL NOT BE TEMPORARILY PLACED OR STORED IN THE STREET, ALLEY, OR OTHER PUBLIC WAY...
18. TRACKING OF SOILS AND CONSTRUCTION DEBRIS OFF-SITE SHALL BE MINIMIZED...
19. THE OWNER/DEVELOPER SHALL BE RESPONSIBLE FOR THE REMOVAL OF ALL CONSTRUCTION DEBRIS, DIRT, TRASH, ROCK, SEDIMENT, AND SAND THAT MAY ACCUMULATE...
20. THE QUANTITY OF MATERIALS STORED ON THE PROJECT SITE SHALL BE LIMITED...
21. NO CHEMICAL(S) HAVING THE POTENTIAL TO BE RELEASED IN STORMWATER UNLESS PERMISSION FOR THE USE OF SUCH CHEMICAL(S) IS GRANTED IN WRITING BY THE EGM ADMINISTRATOR...
22. BULK STORAGE OF ALLOWED PETROLEUM PRODUCTS OR OTHER ALLOWED LIQUID CHEMICALS IN EXCESS OF 55 GALLONS SHALL REQUIRE ADEQUATE SECONDARY CONTAINMENT PROTECTION...
23. NO PERSON SHALL CAUSE THE IMPEDIMENT OF STORMWATER FLOW IN THE CURB AND GUTTER OR DITCH EXCEPT WITH APPROVED SEDIMENT CONTROL MEASURES...
24. OWNER/DEVELOPER AND THEIR AGENTS SHALL COMPLY WITH THE COLORADO WATER QUALITY CONTROL ACT...
25. ALL CONSTRUCTION TRAFFIC MUST ENTER/EXIT THE SITE AT APPROVED CONSTRUCTION ACCESS POINTS...
26. PRIOR TO ACTUAL CONSTRUCTION THE PERMITEE SHALL VERIFY THE LOCATION OF EXISTING UTILITIES...
27. A WATER SOURCE SHALL BE AVAILABLE ON SITE DURING EARTHWORK OPERATIONS...
28. THE SOILS REPORT FOR THIS SITE HAS BEEN PREPARED BY C.T. THOMPSON INCORPORATED...
29. AT LEAST TEN (10) DAYS PRIOR TO THE ANTICIPATED START OF CONSTRUCTION FOR PROJECTS THAT WILL DISTURB (1) ACRE OR MORE...

COLORADO DEPARTMENT OF PUBLIC HEALTH AND ENVIRONMENT
WATER QUALITY CONTROL DIVISION
WOOD - PERMITS
4300 CHERRY CREEK DRIVE SOUTH
DENVER, CO 80246-1530
ATIN: PERMITS UNIT

STANDARD NOTES FOR CONSTRUCTION PLANS

- 1. ALL DRAINAGE AND ROADWAY CONSTRUCTION SHALL MEET THE STANDARDS AND SPECIFICATIONS OF THE CITY OF COLORADO SPRINGS/EL PASO COUNTY DRAINAGE CRITERIA MANUAL, VOLUMES 1 AND 2, AND THE EL PASO COUNTY ENGINEERING CRITERIA MANUAL...
2. CONTRACTOR SHALL BE RESPONSIBLE FOR THE NOTIFICATION AND FIELD NOTIFICATION OF ALL EXISTING UTILITIES, WHETHER SHOWN ON THE PLANS OR NOT...
3. CONTRACTOR SHALL KEEP A COPY OF THESE APPROVED PLANS, THE GRADING AND EROSION CONTROL PLAN, THE STORMWATER MANAGEMENT PLAN (SWMP), THE SOILS AND GEOTECHNICAL REPORT, AND THE APPROPRIATE DESIGN AND CONSTRUCTION STANDARDS AND SPECIFICATIONS AT THE JOB SITE AT ALL TIMES...
4. NOTWITHSTANDING ANYTHING DEPICTED IN THESE PLANS IN WORDS OR GRAPHIC REPRESENTATION, ALL DESIGN AND CONSTRUCTION RELATED TO ROADS, STORM DRAINAGE AND EROSION CONTROL SHALL CONFORM TO THE STANDARDS AND REQUIREMENTS OF THE MOST RECENT VERSION OF THE RELEVANT ADOPTED EL PASO COUNTY STANDARDS...
5. IT IS THE DESIGN ENGINEER'S RESPONSIBILITY TO ACCURATELY SHOW EXISTING CONDITIONS, BOTH ON-SITE AND OFF-SITE, ON THE CONSTRUCTION PLANS...
6. CONTRACTOR SHALL SCHEDULE A PRE-CONSTRUCTION MEETING WITH EL PASO COUNTY PLANNING AND COMMUNITY DEVELOPMENT (PCD) - INSPECTIONS, PRIOR TO STARTING CONSTRUCTION...
7. IT IS THE CONTRACTOR'S RESPONSIBILITY TO UNDERSTAND THE REQUIREMENTS OF ALL JURISDICTIONAL AGENCIES AND TO OBTAIN ALL REQUIRED PERMITS...
8. CONTRACTOR SHALL NOT DEVIATE FROM THE PLANS WITHOUT FIRST OBTAINING WRITTEN APPROVAL FROM THE DESIGN ENGINEER AND PCD...
9. ALL STORM DRAIN PIPE SHALL BE CLASS III RCP UNLESS OTHERWISE NOTED AND APPROVED BY PCD...
10. CONTRACTOR SHALL COORDINATE GEOTECHNICAL TESTING PER EGM STANDARDS...
11. ALL CONSTRUCTION TRAFFIC MUST ENTER/EXIT THE SITE AT APPROVED CONSTRUCTION ACCESS POINTS...
12. SIGHT VISIBILITY TRIANGLES AS IDENTIFIED IN THE PLANS SHALL BE PROVIDED AT ALL INTERSECTIONS...
13. SIGNING AND STRIPING SHALL COMPLY WITH EL PASO COUNTY DOT AND MUTCD CRITERIA...
14. CONTRACTOR SHALL OBTAIN ANY PERMITS REQUIRED BY EL PASO COUNTY DOT...
15. THE LIMITS OF CONSTRUCTION SHALL REMAIN WITHIN THE PROPERTY LINE UNLESS OTHERWISE NOTED...

EROSION CONTROL NOTES

- 1. SOIL EROSION CONTROL MEASURES FOR ALL SLOPES, CHANNELS, DITCHES, OR ANY DISTURBED LAND AREA SHALL BE COMPLETED WITHIN TWENTY-ONE (21) CALENDAR DAYS AFTER FINAL GRADING...
2. CONSTRUCTION FENCE AND SILT FENCE OFFSET FOR CLARITY...
3. EASTONVILLE ROAD SHALL BE STREET SWEEP AND INSPECTED ON A REGULAR BASIS...
4. THE ENTIRE PROJECT SITE IS COVERED WITH NATIVE GRASSES AND WEEDS...
5. NO BATCH PLANTS WILL BE UTILIZED FOR THIS PROJECT.

GENERAL CONSTRUCTION NOTES

- 1. IT SHALL BE THE RESPONSIBILITY OF THE CONTRACTOR TO VERIFY THE EXISTENCE AND LOCATION OF ALL UNDERGROUND UTILITIES...
2. THE CONTRACTOR SHALL TAKE THE NECESSARY PRECAUTIONS TO PROTECT EXISTING UTILITIES FROM DAMAGE...
3. ADDITIONAL EROSION CONTROL STRUCTURES MAY BE REQUIRED AT THE TIME OF CONSTRUCTION...
4. ALL BACKFILL, SUB-BASE AND / OR BASE COURSE (CLASS 6) MATERIAL SHALL BE COMPACTED TO THE SOILS ENGINEERS RECOMMENDATIONS...
5. ALL STATIONING IS CENTERLINE UNLESS OTHERWISE INDICATED...
6. ALL DISTURBED PAVEMENT EDGES SHALL BE CUT TO NEAT LINES...
7. ALL INTERSECTION ACCESSES TO BE CONSTRUCTED WITH A 25 FOOT SIGHT VISIBILITY TRIANGLES...
8. ALL CULVERT AND STORM PIPES SHALL BE SMOOTH INTERIOR CORRUGATED POLYETHYLENE PIPE (HDPE)...
9. ASPHALT THICKNESS AND BASE COURSE THICKNESS (COMPACTED FOR ROADS) SHALL BE PER DESIGN REPORT...
10. TYPE M RIP-RAP WITH 4" OF TYPE II GRANULAR BEDDING...
11. ALL MATERIALS AND INSTALLATION PROCEDURES SHALL BE IN COMPLIANCE WITH ANY AND ALL APPLICABLE EL PASO COUNTY STANDARDS...
12. ALL POTABLE WATER MAINS SHALL BE AWWA C900-SDR18 PVC WITH PUSH-ON SINGLE GASKET TYPE JOINTS...
13. ALL WATER MAIN FITTINGS SHALL BE MADE FROM GRAY-IRON OR DUCTILE IRON...
14. ALL WATER LINE BENDS, TEES, BLOW-OFFS AND PLUGS AT DEAD-END MAINS SHALL BE PROTECTED FROM THRUST...
15. MAXIMUM DEFLECTION OF 8" OR 12" PVC WATER MAIN JOINTS IS 4 DEGREES...
16. CONTRACTOR IS RESPONSIBLE FOR PROVIDING DETAILED AS-BUILTS OF ALL WATER MAIN, STORM SEWER AND SANITARY SEWER MAIN INSTALLATIONS...
17. SANITARY SEWER PIPE AND FITTINGS: PVC 4" - 8" ASTM D3034, TYPE PSN, SDR 35...



1155 Kelly Johnson Blvd., Suite 305
Colorado Springs, CO 80920
719.900.7220
GallowayUS.com

COPYRIGHT
THESE PLANS ARE AN INSTRUMENT OF SERVICE AND ARE THE PROPERTY OF GALLOWAY, AND MAY NOT BE DUPLICATED, DISCLOSED, OR REPRODUCED WITHOUT THE WRITTEN CONSENT OF GALLOWAY.




GRADING & EROSION CONTROL PLANS
GRANDVIEW RESERVE FILING NO. 1
MELODY HOMES, INC.
SF2311
EASTONVILLE RD & REX RD
EL PASO COUNTY, FALCON, CO 80831

Table with 4 columns: #, Date, Issue / Description, Init. It contains a series of empty rows for tracking changes.

Project No: HRG02
Drawn By: JDM, BLB
Checked By: BAS, CMWJ
Date: 03/15/2024

NOTES

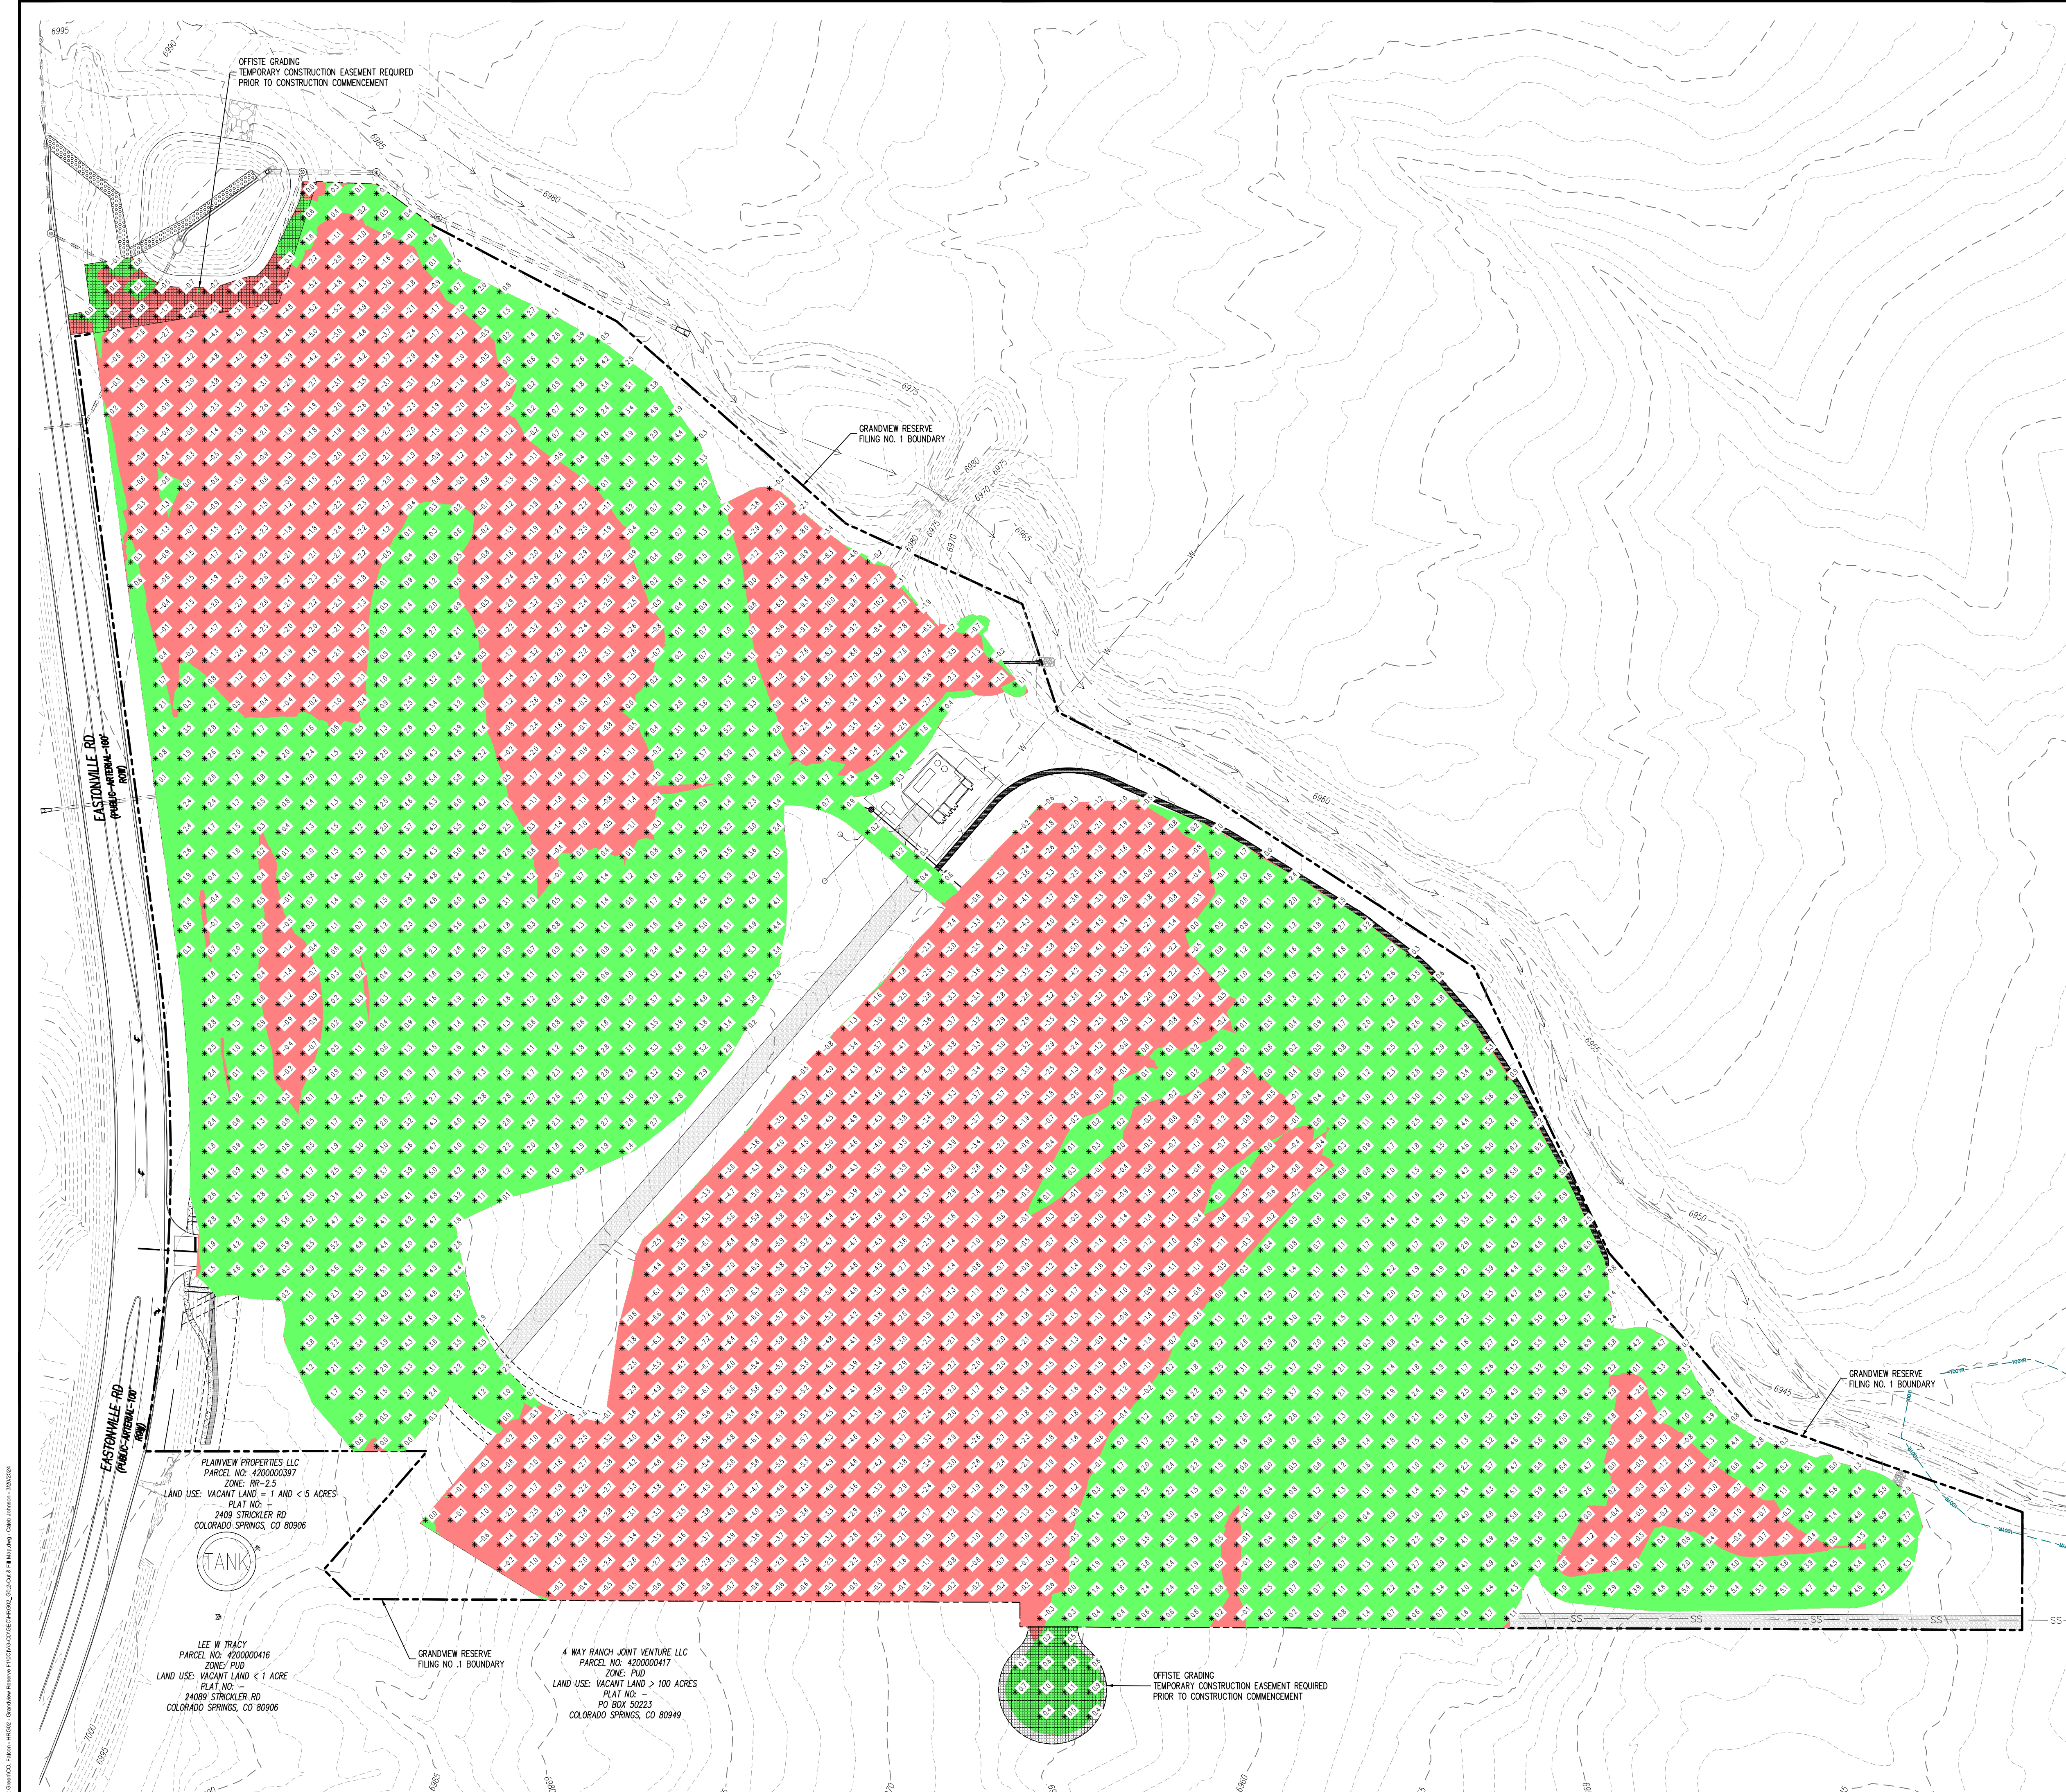

OFFSITE GRADING - TEMPORARY CONSTRUCTION EASEMENT REQUIRED PRIOR TO CONSTRUCTION COMMENCEMENT

GRANDVIEW RESERVE FILING NO. 1 BOUNDARY

GRANDVIEW RESERVE FILING NO. 1 BOUNDARY


PLAINVIEW PROPERTIES LLC
PARCEL NO. 420000397
ZONE: R6-24
LAND USE: VACANT LAND < 1 AND < 5 ACRES
PLAT NO: 2409 STRICKLER RD
COLORADO SPRINGS, CO 80906



LEE W TRACY
PARCEL NO. 420000416
ZONE: PUD
LAND USE: VACANT LAND < 1 ACRE
PLAT NO: 2409 STRICKLER RD
COLORADO SPRINGS, CO 80906

4 WAY RANCH JOINT VENTURE LLC
PARCEL NO. 420000417
ZONE: PUD
LAND USE: VACANT LAND > 100 ACRES
PLAT NO: PO BOX 50223
COLORADO SPRINGS, CO 80949

OFFSITE GRADING - TEMPORARY CONSTRUCTION EASEMENT REQUIRED PRIOR TO CONSTRUCTION COMMENCEMENT

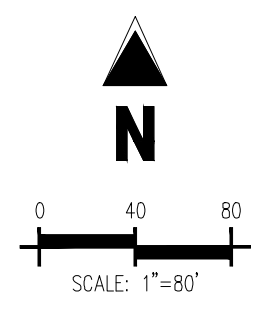

LEGEND

	AREAS OF CUT
	AREAS OF FILL
	OFFSITE GRADING

CUT & FILL SUMMARY

CUT	61,747 CY
FILL	61,045 CY
NET	702 CY (CUT)

FILL FACTOR: 1.00
CUT FACTOR: 1.00

COPYRIGHT
THESE PLANS ARE AN INSTRUMENT OF SERVICE AND ARE THE PROPERTY OF GALLOWAY, AND MAY NOT BE DUPLICATED, DISCLOSED, OR REPRODUCED WITHOUT THE WRITTEN CONSENT OF GALLOWAY. COPYRIGHTS AND INFRINGEMENTS WILL BE ENFORCED AND PROSECUTED.



GRADING & EROSION CONTROL PLANS
GRANDVIEW RESERVE FILING NO. 1
MELODY HOMES, INC.
SF2311
EASTONVILLE RD & REX RD
EL PASO COUNTY, FALCON, CO 80831

#	Date	Issue / Description	Init.


Project No: HRG02
Drawn By: JDM, BLB
Checked By: BAS, CMWJ
Date: 03/15/2024

CUT & FILL MAP

BASIS OF BEARING
THE NORTH LINE OF SECTION 28, TOWNSHIP 12 SOUTH, RANGE 64 WEST OF THE 6TH PRINCIPAL MERIDIAN, EL PASO COUNTY, STATE OF COLORADO BEING MONUMENTED AT EACH END BY A 3-1/8" ALUMINUM SURVEYORS CAP STAMPED "PSINC LS 30087" AND ASSUMED TO BEAR S89°47'04"E, A DISTANCE OF 5285.07 FEET.

BENCHMARK
N05 BENCHMARK F 24
A STANDARD DISK, STAMPED F 24 1929 AND SET IN THE TOP OF A CONCRETE POST PROJECTING ABOUT 6 INCHES ABOVE GROUND, ALONG THE CHICAGO, ROCK ISLAND AND PACIFIC RAILROAD, 52 FEET NORTHWEST OF THE CENTERLINE OF U.S. HIGHWAY 24, 48 FEET SOUTHEAST OF THE CENTERLINE OF THE TRACK.
NAVD88 ELEVATION = 6866.33

CAUTION - NOTICE TO CONTRACTOR
1. ALL UTILITY LOCATIONS SHOWN ARE BASED ON MAPS PROVIDED BY THE APPROPRIATE UTILITY COMPANY AND FIELD SURFACE EVIDENCE AT THE TIME OF SURVEY AND IS TO BE CONSIDERED AN APPROXIMATE LOCATION ONLY. IT IS THE CONTRACTOR'S RESPONSIBILITY TO FIELD VERIFY THE LOCATION OF ALL UTILITIES, PUBLIC OR PRIVATE, WHETHER SHOWN ON THE PLANS OR NOT, PRIOR TO CONSTRUCTION. REPORT ANY DISCREPANCIES TO THE ENGINEER PRIOR TO CONSTRUCTION.
2. WHERE A PROPOSED UTILITY CROSSES AN EXISTING UTILITY, IT IS THE CONTRACTOR'S RESPONSIBILITY TO FIELD VERIFY THE HORIZONTAL AND VERTICAL LOCATION OF SUCH EXISTING UTILITY, EITHER THROUGH POT-Holing OR ALTERNATIVE METHOD. REPORT INFORMATION TO THE ENGINEER PRIOR TO CONSTRUCTION.


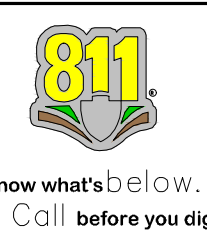


#	Date	Issue / Description	Init.

Project No:	HRG02
Drawn By:	JDM, BLB
Checked By:	BAS, CMWJ
Date:	03/15/2024

INITIAL EROSION CONTROL PLAN

G1.2
 Sheet 5 of 32

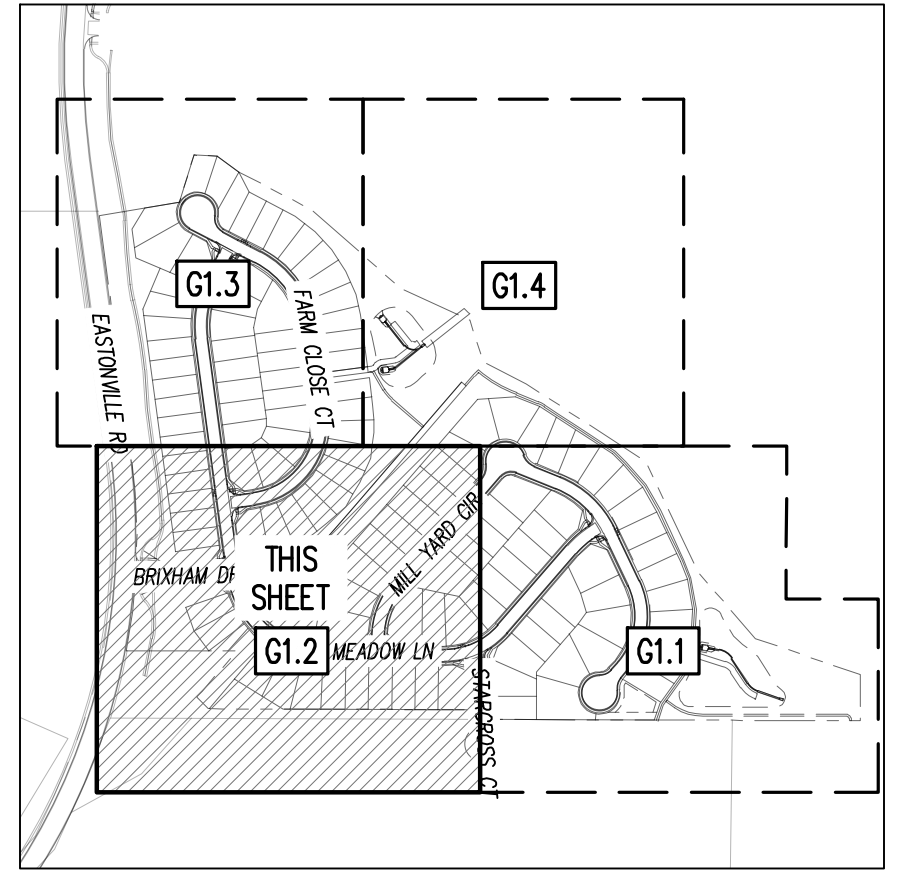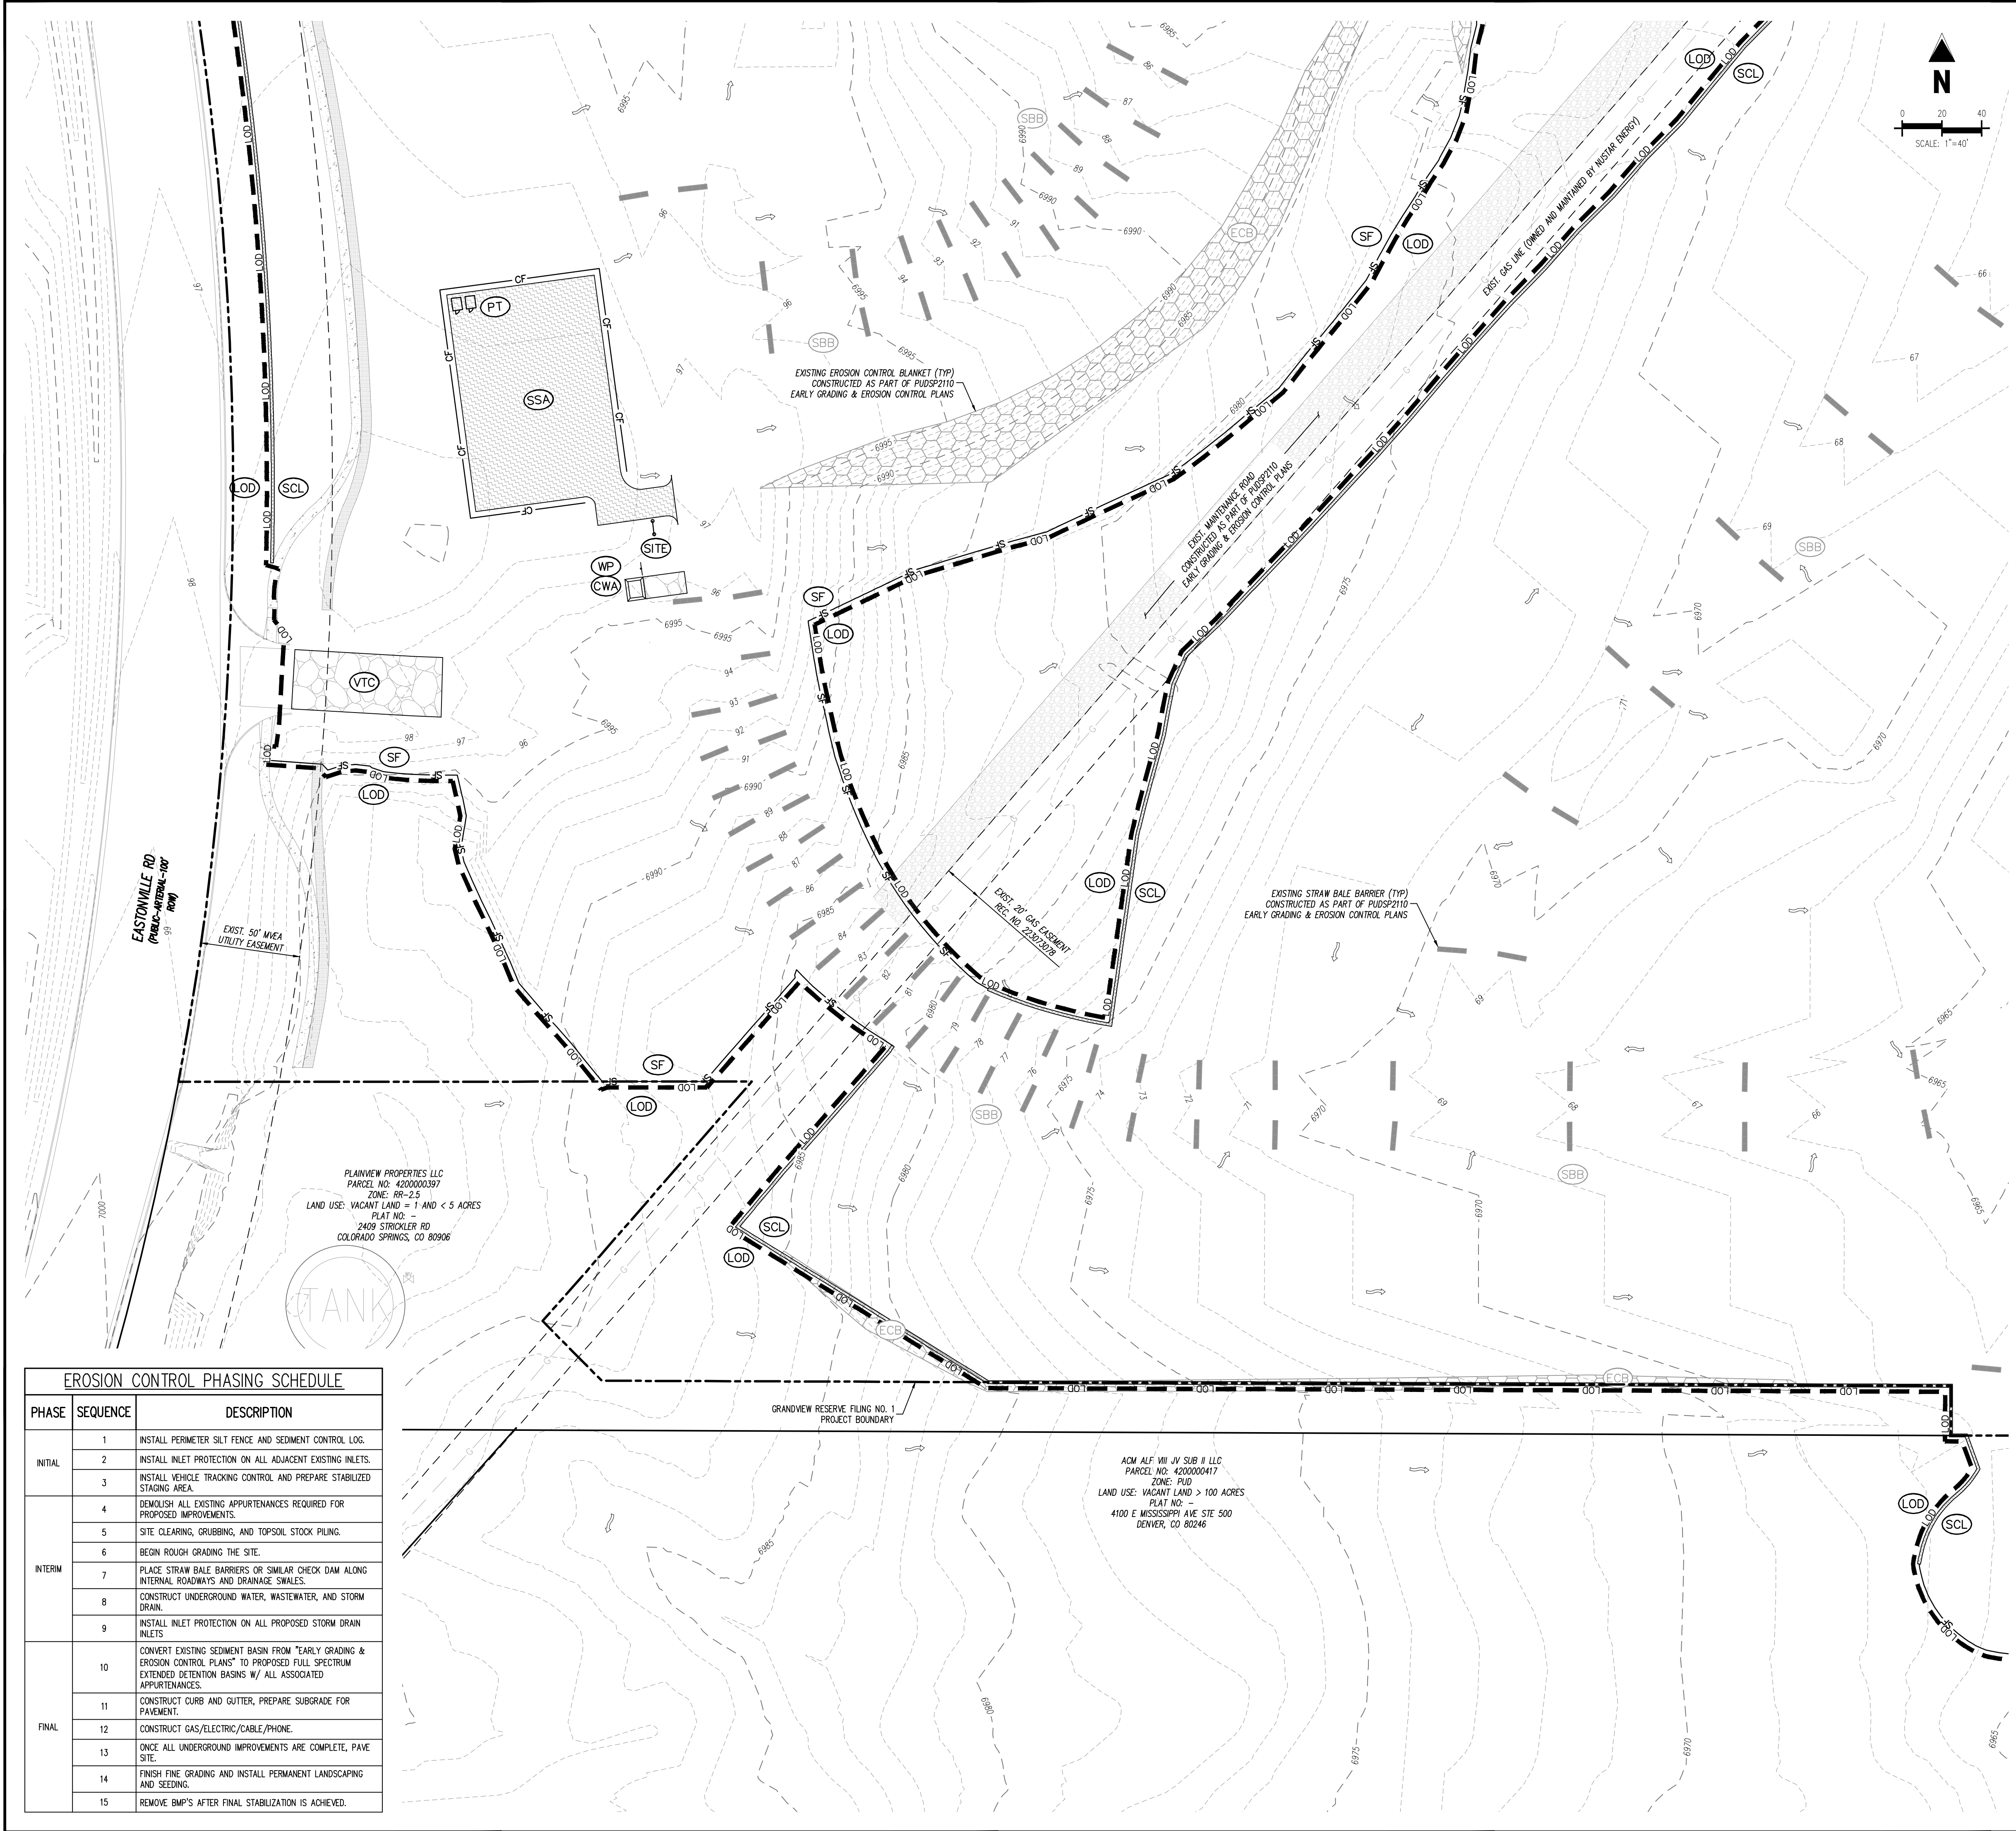

KEYMAP
SCALE: 1"=500'

EROSION CONTROL LEGEND

5460	EXISTING MAJOR CONTOUR
52	EXISTING MINOR CONTOUR
CSBS	PROPOSED MAJOR CONTOUR
CB	PROPOSED MINOR CONTOUR
SS	EXISTING STORM SEWER
SS	PROPOSED STORM SEWER
SS	EXISTING SANITARY SEWER
SS	PROPOSED SANITARY SEWER
W	PROPOSED WATER LINE
W	EXISTING GAS LINE
W	PROPOSED RIDGE LINE
W	PROPOSED SWALE LINE
W	EXISTING SWALE LINE
W	FLOODPLAIN BOUNDARY
W	EXISTING FLOOD ZONE
W	EXISTING FLOOD ZONE SETBACK
W	FLOW ARROW
W	PROPOSED GRAVEL PER EOM TABLE D-7
LS	PERMANENT LANDSCAPING
DD	DIVERSION DITCH
LOD	LIMITS OF DISTURBANCE/CONSTRUCTION
VTC	VEHICLE TRACKING CONTROL
CWA	CONCRETE WASHOUT AREA
SSA	STABILIZED STAGING AREA
SM	SEED AND MULCH
SCL	SEDIMENT CONTROL LOG
IPS	SUMP INLET PROTECTION (P-3)
IPD	ON-GRADE INLET PROTECTION (P-4)
RS	ROCK SOCKS
SF	SILT FENCE
CF	CONSTRUCTION FENCE
SB	SEDIMENT BASIN
CD	CHECK DAM
ECB	COMPOST BLANKET (APPROXIMATE)
RR	RIPRAP OUTFALL PADS
PT	PORTABLE TOILET
SITE	SITE POSTING (CONTACTS AND PERMITS)
WP	WASHOUT POSTING
SBB	STRAW BALE BARRIER
XX	EROSION MEASURE INSTALLED IN EARLIER PHASE
XX	PROPOSED EROSION MEASURE

NOTES

- ALL EXISTING SILT FENCE INSTALLED WITH PUDSP2110, EARLY GRADING & EROSION CONTROL PLANS, SHALL BE RELOCATED TO MATCH THIS PLAN.

BASIS OF BEARING

THE NORTH LINE OF SECTION 28, TOWNSHIP 12 SOUTH, RANGE 64 WEST OF THE 6TH PRINCIPAL MERIDIAN, EL PASO COUNTY, STATE OF COLORADO BEING MONUMENTED AT EACH END BY A 3-1/4" ALUMINUM SURVEYORS CAP STAMPED "PINC LS 30087" AND ASSUMED TO BEAR S89°47'04"E, A DISTANCE OF 5285.07 FEET.

BENCHMARK

NOS BENCHMARK F 24
 A STANDARD DISK, STAMPED F 24 1929 AND SET IN THE TOP OF A CONCRETE POST PROJECTING ABOUT 6 INCHES ABOVE GROUND, ALONG THE CHICAGO, ROCK ISLAND AND PACIFIC RAILROAD, 52 FEET NORTHWEST OF THE CENTERLINE OF U.S. HIGHWAY 24, 48 FEET SOUTHEAST OF THE CENTERLINE OF THE TRACK.
 NAVD88 ELEVATION = 6866.33

CAUTION - NOTICE TO CONTRACTOR



- ALL UTILITY LOCATIONS SHOWN ARE BASED ON MAPS PROVIDED BY THE APPROPRIATE UTILITY COMPANY AND FIELD SURFACE EVIDENCE AT THE TIME OF SURVEY AND IS TO BE CONSIDERED AN APPROXIMATE LOCATION ONLY. IT IS THE CONTRACTOR'S RESPONSIBILITY TO FIELD VERIFY THE LOCATION OF ALL UTILITIES, PUBLIC OR PRIVATE, WHETHER SHOWN ON THE PLANS OR NOT, PRIOR TO CONSTRUCTION. REPORT ANY DISCREPANCIES TO THE ENGINEER PRIOR TO CONSTRUCTION.
- WHERE A PROPOSED UTILITY CROSSES AN EXISTING UTILITY, IT IS THE CONTRACTOR'S RESPONSIBILITY TO FIELD VERIFY THE HORIZONTAL AND VERTICAL LOCATION OF SUCH EXISTING UTILITY, EITHER THROUGH POT-Holing OR ALTERNATIVE METHOD. REPORT INFORMATION TO THE ENGINEER PRIOR TO CONSTRUCTION.

PHASE	SEQUENCE	DESCRIPTION
INITIAL	1	INSTALL PERMETER SILT FENCE AND SEDIMENT CONTROL LOG.
	2	INSTALL INLET PROTECTION ON ALL ADJACENT EXISTING INLETS.
	3	INSTALL VEHICLE TRACKING CONTROL AND PREPARE STABILIZED STAGING AREA.
INTERIM	4	DEMOLISH ALL EXISTING APPURTENANCES REQUIRED FOR PROPOSED IMPROVEMENTS.
	5	SITE CLEARING, GRUBBING, AND TOPSOIL STOCK PILING.
	6	BEGIN ROUGH GRADING THE SITE.
	7	PLACE STRAW BALE BARRIERS OR SIMILAR CHECK DAM ALONG INTERNAL ROADWAYS AND DRAINAGE SWALES.
	8	CONSTRUCT UNDERGROUND WATER, WASTEWATER, AND STORM DRAIN.
FINAL	9	INSTALL INLET PROTECTION ON ALL PROPOSED STORM DRAIN INLETS.
	10	CONVERT EXISTING SEDIMENT BASIN FROM "EARLY GRADING & EROSION CONTROL PLANS" TO PROPOSED FULL SPECTRUM EXTENDED DETENTION BASIN W/ ALL ASSOCIATED APPURTENANCES.
	11	CONSTRUCT CURB AND GUTTER, PREPARE SUBGRADE FOR PAVEMENT.
	12	CONSTRUCT GAS/ELECTRIC/CABLE/PHONE.
	13	ONCE ALL UNDERGROUND IMPROVEMENTS ARE COMPLETE, PAVE SITE.
	14	FINISH FINE GRADING AND INSTALL PERMANENT LANDSCAPING AND SEEDING.
	15	REMOVE BMP'S AFTER FINAL STABILIZATION IS ACHIEVED.


PLAINVIEW PROPERTIES LLC
 PARCEL NO. 420000397
 ZONE: RR-2.5
 LAND USE: VACANT LAND - 1 AND < 5 ACRES
 PLAT NO. -
 2409 STROCKLER RD
 COLORADO SPRINGS, CO 80906

ADM ALF VII JV SUB II LLC
 PARCEL NO. 420000417
 ZONE: PUD
 LAND USE: VACANT LAND > 100 ACRES
 PLAT NO. -
 4100 E MISSISSIPPI AVE STE 500
 DENVER, CO 80246

2/2/24 10:00 AM G:\Projects\2024\Grandview Reserve Filing No. 1\Drawings\EROSION CONTROL PHASING SCHEDULE.dwg (JDM)

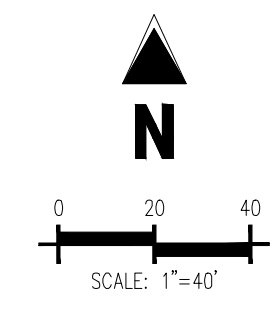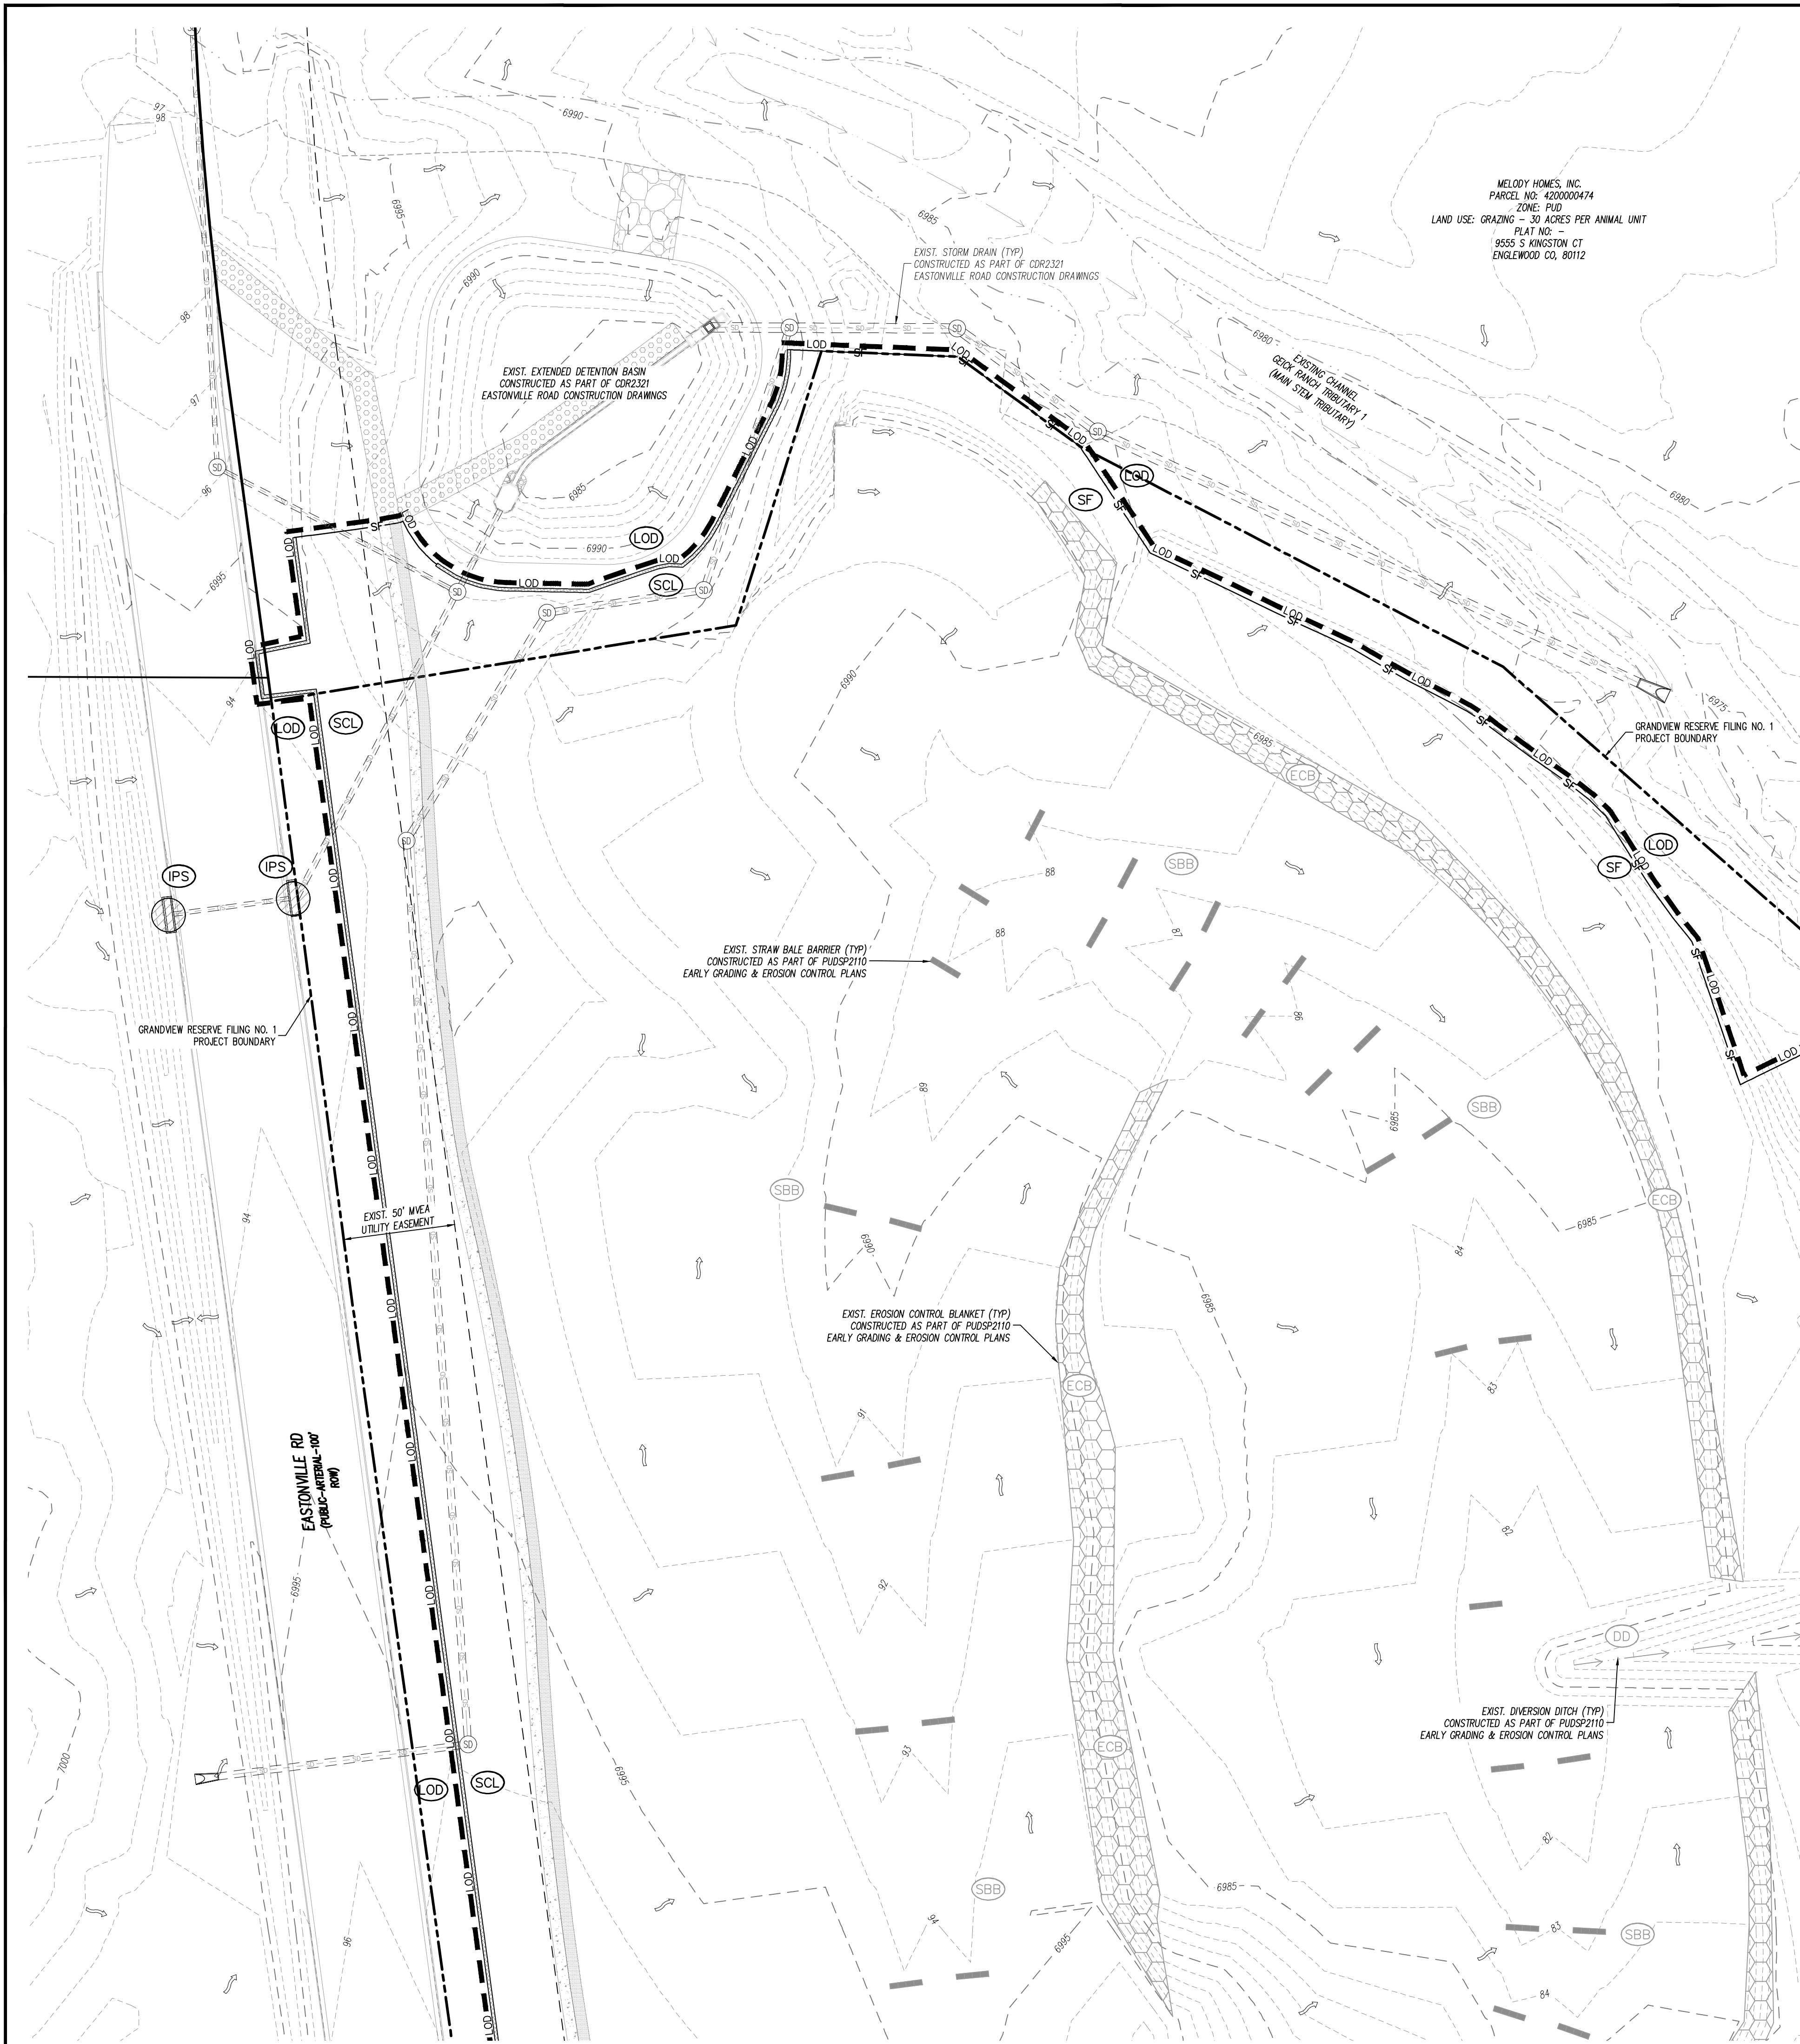

MELODY HOMES, INC.
 PARCEL NO: 420000474
 ZONE: PLD
 LAND USE: GRADING - 30 ACRES PER ANIMAL UNIT
 PLAT NO:
 8555 S KINGSTON CT
 ENGLEWOOD CO, 80112

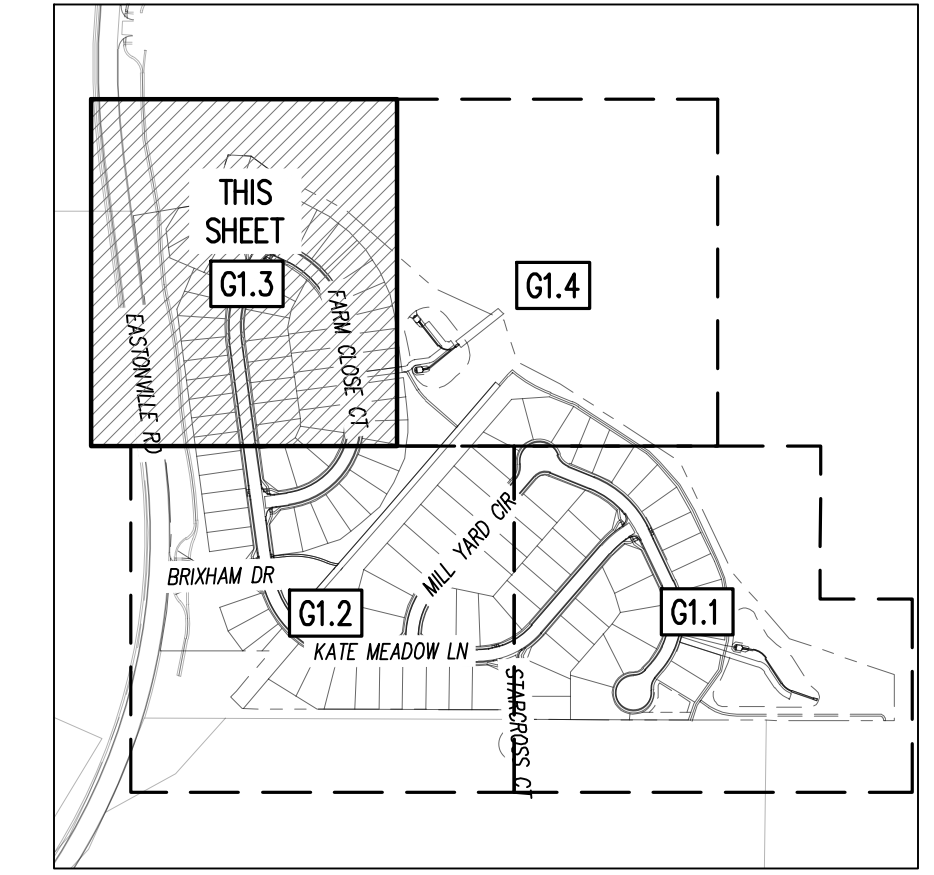


KEYMAP
 SCALE: 1"=500'

EROSION CONTROL PHASING SCHEDULE

PHASE	SEQUENCE	DESCRIPTION
INITIAL	1	INSTALL PERIMETER SILT FENCE AND SEDIMENT CONTROL LOG.
	2	INSTALL INLET PROTECTION ON ALL ADJACENT EXISTING INLETS.
	3	INSTALL VEHICLE TRACKING CONTROL AND PREPARE STABILIZED STAGING AREA.
INTERM	4	DEMOLISH ALL EXISTING APPURTENANCES REQUIRED FOR PROPOSED IMPROVEMENTS.
	5	SITE CLEARING, GRUBBING, AND TOPSOIL STOCK PILING.
	6	BEGIN ROUGH GRADING THE SITE.
	7	PLACE STRAW BALE BARRIERS OR SIMILAR CHECK DAM ALONG INTERNAL ROADWAYS AND DRAINAGE SWALES.
	8	CONSTRUCT UNDERGROUND WATER, WASTEWATER, AND STORM DRAIN.
	9	INSTALL INLET PROTECTION ON ALL PROPOSED STORM DRAIN INLETS.
FINAL	10	CONVERT EXISTING SEDIMENT BASIN FROM "EARLY GRADING & EROSION CONTROL PLANS" TO PROPOSED FULL SPECTRUM EXTENDED DETENTION BASINS W/ ALL ASSOCIATED APPURTENANCES.
	11	CONSTRUCT CURB AND GUTTER, PREPARE SUBGRADE FOR PAVEMENT.
	12	CONSTRUCT GAS/ELECTRIC/CABLE/PHONE.
	13	ONCE ALL UNDERGROUND IMPROVEMENTS ARE COMPLETE, PAVE SITE.
	14	FINISH FINE GRADING AND INSTALL PERMANENT LANDSCAPING AND SEEDING.
	15	REMOVE BMP'S AFTER FINAL STABILIZATION IS ACHIEVED.

EROSION CONTROL LEGEND

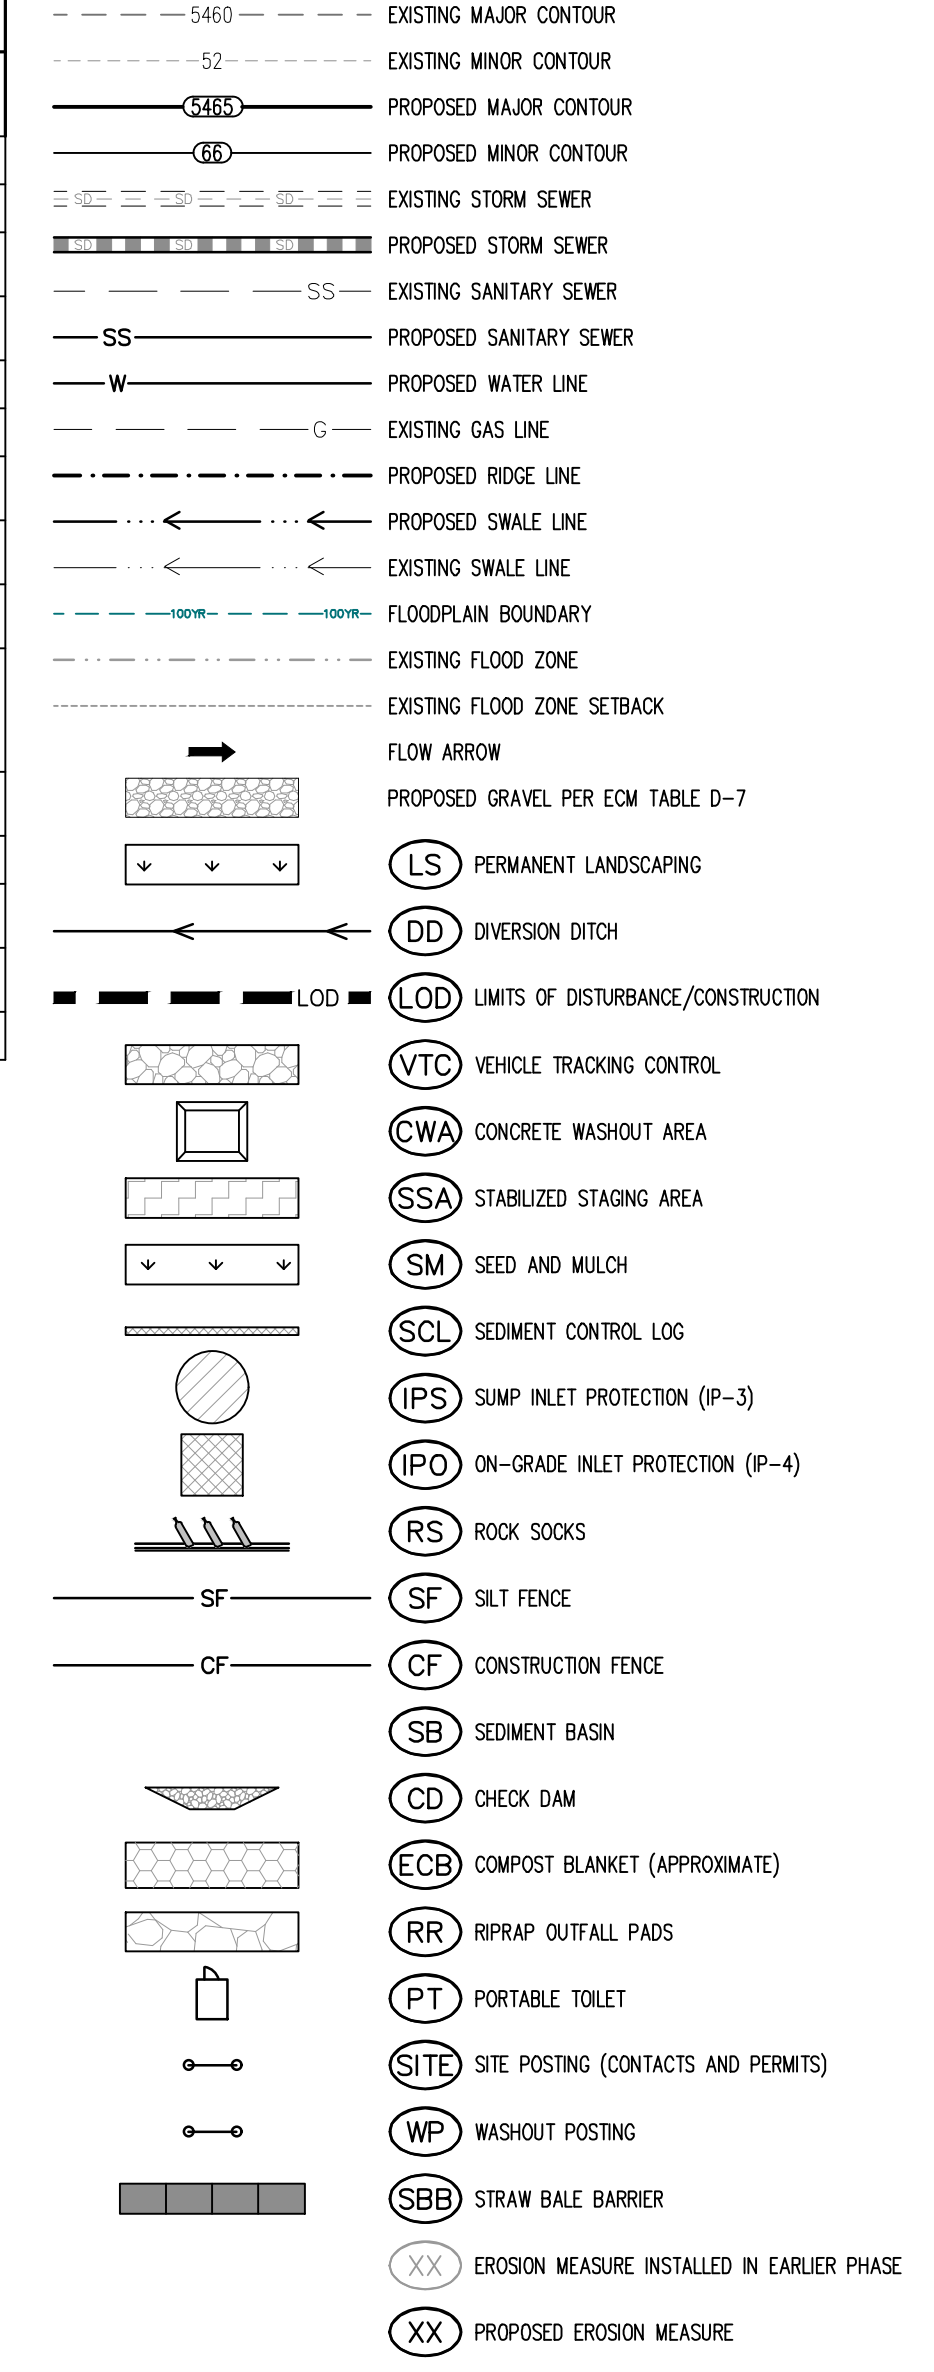

NOTES

1. ALL EXISTING SILT FENCE INSTALLED WITH PUDSP2110, EARLY GRADING & EROSION CONTROL PLANS, SHALL BE RELOCATED TO MATCH THIS PLAN.

BASIS OF BEARING

THE NORTH LINE OF SECTION 28, TOWNSHIP 12 SOUTH, RANGE 64 WEST OF THE 6TH PRINCIPAL MERIDIAN, EL PASO COUNTY, STATE OF COLORADO BEING MONUMENTED AT EACH END BY A 3-1/2" ALUMINUM SURVEYORS CAP STAMPED "PSINC LS 30087" AND ASSUMED TO BEAR S89°47'04"E, A DISTANCE OF 5285.07 FEET.

BENCHMARK

NOS BENCHMARK F 24
 A STANDARD DISK, STAMPED F 24 1929 AND SET IN THE TOP OF A CONCRETE POST PROJECTING ABOUT 6 INCHES ABOVE GROUND, ALONG THE CHICAGO, ROCK ISLAND AND PACIFIC RAILROAD, 52 FEET NORTHWEST OF THE CENTERLINE OF U.S. HIGHWAY 24, 48 FEET SOUTHWEST OF THE CENTERLINE OF THE TRACK.
 NAVD83 ELEVATION = 6866.33

CAUTION - NOTICE TO CONTRACTOR

1. ALL UTILITY LOCATIONS SHOWN ARE BASED ON MAPS PROVIDED BY THE APPROPRIATE UTILITY COMPANY AND FIELD SURFACE EVIDENCE AT THE TIME OF SURVEY AND IS TO BE CONSIDERED AN APPROXIMATE LOCATION ONLY. IT IS THE CONTRACTOR'S RESPONSIBILITY TO FIELD VERIFY THE LOCATION OF ALL UTILITIES, PUBLIC OR PRIVATE, WHETHER SHOWN ON THE PLANS OR NOT, PRIOR TO CONSTRUCTION. REPORT ANY DISCREPANCIES TO THE ENGINEER PRIOR TO CONSTRUCTION.

2. WHERE A PROPOSED UTILITY CROSSES AN EXISTING UTILITY, IT IS THE CONTRACTOR'S RESPONSIBILITY TO FIELD VERIFY THE HORIZONTAL AND VERTICAL LOCATION OF SUCH EXISTING UTILITY, EITHER THROUGH TYPING OR AN ALTERNATIVE METHOD. REPORT INFORMATION TO THE ENGINEER PRIOR TO CONSTRUCTION.



#	Date	Issue / Description	Init.


Project No:	HRG02
Drawn By:	JDM, BLB
Checked By:	BAS, CMWJ
Date:	03/15/2024

INITIAL EROSION CONTROL PLAN


#	Date	Issue / Description	Init.

Project No:	HRG02
Drawn By:	JDM, BLB
Checked By:	BAS, CMWJ
Date:	03/15/2024

INITIAL EROSION CONTROL PLAN

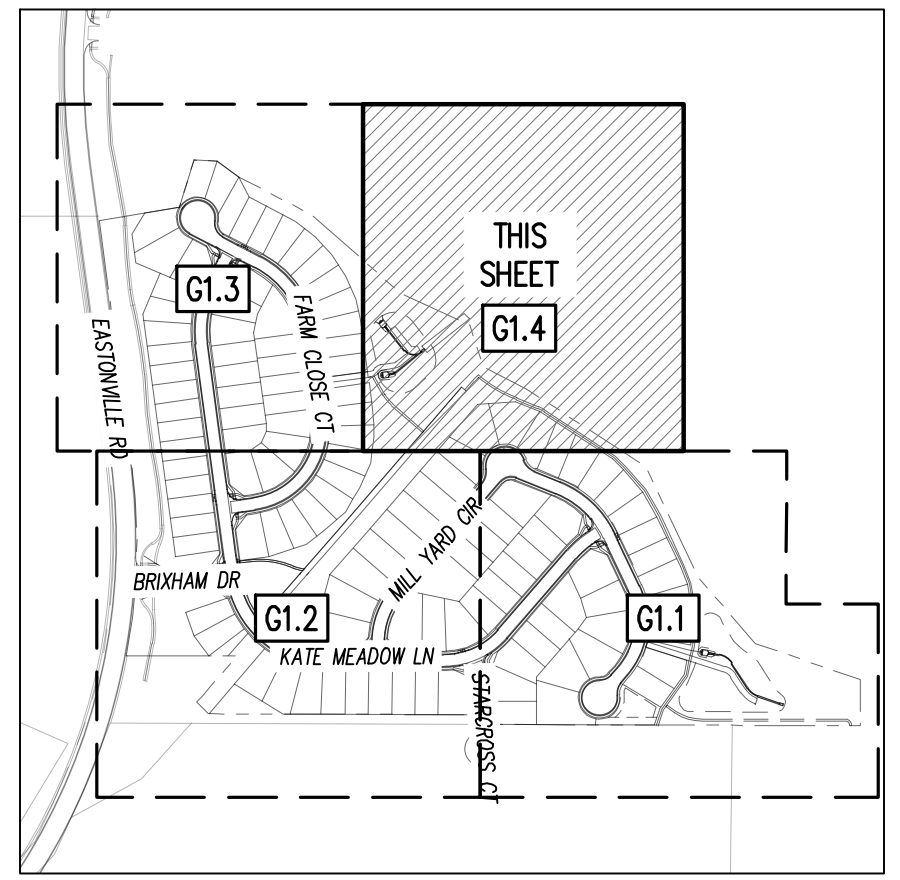

KEYMAP
SCALE: 1"=500'

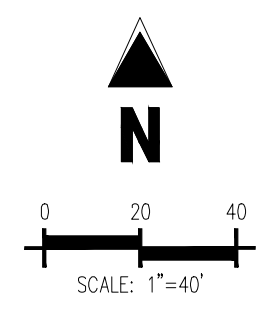

EROSION CONTROL PHASING SCHEDULE

PHASE	SEQUENCE	DESCRIPTION
INITIAL	1	INSTALL PERIMETER SILT FENCE AND SEDIMENT CONTROL LOG.
	2	INSTALL INLET PROTECTION ON ALL ADJACENT EXISTING INLETS.
	3	INSTALL VEHICLE TRACKING CONTROL AND PREPARE STABILIZED STAGING AREA.
INTERIM	4	DEMOLISH ALL EXISTING APPURTENANCES REQUIRED FOR PROPOSED IMPROVEMENTS.
	5	SITE CLEARING, GRUBBING, AND TOPSOIL STOCK PILING.
	6	BEGIN ROUGH GRADING THE SITE.
	7	PLACE STRAW BALE BARRIERS OR SIMILAR CHECK DAM ALONG INTERNAL ROADWAYS AND DRAINAGE SWALES.
	8	CONSTRUCT UNDERGROUND WATER, WASTEWATER, AND STORM DRAIN.
	9	INSTALL INLET PROTECTION ON ALL PROPOSED STORM DRAIN INLETS.
FINAL	10	CONVERT EXISTING SEDIMENT BASIN FROM "EARLY GRADING & EROSION CONTROL PLANS" TO PROPOSED FULL SPECTRUM EXTENDED DETENTION BASINS W/ ALL ASSOCIATED APPURTENANCES.
	11	CONSTRUCT CURB AND GUTTER, PREPARE SUBGRADE FOR PAVEMENT.
	12	CONSTRUCT GAS/ELECTRIC/CABLE/PHONE.
	13	ONCE ALL UNDERGROUND IMPROVEMENTS ARE COMPLETE, PAVE SITE.
	14	FINISH FINE GRADING AND INSTALL PERMANENT LANDSCAPING AND SEEDING.
	15	REMOVE BMP'S AFTER FINAL STABILIZATION IS ACHIEVED.

EROSION CONTROL LEGEND

- 5460 - EXISTING MAJOR CONTOUR
- 52 - EXISTING MINOR CONTOUR
- CSBS - PROPOSED MAJOR CONTOUR
- CS - PROPOSED MINOR CONTOUR
- SS - EXISTING STORM SEWER
- SS - PROPOSED STORM SEWER
- SS - EXISTING SANITARY SEWER
- SS - PROPOSED SANITARY SEWER
- W - EXISTING WATER LINE
- W - PROPOSED WATER LINE
- G - EXISTING GAS LINE
- G - PROPOSED GAS LINE
- PROPOSED RIDGE LINE
- PROPOSED SWALE LINE
- EXISTING SWALE LINE
- FLOODPLAIN BOUNDARY
- EXISTING FLOOD ZONE
- EXISTING FLOOD ZONE SETBACK
- FLOW ARROW
- PROPOSED GRAVEL PER EOM TABLE D-7
- LS - PERMANENT LANDSCAPING
- DD - DIVERSION DITCH
- LOD - LIMITS OF DISTURBANCE/CONSTRUCTION
- VTC - VEHICLE TRACKING CONTROL
- CWA - CONCRETE WASHOUT AREA
- SSA - STABILIZED STAGING AREA
- SM - SEED AND MULCH
- SCL - SEDIMENT CONTROL LOG
- IPS - SLUMP INLET PROTECTION (P-3)
- IPD - ON-GRADE INLET PROTECTION (P-4)
- RS - ROCK SOCKS
- SF - SILT FENCE
- CF - CONSTRUCTION FENCE
- SB - SEDIMENT BASIN
- CD - CHECK DAM
- ECB - COMPOST BLANKET (APPROXIMATE)
- RR - RIPRAP OUTFALL PADS
- PT - PORTABLE TOILET
- SITE - SITE POSTING (CONTACTS AND PERMITS)
- WP - WASHOUT POSTING
- SBB - STRAW BALE BARRIER
- XX - EROSION MEASURE INSTALLED IN EARLIER PHASE
- XX - PROPOSED EROSION MEASURE

NOTES

1. ALL EXISTING SILT FENCE INSTALLED WITH PUDSP2110, EARLY GRADING & EROSION CONTROL PLANS, SHALL BE RELOCATED TO MATCH THIS PLAN.

BASIS OF BEARING

THE NORTH LINE OF SECTION 28, TOWNSHIP 12 SOUTH, RANGE 64 WEST OF THE 6TH PRINCIPAL MERIDIAN, EL PASO COUNTY, STATE OF COLORADO BEING MONUMENTED AT EACH END BY A 3-3/4" ALUMINUM SURVEYORS CAP STAMPED "PSINC LS 30087" AND ASSUMED TO BEAR S89°47'04"E, A DISTANCE OF 5285.07 FEET.


BENCHMARK

NOS BENCHMARK F 24
A STANDARD DISK, STAMPED F 24 1929 AND SET IN THE TOP OF A CONCRETE POST PROJECTING ABOUT 6 INCHES ABOVE GROUND, ALONG THE CHICAGO, ROCK ISLAND AND PACIFIC RAILROAD, 52 FEET NORTHWEST OF THE CENTERLINE OF U.S. HIGHWAY 24, 48 FEET SOUTHWEST OF THE CENTERLINE OF THE TRACK.
NAVD88 ELEVATION = 6886.33



CAUTION - NOTICE TO CONTRACTOR

1. ALL UTILITY LOCATIONS SHOWN ARE BASED ON MAPS PROVIDED BY THE APPROPRIATE UTILITY COMPANY AND FIELD SURFACE EVIDENCE AT THE TIME OF SURVEY AND IS TO BE CONSIDERED AN APPROXIMATE LOCATION ONLY. IT IS THE CONTRACTOR'S RESPONSIBILITY TO FIELD VERIFY THE LOCATION OF ALL UTILITIES, PUBLIC OR PRIVATE, WHETHER SHOWN ON THE PLANS OR NOT, PRIOR TO CONSTRUCTION. REPORT ANY DISCREPANCIES TO THE ENGINEER PRIOR TO CONSTRUCTION.


2. WHERE A PROPOSED UTILITY CROSSES AN EXISTING UTILITY, IT IS THE CONTRACTOR'S RESPONSIBILITY TO FIELD VERIFY THE HORIZONTAL AND VERTICAL LOCATION OF SUCH EXISTING UTILITY, EITHER THROUGH POT-Holing OR ALTERNATIVE METHOD. REPORT INFORMATION TO THE ENGINEER PRIOR TO CONSTRUCTION.

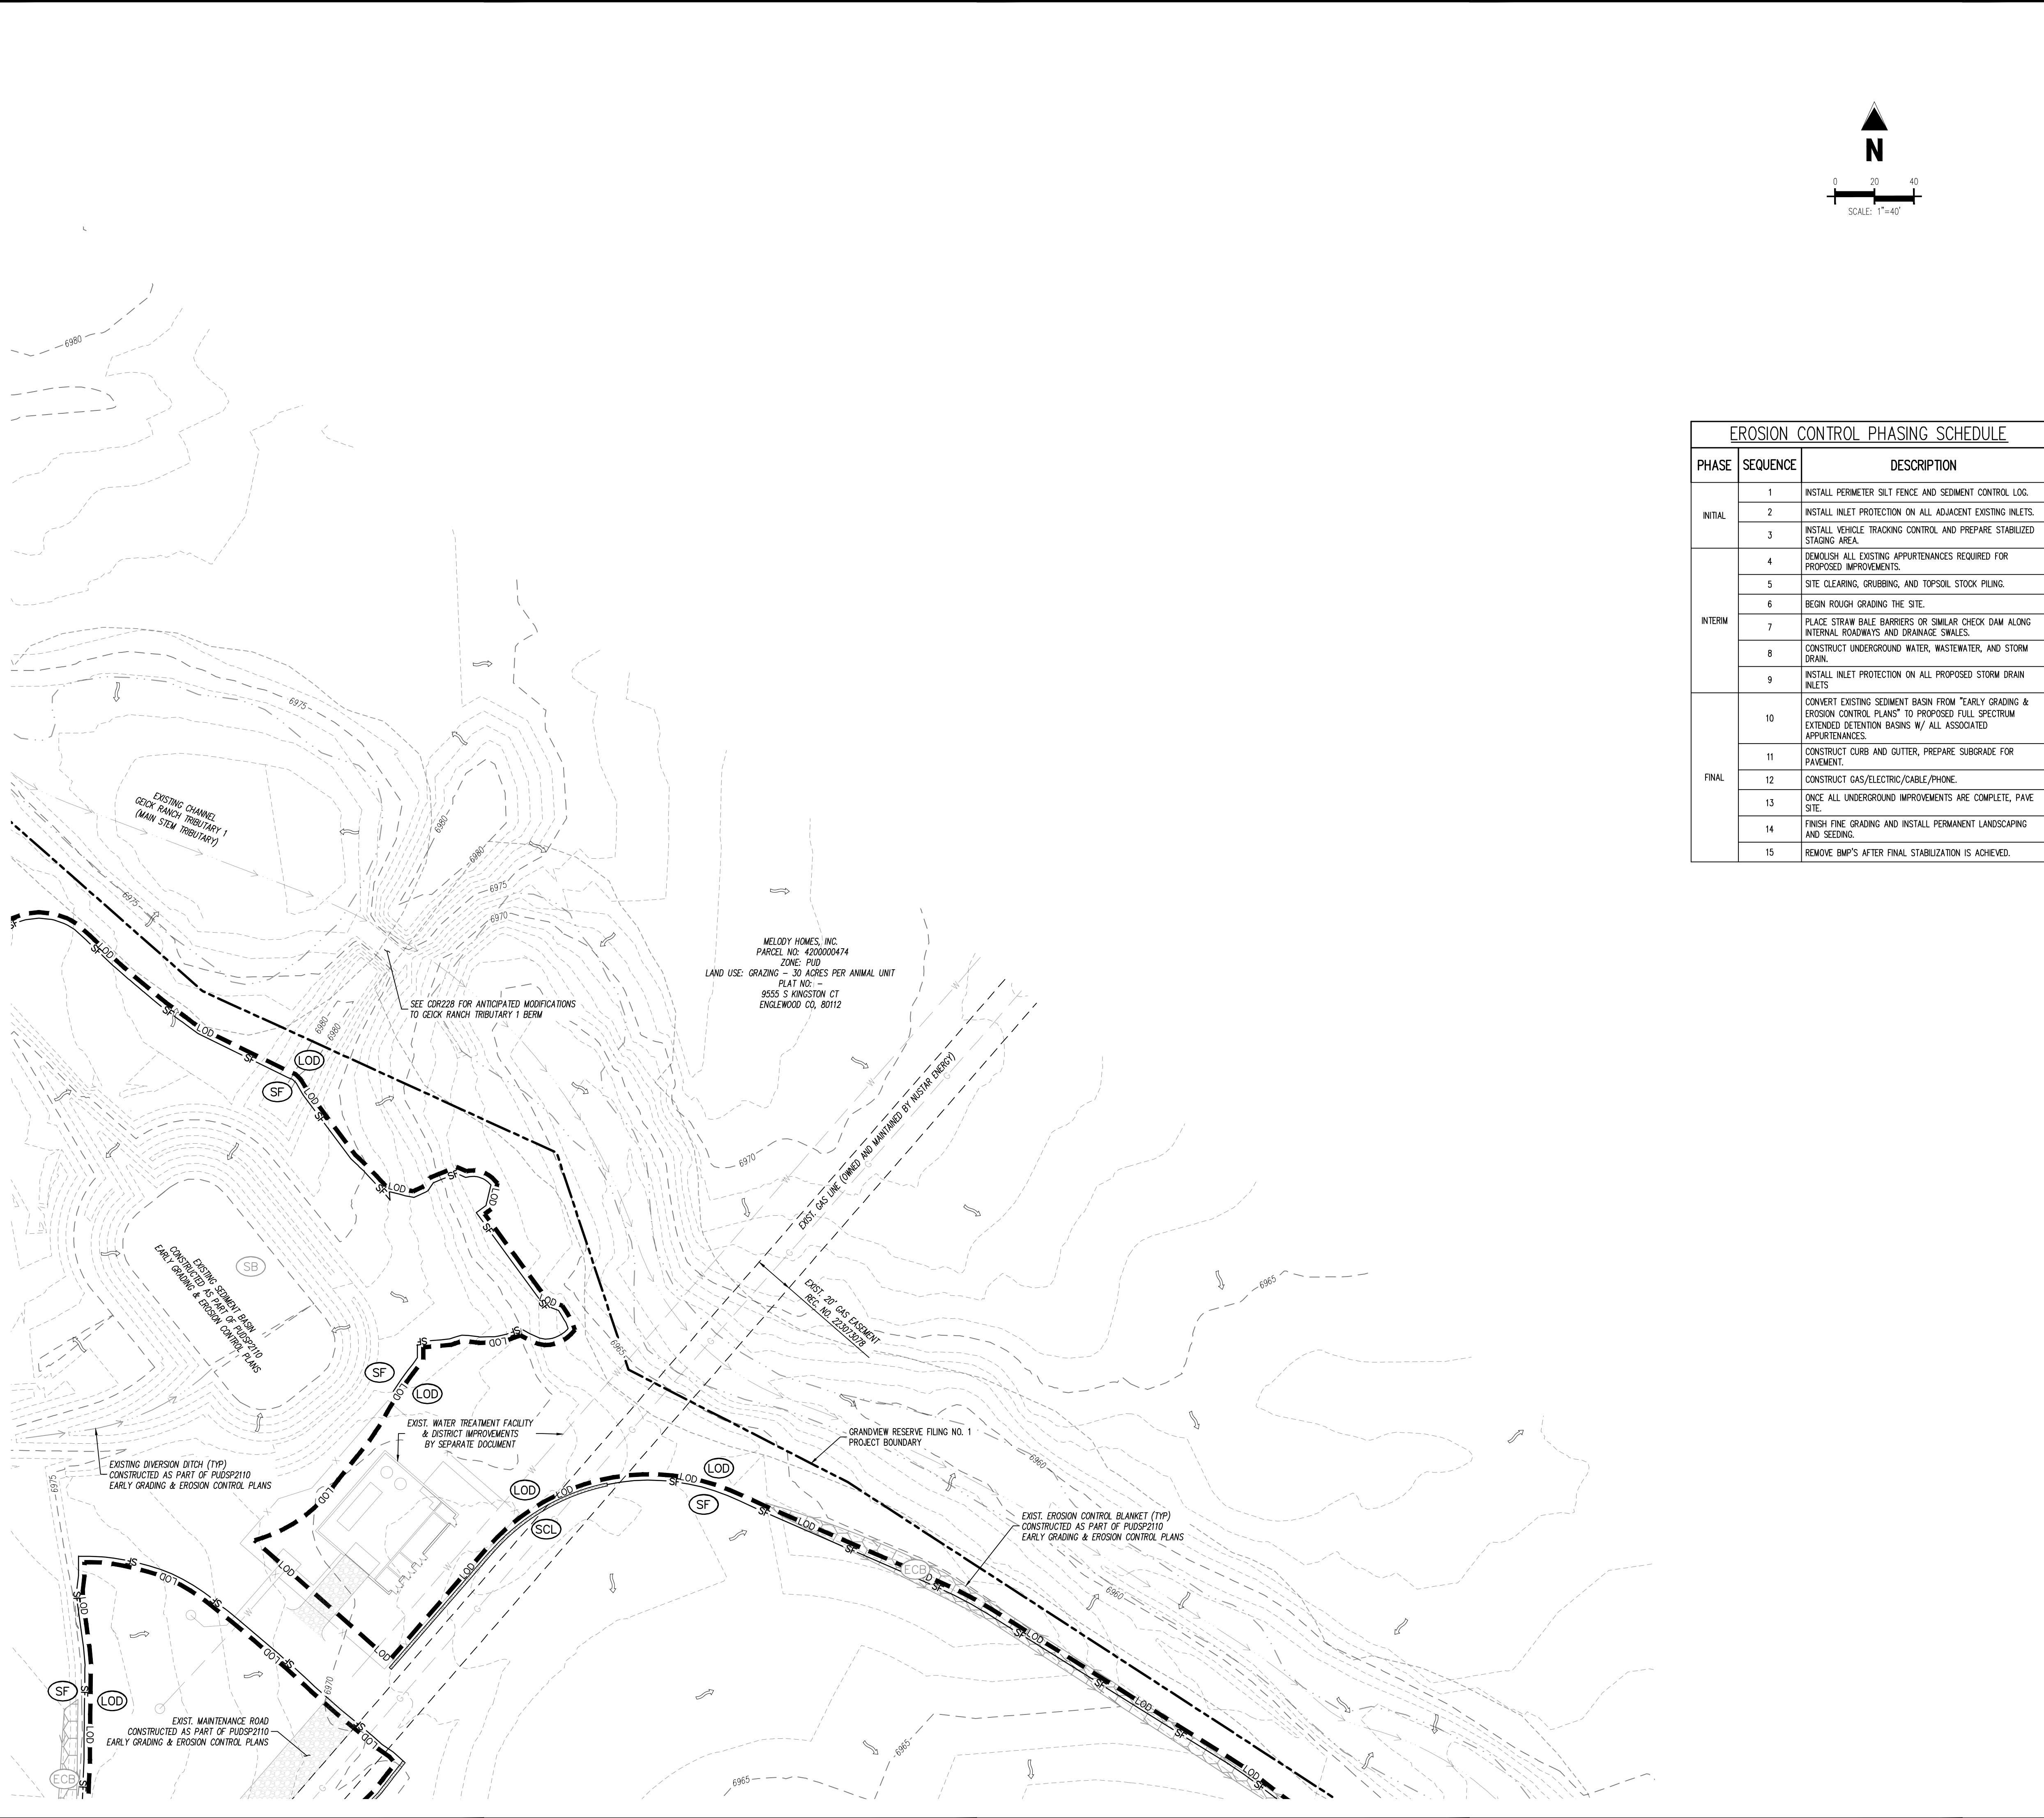

1. ALL UTILITY LOCATIONS SHOWN ARE BASED ON MAPS PROVIDED BY THE APPROPRIATE UTILITY COMPANY AND FIELD SURFACE EVIDENCE AT THE TIME OF SURVEY AND IS TO BE CONSIDERED AN APPROXIMATE LOCATION ONLY. IT IS THE CONTRACTOR'S RESPONSIBILITY TO FIELD VERIFY THE LOCATION OF ALL UTILITIES, PUBLIC OR PRIVATE, WHETHER SHOWN ON THE PLANS OR NOT, PRIOR TO CONSTRUCTION. REPORT ANY DISCREPANCIES TO THE ENGINEER PRIOR TO CONSTRUCTION.
 2. WHERE A PROPOSED UTILITY CROSSES AN EXISTING UTILITY, IT IS THE CONTRACTOR'S RESPONSIBILITY TO FIELD VERIFY THE HORIZONTAL AND VERTICAL LOCATION OF SUCH EXISTING UTILITY, EITHER THROUGH POT-Holing OR ALTERNATIVE METHOD. REPORT INFORMATION TO THE ENGINEER PRIOR TO CONSTRUCTION.

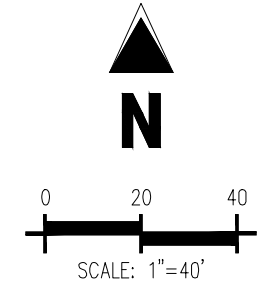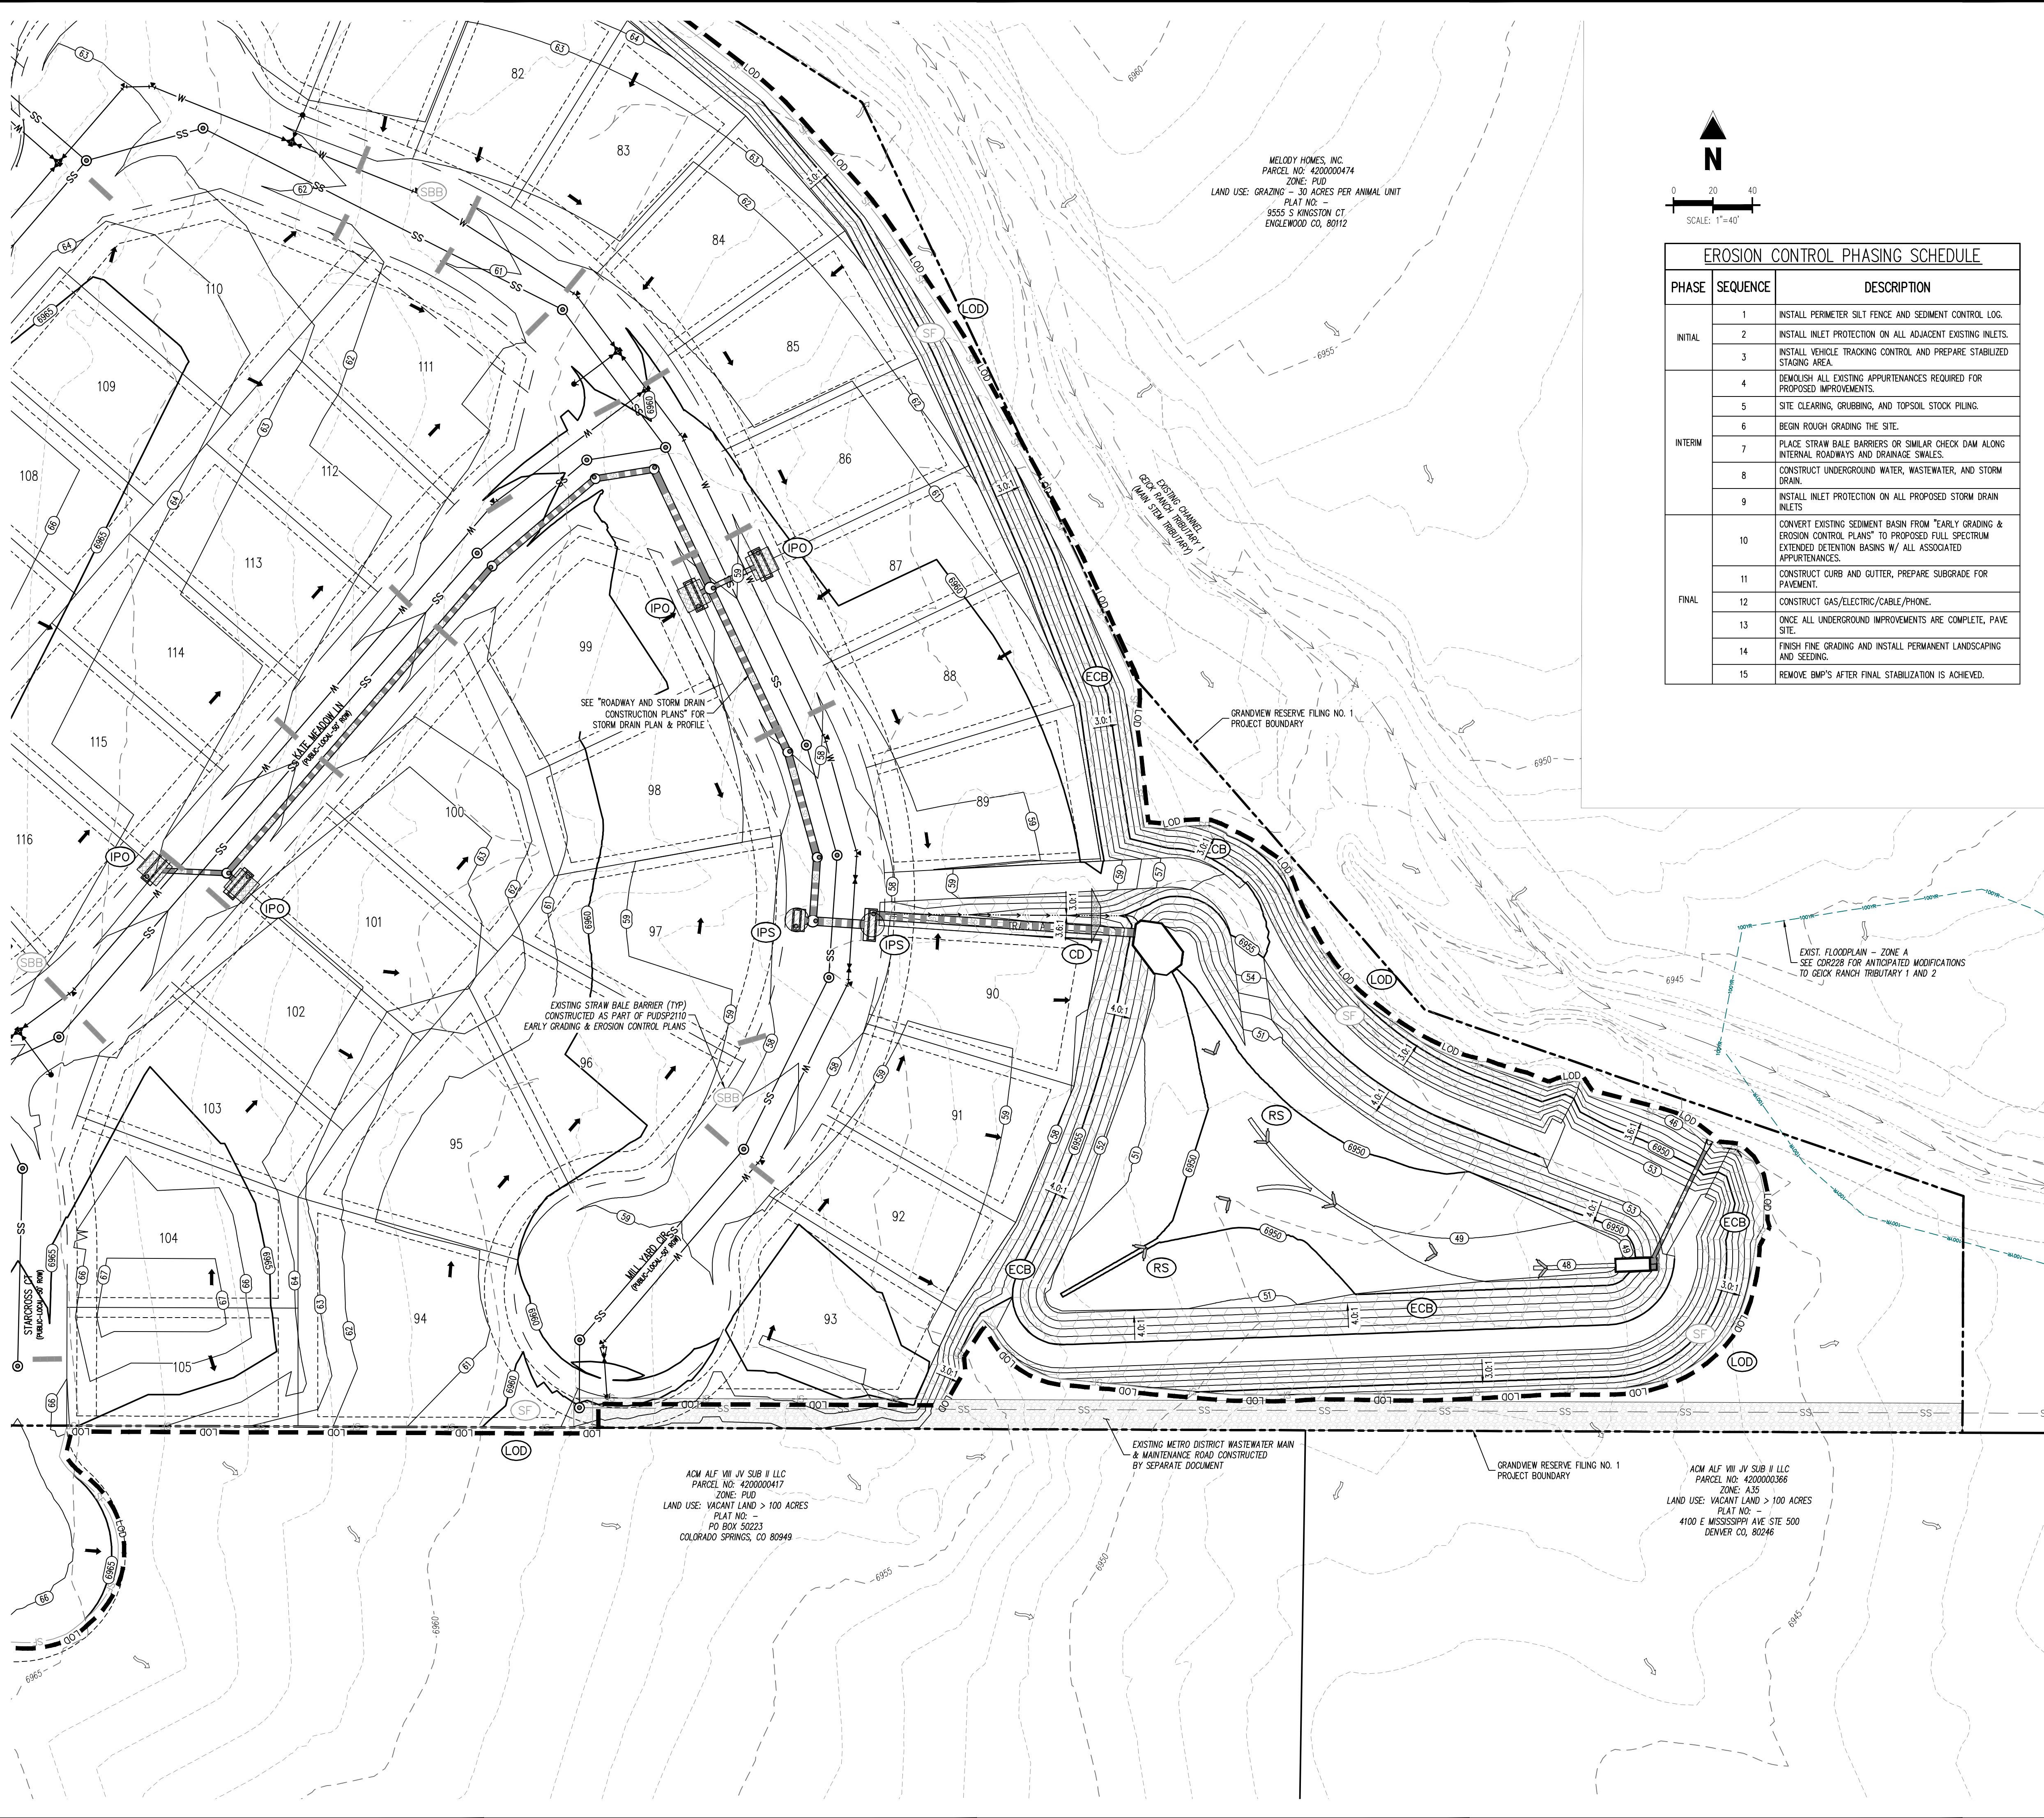

PHASE	SEQUENCE	DESCRIPTION
INITIAL	1	INSTALL PERIMETER SILT FENCE AND SEDIMENT CONTROL LOG.
	2	INSTALL INLET PROTECTION ON ALL ADJACENT EXISTING INLETS.
	3	INSTALL VEHICLE TRACKING CONTROL AND PREPARE STABILIZED STAGING AREA.
INTERIM	4	DEMOLISH ALL EXISTING APPURTENANCES REQUIRED FOR PROPOSED IMPROVEMENTS.
	5	SITE CLEARING, GRUBBING, AND TOPSOIL STOCK PILING.
	6	BEGIN ROUGH GRADING THE SITE.
	7	PLACE STRAW BALE BARRIERS OR SIMILAR CHECK DAM ALONG INTERNAL ROADWAYS AND DRAINAGE SWALES.
	8	CONSTRUCT UNDERGROUND WATER, WASTEWATER, AND STORM DRAIN.
	9	INSTALL INLET PROTECTION ON ALL PROPOSED STORM DRAIN INLETS.
FINAL	10	CONVERT EXISTING SEDIMENT BASIN FROM "EARLY GRADING & EROSION CONTROL PLANS" TO PROPOSED FULL SPECTRUM EXTENDED DETENTION BASIN W/ ALL ASSOCIATED APPURTENANCES.
	11	CONSTRUCT CURB AND GUTTER, PREPARE SUBGRADE FOR PAVEMENT.
	12	CONSTRUCT GAS/ELECTRIC/CABLE/PHONE.
	13	ONCE ALL UNDERGROUND IMPROVEMENTS ARE COMPLETE, PAVE SITE.
	14	FINISH FINE GRADING AND INSTALL PERMANENT LANDSCAPING AND SEEDING.
	15	REMOVE BMP'S AFTER FINAL STABILIZATION IS ACHIEVED.

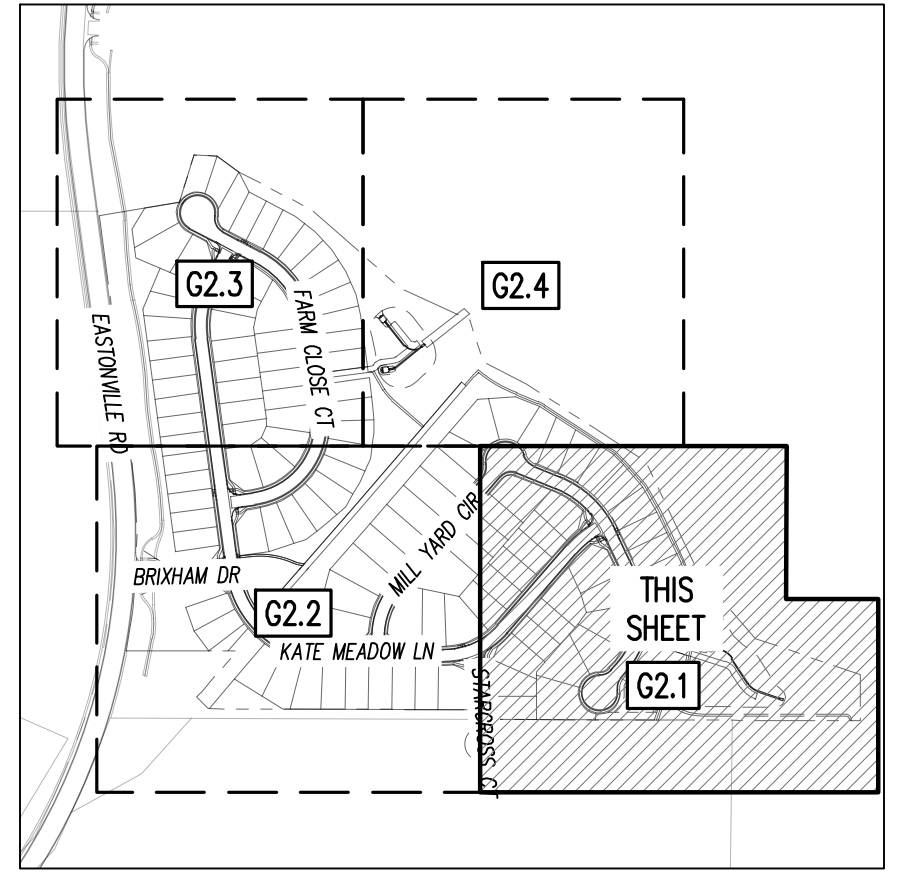

KEYMAP
SCALE: 1"=500'

-5460-	EXISTING MAJOR CONTOUR
-52-	EXISTING MINOR CONTOUR
-CB5-	PROPOSED MAJOR CONTOUR
-CB-	PROPOSED MINOR CONTOUR
-SS-	EXISTING STORM SEWER
-SS-	PROPOSED STORM SEWER
-SS-	EXISTING SANITARY SEWER
-SS-	PROPOSED SANITARY SEWER
-W-	EXISTING WATER LINE
-W-	PROPOSED WATER LINE
-G-	EXISTING GAS LINE
-G-	PROPOSED GAS LINE
-S-	EXISTING SWALE LINE
-S-	PROPOSED SWALE LINE
-S-	EXISTING SWALE LINE
-FLOO-	FLOODPLAIN BOUNDARY
-FLOO-	EXISTING FLOOD ZONE
-FLOO-	EXISTING FLOOD ZONE SETBACK
-FLOO-	FLOW ARROW
-FLOO-	PROPOSED GRAVEL PER EOM TABLE D-7
-LS-	PERMANENT LANDSCAPING
-DD-	DIVERSION DITCH
-LOD-	LOD LIMITS OF DISTURBANCE/CONSTRUCTION
-VTC-	VEHICLE TRACKING CONTROL
-CWA-	CONCRETE WASHOUT AREA
-SSA-	STABILIZED STAGING AREA
-SM-	SEED AND MULCH
-SCL-	SEDIMENT CONTROL LOG
-IPS-	SUMP INLET PROTECTION (P-3)
-IPD-	ON-GRADE INLET PROTECTION (P-4)
-RS-	ROCK SOCKS
-SF-	SILT FENCE
-CF-	CONSTRUCTION FENCE
-SB-	SEDIMENT BASIN
-CD-	CHECK DAM
-ECB-	COMPOST BLANKET (APPROXIMATE)
-RR-	RIPRAP OUTFALL PADS
-PT-	PORTABLE TOILET
-SITE-	SITE POSTING (CONTACTS AND PERMITS)
-WP-	WASHOUT POSTING
-SBB-	STRAW BALE BARRIER
-XX-	EROSION MEASURE INSTALLED IN EARLIER PHASE
-XX-	PROPOSED EROSION MEASURE

Galloway
1155 Kelly Johnson Blvd., Suite 305
Colorado Springs, CO 80920
719.900.7220
GallowayUS.com

DRHORTON
America's Builder

GRADING & EROSION CONTROL PLANS
GRANDVIEW RESERVE FILING NO. 1
MELODY HOMES, INC.
SF2311
EASTONVILLE RD & REX RD
EL PASO COUNTY, FALCON, CO 80831




#	Date	Issue / Description	Init.

BASIS OF BEARING
THE NORTH LINE OF SECTION 28, TOWNSHIP 12 SOUTH, RANGE 64 WEST OF THE 6TH PRINCIPAL MERIDIAN, EL PASO COUNTY, STATE OF COLORADO BEING MONUMENTED AT EACH END BY A 3/4" ALUMINUM SURVEYORS CAP STAMPED "PSINC LS 30087" AND ASSUMED TO BEAR S89°47'04"E, A DISTANCE OF 5285.07 FEET.

BENCHMARK
NOS BENCHMARK F 24
A STANDARD DISK, STAMPED F 24 1929 AND SET IN THE TOP OF A CONCRETE POST PROJECTING ABOUT 6 INCHES ABOVE GROUND, ALONG THE CHICAGO, ROCK ISLAND AND PACIFIC RAILROAD, 52 FEET NORTHWEST OF THE CENTERLINE OF U.S. HIGHWAY 24, 48 FEET SOUTHWEST OF THE CENTERLINE OF THE TRACK.
NAVD88 ELEVATION = 6866.33

CAUTION - NOTICE TO CONTRACTOR
1. ALL UTILITY LOCATIONS SHOWN ARE BASED ON MAPS PROVIDED BY THE APPROPRIATE UTILITY COMPANY AND FIELD SURFACE EVIDENCE AT THE TIME OF SURVEY AND IS TO BE CONSIDERED AN APPROXIMATE LOCATION ONLY. IT IS THE CONTRACTOR'S RESPONSIBILITY TO FIELD VERIFY THE LOCATION OF ALL UTILITIES, PUBLIC OR PRIVATE, WHETHER SHOWN ON THE PLANS OR NOT, PRIOR TO CONSTRUCTION. REPORT ANY DISCREPANCIES TO THE ENGINEER PRIOR TO CONSTRUCTION.

2. WHERE A PROPOSED UTILITY CROSSES AN EXISTING UTILITY, IT IS THE CONTRACTOR'S RESPONSIBILITY TO FIELD VERIFY THE HORIZONTAL AND VERTICAL LOCATION OF SUCH EXISTING UTILITY, EITHER THROUGH POT-Holing OR ALTERNATIVE METHOD. REPORT INFORMATION TO THE ENGINEER PRIOR TO CONSTRUCTION.

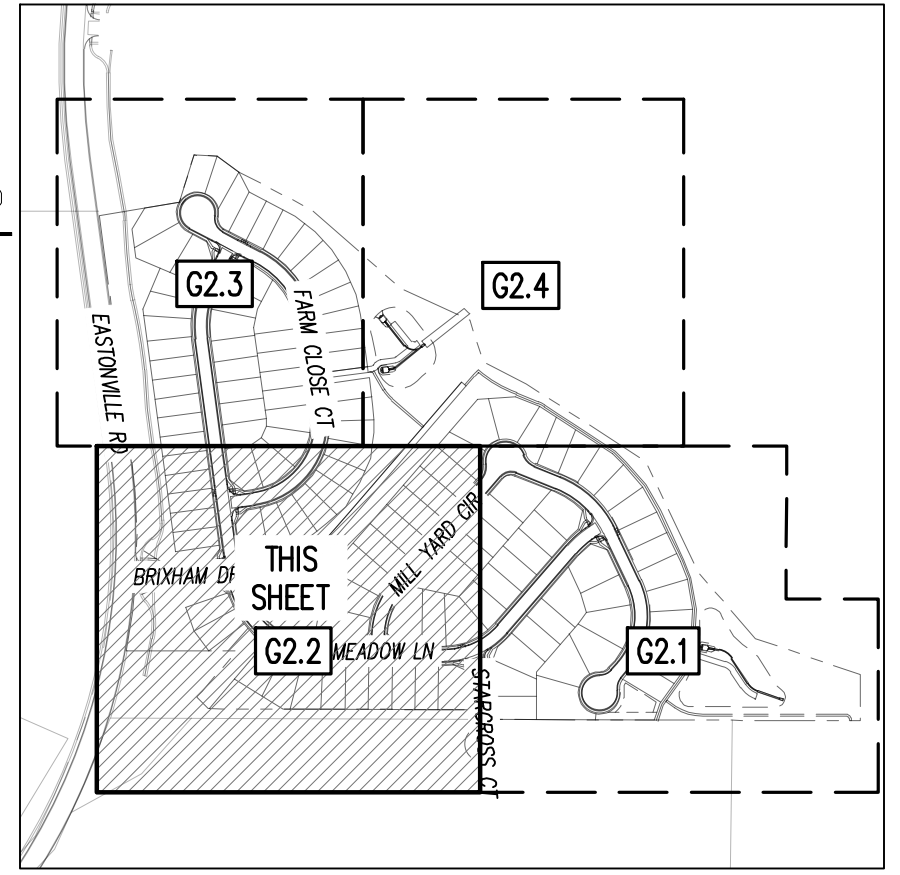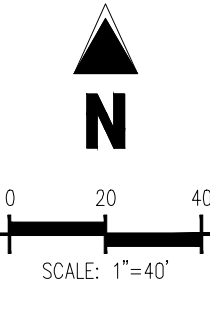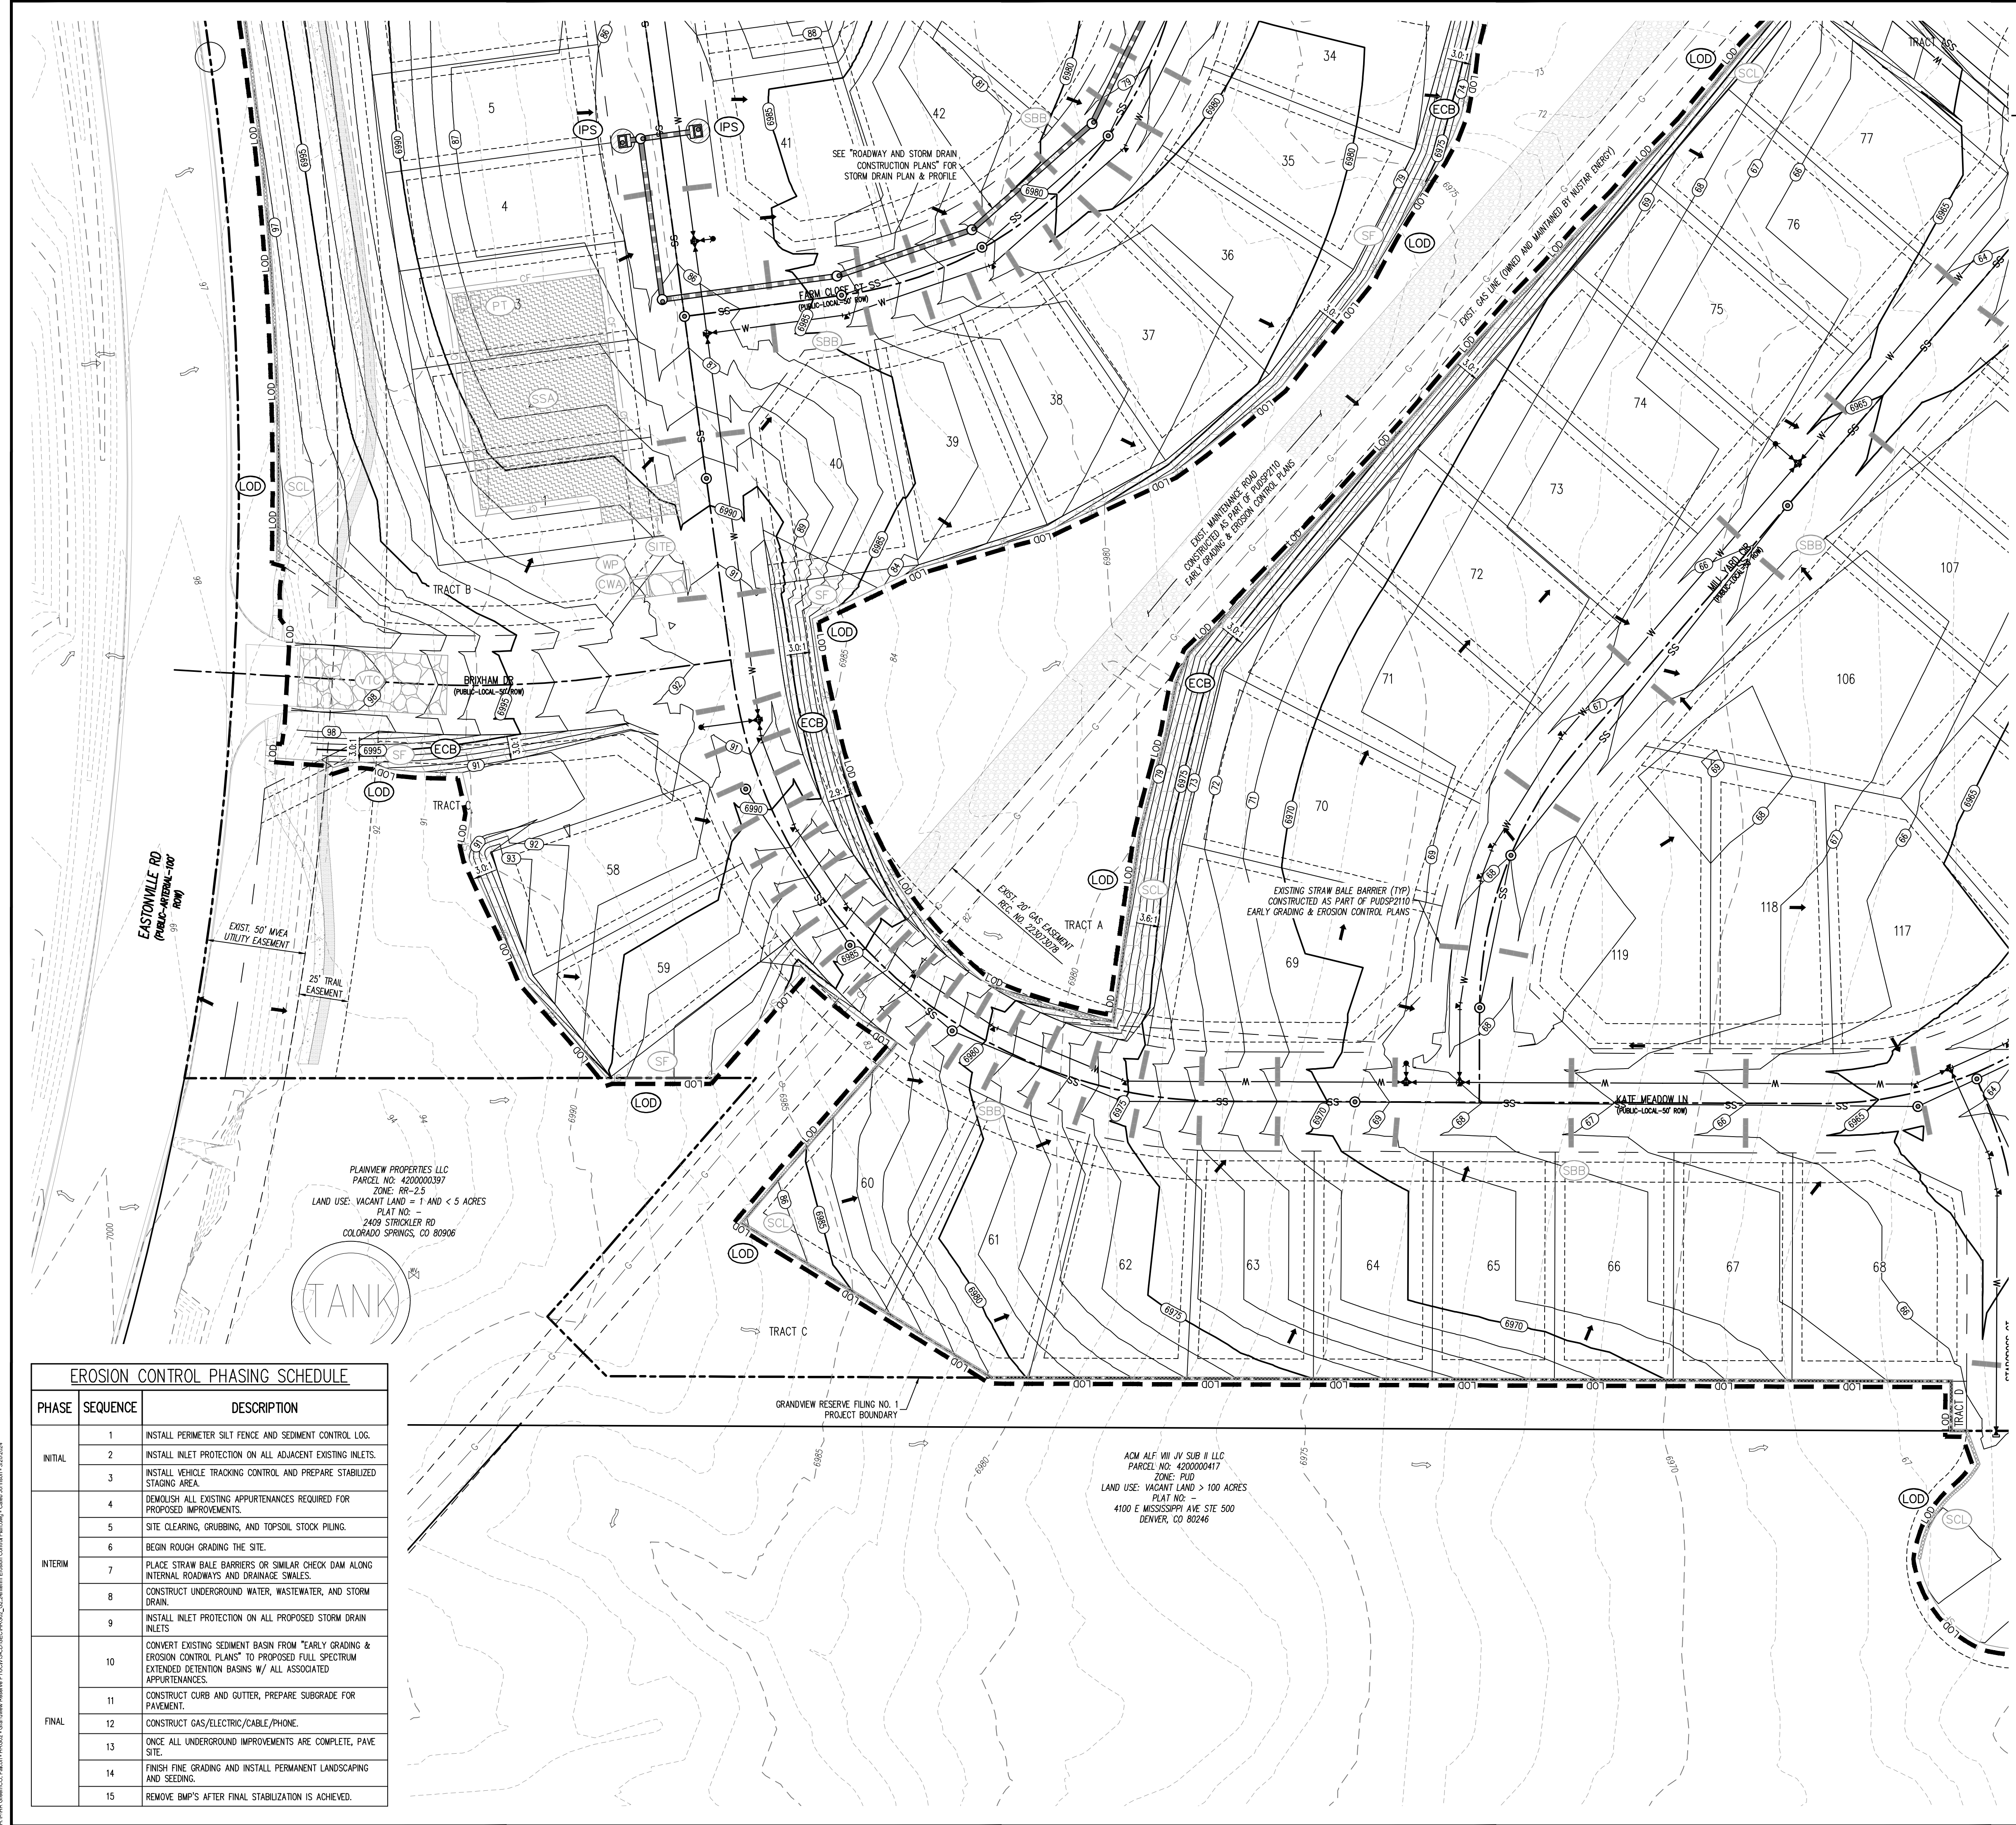

KEYMAP
SCALE: 1"=500'

EROSION CONTROL LEGEND

- 5460 — EXISTING MAJOR CONTOUR
- 52 — EXISTING MINOR CONTOUR
- 5465 — PROPOSED MAJOR CONTOUR
- 56 — PROPOSED MINOR CONTOUR
- — EXISTING STORM SEWER
- — PROPOSED STORM SEWER
- SS — EXISTING SANITARY SEWER
- — PROPOSED SANITARY SEWER
- W — PROPOSED WATER LINE
- G — EXISTING GAS LINE
- — PROPOSED RIDGE LINE
- — PROPOSED SWALE LINE
- — EXISTING SWALE LINE
- — FLOODPLAIN BOUNDARY
- — EXISTING FLOOD ZONE
- — EXISTING FLOOD ZONE SETBACK
- FLOW ARROW
- PROPOSED GRAVEL PER EGM TABLE D-7
- (LS) PERMANENT LANDSCAPING
- (DD) DIVERSION DITCH
- LOD — LOD LIMITS OF DISTURBANCE/CONSTRUCTION
- (VTC) VEHICLE TRACKING CONTROL
- (CWA) CONCRETE WASHOUT AREA
- (SSA) STABILIZED STAGING AREA
- (SM) SEED AND MULCH
- (SCL) SEDIMENT CONTROL LOG
- (IPS) SUMP INLET PROTECTION (P-3)
- (IPD) ON-GRADE INLET PROTECTION (P-4)
- (RS) ROCK SOCKS
- (SF) SILT FENCE
- (CF) CONSTRUCTION FENCE
- (SB) SEDIMENT BASIN
- (CD) CHECK DAM
- (ECB) COMPOST BLANKET (APPROXIMATE)
- (RR) RIPRAP OUTFALL PADS
- (PT) PORTABLE TOILET
- (SITE) SITE POSTING (CONTACTS AND PERMITS)
- (WP) WASHOUT POSTING
- (SBB) STRAW BALE BARRIER
- (XX) EROSION MEASURE INSTALLED IN EARLIER PHASE
- (XX) PROPOSED EROSION MEASURE

PLAINVIEW PROPERTIES LLC
PARCEL NO. 420000397
ZONE: RR-2.5
LAND USE: VACANT LAND > 1 AND < 5 ACRES
PLAT NO. 2409 STROCKLER RD
COLORADO SPRINGS, CO 80906

ADM ALF VII JV SUB II LLC
PARCEL NO. 420000417
ZONE: PUD
LAND USE: VACANT LAND > 100 ACRES
PLAT NO. 4100 MISSISSIPPI AVE SITE 500
DENVER, CO 80246

EROSION CONTROL PHASING SCHEDULE		
PHASE	SEQUENCE	DESCRIPTION
INITIAL	1	INSTALL PERMETER SILT FENCE AND SEDIMENT CONTROL LOG.
	2	INSTALL INLET PROTECTION ON ALL ADJACENT EXISTING INLETS.
	3	INSTALL VEHICLE TRACKING CONTROL AND PREPARE STABILIZED STAGING AREA.
	4	DEMOLISH ALL EXISTING APPURTENANCES REQUIRED FOR PROPOSED IMPROVEMENTS.
INTERIM	5	SITE CLEARING, GRUBBING, AND TOPSOIL STOCK PILING.
	6	BEGIN ROUGH GRADING THE SITE.
	7	PLACE STRAW BALE BARRIERS OR SIMILAR CHECK DAM ALONG INTERNAL ROADWAYS AND DRAINAGE SWALES.
	8	CONSTRUCT UNDERGROUND WATER, WASTEWATER, AND STORM DRAIN.
	9	INSTALL INLET PROTECTION ON ALL PROPOSED STORM DRAIN INLETS.
FINAL	10	CONVERT EXISTING SEDIMENT BASIN FROM "EARLY GRADING & EROSION CONTROL PLANS" TO PROPOSED FULL SPECTRUM EXTENDED DETENTION BASINS W/ ALL ASSOCIATED APPURTENANCES.
	11	CONSTRUCT CURB AND GUTTER, PREPARE SUBGRADE FOR PAVEMENT.
	12	CONSTRUCT GAS/ELECTRIC/CABLE/PHONE.
	13	ONCE ALL UNDERGROUND IMPROVEMENTS ARE COMPLETE, PAVE SITE.
	14	FINISH FINE GRADING AND INSTALL PERMANENT LANDSCAPING AND SEEDING.
	15	REMOVE BMP'S AFTER FINAL STABILIZATION IS ACHIEVED.

BASIS OF BEARING
THE NORTH LINE OF SECTION 28, TOWNSHIP 12 SOUTH, RANGE 64 WEST OF THE 6TH PRINCIPAL MERIDIAN, EL PASO COUNTY, STATE OF COLORADO BEING MONUMENTED AT EACH END BY A 3/4" ALUMINUM SURVEYORS CAP STAMPED "PSINC LS 30087" AND ASSUMED TO BEAR S89°47'04"E, A DISTANCE OF 5285.07 FEET.

BENCHMARK
NOS BENCHMARK F 24
A STANDARD DISK, STAMPED F 24 1929 AND SET IN THE TOP OF A CONCRETE POST PROJECTING ABOUT 6 INCHES ABOVE GROUND, ALONG THE CHICAGO, ROCK ISLAND AND PACIFIC RAILROAD, 52 FEET NORTHWEST OF THE CENTERLINE OF U.S. HIGHWAY 24, 48 FEET SOUTHEAST OF THE CENTERLINE OF THE TRACK.
NAVD88 ELEVATION = 6866.33



CAUTION - NOTICE TO CONTRACTOR
1. ALL UTILITY LOCATIONS SHOWN ARE BASED ON MAPS PROVIDED BY THE APPROPRIATE UTILITY COMPANY AND FIELD SURFACE EVIDENCE AT THE TIME OF SURVEY AND IS TO BE CONSIDERED AN APPROXIMATE LOCATION ONLY. IT IS THE CONTRACTOR'S RESPONSIBILITY TO FIELD VERIFY THE LOCATION OF ALL UTILITIES, PUBLIC OR PRIVATE, WHETHER SHOWN ON THE PLANS OR NOT, PRIOR TO CONSTRUCTION. REPORT ANY DISCREPANCIES TO THE ENGINEER PRIOR TO CONSTRUCTION.
2. WHERE A PROPOSED UTILITY CROSSES AN EXISTING UTILITY, IT IS THE CONTRACTOR'S RESPONSIBILITY TO FIELD VERIFY THE HORIZONTAL AND VERTICAL LOCATION OF SUCH EXISTING UTILITY, EITHER THROUGH POT-HOLING OR AN ALTERNATIVE METHOD. REPORT INFORMATION TO THE ENGINEER PRIOR TO CONSTRUCTION.




#	Date	Issue / Description	Init.

Project No: HRG02
Drawn By: JDM, BLB
Checked By: BAS, CMWJ
Date: 03/15/2024

INTERIM EROSION CONTROL PLAN

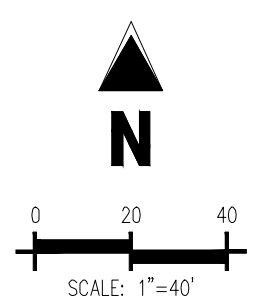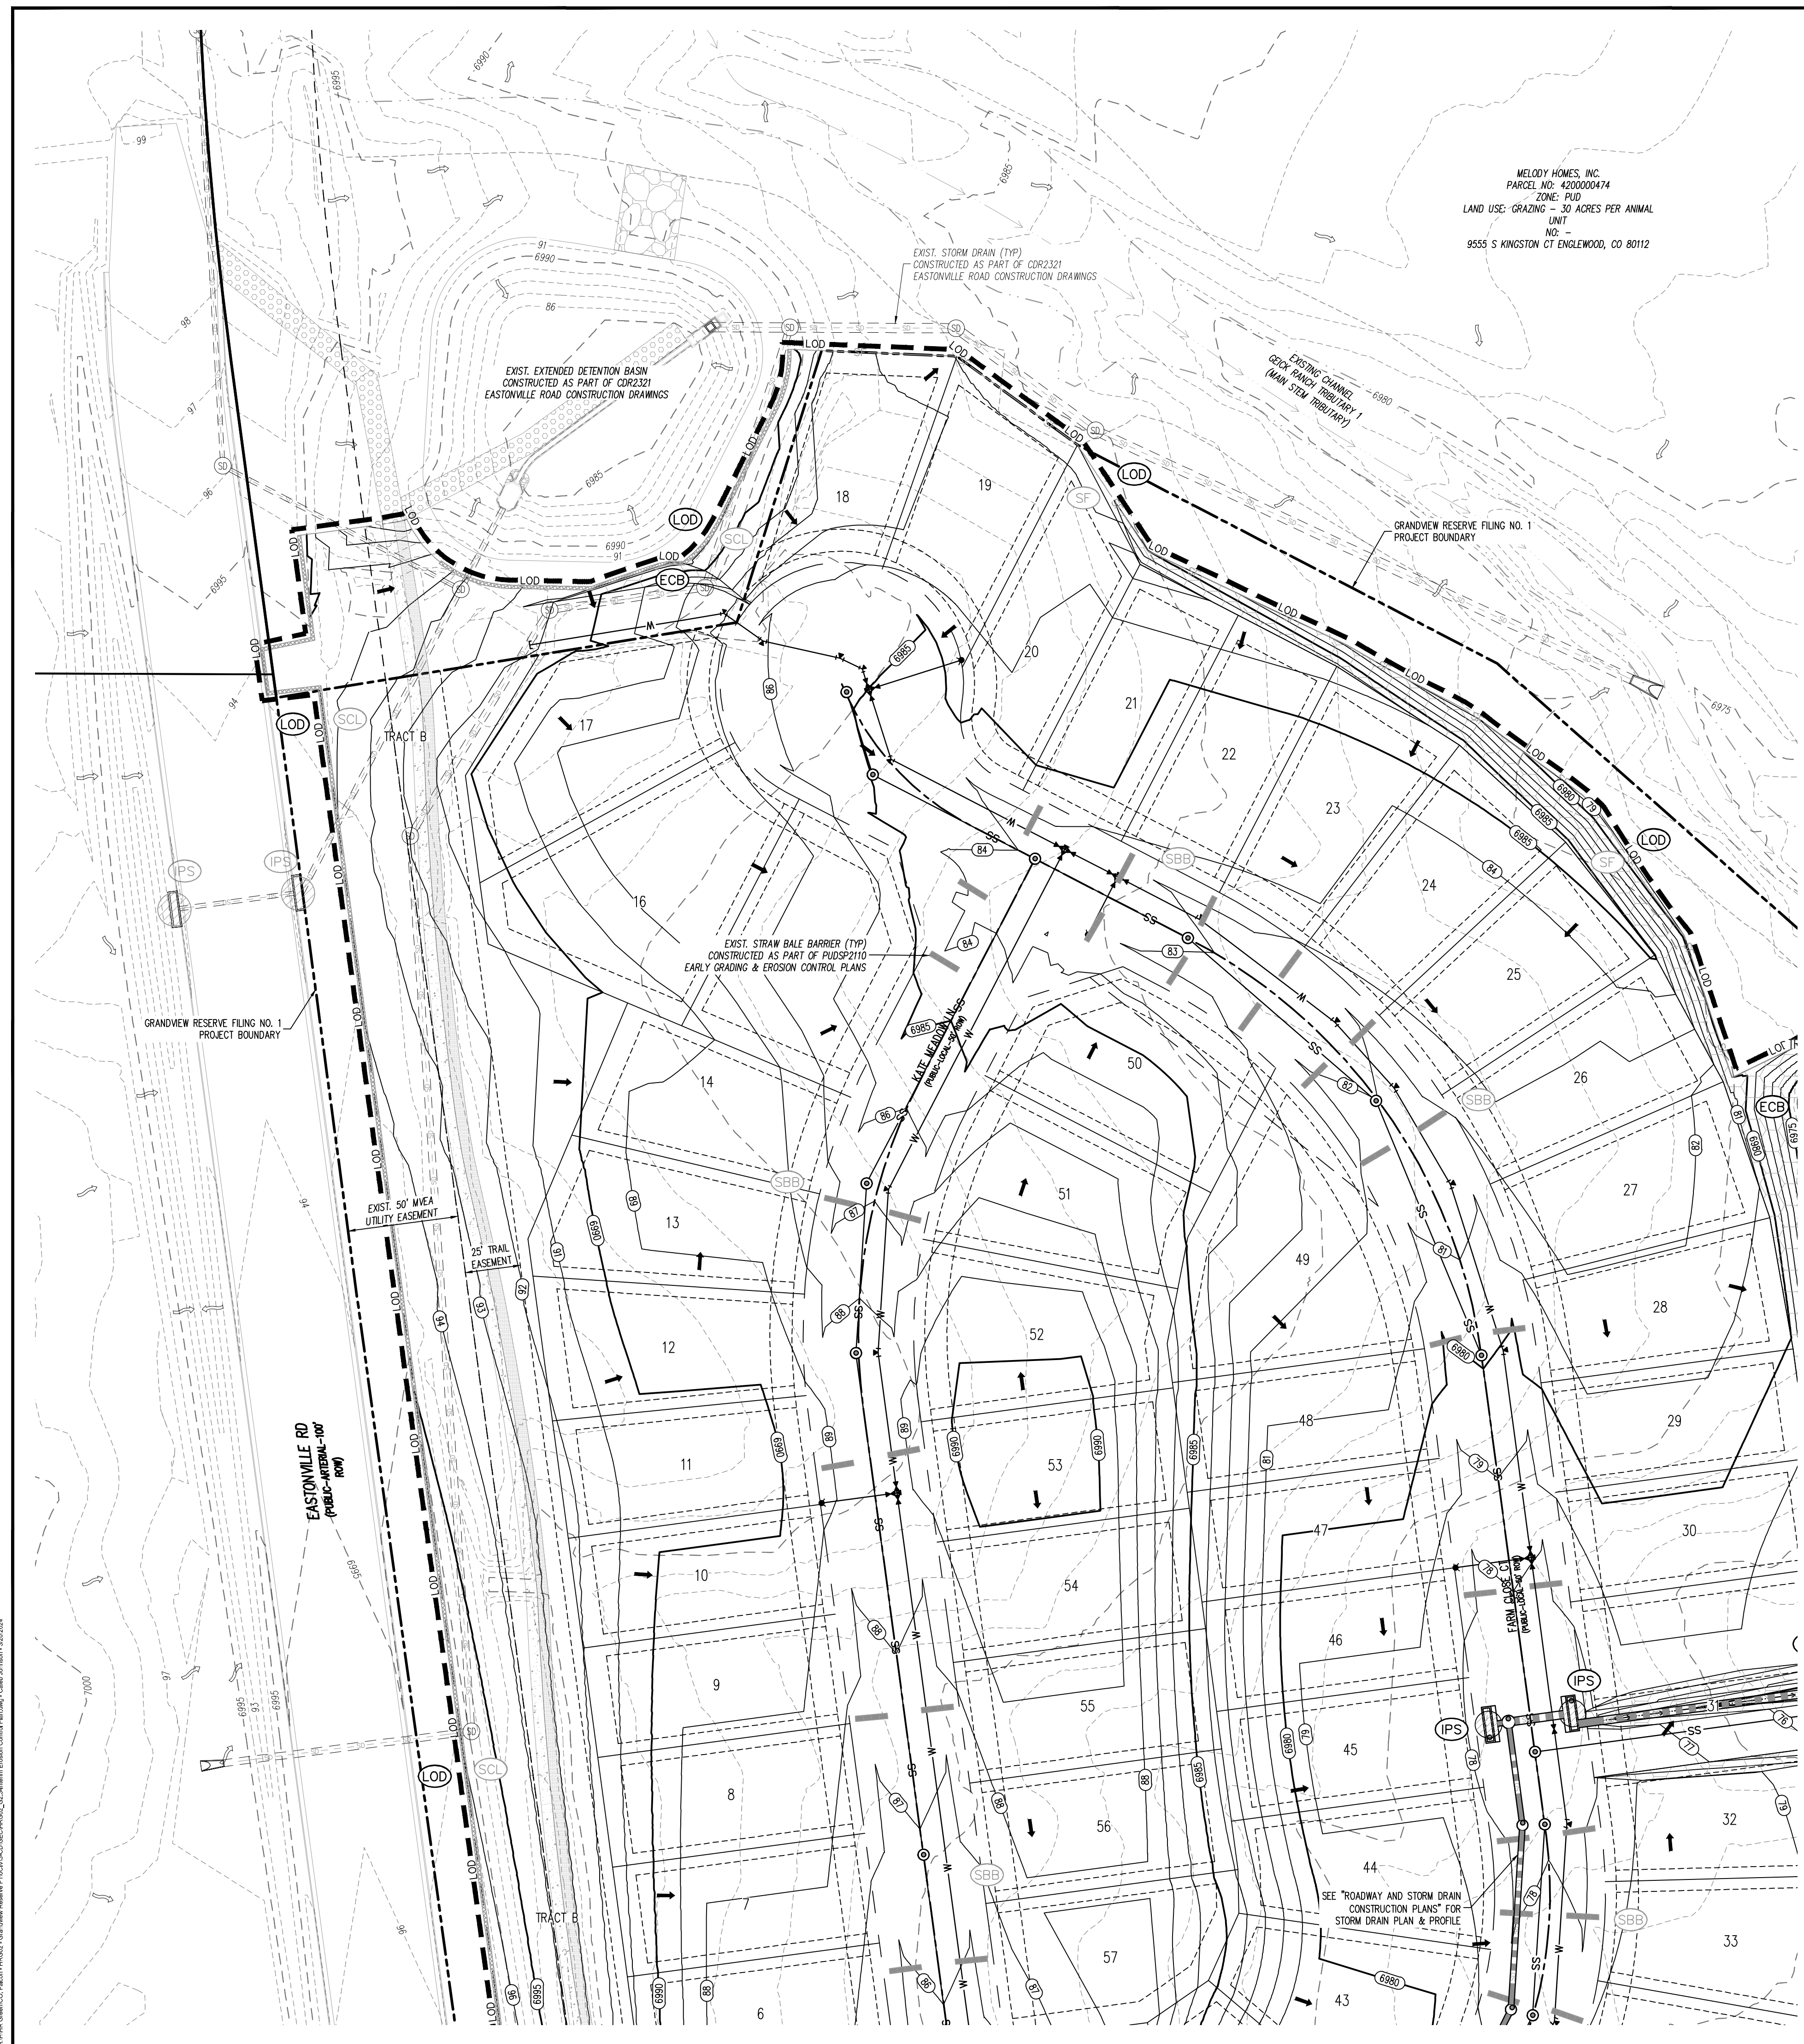


MELODY HOMES, INC.
 PARCEL NO: 420000474
 ZONE: PUD
 LAND USE: GRAZING - 30 ACRES PER ANIMAL
 UNIT
 NO. -
 9555 S KINGSTON CT ENGLEWOOD, CO 80112

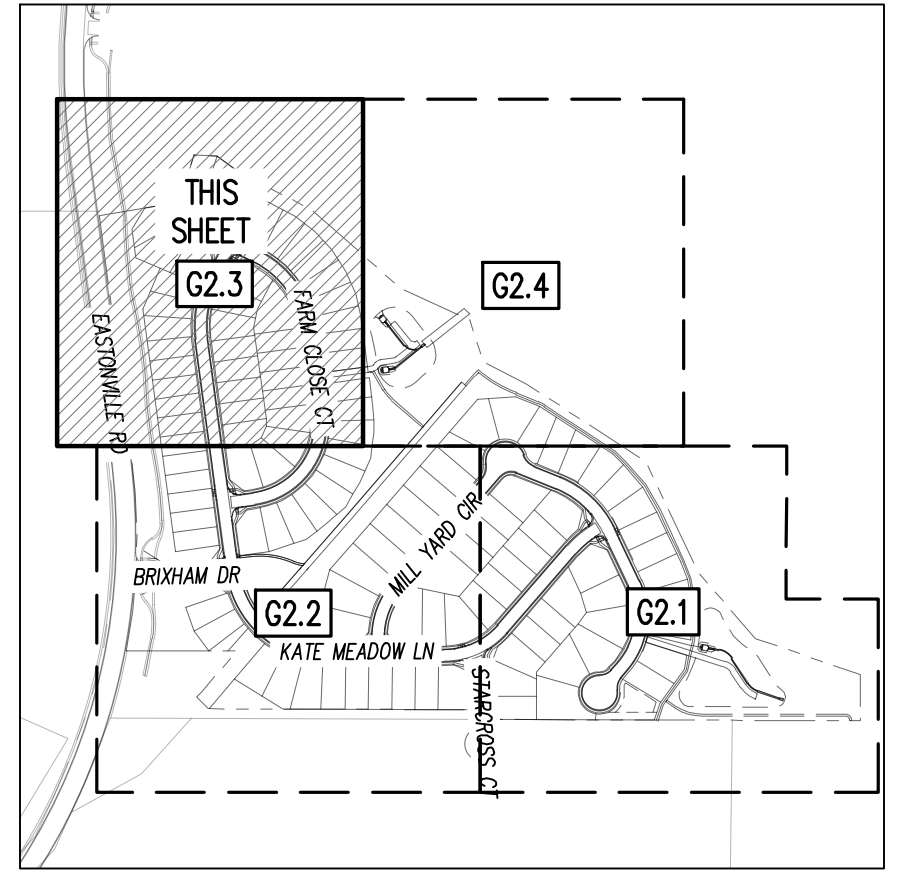

KEYMAP
SCALE: 1"=500'

EROSION CONTROL LEGEND

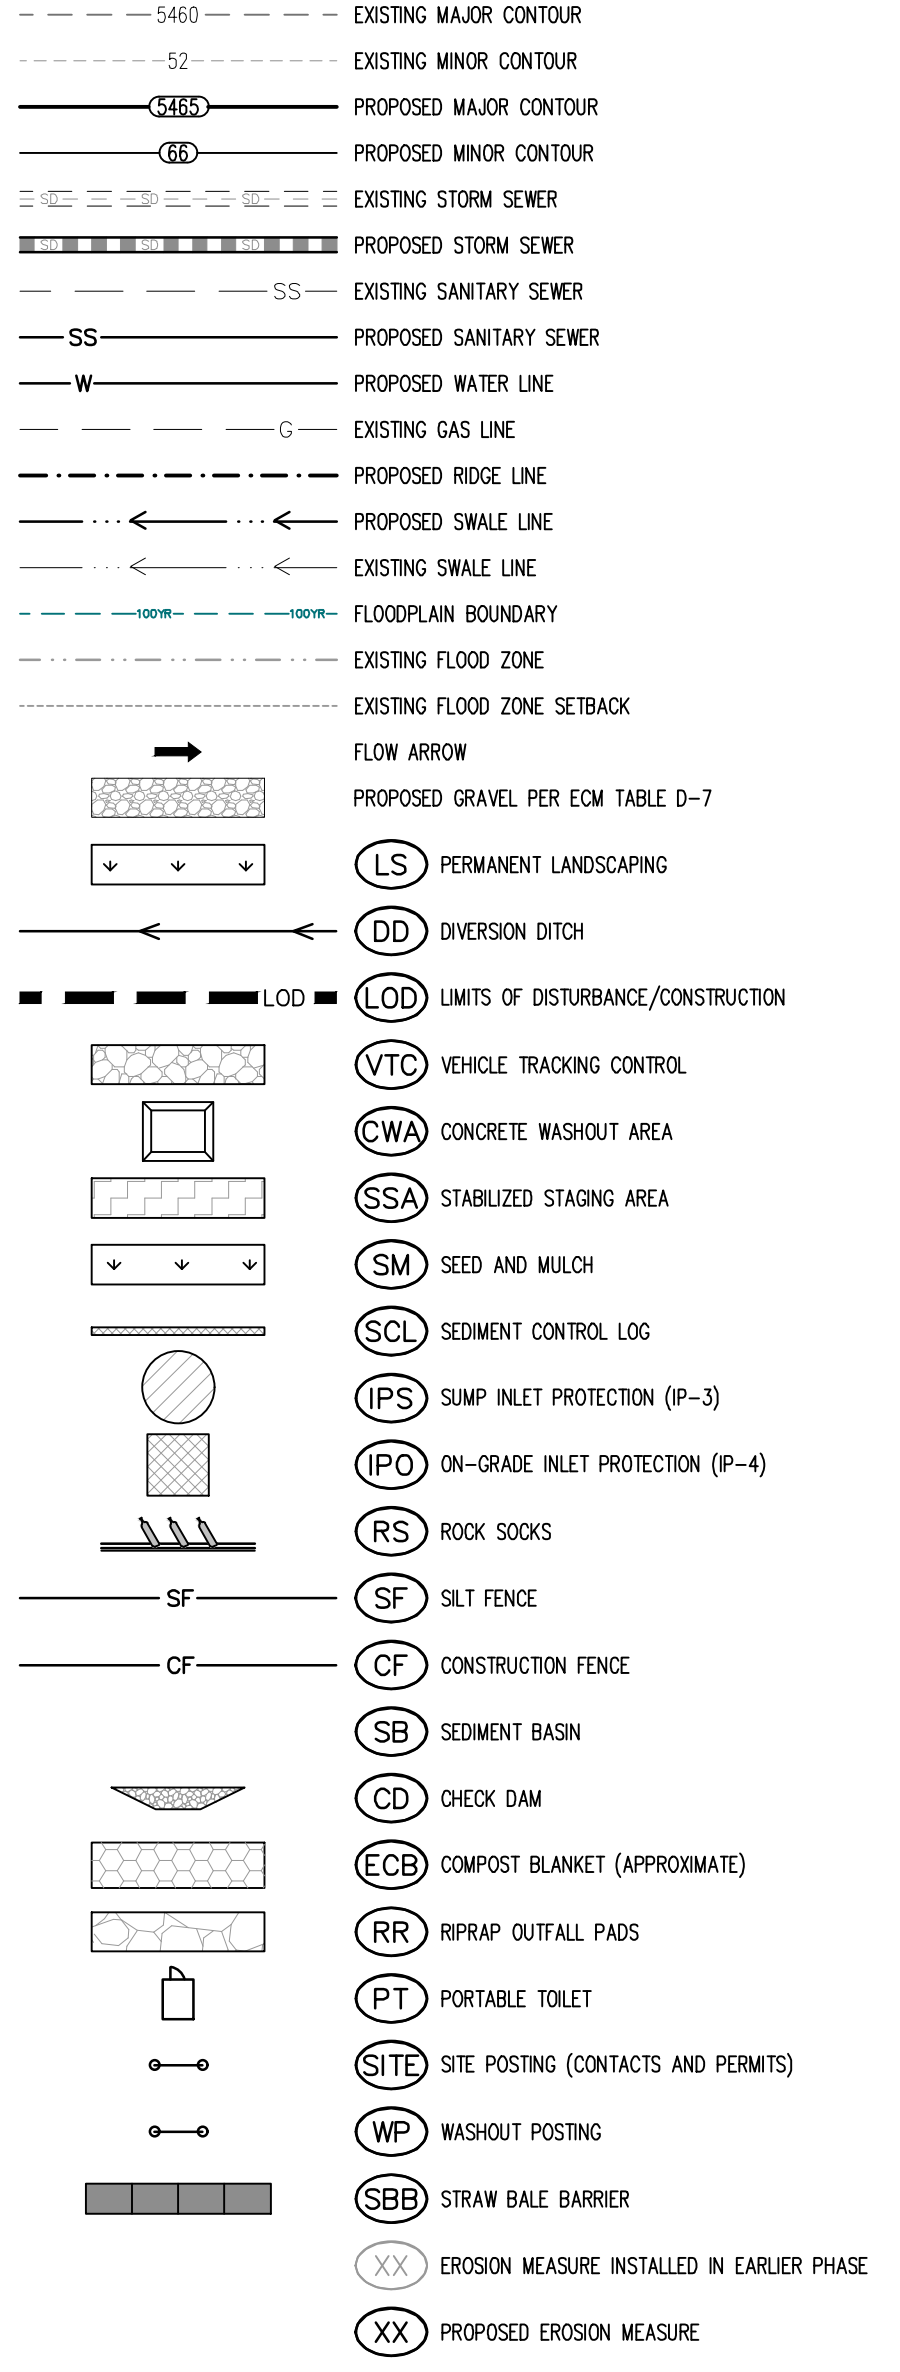

EROSION CONTROL PHASING SCHEDULE		
PHASE	SEQUENCE	DESCRIPTION
INITIAL	1	INSTALL PERIMETER SILT FENCE AND SEDIMENT CONTROL LOG.
	2	INSTALL INLET PROTECTION ON ALL ADJACENT EXISTING INLETS.
	3	INSTALL VEHICLE TRACKING CONTROL AND PREPARE STABILIZED STAGING AREA.
INTERM	4	DEMOLISH ALL EXISTING APPURTENANCES REQUIRED FOR PROPOSED IMPROVEMENTS.
	5	SITE CLEARING, GRUBBING, AND TOPSOIL STOCK PILING.
	6	BEGIN ROUGH GRADING THE SITE.
	7	PLACE STRAW BAILE BARRIERS OR SIMILAR CHECK DAM ALONG INTERNAL ROADWAYS AND DRAINAGE SWALES.
	8	CONSTRUCT UNDERGROUND WATER, WASTEWATER, AND STORM DRAIN.
	9	INSTALL INLET PROTECTION ON ALL PROPOSED STORM DRAIN INLETS.
FINAL	10	CONVERT EXISTING SEDIMENT BASIN FROM "EARLY GRADING & EROSION CONTROL PLANS" TO PROPOSED FULL SPECTRUM EXTENDED DETENTION BASINS W/ ALL ASSOCIATED APPURTENANCES.
	11	CONSTRUCT CURB AND GUTTER, PREPARE SUBGRADE FOR PAVEMENT.
	12	CONSTRUCT GAS/ELECTRIC/CABLE/PHONE.
	13	ONCE ALL UNDERGROUND IMPROVEMENTS ARE COMPLETE, PAVE SITE.
	14	FINISH FINE GRADING AND INSTALL PERMANENT LANDSCAPING AND SEEDING.
	15	REMOVE BMP'S AFTER FINAL STABILIZATION IS ACHIEVED.

BASIS OF BEARING

THE NORTH LINE OF SECTION 28, TOWNSHIP 12 SOUTH, RANGE 64 WEST OF THE 6TH PRINCIPAL MERIDIAN, EL PASO COUNTY, STATE OF COLORADO BEING MONUMENTED AT EACH END BY A 3-3/4" ALUMINUM SURVEYORS CAP STAMPED "PSINC LS 30087" AND ASSUMED TO BEAR S89°47'04"E, A DISTANCE OF 5285.07 FEET.

BENCHMARK

NOS BENCHMARK F 24
 A STANDARD DISK STAMPED F 24 1929 AND SET IN THE TOP OF A CONCRETE POST PROJECTING ABOUT 6 INCHES ABOVE GROUND, ALONG THE CHICAGO, ROCK ISLAND AND PACIFIC RAILROAD, 52 FEET NORTHWEST OF THE CENTERLINE OF U.S. HIGHWAY 24, 48 FEET SOUTHEAST OF THE CENTERLINE OF THE TRACK.
 NAVD83 ELEVATION = 6866.33

CAUTION - NOTICE TO CONTRACTOR

1. ALL UTILITY LOCATIONS SHOWN ARE BASED ON MAPS PROVIDED BY THE APPROPRIATE UTILITY COMPANY AND FIELD SURFACE EVIDENCE AT THE TIME OF SURVEY AND IS TO BE CONSIDERED AN APPROXIMATE LOCATION ONLY. IT IS THE CONTRACTOR'S RESPONSIBILITY TO FIELD VERIFY THE LOCATION OF ALL UTILITIES, PUBLIC OR PRIVATE, WHETHER SHOWN ON THE PLANS OR NOT, PRIOR TO CONSTRUCTION. REPORT ANY DISCREPANCIES TO THE ENGINEER PRIOR TO CONSTRUCTION.

2. WHERE A PROPOSED UTILITY CROSSES AN EXISTING UTILITY, IT IS THE CONTRACTOR'S RESPONSIBILITY TO FIELD VERIFY THE HORIZONTAL AND VERTICAL LOCATION OF SUCH EXISTING UTILITY, EITHER THROUGH DIGGING OR ALTERNATIVE METHOD. REPORT INFORMATION TO THE ENGINEER PRIOR TO CONSTRUCTION.



COPYRIGHT
 THESE PLANS ARE AN INSTRUMENT OF SERVICE AND ARE THE PROPERTY OF GALLOWAY, AND MAY NOT BE DUPLICATED, DISCLOSED, OR REPRODUCED WITHOUT THE WRITTEN CONSENT OF GALLOWAY. COPYRIGHTS AND INFRINGEMENTS WILL BE ENFORCED AND PROSECUTED.





GRADING & EROSION CONTROL PLANS
GRANDVIEW RESERVE FILING NO. 1
MELODY HOMES, INC.
SF2311
EASTONVILLE RD & REX RD
EL PASO COUNTY, FALCON, CO 80831

#	Date	Issue / Description	Init.

Project No: HRC62
 Drawn By: JDM, BLB
 Checked By: BAS, CMWJ
 Date: 03/15/2024


INTERIM EROSION CONTROL PLAN

G2.3
 Sheet 10 of 32

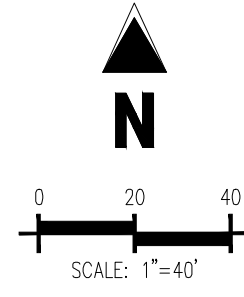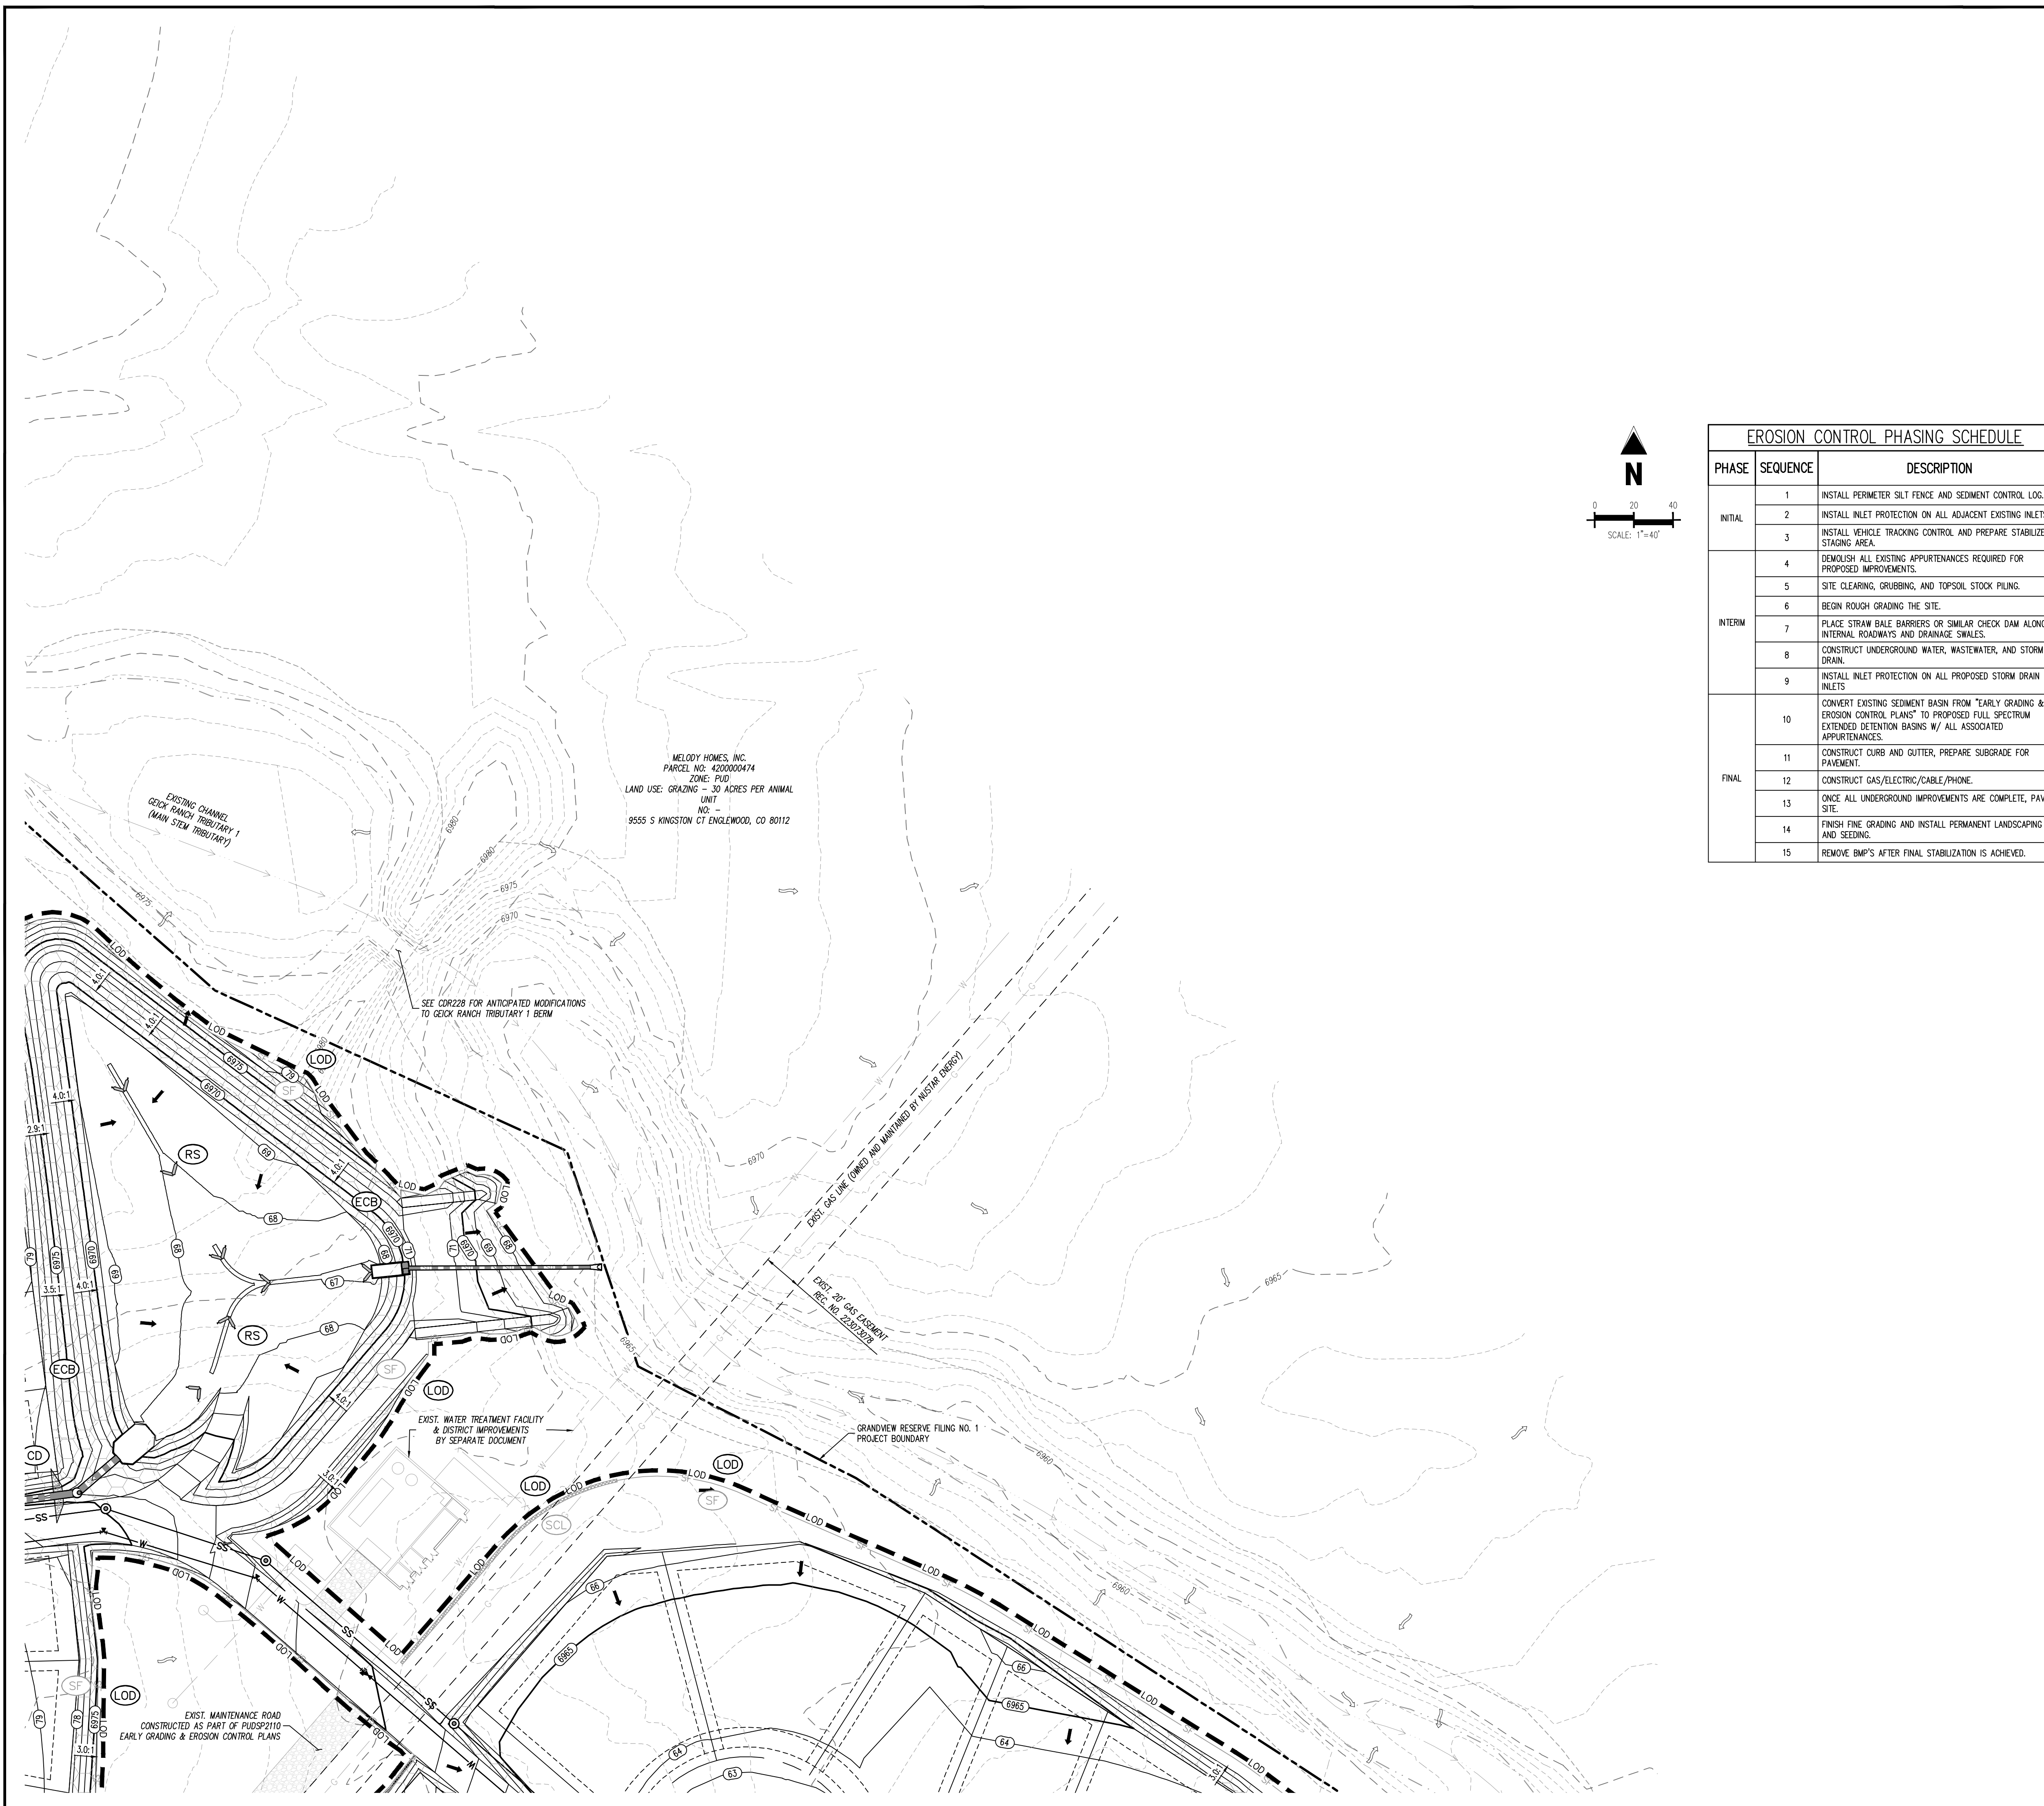

EROSION CONTROL PHASING SCHEDULE

PHASE	SEQUENCE	DESCRIPTION
INITIAL	1	INSTALL PERIMETER SILT FENCE AND SEDIMENT CONTROL LOG.
	2	INSTALL INLET PROTECTION ON ALL ADJACENT EXISTING INLETS.
	3	INSTALL VEHICLE TRACKING CONTROL AND PREPARE STABILIZED STAGING AREA.
INTERM	4	DEMOLISH ALL EXISTING APPURTENANCES REQUIRED FOR PROPOSED IMPROVEMENTS.
	5	SITE CLEARING, GRUBBING, AND TOPSOIL STOCK PILING.
	6	BEGIN ROUGH GRADING THE SITE.
	7	PLACE STRAW BALE BARRIERS OR SIMILAR CHECK DAM ALONG INTERNAL ROADWAYS AND DRAINAGE SWALES.
	8	CONSTRUCT UNDERGROUND WATER, WASTEWATER, AND STORM DRAIN.
	9	INSTALL INLET PROTECTION ON ALL PROPOSED STORM DRAIN INLETS.
FINAL	10	CONVERT EXISTING SEDIMENT BASIN FROM "EARLY GRADING & EROSION CONTROL PLANS" TO PROPOSED FULL SPECTRUM EXTENDED DETENTION BASIN W/ ALL ASSOCIATED APPURTENANCES.
	11	CONSTRUCT CURB AND GUTTER, PREPARE SUBGRADE FOR PAVEMENT.
	12	CONSTRUCT GAS/ELECTRIC/CABLE/PHONE.
	13	ONCE ALL UNDERGROUND IMPROVEMENTS ARE COMPLETE, PAVE SITE.
	14	FINISH FINE GRADING AND INSTALL PERMANENT LANDSCAPING AND SEEDING.
	15	REMOVE BMP'S AFTER FINAL STABILIZATION IS ACHIEVED.

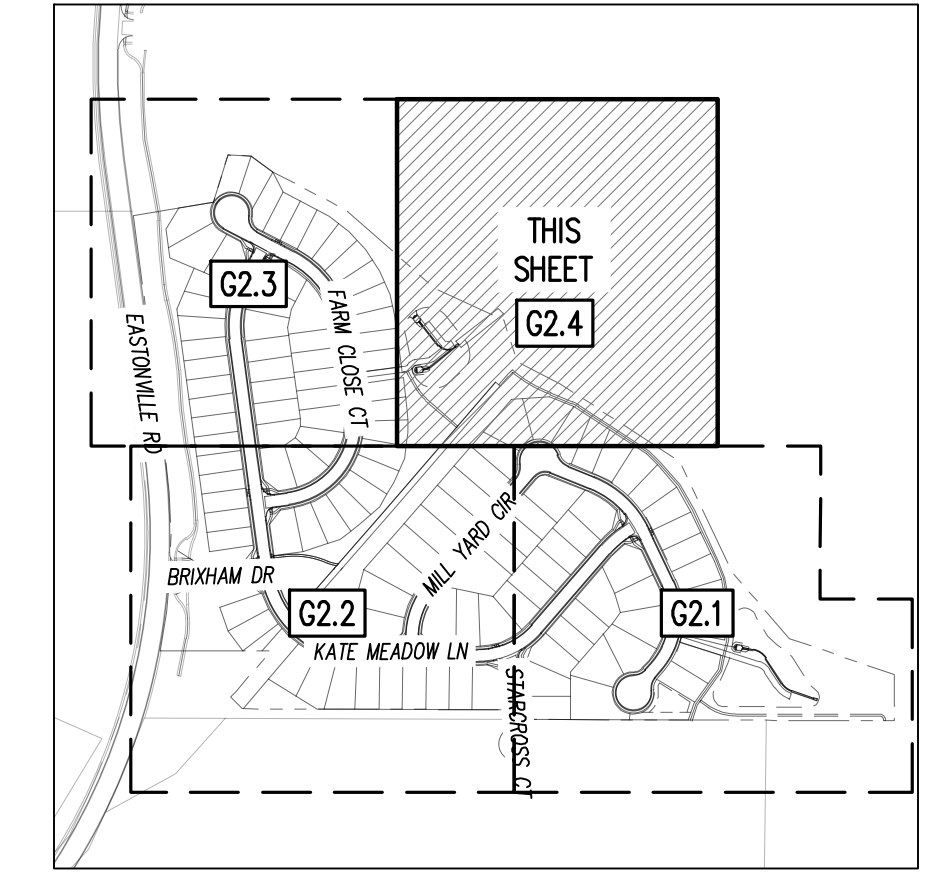

EROSION CONTROL LEGEND

- 5460- EXISTING MAJOR CONTOUR
- 52 EXISTING MINOR CONTOUR
- G2.5- PROPOSED MAJOR CONTOUR
- G2- PROPOSED MINOR CONTOUR
- SS- EXISTING STORM SEWER
- SS- PROPOSED STORM SEWER
- SS- EXISTING SANITARY SEWER
- SS- PROPOSED SANITARY SEWER
- W- PROPOSED WATER LINE
- G- EXISTING GAS LINE
- G- PROPOSED RIDGE LINE
- S- PROPOSED SWALE LINE
- S- EXISTING SWALE LINE
- 1000- FLOODPLAIN BOUNDARY
- 1000- EXISTING FLOOD ZONE
- 1000- EXISTING FLOOD ZONE SETBACK
- >- FLOW ARROW
- >- PROPOSED GRAVEL PER EGM TABLE D-7
- >- (LS) PERMANENT LANDSCAPING
- >- (DD) DIVERSION DITCH
- >- (LOD) LIMITS OF DISTURBANCE/CONSTRUCTION
- >- (VTC) VEHICLE TRACKING CONTROL
- >- (CWA) CONCRETE WASHOUT AREA
- >- (SSA) STABILIZED STAGING AREA
- >- (SM) SEED AND MULCH
- >- (SCL) SEDIMENT CONTROL LOG
- >- (IPS) SUMP INLET PROTECTION (P-3)
- >- (IPD) ON-GRADE INLET PROTECTION (P-4)
- >- (RS) ROCK SOCKS
- >- (SF) SILT FENCE
- >- (CF) CONSTRUCTION FENCE
- >- (SB) SEDIMENT BASIN
- >- (CD) CHECK DAM
- >- (ECB) COMPOST BLANKET (APPROXIMATE)
- >- (RR) RIPRAP OUTFALL PADS
- >- (PT) PORTABLE TOILET
- >- (SITE) SITE POSTING (CONTACTS AND PERMITS)
- >- (WP) WASHOUT POSTING
- >- (SBB) STRAW BALE BARRIER
- >- (XX) EROSION MEASURE INSTALLED IN EARLIER PHASE
- >- (XX) PROPOSED EROSION MEASURE

BASIS OF BEARING
 THE NORTH LINE OF SECTION 28, TOWNSHIP 12 SOUTH, RANGE 64 WEST OF THE 6TH PRINCIPAL MERIDIAN, EL PASO COUNTY, STATE OF COLORADO BEING MONUMENTED AT EACH END BY A 3-1/4" ALUMINUM SURVEYORS CAP STAMPED "PSINC LS 30087" AND ASSUMED TO BEAR S89°47'04"E, A DISTANCE OF 5285.07 FEET.

BENCHMARK
 NOS BENCHMARK F 24
 A STANDARD DISK, STAMPED F 24 1929 AND SET IN THE TOP OF A CONCRETE POST PROJECTING ABOUT 6 INCHES ABOVE GROUND, ALONG THE CHICAGO, ROCK ISLAND AND PACIFIC RAILROAD, 52 FEET NORTHWEST OF THE CENTERLINE OF U.S. HIGHWAY 24, 48 FEET SOUTHWEST OF THE CENTERLINE OF THE TRACK.
 NAVD88 ELEVATION = 6866.33

CAUTION - NOTICE TO CONTRACTOR


- ALL UTILITY LOCATIONS SHOWN ARE BASED ON MAPS PROVIDED BY THE APPROPRIATE UTILITY COMPANY AND FIELD SURFACE EVIDENCE AT THE TIME OF SURVEY AND IS TO BE CONSIDERED AN APPROXIMATE LOCATION ONLY. IT IS THE CONTRACTOR'S RESPONSIBILITY TO FIELD VERIFY THE LOCATION OF ALL UTILITIES, PUBLIC OR PRIVATE, WHETHER SHOWN ON THE PLANS OR NOT, PRIOR TO CONSTRUCTION. REPORT ANY DISCREPANCIES TO THE ENGINEER PRIOR TO CONSTRUCTION.
- WHERE A PROPOSED UTILITY CROSSES AN EXISTING UTILITY, IT IS THE CONTRACTOR'S RESPONSIBILITY TO FIELD VERIFY THE HORIZONTAL AND VERTICAL LOCATION OF SUCH EXISTING UTILITY, EITHER THROUGH POT-HOLING OR ALTERNATIVE METHOD. REPORT INFORMATION TO THE ENGINEER PRIOR TO CONSTRUCTION.




#	Date	Issue / Description	Init.

Project No:	HRG02
Drawn By:	JDM, BLB
Checked By:	BAS, CMWJ
Date:	03/15/2024


INTERIM EROSION CONTROL PLAN

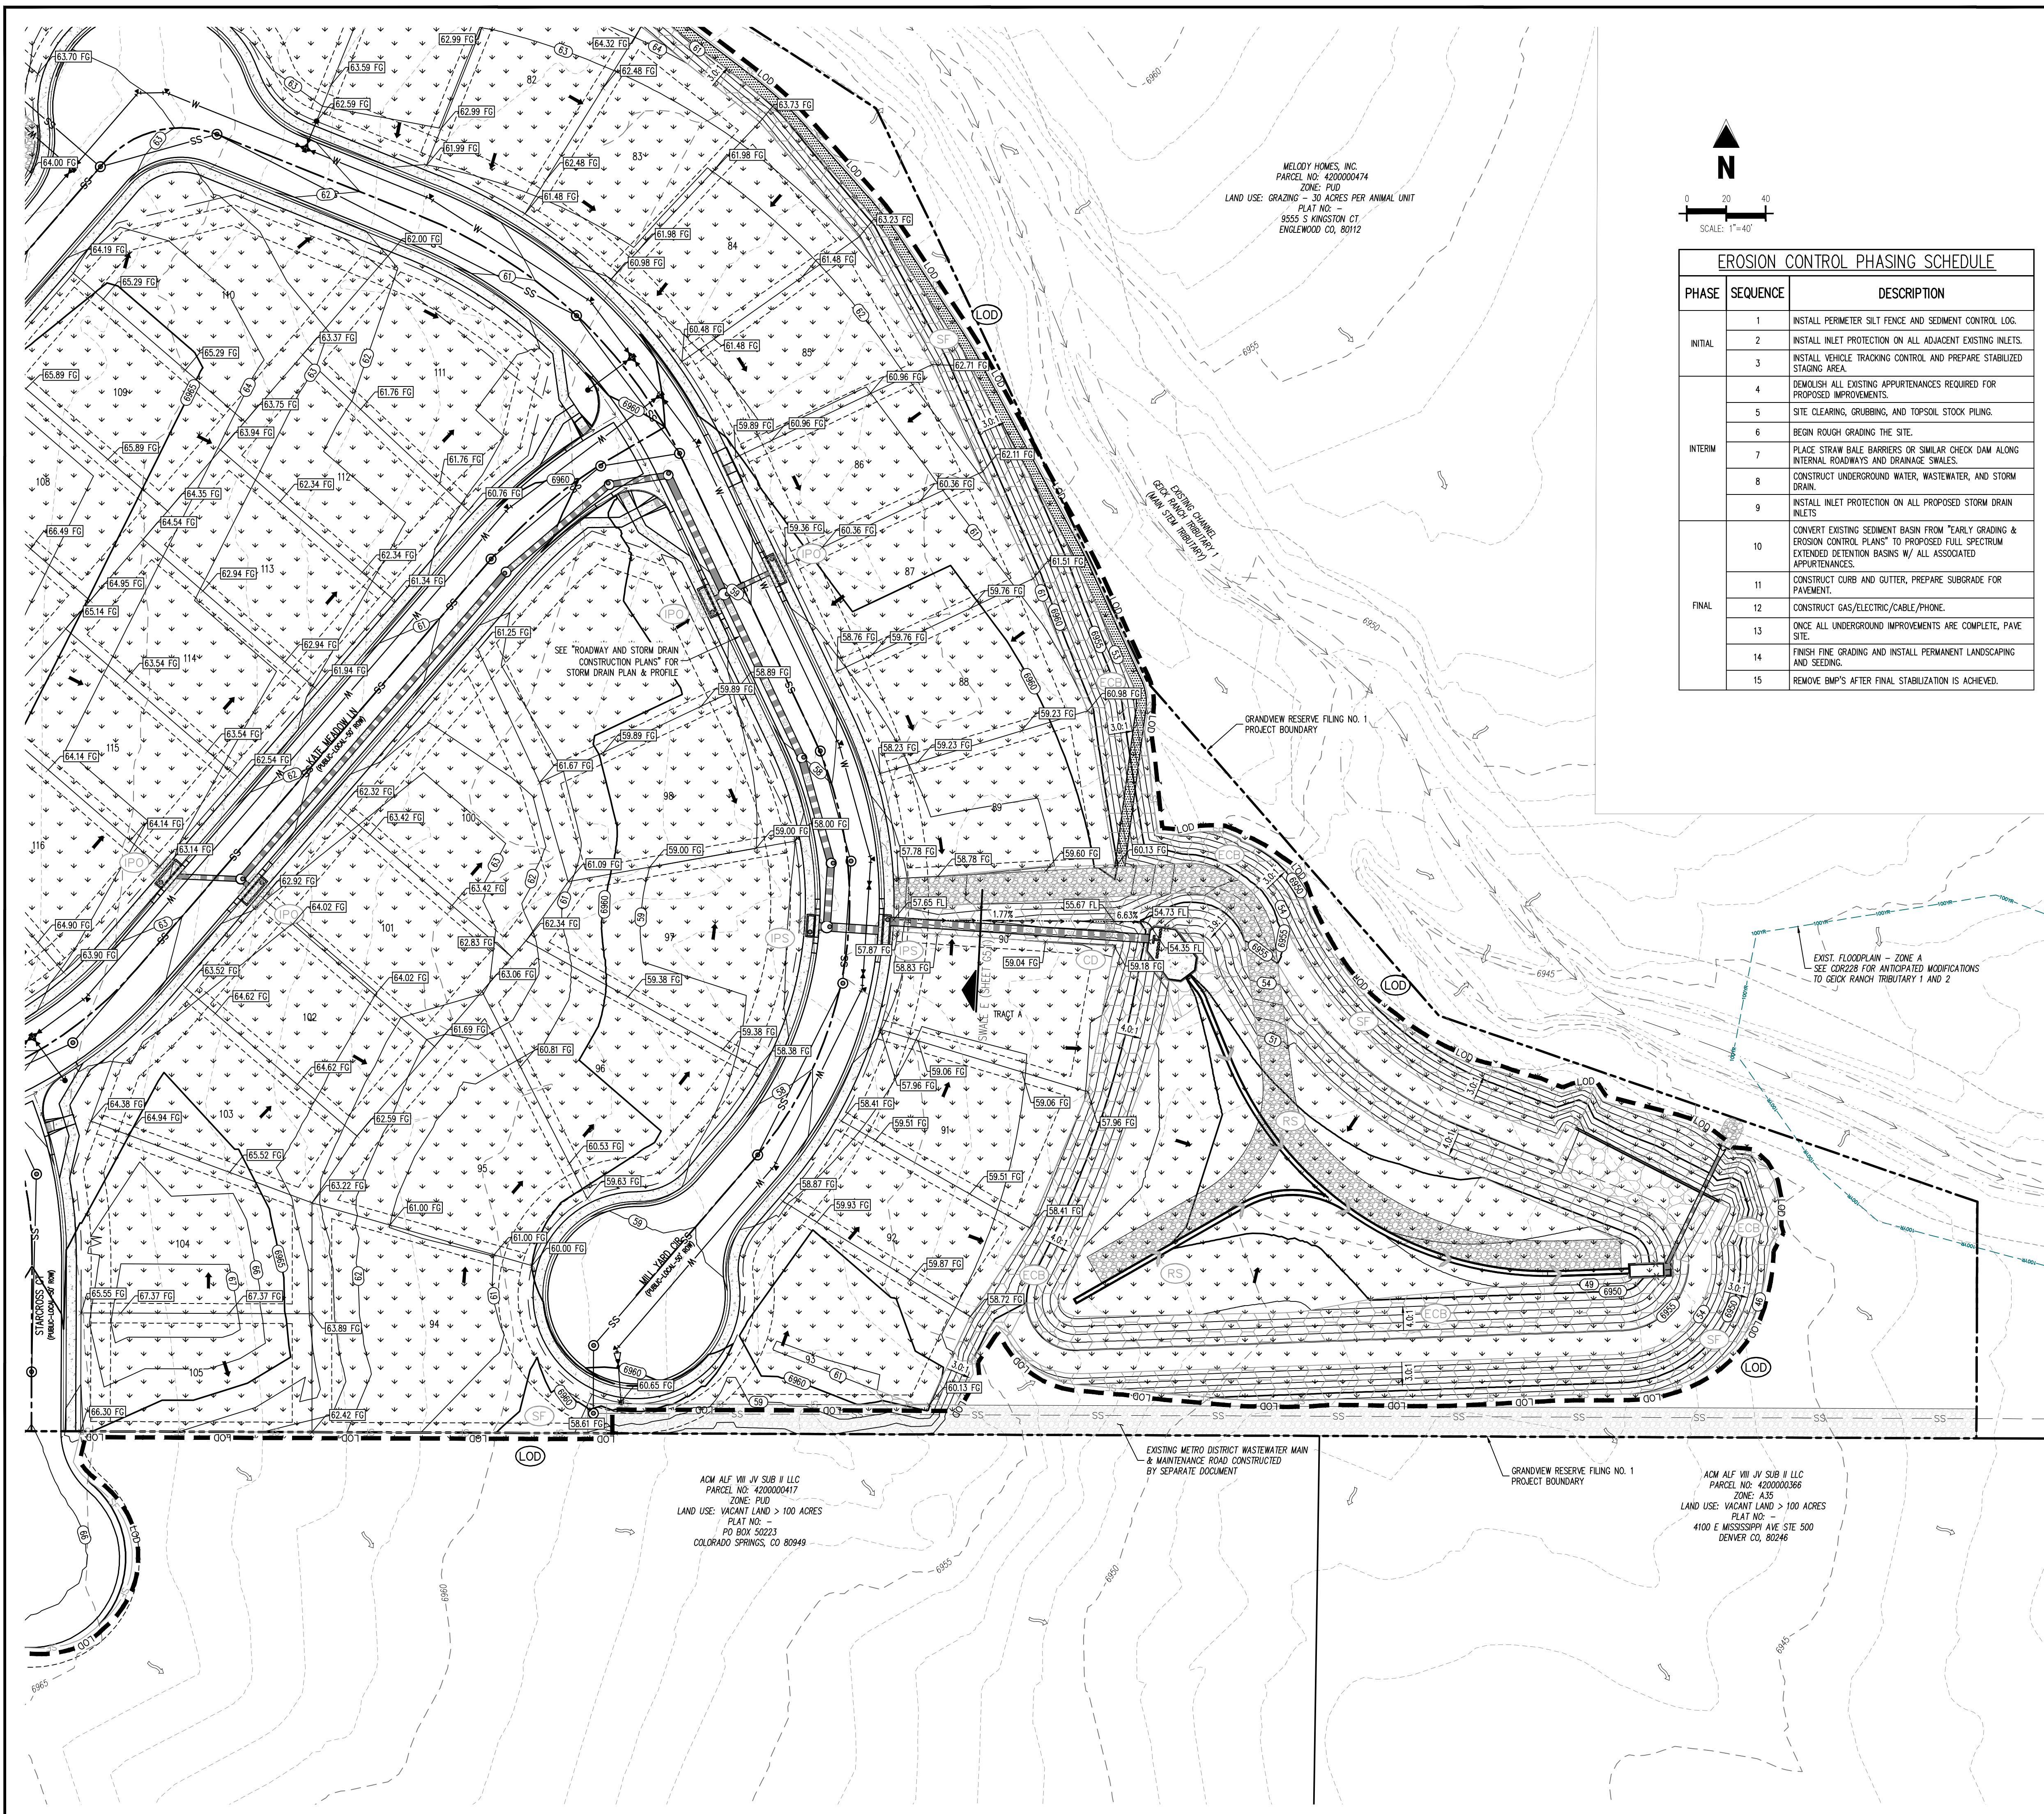

MELODY HOMES, INC.
 PARCEL NO: 4200000474
 ZONE: PUD
 LAND USE: GRAZING - 30 ACRES PER ANIMAL UNIT
 PLAT NO:
 9555 S KINGSTON CT
 ENGLEWOOD CO, 80112

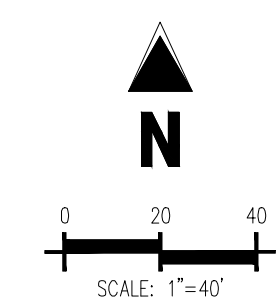

EROSION CONTROL PHASING SCHEDULE		
PHASE	SEQUENCE	DESCRIPTION
INITIAL	1	INSTALL PERIMETER SILT FENCE AND SEDIMENT CONTROL LOG.
	2	INSTALL INLET PROTECTION ON ALL ADJACENT EXISTING INLETS.
	3	INSTALL VEHICLE TRACKING CONTROL AND PREPARE STABILIZED STAGING AREA.
INTERM	4	DEMOLISH ALL EXISTING APPURTENANCES REQUIRED FOR PROPOSED IMPROVEMENTS.
	5	SITE CLEARING, GRUBBING, AND TOPSOIL STOCK PILING.
	6	BEGIN ROUGH GRADING THE SITE.
	7	PLACE STRAW BALE BARRIERS OR SIMILAR CHECK DAM ALONG INTERNAL ROADWAYS AND DRAINAGE SWALES.
	8	CONSTRUCT UNDERGROUND WATER, WASTEWATER, AND STORM DRAIN.
FINAL	9	INSTALL INLET PROTECTION ON ALL PROPOSED STORM DRAIN INLETS.
	10	CONVERT EXISTING SEDIMENT BASIN FROM "EARLY GRADING & EROSION CONTROL PLANS" TO PROPOSED FULL SPECTRUM EXTENDED DETENTION BASIN W/ ALL ASSOCIATED APPURTENANCES.
	11	CONSTRUCT CURB AND GUTTER, PREPARE SUBGRADE FOR PAVEMENT.
	12	CONSTRUCT GAS/ELECTRIC/CABLE/PHONE.
	13	ONCE ALL UNDERGROUND IMPROVEMENTS ARE COMPLETE, PAVE SITE.
	14	FINISH FINE GRADING AND INSTALL PERMANENT LANDSCAPING AND SEEDING.
	15	REMOVE BMP'S AFTER FINAL STABILIZATION IS ACHIEVED.

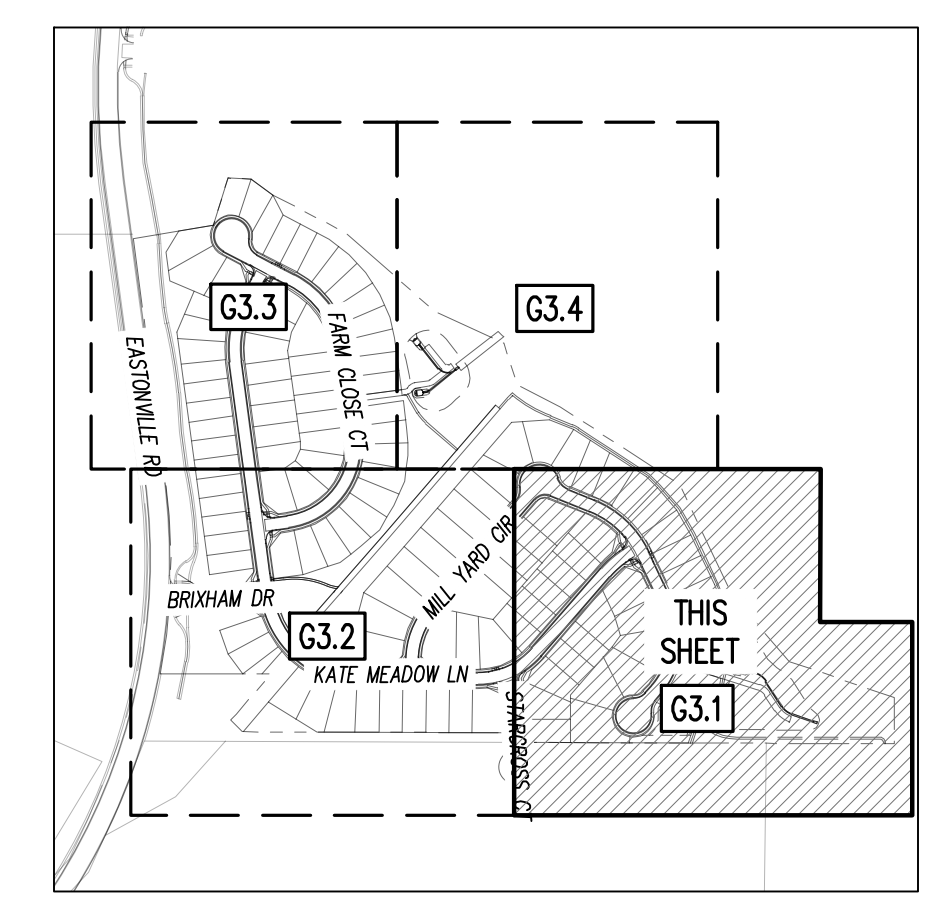

KEYMAP
SCALE: 1"=500'

EROSION CONTROL LEGEND

5460	EXISTING MAJOR CONTOUR
52	EXISTING MINOR CONTOUR
5465	PROPOSED MAJOR CONTOUR
56	PROPOSED MINOR CONTOUR
SS	EXISTING STORM SEWER
SS	PROPOSED STORM SEWER
SS	EXISTING SANITARY SEWER
SS	PROPOSED SANITARY SEWER
W	PROPOSED WATER LINE
G	EXISTING GAS LINE
G	PROPOSED RIDGE LINE
G	PROPOSED SWALE LINE
G	EXISTING SWALE LINE
FL	FLOODPLAIN BOUNDARY
FL	EXISTING FLOOD ZONE
FL	EXISTING FLOOD ZONE SETBACK
→	FLOW ARROW
→	PROPOSED GRAVEL PER ECM TABLE D-7
LS	PERMANENT LANDSCAPING
DD	DIVERSION DITCH
LOD	LIMITS OF DISTURBANCE/CONSTRUCTION
VTC	VEHICLE TRACKING CONTROL
CWA	CONCRETE WASHOUT AREA
SSA	STABILIZED STAGING AREA
SM	SEED AND MULCH
SCL	SEDIMENT CONTROL LOG
IPS	SUMP INLET PROTECTION (P-3)
IPD	ON-GRADE INLET PROTECTION (P-4)
RS	ROCK SOCKS
SF	SILT FENCE
CF	CONSTRUCTION FENCE
SB	SEDIMENT BASIN
CD	CHECK DAM
ECB	COMPOST BLANKET (APPROXIMATE)
RR	RIPRAP OUTFALL PADS
PT	PORTABLE TOILET
SITE	SITE POSTING (CONTACTS AND PERMITS)
WP	WASHOUT POSTING
SBB	STRAW BALE BARRIER
XX	EROSION MEASURE INSTALLED IN EARLIER PHASE
XX	PROPOSED EROSION MEASURE

COPYRIGHT
 THESE PLANS ARE AN INSTRUMENT OF SERVICE AND ARE THE PROPERTY OF GALLOWAY, AND MAY NOT BE DUPLICATED, DISCLOSED, OR REPRODUCED WITHOUT THE WRITTEN CONSENT OF GALLOWAY. COPYRIGHTS AND INFRINGEMENTS WILL BE ENFORCED AND PROSECUTED.

GRADING & EROSION CONTROL PLANS
GRANDVIEW RESERVE FILING NO. 1
MELODY HOMES, INC.
SF2311
EASTONVILLE RD & REX RD
EL PASO COUNTY, FALCON, CO 80831

#	Date	Issue / Description	Init.

Project No:	HRG02
Drawn By:	JDM, BLB
Checked By:	BAS, CMWJ
Date:	03/15/2024

FINAL EROSION CONTROL PLAN

BASIS OF BEARING
 THE NORTH LINE OF SECTION 28, TOWNSHIP 12 SOUTH, RANGE 64 WEST OF THE 6TH PRINCIPAL MERIDIAN, EL PASO COUNTY, STATE OF COLORADO BEING MONUMENTED AT EACH END BY A 3/4" ALUMINUM SURVEYORS CAP STAMPED "PSINC LS 30087" AND ASSUMED TO BEAR S89°47'04"E, A DISTANCE OF 5285.07 FEET.

BENCHMARK
 NOS BENCHMARK F 24
 A STANDARD DISK, STAMPED F 24 1929 AND SET IN THE TOP OF A CONCRETE POST PROJECTING ABOUT 6 INCHES ABOVE GROUND, ALONG THE CHICAGO, ROCK ISLAND AND PACIFIC RAILROAD, 52 FEET NORTHWEST OF THE CENTERLINE OF U.S. HIGHWAY 24, 48 FEET SOUTHWEST OF THE CENTERLINE OF THE TRACK, NAVD88 ELEVATION = 6866.33

CAUTION - NOTICE TO CONTRACTOR

- ALL UTILITY LOCATIONS SHOWN ARE BASED ON MAPS PROVIDED BY THE APPROPRIATE UTILITY COMPANY AND FIELD SURFACE EVIDENCE AT THE TIME OF SURVEY AND IS TO BE CONSIDERED AN APPROXIMATE LOCATION ONLY. IT IS THE CONTRACTOR'S RESPONSIBILITY TO FIELD VERIFY THE LOCATION OF ALL UTILITIES, PUBLIC OR PRIVATE, WHETHER SHOWN ON THE PLANS OR NOT, PRIOR TO CONSTRUCTION. REPORT ANY DISCREPANCIES TO THE ENGINEER PRIOR TO CONSTRUCTION.
- WHERE A PROPOSED UTILITY CROSSES AN EXISTING UTILITY, IT IS THE CONTRACTOR'S RESPONSIBILITY TO FIELD VERIFY THE HORIZONTAL AND VERTICAL LOCATION OF SUCH EXISTING UTILITY, EITHER THROUGH POT-Holing OR ALTERNATIVE METHOD. REPORT INFORMATION TO THE ENGINEER PRIOR TO CONSTRUCTION.



COPYRIGHT
THESE PLANS ARE AN INSTRUMENT OF SERVICE AND ARE THE PROPERTY OF GALLOWAY, AND MAY NOT BE DUPLICATED, DISCLOSED, OR REPRODUCED WITHOUT THE WRITTEN CONSENT OF GALLOWAY. COPYRIGHTS AND INFRINGEMENTS WILL BE ENFORCED AND PROSECUTED.

D.R. HORTON
America's Builder

GRADING & EROSION CONTROL PLANS
GRANDVIEW RESERVE FILING NO. 1
MELODY HOMES, INC.
SF23111


EASTONVILLE RD & REX RD
EL PASO COUNTY, FALCON, CO 80831

#	Date	Issue / Description	Init.

Project No:	HRG02
Drawn By:	JDM, BLB
Checked By:	BAS, CMWJ
Date:	03/15/2024

FINAL EROSION CONTROL PLAN

G3.2
Sheet 13 of 32

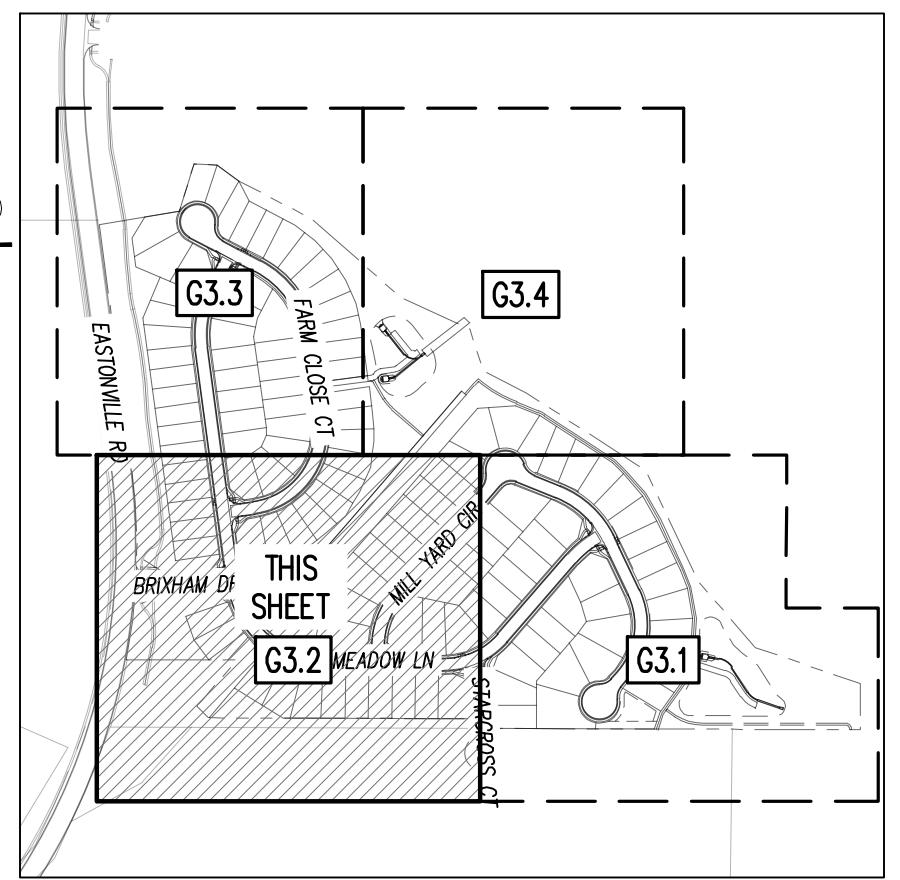

KEYMAP
SCALE: 1"=500'

EROSION CONTROL LEGEND



- 5460 EXISTING MAJOR CONTOUR
- 52 EXISTING MINOR CONTOUR
- C485 PROPOSED MAJOR CONTOUR
- 66 PROPOSED MINOR CONTOUR
- EXISTING STORM SEWER
- PROPOSED STORM SEWER
- EXISTING SANITARY SEWER
- PROPOSED SANITARY SEWER
- PROPOSED WATER LINE
- EXISTING GAS LINE
- PROPOSED RIDGE LINE
- PROPOSED SWALE LINE
- EXISTING SWALE LINE
- FLOODPLAIN BOUNDARY
- EXISTING FLOOD ZONE
- EXISTING FLOOD ZONE SETBACK
- FLOW ARROW
- PROPOSED GRAVEL PER ERM TABLE D-7
- LS PERMANENT LANDSCAPING
- DD DIVERSION DITCH
- LOD LIMITS OF DISTURBANCE/CONSTRUCTION
- VTC VEHICLE TRACKING CONTROL
- CWA CONCRETE WASHOUT AREA
- SSA STABILIZED STAGING AREA
- SM SEED AND MULCH
- SCL SEDIMENT CONTROL LOG
- IPS SUMP INLET PROTECTION (P-3)
- IPD ON-GRADE INLET PROTECTION (P-4)
- RS ROCK SOCKS
- SF SILT FENCE
- CF CONSTRUCTION FENCE
- SB SEDIMENT BASIN
- CD CHECK DAM
- ECB COMPOST BLANKET (APPROXIMATE)
- RR RIPRAP OUTFALL PADS
- PT PORTABLE TOILET
- SITE SITE POSTING (CONTACTS AND PERMITS)
- WP WASHOUT POSTING
- SBB STRAW BALE BARRIER
- XX EROSION MEASURE INSTALLED IN EARLIER PHASE
- XX PROPOSED EROSION MEASURE

BASIS OF BEARING
THE NORTH LINE OF SECTION 28, TOWNSHIP 12 SOUTH, RANGE 64 WEST OF THE 6TH PRINCIPAL MERIDIAN, EL PASO COUNTY, STATE OF COLORADO BEING MONUMENTED AT EACH END BY A 3/4" ALUMINUM SURVEYORS CAP STAMPED "PSINC LS 30087" AND ASSUMED TO BEAR S89°47'04"E, A DISTANCE OF 5285.07 FEET.

BENCHMARK
NOS BENCHMARK F 24
A STANDARD DISK, STAMPED F 24 1929 AND SET IN THE TOP OF A CONCRETE POST PROJECTING ABOUT 6 INCHES ABOVE GROUND, ALONG THE CHICAGO, ROCK ISLAND AND PACIFIC RAILROAD, 52 FEET NORTHWEST OF THE CENTERLINE OF U.S. HIGHWAY 24, 48 FEET SOUTHWEST OF THE CENTERLINE OF THE TRACK.
NAVD88 ELEVATION = 6866.33

CAUTION - NOTICE TO CONTRACTOR

- ALL UTILITY LOCATIONS SHOWN ARE BASED ON MAPS PROVIDED BY THE APPROPRIATE UTILITY COMPANY AND FIELD SURFACE EVIDENCE AT THE TIME OF SURVEY AND IS TO BE CONSIDERED AN APPROXIMATE LOCATION ONLY. IT IS THE CONTRACTOR'S RESPONSIBILITY TO FIELD VERIFY THE LOCATION OF ALL UTILITIES, PUBLIC OR PRIVATE, WHETHER SHOWN ON THE PLANS OR NOT, PRIOR TO CONSTRUCTION. REPORT ANY DISCREPANCIES TO THE ENGINEER PRIOR TO CONSTRUCTION.
- WHERE A PROPOSED UTILITY CROSSES AN EXISTING UTILITY, IT IS THE CONTRACTOR'S RESPONSIBILITY TO FIELD VERIFY THE HORIZONTAL AND VERTICAL LOCATION OF SUCH EXISTING UTILITY, EITHER THROUGH POT-HOLING OR AN ALTERNATIVE METHOD. REPORT INFORMATION TO THE ENGINEER PRIOR TO CONSTRUCTION.

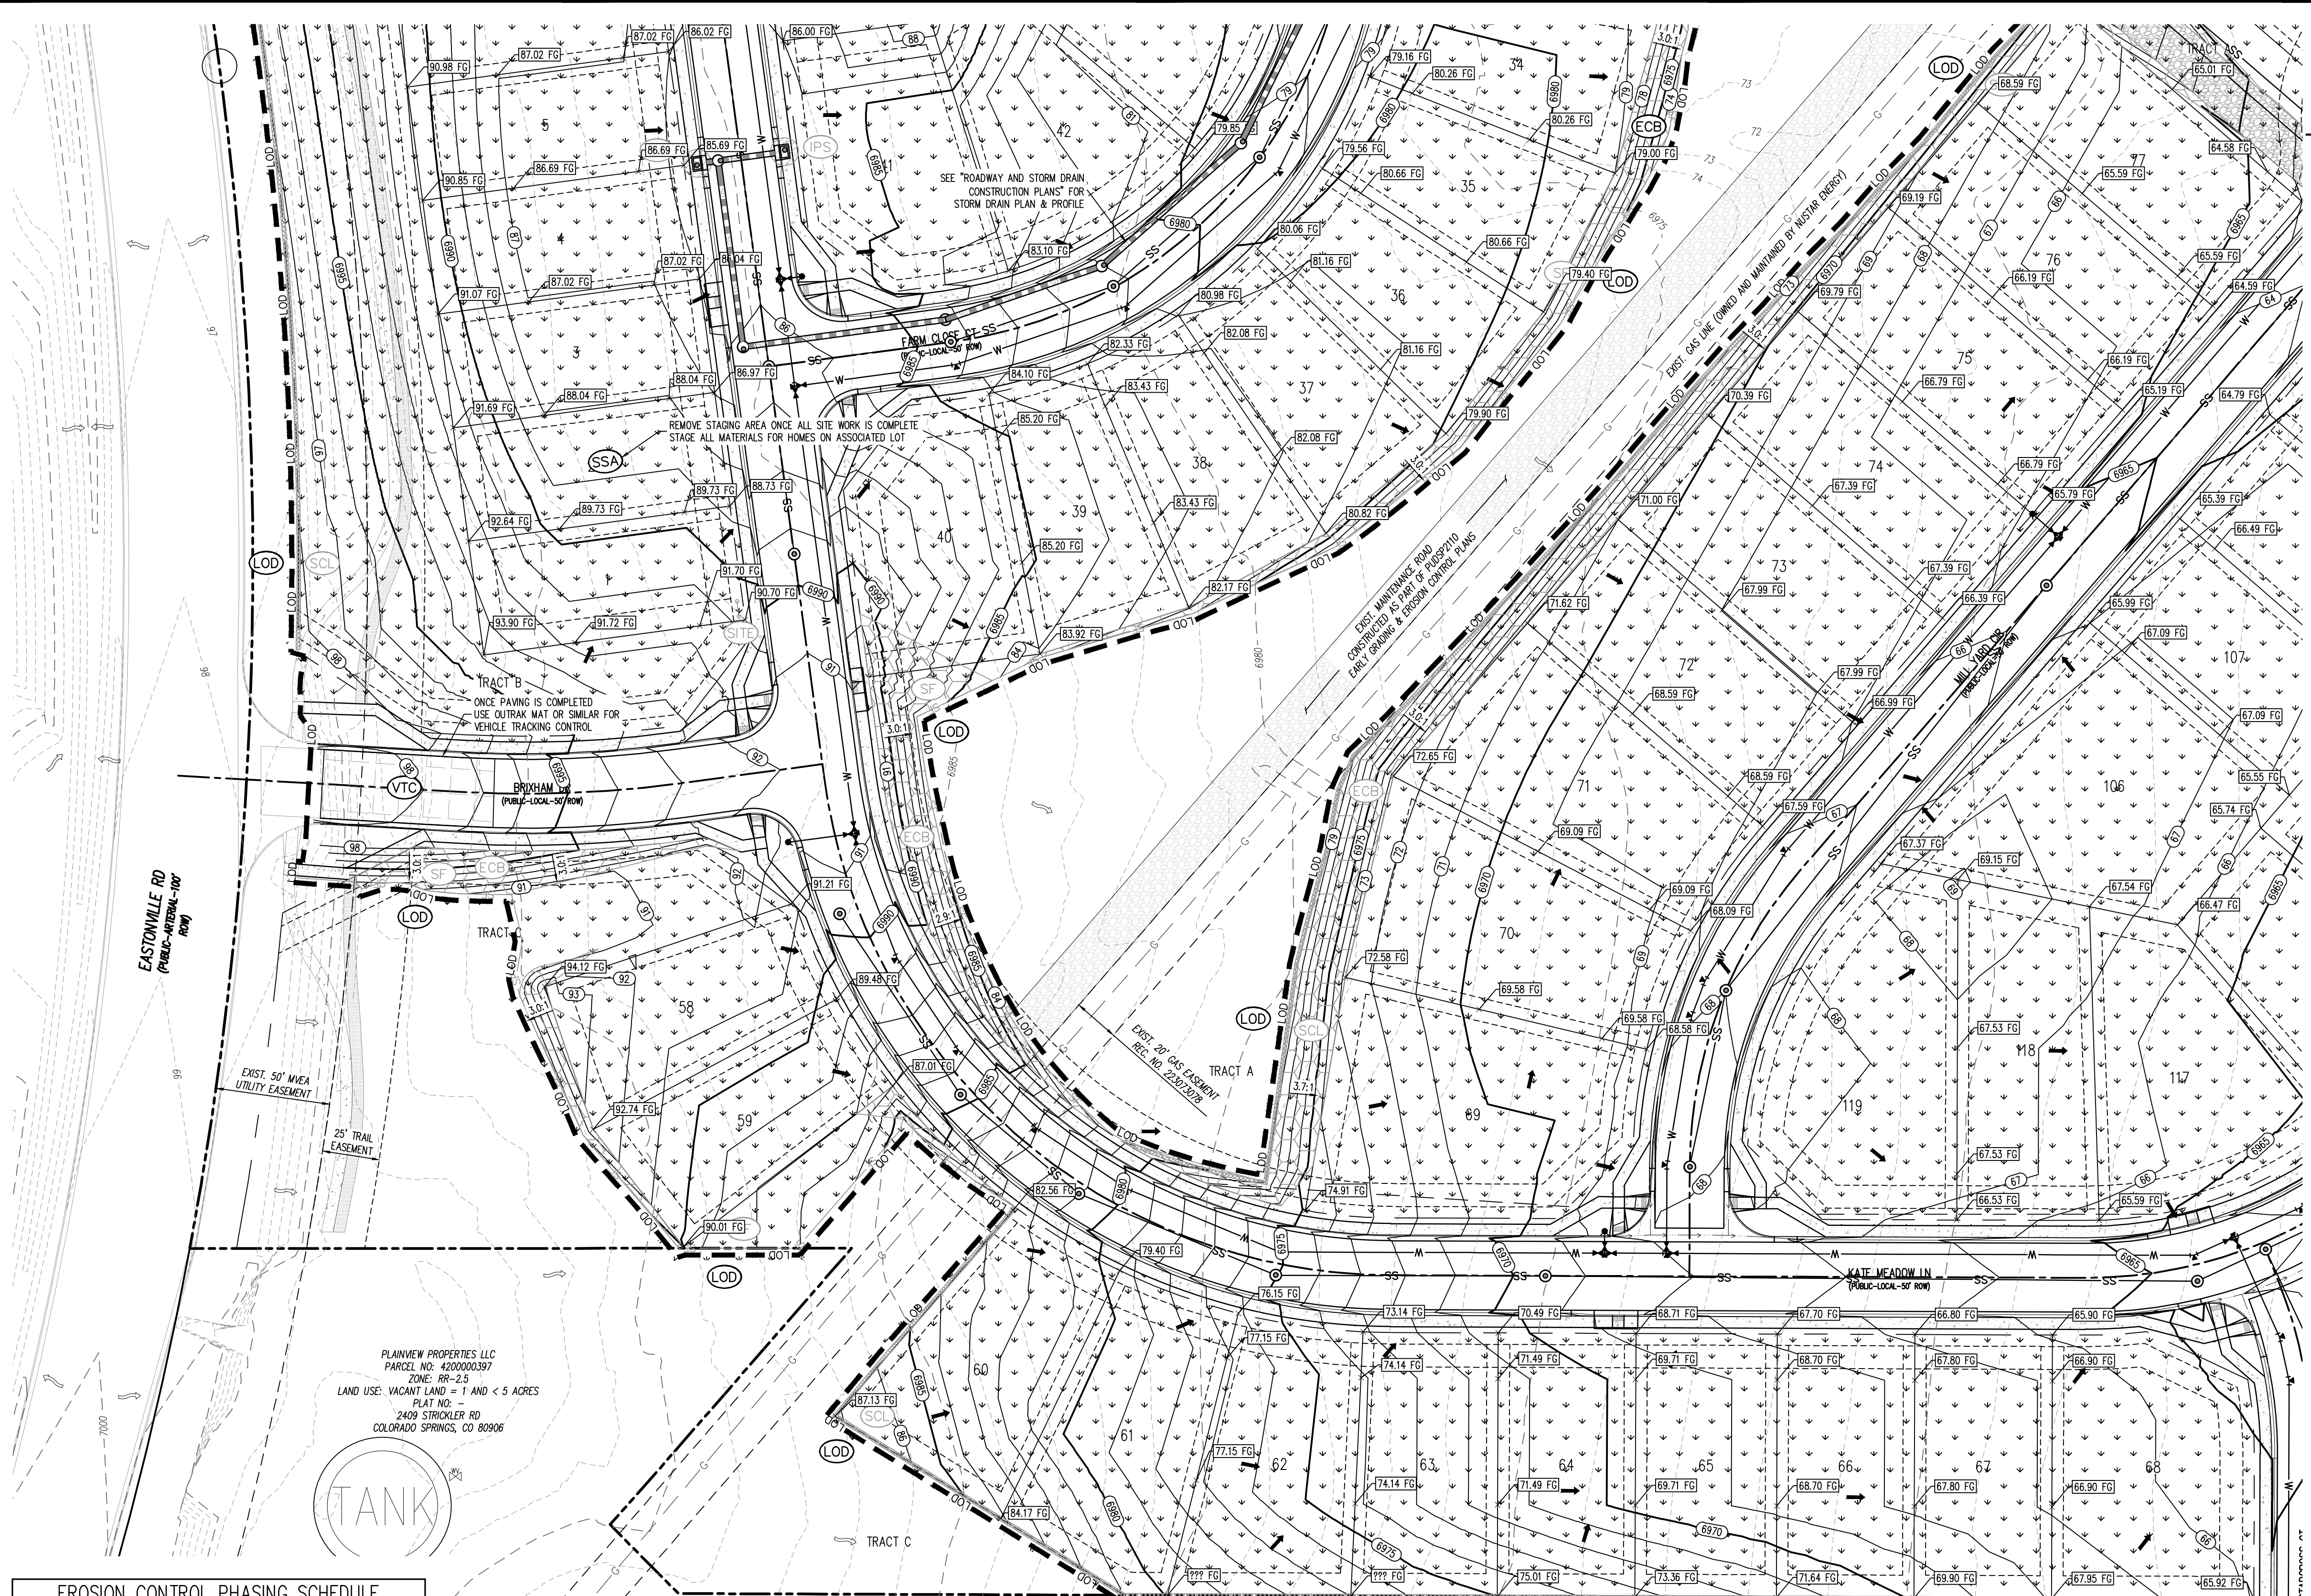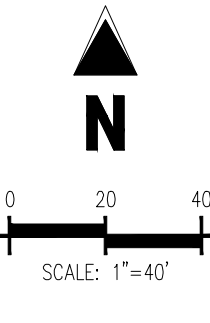

EROSION CONTROL PHASING SCHEDULE		
PHASE	SEQUENCE	DESCRIPTION
INITIAL	1	INSTALL PERIMETER SILT FENCE AND SEDIMENT CONTROL LOG.
	2	INSTALL INLET PROTECTION ON ALL ADJACENT EXISTING INLETS.
	3	INSTALL VEHICLE TRACKING CONTROL AND PREPARE STABILIZED STAGING AREA.
	4	DEMOLISH ALL EXISTING APPURTENANCES REQUIRED FOR PROPOSED IMPROVEMENTS.
INTERIM	5	SITE CLEARING, GRUBBING, AND TOPSOIL STOCK PILING.
	6	BEGIN ROUGH GRADING THE SITE.
	7	PLACE STRAW BALE BARRIERS OR SIMILAR CHECK DAM ALONG INTERNAL ROADWAYS AND DRAINAGE SWALES.
	8	CONSTRUCT UNDERGROUND WATER, WASTEWATER, AND STORM DRAIN.
	9	INSTALL INLET PROTECTION ON ALL PROPOSED STORM DRAIN INLETS.
FINAL	10	CONVERT EXISTING SEDIMENT BASIN FROM "EARLY GRADING & EROSION CONTROL PLANS" TO PROPOSED FULL SPECTRUM EXTENDED DETENTION BASINS W/ ALL ASSOCIATED APPURTENANCES.
	11	CONSTRUCT CURB AND GUTTER, PREPARE SUBGRADE FOR PAVEMENT.
	12	CONSTRUCT GAS/ELECTRIC/CABLE/PHONE.
	13	ONCE ALL UNDERGROUND IMPROVEMENTS ARE COMPLETE, PAVE SITE.
	14	FINISH FINE GRADING AND INSTALL PERMANENT LANDSCAPING AND SEEDING.
	15	REMOVE BMP'S AFTER FINAL STABILIZATION IS ACHIEVED.

PLAINVIEW PROPERTIES LLC
PARCEL NO. 4200000397
ZONE: RR-2.5
LAND USE: VACANT LAND = 1 AND < 5 ACRES
PLAT NO. =
2409 STROCKLER RD
COLORADO SPRINGS, CO 80906






ADM ALF VII JV SUB II LLC
PARCEL NO. 4200004417
ZONE: PUD
LAND USE: VACANT LAND > 100 ACRES
PLAT NO. =
4100 E MISSISSIPPI AVE STE 500
DENVER, CO 80246

2024 GALLOWAY CONSULTANTS, INC. ALL RIGHTS RESERVED. PROJECT: GRANDVIEW RESERVE FILING NO. 1, MELODY HOMES, INC., SF23111. SHEET: G3.2. DATE: 03/15/2024.

Per comments on the drainage report, if runoff reduction is proposed for these lots:
 - All RPA/SPA areas will need to be within a no build/drainage easement (or tract) and discussed in the maintenance agreement and O&M manual. This can be existing no build setback areas but it needs to be clearly identified because it is a permanent water quality facility.
 - RPA vegetation should have a uniform density of at least 80%. This needs to be specified in a detail and the seed mix needs to be identified.
 - RPA/SPA limits must be shown on GEC Plans (not just FDR) so our SW inspectors and the QSM know that these areas are to remain pervious and vegetated (80%). Our SW inspectors do not look at drainage reports.

REMOVED RUNOFF REDUCTION,
 NOT NECESSARY TO MEET CRITERIA


MELODY HOMES, INC.
 PARCEL NO: 420000474
 ZONE: P10
 LAND USE: GRAZING - 30 ACRES PER ANIMAL
 UNIT
 NO -
 9555 S KINGSTON CT ENGLEWOOD, CO 80112

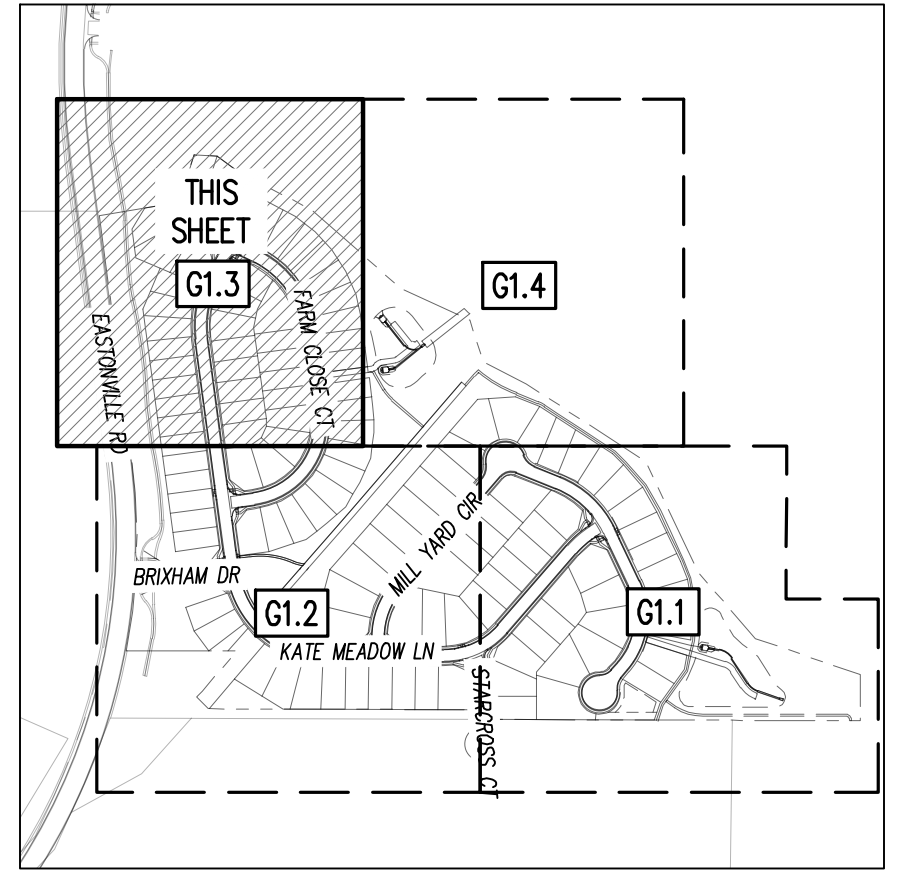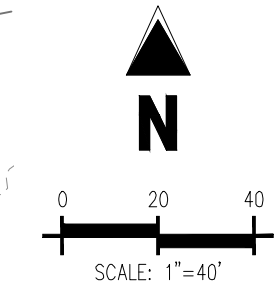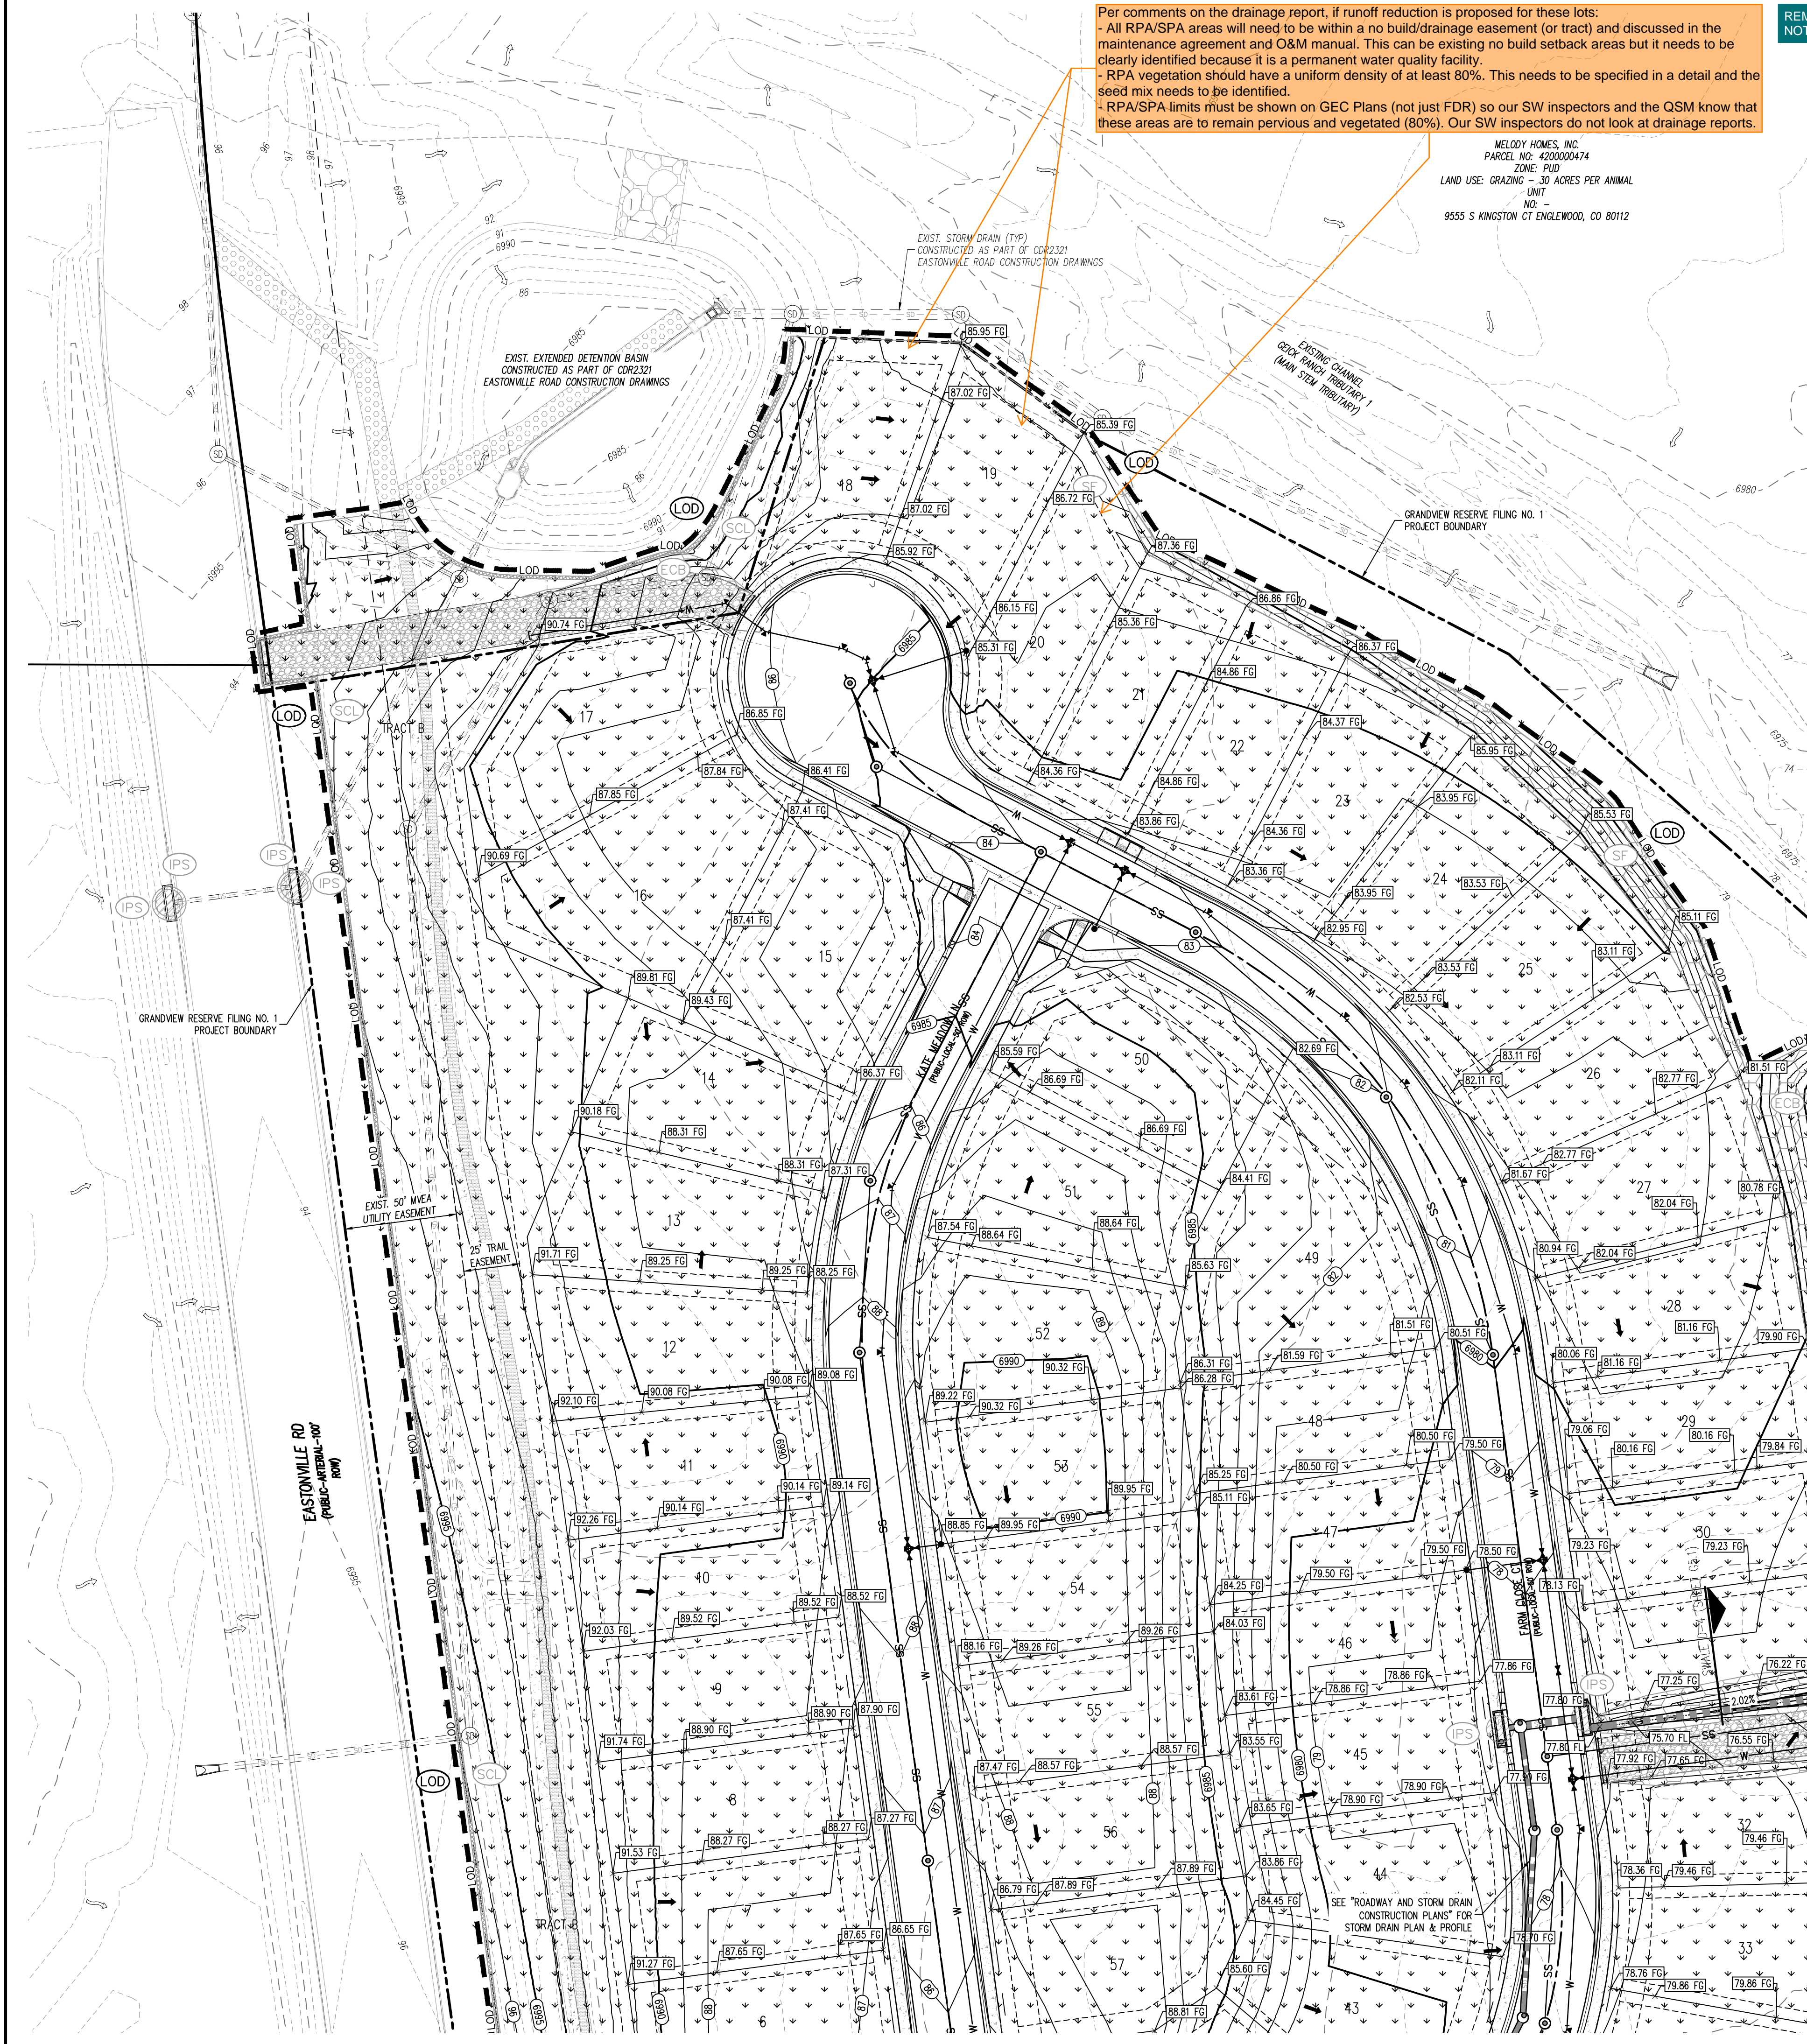

KEYMAP
 SCALE: 1"=500'

EROSION CONTROL PHASING SCHEDULE		
PHASE	SEQUENCE	DESCRIPTION
INITIAL	1	INSTALL PERIMETER SILT FENCE AND SEDIMENT CONTROL LOG.
	2	INSTALL INLET PROTECTION ON ALL ADJACENT EXISTING INLETS.
	3	INSTALL VEHICLE TRACKING CONTROL AND PREPARE STABILIZED STAGING AREA.
INTERM	4	DEMOLISH ALL EXISTING APPURTENANCES REQUIRED FOR PROPOSED IMPROVEMENTS.
	5	SITE CLEARING, GRUBBING, AND TOPSOIL STOCK PILING.
	6	BEGIN ROUGH GRADING THE SITE.
	7	PLACE STRAW BALE BARRIERS OR SIMILAR CHECK DAM ALONG INTERNAL ROADWAYS AND DRAINAGE SWALES.
	8	CONSTRUCT UNDERGROUND WATER, WASTEWATER, AND STORM DRAIN.
	9	INSTALL INLET PROTECTION ON ALL PROPOSED STORM DRAIN INLETS.
FINAL	10	CONVERT EXISTING SEDIMENT BASIN FROM 'EARLY GRADING & EROSION CONTROL PLANS' TO PROPOSED FULL SPECTRUM EXTENDED DETENTION BASINS W/ ALL ASSOCIATED APPURTENANCES.
	11	CONSTRUCT CURB AND GUTTER, PREPARE SUBGRADE FOR PAVEMENT.
	12	CONSTRUCT GAS/ELECTRIC/CABLE/PHONE.
	13	ONCE ALL UNDERGROUND IMPROVEMENTS ARE COMPLETE, PAVE SITE.
	14	FINISH FINE GRADING AND INSTALL PERMANENT LANDSCAPING AND SEEDING.
	15	REMOVE BMP'S AFTER FINAL STABILIZATION IS ACHIEVED.

EROSION CONTROL LEGEND

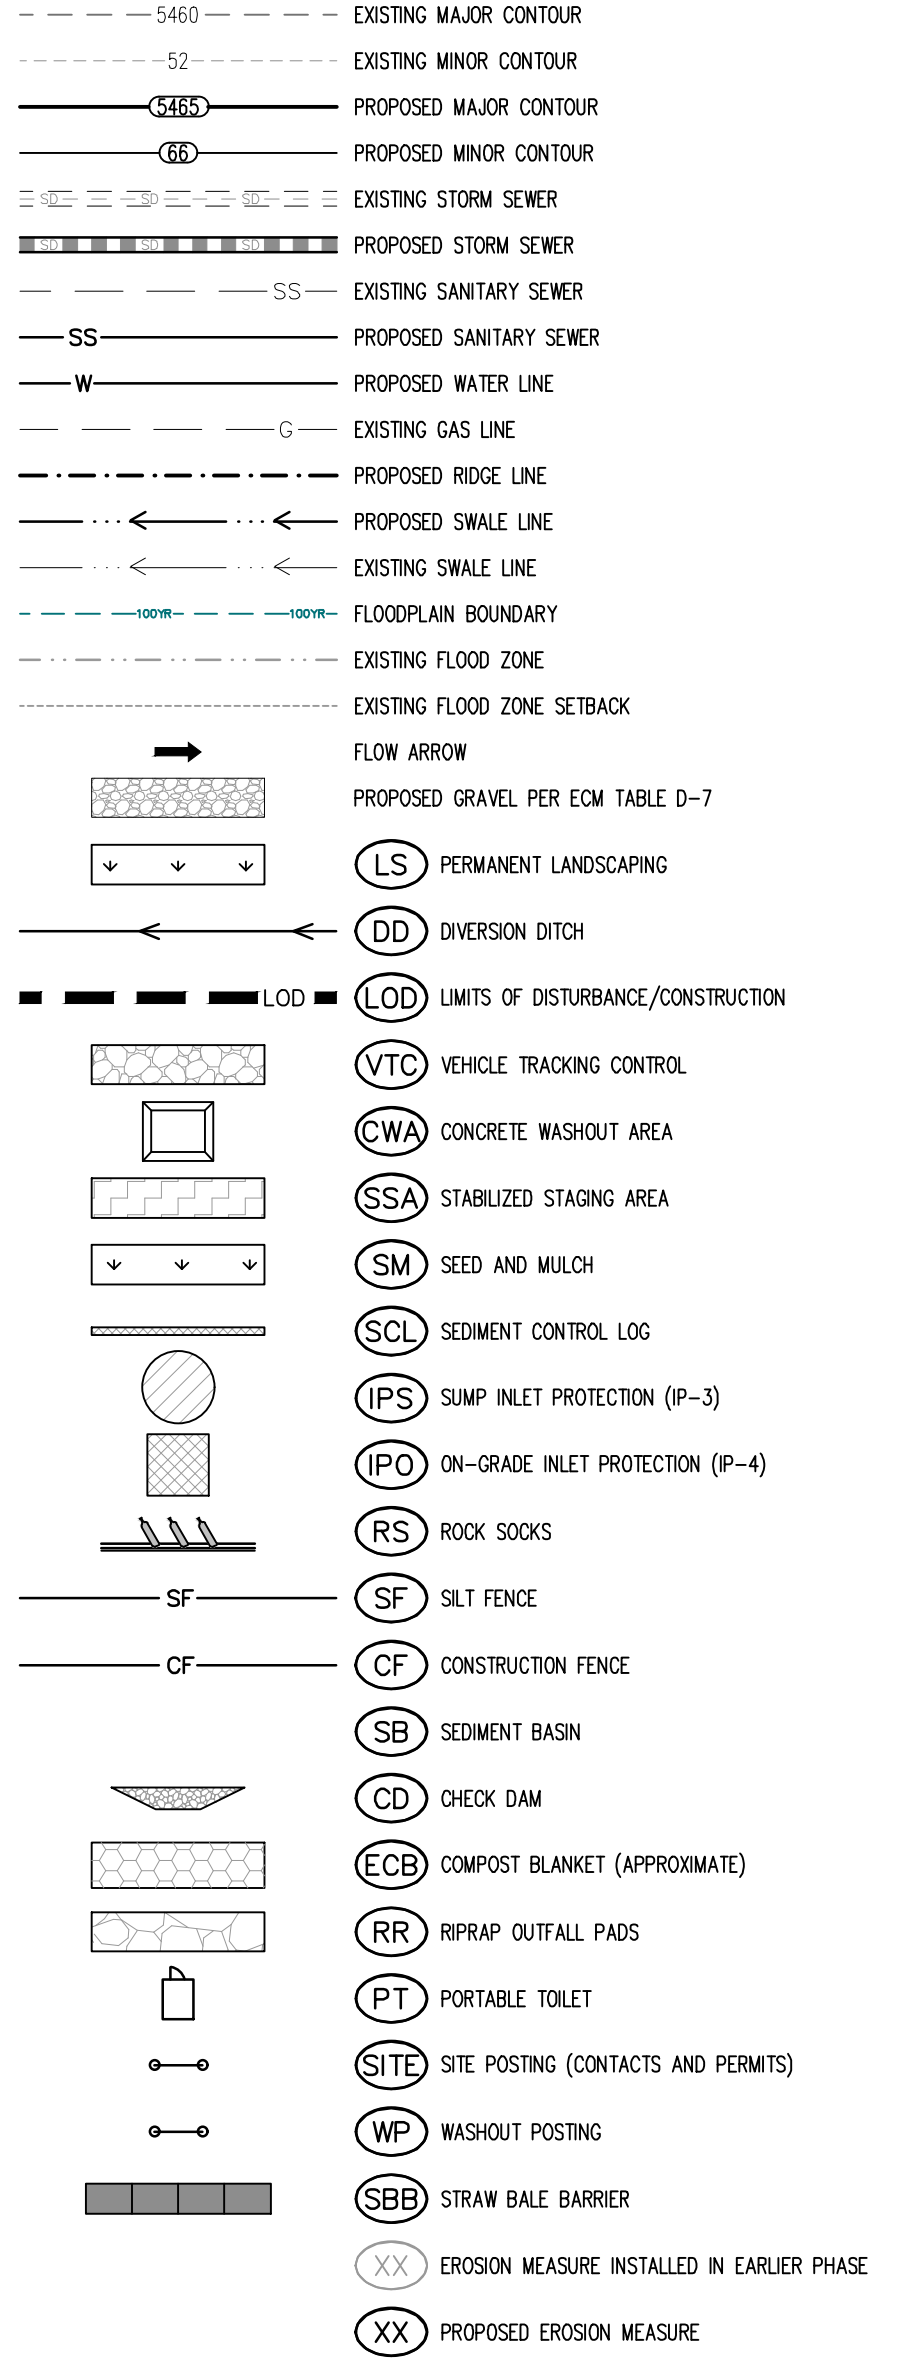

BASIS OF BEARING
 THE NORTH LINE OF SECTION 28, TOWNSHIP 12 SOUTH, RANGE 64 WEST OF THE 6TH PRINCIPAL MERIDIAN, EL PASO COUNTY, STATE OF COLORADO BEING MONUMENTED AT EACH END BY A 3/4" ALUMINUM SURVEYORS CAP STAMPED "PSINC LS 30087" AND ASSUMED TO BEAR S89°47'04"E, A DISTANCE OF 5285.07 FEET.

BENCHMARK
 NOS BENCHMARK F 24
 A STANDARD DISK, STAMPED F 24 1929 AND SET IN THE TOP OF A CONCRETE POST PROJECTING ABOUT 6 INCHES ABOVE GROUND, ALONG THE CHICAGO, ROCK ISLAND AND PACIFIC RAILROAD, 52 FEET NORTHWEST OF THE CENTERLINE OF U.S. HIGHWAY 24, 48 FEET SOUTHWEST OF THE CENTERLINE OF THE TRACK.
 NAVD83 ELEVATION = 6866.33

CAUTION - NOTICE TO CONTRACTOR
 1. ALL UTILITY LOCATIONS SHOWN ARE BASED ON MAPS PROVIDED BY THE APPROPRIATE UTILITY COMPANY AND FIELD SURFACE EVIDENCE AT THE TIME OF SURVEY AND IS TO BE CONSIDERED AN APPROXIMATE LOCATION ONLY. IT IS THE CONTRACTOR'S RESPONSIBILITY TO FIELD VERIFY THE LOCATION OF ALL UTILITIES, PUBLIC OR PRIVATE, WHETHER SHOWN ON THE PLANS OR NOT, PRIOR TO CONSTRUCTION. REPORT ANY DISCREPANCIES TO THE ENGINEER PRIOR TO CONSTRUCTION.
 2. WHERE A PROPOSED UTILITY CROSSES AN EXISTING UTILITY, IT IS THE CONTRACTOR'S RESPONSIBILITY TO FIELD VERIFY THE HORIZONTAL AND VERTICAL LOCATION OF SUCH EXISTING UTILITY, EITHER THROUGH POT-HOLING OR ALTERNATIVE METHOD. REPORT INFORMATION TO THE ENGINEER PRIOR TO CONSTRUCTION.

COPYRIGHT
 THESE PLANS ARE AN INSTRUMENT OF SERVICE AND ARE THE PROPERTY OF GALLOWAY, AND MAY NOT BE DUPLICATED, DISCLOSED, OR REPRODUCED WITHOUT THE WRITTEN CONSENT OF GALLOWAY. COPYRIGHTS AND INFRINGEMENTS WILL BE ENFORCED AND PROSECUTED.






GRADING & EROSION CONTROL PLANS
 GRANDVIEW RESERVE FILING NO. 1
 MELODY HOMES, INC.
 SF2311
 EASTONVILLE RD & REX RD
 EL PASO COUNTY, FALCON, CO 80831

#	Date	Issue / Description	Init.

Project No: HRG02
 Drawn By: JDM, BLB
 Checked By: BAS, CMWJ
 Date: 03/15/2024

FINAL EROSION CONTROL PLAN



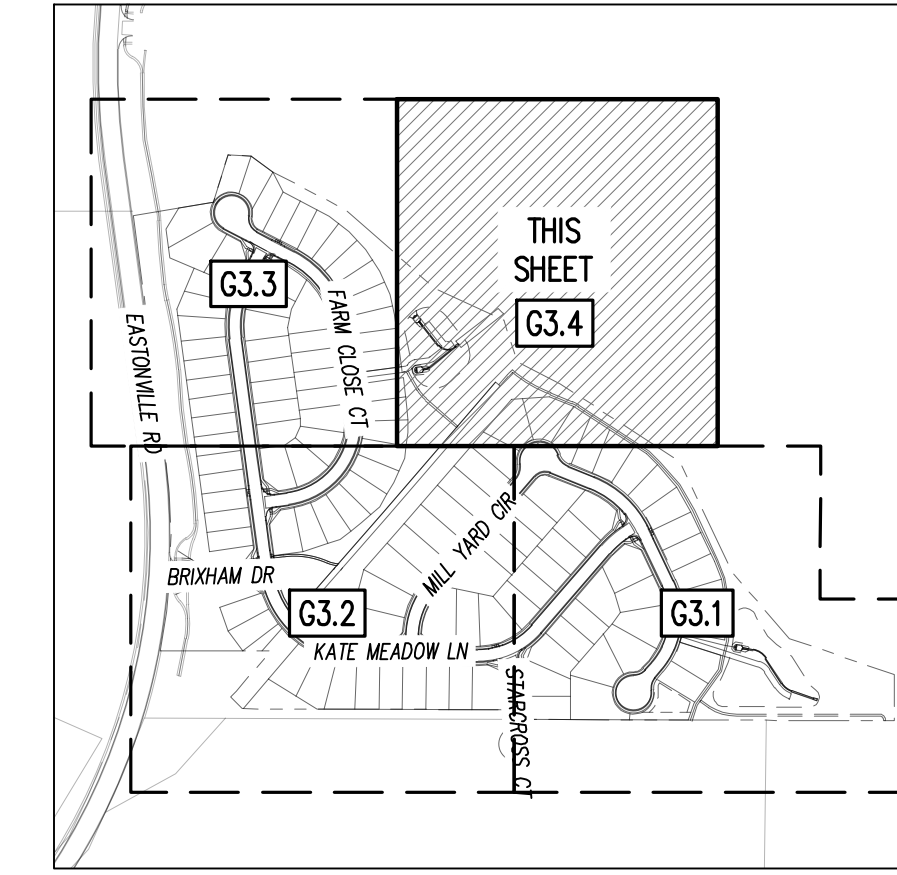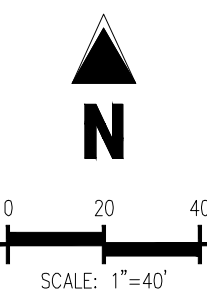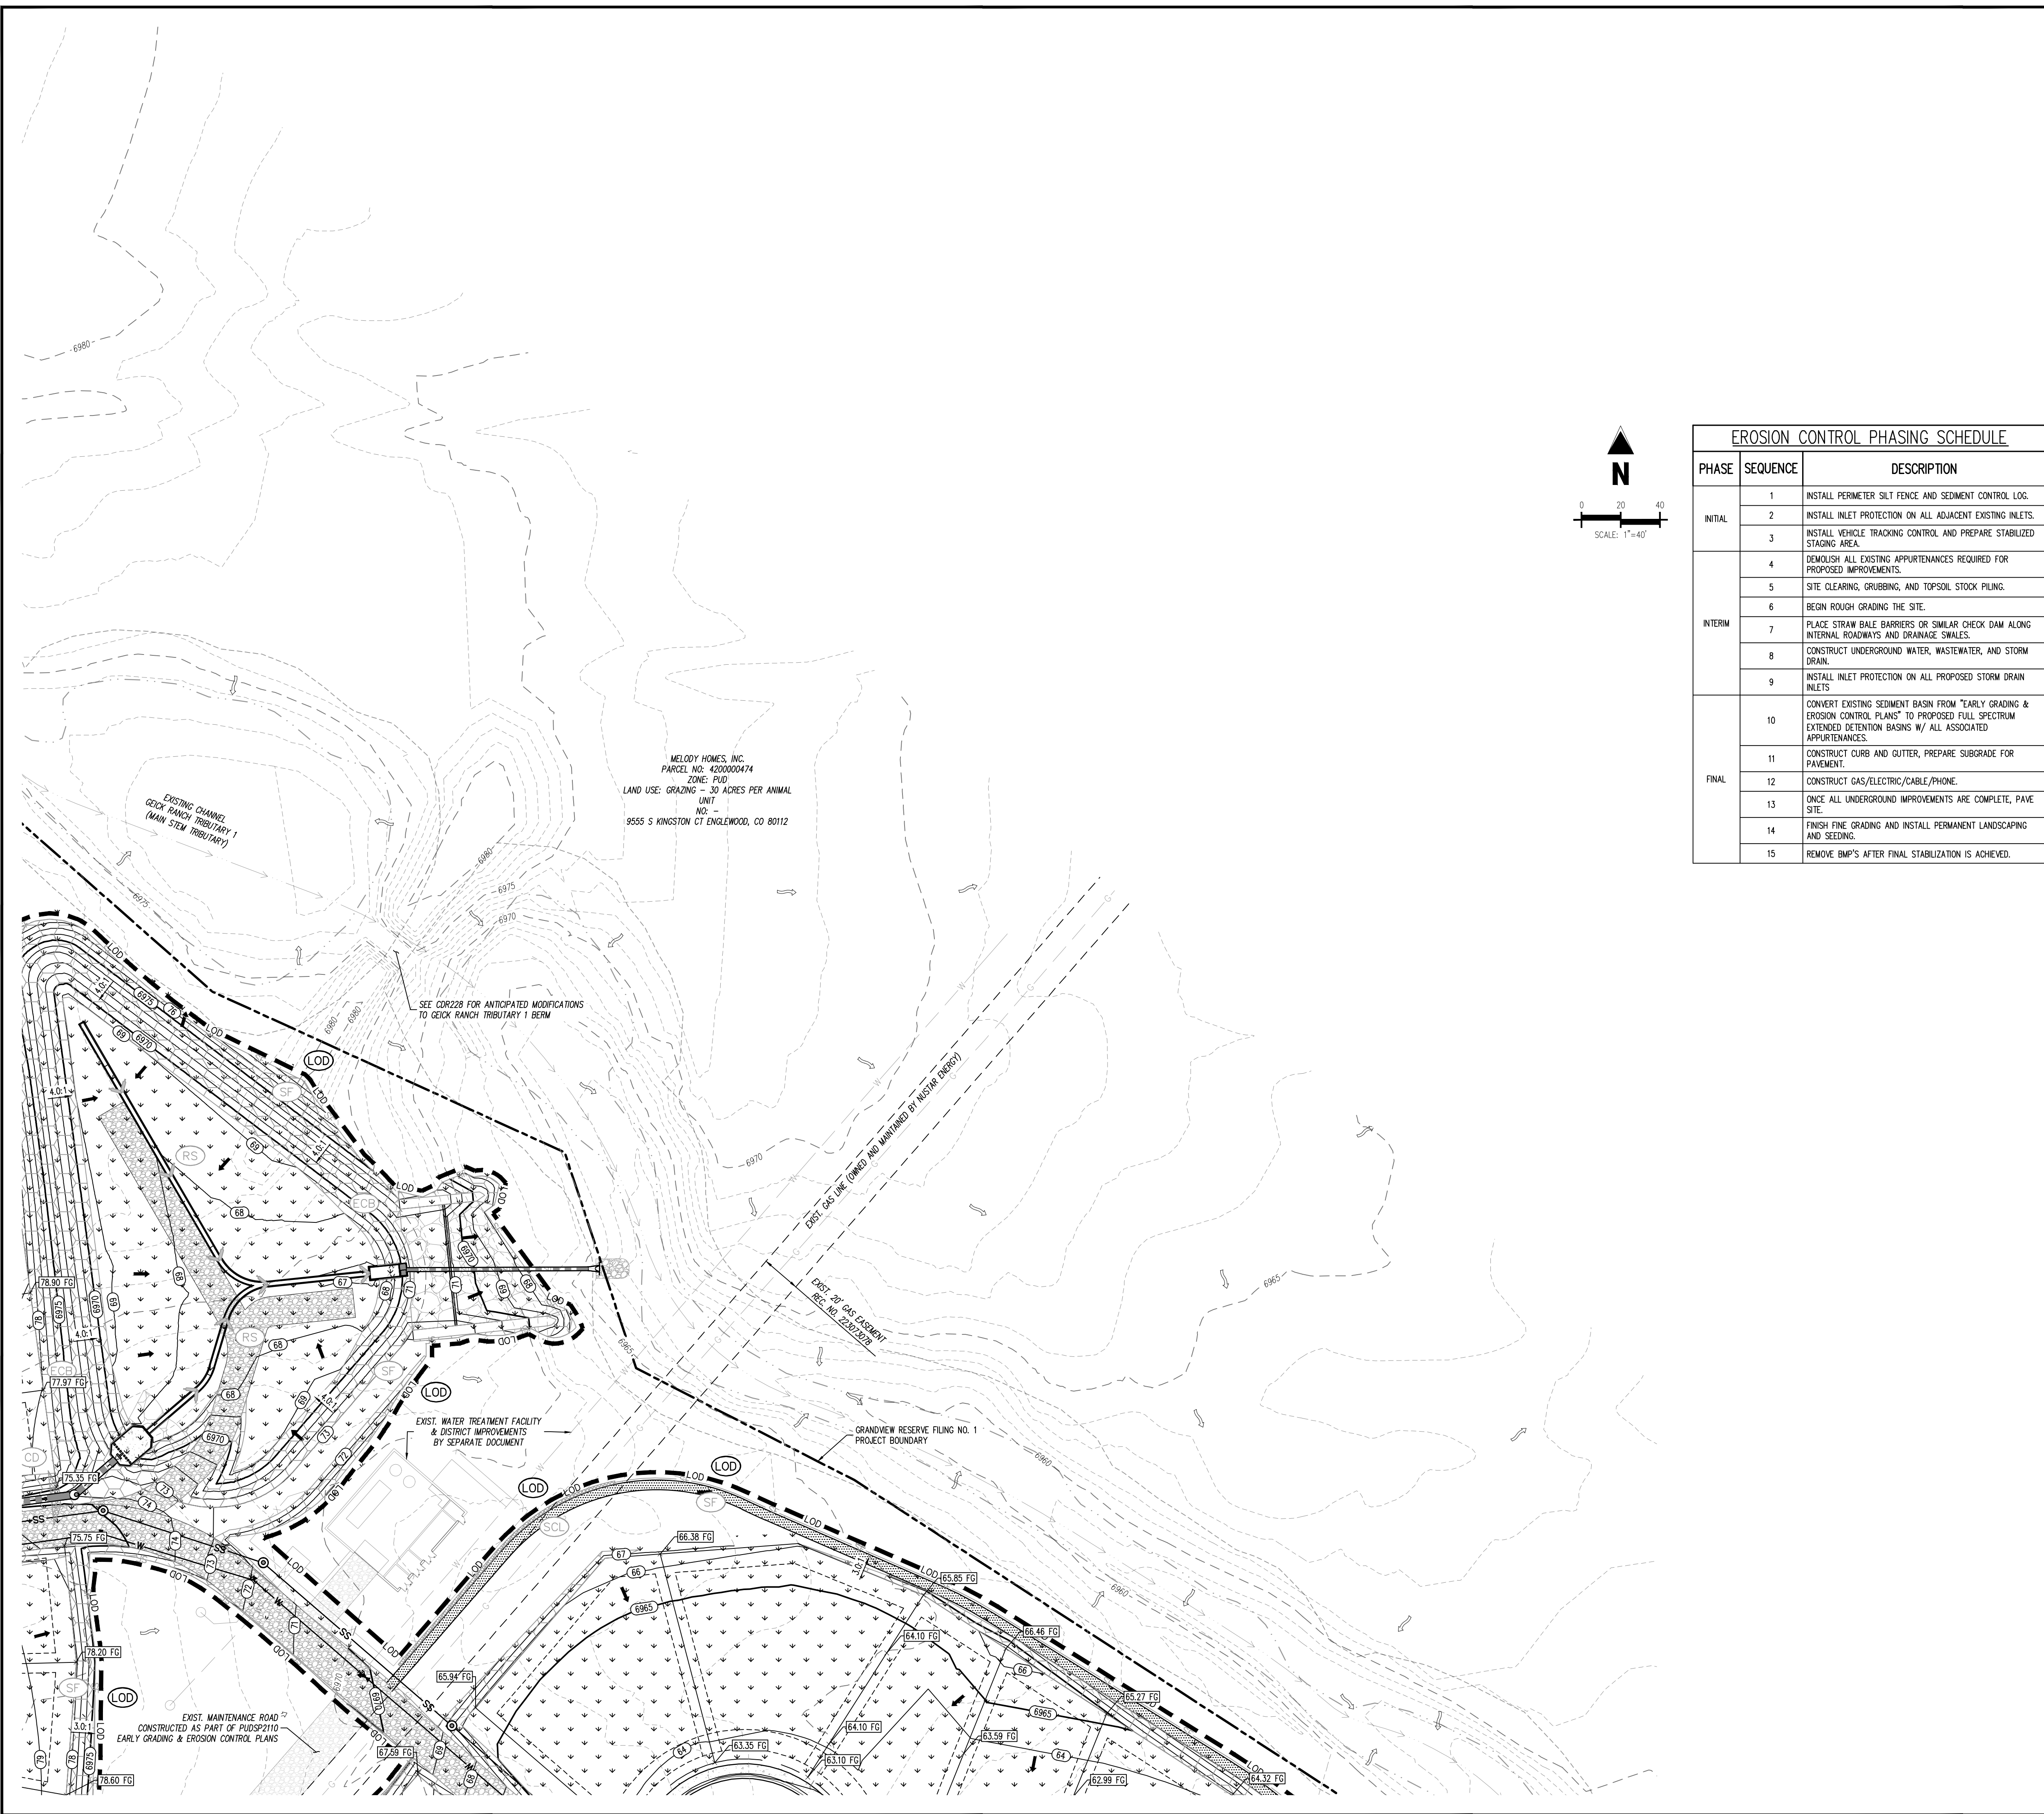

EROSION CONTROL PHASING SCHEDULE

PHASE	SEQUENCE	DESCRIPTION
INITIAL	1	INSTALL PERIMETER SILT FENCE AND SEDIMENT CONTROL LOG.
	2	INSTALL INLET PROTECTION ON ALL ADJACENT EXISTING INLETS.
	3	INSTALL VEHICLE TRACKING CONTROL AND PREPARE STABILIZED STAGING AREA.
INTERM	4	DEMOLISH ALL EXISTING APPURTENANCES REQUIRED FOR PROPOSED IMPROVEMENTS.
	5	SITE CLEARING, GRUBBING, AND TOPSOIL STOCK PILING.
	6	BEGIN ROUGH GRADING THE SITE.
	7	PLACE STRAW BALE BARRIERS OR SIMILAR CHECK DAM ALONG INTERNAL ROADWAYS AND DRAINAGE SWALES.
	8	CONSTRUCT UNDERGROUND WATER, WASTEWATER, AND STORM DRAIN.
	9	INSTALL INLET PROTECTION ON ALL PROPOSED STORM DRAIN INLETS.
FINAL	10	CONVERT EXISTING SEDIMENT BASIN FROM "EARLY GRADING & EROSION CONTROL PLANS" TO PROPOSED FULL SPECTRUM EXTENDED DETENTION BASINS W/ ALL ASSOCIATED APPURTENANCES.
	11	CONSTRUCT CURB AND GUTTER, PREPARE SUBGRADE FOR PAVEMENT.
	12	CONSTRUCT GAS/ELECTRIC/CABLE/PHONE.
	13	ONCE ALL UNDERGROUND IMPROVEMENTS ARE COMPLETE, PAVE SITE.
	14	FINISH FINE GRADING AND INSTALL PERMANENT LANDSCAPING AND SEEDING.
	15	REMOVE BMP'S AFTER FINAL STABILIZATION IS ACHIEVED.

EROSION CONTROL LEGEND

- 5460--- EXISTING MAJOR CONTOUR
- 52--- EXISTING MINOR CONTOUR
- G455--- PROPOSED MAJOR CONTOUR
- G6--- PROPOSED MINOR CONTOUR
- ===== EXISTING STORM SEWER
- ===== PROPOSED STORM SEWER
- SS--- EXISTING SANITARY SEWER
- SS--- PROPOSED SANITARY SEWER
- W--- PROPOSED WATER LINE
- G--- EXISTING GAS LINE
- G--- PROPOSED RIDGE LINE
- SW--- PROPOSED SWALE LINE
- SW--- EXISTING SWALE LINE
- FLOODPLAIN BOUNDARY
- EXISTING FLOOD ZONE
- EXISTING FLOOD ZONE SETBACK
- FLOW ARROW
- PROPOSED GRAVEL PER EOM TABLE D-7
- (LS) PERMANENT LANDSCAPING
- (DD) DIVERSION DITCH
- (LOD) LIMITS OF DISTURBANCE/CONSTRUCTION
- (VTC) VEHICLE TRACKING CONTROL
- (CWA) CONCRETE WASHOUT AREA
- (SSA) STABILIZED STAGING AREA
- (SM) SEED AND MULCH
- (SCL) SEDIMENT CONTROL LOG
- (IPS) SLUMP INLET PROTECTION (P-3)
- (IPD) ON-GRADE INLET PROTECTION (P-4)
- (RS) ROCK SOCKS
- (SF) SILT FENCE
- (CF) CONSTRUCTION FENCE
- (SB) SEDIMENT BASIN
- (CD) CHECK DAM
- (ECB) COMPOST BLANKET (APPROXIMATE)
- (RR) RIPRAP OUTFALL PADS
- (PT) PORTABLE TOILET
- (SITE) SITE POSTING (CONTACTS AND PERMITS)
- (WP) WASHOUT POSTING
- (SBB) STRAW BALE BARRIER
- (XX) EROSION MEASURE INSTALLED IN EARLIER PHASE
- (XX) PROPOSED EROSION MEASURE

BASIS OF BEARING
 THE NORTH LINE OF SECTION 28, TOWNSHIP 12 SOUTH, RANGE 64 WEST OF THE 6TH PRINCIPAL MERIDIAN, EL PASO COUNTY, STATE OF COLORADO BEING MONUMENTED AT EACH END BY A 3-1/2" ALUMINUM SURVEYORS CAP STAMPED "PSINC LS 30087" AND ASSUMED TO BEAR S89°47'04"E, A DISTANCE OF 5285.07 FEET.

BENCHMARK
 NOS BENCHMARK F 24
 A STANDARD DISK STAMPED F 24 1929 AND SET IN THE TOP OF A CONCRETE POST PROJECTING ABOUT 6 INCHES ABOVE GROUND, ALONG THE CHICAGO, ROCK ISLAND AND PACIFIC RAILROAD, 52 FEET NORTHWEST OF THE CENTERLINE OF U.S. HIGHWAY 24, 48 FEET SOUTHEAST OF THE CENTERLINE OF THE TRACK, NAVD88 ELEVATION = 6986.33

CAUTION - NOTICE TO CONTRACTOR

1. ALL UTILITY LOCATIONS SHOWN ARE BASED ON MAPS PROVIDED BY THE APPROPRIATE UTILITY COMPANY AND FIELD SURFACE EVIDENCE AT THE TIME OF SURVEY AND IS TO BE CONSIDERED AN APPROXIMATE LOCATION ONLY. IT IS THE CONTRACTOR'S RESPONSIBILITY TO FIELD VERIFY THE LOCATION OF ALL UTILITIES, PUBLIC OR PRIVATE, WHETHER SHOWN ON THE PLANS OR NOT, PRIOR TO CONSTRUCTION. REPORT ANY DISCREPANCIES TO THE ENGINEER PRIOR TO CONSTRUCTION.

2. WHERE A PROPOSED UTILITY CROSSES AN EXISTING UTILITY, IT IS THE CONTRACTOR'S RESPONSIBILITY TO FIELD VERIFY THE HORIZONTAL AND VERTICAL LOCATION OF SUCH EXISTING UTILITY, EITHER THROUGH POT-Holing OR ALTERNATIVE METHOD. REPORT INFORMATION TO THE ENGINEER PRIOR TO CONSTRUCTION.



COPYRIGHT
 THESE PLANS ARE AN INSTRUMENT OF SERVICE AND ARE THE PROPERTY OF GALLOWAY, AND MAY NOT BE DUPLICATED, DISCLOSED OR REPRODUCED WITHOUT THE WRITTEN CONSENT OF GALLOWAY. COPYRIGHTS AND INFINGEMENTS WILL BE ENFORCED AND PROSECUTED.

GRADING & EROSION CONTROL PLANS
GRANDVIEW RESERVE FILING NO. 1
MELODY HOMES, INC.
SF2311

EASTONVILLE RD & REX RD
 EL PASO COUNTY, FALCON, CO 80831


#	Date	Issue / Description	Init.

Project No: HRC02
 Drawn By: JDM, BLB
 Checked By: BAS, CMWJ
 Date: 03/15/2024

FINAL EROSION CONTROL PLAN

Check Dams (CD)

EC-12

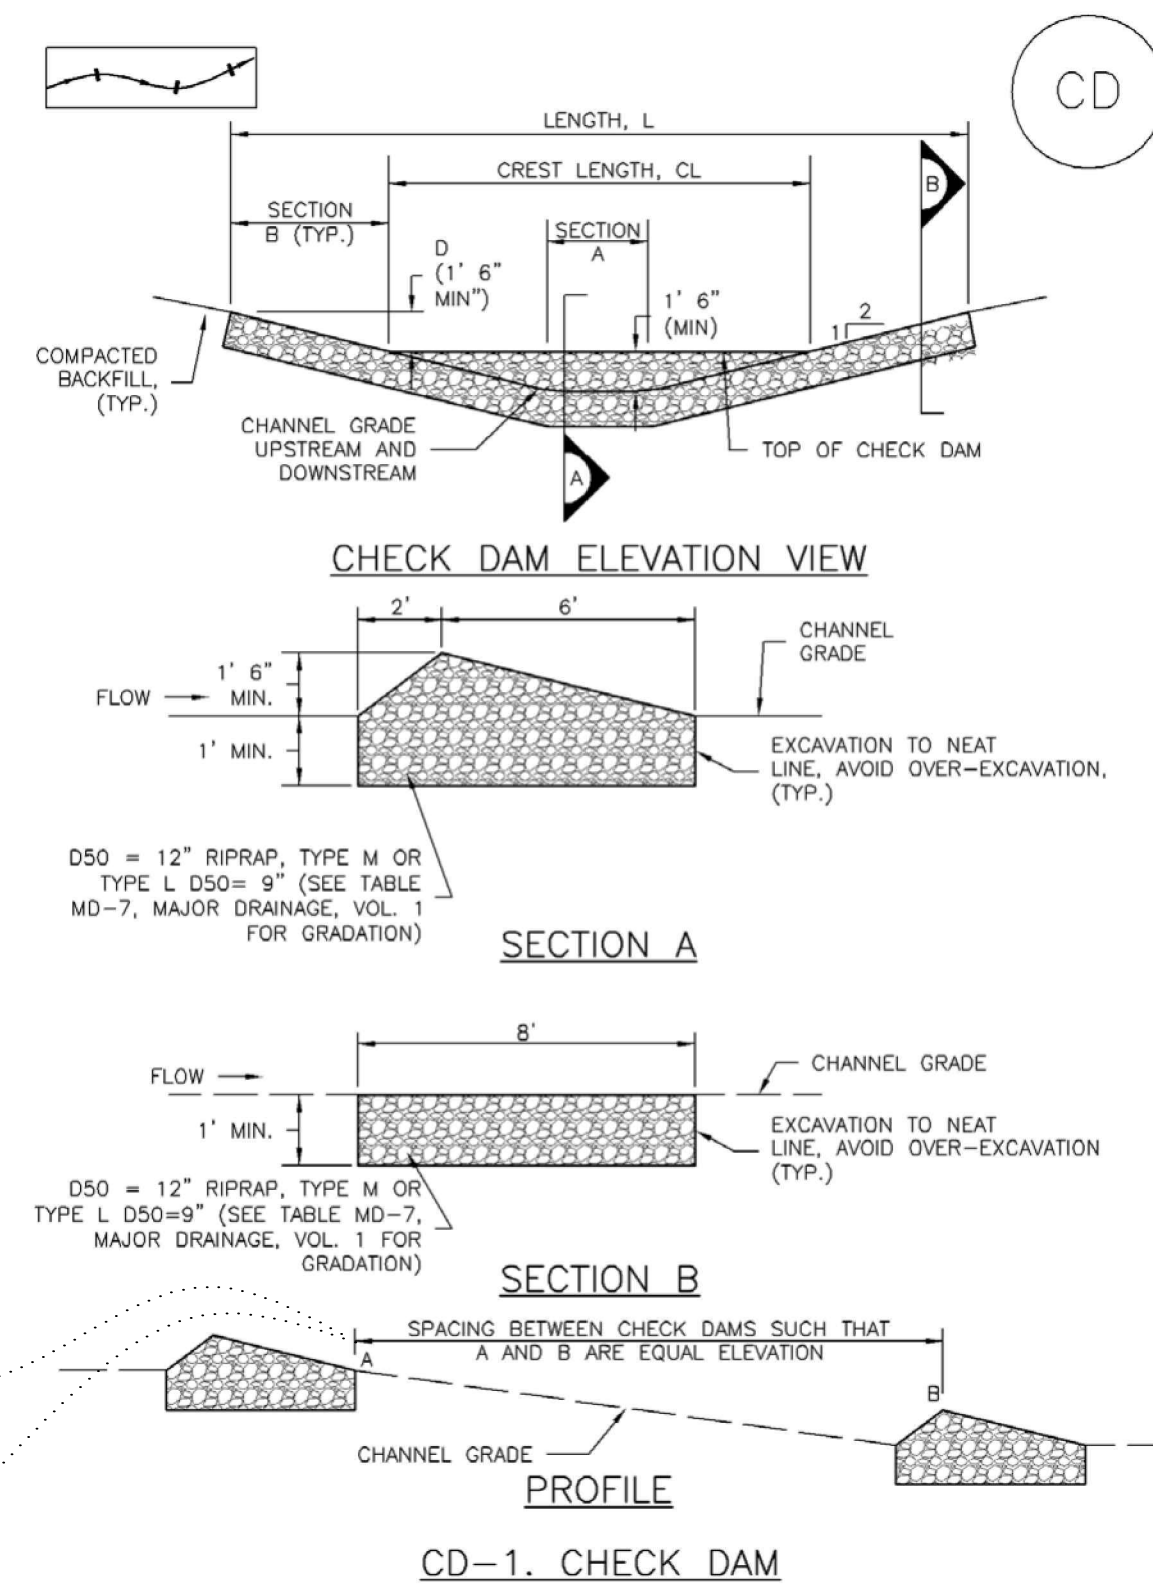


REQUIRED SPACING FOR CHECK DAMS	
SLOPE OF DITCH FLOW LINE	SPACING (FT) (H = 1.5 FT)
1%	150.00
2%	75.00
3%	50.00
4%	37.50
5%	30.00
6%	25.00
7%	21.50
8%	18.75

November 2010 Urban Drainage and Flood Control District Urban Storm Drainage Criteria Manual Volume 3 CD-3

Stockpile Management (SP)

MM-2

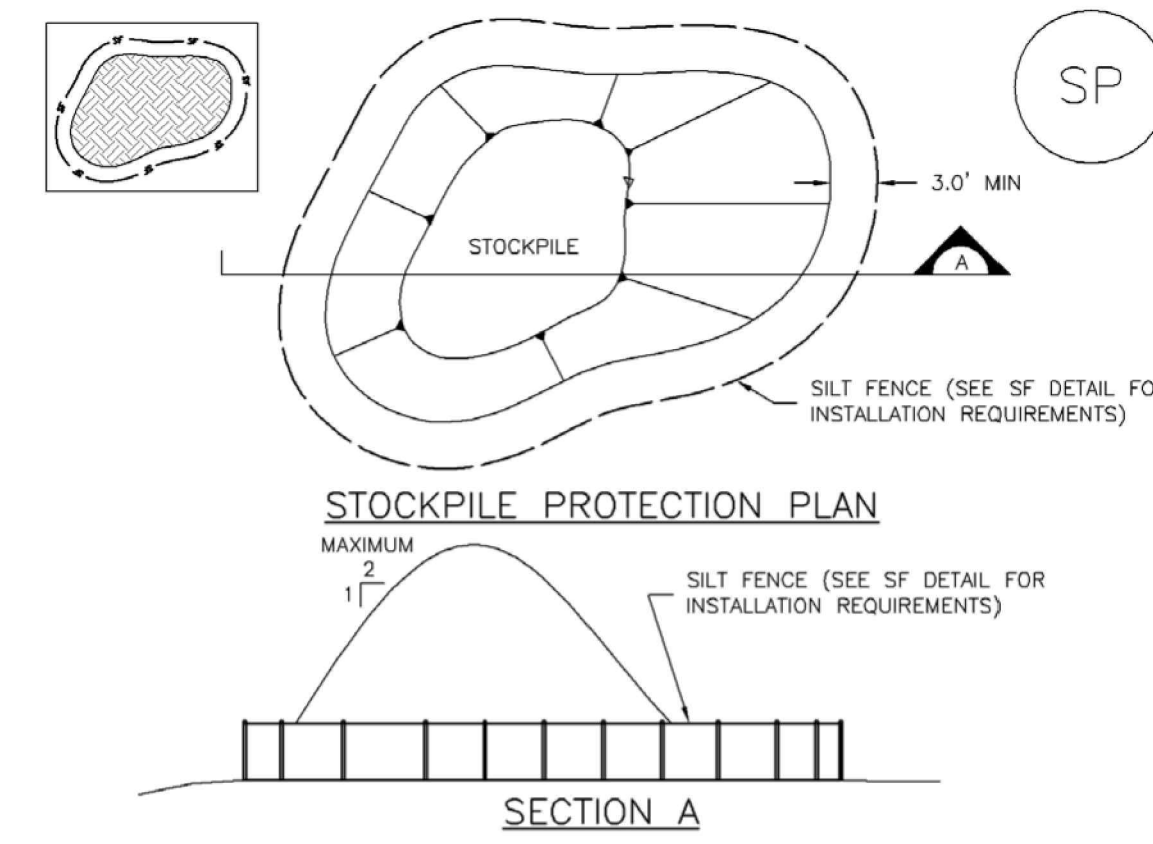

SP-1. STOCKPILE PROTECTION
STOCKPILE PROTECTION INSTALLATION NOTES
 1. SEE PLAN VIEW FOR:
 -LOCATION OF STOCKPILES.
 -TYPE OF STOCKPILE PROTECTION.
 2. INSTALL PERIMETER CONTROLS IN ACCORDANCE WITH THEIR RESPECTIVE DESIGN DETAILS. SILT FENCE IS SHOWN IN THE STOCKPILE PROTECTION DETAILS; HOWEVER, OTHER TYPES OF PERIMETER CONTROLS INCLUDING SEDIMENT CONTROL LOGS OR ROCK SOCKS MAY BE SUITABLE IN SOME CIRCUMSTANCES. CONSIDERATIONS FOR DETERMINING THE APPROPRIATE TYPE OF PERIMETER CONTROL FOR A STOCKPILE INCLUDE WHETHER THE STOCKPILE IS LOCATED ON A PERVIOUS OR IMPERVIOUS SURFACE, THE RELATIVE HEIGHTS OF THE PERIMETER CONTROL AND STOCKPILE, THE ABILITY OF THE PERIMETER CONTROL TO CONTAIN THE STOCKPILE WITHOUT FAILING IN THE EVENT THAT MATERIAL FROM THE STOCKPILE SHIFTS OR SLUMPS AGAINST THE PERIMETER, AND OTHER FACTORS.
 3. STABILIZE THE STOCKPILE SURFACE WITH SURFACE ROUGHENING, TEMPORARY SEEDING AND MULCHING, EROSION CONTROL BLANKETS, OR SOIL BINDERS. SOILS STOCKPILED FOR AN EXTENDED PERIOD (TYPICALLY FOR MORE THAN 60 DAYS) SHOULD BE SEEDING AND MULCHED WITH A TEMPORARY GRASS COVER ONCE THE STOCKPILE IS PLACED (TYPICALLY WITHIN 14 DAYS). USE OF MULCH ONLY OR A SOIL BINDER IS ACCEPTABLE IF THE STOCKPILE WILL BE IN PLACE FOR A MORE LIMITED TIME PERIOD (TYPICALLY 30-60 DAYS).
 4. FOR TEMPORARY STOCKPILES ON THE INTERIOR PORTION OF A CONSTRUCTION SITE, WHERE OTHER DOWNGRADIENT CONTROLS, INCLUDING PERIMETER CONTROL, ARE IN PLACE, STOCKPILE PERIMETER CONTROLS MAY NOT BE REQUIRED.

November 2010 Urban Drainage and Flood Control District Urban Storm Drainage Criteria Manual Volume 3 SP-3

EC-12

Check Dams (CD)

CHECK DAM INSTALLATION NOTES
 1. SEE PLAN VIEW FOR:
 -LOCATION OF CHECK DAMS.
 -CHECK DAM TYPE (CHECK DAM OR REINFORCED CHECK DAM).
 -LENGTH (L), CREST LENGTH (CL), AND DEPTH (D).
 2. CHECK DAMS INDICATED ON INITIAL SWMP SHALL BE INSTALLED AFTER CONSTRUCTION FENCE, BUT PRIOR TO ANY UPSTREAM LAND DISTURBING ACTIVITIES.
 3. RIPRAP UTILIZED FOR CHECK DAMS SHOULD BE OF APPROPRIATE SIZE FOR THE APPLICATION. TYPICAL TYPES OF RIPRAP USED FOR CHECK DAMS ARE TYPE M (D50 12") OR TYPE L (D50 9").
 4. RIPRAP PAD SHALL BE TRENCHED INTO THE GROUND A MINIMUM OF 1'.
 5. THE ENDS OF THE CHECK DAM SHALL BE A MINIMUM OF 1' 6" HIGHER THAN THE CENTER OF THE CHECK DAM.
CHECK DAM MAINTENANCE NOTES
 1. INSPECT BMPs EACH WORKDAY, AND MAINTAIN THEM IN EFFECTIVE OPERATING CONDITION. MAINTENANCE OF BMPs SHOULD BE PROACTIVE, NOT REACTIVE. INSPECT BMPs AS SOON AS POSSIBLE (AND ALWAYS WITHIN 24 HOURS) FOLLOWING A STORM THAT CAUSES SURFACE EROSION, AND PERFORM NECESSARY MAINTENANCE.
 2. FREQUENT OBSERVATIONS AND MAINTENANCE ARE NECESSARY TO MAINTAIN BMPs IN EFFECTIVE OPERATING CONDITION. INSPECTIONS AND CORRECTIVE MEASURES SHOULD BE DOCUMENTED THOROUGHLY.
 3. WHERE BMPs HAVE FAILED, REPAIR OR REPLACEMENT SHOULD BE INITIATED UPON DISCOVERY OF THE FAILURE.
 4. SEDIMENT ACCUMULATED UPSTREAM OF THE CHECK DAMS SHALL BE REMOVED WHEN THE SEDIMENT DEPTH IS WITHIN 1/2 OF THE HEIGHT OF THE CREST.
 5. CHECK DAMS ARE TO REMAIN IN PLACE UNTIL THE UPSTREAM DISTURBED AREA IS STABILIZED AND APPROVED BY THE LOCAL JURISDICTION.
 6. WHEN CHECK DAMS ARE REMOVED, EXCAVATIONS SHALL BE FILLED WITH SUITABLE COMPACTED BACKFILL. DISTURBED AREA SHALL BE SEEDING AND MULCHED AND COVERED WITH GEOTEXTILE OR OTHERWISE STABILIZED IN A MANNER APPROVED BY THE LOCAL JURISDICTION.
 (DETAILS ADAPTED FROM DOUGLAS COUNTY, COLORADO, NOT AVAILABLE IN AUTOCAD)
NOTE: MANY JURISDICTIONS HAVE BMP DETAILS THAT VARY FROM UDFCD STANDARD DETAILS. CONSULT WITH LOCAL JURISDICTIONS AS TO WHICH DETAIL SHOULD BE USED WHEN DIFFERENCES ARE NOTED.

CD-4 Urban Drainage and Flood Control District Urban Storm Drainage Criteria Manual Volume 3 November 2010

MM-2


Stockpile Management (SM)

STOCKPILE PROTECTION MAINTENANCE NOTES
 1. INSPECT BMPs EACH WORKDAY, AND MAINTAIN THEM IN EFFECTIVE OPERATING CONDITION. MAINTENANCE OF BMPs SHOULD BE PROACTIVE, NOT REACTIVE. INSPECT BMPs AS SOON AS POSSIBLE (AND ALWAYS WITHIN 24 HOURS) FOLLOWING A STORM THAT CAUSES SURFACE EROSION, AND PERFORM NECESSARY MAINTENANCE.
 2. FREQUENT OBSERVATIONS AND MAINTENANCE ARE NECESSARY TO MAINTAIN BMPs IN EFFECTIVE OPERATING CONDITION. INSPECTIONS AND CORRECTIVE MEASURES SHOULD BE DOCUMENTED THOROUGHLY.
 3. WHERE BMPs HAVE FAILED, REPAIR OR REPLACEMENT SHOULD BE INITIATED UPON DISCOVERY OF THE FAILURE.
STOCKPILE PROTECTION MAINTENANCE NOTES
 4. IF PERIMETER PROTECTION MUST BE MOVED TO ACCESS SOIL STOCKPILE, REPLACE PERIMETER CONTROLS BY THE END OF THE WORKDAY.
 5. STOCKPILE PERIMETER CONTROLS CAN BE REMOVED ONCE ALL THE MATERIAL FROM THE STOCKPILE HAS BEEN USED.
 (DETAILS ADAPTED FROM PARKER, COLORADO, NOT AVAILABLE IN AUTOCAD)
NOTE: MANY JURISDICTIONS HAVE BMP DETAILS THAT VARY FROM UDFCD STANDARD DETAILS. CONSULT WITH LOCAL JURISDICTIONS AS TO WHICH DETAIL SHOULD BE USED WHEN DIFFERENCES ARE NOTED.

SP-4 Urban Drainage and Flood Control District Urban Storm Drainage Criteria Manual Volume 3 November 2010

Concrete Washout Area (CWA)

MM-1

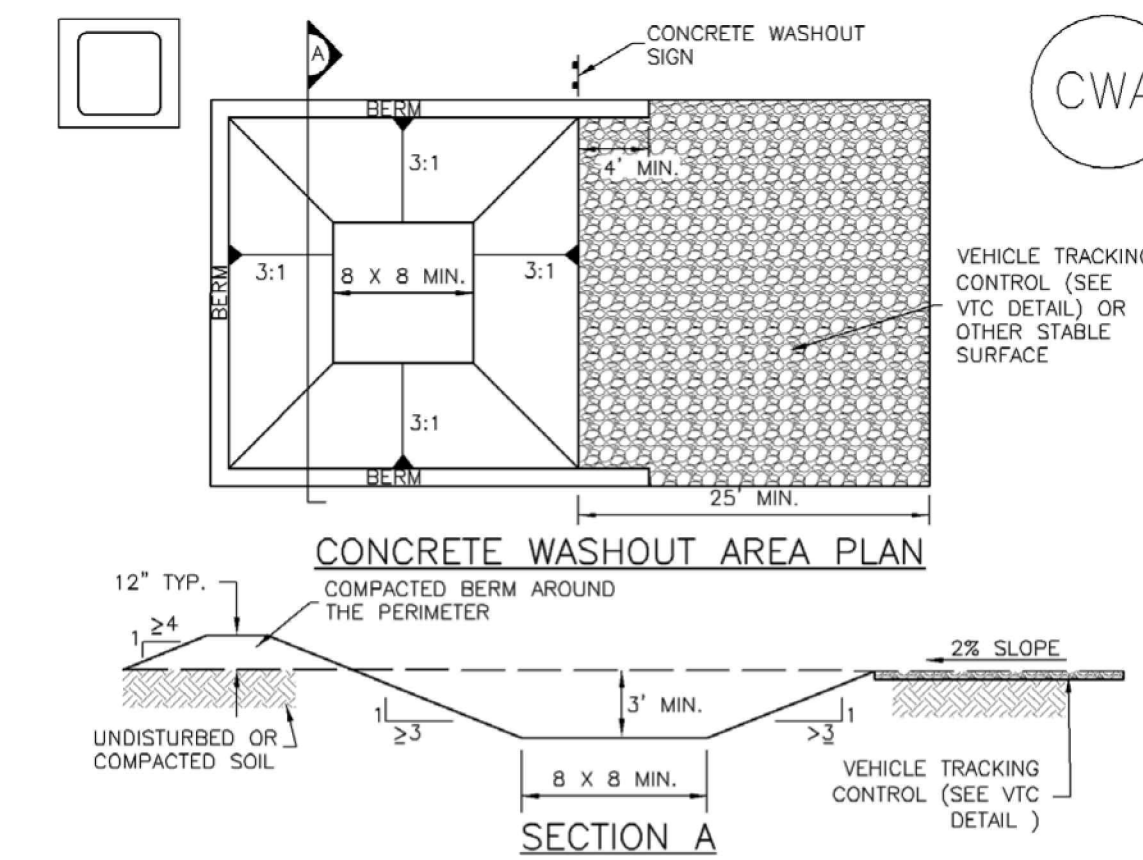

CWA-1. CONCRETE WASHOUT AREA
CWA INSTALLATION NOTES
 1. SEE PLAN VIEW FOR:
 -CWA INSTALLATION LOCATION.
 2. DO NOT LOCATE AN UNLINED CWA WITHIN 400' OF ANY NATURAL DRAINAGE PATHWAY OR WATERBODY. DO NOT LOCATE WITHIN 1,000' OF ANY WELLS OR DRINKING WATER SOURCES. IF SITE CONSTRAINTS MAKE THIS INFEASIBLE, OR IF HIGHLY PERMEABLE SOILS EXIST ON SITE, THE CWA MUST BE INSTALLED WITH AN IMPERMEABLE LINER (1/8 MIN. THICKNESS) OR SURFACE STORAGE ALTERNATIVES USING PREFABRICATED CONCRETE WASHOUT DEVICES OR A LINED ABOVE GROUND STORAGE ARE SHOULD BE USED.
 3. THE CWA SHALL BE INSTALLED PRIOR TO CONCRETE PLACEMENT ON SITE.
 4. CWA SHALL INCLUDE A FLAT SUBSURFACE PIT THAT IS AT LEAST 8' BY 8' SLOPES LEADING OUT OF THE SUBSURFACE PIT SHALL BE 3:1 OR FLATTER. THE PIT SHALL BE AT LEAST 3' DEEP.
 5. BERM SURROUNDING SIDES AND BACK OF THE CWA SHALL HAVE MINIMUM HEIGHT OF 1'.
 6. VEHICLE TRACKING PAD SHALL BE SLOPED 2% TOWARDS THE CWA.
 7. SIGNS SHALL BE PLACED AT THE CONSTRUCTION ENTRANCE, AT THE CWA, AND ELSEWHERE AS NECESSARY TO CLEARLY INDICATE THE LOCATION OF THE CWA TO OPERATORS OF CONCRETE TRUCKS AND PUMP RIGS.
 8. USE EXCAVATED MATERIAL FOR PERIMETER BERM CONSTRUCTION.

CWA-3 Urban Drainage and Flood Control District Urban Storm Drainage Criteria Manual Volume 3 November 2010

MM-1

Concrete Washout Area (CWA)

CWA MAINTENANCE NOTES
 1. INSPECT BMPs EACH WORKDAY, AND MAINTAIN THEM IN EFFECTIVE OPERATING CONDITION. MAINTENANCE OF BMPs SHOULD BE PROACTIVE, NOT REACTIVE. INSPECT BMPs AS SOON AS POSSIBLE (AND ALWAYS WITHIN 24 HOURS) FOLLOWING A STORM THAT CAUSES SURFACE EROSION, AND PERFORM NECESSARY MAINTENANCE.
 2. FREQUENT OBSERVATIONS AND MAINTENANCE ARE NECESSARY TO MAINTAIN BMPs IN EFFECTIVE OPERATING CONDITION. INSPECTIONS AND CORRECTIVE MEASURES SHOULD BE DOCUMENTED THOROUGHLY.
 3. WHERE BMPs HAVE FAILED, REPAIR OR REPLACEMENT SHOULD BE INITIATED UPON DISCOVERY OF THE FAILURE.
 4. THE CWA SHALL BE REPAIRED, CLEANED, OR ENLARGED AS NECESSARY TO MAINTAIN CAPACITY FOR CONCRETE WASTE. CONCRETE MATERIALS ACCUMULATED IN PIT, SHALL BE REMOVED ONCE THE MATERIALS HAVE REACHED A DEPTH OF 2'.
 5. CONCRETE WASHOUT WATER, WASTED PIECES OF CONCRETE AND ALL OTHER DEBRIS IN THE SUBSURFACE PIT SHALL BE TRANSPORTED FROM THE JOB SITE IN A WATER-TIGHT CONTAINER AND DISPOSED OF PROPERLY.
 6. THE CWA SHALL REMAIN IN PLACE UNTIL ALL CONCRETE FOR THE PROJECT IS PLACED.
 7. WHEN THE CWA IS REMOVED, COVER THE DISTURBED AREA WITH TOP SOIL, SEED AND MULCH OR OTHERWISE STABILIZED IN A MANNER APPROVED BY THE LOCAL JURISDICTION.
 (DETAIL ADAPTED FROM DOUGLAS COUNTY, COLORADO AND THE CITY OF PARKER, COLORADO, NOT AVAILABLE IN AUTOCAD)
NOTE: MANY JURISDICTIONS HAVE BMP DETAILS THAT VARY FROM UDFCD STANDARD DETAILS. CONSULT WITH LOCAL JURISDICTIONS AS TO WHICH DETAIL SHOULD BE USED WHEN DIFFERENCES ARE NOTED.

CWA-4 Urban Drainage and Flood Control District Urban Storm Drainage Criteria Manual Volume 3 November 2010

COPYRIGHT
 THESE PLANS ARE AN INSTRUMENT OF SERVICE AND ARE THE PROPERTY OF GALLOWAY, AND MAY NOT BE DUPLICATED, DISCLOSED, OR REPRODUCED WITHOUT THE WRITTEN CONSENT OF GALLOWAY. COPYRIGHTS AND INFRINGEMENTS WILL BE ENFORCED AND PROSECUTED.


#	Date	Issue / Description	Init.

Project No: HRG02
 Drawn By: JDM, BLB
 Checked By: BAS, CMWJ
 Date: 03/15/2024


EROSION CONTROL DETAILS

Silt Fence (SF)

SC-1

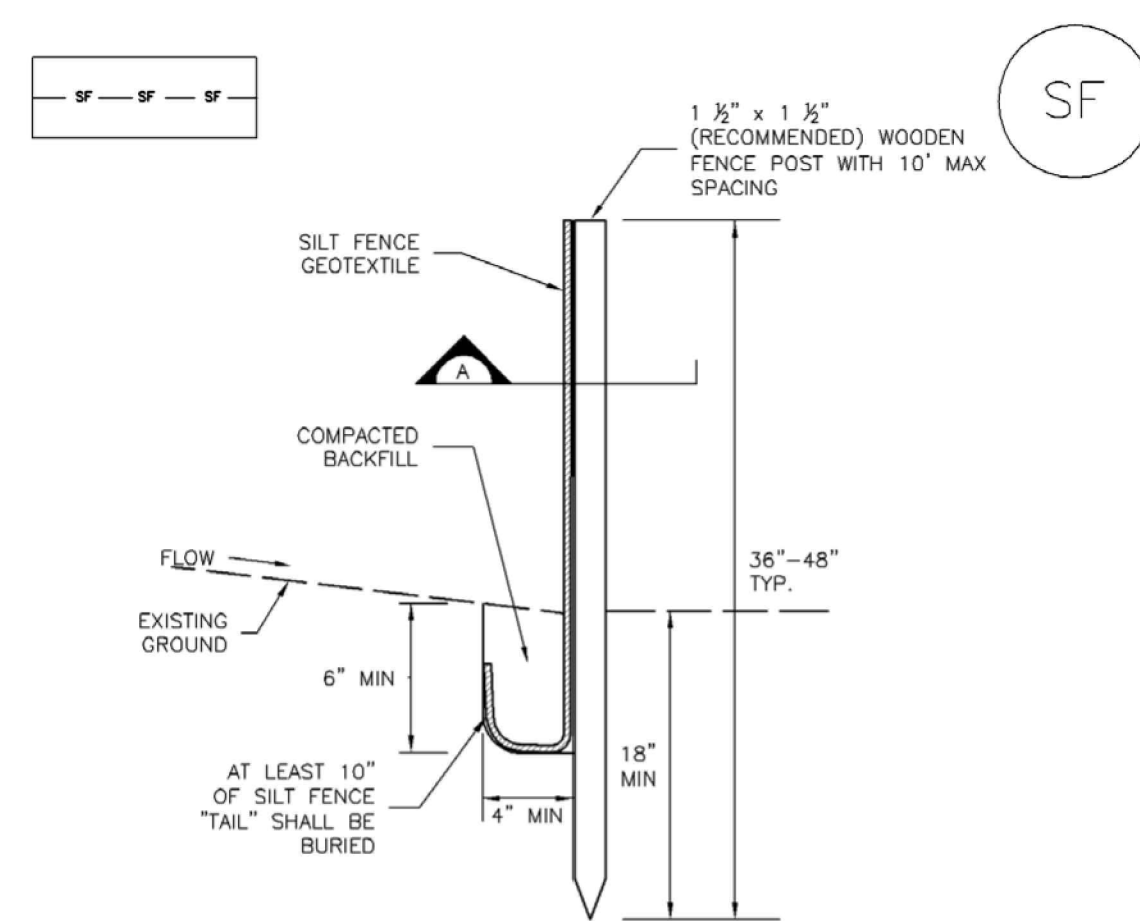

SILT FENCE

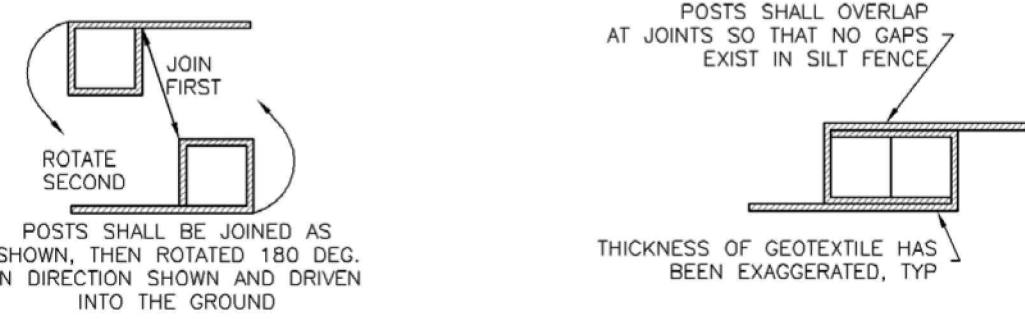

SECTION A

SF-1. SILT FENCE

November 2010 Urban Drainage and Flood Control District Urban Storm Drainage Criteria Manual Volume 3 SF-3

SC-1

Silt Fence (SF)

SILT FENCE INSTALLATION NOTES

- SILT FENCE MUST BE PLACED AWAY FROM THE TOE OF THE SLOPE TO ALLOW FOR WATER PONDING. SILT FENCE AT THE TOE OF A SLOPE SHOULD BE INSTALLED IN A FLAT LOCATION AT LEAST SEVERAL FEET (2-5 FT) FROM THE TOE OF THE SLOPE TO ALLOW ROOM FOR PONDING AND DEPOSITION.
- A UNIFORM 6" X 4" ANCHOR TRENCH SHALL BE EXCAVATED USING TRENCHER OR SILT FENCE INSTALLATION DEVICE. NO ROAD GRADERS, BACKHOES, OR SIMILAR EQUIPMENT SHALL BE USED.
- COMPACT ANCHOR TRENCH BY HAND WITH A "JUMPING JACK" OR BY WHEEL ROLLING. COMPACTION SHALL BE SUCH THAT SILT FENCE RESISTS BEING PULLED OUT OF ANCHOR TRENCH BY HAND.
- SILT FENCE SHALL BE PULLED TIGHT AS IT IS ANCHORED TO THE STAKES. THERE SHOULD BE NO NOTICEABLE SAG BETWEEN STAKES AFTER IT HAS BEEN ANCHORED TO THE STAKES.
- SILT FENCE FABRIC SHALL BE ANCHORED TO THE STAKES USING 1" HEAVY DUTY STAPLES OR NAILS WITH 1" HEADS. STAPLES AND NAILS SHOULD BE PLACED 3" ALONG THE FABRIC DOWN THE STAKE.
- AT THE END OF A RUN OF SILT FENCE ALONG A CONTOUR, THE SILT FENCE SHOULD BE TURNED PERPENDICULAR TO THE CONTOUR TO CREATE A "J-HOOK." THE "J-HOOK" EXTENDING PERPENDICULAR TO THE CONTOUR SHOULD BE OF SUFFICIENT LENGTH TO KEEP RUNOFF FROM FLOWING AROUND THE END OF THE SILT FENCE (TYPICALLY 10' - 20').
- SILT FENCE SHALL BE INSTALLED PRIOR TO ANY LAND DISTURBING ACTIVITIES.

SILT FENCE MAINTENANCE NOTES


- INSPECT BMPs EACH WORKDAY, AND MAINTAIN THEM IN EFFECTIVE OPERATING CONDITION. MAINTENANCE OF BMPs SHOULD BE PROACTIVE, NOT REACTIVE. INSPECT BMPs AS SOON AS POSSIBLE (AND ALWAYS WITHIN 24 HOURS) FOLLOWING A STORM THAT CAUSES SURFACE EROSION, AND PERFORM NECESSARY MAINTENANCE.
- FREQUENT OBSERVATIONS AND MAINTENANCE ARE NECESSARY TO MAINTAIN BMPs IN EFFECTIVE OPERATING CONDITION. INSPECTIONS AND CORRECTIVE MEASURES SHOULD BE DOCUMENTED THOROUGHLY.
- WHERE BMPs HAVE FAILED, REPAIR OR REPLACEMENT SHOULD BE INITIATED UPON DISCOVERY OF THE FAILURE.
- SEDIMENT ACCUMULATED UPSTREAM OF THE SILT FENCE SHALL BE REMOVED AS NEEDED TO MAINTAIN THE FUNCTIONALITY OF THE BMP, TYPICALLY WHEN DEPTH OF ACCUMULATED SEDIMENTS IS APPROXIMATELY 6".
- REPAIR OR REPLACE SILT FENCE WHEN THERE ARE SIGNS OF WEAR, SUCH AS SAGGING, TEARING, OR COLLAPSE.
- SILT FENCE IS TO REMAIN IN PLACE UNTIL THE UPSTREAM DISTURBED AREA IS STABILIZED AND APPROVED BY THE LOCAL JURISDICTION, OR IS REPLACED BY AN EQUIVALENT PERIMETER SEDIMENT CONTROL BMP.
- WHEN SILT FENCE IS REMOVED, ALL DISTURBED AREAS SHALL BE COVERED WITH TOPSOIL, SEEDED AND MULCHED OR OTHERWISE STABILIZED AS APPROVED BY LOCAL JURISDICTION.

(DETAIL ADAPTED FROM TOWN OF PARKER, COLORADO AND CITY OF AURORA, NOT AVAILABLE IN AUTOCAD)
 NOTE: MANY JURISDICTIONS HAVE BMP DETAILS THAT VARY FROM UDFCD STANDARD DETAILS. CONSULT WITH LOCAL JURISDICTIONS AS TO WHICH DETAIL SHOULD BE USED WHEN DIFFERENCES ARE NOTED.

November 2010 Urban Drainage and Flood Control District Urban Storm Drainage Criteria Manual Volume 3 SF-4


SC-5

Rock Sock (RS)

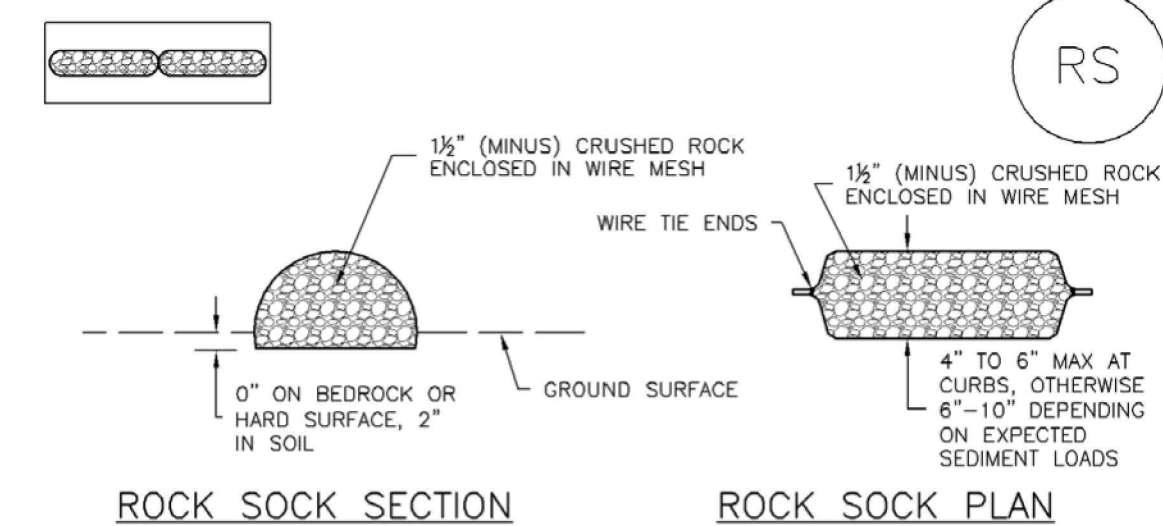

ROCK SOCK SECTION

ROCK SOCK PLAN

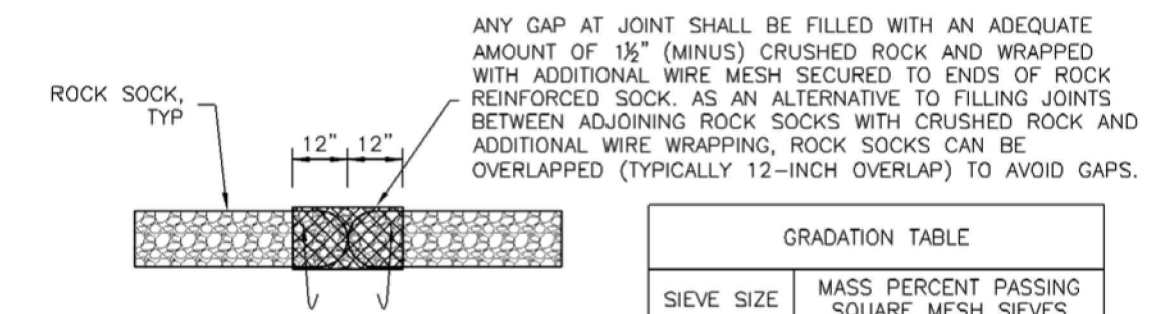

ROCK SOCK JOINTING

ROCK SOCK INSTALLATION NOTES

- SEE PLAN VIEW FOR: -LOCATION(S) OF ROCK SOCKS.
- CRUSHED ROCK SHALL BE 1 1/2" (MINUS) IN SIZE WITH A FRACTURED FACE (ALL SIDES) AND SHALL COMPLY WITH GRADATION SHOWN ON THIS SHEET (1 1/2" MINUS).
- WIRE MESH SHALL BE FABRICATED OF 10 GAGE POULTRY MESH, OR EQUIVALENT, WITH A MAXIMUM OPENING OF 1/2", RECOMMENDED MINIMUM ROLL WIDTH OF 48"
- WIRE MESH SHALL BE SECURED USING "HOG RINGS" OR WIRE TIES AT 6" CENTERS ALONG ALL JOINTS AND AT 2" CENTERS ON ENDS OF SOCKS.
- SOME MUNICIPALITIES MAY ALLOW THE USE OF FILTER FABRIC AS AN ALTERNATIVE TO WIRE MESH FOR THE ROCK ENCLOSURE.

GRADATION TABLE	
SIEVE SIZE	MASS PERCENT PASSING SQUARE MESH SIEVES
NO. 4	
2"	100
1 1/2"	90 - 100
1"	20 - 55
3/4"	0 - 15
3/8"	0 - 5


MATCHES SPECIFICATIONS FOR NO. 4 COARSE AGGREGATE FOR CONCRETE PER ASTM M43. ALL ROCK SHALL BE FRACTURED FACE, ALL SIDES.

RS-1. ROCK SOCK PERIMETER CONTROL

November 2010 Urban Drainage and Flood Control District Urban Storm Drainage Criteria Manual Volume 3 RS-2

SM-3

Construction Fence (CF)

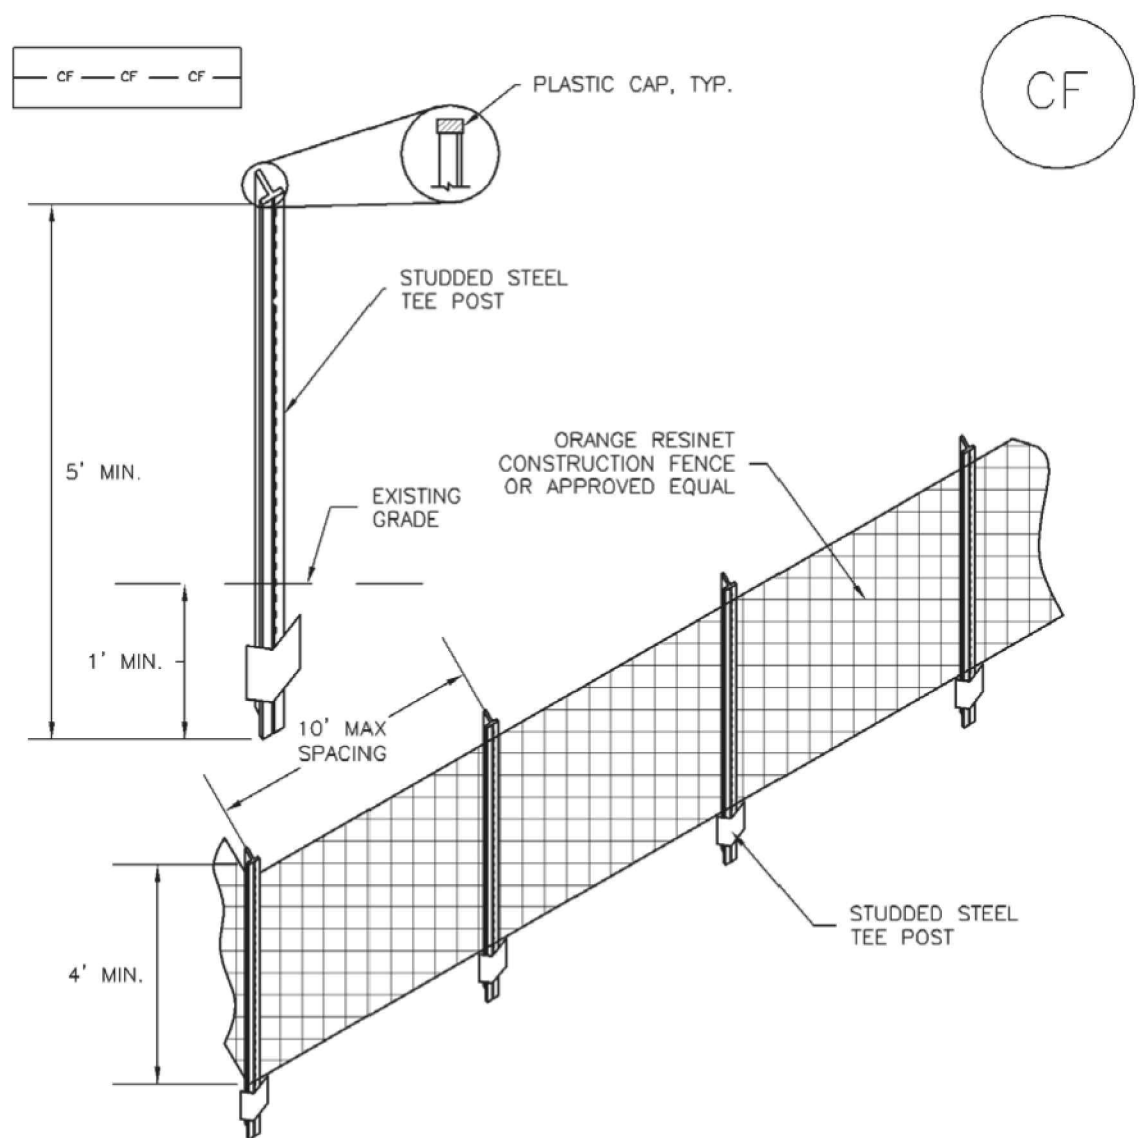

CF-1. PLASTIC MESH CONSTRUCTION FENCE

CONSTRUCTION FENCE INSTALLATION NOTES

- SEE PLAN VIEW FOR: -LOCATION OF CONSTRUCTION FENCE.
- CONSTRUCTION FENCE SHOWN SHALL BE INSTALLED PRIOR TO ANY LAND DISTURBING ACTIVITIES.
- CONSTRUCTION FENCE SHALL BE COMPOSED OF ORANGE, CONTRACTOR-GRADE MATERIAL THAT IS AT LEAST 4' HIGH. METAL POSTS SHOULD HAVE A PLASTIC CAP FOR SAFETY.
- STUDDER STEEL TEE POSTS SHALL BE UTILIZED TO SUPPORT THE CONSTRUCTION FENCE. MAXIMUM SPACING FOR STEEL TEE POSTS SHALL BE 10'.
- CONSTRUCTION FENCE SHALL BE SECURELY FASTENED TO THE TOP, MIDDLE, AND BOTTOM OF EACH POST.

November 2010 Urban Drainage and Flood Control District Urban Storm Drainage Criteria Manual Volume 3 CF-2

Construction Fence (CF)

SM-3

CONSTRUCTION FENCE MAINTENANCE NOTES

- INSPECT BMPs EACH WORKDAY, AND MAINTAIN THEM IN EFFECTIVE OPERATING CONDITION. MAINTENANCE OF BMPs SHOULD BE PROACTIVE, NOT REACTIVE. INSPECT BMPs AS SOON AS POSSIBLE (AND ALWAYS WITHIN 24 HOURS) FOLLOWING A STORM THAT CAUSES SURFACE EROSION, AND PERFORM NECESSARY MAINTENANCE.
- FREQUENT OBSERVATIONS AND MAINTENANCE ARE NECESSARY TO MAINTAIN BMPs IN EFFECTIVE OPERATING CONDITION. INSPECTIONS AND CORRECTIVE MEASURES SHOULD BE DOCUMENTED THOROUGHLY.
- WHERE BMPs HAVE FAILED, REPAIR OR REPLACEMENT SHOULD BE INITIATED UPON DISCOVERY OF THE FAILURE.
- CONSTRUCTION FENCE SHALL BE REPAIRED OR REPLACED WHEN THERE ARE SIGNS OF DAMAGE SUCH AS RIPS OR SAGS. CONSTRUCTION FENCE IS TO REMAIN IN PLACE UNTIL THE UPSTREAM DISTURBED AREA IS STABILIZED AND APPROVED BY THE LOCAL JURISDICTION.
- WHEN CONSTRUCTION FENCES ARE REMOVED, ALL DISTURBED AREAS ASSOCIATED WITH THE INSTALLATION, MAINTENANCE, AND/OR REMOVAL OF THE FENCE SHALL BE COVERED WITH TOPSOIL, SEEDED AND MULCHED, OR OTHERWISE STABILIZED AS APPROVED BY LOCAL JURISDICTION.

(DETAIL ADAPTED FROM TOWN OF PARKER, COLORADO AND CITY OF AURORA, NOT AVAILABLE IN AUTOCAD)
 NOTE: MANY JURISDICTIONS HAVE BMP DETAILS THAT VARY FROM UDFCD STANDARD DETAILS. CONSULT WITH LOCAL JURISDICTIONS AS TO WHICH DETAIL SHOULD BE USED WHEN DIFFERENCES ARE NOTED.

November 2010 Urban Drainage and Flood Control District Urban Storm Drainage Criteria Manual Volume 3 CF-3

Rock Sock (RS)

SC-5

ROCK SOCK MAINTENANCE NOTES

- INSPECT BMPs EACH WORKDAY, AND MAINTAIN THEM IN EFFECTIVE OPERATING CONDITION. MAINTENANCE OF BMPs SHOULD BE PROACTIVE, NOT REACTIVE. INSPECT BMPs AS SOON AS POSSIBLE (AND ALWAYS WITHIN 24 HOURS) FOLLOWING A STORM THAT CAUSES SURFACE EROSION, AND PERFORM NECESSARY MAINTENANCE.
- FREQUENT OBSERVATIONS AND MAINTENANCE ARE NECESSARY TO MAINTAIN BMPs IN EFFECTIVE OPERATING CONDITION. INSPECTIONS AND CORRECTIVE MEASURES SHOULD BE DOCUMENTED THOROUGHLY.
- WHERE BMPs HAVE FAILED, REPAIR OR REPLACEMENT SHOULD BE INITIATED UPON DISCOVERY OF THE FAILURE.
- ROCK SOCKS SHALL BE REPLACED IF THEY BECOME HEAVILY SOILED, OR DAMAGED BEYOND REPAIR.
- SEDIMENT ACCUMULATED UPSTREAM OF ROCK SOCKS SHALL BE REMOVED AS NEEDED TO MAINTAIN FUNCTIONALITY OF THE BMP. TYPICALLY WHEN DEPTH OF ACCUMULATED SEDIMENTS IS APPROXIMATELY 1/2 OF THE HEIGHT OF THE ROCK SOCK.
- ROCK SOCKS ARE TO REMAIN IN PLACE UNTIL THE UPSTREAM DISTURBED AREA IS STABILIZED AND APPROVED BY THE LOCAL JURISDICTION.
- WHEN ROCK SOCKS ARE REMOVED, ALL DISTURBED AREAS SHALL BE COVERED WITH TOPSOIL, SEEDED AND MULCHED OR OTHERWISE STABILIZED AS APPROVED BY LOCAL JURISDICTION.

(DETAIL ADAPTED FROM TOWN OF PARKER, COLORADO AND CITY OF AURORA, NOT AVAILABLE IN AUTOCAD)
 NOTE: MANY JURISDICTIONS HAVE BMP DETAILS THAT VARY FROM UDFCD STANDARD DETAILS. CONSULT WITH LOCAL JURISDICTIONS AS TO WHICH DETAIL SHOULD BE USED WHEN DIFFERENCES ARE NOTED.

NOTE: THE DETAILS INCLUDED WITH THIS FACT SHEET SHOW COMMONLY USED, CONVENTIONAL METHODS OF ROCK SOCK INSTALLATION IN THE DENVER METROPOLITAN AREA. THERE ARE MANY OTHER SIMILAR PROPRIETARY PRODUCTS ON THE MARKET. UDFCD NEITHER ENDORSES NOR DISCOURAGES USE OF PROPRIETARY PROTECTION PRODUCTS. HOWEVER, IN THE EVENT PROPRIETARY METHODS ARE USED, THE APPROPRIATE DETAIL FROM THE MANUFACTURER MUST BE INCLUDED IN THE SWMP AND THE BMP MUST BE INSTALLED AND MAINTAINED AS SHOWN IN THE MANUFACTURER'S DETAILS.


November 2010 Urban Drainage and Flood Control District Urban Storm Drainage Criteria Manual Volume 3 RS-3

COPYRIGHT
 THESE PLANS ARE AN INSTRUMENT OF SERVICE AND ARE THE PROPERTY OF GALLOWAY, AND MAY NOT BE DUPLICATED, DISCLOSED, OR REPRODUCED WITHOUT THE WRITTEN CONSENT OF GALLOWAY. COPYRIGHTS AND INFRINGEMENTS WILL BE ENFORCED AND PROSECUTED.

#	Date	Issue / Description	Init.


Project No: HRG02
 Drawn By: JDM, BLB
 Checked By: BAS, CMWJ
 Date: 03/15/2024

EROSION CONTROL
 DETAILS

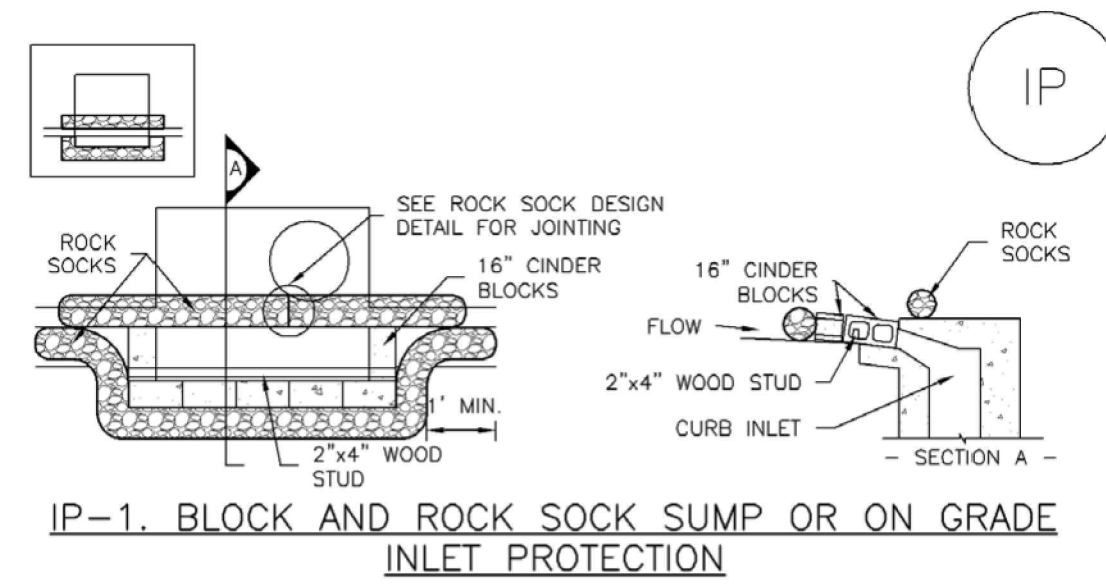

BLOCK AND CURB SOCK INLET PROTECTION INSTALLATION NOTES

1. SEE ROCK SOCK DESIGN DETAIL FOR INSTALLATION REQUIREMENTS.
2. CONCRETE "CINDER" BLOCKS SHALL BE LAID ON THEIR SIDES AROUND THE INLET IN A SINGLE ROW, ABUTTING ONE ANOTHER WITH THE OPEN END FACING AWAY FROM THE CURB.
3. GRAVEL BAGS SHALL BE PLACED AROUND CONCRETE BLOCKS, CLOSELY ABUTTING ONE ANOTHER AND JOINED TOGETHER IN ACCORDANCE WITH ROCK SOCK DESIGN DETAIL.

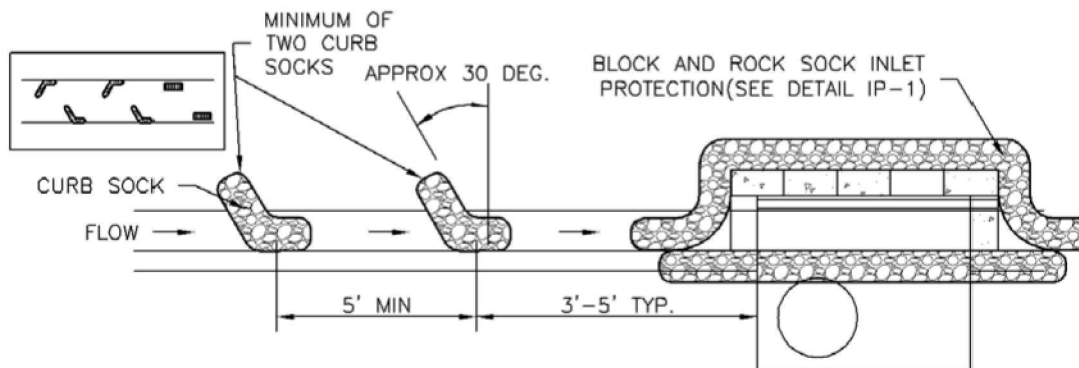


IP-2. CURB ROCK SOCKS UPSTREAM OF INLET PROTECTION

CURB ROCK SOCK INLET PROTECTION INSTALLATION NOTES

1. SEE ROCK SOCK DESIGN DETAIL INSTALLATION REQUIREMENTS.
2. PLACEMENT OF THE SOCK SHALL BE APPROXIMATELY 30 DEGREES FROM PERPENDICULAR IN THE OPPOSITE DIRECTION OF FLOW.
3. SOCKS ARE TO BE FLUSH WITH THE CURB AND SPACED A MINIMUM OF 5 FEET APART.
4. AT LEAST TWO CURB SOCKS IN SERIES ARE REQUIRED UPSTREAM OF ON-GRADE INLETS.


IP-4 Urban Drainage and Flood Control District August 2013 Urban Storm Drainage Criteria Manual Volume 3

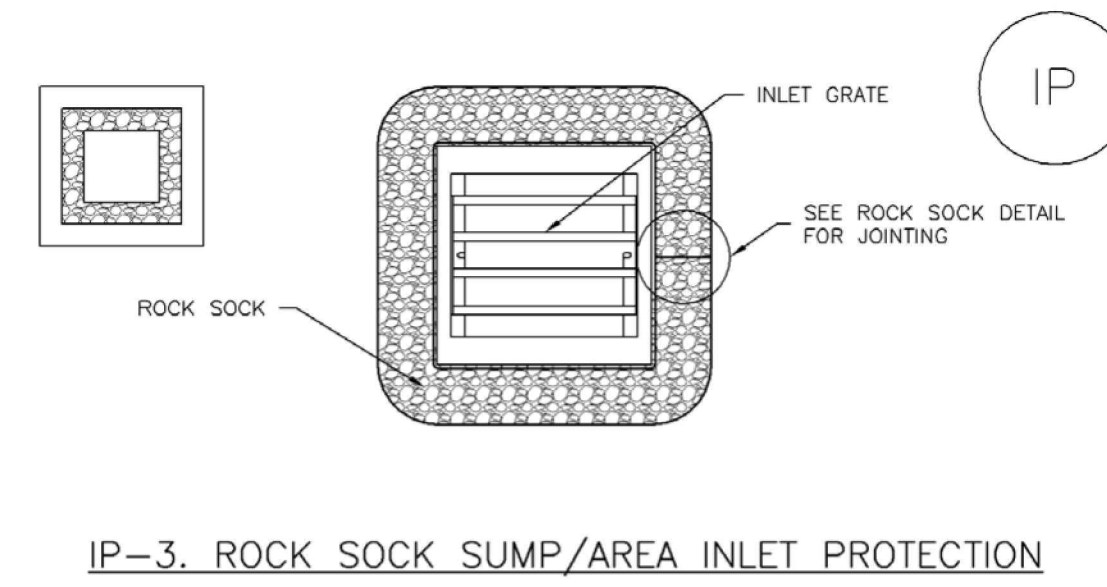

IP-3. ROCK SOCK SUMP/AREA INLET PROTECTION

ROCK SOCK SUMP/AREA INLET PROTECTION INSTALLATION NOTES

1. SEE ROCK SOCK DESIGN DETAIL FOR INSTALLATION REQUIREMENTS.
2. STRAW WATTLES/SEDIMENT CONTROL LOGS MAY BE USED IN PLACE OF ROCK SOCKS FOR INLETS IN PERVIOUS AREAS. INSTALL PER SEDIMENT CONTROL LOG DETAIL.

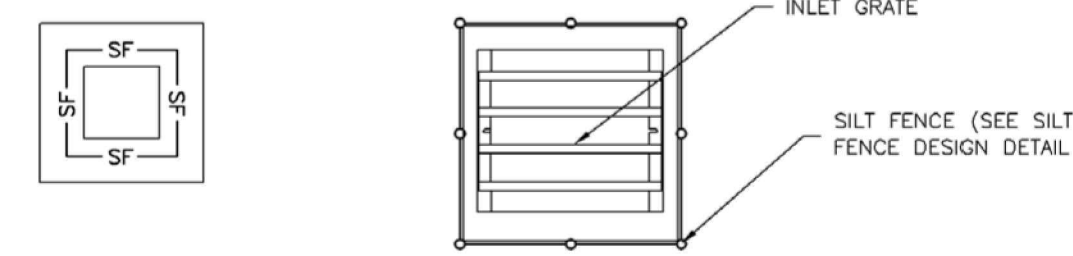

IP-4. SILT FENCE FOR SUMP INLET PROTECTION

SILT FENCE INLET PROTECTION INSTALLATION NOTES

1. SEE SILT FENCE DESIGN DETAIL FOR INSTALLATION REQUIREMENTS.
2. POSTS SHALL BE PLACED AT EACH CORNER OF THE INLET AND AROUND THE EDGES AT A MAXIMUM SPACING OF 3 FEET.
3. STRAW WATTLES/SEDIMENT CONTROL LOGS MAY BE USED IN PLACE OF SILT FENCE FOR INLETS IN PERVIOUS AREAS. INSTALL PER SEDIMENT CONTROL LOG DETAIL.

August 2013 Urban Drainage and Flood Control District August 2013 Urban Storm Drainage Criteria Manual Volume 3 IP-5

GENERAL INLET PROTECTION INSTALLATION NOTES

1. SEE PLAN VIEW FOR:
 - LOCATION OF INLET PROTECTION.
 - TYPE OF INLET PROTECTION (IP.1, IP.2, IP.3, IP.4, IP.5, IP.6)
2. INLET PROTECTION SHALL BE INSTALLED PROMPTLY AFTER INLET CONSTRUCTION OR PAVING IS COMPLETE (TYPICALLY WITHIN 48 HOURS). IF A RAINFALL/RUNOFF EVENT IS FORECAST, INSTALL INLET PROTECTION PRIOR TO ONSET OF EVENT.
3. MANY JURISDICTIONS HAVE BMP DETAILS THAT VARY FROM UDFCD STANDARD DETAILS. CONSULT WITH LOCAL JURISDICTIONS AS TO WHICH DETAIL SHOULD BE USED WHEN DIFFERENCES ARE NOTED.

INLET PROTECTION MAINTENANCE NOTES

1. INSPECT BMPs EACH WORKDAY, AND MAINTAIN THEM IN EFFECTIVE OPERATING CONDITION. MAINTENANCE OF BMPs SHOULD BE PROACTIVE, NOT REACTIVE. INSPECT BMPs AS SOON AS POSSIBLE (AND ALWAYS WITHIN 24 HOURS) FOLLOWING A STORM THAT CAUSES SURFACE EROSION, AND PERFORM NECESSARY MAINTENANCE.
2. FREQUENT OBSERVATIONS AND MAINTENANCE ARE NECESSARY TO MAINTAIN BMPs IN EFFECTIVE OPERATING CONDITION. INSPECTIONS AND CORRECTIVE MEASURES SHOULD BE DOCUMENTED THOROUGHLY.
3. WHERE BMPs HAVE FAILED, REPAIR OR REPLACEMENT SHOULD BE INITIATED UPON DISCOVERY OF THE FAILURE.
4. SEDIMENT ACCUMULATED UPSTREAM OF INLET PROTECTION SHALL BE REMOVED AS NECESSARY TO MAINTAIN BMP EFFECTIVENESS, TYPICALLY WHEN STORAGE VOLUME REACHES 50% OF CAPACITY, A DEPTH OF 6" WHEN SILT FENCE IS USED, OR 1/4 OF THE HEIGHT FOR STRAW BALES.
5. INLET PROTECTION IS TO REMAIN IN PLACE UNTIL THE UPSTREAM DISTURBED AREA IS PERMANENTLY STABILIZED, UNLESS THE LOCAL JURISDICTION APPROVES EARLIER REMOVAL OF INLET PROTECTION IN STREETS.
6. WHEN INLET PROTECTION AT AREA INLETS IS REMOVED, THE DISTURBED AREA SHALL BE COVERED WITH TOP SOIL, SEEDED AND MULCHED, OR OTHERWISE STABILIZED IN A MANNER APPROVED BY THE LOCAL JURISDICTION.


(DETAIL ADAPTED FROM TOWN OF PARKER, COLORADO AND CITY OF AURORA, COLORADO, NOT AVAILABLE IN AUTOCAD)

NOTE: MANY JURISDICTIONS HAVE BMP DETAILS THAT VARY FROM UDFCD STANDARD DETAILS. CONSULT WITH LOCAL JURISDICTIONS AS TO WHICH DETAIL SHOULD BE USED WHEN DIFFERENCES ARE NOTED.

NOTE: THE DETAILS INCLUDED WITH THIS FACT SHEET SHOW COMMONLY USED, CONVENTIONAL METHODS OF INLET PROTECTION IN THE DENVER METROPOLITAN AREA. THERE ARE MANY PROPRIETARY INLET PROTECTION METHODS ON THE MARKET. UDFCD NEITHER ENDORSES NOR DISCOURAGES USE OF PROPRIETARY INLET PROTECTION; HOWEVER, IN THE EVENT PROPRIETARY METHODS ARE USED, THE APPROPRIATE DETAIL FROM THE MANUFACTURER MUST BE INCLUDED IN THE SWMP AND THE BMP MUST BE INSTALLED AND MAINTAINED AS SHOWN IN THE MANUFACTURER'S DETAILS.

NOTE: SOME MUNICIPALITIES DISCOURAGE OR PROHIBIT THE USE OF STRAW BALES FOR INLET PROTECTION. CHECK WITH LOCAL JURISDICTION TO DETERMINE IF STRAW BALE INLET PROTECTION IS ACCEPTABLE.

IP-8 Urban Drainage and Flood Control District August 2013 Urban Storm Drainage Criteria Manual Volume 3

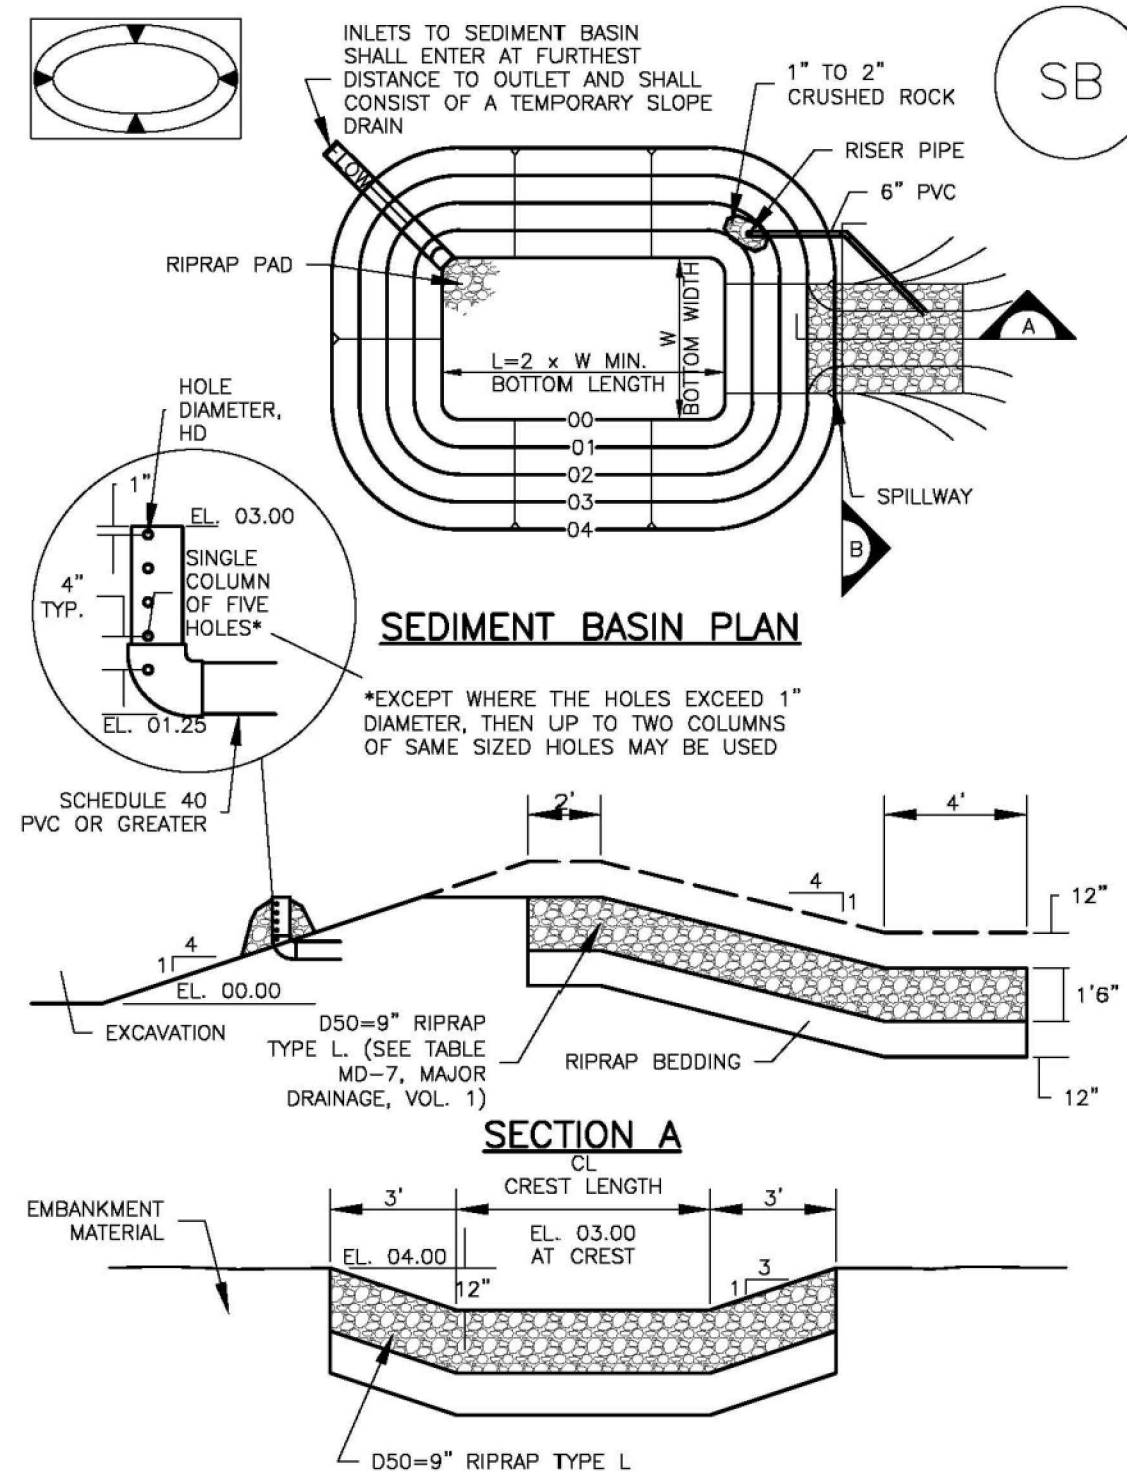

August 2013 Urban Drainage and Flood Control District August 2013 Urban Storm Drainage Criteria Manual Volume 3 SB-5

Upstream Drainage Area (rounded to nearest acre), (ac)	Basin Bottom Width (W), (ft)	Spillway Crest Length (CL), (ft)	Hole Diameter (HD), (in)
1	12 1/2	2	9/32
2	21	3	15/64
3	28	5	1/8
4	33 1/2	6	9/16
5	38 1/2	8	5/8
6	43	9	3/4
7	47 1/4	11	7/8
8	51	12	1 1/8
9	55	13	1 1/4
10	58 1/2	15	1 5/16
11	61	16	1 3/8
12	64	18	1 7/8
13	67 1/2	19	1 7/8
14	70 1/2	21	1 3/4
15	73 1/2	22	1 3/4

SEDIMENT BASIN INSTALLATION NOTES

1. SEE PLAN VIEW FOR:
 - LOCATION OF SEDIMENT BASIN.
 - TYPE OF BASIN (STANDARD BASIN OR NONSTANDARD BASIN).
 - FOR STANDARD BASIN, BOTTOM WIDTH W, CREST LENGTH CL, AND HOLE DIAMETER, HD.
 - FOR NONSTANDARD BASIN, SEE CONSTRUCTION DRAWINGS FOR DESIGN OF BASIN INCLUDING RISER HEIGHT H, NUMBER OF COLUMNS N, HOLE DIAMETER HD AND PIPE DIAMETER D.
2. FOR STANDARD BASIN, BOTTOM DIMENSION MAY BE MODIFIED AS LONG AS BOTTOM AREA IS NOT REDUCED.
3. SEDIMENT BASINS SHALL BE INSTALLED PRIOR TO ANY OTHER LAND-DISTURBING ACTIVITY THAT RELIES ON BASINS AS A STORMWATER CONTROL.
4. EMBANKMENT MATERIAL SHALL CONSIST OF SOIL FREE OF DEBRIS, ORGANIC MATERIAL, AND ROCKS OR CONCRETE GREATER THAN 3 INCHES AND SHALL HAVE A MINIMUM OF 15 PERCENT BY WEIGHT PASSING THE NO. 200 SIEVE.
5. EMBANKMENT MATERIAL SHALL BE COMPACTED TO AT LEAST 95 PERCENT OF MAXIMUM DENSITY IN ACCORDANCE WITH ASTM D698.
6. PIPE SCH 40 OR GREATER SHALL BE USED.
7. THE DETAILS SHOWN ON THESE SHEETS PERTAIN TO STANDARD SEDIMENT BASINS(S) FOR DRAINAGE AREAS LESS THAN 15 ACRES. SEE CONSTRUCTION DRAWINGS FOR EMBANKMENT, STORAGE VOLUME, SPILLWAY, OUTLET, AND OUTLET PROTECTION DETAILS FOR ANY SEDIMENT BASIN(S) THAT HAVE BEEN INDIVIDUALLY DESIGNED FOR DRAINAGE AREAS LARGER THAN 15 ACRES.

August 2013 Urban Drainage and Flood Control District August 2013 Urban Storm Drainage Criteria Manual Volume 3

SEDIMENT BASIN MAINTENANCE NOTES

1. INSPECT BMPs EACH WORKDAY, AND MAINTAIN THEM IN EFFECTIVE OPERATING CONDITION. MAINTENANCE OF BMPs SHOULD BE PROACTIVE, NOT REACTIVE. INSPECT BMPs AS SOON AS POSSIBLE (AND ALWAYS WITHIN 24 HOURS) FOLLOWING A STORM THAT CAUSES SURFACE EROSION, AND PERFORM NECESSARY MAINTENANCE.
2. FREQUENT OBSERVATIONS AND MAINTENANCE ARE NECESSARY TO MAINTAIN BMPs IN EFFECTIVE OPERATING CONDITION. INSPECTIONS AND CORRECTIVE MEASURES SHOULD BE DOCUMENTED THOROUGHLY.
3. WHERE BMPs HAVE FAILED, REPAIR OR REPLACEMENT SHOULD BE INITIATED UPON DISCOVERY OF THE FAILURE.
4. SEDIMENT ACCUMULATED IN BASIN SHALL BE REMOVED AS NEEDED TO MAINTAIN BMP EFFECTIVENESS, TYPICALLY WHEN SEDIMENT DEPTH REACHES ONE FOOT (I.E., TWO FEET BELOW THE SPILLWAY CREST).
5. SEDIMENT BASINS ARE TO REMAIN IN PLACE UNTIL THE UPSTREAM DISTURBED AREA IS STABILIZED AND GRASS COVER IS ACCEPTED BY THE LOCAL JURISDICTION.
6. WHEN SEDIMENT BASINS ARE REMOVED, ALL DISTURBED AREAS SHALL BE COVERED WITH TOPSOIL, SEEDED AND MULCHED OR OTHERWISE STABILIZED AS APPROVED BY LOCAL JURISDICTION.

(DETAILS ADAPTED FROM DOUGLAS COUNTY, COLORADO)

NOTE: MANY JURISDICTIONS HAVE BMP DETAILS THAT VARY FROM UDFCD STANDARD DETAILS. CONSULT WITH LOCAL JURISDICTIONS AS TO WHICH DETAIL SHOULD BE USED WHEN DIFFERENCES ARE NOTED.

August 2013 Urban Drainage and Flood Control District August 2013 Urban Storm Drainage Criteria Manual Volume 3 SB-7


COPYRIGHT THESE PLANS ARE AN INSTRUMENT OF SERVICE AND ARE THE PROPERTY OF GALLOWAY, AND MAY NOT BE DUPLICATED, DISCLOSED, OR REPRODUCED WITHOUT THE WRITTEN CONSENT OF GALLOWAY. COPYRIGHTS AND INFRAINGEMENTS WILL BE ENFORCED AND PROSECUTED.

GRADING & EROSION CONTROL PLANS GRANDVIEW RESERVE FILING NO. 1 MELODY HOMES, INC. SF2311 EASTONVILLE RD & REX RD EL PASO COUNTY, FALCON, CO 80831

#	Date	Issue / Description	Init.

Project No: HRG02 Drawn By: JDM, BLB Checked By: BAS, CMWJ Date: 03/15/2024

EROSION CONTROL DETAILS

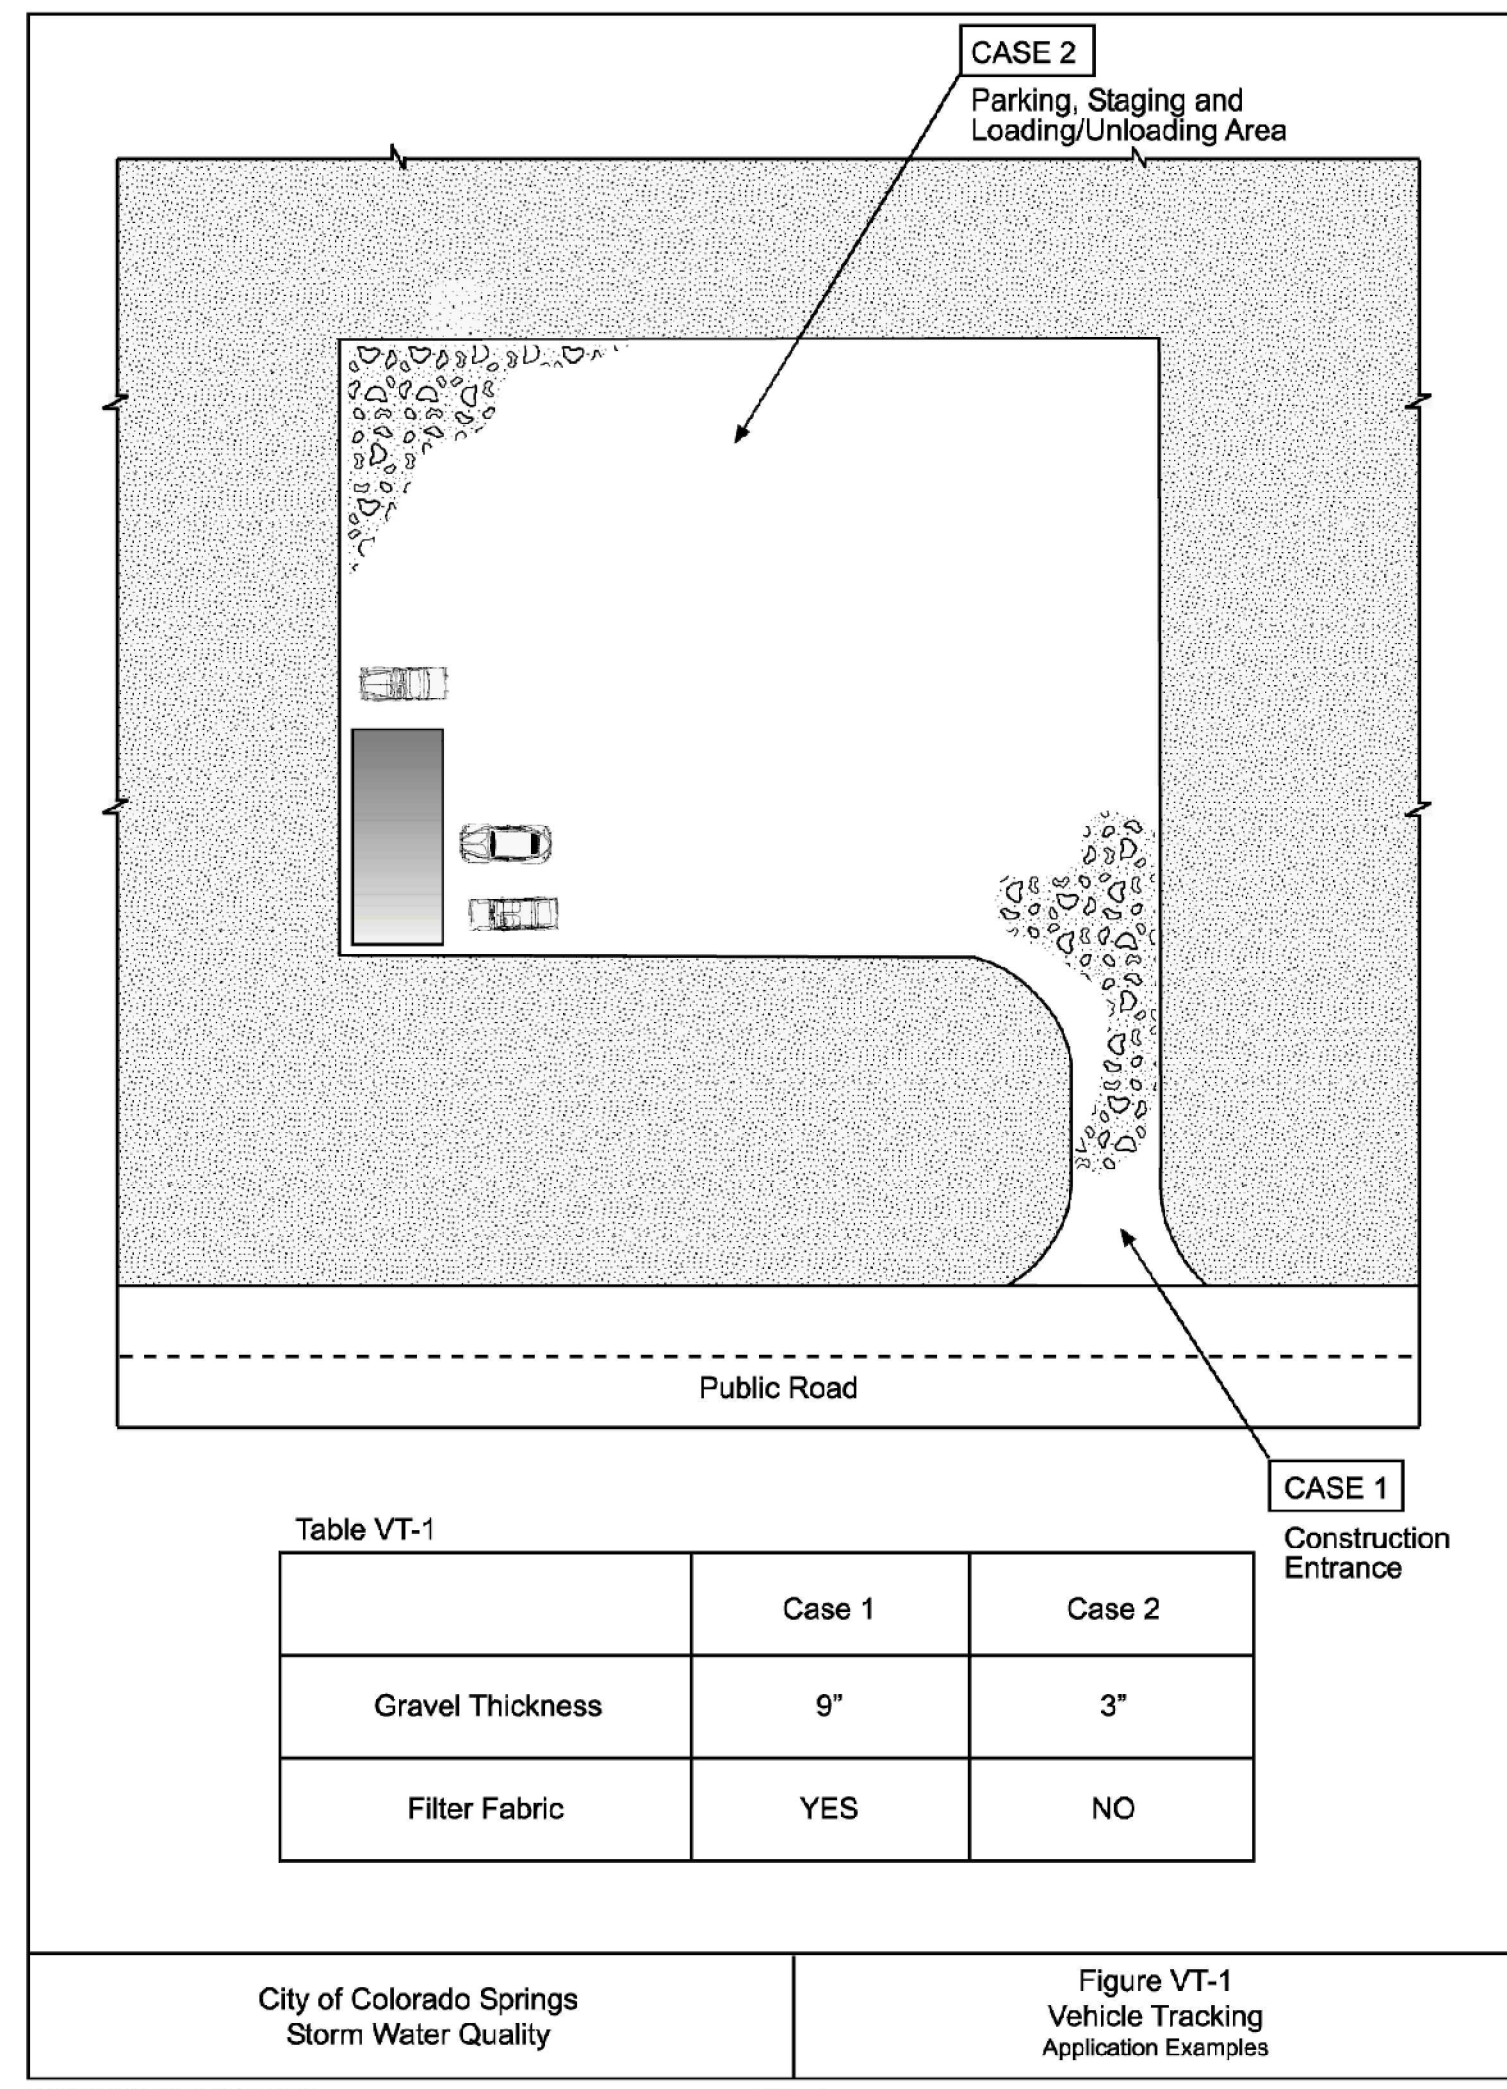


SM-4 Vehicle Tracking Control (VTC)

STABILIZED CONSTRUCTION ENTRANCE/EXIT INSTALLATION NOTES


- SEE PLAN VIEW FOR:
 - LOCATION OF CONSTRUCTION ENTRANCE(S)/EXIT(S)
 - TYPE OF CONSTRUCTION ENTRANCE(S)/EXIT(S) (WITH/WITHOUT WHEEL WASH, CONSTRUCTION MAT OR TRM)
- CONSTRUCTION MAT OR TRM STABILIZED CONSTRUCTION ENTRANCES ARE ONLY TO BE USED ON SHORT DURATION PROJECTS (TYPICALLY RANGING FROM A WEEK TO A MONTH) WHERE THERE WILL BE LIMITED VEHICULAR ACCESS.
- A STABILIZED CONSTRUCTION ENTRANCE/EXIT SHALL BE LOCATED AT ALL ACCESS POINTS WHERE VEHICLES ACCESS THE CONSTRUCTION SITE FROM PAVED RIGHT-OF-WAYS.
- STABILIZED CONSTRUCTION ENTRANCE/EXIT SHALL BE INSTALLED PRIOR TO ANY LAND DISTURBING ACTIVITIES.
- A NON-WOVEN GEOTEXTILE FABRIC SHALL BE PLACED UNDER THE STABILIZED CONSTRUCTION ENTRANCE/EXIT PRIOR TO THE PLACEMENT OF ROCK.
- UNLESS OTHERWISE SPECIFIED BY LOCAL JURISDICTION, ROCK SHALL CONSIST OF DOT SECT. #703, AASHTO #3 COARSE AGGREGATE OR 6" (MINUS) ROCK.

STABILIZED CONSTRUCTION ENTRANCE/EXIT MAINTENANCE NOTES

- INSPECT BMPs EACH WORKDAY, AND MAINTAIN THEM IN EFFECTIVE OPERATING CONDITION. MAINTENANCE OF BMPs SHOULD BE PROACTIVE, NOT REACTIVE. INSPECT BMPs AS SOON AS POSSIBLE (AND ALWAYS WITHIN 24 HOURS) FOLLOWING A STORM THAT CAUSES SURFACE EROSION, AND PERFORM NECESSARY MAINTENANCE.
 - FREQUENT OBSERVATIONS AND MAINTENANCE ARE NECESSARY TO MAINTAIN BMPs IN EFFECTIVE OPERATING CONDITION. INSPECTIONS AND CORRECTIVE MEASURES SHOULD BE DOCUMENTED THOROUGHLY.
 - WHERE BMPs HAVE FAILED, REPAIR OR REPLACEMENT SHOULD BE INITIATED UPON DISCOVERY OF THE FAILURE.
 - ROCK SHALL BE REAPPLIED OR REGRADED AS NECESSARY TO THE STABILIZED ENTRANCE/EXIT TO MAINTAIN A CONSISTENT DEPTH.
 - SEDIMENT TRACKED ONTO PAVED ROADS IS TO BE REMOVED THROUGHOUT THE DAY AND AT THE END OF THE DAY BY SHOVELING OR SWEEPING. SEDIMENT MAY NOT BE WASHED DOWN STORM SEWER DRAINS.
- NOTE: MANY JURISDICTIONS HAVE BMP DETAILS THAT VARY FROM UDFCD STANDARD DETAILS. CONSULT WITH LOCAL JURISDICTIONS AS TO WHICH DETAIL SHOULD BE USED WHEN DIFFERENCES ARE NOTED.
- (DETAILS ADAPTED FROM CITY OF BROOMFIELD, COLORADO, NOT AVAILABLE IN AUTOCAD)

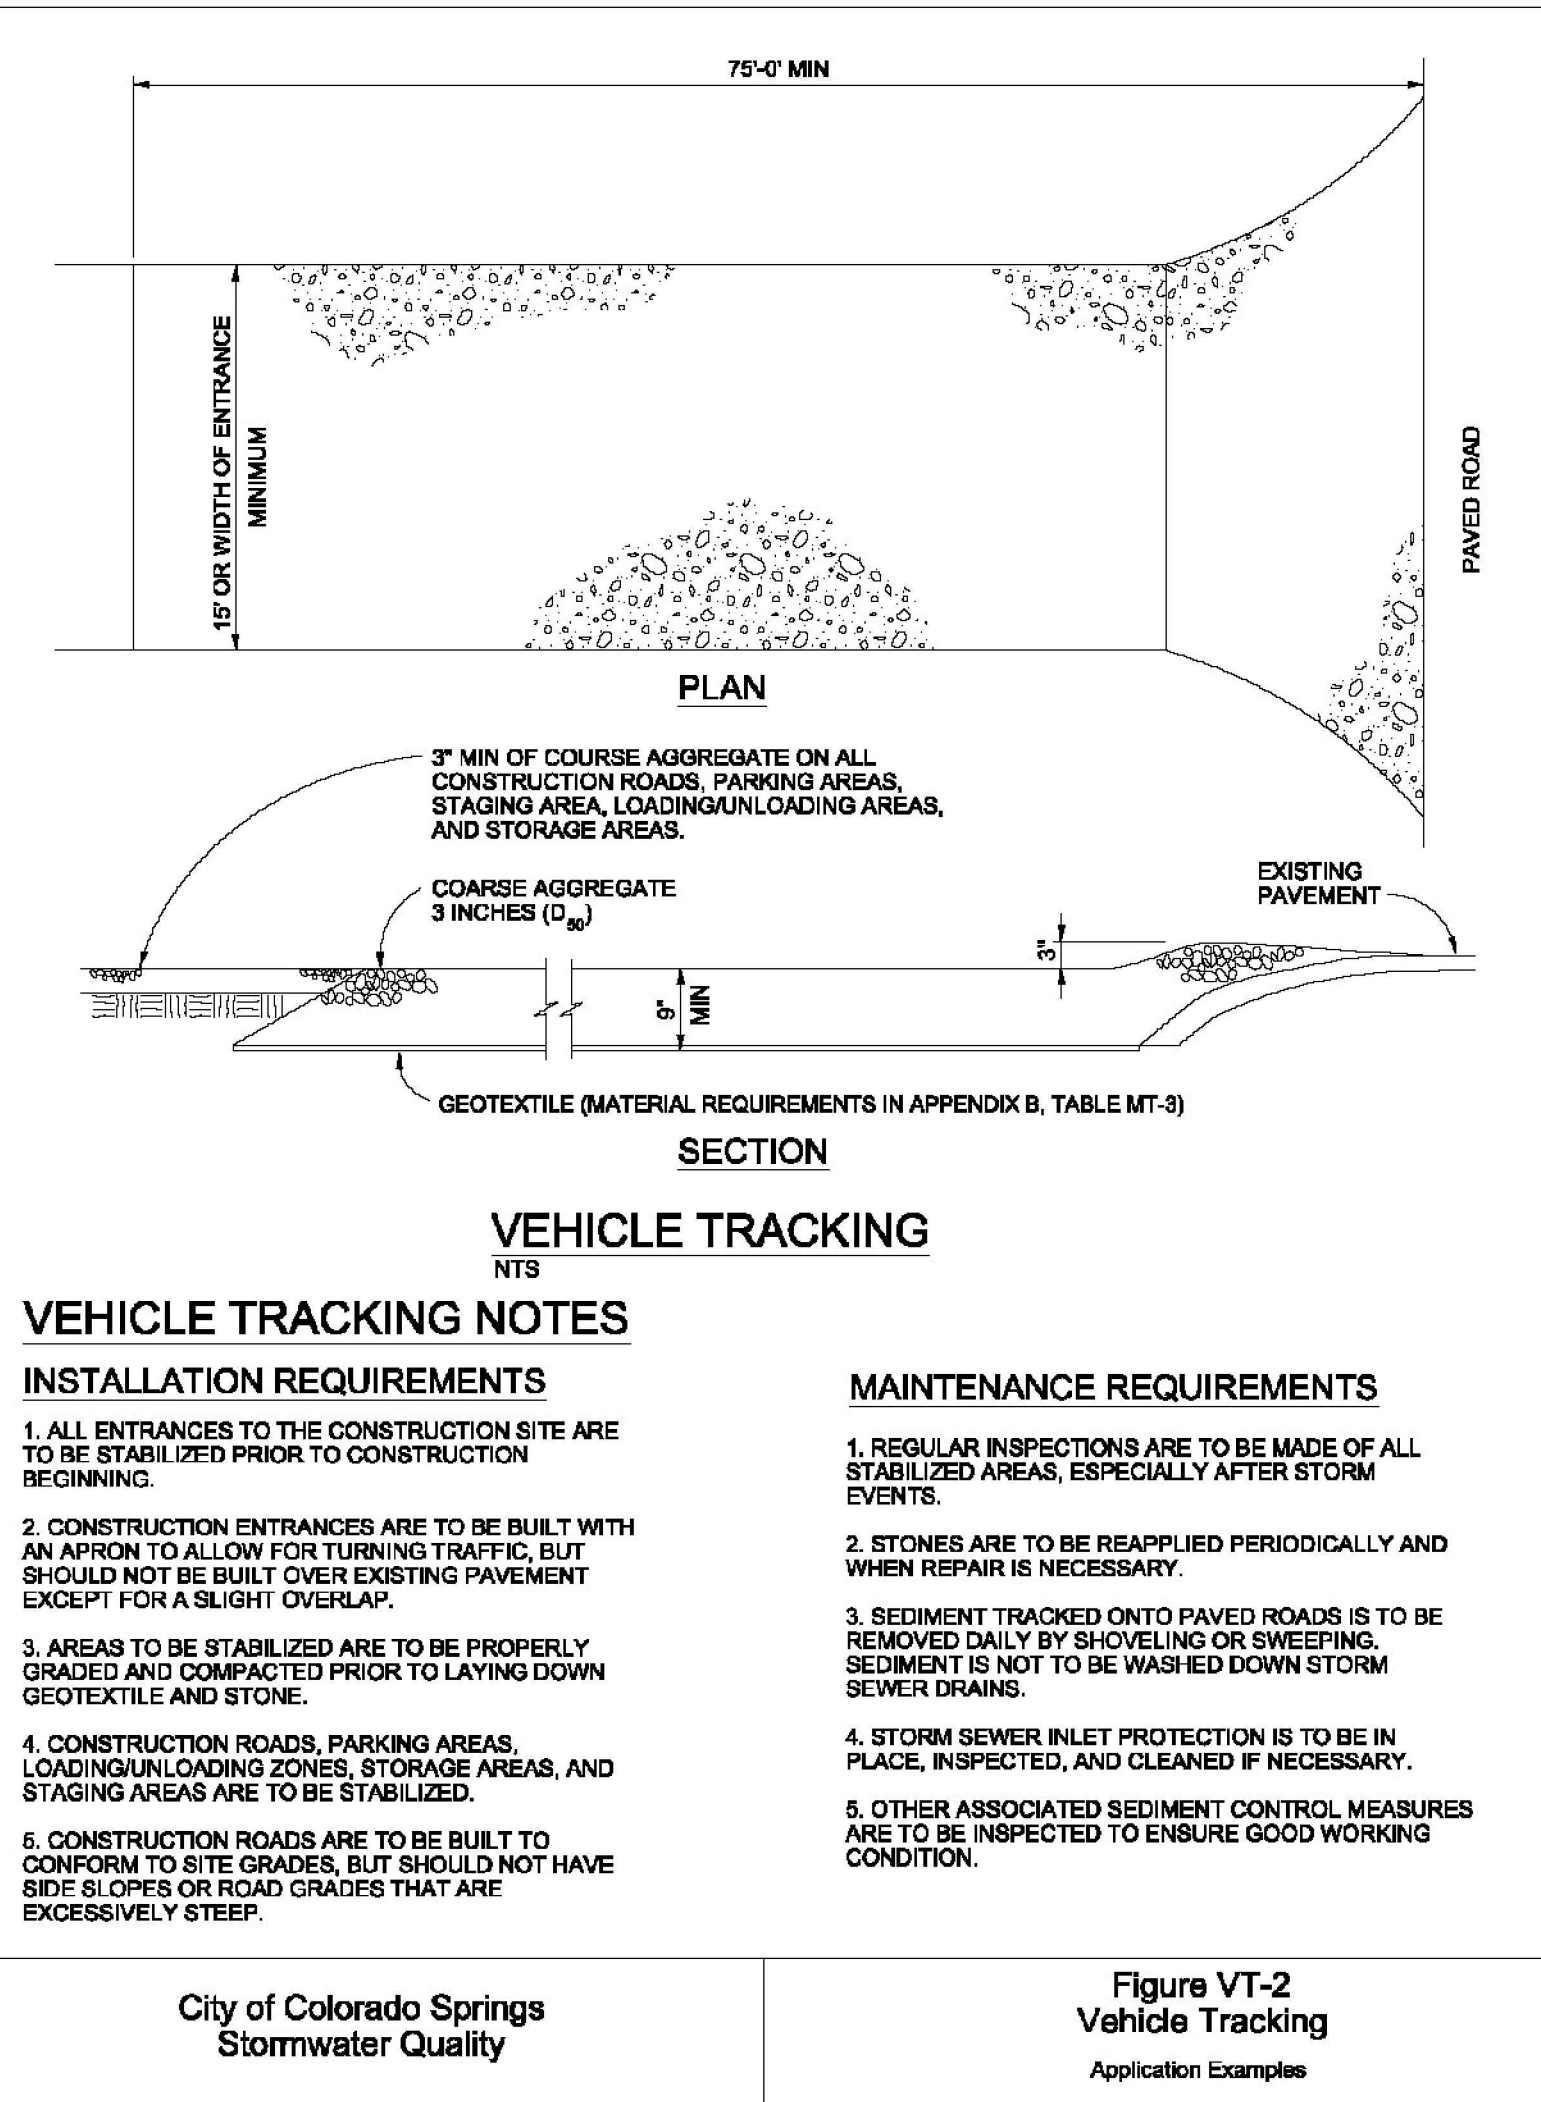

SM-6 Stabilized Staging Area (SSA)

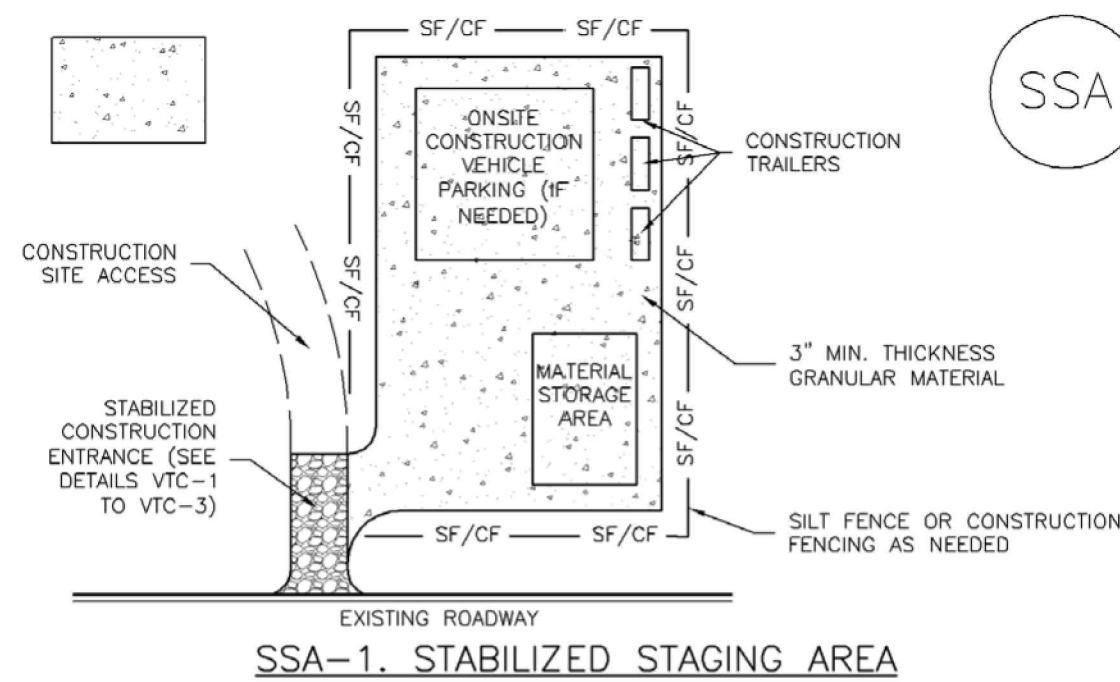


STABILIZED STAGING AREA INSTALLATION NOTES

- SEE PLAN VIEW FOR:
 - LOCATION OF STAGING AREA(S)
 - CONTRACTOR MAY ADJUST LOCATION AND SIZE OF STAGING AREA WITH APPROVAL FROM THE LOCAL JURISDICTION.
- STABILIZED STAGING AREA SHOULD BE APPROPRIATE FOR THE NEEDS OF THE SITE. OVERSIZING RESULTS IN A LARGER AREA TO STABILIZE FOLLOWING CONSTRUCTION.
- STAGING AREA SHALL BE STABILIZED PRIOR TO OTHER OPERATIONS ON THE SITE.
- THE STABILIZED STAGING AREA SHALL CONSIST OF A MINIMUM 3" THICK GRANULAR MATERIAL.
- UNLESS OTHERWISE SPECIFIED BY LOCAL JURISDICTION, ROCK SHALL CONSIST OF DOT SECT. #703, AASHTO #3 COARSE AGGREGATE OR 6" (MINUS) ROCK.
- ADDITIONAL PERIMETER BMPs MAY BE REQUIRED INCLUDING BUT NOT LIMITED TO SILT FENCE AND CONSTRUCTION FENCING.

STABILIZED STAGING AREA MAINTENANCE NOTES

- INSPECT BMPs EACH WORKDAY, AND MAINTAIN THEM IN EFFECTIVE OPERATING CONDITION. MAINTENANCE OF BMPs SHOULD BE PROACTIVE, NOT REACTIVE. INSPECT BMPs AS SOON AS POSSIBLE (AND ALWAYS WITHIN 24 HOURS) FOLLOWING A STORM THAT CAUSES SURFACE EROSION, AND PERFORM NECESSARY MAINTENANCE.
- FREQUENT OBSERVATIONS AND MAINTENANCE ARE NECESSARY TO MAINTAIN BMPs IN EFFECTIVE OPERATING CONDITION. INSPECTIONS AND CORRECTIVE MEASURES SHOULD BE DOCUMENTED THOROUGHLY.
- WHERE BMPs HAVE FAILED, REPAIR OR REPLACEMENT SHOULD BE INITIATED UPON DISCOVERY OF THE FAILURE.
- ROCK SHALL BE REAPPLIED OR REGRADED AS NECESSARY IF RUTTING OCCURS OR UNDERLYING SUBGRADE BECOMES EXPOSED.

SM-4 Vehicle Tracking Control (VTC)

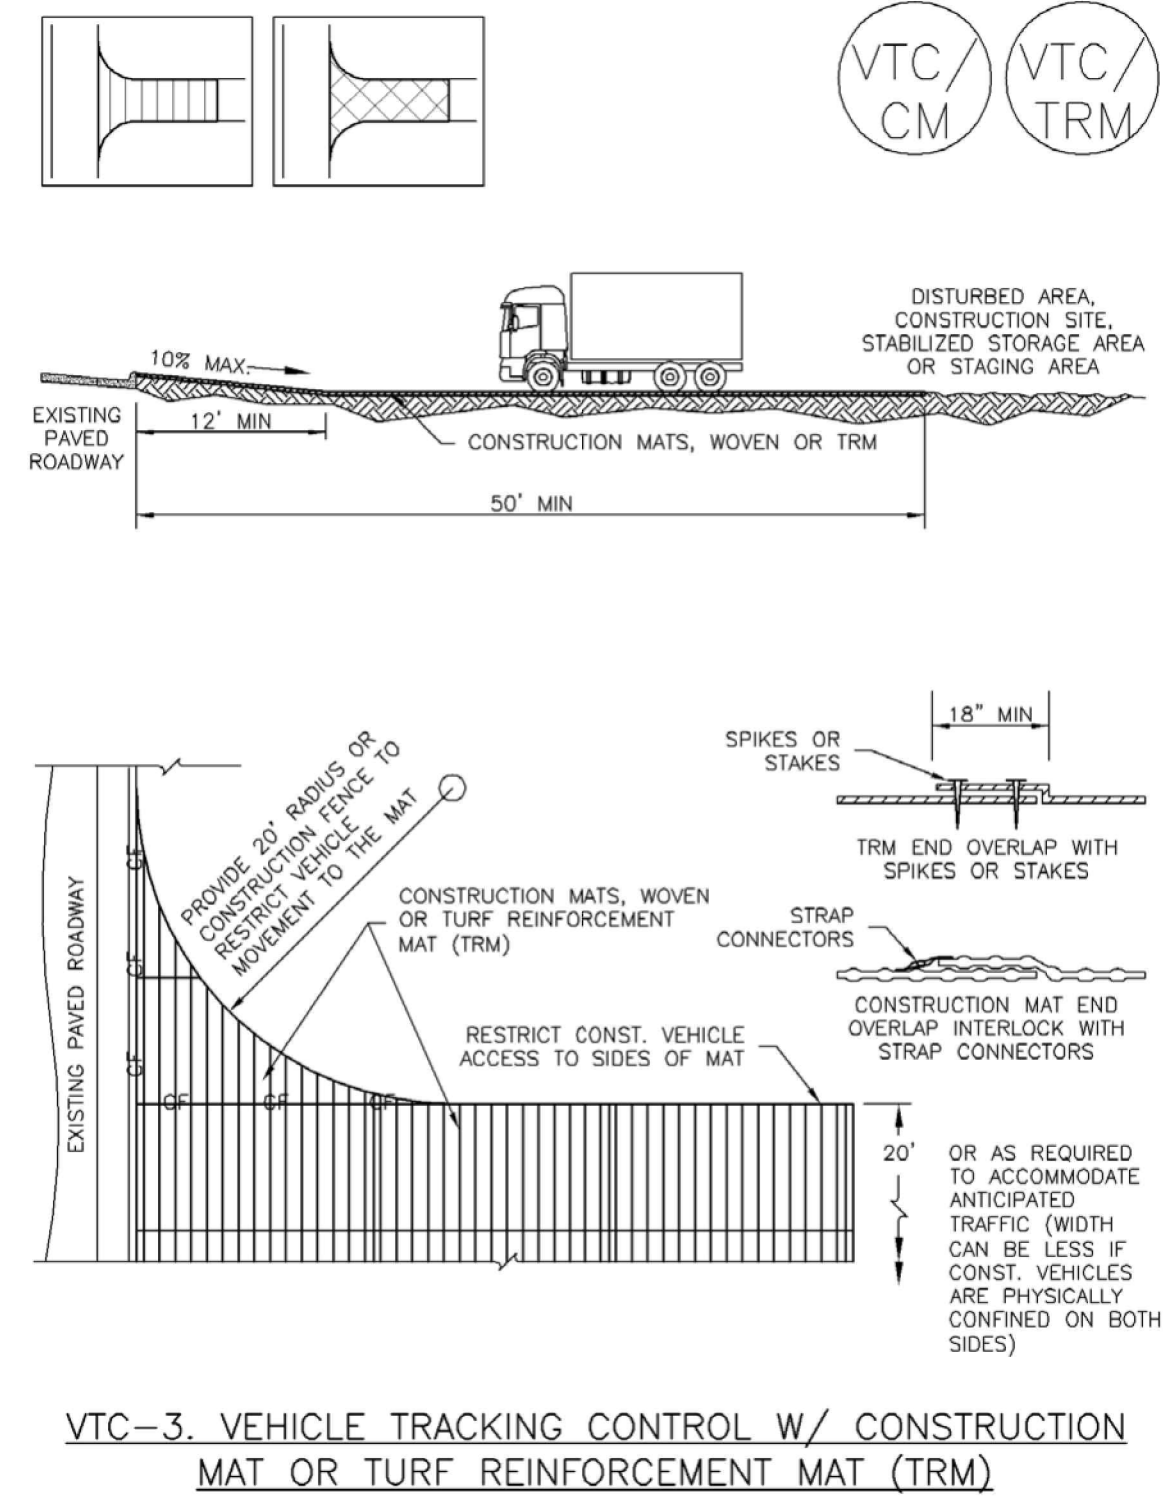

SM-6 Stabilized Staging Area (SSA)

STABILIZED STAGING AREA MAINTENANCE NOTES


- STABILIZED STAGING AREA SHALL BE ENLARGED IF NECESSARY TO CONTAIN PARKING, STORAGE, AND UNLOADING/LOADING OPERATIONS.
 - THE STABILIZED STAGING AREA SHALL BE REMOVED AT THE END OF CONSTRUCTION. THE GRANULAR MATERIAL SHALL BE REMOVED OR, IF APPROVED BY THE LOCAL JURISDICTION, USED ON SITE, AND THE AREA COVERED WITH TOPSOIL, SEEDED AND MULCHED OR OTHERWISE STABILIZED IN A MANNER APPROVED BY LOCAL JURISDICTION.
- NOTE: MANY MUNICIPALITIES PROHIBIT THE USE OF RECYCLED CONCRETE AS GRANULAR MATERIAL FOR STABILIZED STAGING AREAS DUE TO DIFFICULTIES WITH RE-ESTABLISHMENT OF VEGETATION IN AREAS WHERE RECYCLED CONCRETE WAS PLACED.
- NOTE: MANY JURISDICTIONS HAVE BMP DETAILS THAT VARY FROM UDFCD STANDARD DETAILS. CONSULT WITH LOCAL JURISDICTIONS AS TO WHICH DETAIL SHOULD BE USED WHEN DIFFERENCES ARE NOTED.
- (DETAILS ADAPTED FROM DOUGLAS COUNTY, COLORADO, NOT AVAILABLE IN AUTOCAD)

#	Date	Issue / Description	Init.

Project No:	HRG02
Drawn By:	JDM, BLB
Checked By:	BAS, CMWJ
Date:	03/15/2024

EROSION CONTROL DETAILS

SC-3 Straw Bale Barrier (SBB)

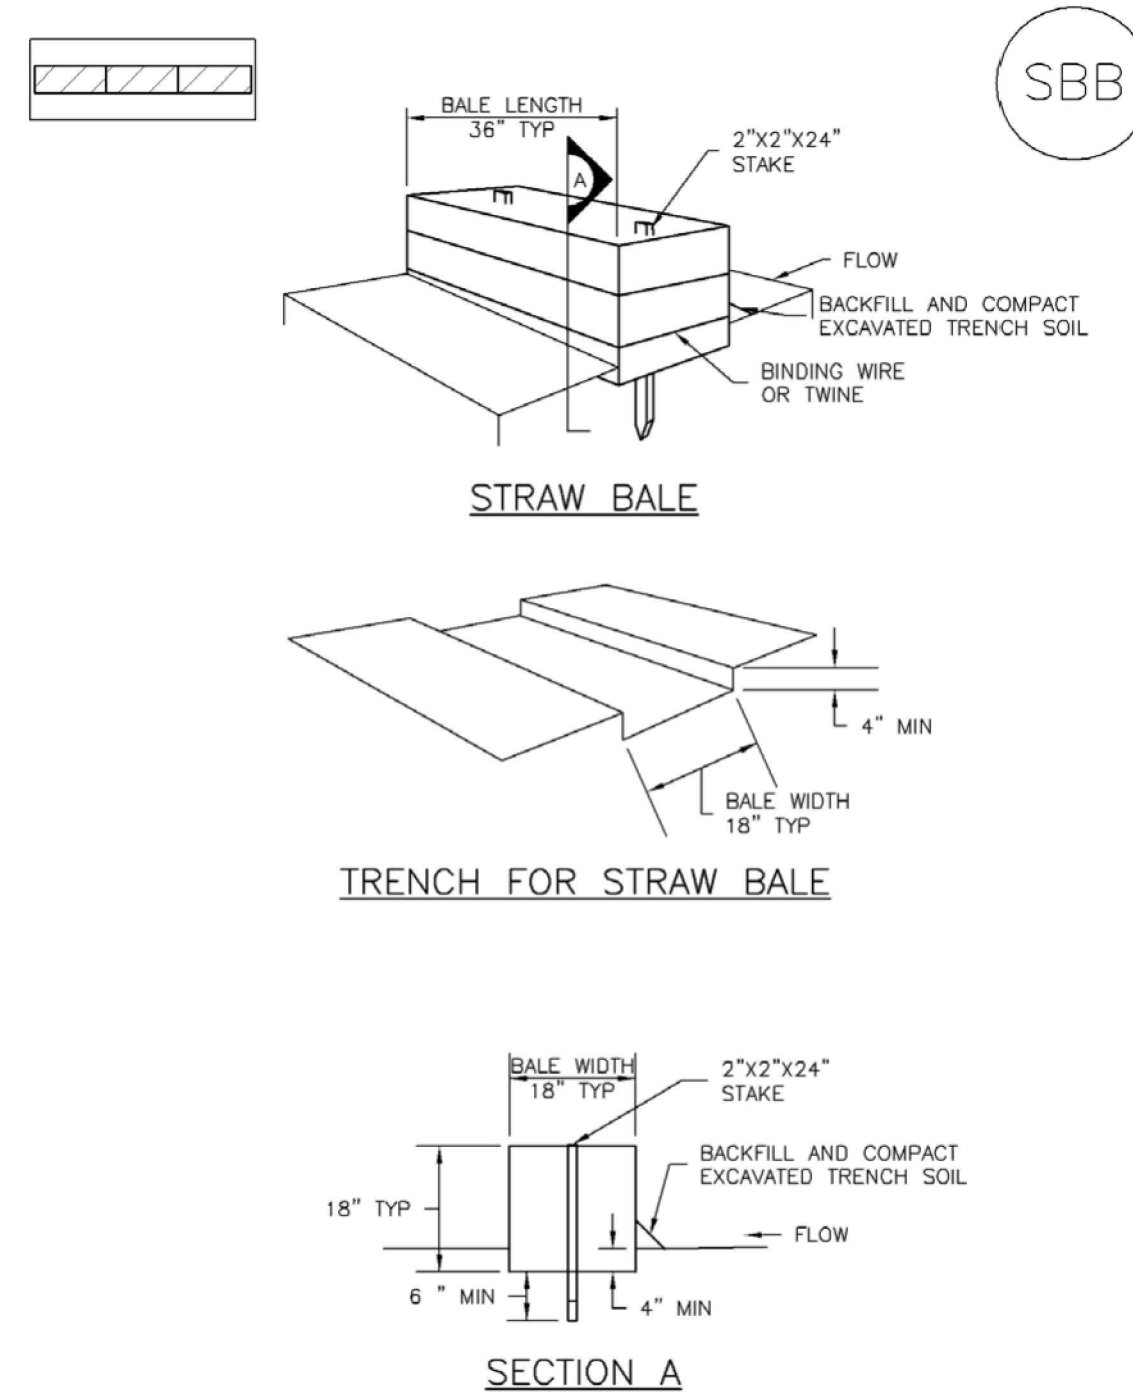

SBB-1. STRAW BALE

SBB-2 Urban Drainage and Flood Control District Urban Storm Drainage Criteria Manual Volume 3 November 2010

Straw Bale Barrier (SBB) SC-3

STRAW BALE INSTALLATION NOTES

1. SEE PLAN VIEW FOR: -LOCATION(S) OF STRAW BALES.
2. STRAW BALES SHALL CONSIST OF CERTIFIED WEED FREE STRAW OR HAY. LOCAL JURISDICTIONS MAY REQUIRE PROOF THAT BALES ARE WEED FREE.
3. STRAW BALES SHALL CONSIST OF APPROXIMATELY 5 CUBIC FEET OF STRAW OR HAY AND WEIGH NOT LESS THAN 35 POUNDS.
4. WHEN STRAW BALES ARE USED IN SERIES AS A BARRIER, THE END OF EACH BALE SHALL BE TIGHTLY ABUTTING ONE ANOTHER.
5. STRAW BALE DIMENSIONS SHALL BE APPROXIMATELY 36"x18"x18".
6. A UNIFORM ANCHOR TRENCH SHALL BE EXCAVATED TO A DEPTH OF 4". STRAW BALES SHALL BE PLACED SO THAT BINDING TWINE IS ENCOMPASSING THE VERTICAL SIDES OF THE BALE(S). ALL EXCAVATED SOIL SHALL BE PLACED ON THE UPHILL SIDE OF THE STRAW BALE(S) AND COMPACTED.
7. TWO (2) WOODEN STAKES SHALL BE USED TO HOLD EACH BALE IN PLACE. WOODEN STAKES SHALL BE 2"x2"x24". WOODEN STAKES SHALL BE DRIVEN 6" INTO THE GROUND.

STRAW BALE MAINTENANCE NOTES


1. INSPECT BMPs EACH WORKDAY, AND MAINTAIN THEM IN EFFECTIVE OPERATING CONDITION. MAINTENANCE OF BMPs SHOULD BE PROACTIVE, NOT REACTIVE. INSPECT BMPs AS SOON AS POSSIBLE (AND ALWAYS WITHIN 24 HOURS) FOLLOWING A STORM THAT CAUSES SURFACE EROSION, AND PERFORM NECESSARY MAINTENANCE.
2. FREQUENT OBSERVATIONS AND MAINTENANCE ARE NECESSARY TO MAINTAIN BMPs IN EFFECTIVE OPERATING CONDITION. INSPECTIONS AND CORRECTIVE MEASURES SHOULD BE DOCUMENTED THOROUGHLY.
3. WHERE BMPs HAVE FAILED, REPAIR OR REPLACEMENT SHOULD BE INITIATED UPON DISCOVERY OF THE FAILURE.
4. STRAW BALES SHALL BE REPLACED IF THEY BECOME HEAVILY SOILED, ROTTEN, OR DAMAGED BEYOND REPAIR.
5. SEDIMENT ACCUMULATED UPSTREAM OF STRAW BALE BARRIER SHALL BE REMOVED AS NEEDED TO MAINTAIN FUNCTIONALITY OF THE BMP, TYPICALLY WHEN DEPTH OF ACCUMULATED SEDIMENTS IS APPROXIMATELY 1/2 OF THE HEIGHT OF THE STRAW BALE BARRIER.
6. STRAW BALES ARE TO REMAIN IN PLACE UNTIL THE UPSTREAM DISTURBED AREA IS STABILIZED AND APPROVED BY THE LOCAL JURISDICTION.
7. WHEN STRAW BALES ARE REMOVED, ALL DISTURBED AREAS SHALL BE COVERED WITH TOPSOIL, SEEDED AND MULCHED OR OTHERWISE STABILIZED AS APPROVED BY LOCAL JURISDICTION.

(DETAILS ADAPTED FROM TOWN OF PARKER, COLORADO, NOT AVAILABLE IN AUTOCAD)

NOTE: MANY JURISDICTIONS HAVE BMP DETAILS THAT VARY FROM UDFCD STANDARD DETAILS. CONSULT WITH LOCAL JURISDICTIONS AS TO WHICH DETAIL SHOULD BE USED WHEN DIFFERENCES ARE NOTED.

November 2010 Urban Drainage and Flood Control District Urban Storm Drainage Criteria Manual Volume 3 SBB-3


Sediment Control Log (SCL) SC-2

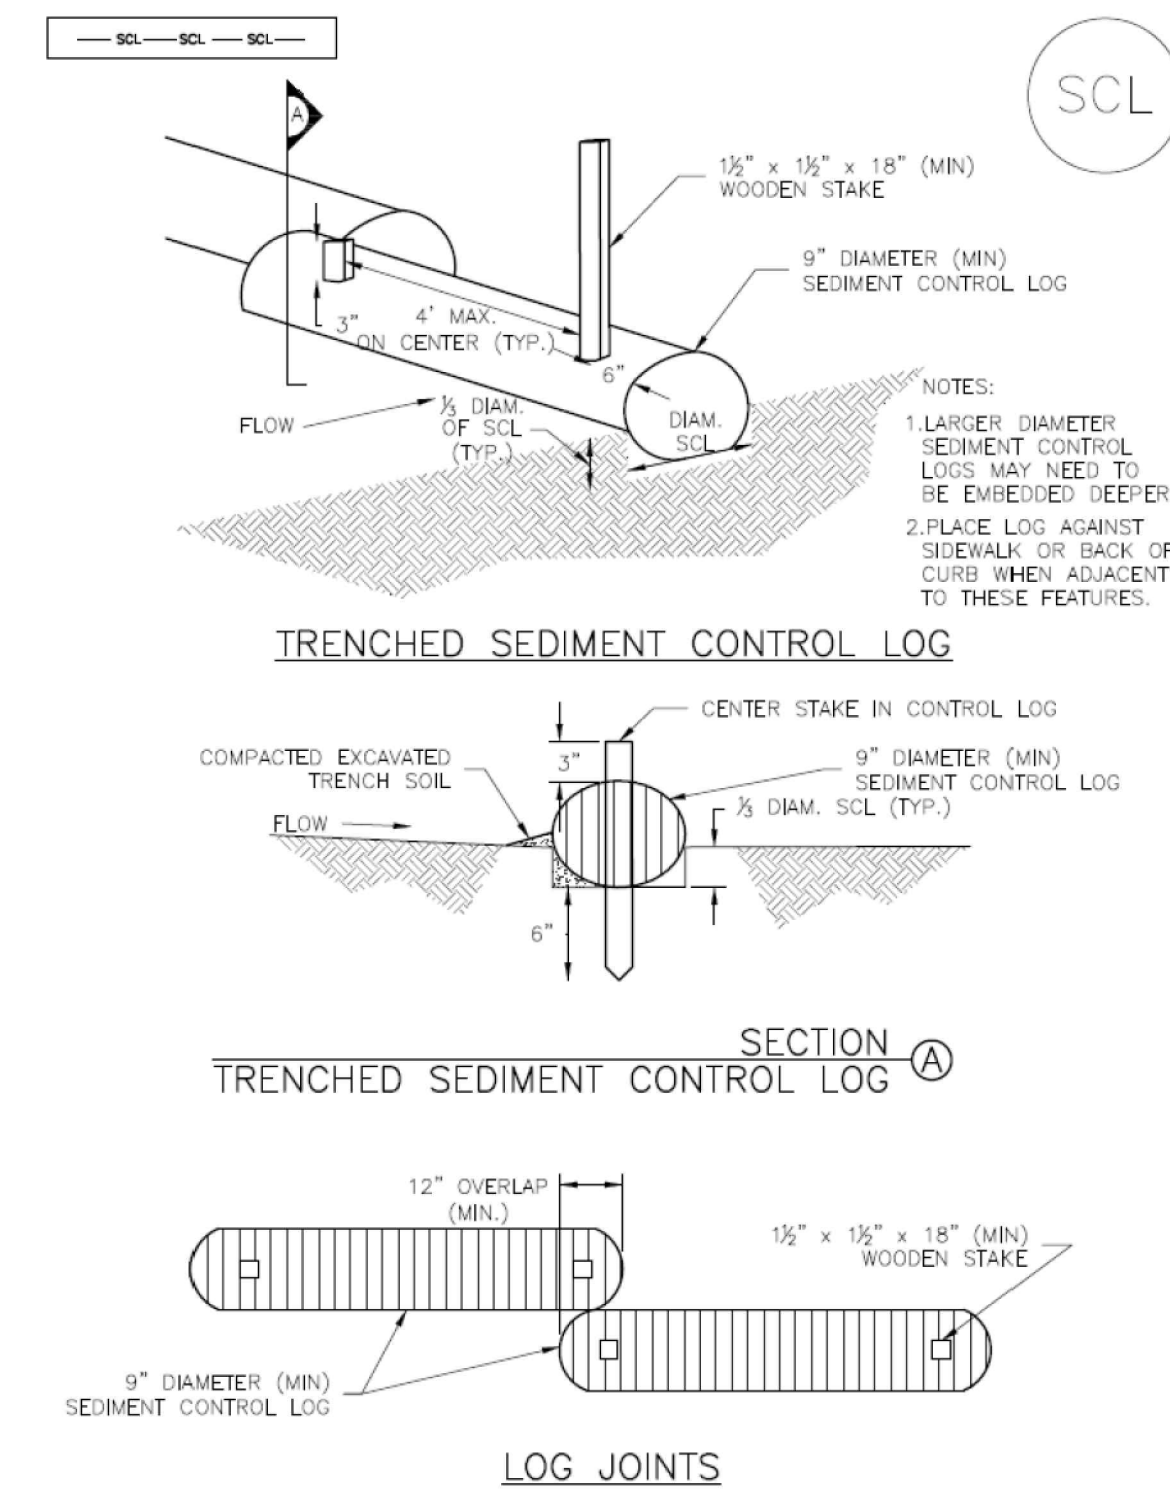

SCL-1. TRENCHED SEDIMENT CONTROL LOG

November 2015 Urban Drainage and Flood Control District Urban Storm Drainage Criteria Manual Volume 3 SCL-3


SC-2 Sediment Control Log (SCL)

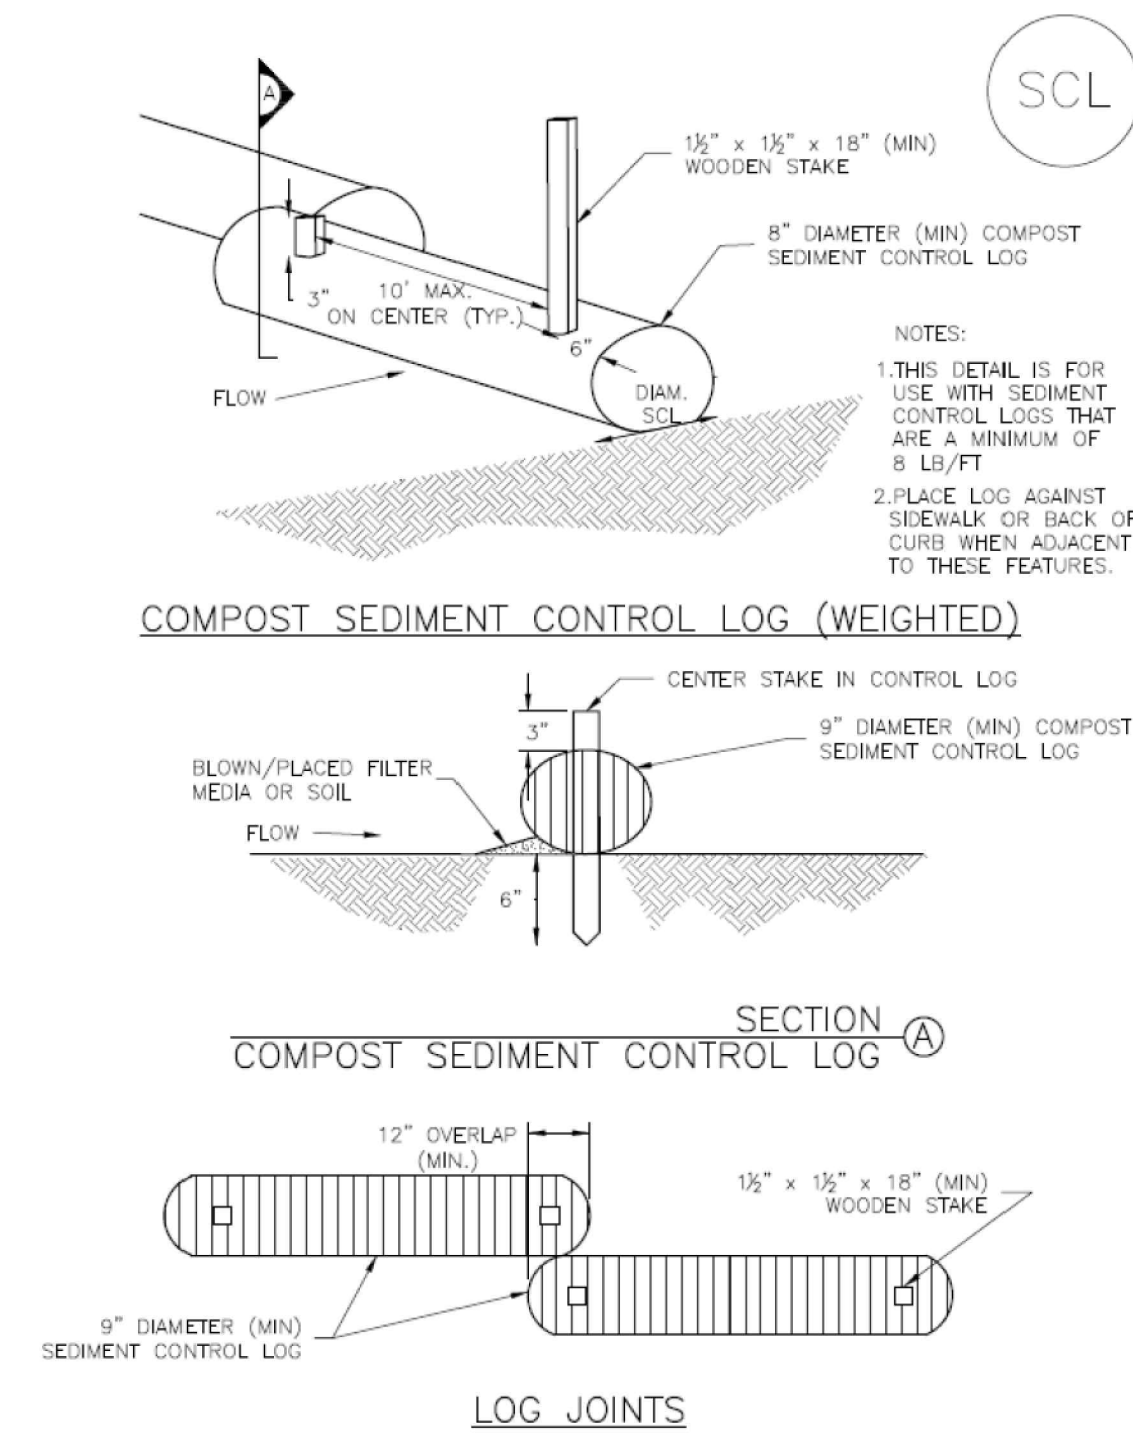

SCL-2. COMPOST SEDIMENT CONTROL LOG (WEIGHTED)

SCL-4 Urban Drainage and Flood Control District Urban Storm Drainage Criteria Manual Volume 3 November 2015

Sediment Control Log (SCL) SC-2

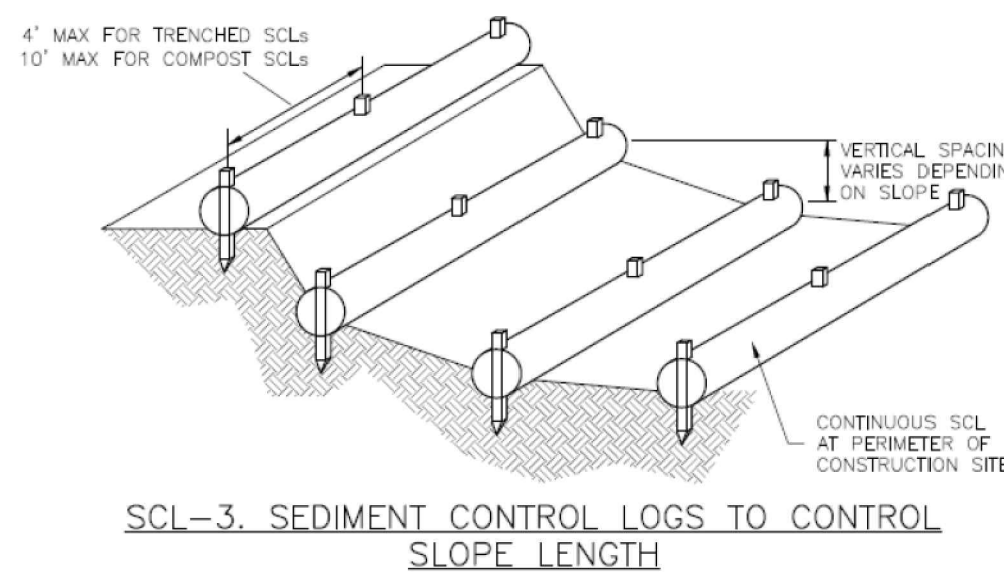

November 2015 Urban Drainage and Flood Control District Urban Storm Drainage Criteria Manual Volume 3 SCL-5

SC-2 Sediment Control Log (SCL)

SEDIMENT CONTROL LOG INSTALLATION NOTES

1. SEE PLAN VIEW FOR LOCATION AND LENGTH OF SEDIMENT CONTROL LOGS.
2. SEDIMENT CONTROL LOGS THAT ACT AS A PERIMETER CONTROL SHALL BE INSTALLED PRIOR TO ANY UPGRADE/REPAIR OF PERENNIAL LAND-DISTURBING ACTIVITIES.
3. SEDIMENT CONTROL LOGS SHALL CONSIST OF STRAW, COMPOST, EXCELSIOR OR COCONUT FIBER, AND SHALL BE FREE OF ANY NOXIOUS WEED SEEDS OR DEFECTS INCLUDING RIPS, HOLES AND OBVIOUS WEAR.
4. SEDIMENT CONTROL LOGS MAY BE USED AS SMALL CHECK DAMS IN DITCHES AND SWALES. HOWEVER, THEY SHOULD NOT BE USED IN PERENNIAL STREAMS.
5. IT IS RECOMMENDED THAT SEDIMENT CONTROL LOGS BE TRENCHED INTO THE GROUND TO A DEPTH OF APPROXIMATELY 1/2 OF THE DIAMETER OF THE LOG. IF TRENCHING TO THIS DEPTH IS NOT FEASIBLE AND/OR DESIRABLE (SHORT TERM INSTALLATION WITH DESIRE NOT TO DAMAGE LANDSCAPE) A LESSER TRENCHING DEPTH MAY BE ACCEPTABLE WITH MORE ROBUST STAKING. COMPOST LOGS THAT ARE 8 LB/FT DO NOT NEED TO BE TRENCHED.
6. THE UPHILL SIDE OF THE SEDIMENT CONTROL LOG SHALL BE BACKFILLED WITH SOIL OR FILTER MATERIAL THAT IS FREE OF ROCKS AND DEBRIS. THE SOIL SHALL BE TIGHTLY COMPACTED INTO THE SHAPE OF A RIGHT TRIANGLE USING A SHOVEL OR WEIGHTED LAWN ROLLER OR BLOWN IN PLACE.
7. FOLLOW MANUFACTURERS' GUIDANCE FOR STAKING. IF MANUFACTURERS' INSTRUCTIONS DO NOT SPECIFY SPACING, STAKES SHALL BE PLACED ON 4' CENTERS AND EMBEDDED A MINIMUM OF 6" INTO THE GROUND. 3" OF THE STAKE SHALL PROTRUDE FROM THE TOP OF THE LOG. STAKES THAT ARE BROKEN PRIOR TO INSTALLATION SHALL BE REPLACED. COMPOST LOGS SHOULD BE STAKED 10' ON CENTER.

SEDIMENT CONTROL LOG MAINTENANCE NOTES

1. INSPECT BMPs EACH WORKDAY, AND MAINTAIN THEM IN EFFECTIVE OPERATING CONDITION. MAINTENANCE OF BMPs SHOULD BE PROACTIVE, NOT REACTIVE. INSPECT BMPs AS SOON AS POSSIBLE (AND ALWAYS WITHIN 24 HOURS) FOLLOWING A STORM THAT CAUSES SURFACE EROSION, AND PERFORM NECESSARY MAINTENANCE.
2. FREQUENT OBSERVATIONS AND MAINTENANCE ARE NECESSARY TO MAINTAIN BMPs IN EFFECTIVE OPERATING CONDITION. INSPECTIONS AND CORRECTIVE MEASURES SHOULD BE DOCUMENTED THOROUGHLY.
3. WHERE BMPs HAVE FAILED, REPAIR OR REPLACEMENT SHOULD BE INITIATED UPON DISCOVERY OF THE FAILURE.
4. SEDIMENT ACCUMULATED UPSTREAM OF SEDIMENT CONTROL LOG SHALL BE REMOVED AS NEEDED TO MAINTAIN FUNCTIONALITY OF THE BMP, TYPICALLY WHEN DEPTH OF ACCUMULATED SEDIMENTS IS APPROXIMATELY 1/2 OF THE HEIGHT OF THE SEDIMENT CONTROL LOG.
5. SEDIMENT CONTROL LOG SHALL BE REMOVED AT THE END OF CONSTRUCTION. COMPOST FROM COMPOST LOGS MAY BE LEFT IN PLACE AS LONG AS BAGS ARE REMOVED AND THE AREA SEEDS. IF DISTURBED AREAS EXIST AFTER REMOVAL, THEY SHALL BE COVERED WITH TOP SOIL, SEEDS AND MULCHED OR OTHERWISE STABILIZED IN A MANNER APPROVED BY THE LOCAL JURISDICTION.

(DETAILS ADAPTED FROM TOWN OF PARKER, COLORADO, JEFFERSON COUNTY, COLORADO, DOUGLAS COUNTY, COLORADO, AND CITY OF AURORA, COLORADO, NOT AVAILABLE IN AUTOCAD)

NOTE: MANY JURISDICTIONS HAVE BMP DETAILS THAT VARY FROM UDFCD STANDARD DETAILS. CONSULT WITH LOCAL JURISDICTIONS AS TO WHICH DETAIL SHOULD BE USED WHEN DIFFERENCES ARE NOTED.


SCL-6 Urban Drainage and Flood Control District Urban Storm Drainage Criteria Manual Volume 3 November 2015

#	Date	Issue / Description	Init.

Project No: HRG02
Drawn By: JDM, BLB
Checked By: BAS, CMWJ
Date: 03/15/2024

EROSION CONTROL
DETAILS

REC-6 Rolled Erosion Control Products (RECP)

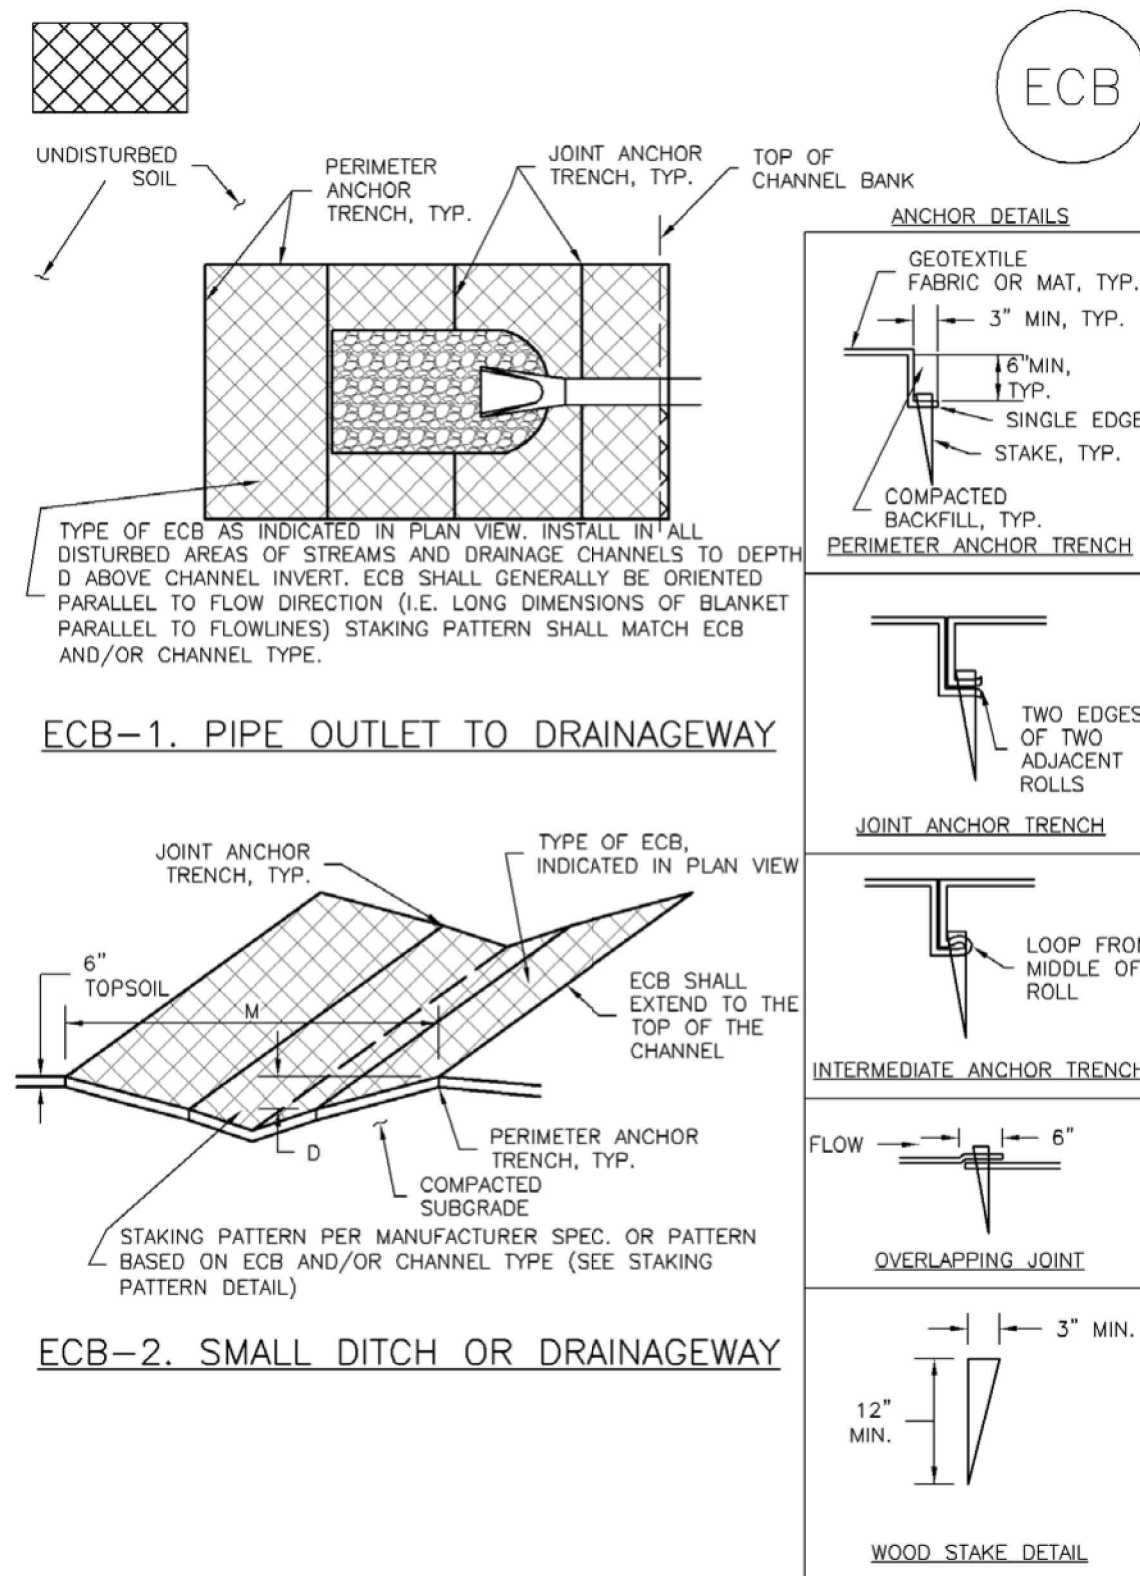

REC-6 Urban Drainage and Flood Control District Urban Storm Drainage Criteria Manual Volume 3 November 2010


Roller Erosion Control Products (RECP) EC-6

EROSION CONTROL BLANKET MAINTENANCE NOTES

- INSPECT BMPs EACH WORKDAY, AND MAINTAIN THEM IN EFFECTIVE OPERATING CONDITION. MAINTENANCE OF BMPs SHOULD BE PROACTIVE, NOT REACTIVE. INSPECT BMPs AS SOON AS POSSIBLE (AND ALWAYS WITHIN 24 HOURS) FOLLOWING A STORM THAT CAUSES SURFACE EROSION, AND PERFORM NECESSARY MAINTENANCE.
 - FREQUENT OBSERVATIONS AND MAINTENANCE ARE NECESSARY TO MAINTAIN BMPs IN EFFECTIVE OPERATING CONDITION. INSPECTIONS AND CORRECTIVE MEASURES SHOULD BE DOCUMENTED THOROUGHLY.
 - WHERE BMPs HAVE FAILED, REPAIR OR REPLACEMENT SHOULD BE INITIATED UPON DISCOVERY OF THE FAILURE.
 - ECBs SHALL BE LEFT IN PLACE TO EVENTUALLY BIODEGRADE, UNLESS REQUESTED TO BE REMOVED BY THE LOCAL JURISDICTION.
 - ANY ECB PULLED OUT, TORN, OR OTHERWISE DAMAGED SHALL BE REPAIRED OR REINSTALLED. ANY SUBGRADE AREAS BELOW THE GEOTEXTILE THAT HAVE ERODED TO CREATE A VOID UNDER THE BLANKET, OR THAT REMAIN DEVOID OF GRASS SHALL BE REPAIRED, RESEDED AND MULCHED AND THE ECB REINSTALLED.
- NOTE: MANY JURISDICTIONS HAVE BMP DETAILS THAT VARY FROM UDFCD STANDARD DETAILS. CONSULT WITH LOCAL JURISDICTIONS AS TO WHICH DETAIL SHOULD BE USED WHEN DIFFERENCES ARE NOTED.
- (DETAILS ADAPTED FROM DOUGLAS COUNTY, COLORADO AND TOWN OF PARKER, COLORADO, NOT AVAILABLE IN AUTOCAD)

REC-6 Urban Drainage and Flood Control District Urban Storm Drainage Criteria Manual Volume 3 November 2010

Roller Erosion Control Products (RECP) EC-6

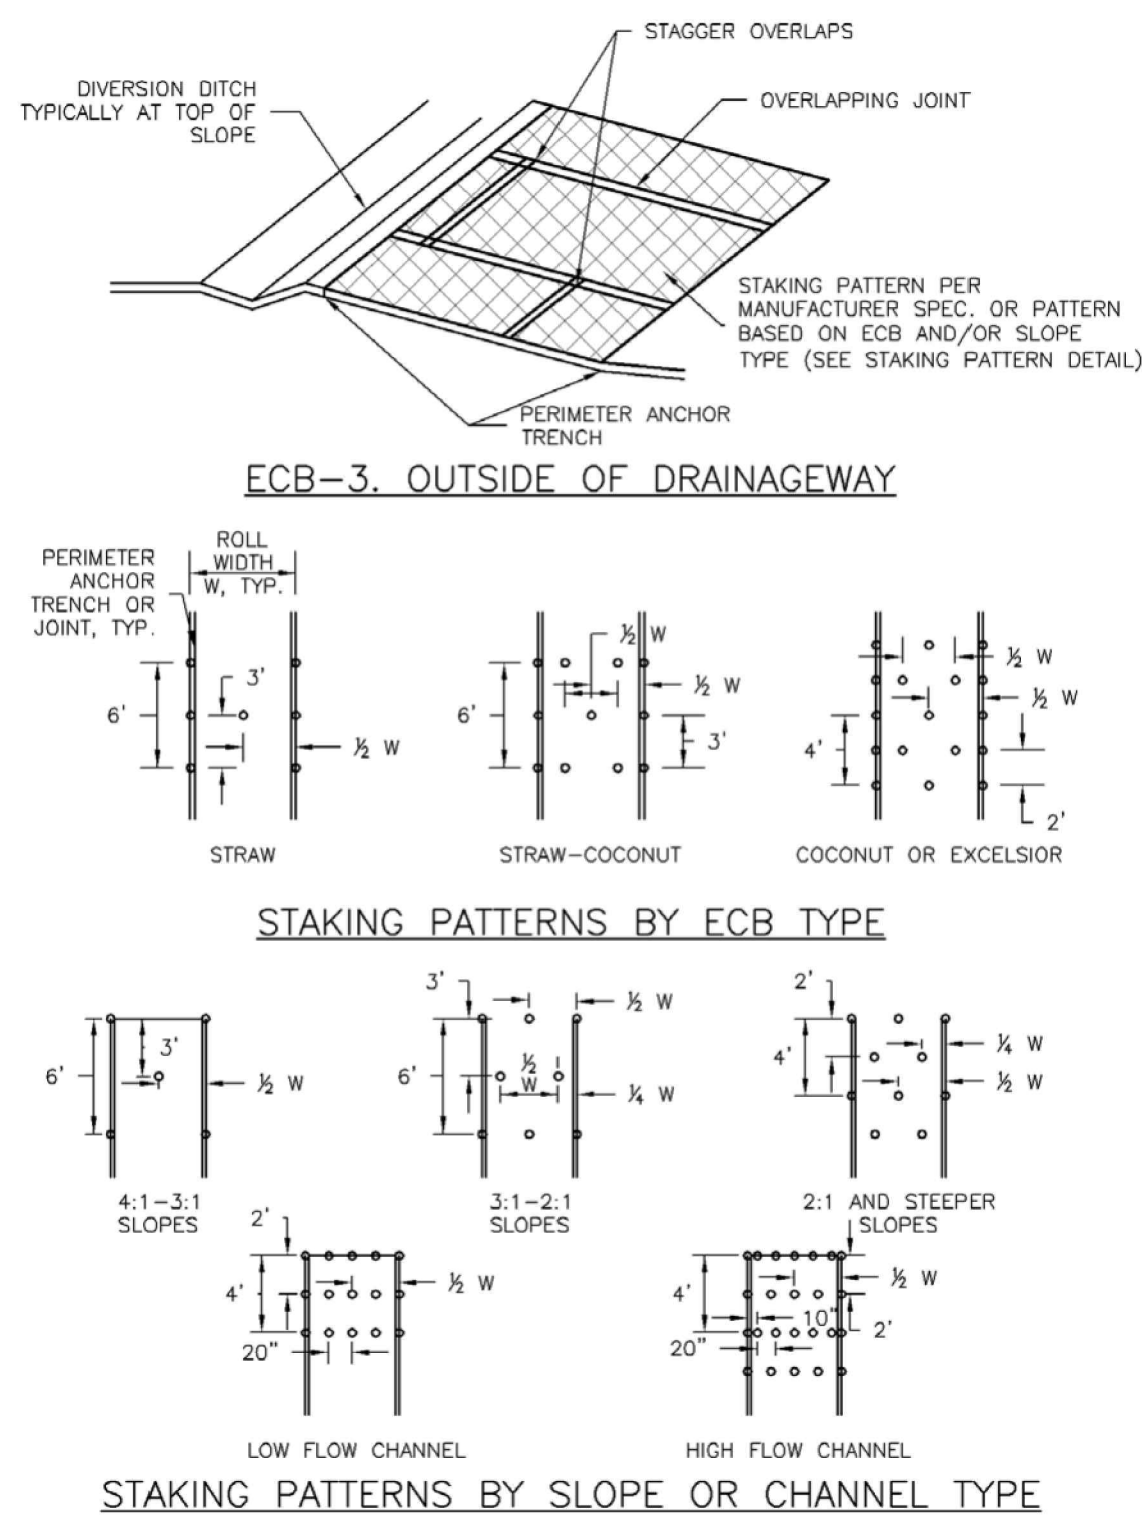

REC-7 Urban Drainage and Flood Control District Urban Storm Drainage Criteria Manual Volume 3 November 2010

T-2 Grass Swale

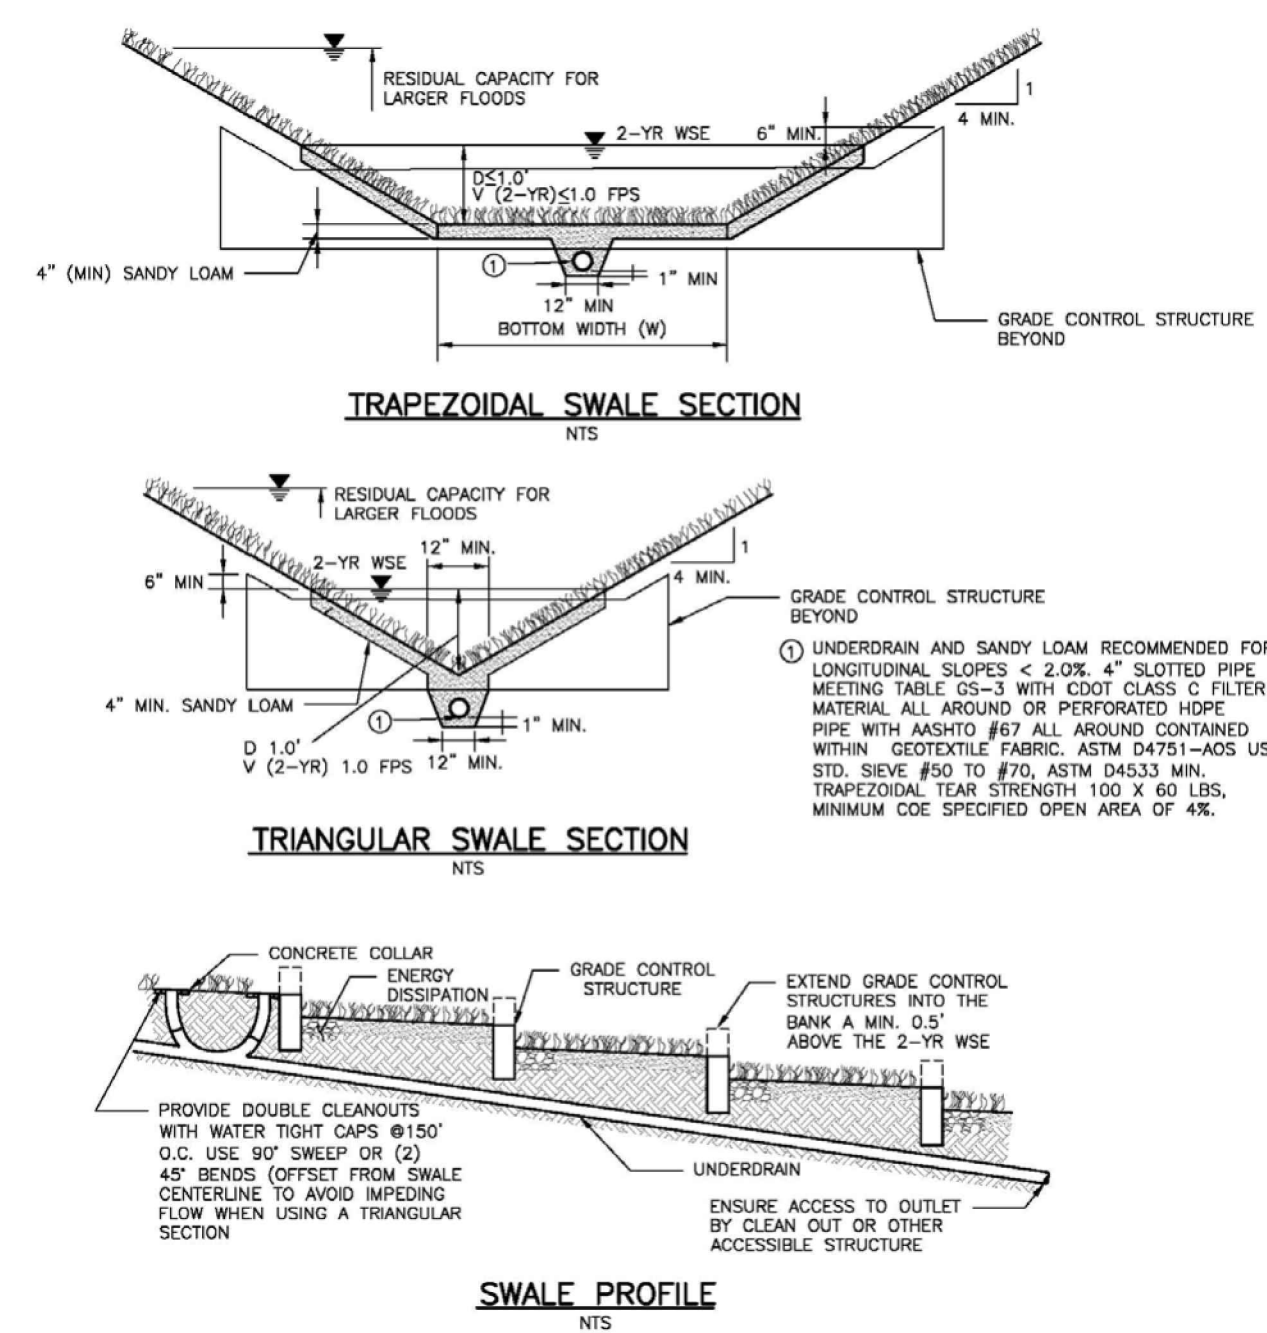


Figure GS-1. Grass Swale Profile and Sections

Design Example

The UD-BMP workbook, designed as a tool for both designer and reviewing agency is available at www.udfcd.org. This section provides a completed design form from this workbook as an example.

REC-6 Urban Drainage and Flood Control District Urban Storm Drainage Criteria Manual Volume 3 November 2010

REC-6 Rolled Erosion Control Products (RECP)

EROSION CONTROL BLANKET INSTALLATION NOTES

- SEE PLAN VIEW FOR:
 - LOCATION OF ECB.
 - TYPE OF ECB (STRAW, STRAW-COCONUT, COCONUT, OR EXCELSIOR).
 - AREA, A, IN SQUARE YARDS OF EACH TYPE OF ECB.
- 100% NATURAL AND BIODEGRADABLE MATERIALS ARE PREFERRED FOR RECPs, ALTHOUGH SOME JURISDICTIONS MAY ALLOW OTHER MATERIALS IN SOME APPLICATIONS.
- IN AREAS WHERE ECBs ARE SHOWN ON THE PLANS, THE PERMITTEE SHALL PLACE TOPSOIL AND PERFORM FINAL GRADING, SURFACE PREPARATION, AND SEEDING AND MULCHING. SUBGRADE SHALL BE SMOOTH AND MOIST PRIOR TO ECB INSTALLATION AND THE ECB SHALL BE IN FULL CONTACT WITH SUBGRADE. NO GAPS OR VOIDS SHALL EXIST UNDER THE BLANKET.
- PERIMETER ANCHOR TRENCH SHALL BE USED ALONG THE OUTSIDE PERIMETER OF ALL BLANKET AREAS.
- JOINT ANCHOR TRENCH SHALL BE USED TO JOIN ROLLS OF ECBs TOGETHER (LONGITUDINALLY AND TRANSVERSELY) FOR ALL ECBs EXCEPT STRAW WHICH MAY USE AN OVERLAPPING JOINT.
- INTERMEDIATE ANCHOR TRENCH SHALL BE USED AT SPACING OF ONE-HALF ROLL LENGTH FOR COCONUT AND EXCELSIOR ECBs.
- OVERLAPPING JOINT DETAIL SHALL BE USED TO JOIN ROLLS OF ECBs TOGETHER FOR ECBs ON SLOPES.
- MATERIAL SPECIFICATIONS OF ECBs SHALL CONFORM TO TABLE ECB-1.
- ANY AREAS OF SEEDING AND MULCHING DISTURBED IN THE PROCESS OF INSTALLING ECBs SHALL BE RESEDED AND MULCHED.
- DETAILS ON DESIGN PLANS FOR MAJOR DRAINAGEWAY STABILIZATION WILL GOVERN IF DIFFERENT FROM THOSE SHOWN HERE.

TABLE ECB-1. ECB MATERIAL SPECIFICATIONS				
TYPE	COCONUT CONTENT	STRAW CONTENT	EXCELSIOR CONTENT	RECOMMENDED NETTING**
STRAW*	-	100%	-	DOUBLE/NATURAL
STRAW-COCONUT	30% MIN	70% MAX	-	DOUBLE/NATURAL
COCONUT	100%	-	-	DOUBLE/NATURAL
EXCELSIOR	-	-	100%	DOUBLE/NATURAL

*STRAW ECBs MAY ONLY BE USED OUTSIDE OF STORM AND DRAINAGE CHANNEL.
**ALTERNATE NETTING MAY BE ACCEPTABLE IN SOME JURISDICTIONS

REC-8 Urban Drainage and Flood Control District Urban Storm Drainage Criteria Manual Volume 3 November 2010


**GRADING & EROSION CONTROL PLANS
GRANDVIEW RESERVE FILING NO. 1
MELODY HOMES, INC.
SF2311**

EASTONVILLE RD & REX RD
EL PASO COUNTY, FALCON, CO 80831


#	Date	Issue / Description	Init.

Project No: HRG02
Drawn By: JDM, BLB
Checked By: BAS, CMWJ
Date: 03/15/2024


EROSION CONTROL
DETAILS

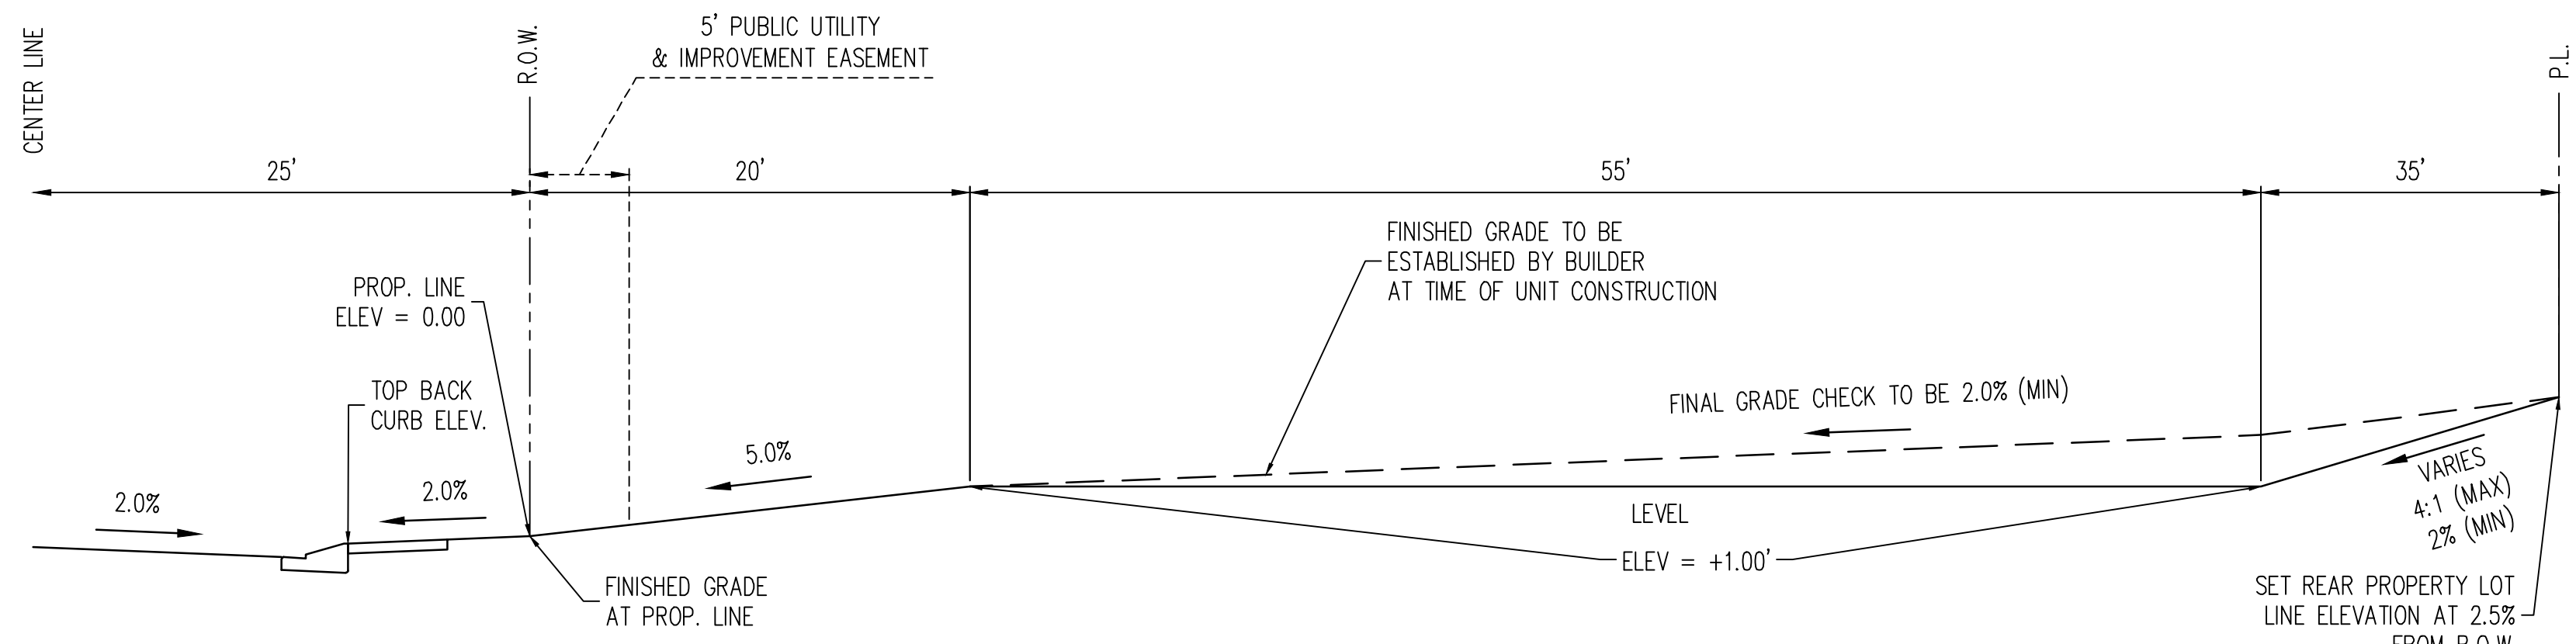


TYPICAL A LOT
N.T.S.

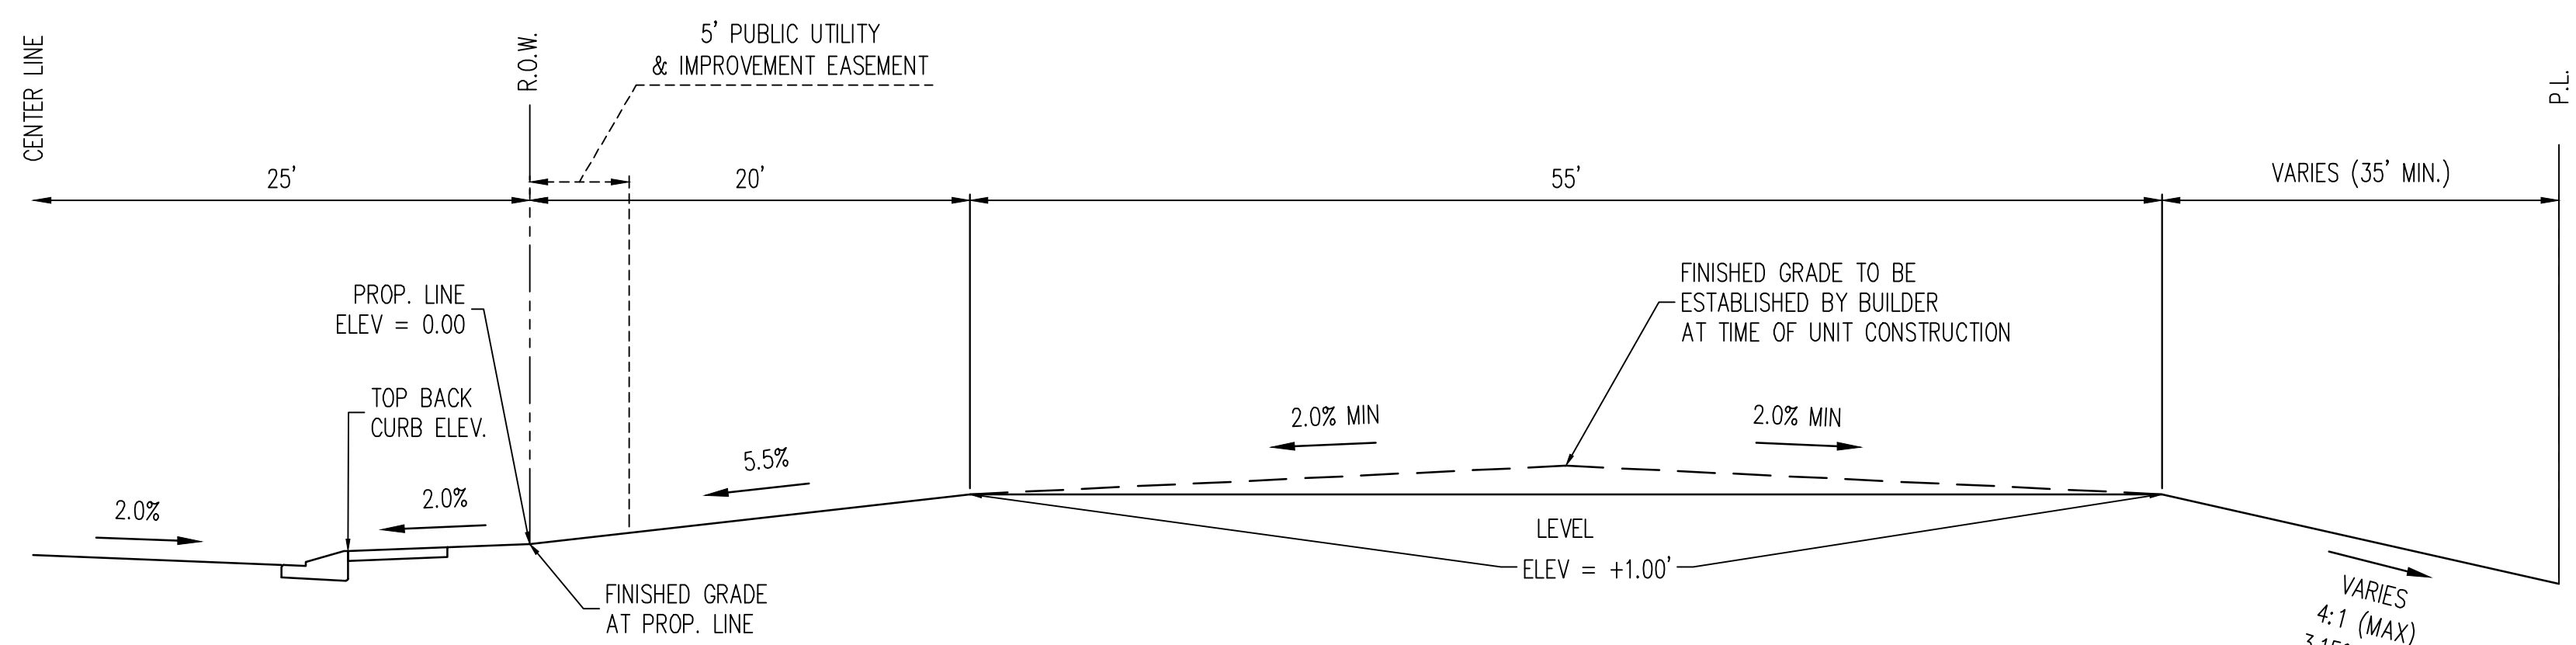


TYPICAL B LOT
N.T.S.

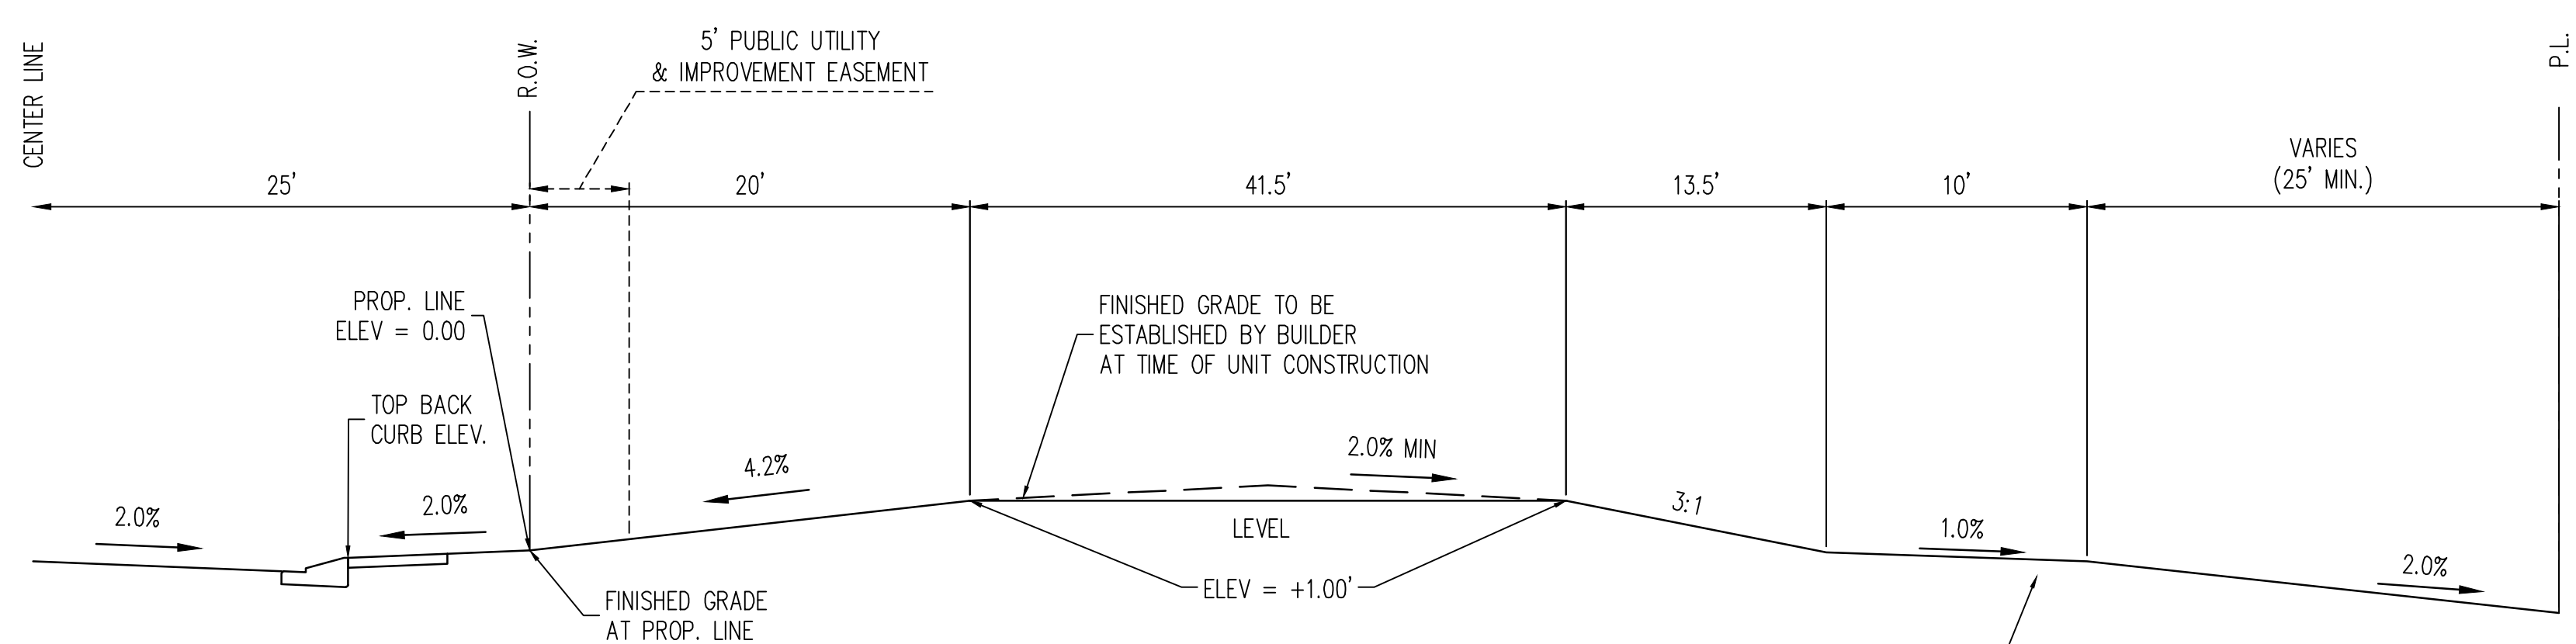



TYPICAL G LOT
N.T.S.

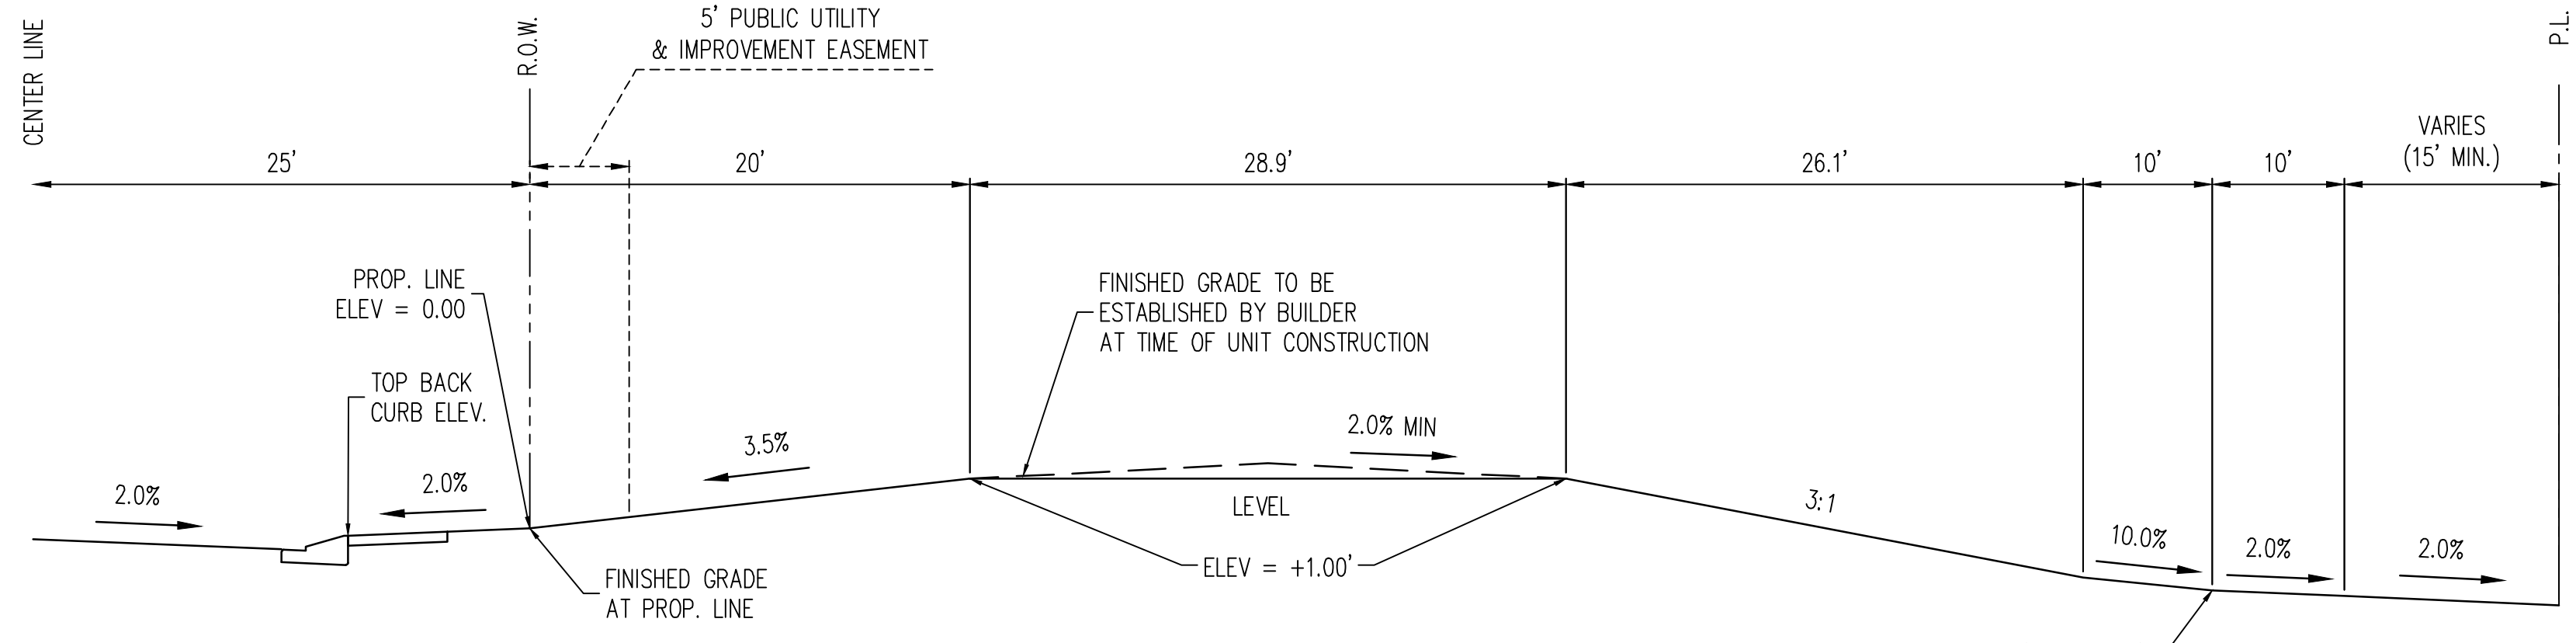

TYPICAL W/O LOT
N.T.S.

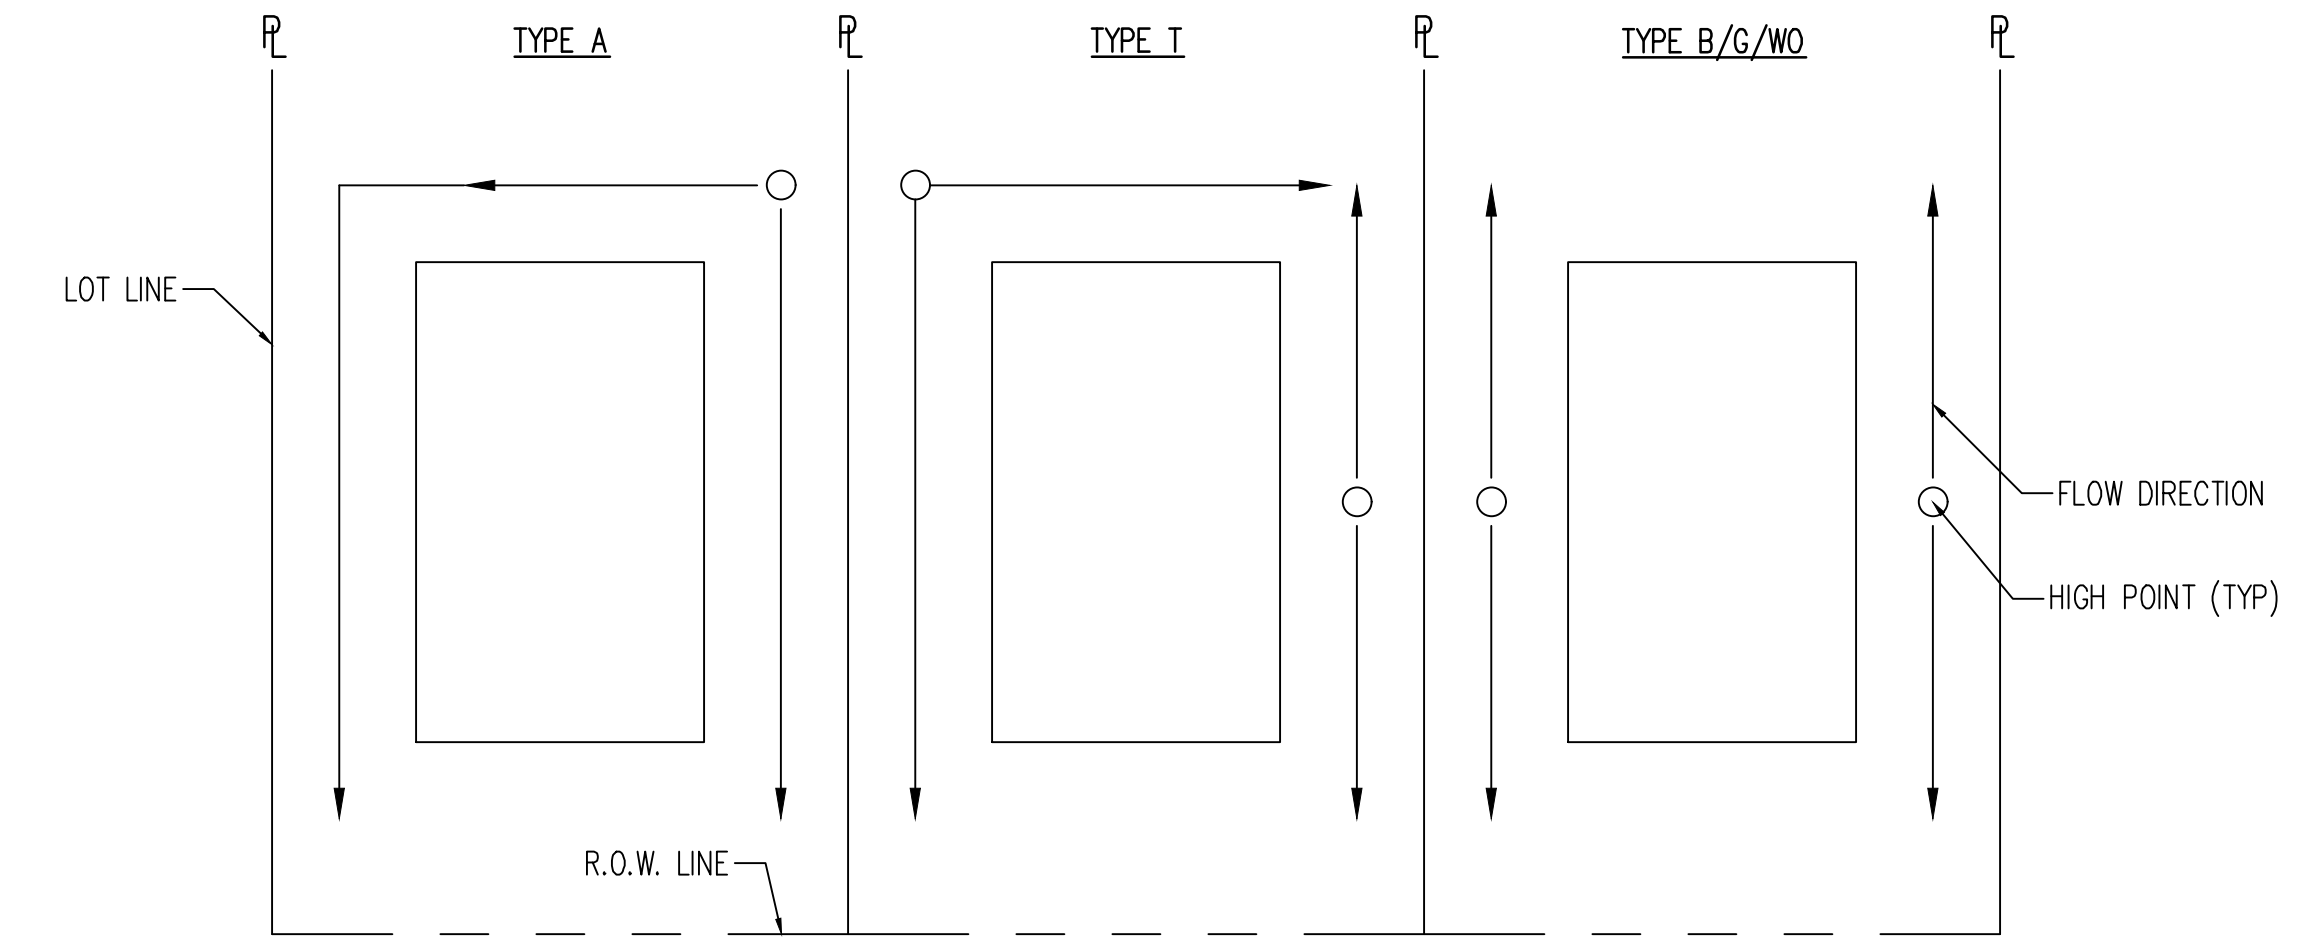

- NOTES:
- TRANSITION LOTS IDENTIFIED BY A "T" ARE INCLUDED TO INDICATE LOTS THAT WILL REQUIRE HOME BUILDERS TO PREPARE A SITE SPECIFIC GRADING PLAN TO DETAIL THE GRADING TRANSITION FROM TYPE A/B LOTS TO GARDEN/WALKOUT LOTS
 - THE DEVELOPER/HOME BUILDER SHALL INSTALL SIDE LOT SWALES TO MINIMIZE THE LOT TO LOT DRAINAGE.

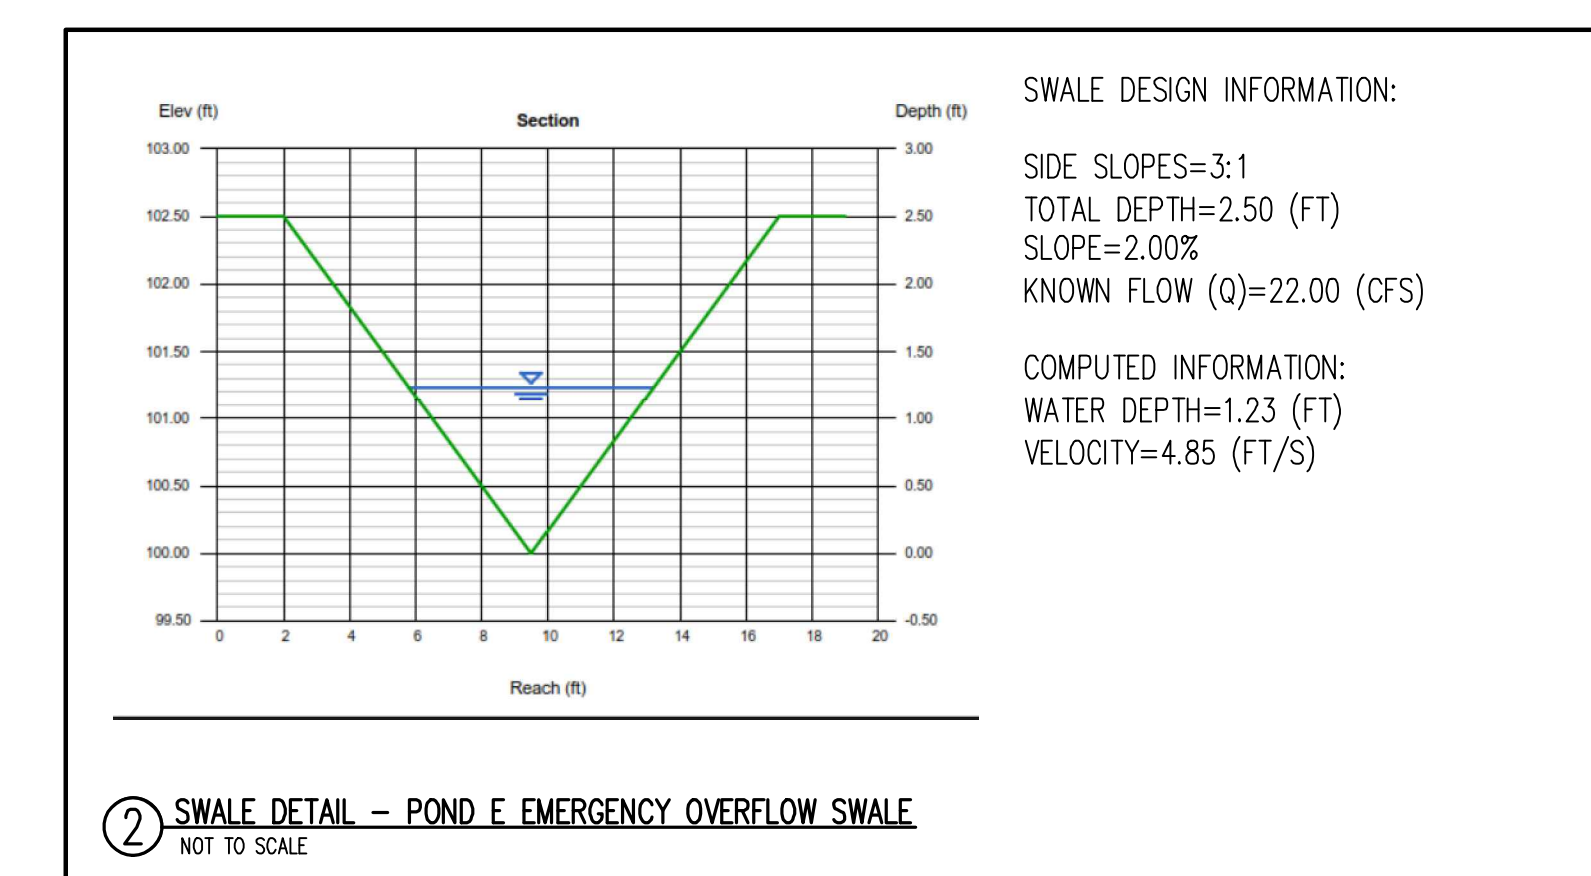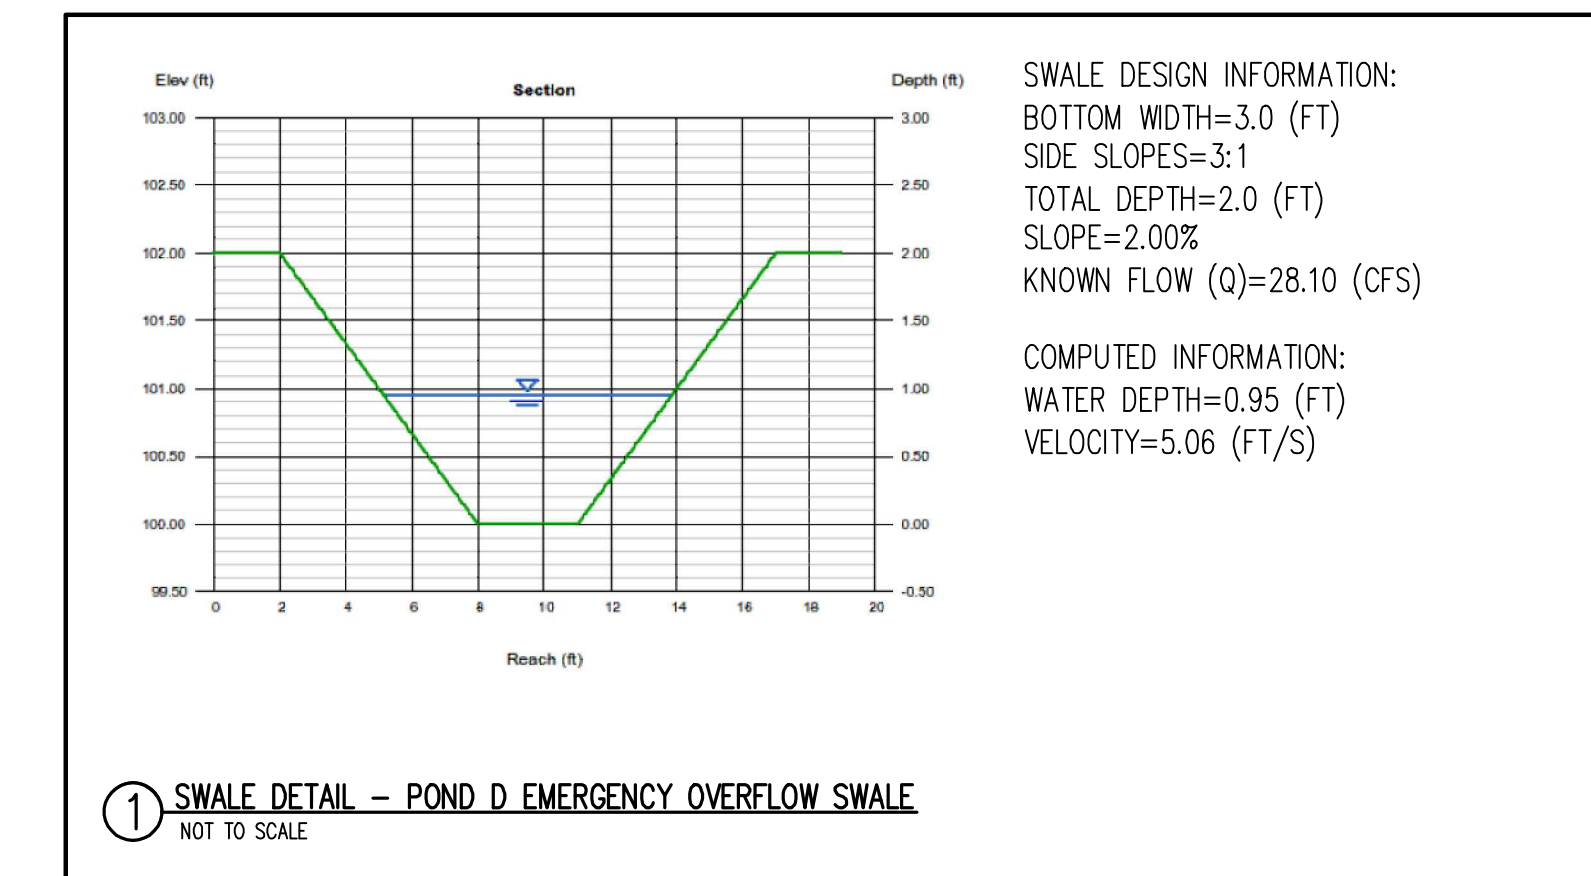


COPYRIGHT
 THESE PLANS ARE AN INSTRUMENT OF SERVICE AND ARE THE PROPERTY OF GALLOWAY, AND MAY NOT BE DUPLICATED, DISCLOSED, OR REPRODUCED WITHOUT THE WRITTEN CONSENT OF GALLOWAY. COPYRIGHTS AND INFRINGEMENTS WILL BE ENFORCED AND PROSECUTED.

GRADING & EROSION CONTROL PLANS
 GRANDVIEW RESERVE FILING NO. 1
 MELODY HOMES, INC.
 SF2311
 EASTONVILLE RD & REX RD
 EL PASO COUNTY, FALCON, CO 80831

#	Date	Issue / Description	Init.


Project No:	HRG02
Drawn By:	JDM, BLB
Checked By:	BAS, CMWJ
Date:	03/15/2024

GENERAL GRADING
 DETAILS

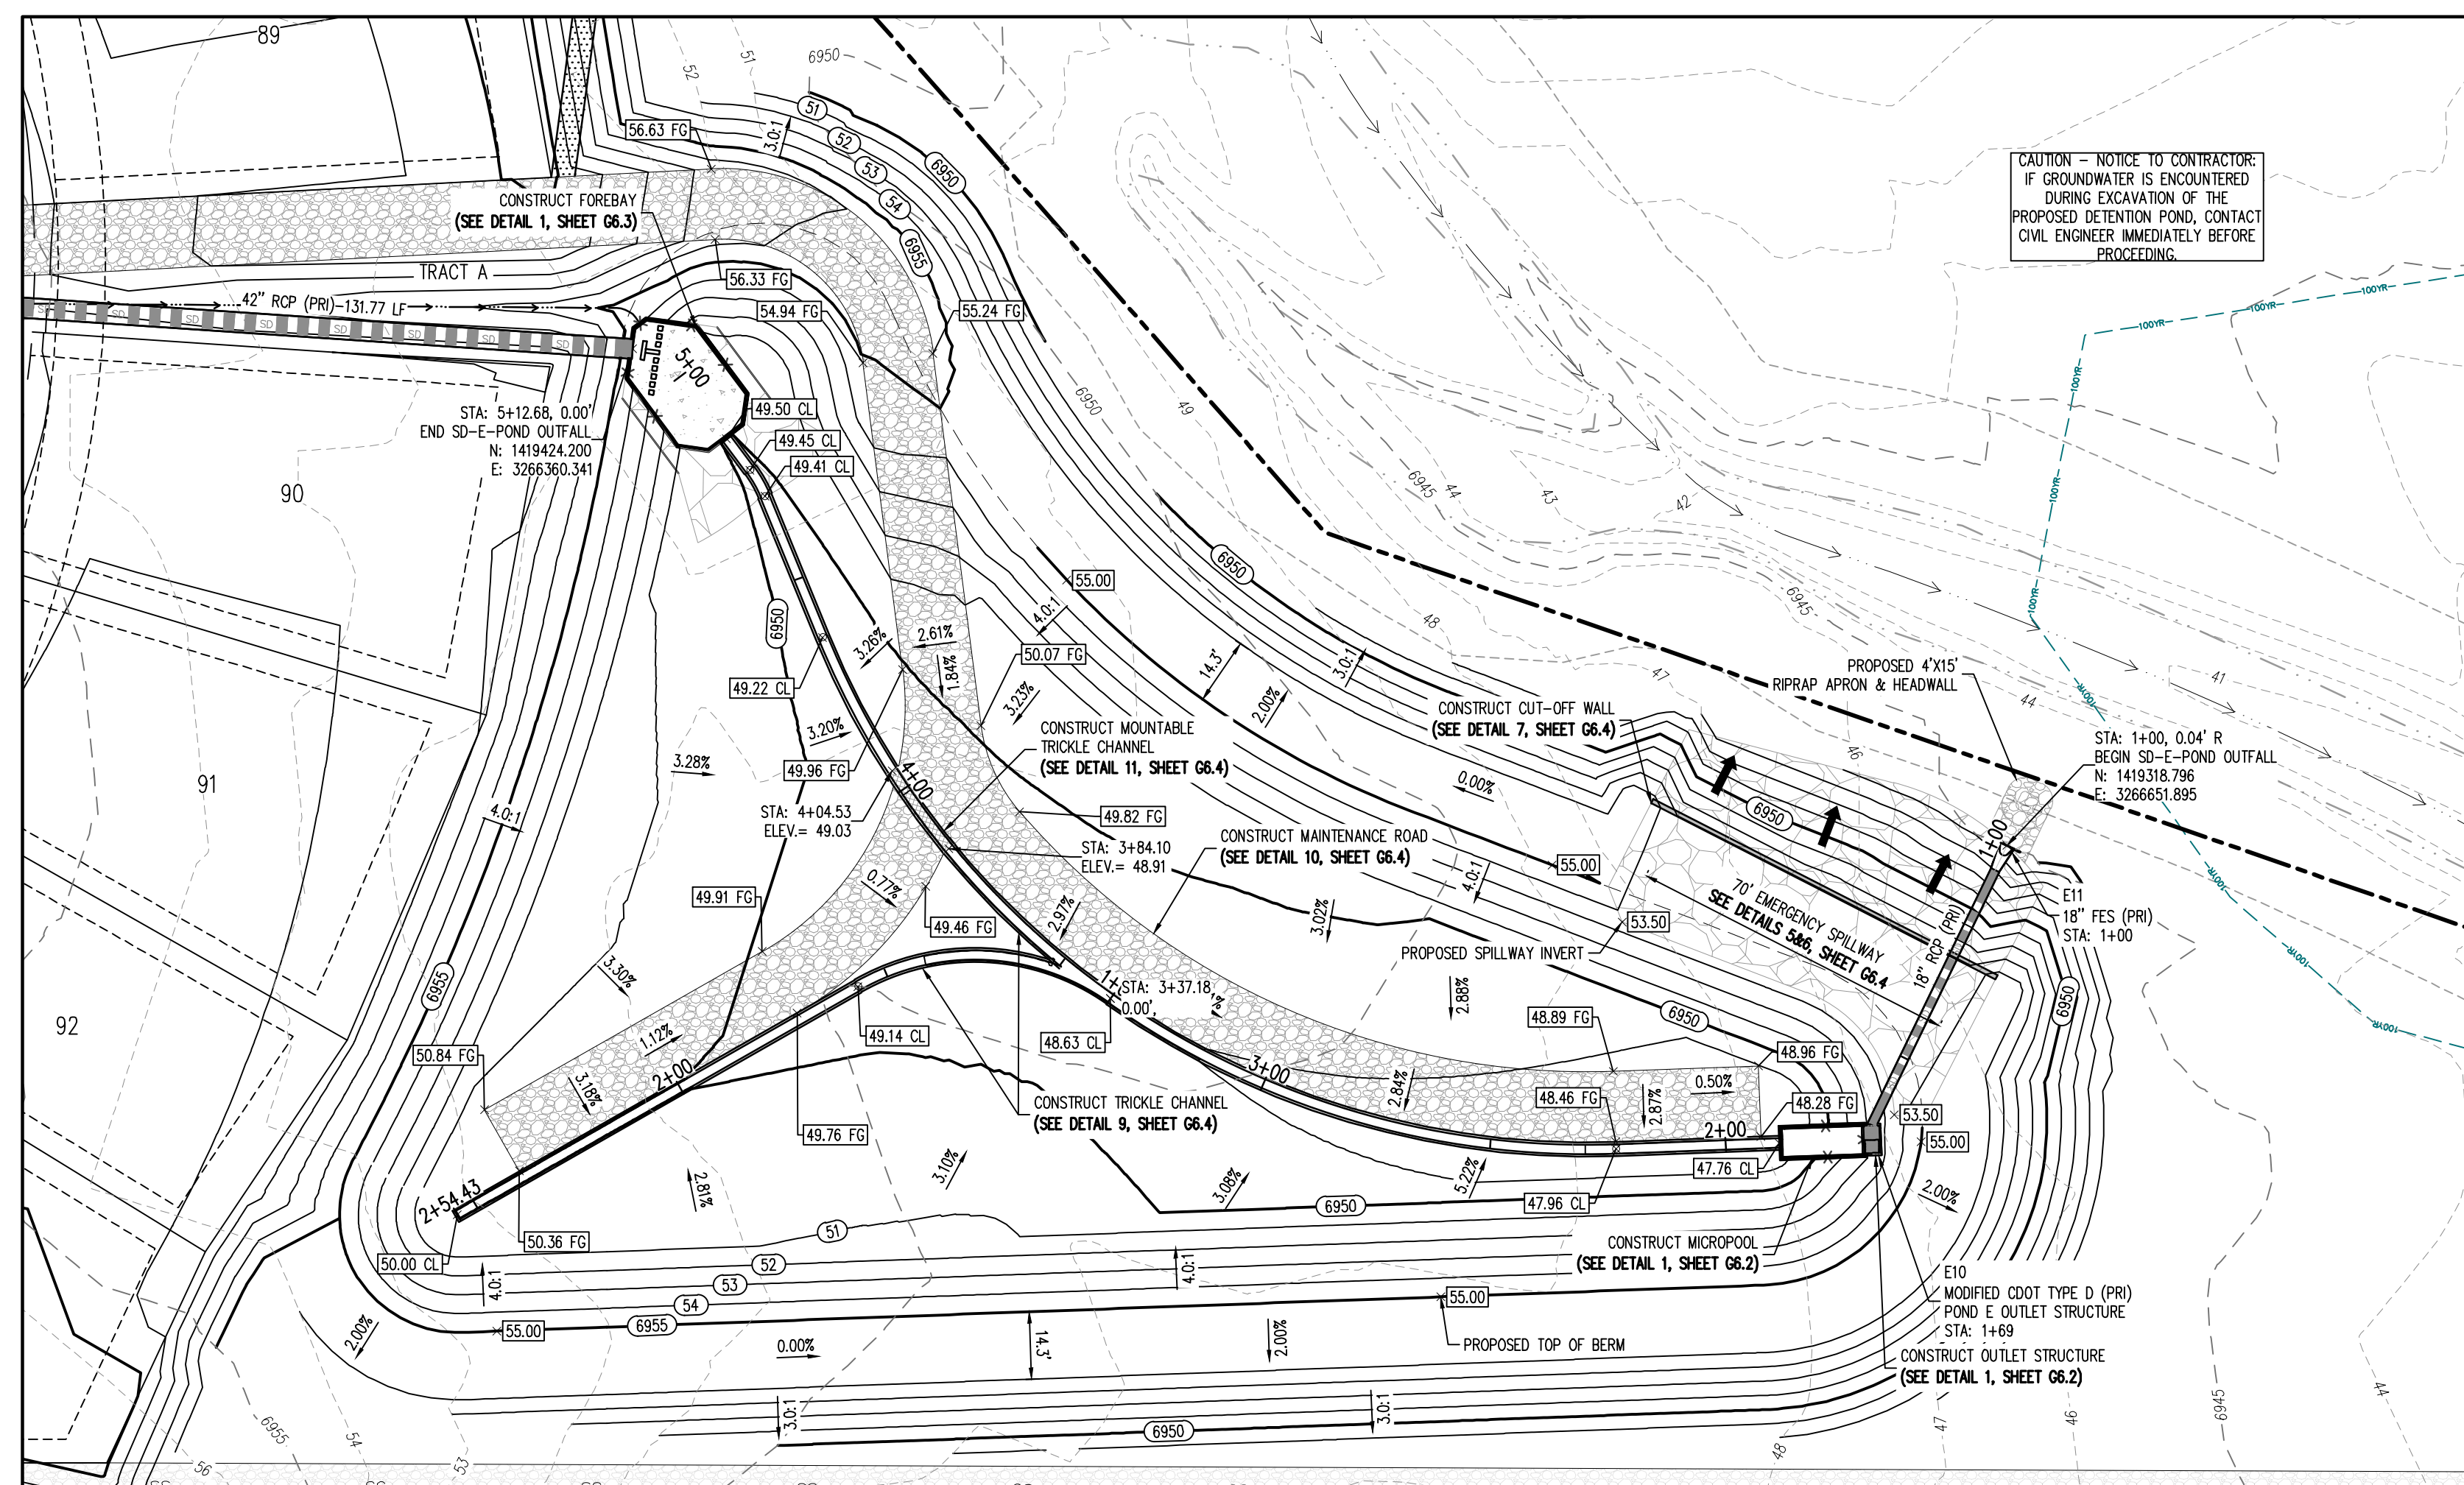

STORM DRAIN LINE PLAN: SD-E-POND OUTFALL (STA: 0+75 - 5+88.56)

SCALE: 1"=30'

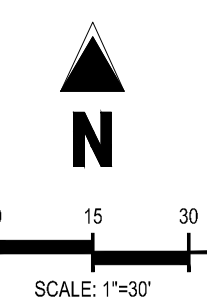

GRADING LEGEND

5460	EXISTING MAJOR CONTOUR
52	EXISTING MINOR CONTOUR
5465	PROPOSED MAJOR CONTOUR
56	PROPOSED MINOR CONTOUR
2.00%	EXISTING SLOPE - PERCENT
4:1	EXISTING SLOPE - RISE/RUN
2.00%	PROPOSED SLOPE - PERCENT
4:1	PROPOSED SLOPE - RISE/RUN
89.00 HP	PROPOSED SPOT ELEVATION - HIGH POINT
89.00 LP	PROPOSED SPOT ELEVATION - LOW POINT
89.00 TOR	PROPOSED SPOT ELEVATION - TOP OF BERM
89.00 FL	PROPOSED SPOT ELEVATION - FLOW LINE
89.00 TG	PROPOSED SPOT ELEVATION - TOP OF GRATE
89.00 FG	PROPOSED SPOT ELEVATION - FINISHED GRADE
89.00 SW	PROPOSED SPOT ELEVATION - SIDEWALK
89.00 EDC	PROPOSED SPOT ELEVATION - EDGE OF CONCRETE
89.00 EDA	PROPOSED SPOT ELEVATION - EDGE OF ASPHALT
89.00 ME	PROPOSED SPOT ELEVATION - MATCH EXISTING

UTILITY LEGEND

W	EXISTING WATER LINE
W	PROPOSED WATER LINE
SS	EXISTING SANITARY SEWER
SS	PROPOSED SANITARY SEWER
SS	EXISTING STORM SEWER
SS	PROPOSED STORM SEWER
G	EXISTING GAS LINE
G	PROPOSED GAS LINE
S	EXISTING STREET LIGHT
S	PROPOSED STREET LIGHT
M	PROPOSED WATER METER
V	EXISTING WATER VALVE
V	PROPOSED WATER VALVE
H	EXISTING FIRE HYDRANT
H	PROPOSED FIRE HYDRANT
M	EXISTING STORM SEWER MANHOLE
M	PROPOSED STORM SEWER MANHOLE
S	EXISTING SANITARY SEWER MANHOLE
S	PROPOSED SANITARY SEWER MANHOLE

SITE LEGEND

---	PROPERTY BOUNDARY LINE
---	ADJACENT PROPERTY BOUNDARY LINE
---	RIGHT OF WAY BOUNDARY LINE
---	SECTION LINE
---	EXISTING ADJACENT LOT LINE
---	PROPOSED LOT LINE
---	EXISTING EASEMENT LINE
---	PROPOSED EASEMENT LINE
---	ROAD CENTERLINE
---	PROPOSED RIDGE LINE
---	PROPOSED SWALE LINE
---	EXISTING SWALE LINE
---	EXISTING SWALE LINE
---	FLOODPLAIN BOUNDARY
---	EXISTING FLOOD ZONE
---	EXISTING FLOOD ZONE SETBACK
---	PROPOSED CURB AND GUTTER
---	EXISTING CURB AND GUTTER
---	PROPOSED SIDEWALK
---	PROPOSED TRAIL
---	PROPOSED GRAVEL PER EDC TABLE D-7
---	RRIPRAP OUTFALL PADS
---	EXISTING SIGN
---	PROPOSED SIGN
---	PROPOSED CONCRETE
---	EXISTING CONCRETE

BASIS OF BEARING


THE NORTH LINE OF SECTION 28, TOWNSHIP 12 SOUTH, RANGE 64 WEST OF THE 6TH PRINCIPAL MERIDIAN, EL PASO COUNTY, STATE OF COLORADO BEING MONUMENTED AT EACH END BY A 3-1/4" ALUMINUM SURVEYORS CAP STAMPING P-53087 AND ASSUMED TO BEAR S89°47'04"E, A DISTANCE OF 5285.07 FEET.

BENCHMARK

NBS BENCHMARK F 24 A STANDARD DISK, STAMPED F 24 1929 AND SET IN THE TOP OF A CONCRETE POST PROJECTING ABOUT 6 INCHES ABOVE GROUND, ALONG THE CHICAGO, ROCK ISLAND AND PACIFIC RAILROAD, 52 FEET NORTHWEST OF THE CENTERLINE OF U.S. HIGHWAY 24, 48 FEET SOUTHEAST OF THE CENTERLINE OF THE TRACK NAVD88 ELEVATION = 6866.33


CAUTION - NOTICE TO CONTRACTOR

- ALL UTILITY LOCATIONS SHOWN ARE BASED ON MAPS PROVIDED BY THE APPROPRIATE UTILITY COMPANY AND FIELD SURFACE EVIDENCE AT THE TIME OF SURVEY AND IS TO BE CONSIDERED AN APPROXIMATE LOCATION ONLY. IT IS THE CONTRACTOR'S RESPONSIBILITY TO FIELD VERIFY THE LOCATION OF ALL UTILITIES, PUBLIC OR PRIVATE, WHETHER SHOWN ON THE PLANS OR NOT, PRIOR TO CONSTRUCTION. REPORT ANY DISCREPANCIES TO THE ENGINEER PRIOR TO CONSTRUCTION.
- WHERE A PROPOSED UTILITY GROSSES AN EXISTING UTILITY, IT IS THE CONTRACTOR'S RESPONSIBILITY TO FIELD VERIFY THE HORIZONTAL AND VERTICAL LOCATION OF SUCH EXISTING UTILITY, EITHER THROUGH POT-HOLING OR ALTERNATIVE METHOD. REPORT INFORMATION TO THE ENGINEER PRIOR TO CONSTRUCTION.

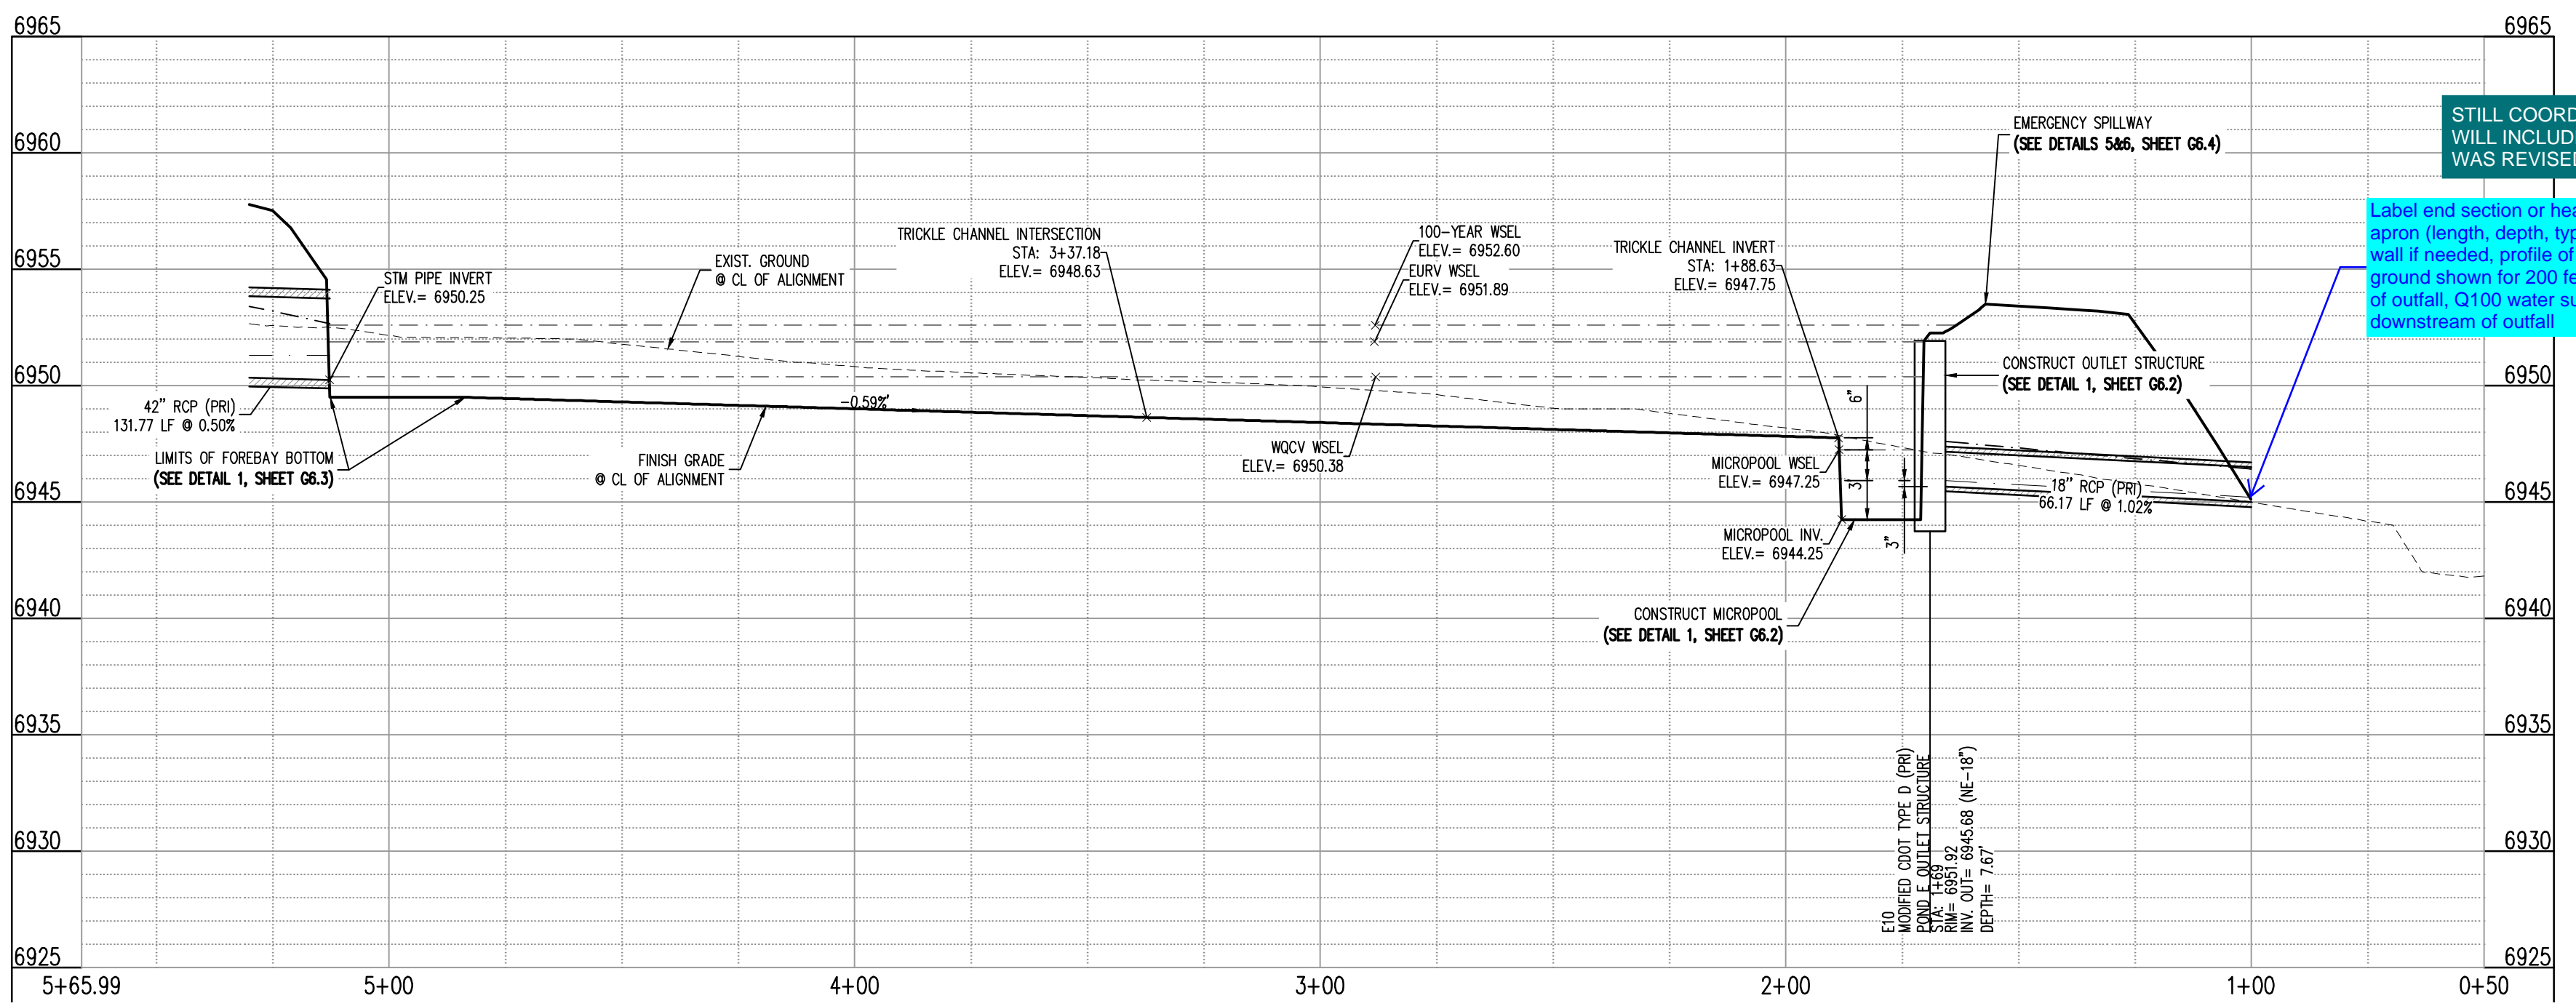

STORM DRAIN LINE PROFILE: SD-E-POND OUTFALL (STA: 0+50 - 5+65.99)

SCALE: HORIZONTAL 1"=30', VERTICAL 1"=6'

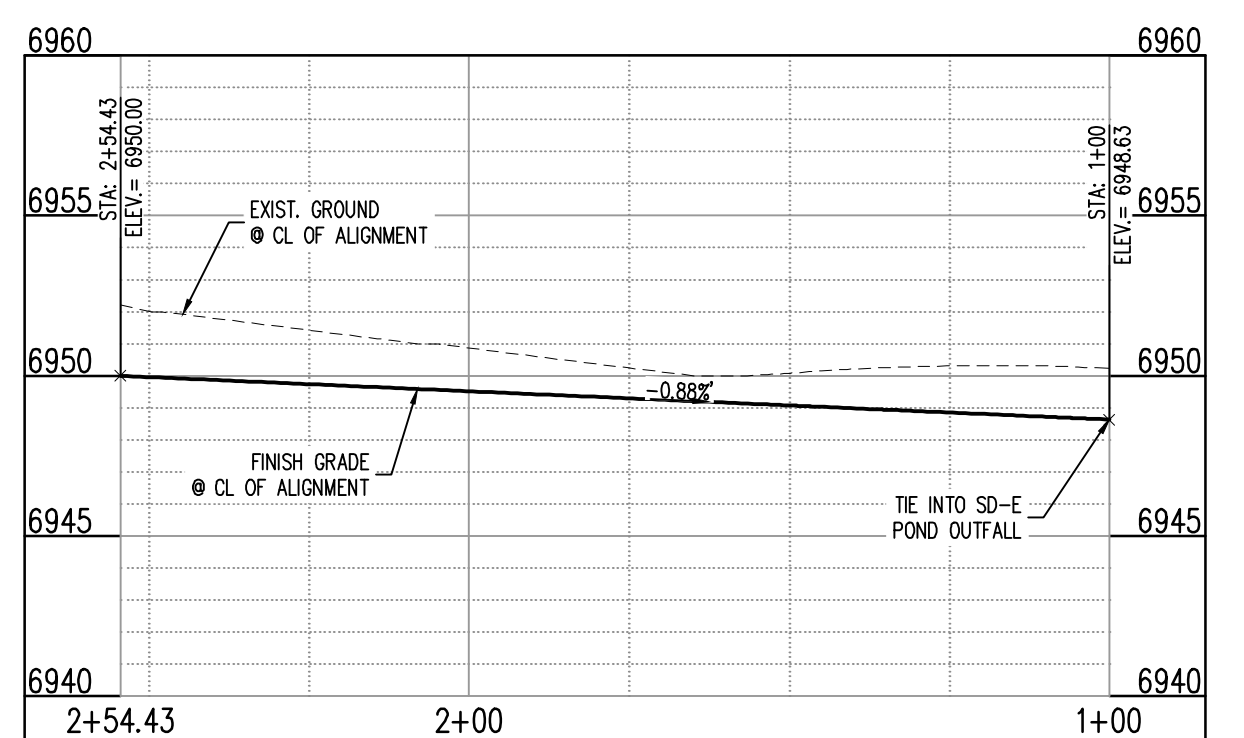

STORM DRAIN LINE PROFILE: SD-E-POND TRICKLE CHANNEL (STA: 1+00 - 2+54.43)

SCALE: HORIZONTAL 1"=30', VERTICAL 1"=6'


#	Date	Issue / Description	Init.

Project No:	HRG02
Drawn By:	JDM, BLB
Checked By:	BAS, CMWJ
Date:	03/15/2024



#	Date	Issue / Description	Init.

Project No:	HRG02
Drawn By:	JDM, BLB
Checked By:	BAS, CMWJ
Date:	03/15/2024


POND E - OUTLET STRUCTURE DETAILS

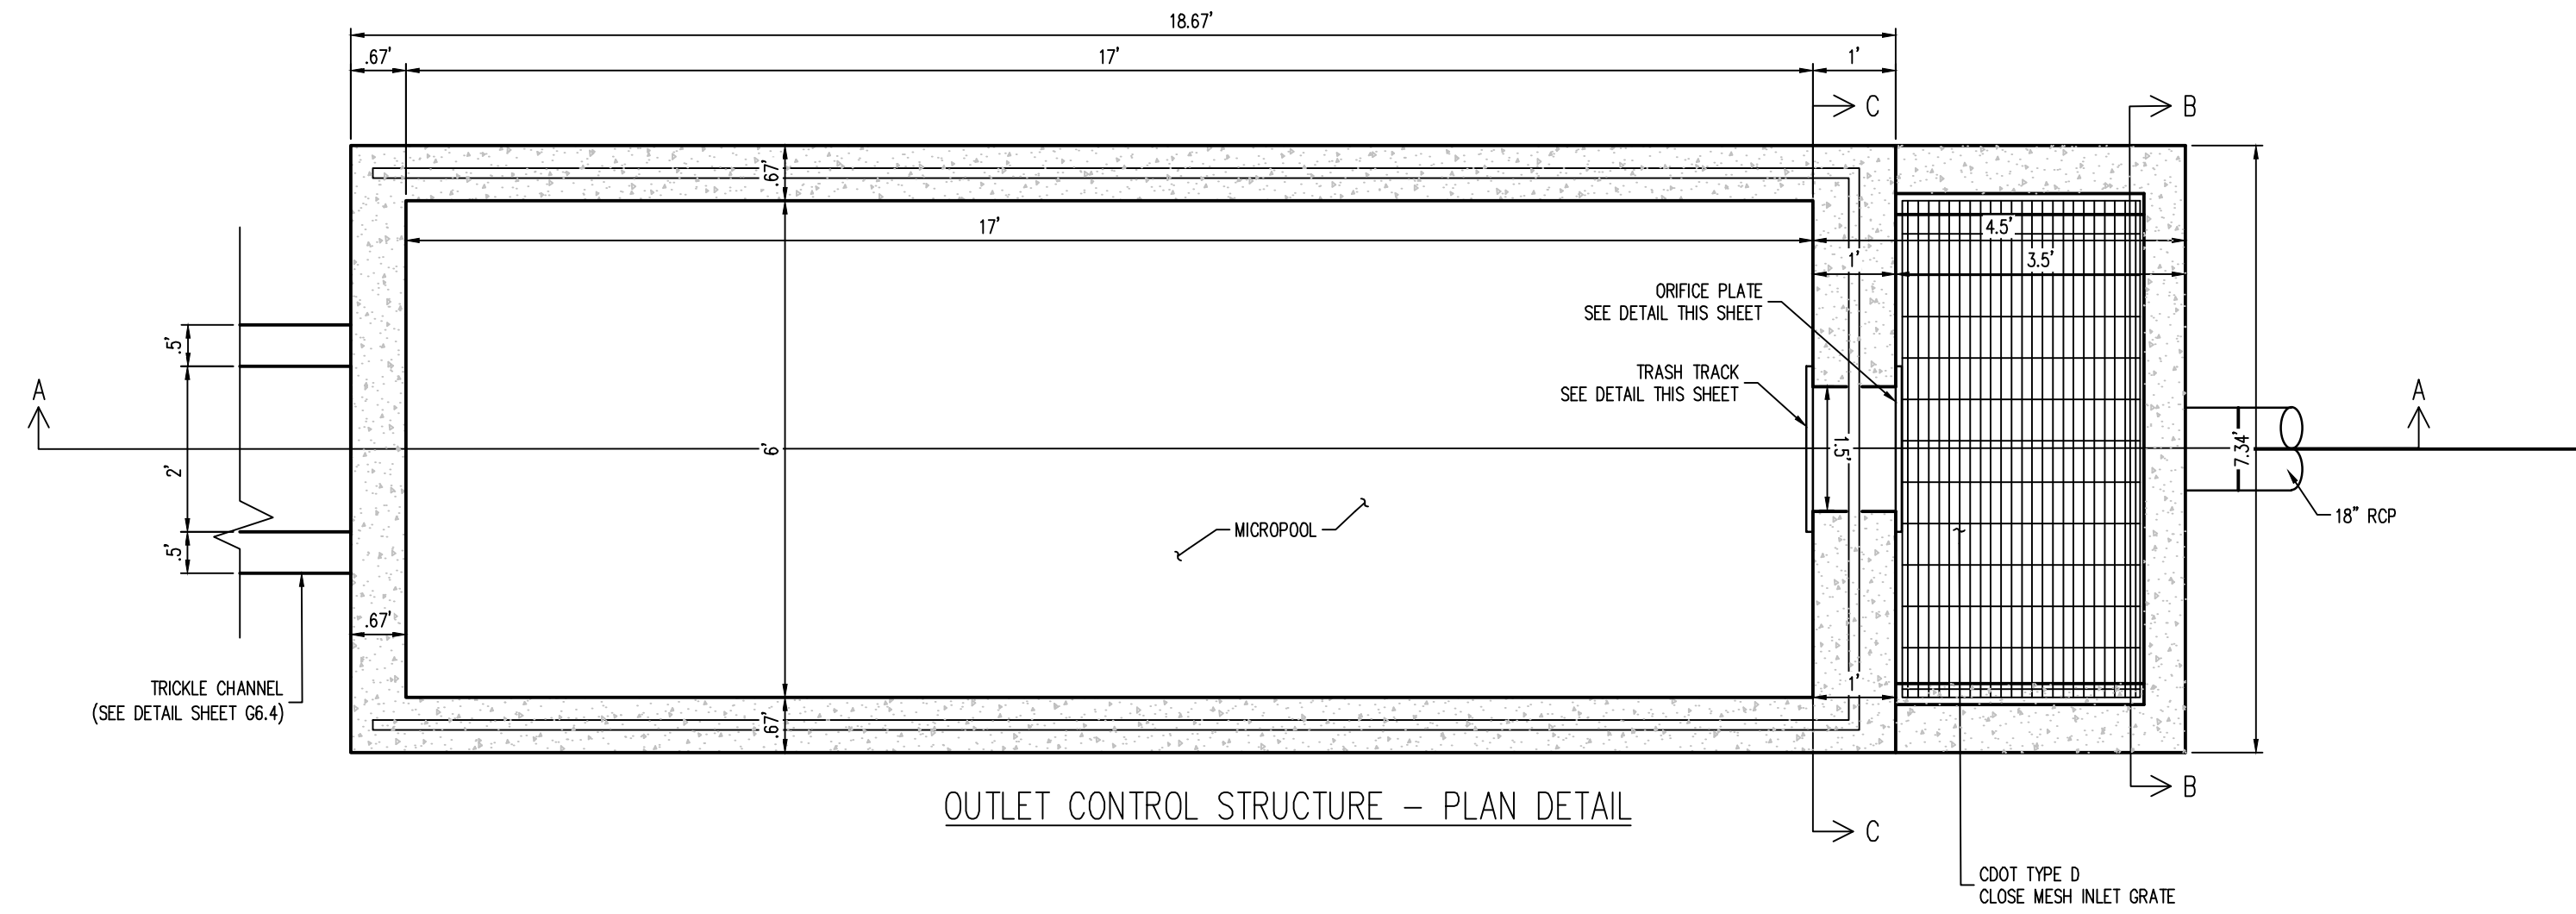


NOTE: ALL BAR REINFORCEMENTS SHALL CONFORM WITH CDOT M&S - M-604-11 INLET TYPE D

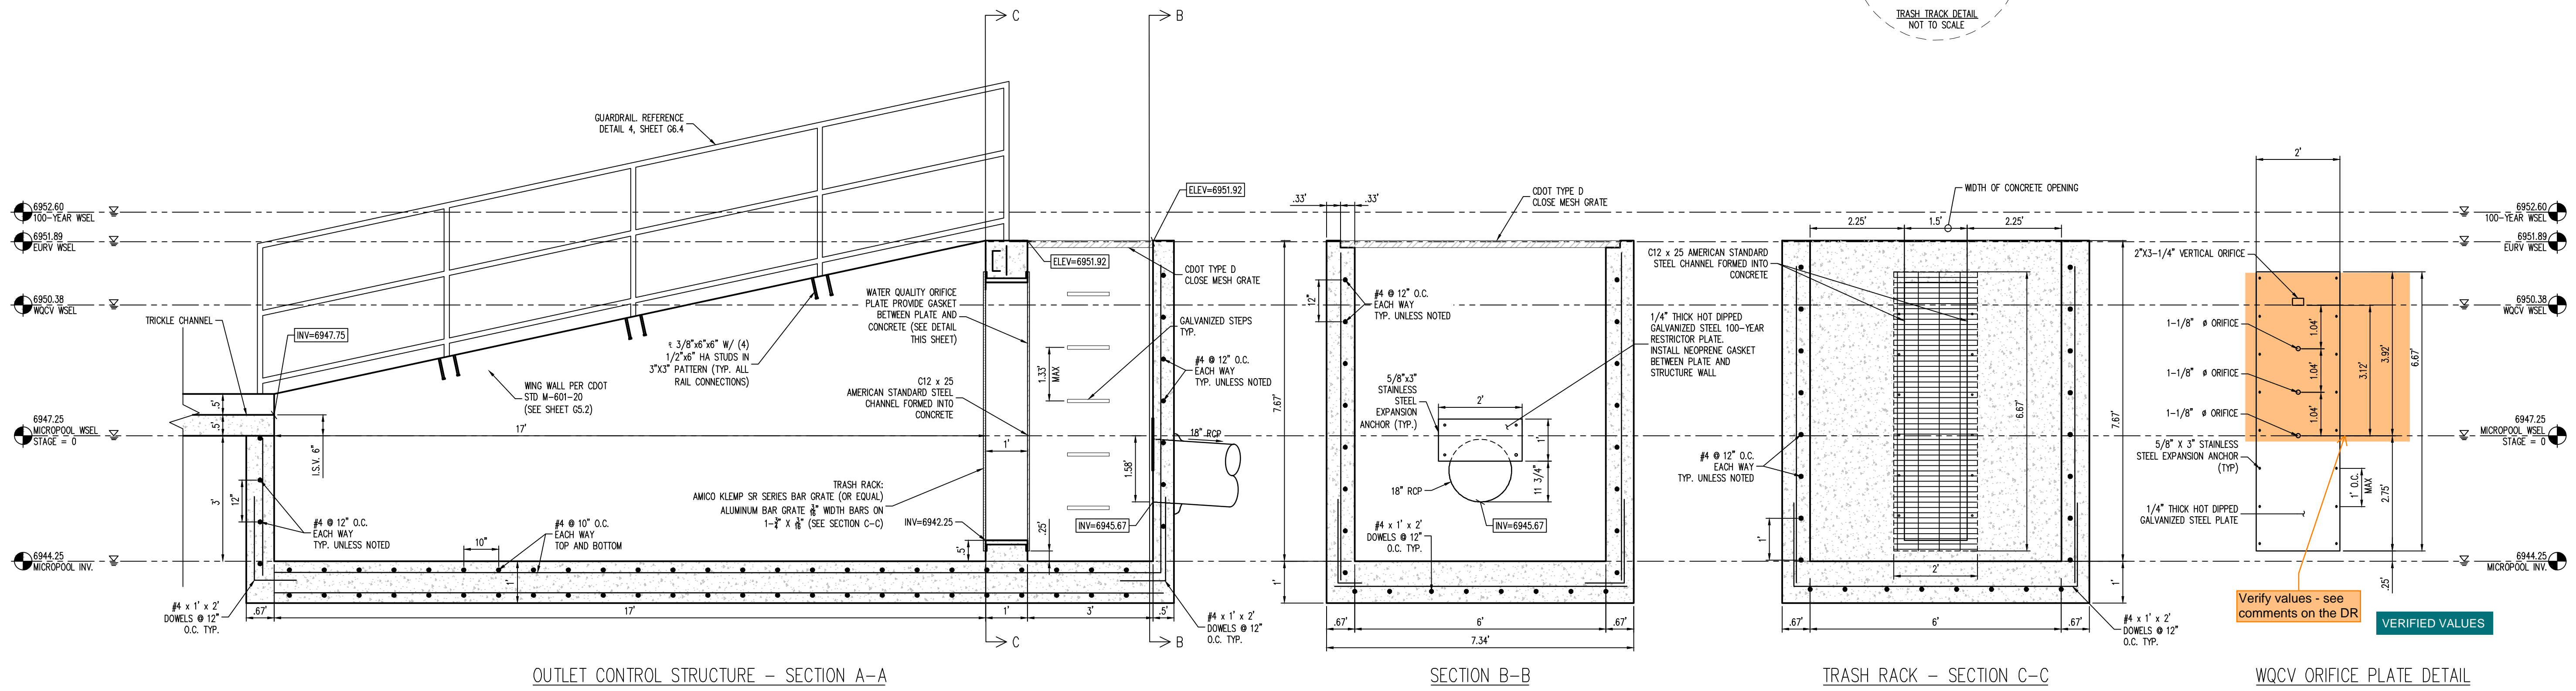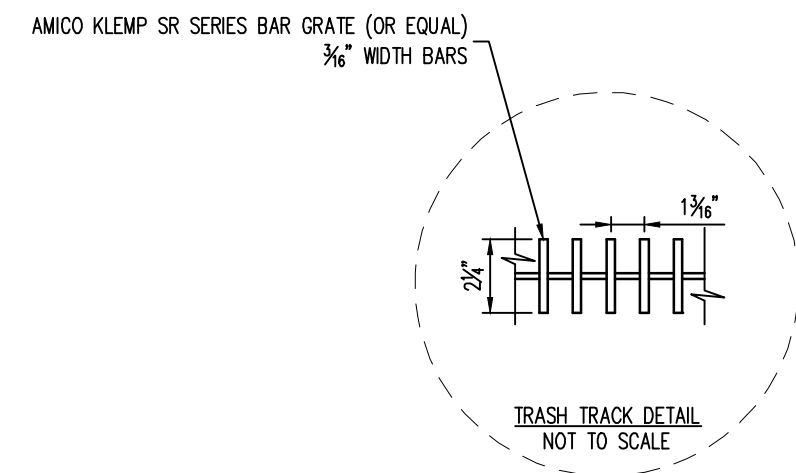

Verify values - see comments on the DR
VERIFIED VALUES


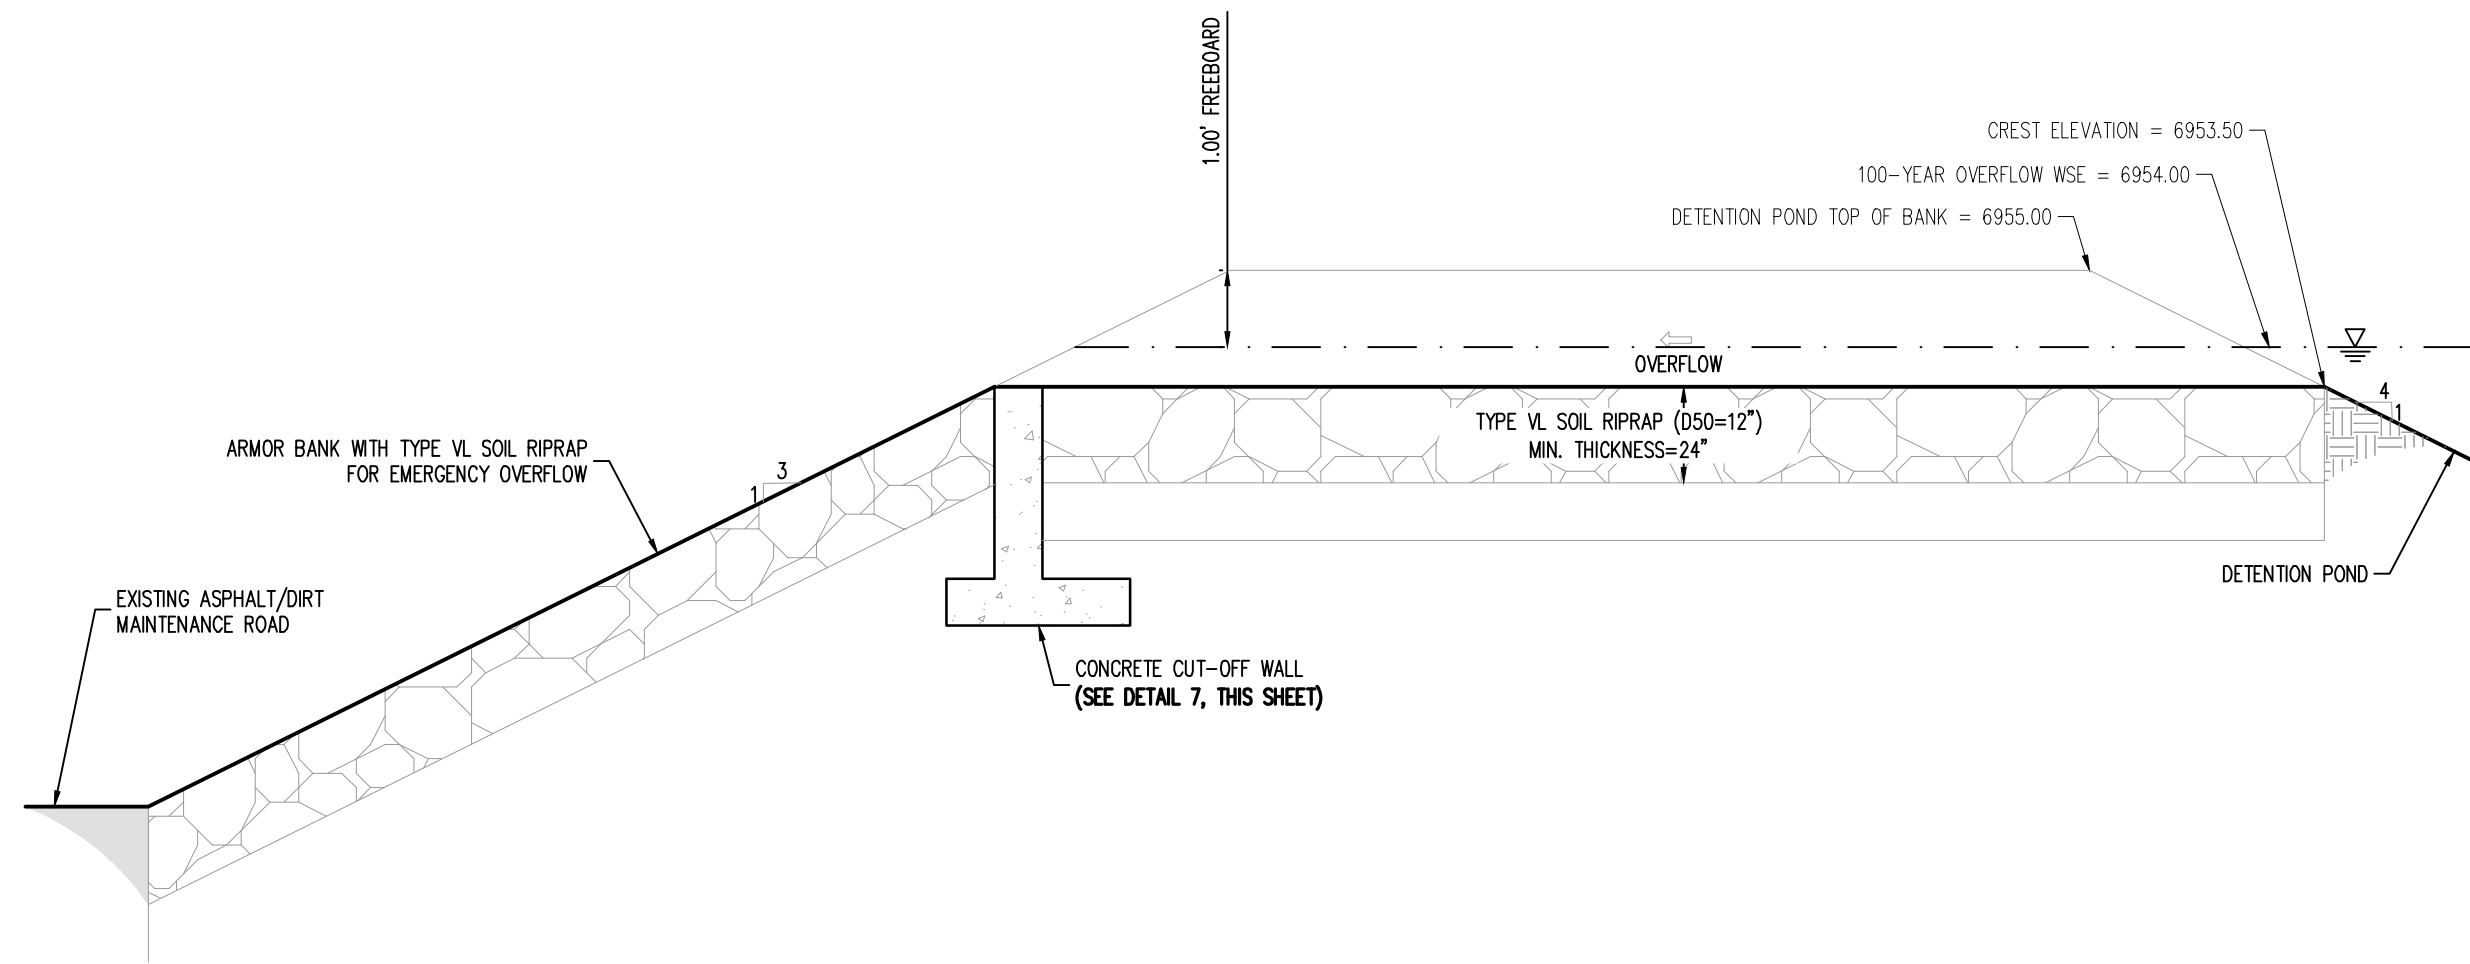


5 100-YEAR OVERFLOW - PROFILE
NOT TO SCALE

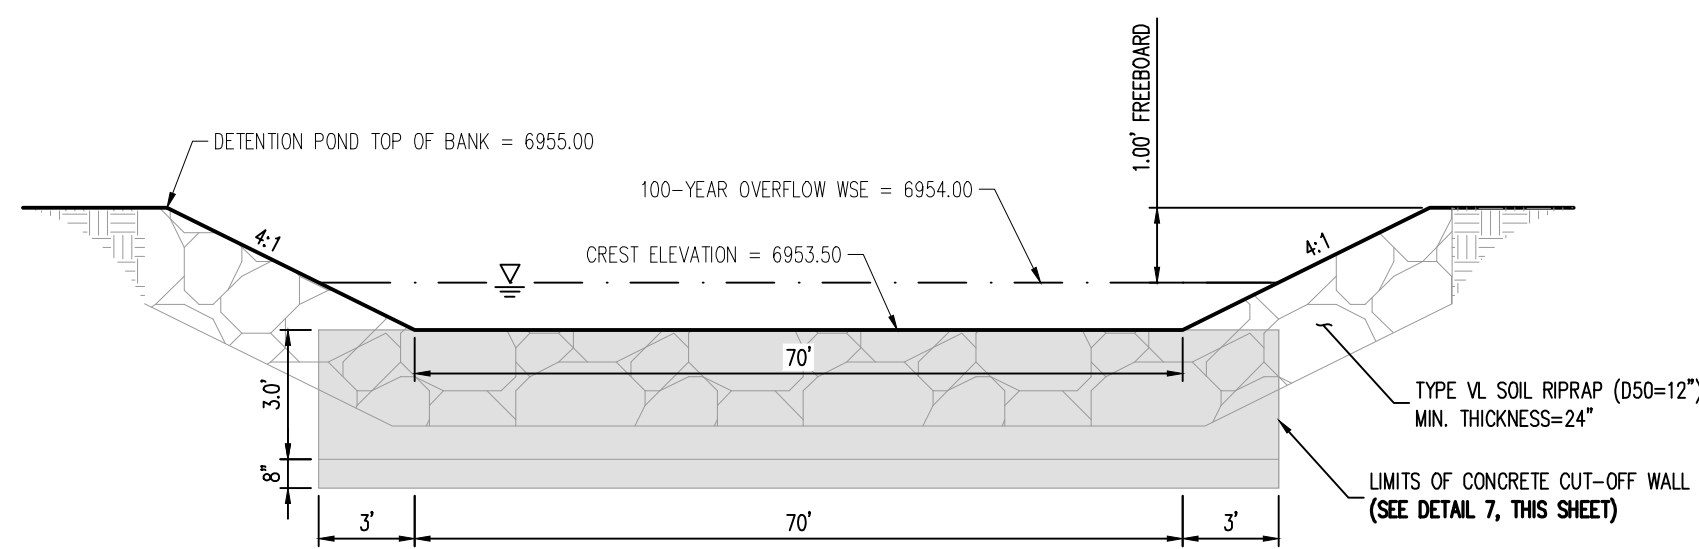


6 100-YEAR OVERFLOW - CROSS SECTION
NOT TO SCALE

4 GUARDRAIL
NOT TO SCALE

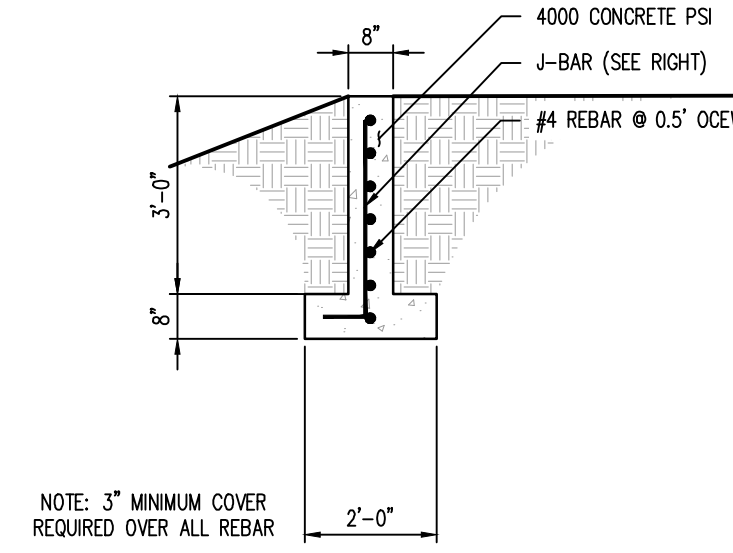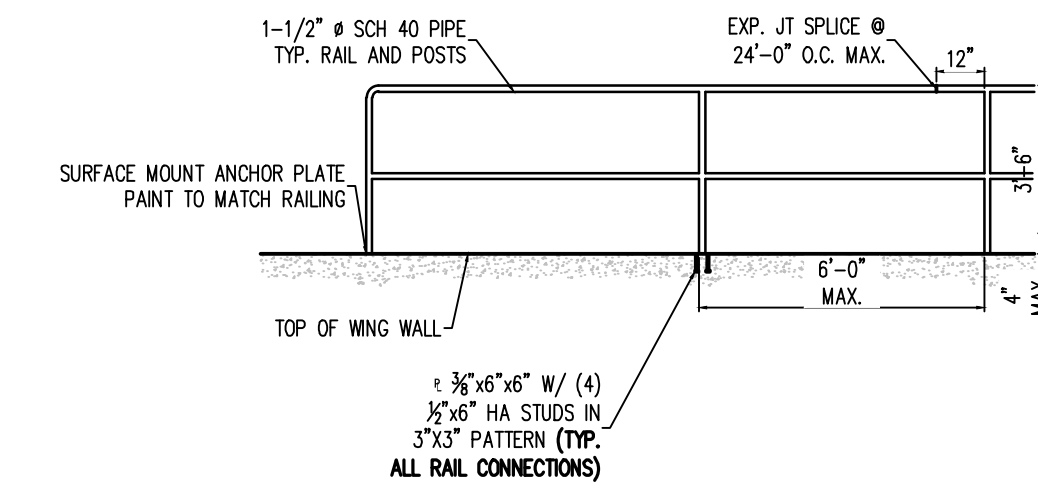

7 CUT-OFF WALL DETAIL
NOT TO SCALE

NOTES:
1. CONSTRUCT CONTRACTION JOINTS EVERY 5 LF (SAW CUT OR TOOLED)
2. CONSTRUCT EXPANSION JOINT W/ 1/2" BITUMINOUS FILLER EVERY 40 FT O.C.

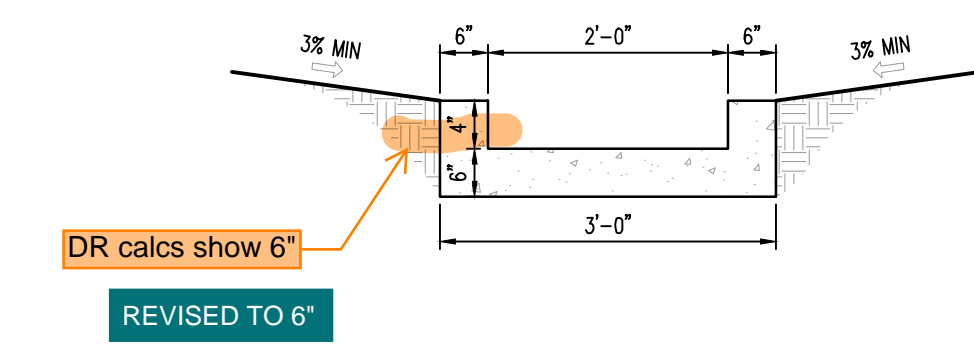


9 CONCRETE TRICKLE CHANNEL
NOT TO SCALE

WARNING
THIS AREA IS A STORMWATER FACILITY
AND IS SUBJECT TO PERIODIC FLOODING

PET WASTE
"LEASH-CURB AND CLEAN UP AFTER YOUR DOG
PLEASE KEEP THIS AREA CLEAN"

- NOTES:
- THREE (3) SIGNS WITH THE ABOVE MESSAGES, EACH WITH A MINIMUM AREA OF 3 SQUARE FEET SHALL BE PROVIDED AROUND THE PERIMETER OF THE DETENTION POND, AS SHOWN ON THESE PLANS. BOTH SIGNS ARE TO BE POSTED ON THE SAME POST.
 - WARNING SIGNS SHALL BE DURABLE MATERIALS, SUCH AS METAL OR PLASTIC, USING RED LETTERING ON A WHITE BACKGROUND.
 - PET WASTE SIGNS SHALL BE DURABLE MATERIALS, SUCH AS METAL OR PLASTIC, USING WHITE LETTERING ON A GREEN BACKGROUND.

8 DETENTION POND SIGNAGE
NOT TO SCALE

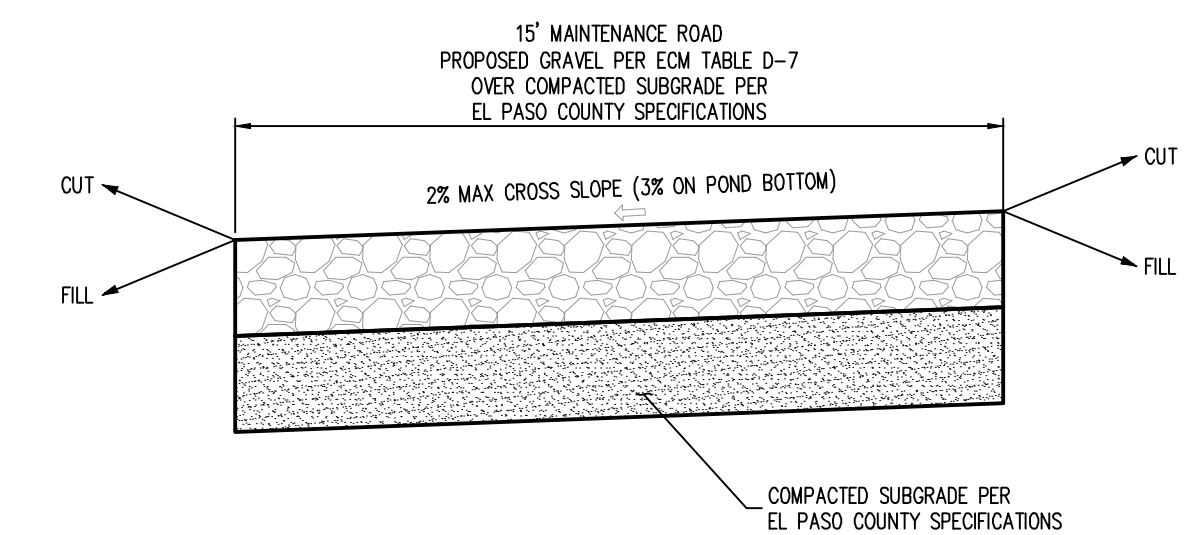


10 MAINTENANCE ROAD
NOT TO SCALE



#	Date	Issue / Description	Init.

Project No: HRG02
Drawn By: JDM, BLB
Checked By: BAS, CMWJ
Date: 03/15/2024

POND E - POND DETAILS

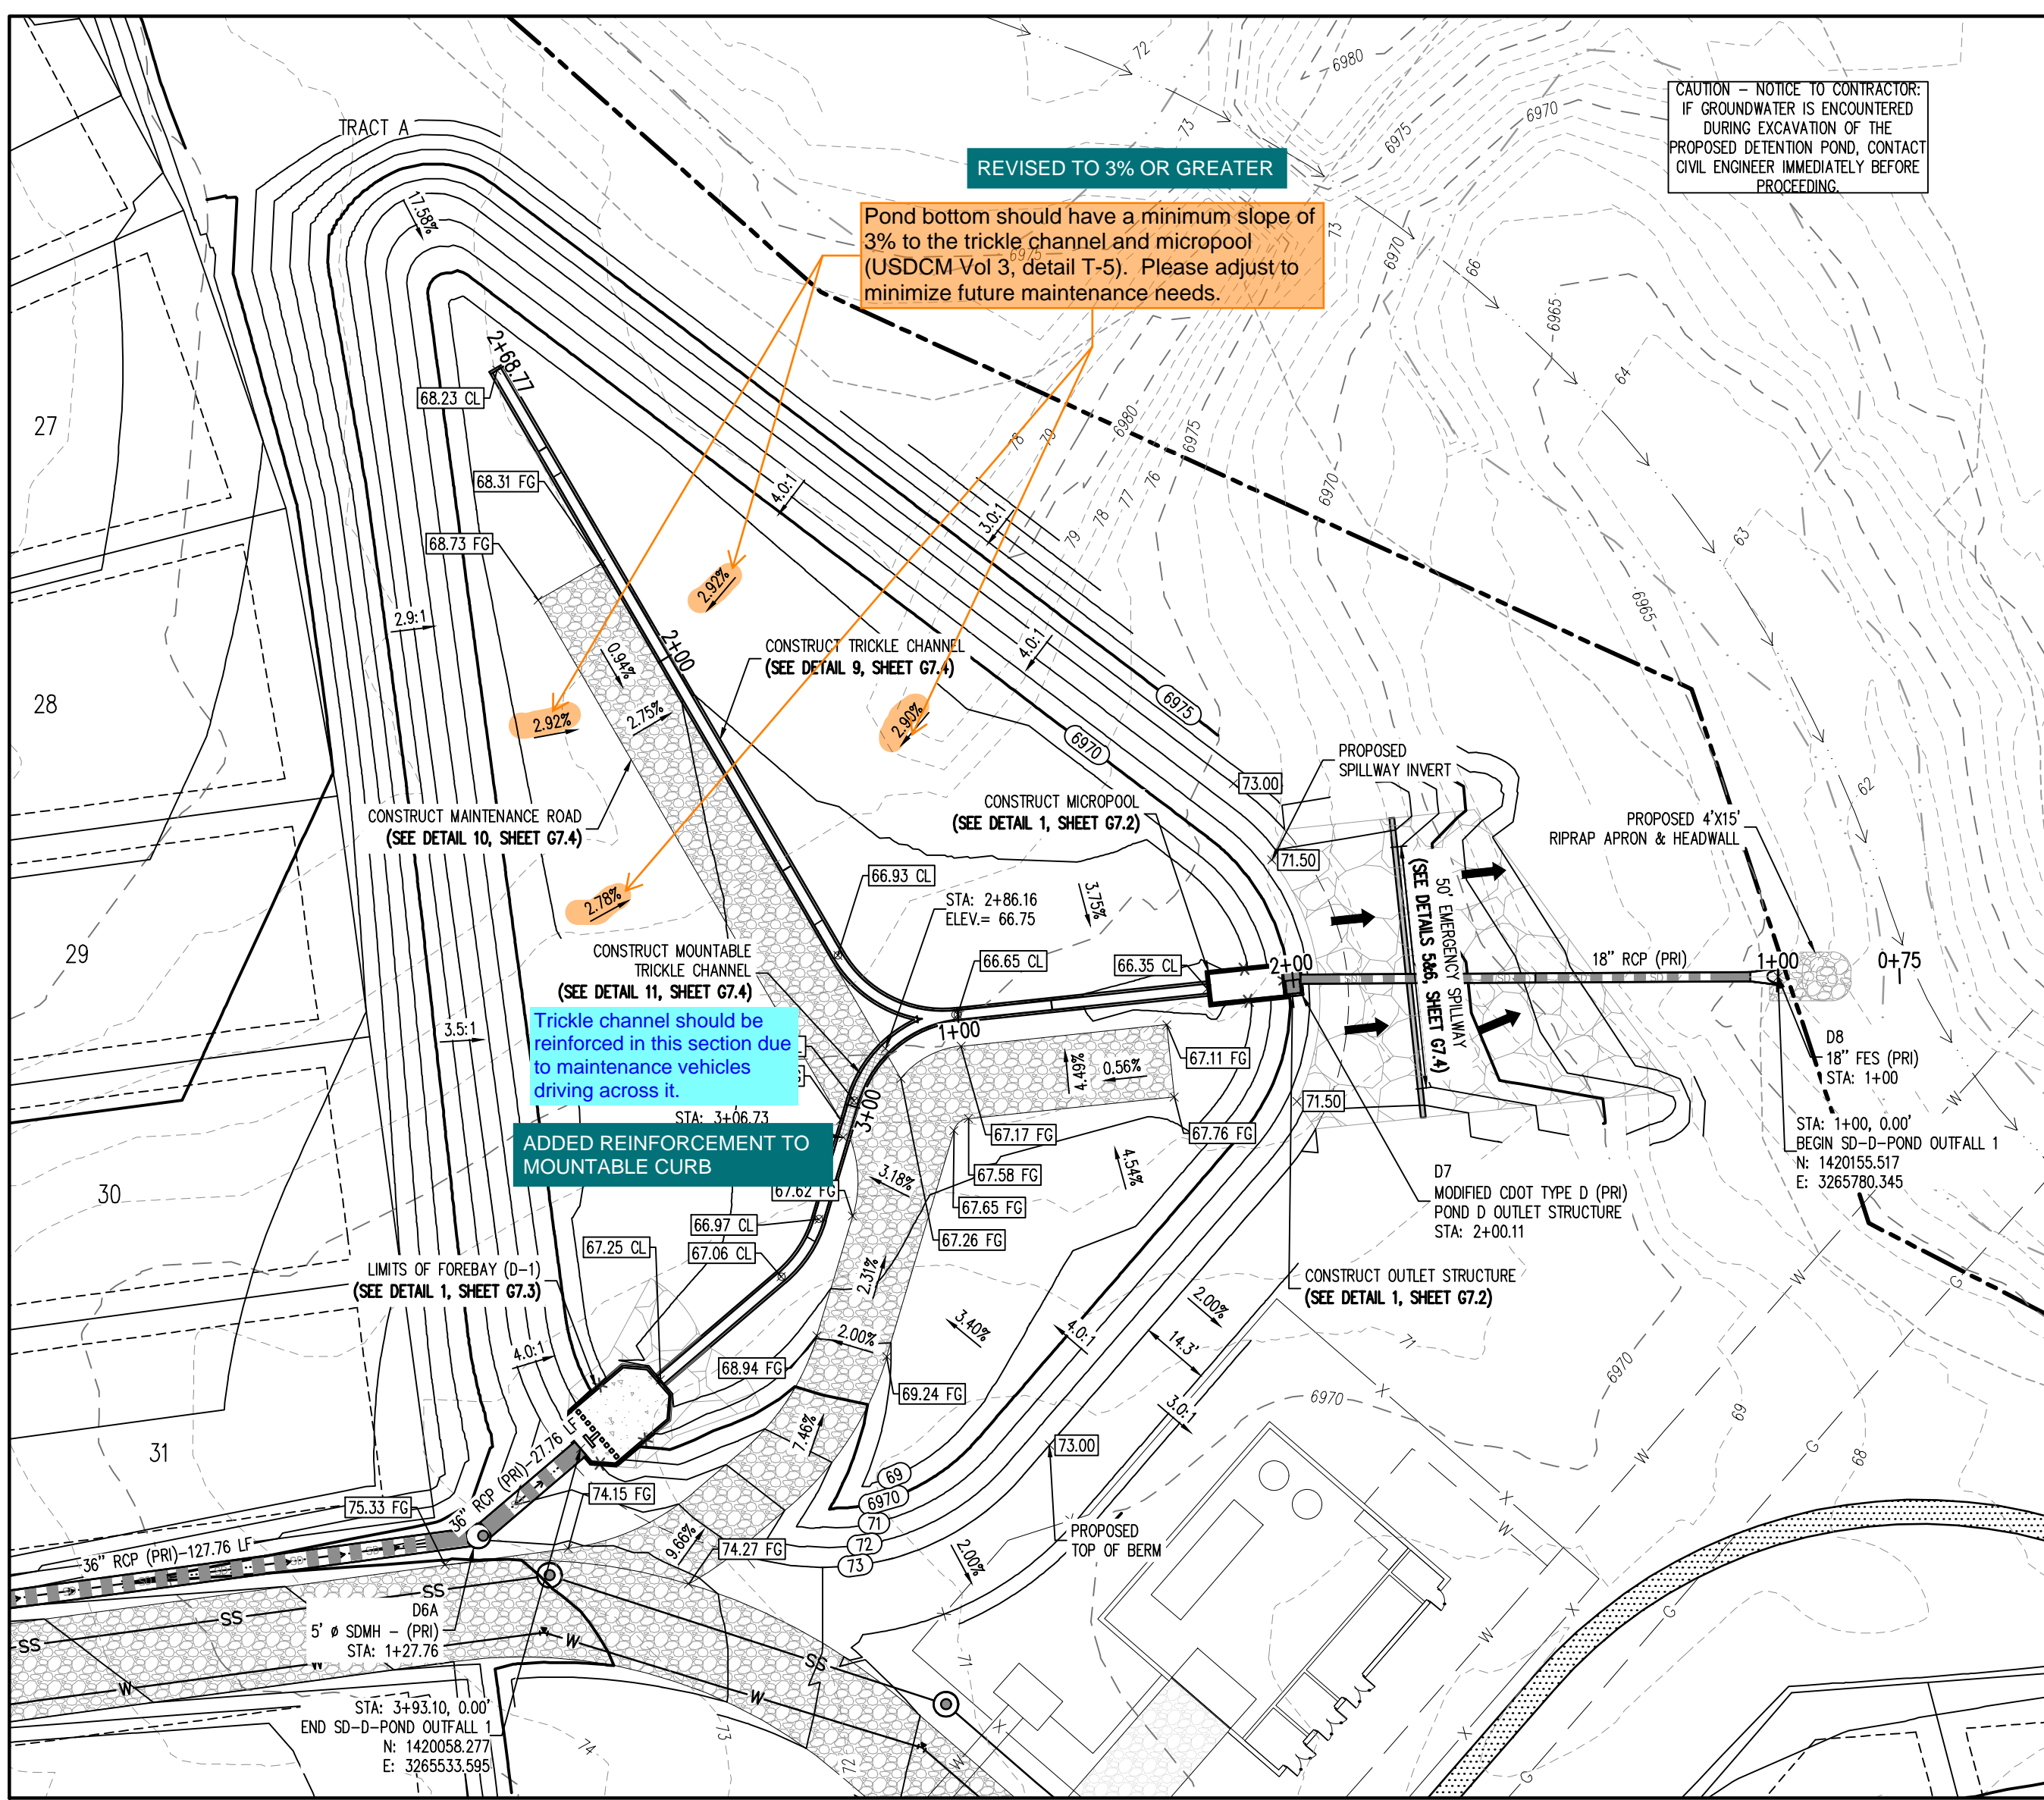



STORM DRAIN LINE PLAN: SD-D-POND
SCALE: 1"=30'

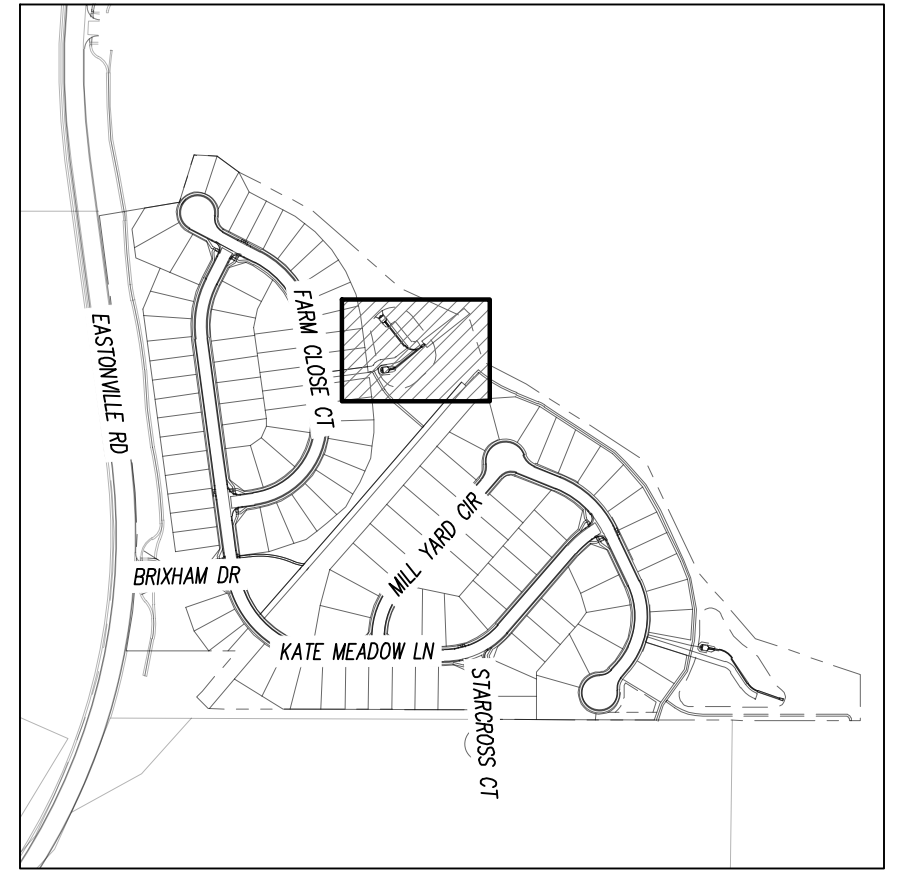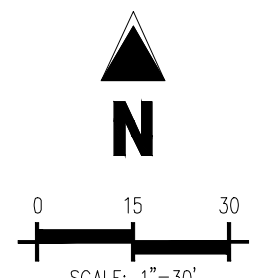

GRADING LEGEND	
---	EXISTING MAJOR CONTOUR
- - -	EXISTING MINOR CONTOUR
—5465—	PROPOSED MAJOR CONTOUR
- - -	PROPOSED MINOR CONTOUR
2.00%	EXISTING SLOPE - PERCENT
4:1	EXISTING SLOPE - RISE/RUN
2.00%	PROPOSED SLOPE - PERCENT
4:1	PROPOSED SLOPE - RISE/RUN
89.00 HP	PROPOSED SPOT ELEVATION - HIGH POINT
89.00 LP	PROPOSED SPOT ELEVATION - LOW POINT
89.00 TOB	PROPOSED SPOT ELEVATION - TOP OF BERM
89.00 TOL	PROPOSED SPOT ELEVATION - FLOW LINE
89.00 TG	PROPOSED SPOT ELEVATION - TOP OF GRATE
89.00 FG	PROPOSED SPOT ELEVATION - FINISHED GRADE
89.00 SW	PROPOSED SPOT ELEVATION - SIDEWALK
89.00 EOC	PROPOSED SPOT ELEVATION - EDGE OF CONCRETE
89.00 EOA	PROPOSED SPOT ELEVATION - EDGE OF ASPHALT
89.00 ME	PROPOSED SPOT ELEVATION - MATCH EXISTING

UTILITY LEGEND	
—	EXISTING WATER LINE
—	PROPOSED WATER LINE
—	EXISTING SANITARY SEWER
—	PROPOSED SANITARY SEWER
—	EXISTING STORM SEWER
—	PROPOSED STORM SEWER
—	EXISTING GAS LINE
—	PROPOSED GAS LINE
—	EXISTING STREET LIGHT
—	PROPOSED STREET LIGHT
—	PROPOSED WATER METER
—	EXISTING WATER VALVE
—	PROPOSED WATER VALVE
—	EXISTING FIRE HYDRANT
—	PROPOSED FIRE HYDRANT
—	EXISTING STORM SEWER MANHOLE
—	PROPOSED STORM SEWER MANHOLE
—	EXISTING SANITARY SEWER MANHOLE
—	PROPOSED SANITARY SEWER MANHOLE

SITE LEGEND	
—	PROPERTY BOUNDARY LINE
—	ADJACENT PROPERTY BOUNDARY LINE
—	RIGHT OF WAY BOUNDARY LINE
—	SECTION LINE
—	EXISTING ADJACENT LOT LINE
—	PROPOSED LOT LINE
—	EXISTING EASEMENT LINE
—	PROPOSED EASEMENT LINE
—	ROAD CENTERLINE
—	PROPOSED RIDGE LINE
—	PROPOSED SWALE LINE
—	EXISTING SWALE LINE
—	FLOODPLAIN BOUNDARY
—	EXISTING FLOOD ZONE
—	EXISTING FLOOD ZONE SETBACK
—	PROPOSED CURB AND GUTTER
—	EXISTING CURB AND GUTTER
—	PROPOSED SIDEWALK
—	PROPOSED TRAIL
—	PROPOSED GRAVEL PER ECM TABLE D-7
—	RIPPRAP OUTFALL PADS
—	EXISTING SIGN
—	PROPOSED SIGN
—	PROPOSED CONCRETE
—	EXISTING CONCRETE

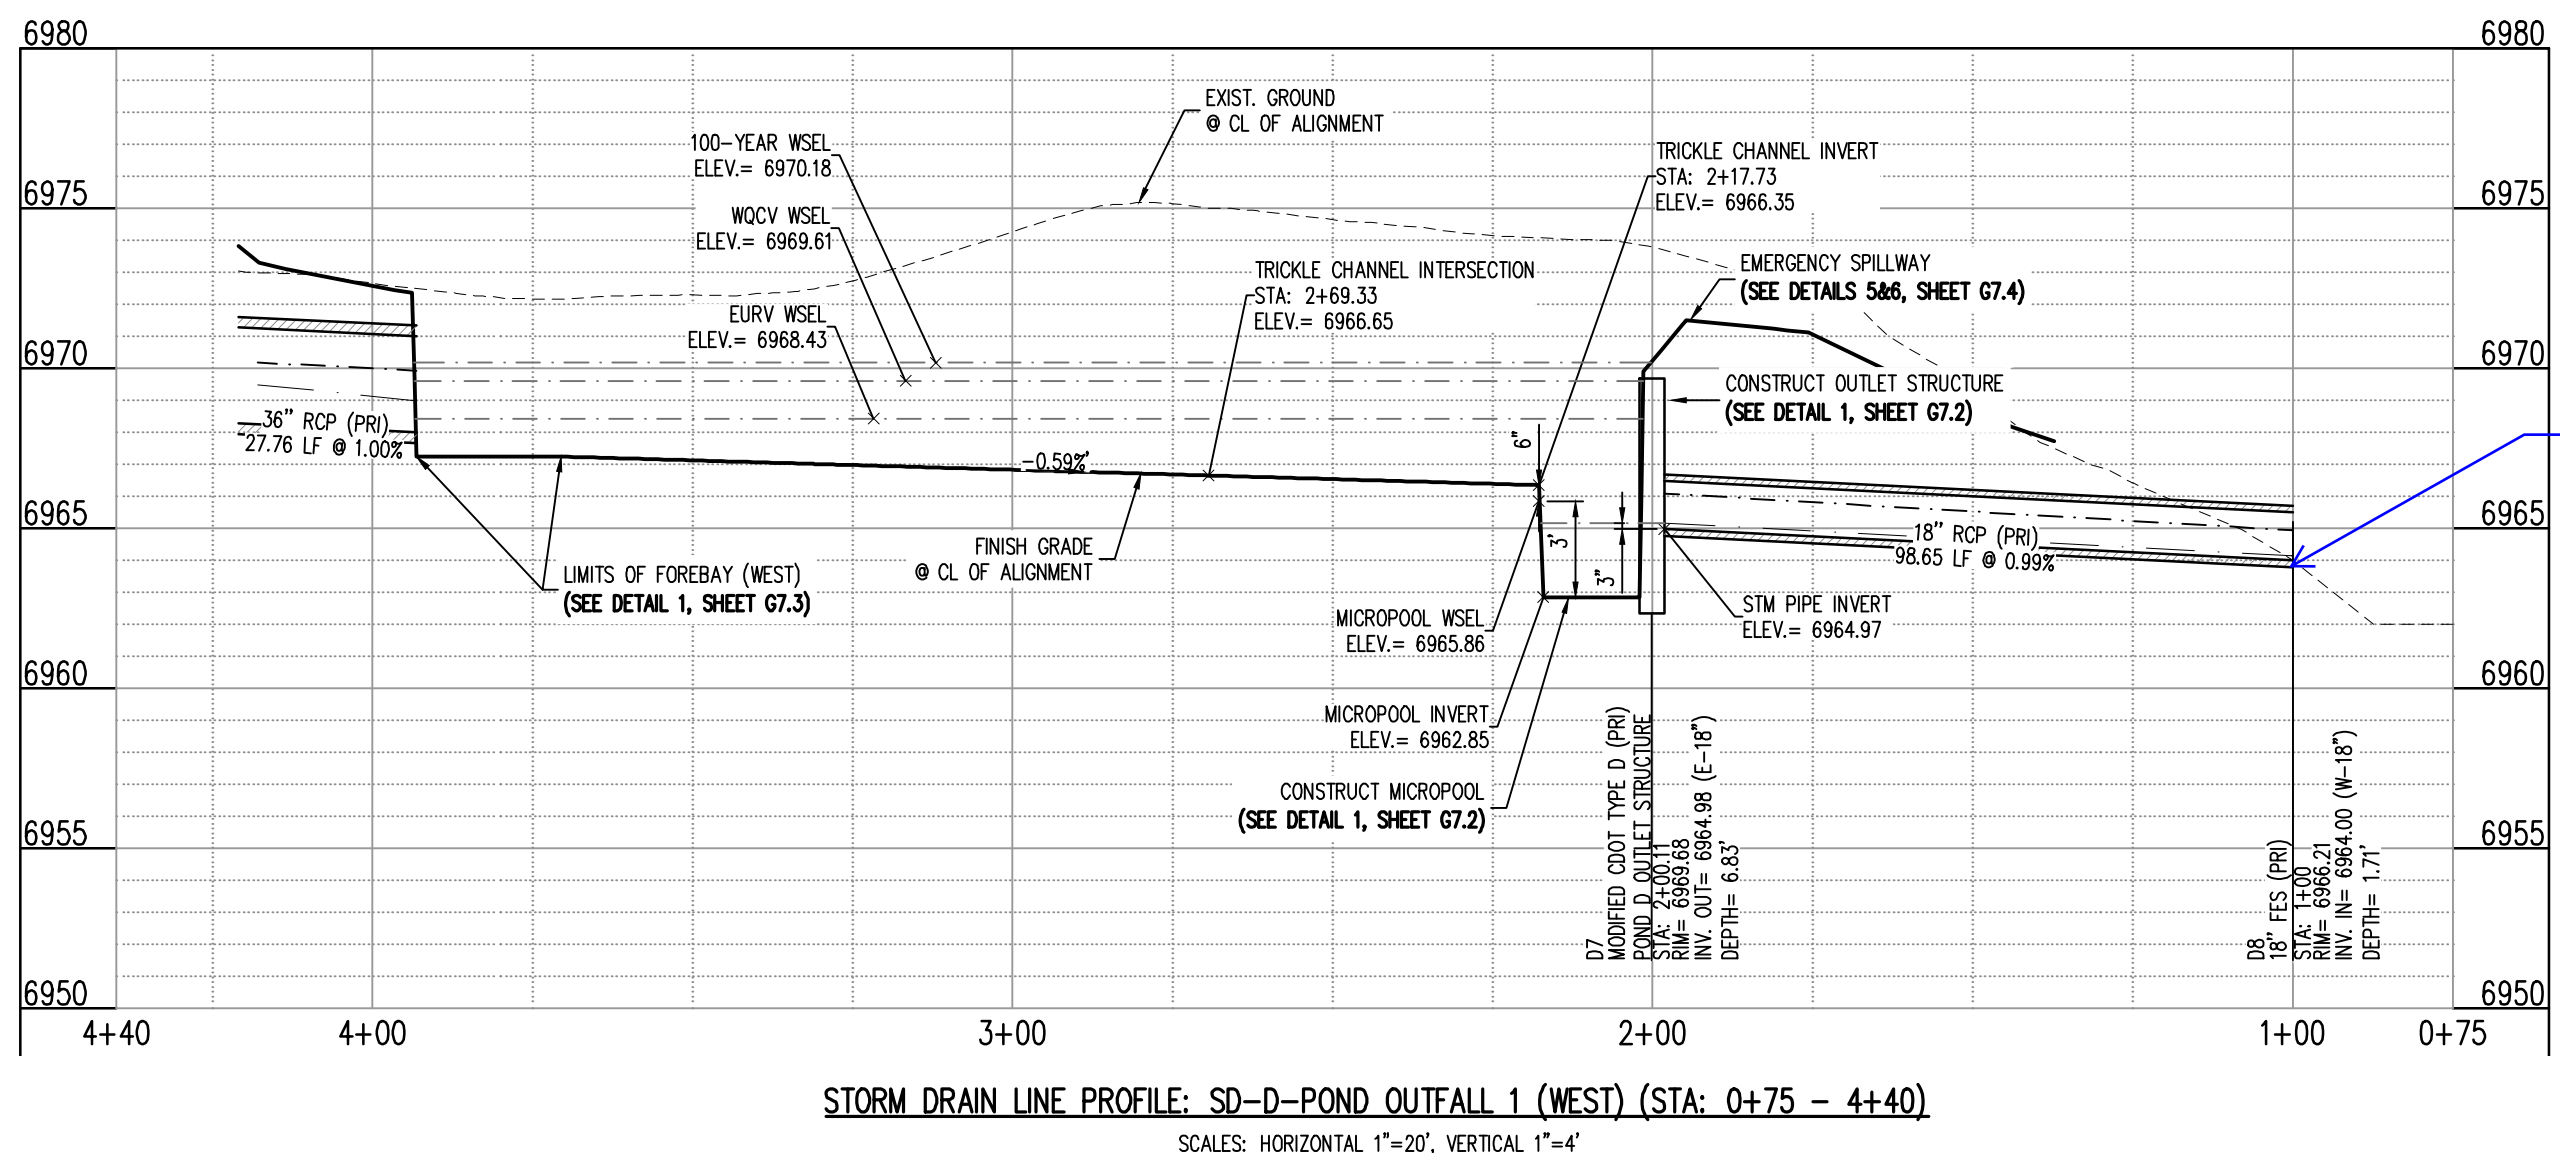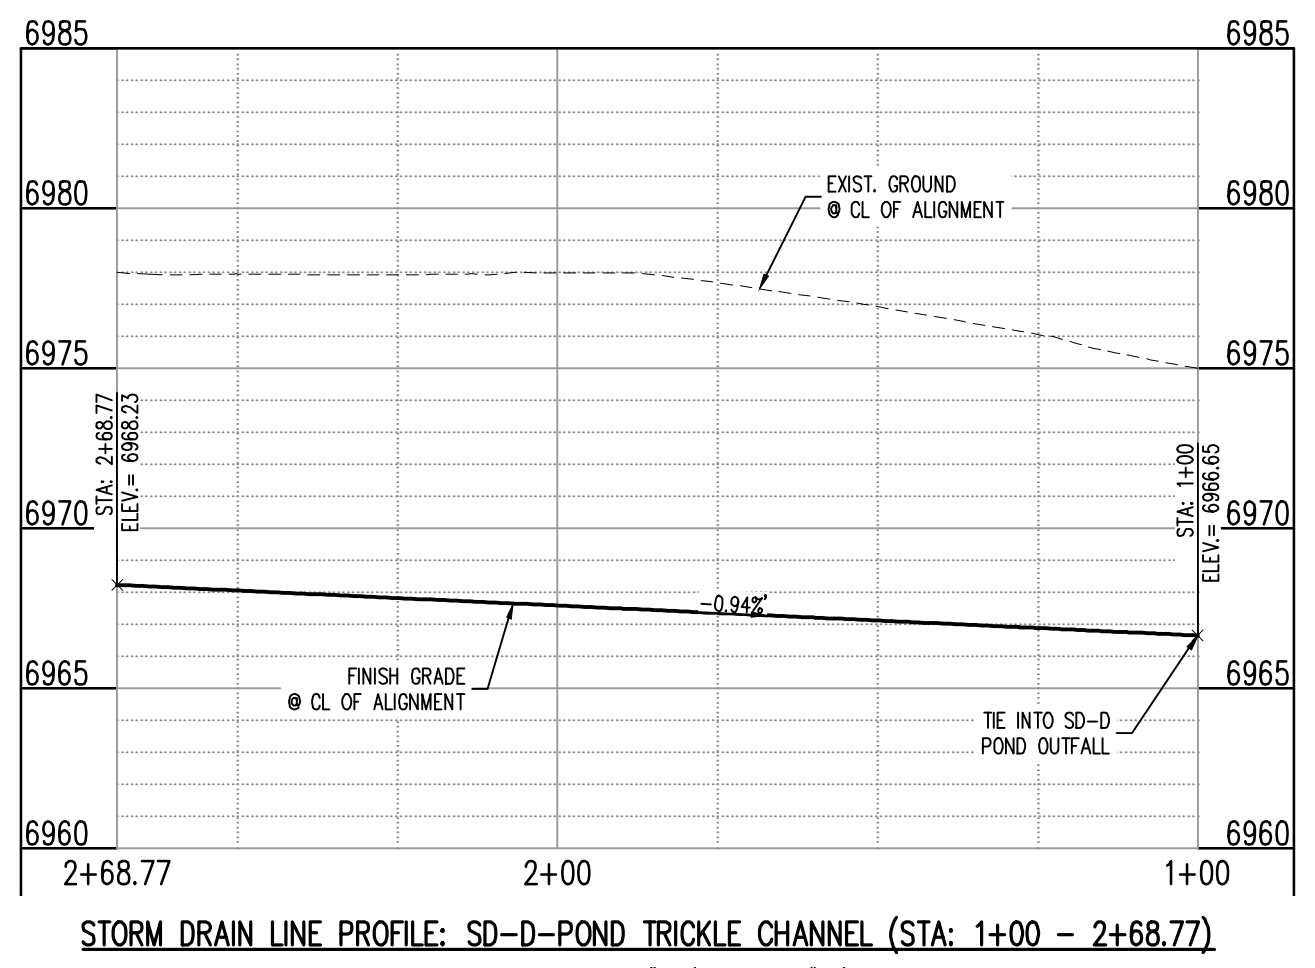

Label end section or headwalls, riprap apron (length, depth, type, D50), toe wall if needed, profile of existing ground shown for 200 feet downstream of outfall, Q100 water surface elevation downstream of outfall

STILL COORDINATING DOWN STREAM CONDITIONS, WILL INCLUDE REVISIONS NEXT SUBMITTAL. PROFILE WAS REVISED TO SHOW 200 FEET DOWNSTREAM

NOTICE TO CONTRACTOR

SECTION 28, TOWNSHIP 12 SOUTH, RANGE 64 WEST OF THE 6TH PRINCIPAL MERIDIAN, EL PASO COUNTY, STATE OF COLORADO BEING MONUMENTED AT EACH END BY A 3/4" ALUMINUM SURVEYORS CAP STAMPED "PNSC LS 30087" AND ASSUMED TO BEAR S89°47'04"E, A DISTANCE OF 5285.07 FEET.

BENCHMARK
NPS BENCHMARK F 24
A STANDARD DISK, STAMPED F 24 1929 AND SET IN THE TOP OF A CONCRETE POST PROJECTING ABOUT 6 INCHES ABOVE GROUND, ALONG THE CHICAGO, ROCK ISLAND AND PACIFIC RAILROAD, 52 FEET NORTHWEST OF THE CENTERLINE OF U.S. HIGHWAY 24, 48 FEET SOUTHEAST OF THE CENTERLINE OF THE TRACK
NAVD88 ELEVATION = 6866.33

CAUTION - NOTICE TO CONTRACTOR

- ALL UTILITY LOCATIONS SHOWN ARE BASED ON MAPS PROVIDED BY THE APPROPRIATE UTILITY COMPANY AND FIELD SURFACE EVIDENCE AT THE TIME OF SURVEY AND IS TO BE CONSIDERED AN APPROXIMATE LOCATION ONLY. IT IS THE CONTRACTOR'S RESPONSIBILITY TO FIELD VERIFY THE LOCATION OF ALL UTILITIES, PUBLIC OR PRIVATE, WHETHER SHOWN ON THE PLANS OR NOT, PRIOR TO CONSTRUCTION. REPORT ANY DISCREPANCIES TO THE ENGINEER PRIOR TO CONSTRUCTION.
- WHERE A PROPOSED UTILITY CROSSES AN EXISTING UTILITY, IT IS THE CONTRACTOR'S RESPONSIBILITY TO FIELD VERIFY THE HORIZONTAL AND VERTICAL LOCATION OF SUCH EXISTING UTILITY, EITHER THROUGH POT-HOLING OR ALTERNATIVE METHOD. REPORT INFORMATION TO THE ENGINEER PRIOR TO CONSTRUCTION.



#	Date	Issue / Description	Init.

Project No: HRG02
Drawn By: JDM, BLB
Checked By: BAS, CMWJ
Date: 03/15/2024

POND D - PLAN & PROFILE


#	Date	Issue / Description	Init.

Project No: HRG02
 Drawn By: JDM, BLB
 Checked By: BAS, CMWJ
 Date: 03/15/2024


POND D - OUTLET
 STRUCTURE DETAILS

G7.2


Sheet 30 of 32

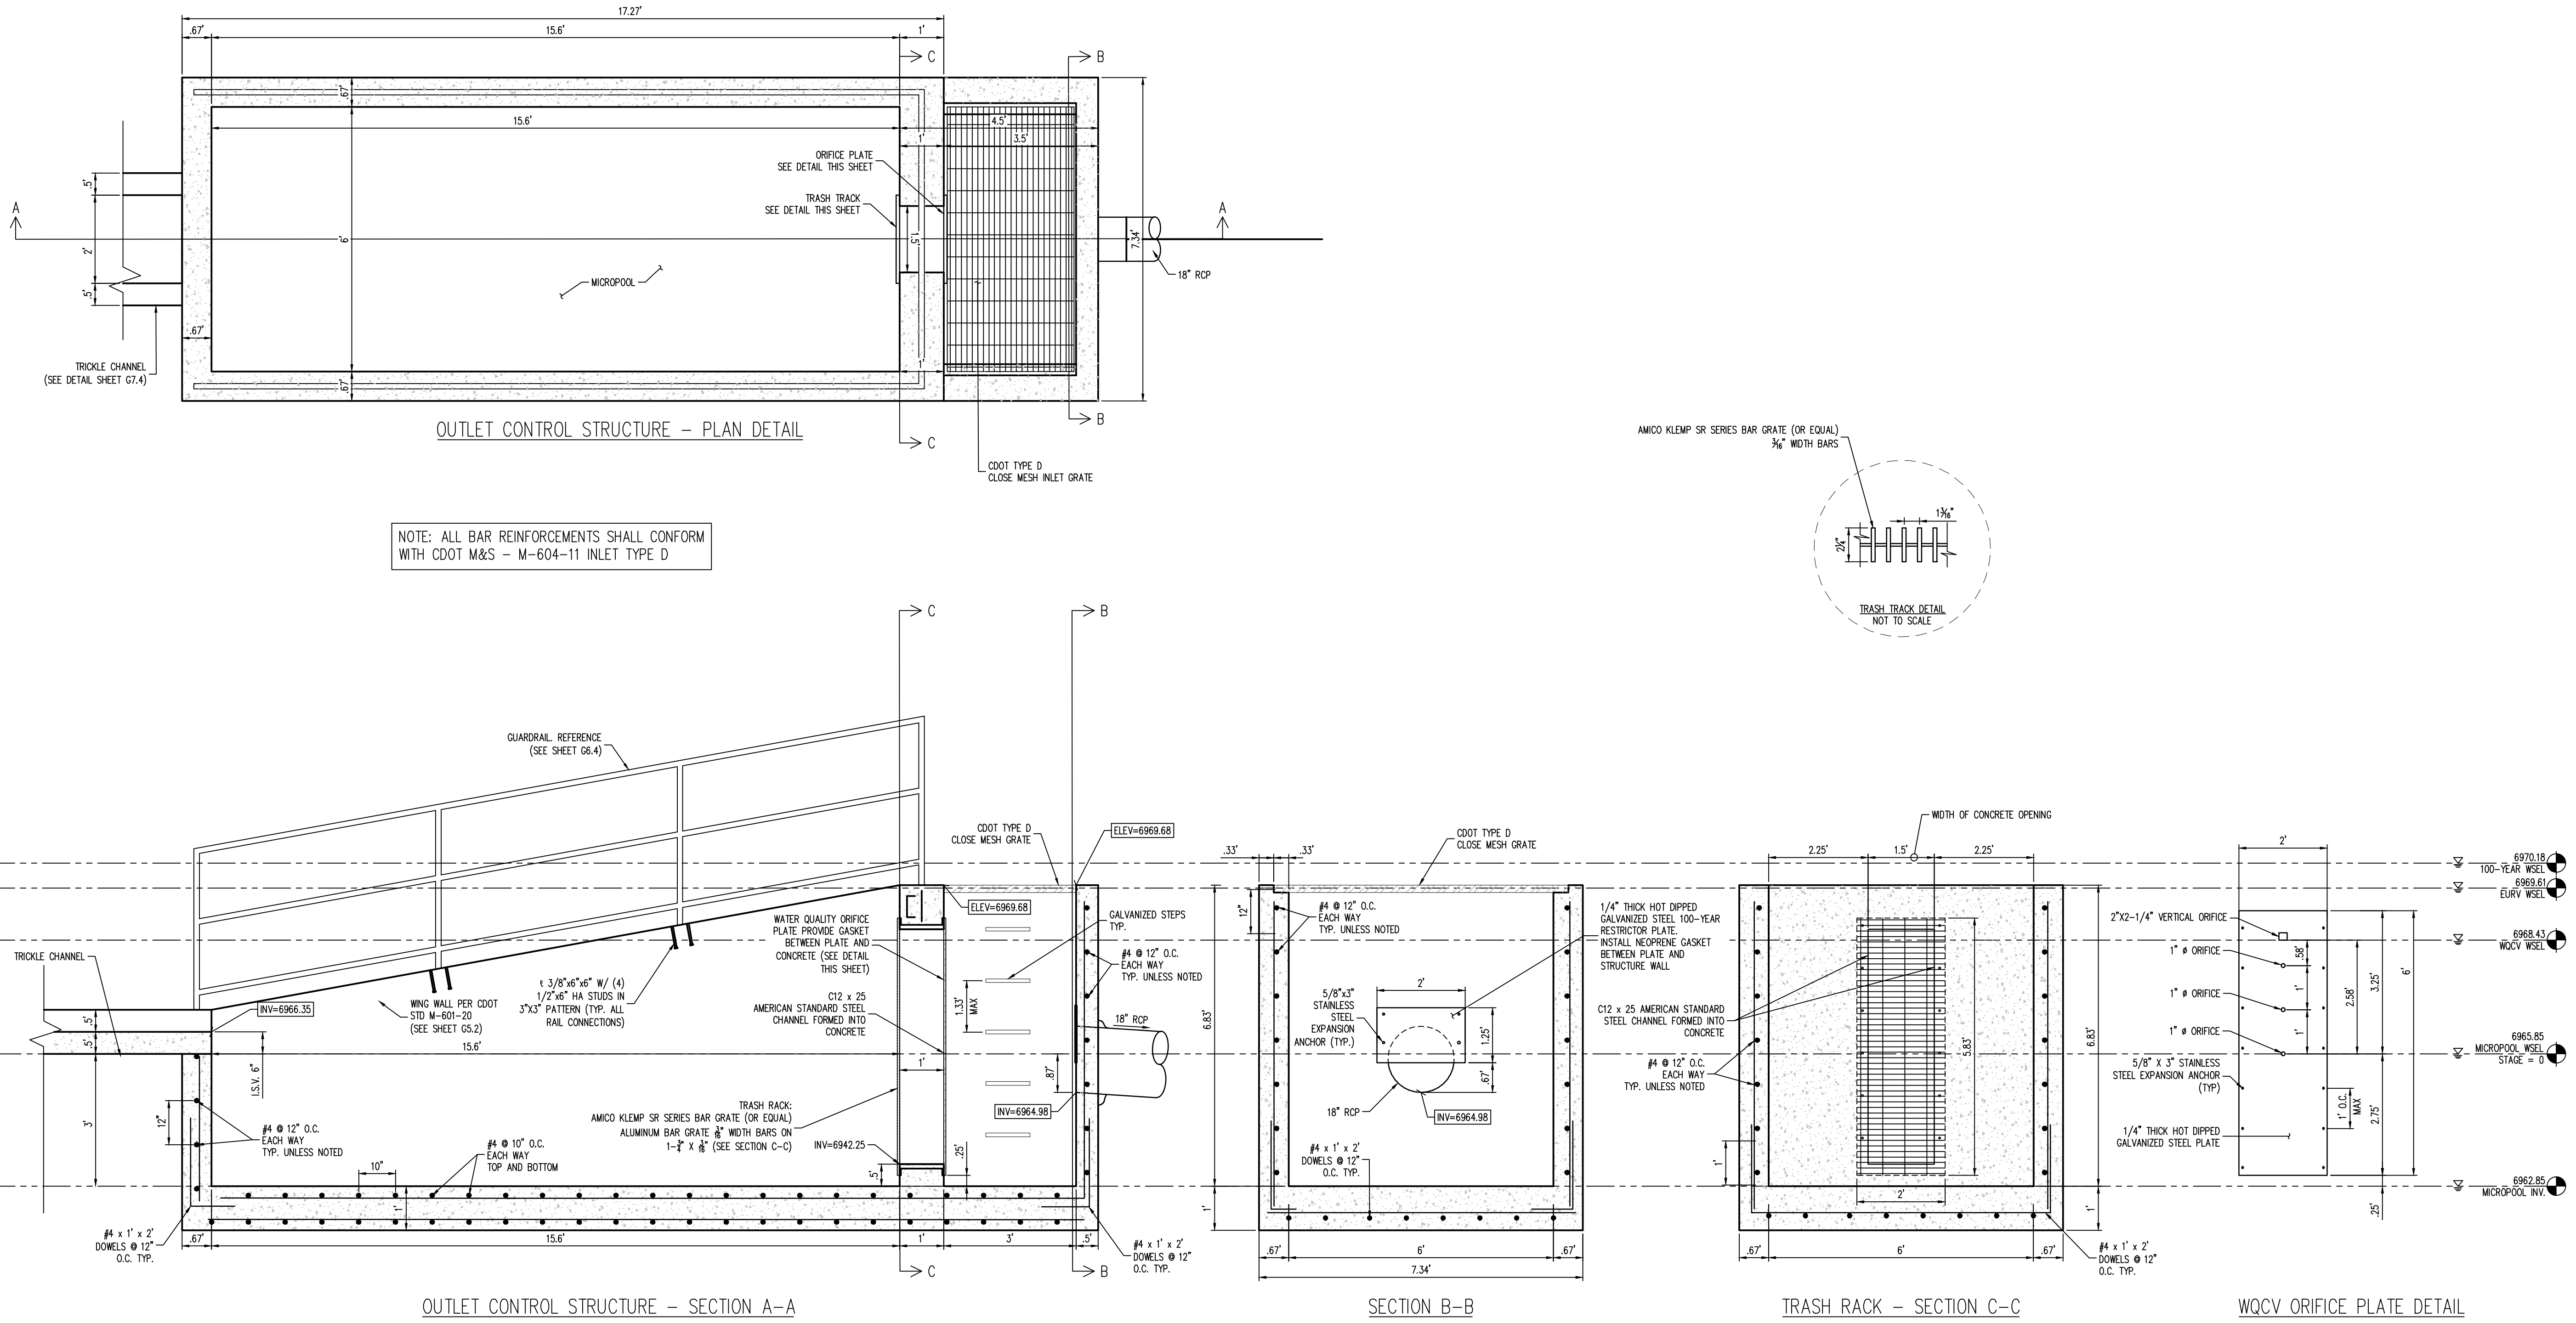


REQUIRED VOLUME (CU. FT.)	PROVIDED VOLUME (CU. FT.)
183	318

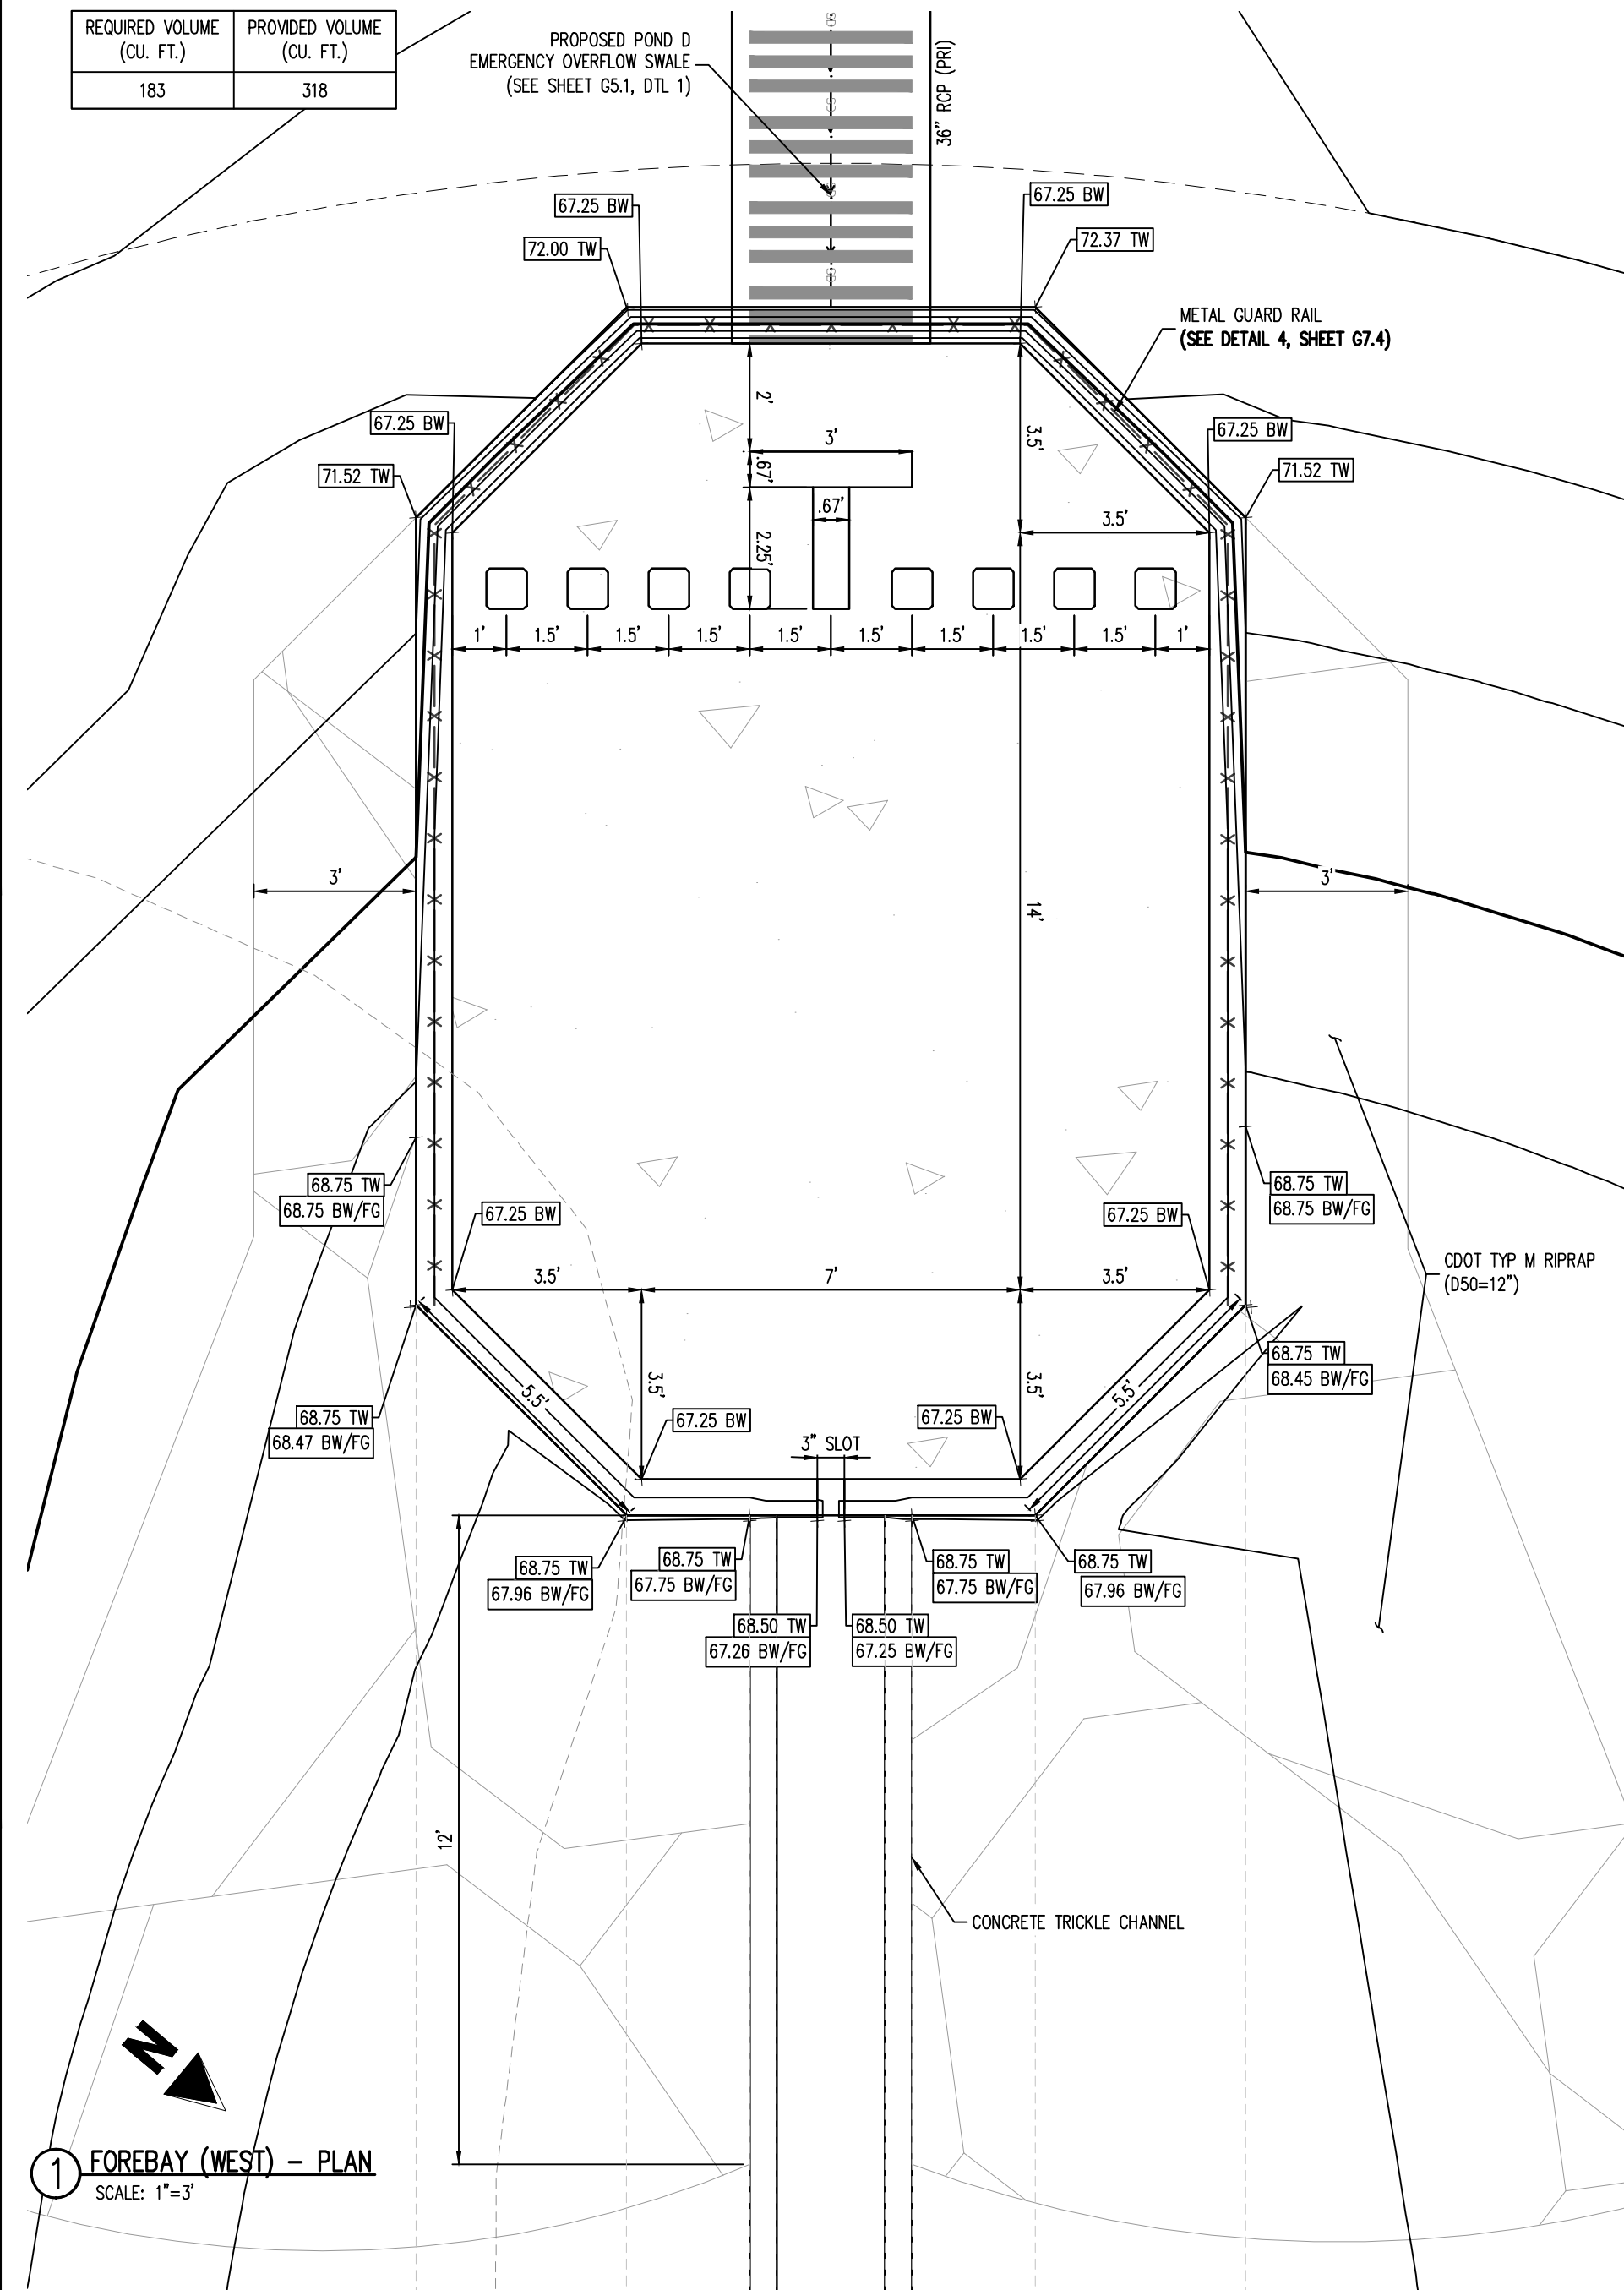


1 FOREBAY (WEST) - PLAN
SCALE: 1"=3'

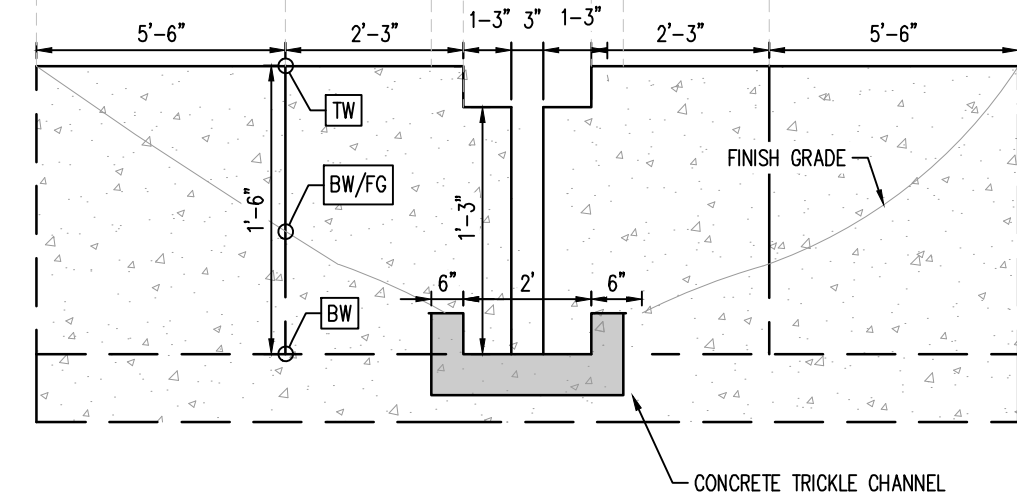


2 FOREBAY - SLOT DETAIL
NOT TO SCALE

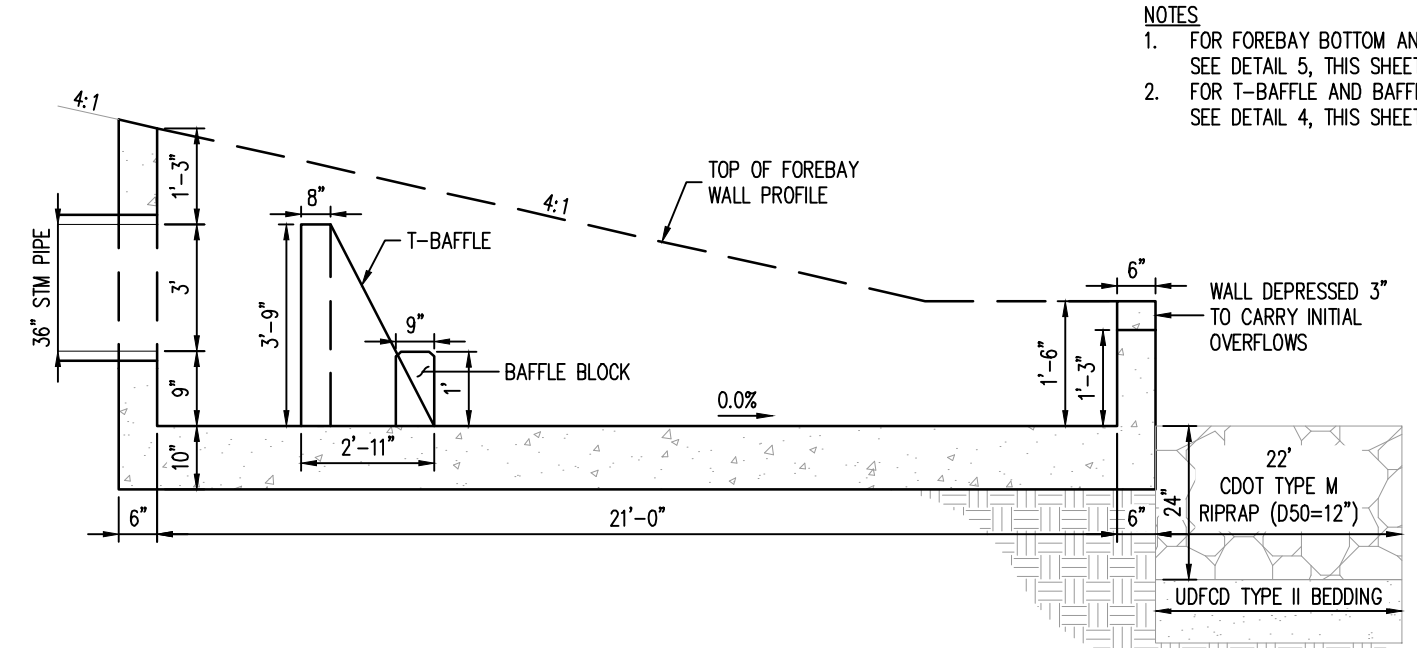

3 FOREBAY - PROFILE DETAIL
NOT TO SCALE

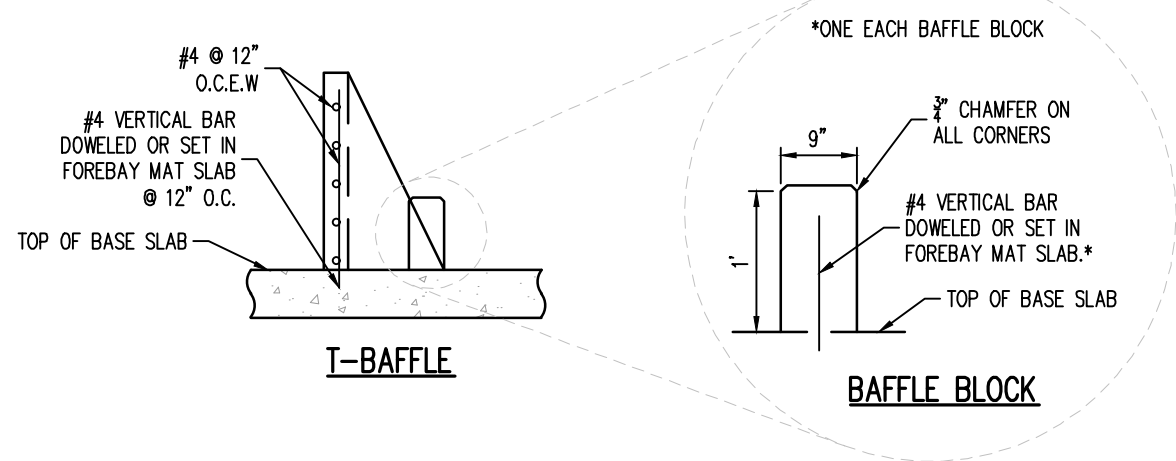

4 FOREBAY - T-BAFFLES & BAFFLE BLOCKS REINFORCING DETAIL
NOT TO SCALE

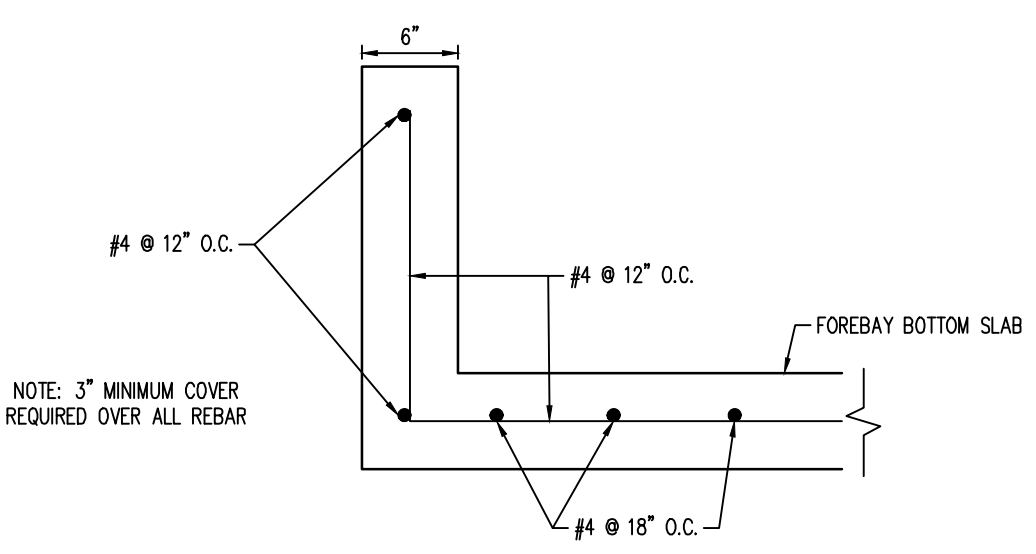

5 FOREBAY - REINFORCING DETAIL
NOT TO SCALE

#	Date	Issue / Description	Init.

Project No:	HRG02
Drawn By:	JDM, BLB
Checked By:	BAS, CMWJ
Date:	03/15/2024



POND D - FOREBAY
DETAILS

#	Date	Issue / Description	Init.

Project No:	HRG02
Drawn By:	JDM, BLB
Checked By:	BAS, CMWJ
Date:	03/15/2024


POND D - POND DETAILS

NOTES:
1. CONSTRUCT CONTRACTION JOINTS EVERY 5 LF (SAW CUT OR TOOLED)
2. CONSTRUCT EXPANSION JOINT W/ 1/2" BITUMINOUS FILLER EVERY 40 FT O.C.

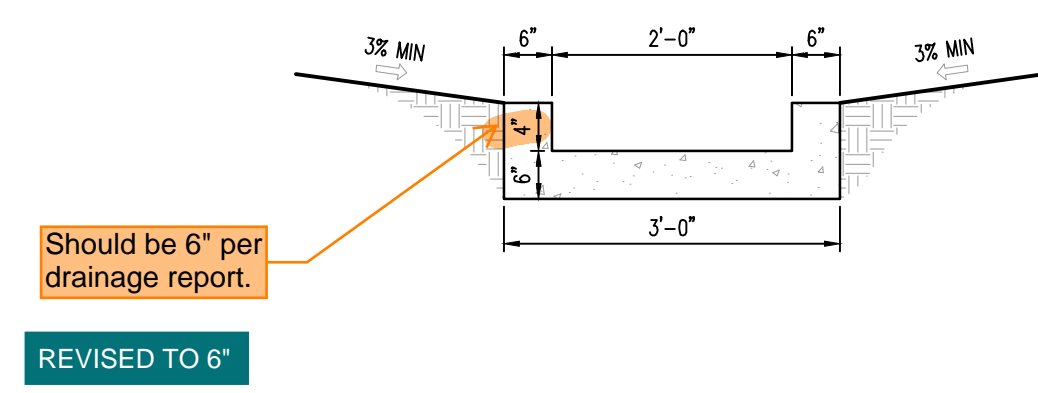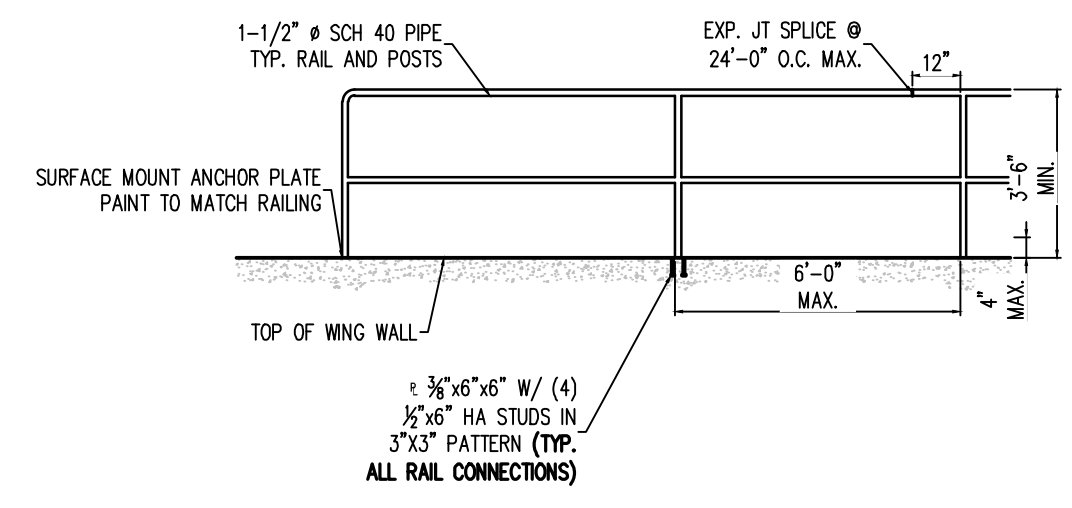



4 GUARDRAIL
NOT TO SCALE

9 CONCRETE TRICKLE CHANNEL
NOT TO SCALE

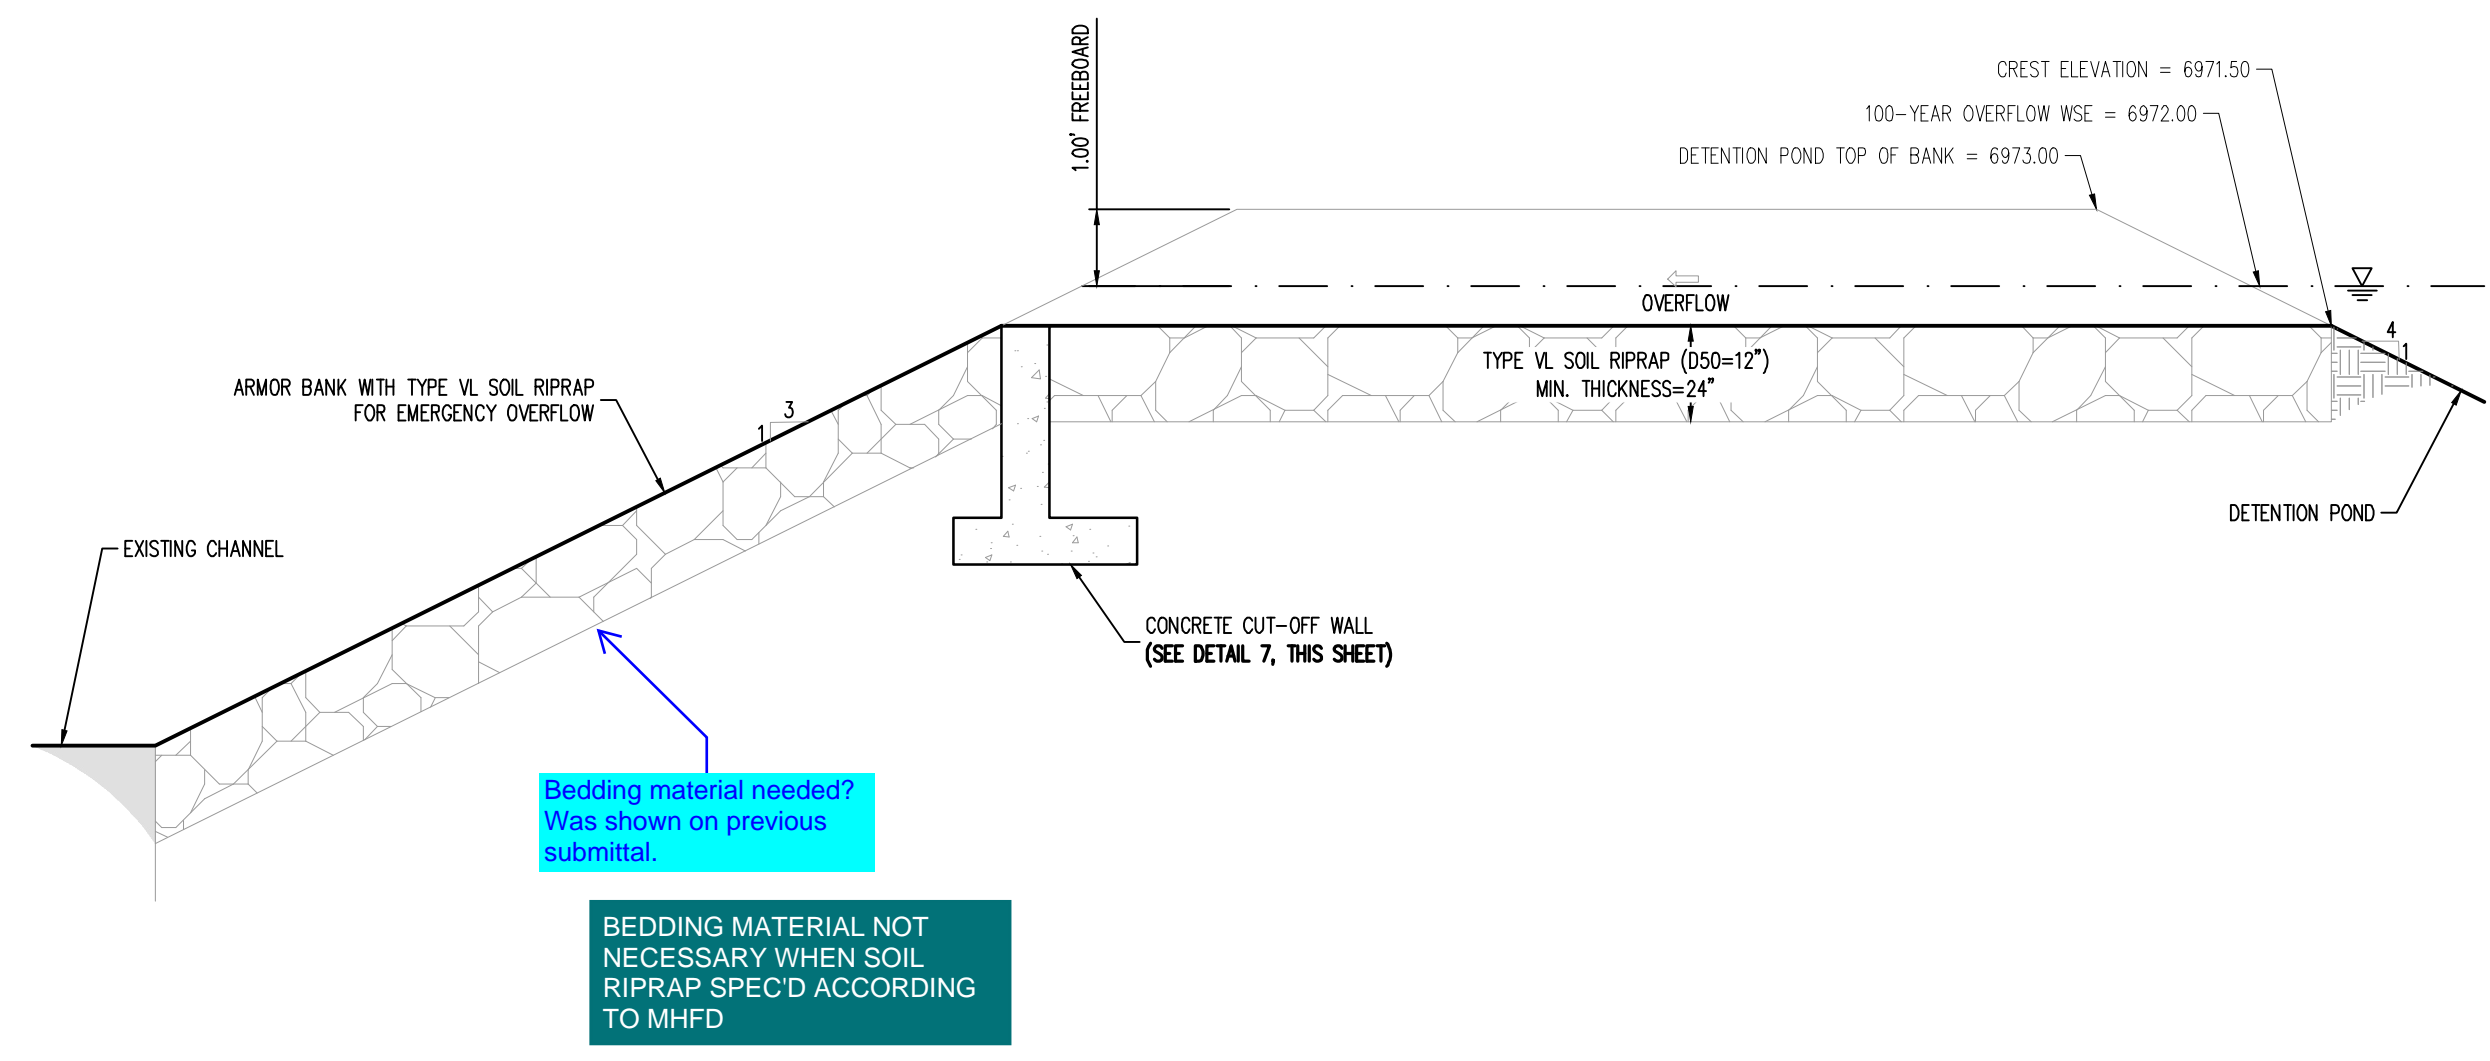


Bedding material needed? Was shown on previous submittal.
BEDDING MATERIAL NOT NECESSARY WHEN SOIL RIPRAP SPEC'D ACCORDING TO MHFD


5 100-YEAR OVERFLOW - PROFILE
NOT TO SCALE

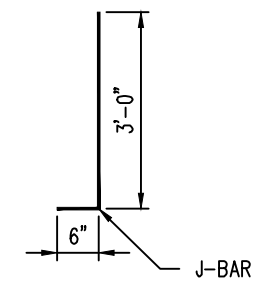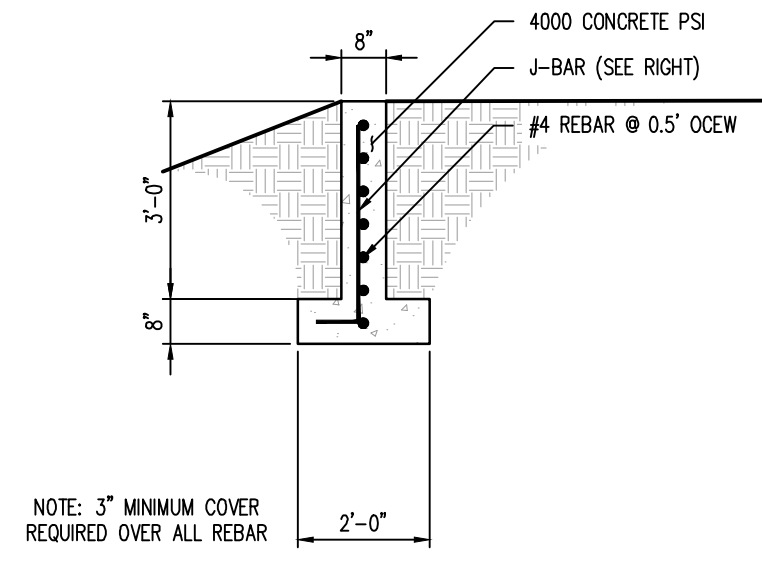

7 CUT-OFF WALL DETAIL
NOT TO SCALE

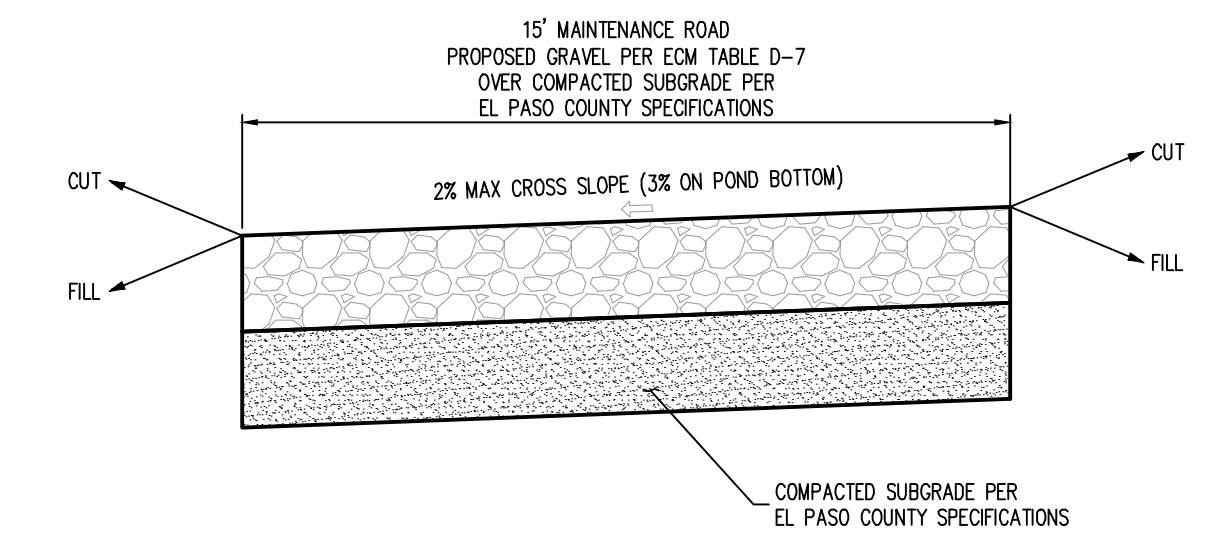

10 MAINTENANCE ROAD
NOT TO SCALE

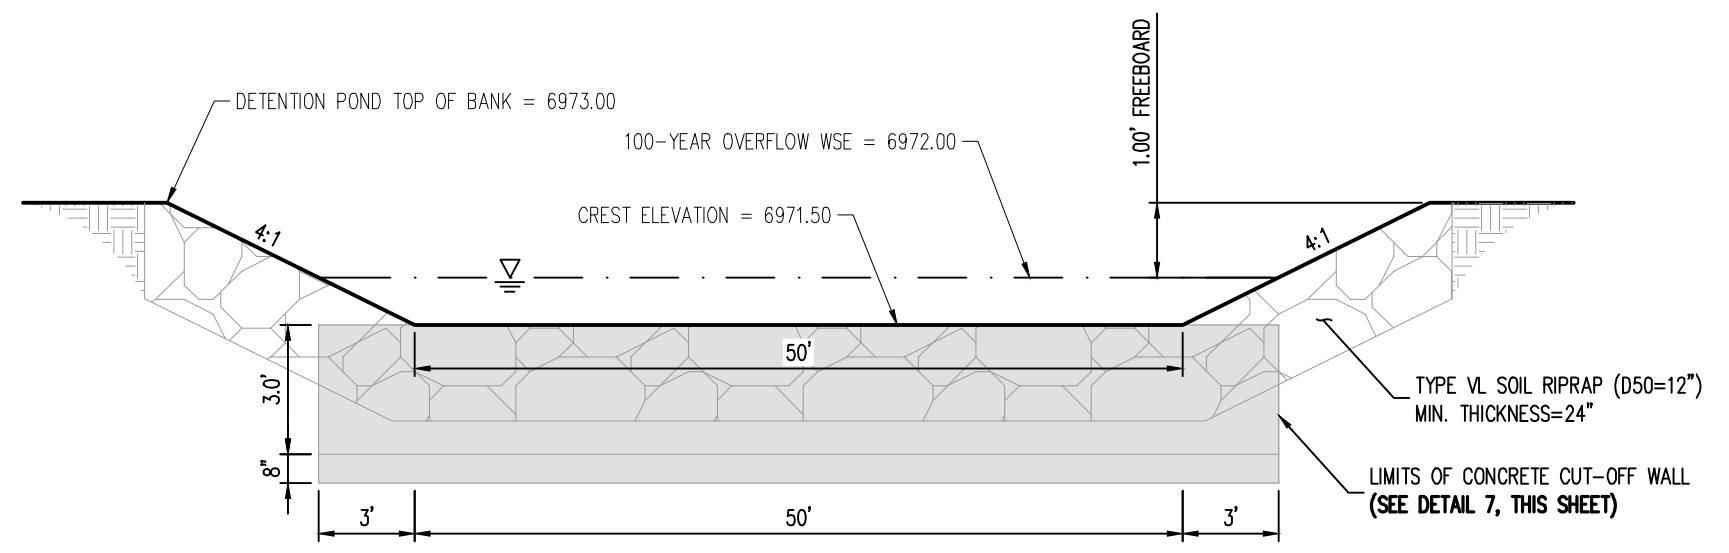


6 100-YEAR OVERFLOW - CROSS SECTION
NOT TO SCALE

WARNING
THIS AREA IS A STORMWATER FACILITY AND IS SUBJECT TO PERIODIC FLOODING

PET WASTE
"LEASH-CURB AND CLEAN UP AFTER YOUR DOG PLEASE KEEP THIS AREA CLEAN"

- NOTES:
- THREE (3) SIGNS WITH THE ABOVE MESSAGES, EACH WITH A MINIMUM AREA OF 3 SQUARE FEET SHALL BE PROVIDED AROUND THE PERIMETER OF THE DETENTION POND, AS SHOWN ON THESE PLANS. BOTH SIGNS ARE TO BE POSTED ON THE SAME POST.
 - WARNING SIGNS SHALL BE DURABLE MATERIALS, SUCH AS METAL OR PLASTIC, USING RED LETTERING ON A WHITE BACKGROUND.
 - PET WASTE SIGNS SHALL BE DURABLE MATERIALS, SUCH AS METAL OR PLASTIC, USING WHITE LETTERING ON A GREEN BACKGROUND.

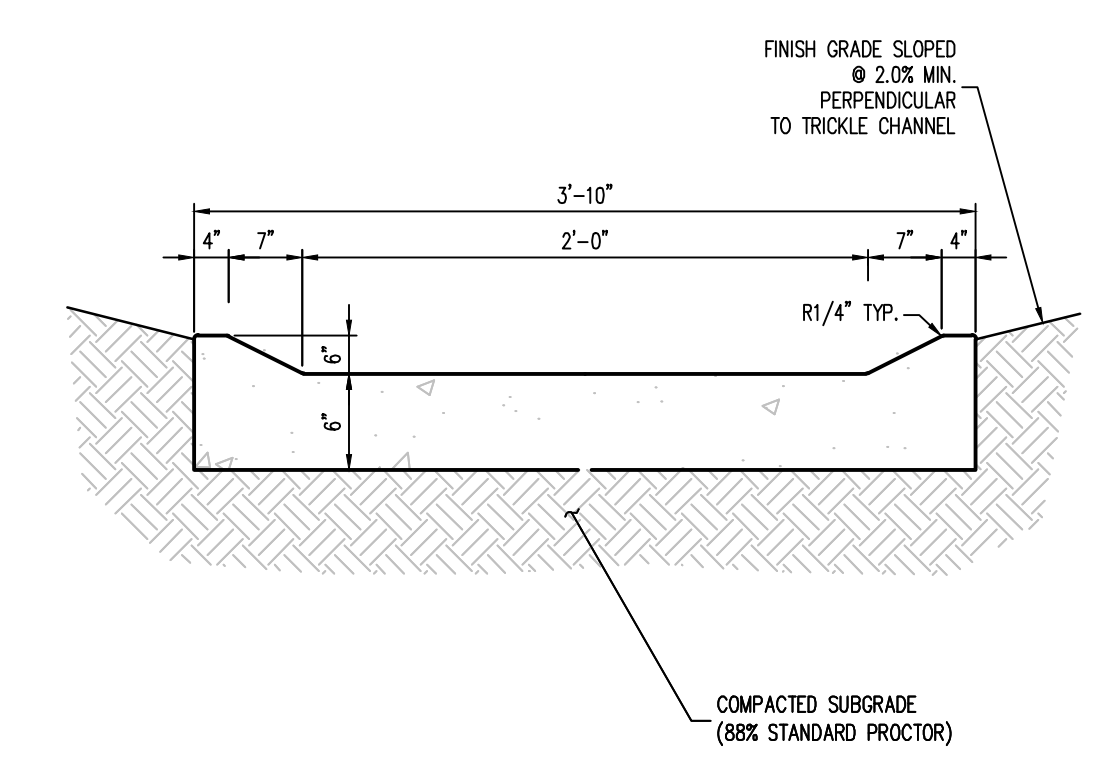


8 DETENTION POND SIGNAGE
NOT TO SCALE

11 TRICKLE CHANNEL WITH MOUNTABLE CURB
NOT TO SCALE

V_2 GEC.pdf Markup Summary

Callout (3)

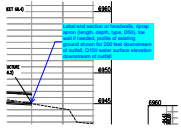


Subject: Callout
Page Label: [26] 26 POND E - OUTLET STRUCTURE DETAILS
Author: CDurham
Date: 4/11/2024 5:36:52 PM
Status:
Color: ■
Layer:
Space:

Label end section or headwalls, riprap apron (length, depth, type, D50), toe wall if needed, profile of existing ground shown for 200 feet downstream of outfall, Q100 water surface elevation downstream of outfall



Subject: Callout
Page Label: [32] 32 POND D - POND DETAILS
Author: CDurham
Date: 4/11/2024 5:37:26 PM
Status:
Color: ■
Layer:
Space:

Label end section or headwalls, riprap apron (length, depth, type, D50), toe wall if needed, profile of existing ground shown for 200 feet downstream of outfall, Q100 water surface elevation downstream of outfall

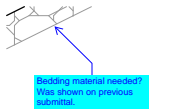

Subject: Callout
Page Label: [32] 32 POND D - POND DETAILS
Author: CDurham
Date: 4/11/2024 5:49:05 PM
Status:
Color: ■
Layer:
Space:


Bedding material needed? Was shown on previous submittal.

Stamp - Stormwater Comment Legend (1)



Subject: Stamp - Stormwater Comment Legend
Page Label: [1] 1 COVER SHEET
Author: Mikayla Hartford
Date: 4/16/2024 10:11:00 AM
Status:
Color: ■
Layer:
Space:

SW - Highlight (6)

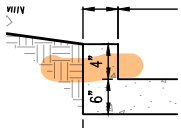


Subject: SW - Highlight
Page Label: [30] 30 POND D - OUTLET STRUCTURE DETAILS
Author: Mikayla Hartford
Date: 4/16/2024 4:57:48 PM
Status:
Color: ■
Layer:
Space:




Subject: SW - Highlight
 Page Label: [32] 32 POND D - POND DETAILS
 Author: Mikayla Hartford
 Date: 4/16/2024 5:09:14 PM
 Status:
 Color: ■
 Layer:
 Space:




Subject: SW - Highlight
 Page Label: [32] 32 POND D - POND DETAILS
 Author: Mikayla Hartford
 Date: 4/16/2024 5:09:15 PM
 Status:
 Color: ■
 Layer:
 Space:

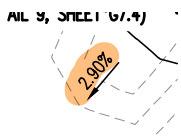

Subject: SW - Highlight
 Page Label: [32] 32 POND D - POND DETAILS
 Author: Mikayla Hartford
 Date: 4/16/2024 5:09:18 PM
 Status:
 Color: ■
 Layer:
 Space:

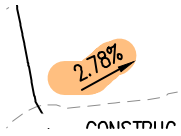


Subject: SW - Highlight
 Page Label: [32] 32 POND D - POND DETAILS
 Author: Mikayla Hartford
 Date: 4/16/2024 5:09:20 PM
 Status:
 Color: ■
 Layer:
 Space:

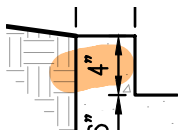


Subject: SW - Highlight
 Page Label: [32] 32 POND D - POND DETAILS
 Author: Mikayla Hartford
 Date: 4/16/2024 5:25:05 PM
 Status:
 Color: ■
 Layer:
 Space:

SW - Rectangle (1)

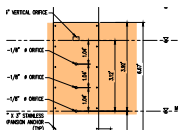


Subject: SW - Rectangle
 Page Label: [28] 28 POND E - POND DETAILS
 Author: Mikayla Hartford
 Date: 4/16/2024 4:54:18 PM
 Status:
 Color: ■
 Layer:
 Space:

SW - Textbox with Arrow (5)

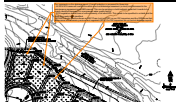


Subject: SW - Textbox with Arrow
Page Label: [14] 14 FINAL EROSION CONTROL PLAN
Author: Mikayla Hartford
Date: 4/16/2024 3:40:33 PM
Status:
Color: ■
Layer:
Space:

Per comments on the drainage report, if runoff reduction is proposed for these lots:
- All RPA/SPA areas will need to be within a no build/drainage easement (or tract) and discussed in the maintenance agreement and O&M manual. This can be existing no build setback areas but it needs to be clearly identified because it is a permanent water quality facility.
- RPA vegetation should have a uniform density of at least 80%. This needs to be specified in a detail and the seed mix needs to be identified.
- RPA/SPA limits must be shown on GEC Plans (not just FDR) so our SW inspectors and the QSM know that these areas are to remain pervious and vegetated (80%). Our SW inspectors do not look at drainage reports.

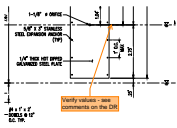

Subject: SW - Textbox with Arrow
Page Label: [28] 28 POND E - POND DETAILS
Author: Mikayla Hartford
Date: 4/16/2024 4:54:32 PM
Status:
Color: ■
Layer:
Space:

Verify values - see comments on the DR

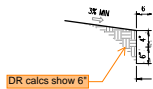


Subject: SW - Textbox with Arrow
Page Label: [30] 30 POND D - OUTLET STRUCTURE DETAILS
Author: Mikayla Hartford
Date: 4/16/2024 4:58:02 PM
Status:
Color: ■
Layer:
Space:

DR calcs show 6"



Subject: SW - Textbox with Arrow
Page Label: [32] 32 POND D - POND DETAILS
Author: Mikayla Hartford
Date: 4/16/2024 5:10:02 PM
Status:
Color: ■
Layer:
Space:


Pond bottom should have a minimum slope of 3% to the trickle channel and micropool (USDCM Vol 3, detail T-5). Please adjust to minimize future maintenance needs.

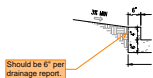

Subject: SW - Textbox with Arrow
Page Label: [32] 32 POND D - POND DETAILS
Author: Mikayla Hartford
Date: 4/16/2024 5:25:33 PM
Status:
Color: ■
Layer:
Space:

Should be 6" per drainage report.

Text Box (1)

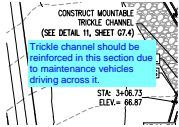

Subject: Text Box

Page Label: [32] 32 POND D - POND DETAILS

Author: CDurham

Date: 4/11/2024 5:43:31 PM

Status:

Color: ■

Layer:

Space:

Trickle channel should be reinforced in this section due to maintenance vehicles driving across it.