



2,521 square feet  
Must request guest house area relief in Special Use letter of intent.

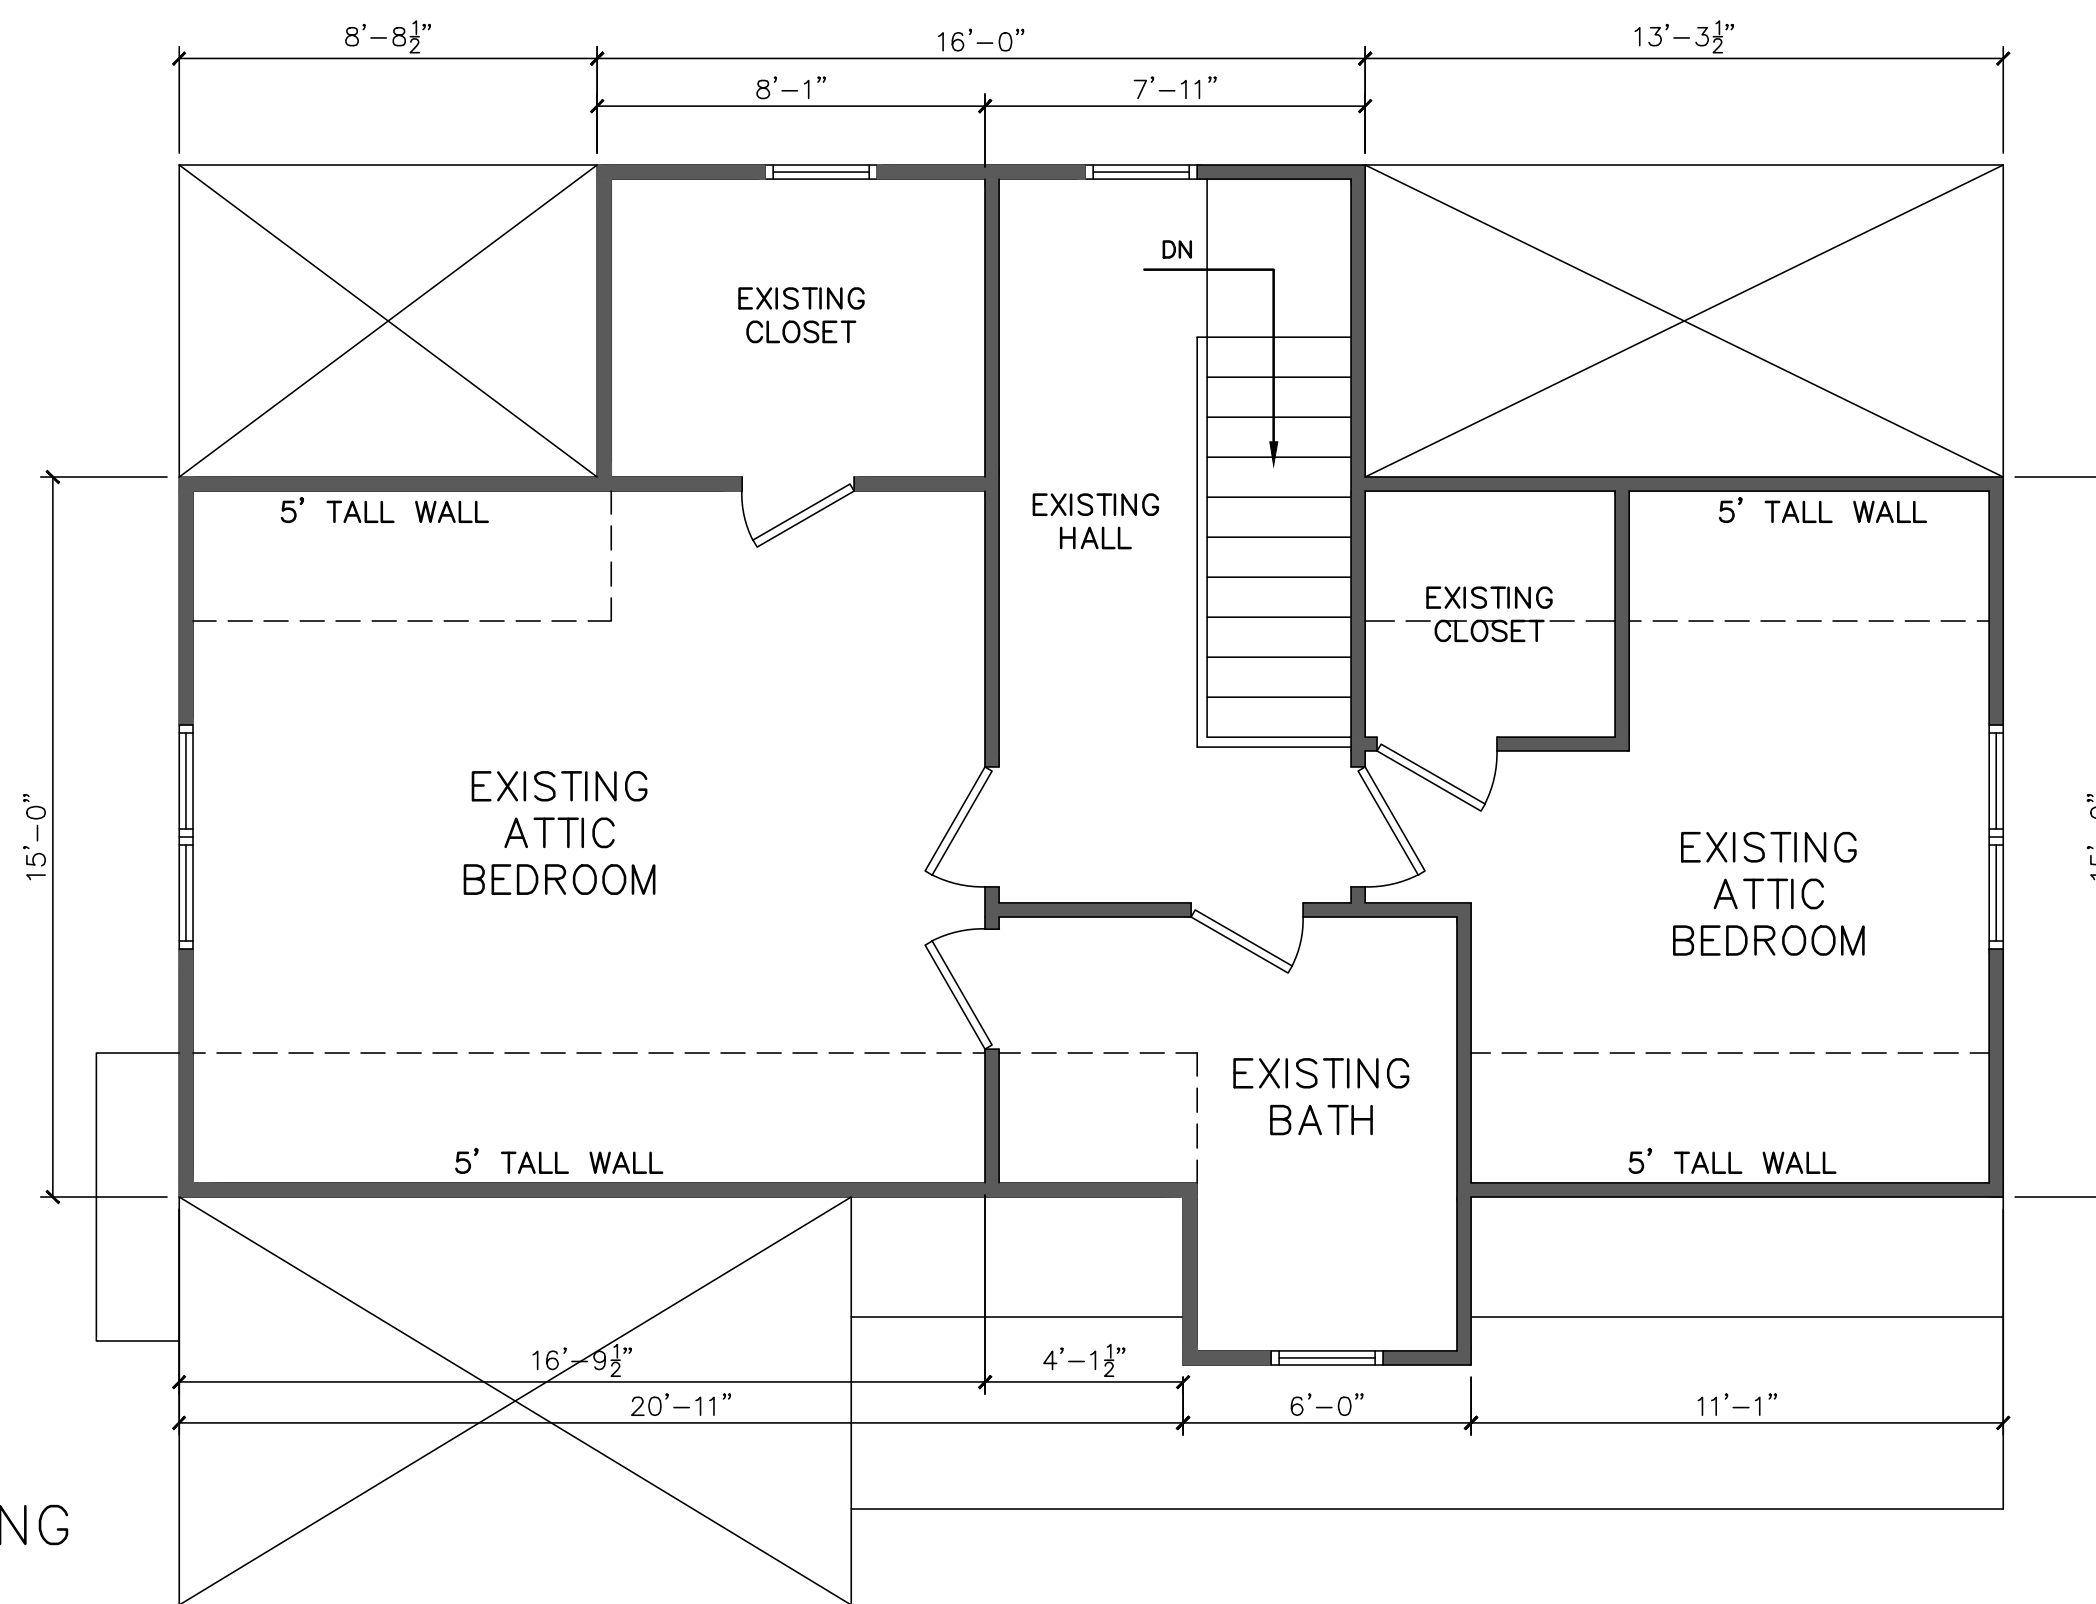

**Design Renaissance**  
Architectural Design & Planning  
815 W. Jefferson Street  
Colorado Springs, CO 80907  
719.633.4604 v  
dmservers@comcast.net

Extended Family Dwelling Request For:  
**Randall & Gwyndena Petrick**  
14195 Silverton Rd  
Colorado Springs, CO 80921

Solid Rock Custom Homes, LLC  
Contact: Lain Chappell  
6250 Corporate Drive  
Colo. Spgs., CO 80919  
Cell 719.964.6352  
Prt./Fax 719.494.0932  
www.SolidRockCustomHomes.com

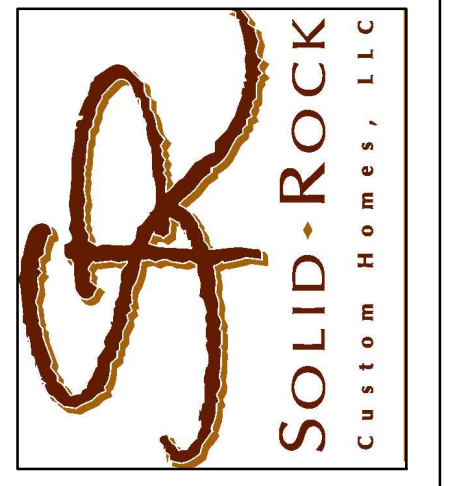

**GUEST HOUSE FLOOR PLANS**

Date Revised: December 13, 2018  
Date: \_\_\_\_\_  
Drawn by: DDS

**A1**

# Markup Summary

---

dskendall (1)

---

2,521 square feet  
Must request guest house area relief in Special Use letter of intent.

**Subject:** Text Box  
**Page Label:** 1  
**Lock:** Unlocked  
**Author:** dskendall  
**Date:** 1/11/2019 11:45:14 AM  
**Color:** ■

2,521 square feet

Must request guest house area relief in  
Special Use letter of intent.