


LOT
Total:
347608.8
Square Feet

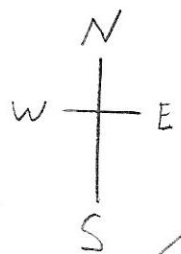

0' 50' 100'
1" = 100'


ZONE: M

Highway 24

Sight Distance Triangle

show where the goat area and propane tank are.

show measurement area of parking area

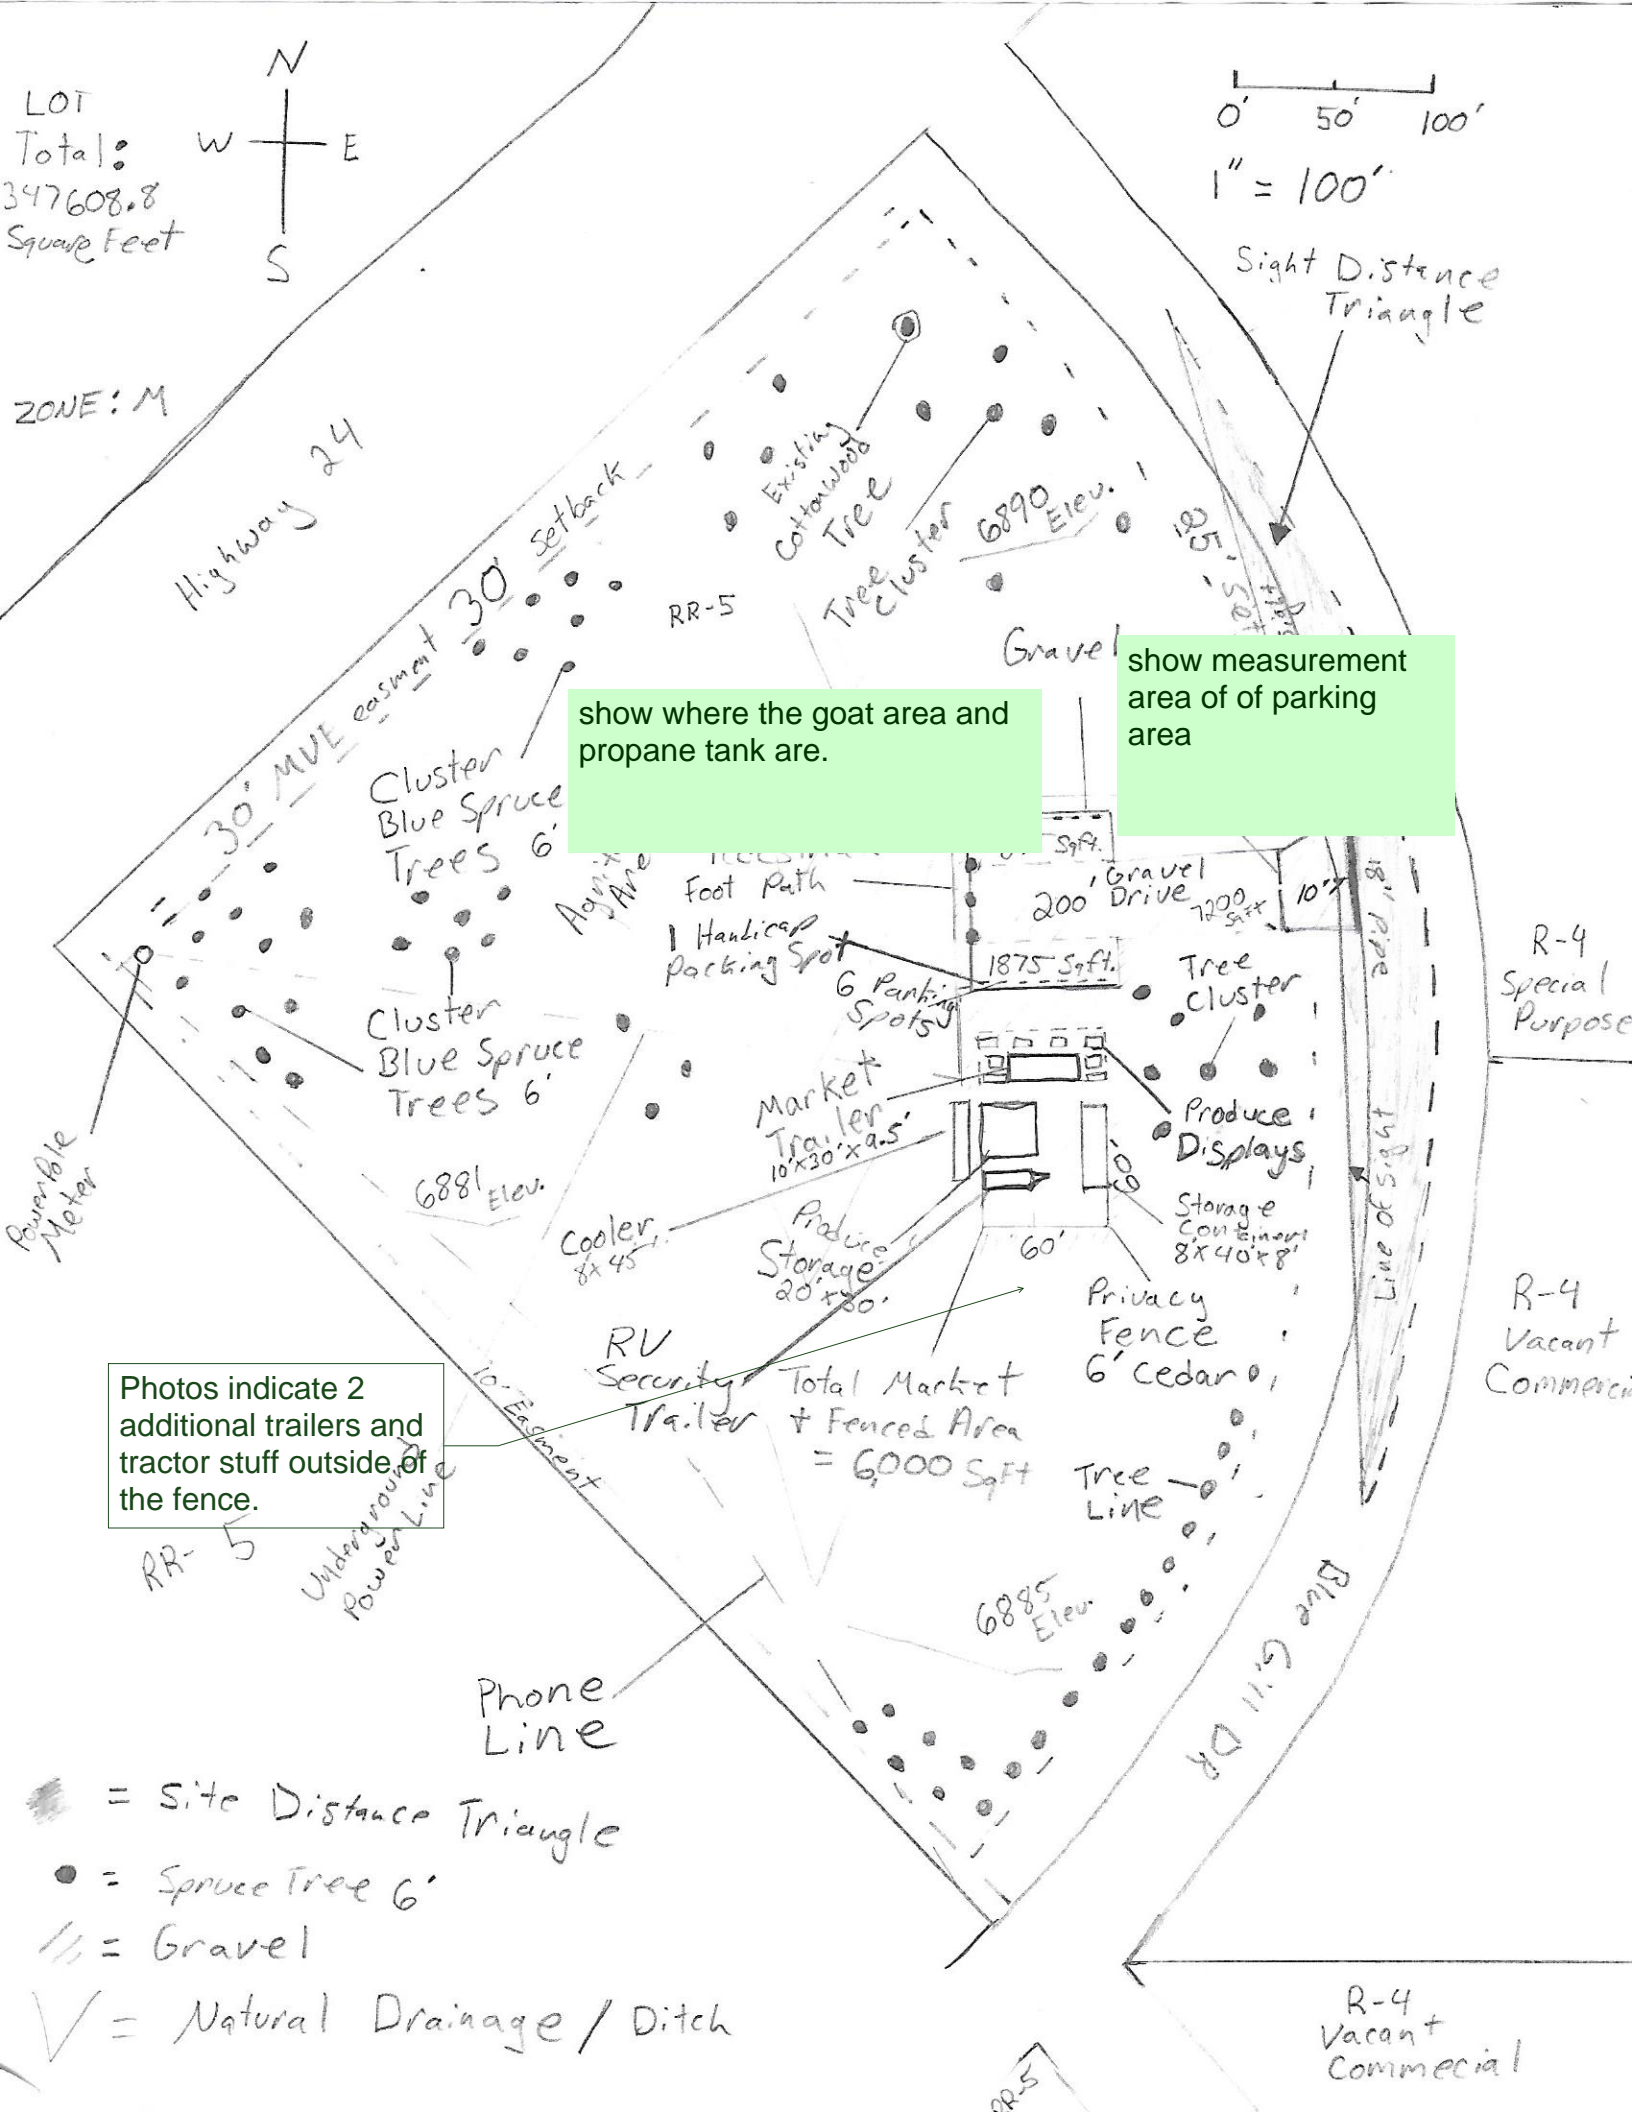

Portable Motor

Photos indicate 2 additional trailers and tractor stuff outside of the fence.

- = Site Distance Triangle
- = Spruce Tree 6'
- /// = Gravel
- ∨ = Natural Drainage / Ditch


R-4 Special Purpose

R-4 Vacant Commercial

R-4 Vacant Commercial


Markup Summary

dsdkendall (3)

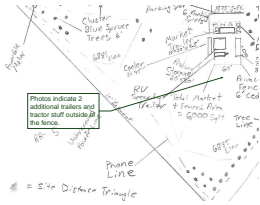


Subject: Callout
Page Label: 1
Author: dsdkendall
Date: 8/30/2018 11:22:23 AM
Color: ■

Photos indicate 2 additional trailers and tractor stuff outside of the fence.

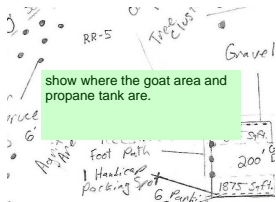

Subject: Text Box
Page Label: 1
Author: dsdkendall
Date: 8/30/2018 3:55:47 PM
Color: ■

show where the goat area and propane tank are.

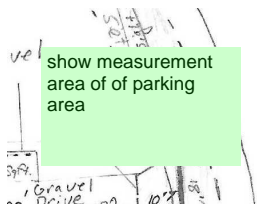

Subject: Text Box
Page Label: 1
Author: dsdkendall
Date: 8/30/2018 3:56:51 PM
Color: ■

show measurement area of of parking area