INDEX MAP

LEGAL DESCRIPTION:

MERIDIAN RANCH ESTATES FILING NO. 2:

THAT GTL, INC. DBA GTL DEVELOPMENT, INC., THEODORE TCHANG, PRESIDENT AND MERIDIAN SERVICE METROPOLITAN DISTRICT BEING THE OWNERS OF THE FOLLOWING DESCRIBED TRACT OF LAND:

A PARCEL OF LAND LOCATED IN A PORTIONS OF SECTION 19 AND 20, IN TOWNSHIP 12 SOUTH, RANGE 64 WEST OF THE 6TH PRINCIPAL MERIDIAN, MORE PARTICULARLY DESCRIBED AS FOLLOWS:

BEGINNING AT THE SOUTHERN MOST CORNER OF TRACT C OF MERIDIAN RANCH ESTATES FILING NO. 2,

THE FOLLOWING EIGHT (8) COURSES ARE ALONG SAID LINE OF TRACT C AND BOUNDARY OF SAID

1. THENCE N72°25'54"E A DISTANCE OF 442.10 FEET TO A CURVE TO THE RIGHT;

RECORDED WITH RECEPTION NO. 213713406 IN THE RECORDS OF EL PASO COUNTY;

- 2. THENCE ON THE ARC OF SAID CURVE, HAVING A RADIUS OF 3300.00 FEET, A DELTA ANGLE OF 14°24'45", AN ARC LENGTH OF 830.10 FEET, WHOSE LONG CHORD BEARS N79°38'16"E A DISTANCE OF 827.92 FEET;
- 3. THENCE N42°55'36"E A DISTANCE OF 31.60 FEET;
- 4. THENCE ON THE ARC OF SAID CURVE, HAVING A RADIUS OF 260.00 FEET, A DELTA ANGLE OF 33'20'58", AN ARC LENGTH OF 151.33 FEET, WHOSE LONG CHORD BEARS N14'36'05"E A DISTANCE
- OF 149.21 FEET; 5. THENCE N57°09'47"W A DISTANCE OF 17.27 FEET;
- 6. THENCE N64°40'14"W A DISTANCE OF 392.46 FEET;
- 7. THENCE N11"10'28"W A DISTANCE OF 81.37 FEET TO A POINT ON THE SOUTHEAST CORNER OF TRACT A OF MERIDIAN RANCH ESTATES FILING NO. 3, RECORDED WITH RECEPTION NO. 216713852 IN THE RECORDS OF EL PASO COUNTY;

THE FOLLOWING SIX (6) COURSES ARE ALONG SAID TRACT A AND THE BOUNDARY OF SAID MERIDIAN RANCH ESTATES FILING NO. 3.

- 8. THENCE N11°10'28"W A DISTANCE OF 163.41 FEET;
- 9. THENCE N22°25'07"W A DISTANCE OF 421.43 FEET; 10. THENCE N39°04'57"W A DISTANCE OF 244.00 FEET;
- 11. THENCE N34°57'33"W A DISTANCE OF 239.34 FEET; 12. THENCE NO6'29'52"W A DISTANCE OF 236.42 FEET
- 13. THENCE NOO'00'00"E A DISTANCE OF 552.46 FEET TO A POINT ON THE NORTH LINE OF THE
- NORTHEAST 1/4 OF SAID SECTION 19;
- 14. THENCE S89"18'07"E ON SAID NORTH SECTION LINE A DISTANCE OF 603.18 FEET;
- 15. THENCE S00°00'00"E A DISTANCE OF 672.92 FEET; 16. THENCE S35°00'00"E A DISTANCE OF 540.00 FEET;
- 17. THENCE S30°02'34"E A DISTANCE OF 180.68 FEET; 18. THENCE SOO°OO'OO"E A DISTANCE OF 254.85 FEET;
- 19. THENCE S38'41'44"W A DISTANCE OF 150.00 FEET;
- 20. THENCE S51"18'16"E A DISTANCE OF 170.23 FEET;
- 21. THENCE N83°41'44"E A DISTANCE OF 31.11 FEET; 22. THENCE S51°18'16"E A DISTANCE OF 30.00 FEET;
- 23. THENCE S38'41'44"W A DISTANCE OF 231.44 FEET TO A POINT OR CURVE TO THE LEFT;
- 24. THENCE ON THE ARC OF SAID CURVE, HAVING A RADIUS OF 220.00 FEET, A DELTA ANGLE OF 40'46'08", AN ARC LENGTH OF 156.54 FEET, WHOSE LONG CHORD BEARS S18"18'40"W A DISTANCE
- 25. THENCE SO2°04'24"E A DISTANCE OF 45.00 FEET;
- 26. THENCE S47°04'24"E A DISTANCE OF 100.00 FEET; 27. THENCE S42*56'08"W A DISTANCE OF 31.12 FEET TO A NON-TANGENT POINT OF CURVE TO THE
- 28. THENCE ON THE ARC OF SAID CURVE, HAVING A RADIUS OF 630.00 FEET. A DELTA ANGLE OF
- 22°38'05", AN ARC LENGTH OF 248.88 FEET, WHOSE LONG CHORD BEARS S09°30'41"W A DISTANCE
- 29. THENCE S20°49'43"E A DISTANCE OF 52.81 FEET;
- 30. THENCE S22°23'52"E A DISTANCE OF 32.06 FEET; 31. THENCE S24°30'35"W A DISTANCE OF 60.00 FEET;
- 32. THENCE S72°56'20"W A DISTANCE OF 32.99 FEET TO A NON-TANGENT POINT OF CURVE TO THE
- 33. THENCE ON THE ARC OF SAID CURVE, HAVING A RADIUS OF 330.00 FEET, A DELTA ANGLE OF 04'41'46", AN ARC LENGTH OF 27.05 FEET, WHOSE LONG CHORD BEARS S35'45'37"W A DISTANCE OF 27.04 FEET TO A POINT ON THE EASTERLY BOUNDARY OF MERIDIAN RANCH FILING NO. 9, RECORDED WITH RECEPTION NO. 216713763 IN THE RECORDS OF EL PASO COUNTY;

THE FOLLOWING EIGHT (8) COURSES ARE ON SAID BOUNDARY LINE:

- 34. THENCE N51*53'30"W A DISTANCE OF 60.00 FEET TO A NON-TANGENT CURVE TO THE LEFT; 35. THENCE ON THE ARC OF SAID CURVE, HAVING A RADIUS OF 270.00 FEET, A DELTA ANGLE OF 17'16'47", AN ARC LENGTH OF 81.43 FEET, WHOSE LONG CHORD BEARS N29'28'07"E A DISTANCE OF 81.12 FEET;
- 36. THENCE N20°49'43"E A DISTANCE OF 84.41 FEET TO A CURVE TO THE LEFT;
- 37. THENCE ON THE ARC OF SAID CURVE, HAVING A RADIUS OF 570.00 FEET, A DELTA ANGLE OF 22'54'07", AN ARC LENGTH OF 227.84 FEET, WHOSE LONG CHORD BEARS NO9'22'40"E A DISTANCE OF 226.32 FEET;
- 38. THENCE NO2°04'24"W A DISTANCE OF 3.92 FEET;
- 39. THENCE N47'26'09"W A DISTANCE OF 30.92 FEET TO A NON-TANGENT CURVE TO THE LEFT; 40. THENCE ON THE ARC OF SAID CURVE, HAVING A RADIUS OF 3240.00 FEET, A DELTA ANGLE OF 14°34'32", AN ARC LENGTH OF 824.23 FEET, WHOSE LONG CHORD BEARS S79°43'10"W A DISTANCE
- 41. THENCE S72°25'54"W A DISTANCE OF 442.10 FEET TO A POINT ON THE BOUNDARY LINE OF SAID MERIDIAN RANCH ESTATES FILING NO. 2;
- 42. THENCE N17°34'06"W A DISTANCE OF 60.00 FEET TO THE POINT OF BEGINNING.

THE ABOVE PARCEL OF LAND CONTAINS 28.907 ACRES, MORE OR LESS.

THE ESTATES AT ROLLING HILLS RANCH FILING NO. 1

A PARCEL OF LAND LOCATED IN A PORTION OF SECTION 19 & 20, IN TOWNSHIP 12 SOUTH, RANGE 64 WEST OF THE 6TH PRINCIPAL MERIDIAN

EL PASO COUNTY, COLORADO.

what about sunrise ridge?

— please revise

Rainbow bridge drive

is not identified in this

the plat shows what

would be the sight

triangle as ROW

- 1) BASIS OF BEARINGS FOR THIS DESCRIPTION IS THE NORTH LINE OF THE NORTHWEST QUARTER OF SECTION 19, T12S, R64W OF THE 6TH P.M., WHICH IS ASSUMED TO BEAR S89"18'12"E FROM THE NORTHWEST CORNER OF SECTION 19 ((2) REFERENCE MONUMENTS PLS 24964) TO THE NORTH QUARTER CORNER OF SECTION 1 (3.25" ALUM. CAP PLS 24964).
- 2) THERE SHALL BE NO VEHICULAR ACCESS FROM ANY RESIDENTIAL LOT IN THIS SUBDIVISION (TO REX ROAD.
- 3) ALL LOT LINES ADJACENT TO STREETS ARE HEREBY PLATTED WITH A 10 FOOT EASEMENT FOR PUBLICAL UTILITIES AND DRAINAGE PURPOSES. THE ENTIRE AREA OF THESE EASEMENTS ARE HEREBY RESERVED FOR UTILITY PURPOSES, WITH MERIDIAN SERVICE METROPOLITAN DISTRICT AND GTL, INC., DBA GTL DEVELOPMENT INC. RESERVING THE RIGHT TO PERMIT ANY SUCH UTILITIES. THE SOLE RESPONSIBILITY FOR MAINTENANCE OF THESE EASEMENTS IS VESTED WITH THE INDIVIDUAL PROPERTY OWNERS.
- 4) UNLESS OTHERWISE SHOWN, ALL SIDE LOT LINES ARE HEREBY PLATTED WITH A 5 FOOT PUBLIC UTILITY AND DRAINAGE EASEMENT AND ALL REAR LOT LINES ARE HEREBY PLATTED WITH A 7.5 FOOT PUBLIC UTILITY AND DRAINAGE EASEMENT. THE SOLE RESPONSIBILITY FOR MAINTENANCE OF THESE EASEMENTS IS VESTED WITH THE INDIVIDUAL PROPERTY OWNERS
- 5) ALL STRUCTURAL FOUNDATIONS SHALL BE LOCATED AND DESIGNED BY A PROFESSIONAL ENGINEER, CURRENTLY REGISTERED IN THE STATE OF COLORADO.
- 6) THE WATER AND SEWER PROVIDER SHALL BE MERIDIAN SERVICE METROPOLITAN DISTRICT.

DEPARTMENT PRIOR TO THE ESTABLISHMENT OF ANY DRIVEWAY.

- 7) NO STRUCTURES OR MATERIAL STORAGE ACTIVITIES ARE PERMITTED WITHIN THE DESIGNATED DRAINAGE EASEMENTS OR NO-BUILD ZONES, EXCEPT FENCES; FENCES SHALL NOT IMPEDE RUNOFF FROM REACHING
- 8) THE FOLLOWING REPORTS HAVE BEEN SUBMITTED AND ARE ON FILE AT THE EL PASO COUNTY PLANNING AND COMMUNITY DEVELOPMENT DEPARTMENT; SOILS AND GEOLOGICAL STUDY; WATER AVAILABILITY STUDY; DRAINAGE REPORT; EROSION CONTROL REPORT; TRAFFIC IMPACT STUDY; FIRE PROTECTION REPORT; NATURAL
- 9) A DRIVEWAY PERMIT MUST BE ISSUED BY EL PASO COUNTY PLANNING AND COMMUNITY DEVELOPMENT
- 10) THE 60 FOOT WIDE PUBLIC HIGHWAY CONTAINED WITHIN THIS PLAT AS ORDERED BY THE BOARD OF COUNTY COMMISSIONERS FOR EL PASO COUNTY ON OCTOBER 3, 1887, AND RECORDED IN ROAD BOOK "A" AT PAGE 78 OF THE RECORDS OF EL PASO COUNTY, IS HEREBY VACATED UPON RECORDATION OF THIS PLAT.
- 11) WATER IN THE DENVER BASIN AQUIFERS IS ALLOCATED BASED ON A 100 YEAR AQUIFER LIFE; HOWEVER, FOR EL PASO COUNTY PLANNING PURPOSES, WATER IN THE DENVER BASIN AQUIFERS IS EVALUATED BASED ON A 300 YEAR AQUIFER LIFE. APPLICANTS, THE HOME OWNERS ASSOCIATION, AND ALL FUTURE OWNERS IN THE SUBDIVISION SHOULD BE AWARE THAT THE ECONOMIC LIFE OF A WATER SUPPLY BASED ON WELLS IN A GIVEN DENVER BASIN AQUIFER MAY BE LESS THAN EITHER THE 100 YEARS OR 300 YEARS INDICATED DUE TO ANTICIPATED WATER LEVEL DECLINES. FURTHERMORE, THE WATER SUPPLY PLAN SHOULD NOT RELY SOLELY UPON NON-RENEWABLE AQUIFERS. ALTERNATIVE RENEWABLE WATER RESOURCES SHOULD BE ACQUIRED AND INCORPORATED IN A PERMANENT WATER SUPPLY PLAN THAT PROVIDES FUTURE GENERATIONS
- 12) DUE TO POTENTIAL FOR HIGH GROUND WATER IN THE AREA, ALL FOUNDATIONS SHALL INCORPORATE AN UNDERGROUND DRAINAGE SYSTEM.
- 13) DEVELOPER SHALL COMPLY WITH FEDERAL AND STATE LAWS, REGULATIONS, ORDINANCES, REVIEW AND PERMIT REQUIREMENTS, AND OTHER AGENCY REQUIREMENTS, IF ANY OF APPLICABLE AGENCIES INCLUDING, BUT NOT LIMITED TO, THE COLORADO DEPARTMENT OF WILDLIFE, COLORADO DEPARTMENT OF TRANSPORTATION, U.S. ARMY CORPS OF ENGINEERS, THE U.S. FISH & WILDLIFE SERVICE AND/OR COLORADO DEPARTMENT OF WILDLIFE REGARDING THE ENDANGERED SPECIES ACT, PARTICULARLY AS IT RELATES TO THE PREBLE'S MEADOW JUMPING MOUSE AS A LISTED THREATENED SPECIES.
- 14) TRACTS A & B ARE HEREBY DEDICATED AS TRAIL, LANDSCAPE, DRAINAGE, AND UTILITY TRACTS TO BE OWNED AND MAINTAINED BY THE MERIDIAN SERVICE METROPOLITAN DISTRICT. THE ENTIRE AREA OF THESE TRACTS IS HEREBY RESERVED FOR UTILITY PURPOSES, WITH MERIDIAN SERVICE METROPOLITAN DISTRICT AND GTL, INC., DBA GTL DEVELOPEMENT, INC. RESERVING THE RIGHT TO PERMIT ANY SUCH UTILITIES. ALL OPEN
- SPACE/LANDSCAPE TRACTS ARE RESTRICTED TO NON-MOTORIZED USE ONLY. 15) EASEMENTS AND RIGHT-OF-WAYS WERE BASED ON TITLE COMMITMENT NO. _____ BY
- HERITAGE TITLE COMPANY, DATED _ 16) ALL PROPERTY WITHIN THIS SUBDIVISION IS WITHIN THE BOUNDARIES OF THE WOODMEN ROAD METROPOLITAN DISTRICT AND, AS SUCH, IS SUBJECT TO A MILL LEVY, PLATTING FEES AND BUILDING PERMIT FEES FOR THE PURPOSE OF FINANCING CONSTRUCTION OF SPECIFIED IMPROVEMENTS TO WOODMEN ROAD.
- 17) ALL PUBLIC LAND SURVEY INFORMATION AS SHOWN HEREON IS BASED ON A BOUNDARY SURVEY PERFORMED BY URS CORPORATION DATED APRIL 13, 2000. BOUNDARY SURVEY IS RECORDED WITH RECEPTION NUMBER 201900096 OF EL PASO COUNTY RECORDS.
- 18) THIS PLAT IS SUBJECT TO THE TERMS AND CONDITIONS OF THE SUBDIVISION IMPROVEMENTS AGREEMENT AS RECORDED AT RECEPTION NO.____ ______ IN THE OFFICE OF THE CLERK AND RECORDER OF THE EL PASO COUNTY, COLORADO.
- 19) THE PLAT IS REGULATED BY A P.U.D. DEVELOPMENT PLAN FILES PUDSP-18-003 AS RECORDED WITH
- _____ OF THE RECORDS OF EL PASO COUNTY, COLORADO. RECEPTION NO._____ 20) ALL PROPERTY OWNERS ARE RESPONSIBLE FOR MAINTAINING PROPER STORM WATER DRAINAGE IN AND THROUGH THEIR PROPERTY. PUBLIC DRAINAGE EASEMENTS AS SPECIFICALLY NOTED ON THE PLAT SHALL BE MAINTAINED BY THE INDIVIDUAL LOT OWNERS UNLESS OTHERWISE INDICATED. STRUCTURES, FENCES,
- MATERIALS OR LANDSCAPING THAT COULD IMPEDE THE FLOW OF RUNOFF SHALL NOT BE PLACED IN 21) NO LOT OR INTEREST THEREIN, SHALL BE SOLD, CONVEYED OR TRANSFERRED WHETHER BY DEED OR BY CONTRACT, NOR SHALL BUILDING PERMITS BE ISSUED, UNTIL AND UNLESS THE REQUIRED PUBLIC IMPROVEMENTS HAVE BEEN CONSTRUCTED AND COMPLETED IN ACCORDANCE WITH THE SUBDIVISION
- IMPROVEMENTS AGREEMENT BETWEEN THE APPLICANT AND EL PASO COUNTY AS RECORDED AT RECEPTION __, IN THE OFFICE OF THE CLERK AND RECORDER OF EL PASO COUNTY, COLORADO, OR IN THE ALTERNATIVE, OTHER COLLATERAL IS PROVIDED WHICH IS SUFFICIENT IN THE JUDGEMENT OF THE BOARD OF COUNTY COMMISSIONERS, TO MAKE PROVISION FOR THE COMPLETION OF SAID
- 22) NO OBSTRUCTION GREATER THAN EIGHTEEN INCHES (18") IS ALLOWED IN A TWENTY-FIVE FOOT (25') BY TWENTY-FIVE FOOT (25') SIGHT TRIANGLE NO-BUILD AREA NEAR ALL CORNER LOTS AT STREET INTERSECTIONS. NO OBSTRUCTION GREATER THAN EIGHTEEN INCHES (18") IS ALLOWED IN A THIRTY FOOT (30') BY THIRTY FOOT (30') SIGHT TRIANGLE NO-BUILD AREA NEAR ALL CORNER LOTS AT STREET INTÉRSECTIONS ALONG RAINBOW BRIDGE DRIVE.

Mailboxes shall be installed in accordance with all El Paso County and United States Postal Service

ACCORDANCE WITH THE PROVISIONS OF THE FIRST AMENDMENT TO THE INTERGOVERNMENTAL AGREEMENT CONCERNING WOODMEN ROAD ADOPTED PURSUANT TO RESOLUTION NO. 13-041.

25) PLOOD PLAIN: "THE ESTATES AT ROLLING HILLS RANCH FILING 1" IS NOT LOCATED WITHIN ANY DESIGNATED F.E.M.A. FLOOD ZONE BASED ON LOMR CASE NO. 14-08-1121P, EFFECTIVE DATE MARCH 24, 2015 WHICH IS A REVISION TO THE FLOOD HAZARDS DEPICTED ON F.E.M.A. FIRM MAP 08041C0575-F DATED MARCH 17,

26) LOTS 1-16 ACREAGE: 18.333 TRACT A & B ACREAGE: 5.160 <u>STREETS ACREAGE:</u> TOTAL ACREAGE:

Please provide the

atest FIRM MAP #

and date in your

Flood plain note.

DEDICATION:

THE ABOVE OWNER(S) HAVING CAUSED SAID TRACT OF LAND TO BE PLATTED INTO LOTS, TRACTS, STREETS AND EASEMENTS AS SHOWN ON THE PLAT, WHICH SUBDIVISION SHALL BE ENTITLED "THE ESTATES AT ROLLING HILLS RANCH FILING 1", A SUBDIVISION IN EL PASO COUNTY, COLORADO. ALL STREETS PLATTED ARE HEREBY DEDICATED TO PUBLIC USE AND SAID OWNER DOES HEREBY AGREE THAT ALL PLATTED STREETS WILL BE CONSTRUCTED AND PROPER DRAINAGE PROVIDED AT THE OWNER'S EXPENSE AND ALL TO THE SATISFACTION OF THE BOARD OF COUNTY COMMISSIONERS OF EL PASO COUNTY, COLORADO UPON ACCEPTANCE BY RESOLUTION, ALL STREETS SO DEDICATED WILL BECOME MATTERS OF MAINTENANCE BY EL PASO COUNTY, COLORADO WITH THE EXCEPTION OF MEDIANS WHICH WILL BE MAINTAINED BY THE MERIDIAN SERVICE METROPOLITAN DISTRICT.

PLAT NO.

GTL, INC. DBA GTL DEVELOPMENT, INC., RAUL GUZMAN, VICE PRESIDENT HAS CAUSED THESE PRESENTS TO BE EXECUTED THIS ____ DAY OF ______

GTL, INC., DBA GTL DEVELOPMENT, INC.

RAUL GUZMAN, VICE PRESIDENT

STATE OF COLORADO) COUNTY OF EL PASO)

THIS INSTRUMENT WAS ACKNOWLEDGED BEFORE ME THIS ____ DAY OF _____, 20__, BY RAUL GUZMAN, VICE PRESIDENT, GTL, INC. DBA GTL DEVELOPMENT, INC.

NOTARY PUBLIC ADDRESS MY COMMISSION EXPIRES: ______

MERIDIAN SERVICE METROPOLITAN DISTRICT

MITLON GABRIELSKI, PRESIDENT

STATE OF COLORADO)

COUNTY OF EL PASO) THIS INSTRUMENT WAS ACKNOWLEDGED BEFORE ME THIS ____ DAY OF _____, 20__, BY MILTON GABRIELSKI, MERIDIAN SERVICE METROPOLITAN DISTRICT.

ADDRESS NOTARY PUBLIC MY COMMISSION EXPIRES: _____


Surveyors Certificate

I surveyor's name, a duly registered Professional Land Surveyor in the State of Colorado, do hereby certify that this plat truly and correctly represents the results of a survey made on date of survey, by me or under my direct supervision and that all monuments exist as shown hereon; that mathematical closure errors are less than 1:10,000; and that said plat has been prepared in full compliance with all applicable laws of the State of Colorado dealing with monuments, subdivision, or surveying of land and all applicable provisions of the El Paso County Land Development Code.

I attest the above on this _____ day of ___ Surveyor's Name, (Signature) Colorado registered PLS #__

PROFESSIONAL LAND SURVEYOR IN THE STATE OF COLORADO, PLS NO. 34583

NOTICE: ACCORDING TO COLORADO LAW, YOU MUST COMMENCE ANY LEGAL ACTION BASED UPON ANY DEFECT IN THIS SURVEY WITHIN THREE YEARS AFTER YOU FIRST DISCOVER SUCH DEFECT. IN NO EVENT, MAY ANY ACTION BASED UPON ANY DEFECT IN THIS SURVEY BE COMMENCED MORE THAN TEN YEARS FROM THE DATE OF CERTIFICATION SHOWN HEREON.

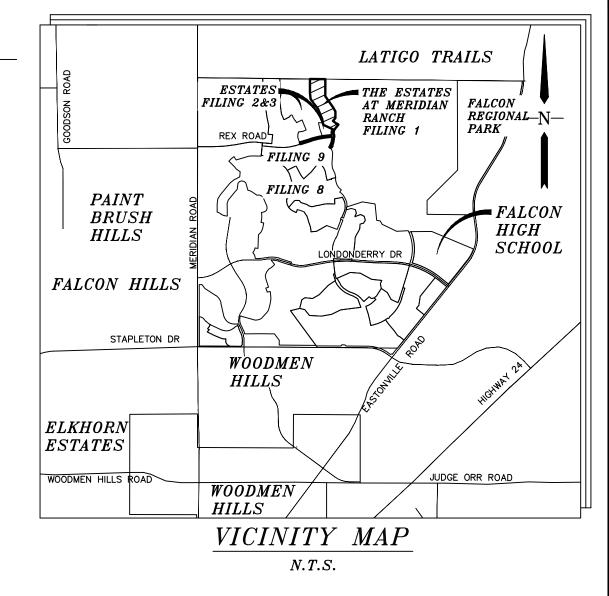

APPROVALS:

THE ACCOMPANYING PLAT OF "THE ESTATES AT ROLLING HILLS RANCH FILING 1", EL PASO COUNTY, COLORADO, WAS APPROVED FOR FILING THIS ____ DAY OF ______, 20__.

DIRECTOR OF PLANNING AND COMMUNITY DEVELOPMENT

Board of County Commissioners Certificate

This plat for (name of subdivision or plat) was approved for filing by the El Paso County, Colorado Board of County Commissioners on the specified hereon and any conditions included in the resolution of approval. The dedications of land to the public (streets, tracts, easements: list those applicable) are accepted, but public improvements thereon will not become the maintenance responsibility of El Paso County until preliminary acceptance of the public improvements in accordance with the requirements of the Land Development Code and Engineering Criteria Manual, and the Subdivision Improvements Agreement.

Chair Board of County Commissioners

THIS ____, 20__.

EL PASO COUNTY CLERK AND RECORDER

Clerk and Recorder STATE OF COLORADO

COUNTY OF EL PASO I hereby certify that this instrument was filed in my office on this ____ day of _____, 20__, and was recorded at Reception Number ___ El Paso County

of the records of 20__, AND IS DULY OF THE RECORDS OF

RD IN MY OFFICE AT

El Paso County Clerk and Recorder

<u>FEES:</u>


RECEIPT NO: PLAT FEE:


SURCHARGE: SCHOOL: PARK:


BRIDGE: DRAINAGE:

> DRAWN BY: LCG DATE: JULY 2019 SHEET: 1 OF 5 CHECKED BY: TAK

> > PCD PROJ Add PCD File #

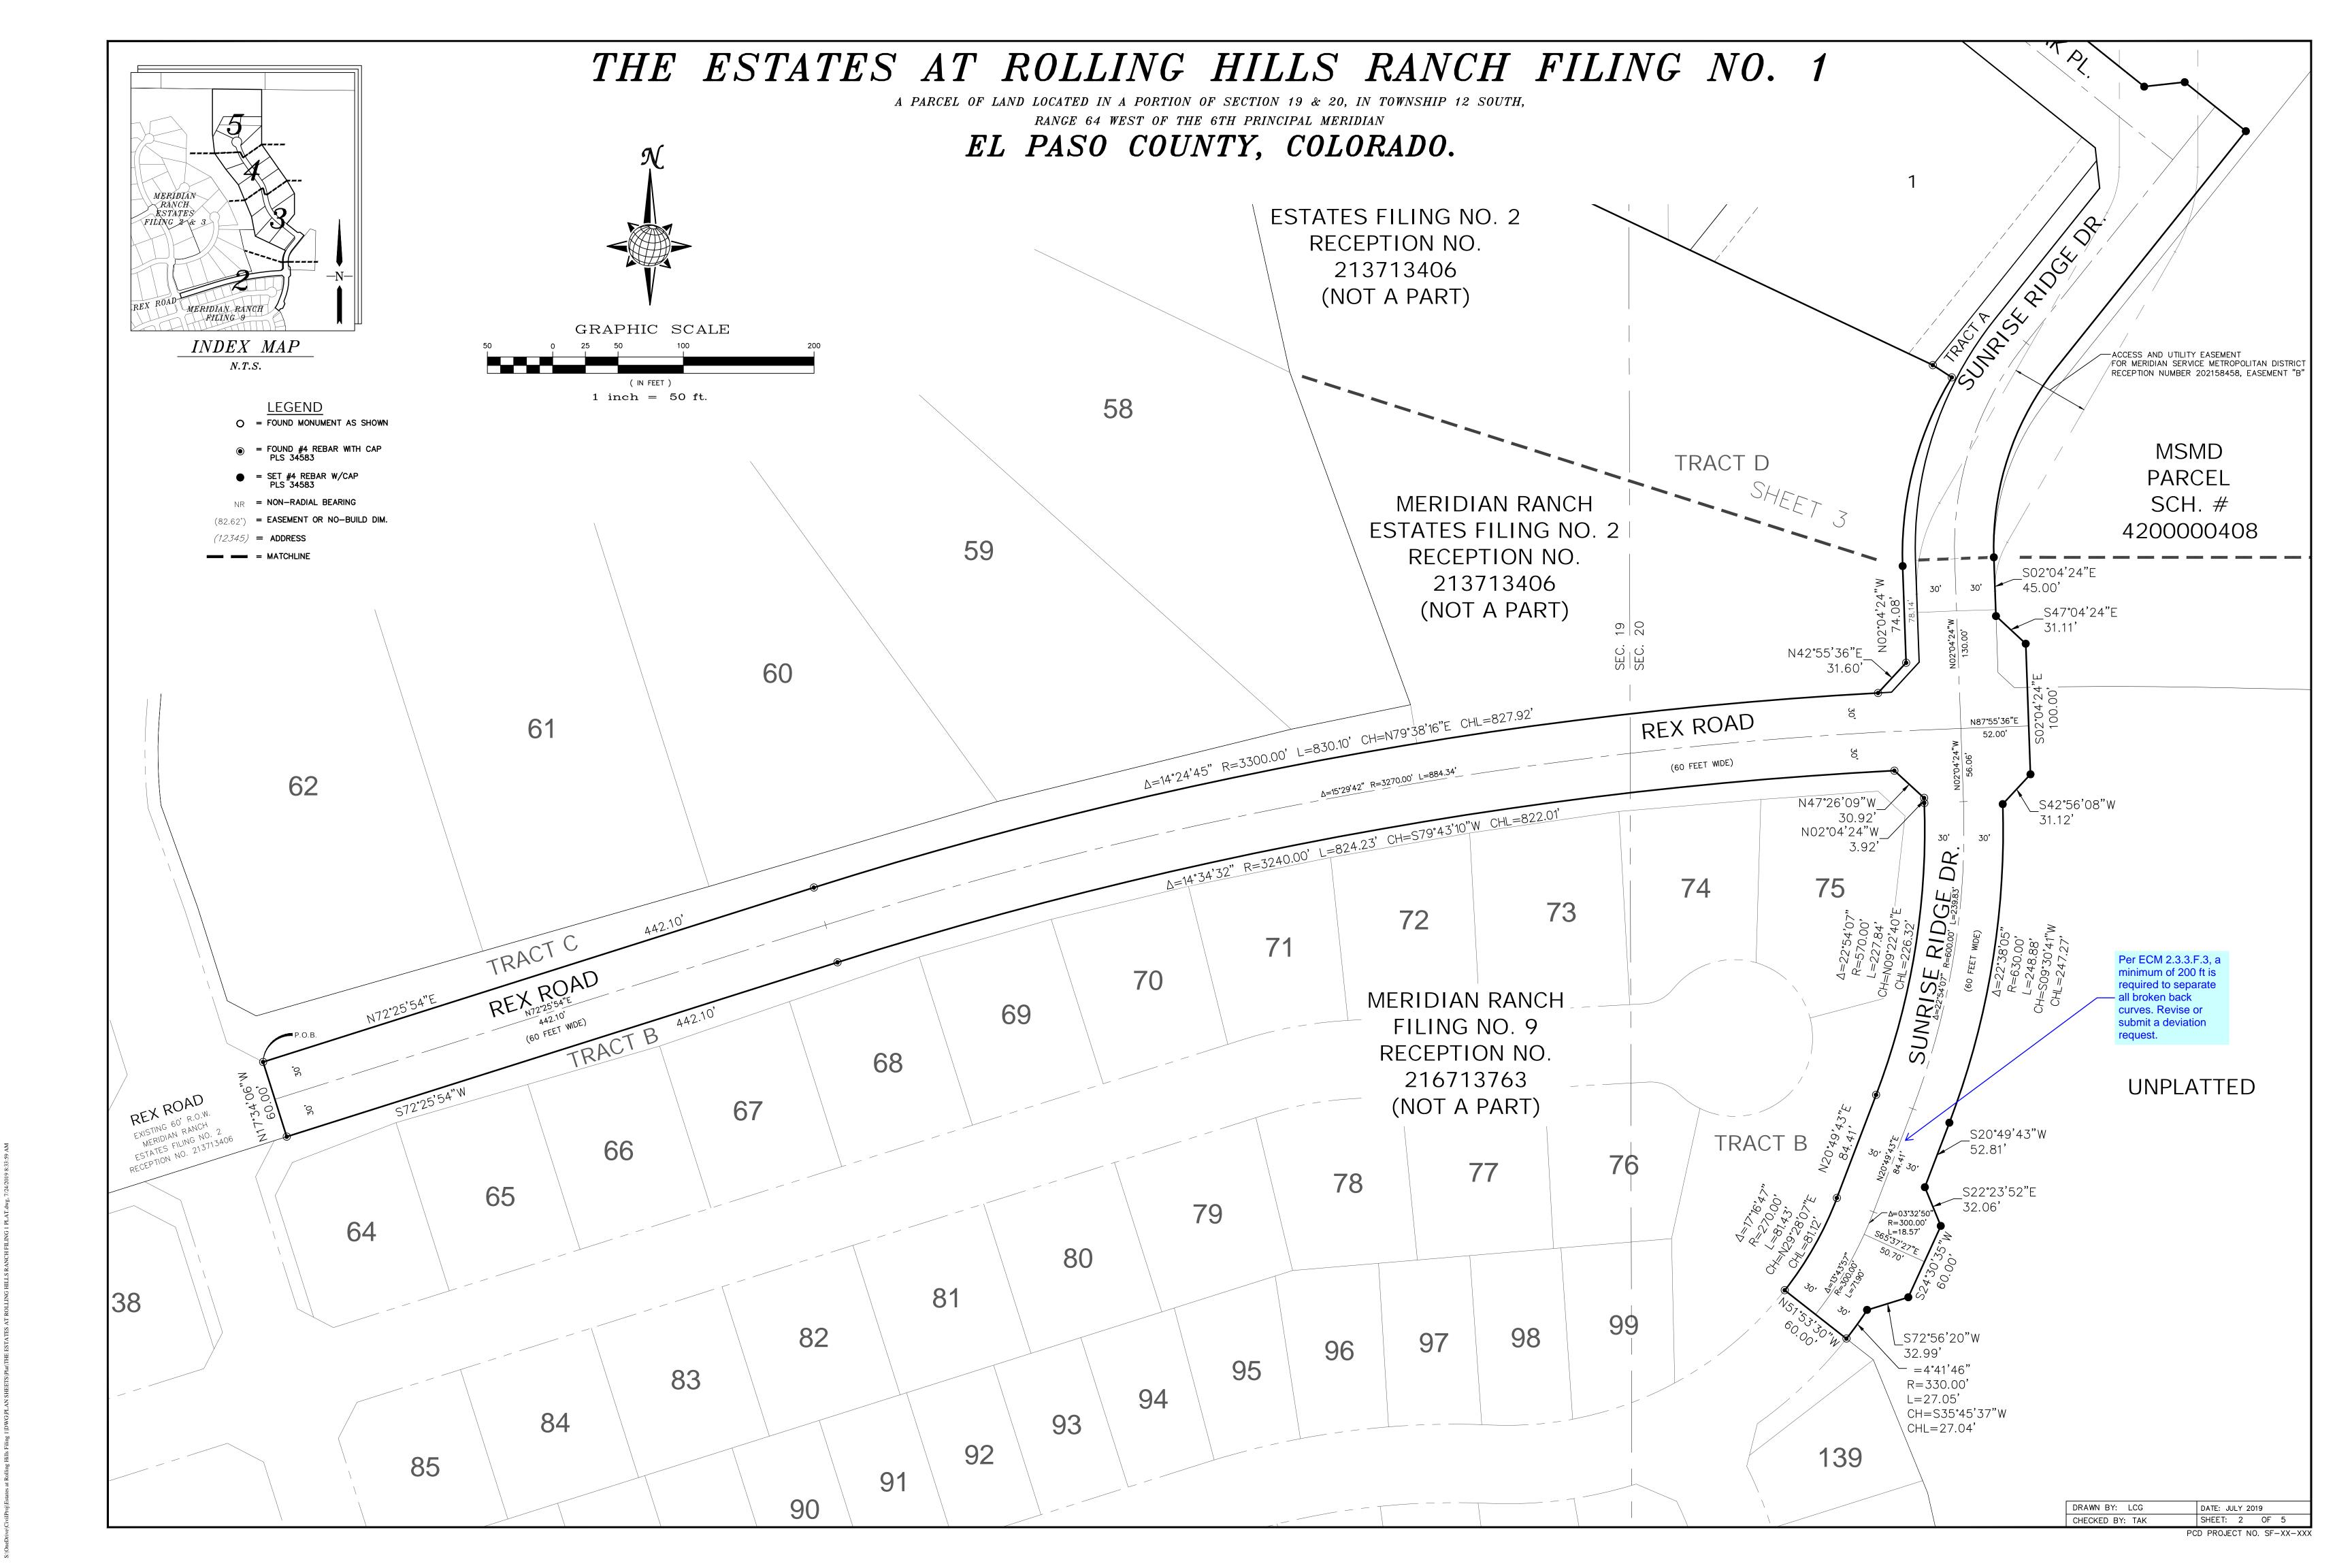

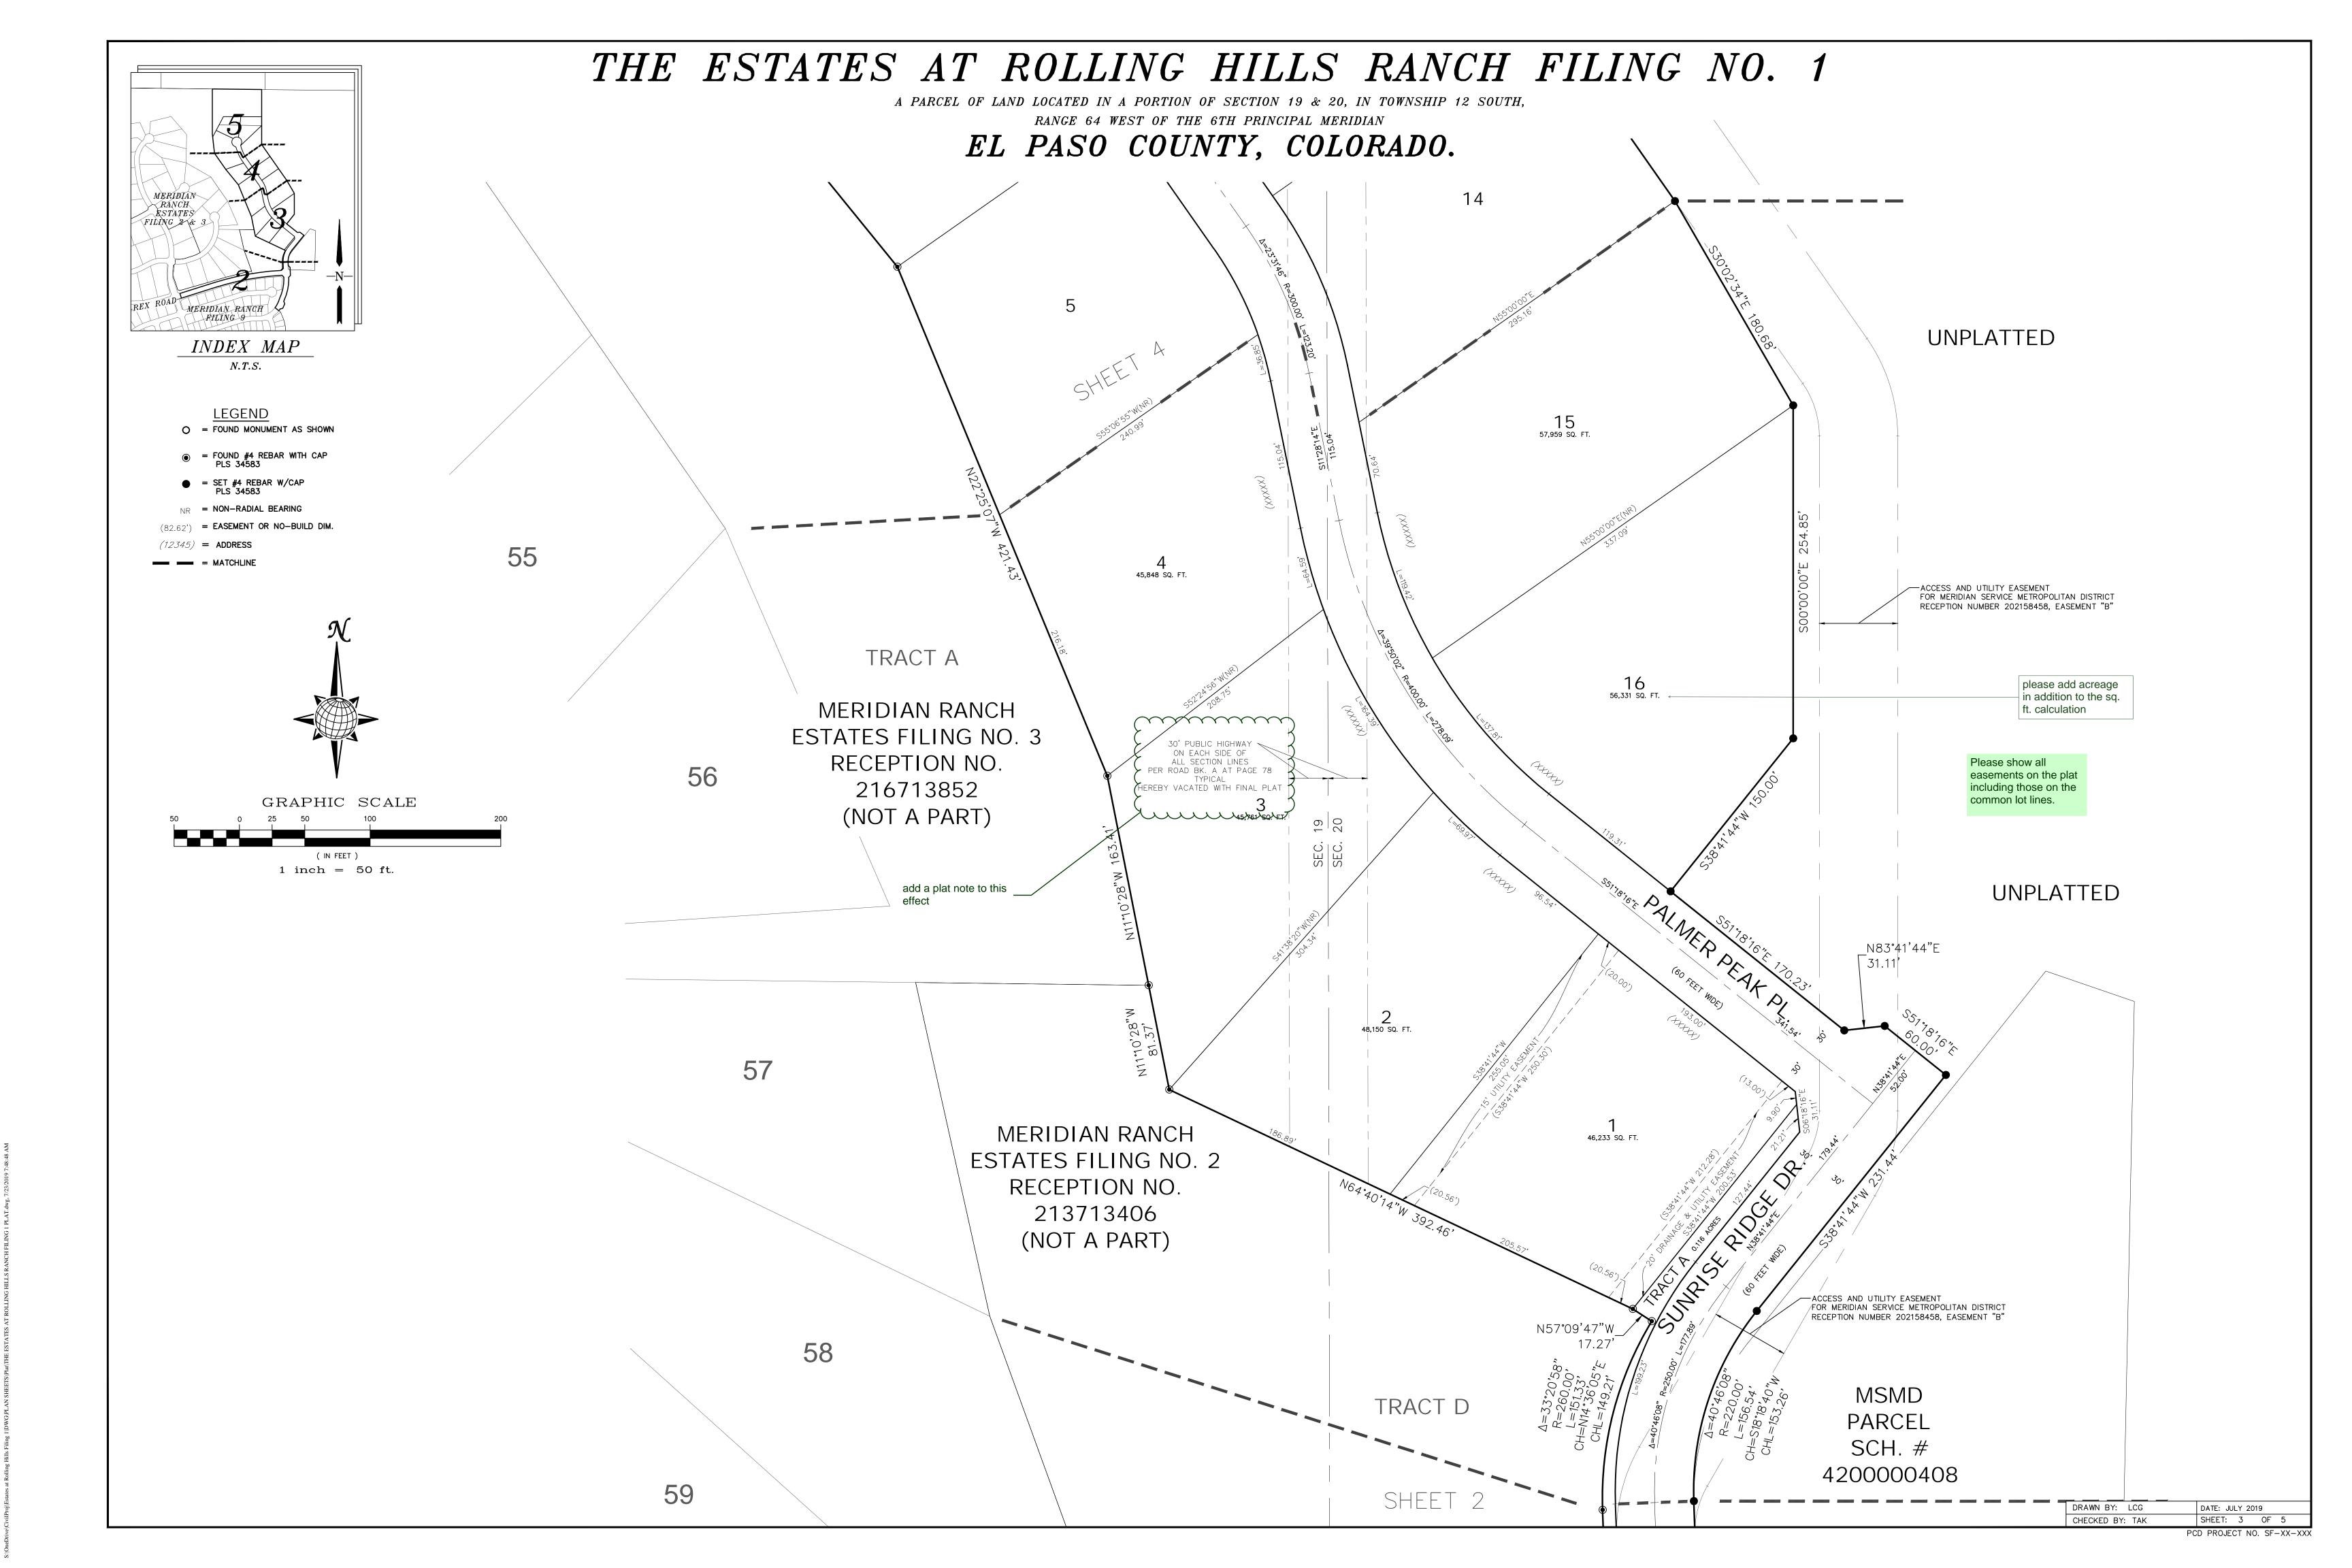

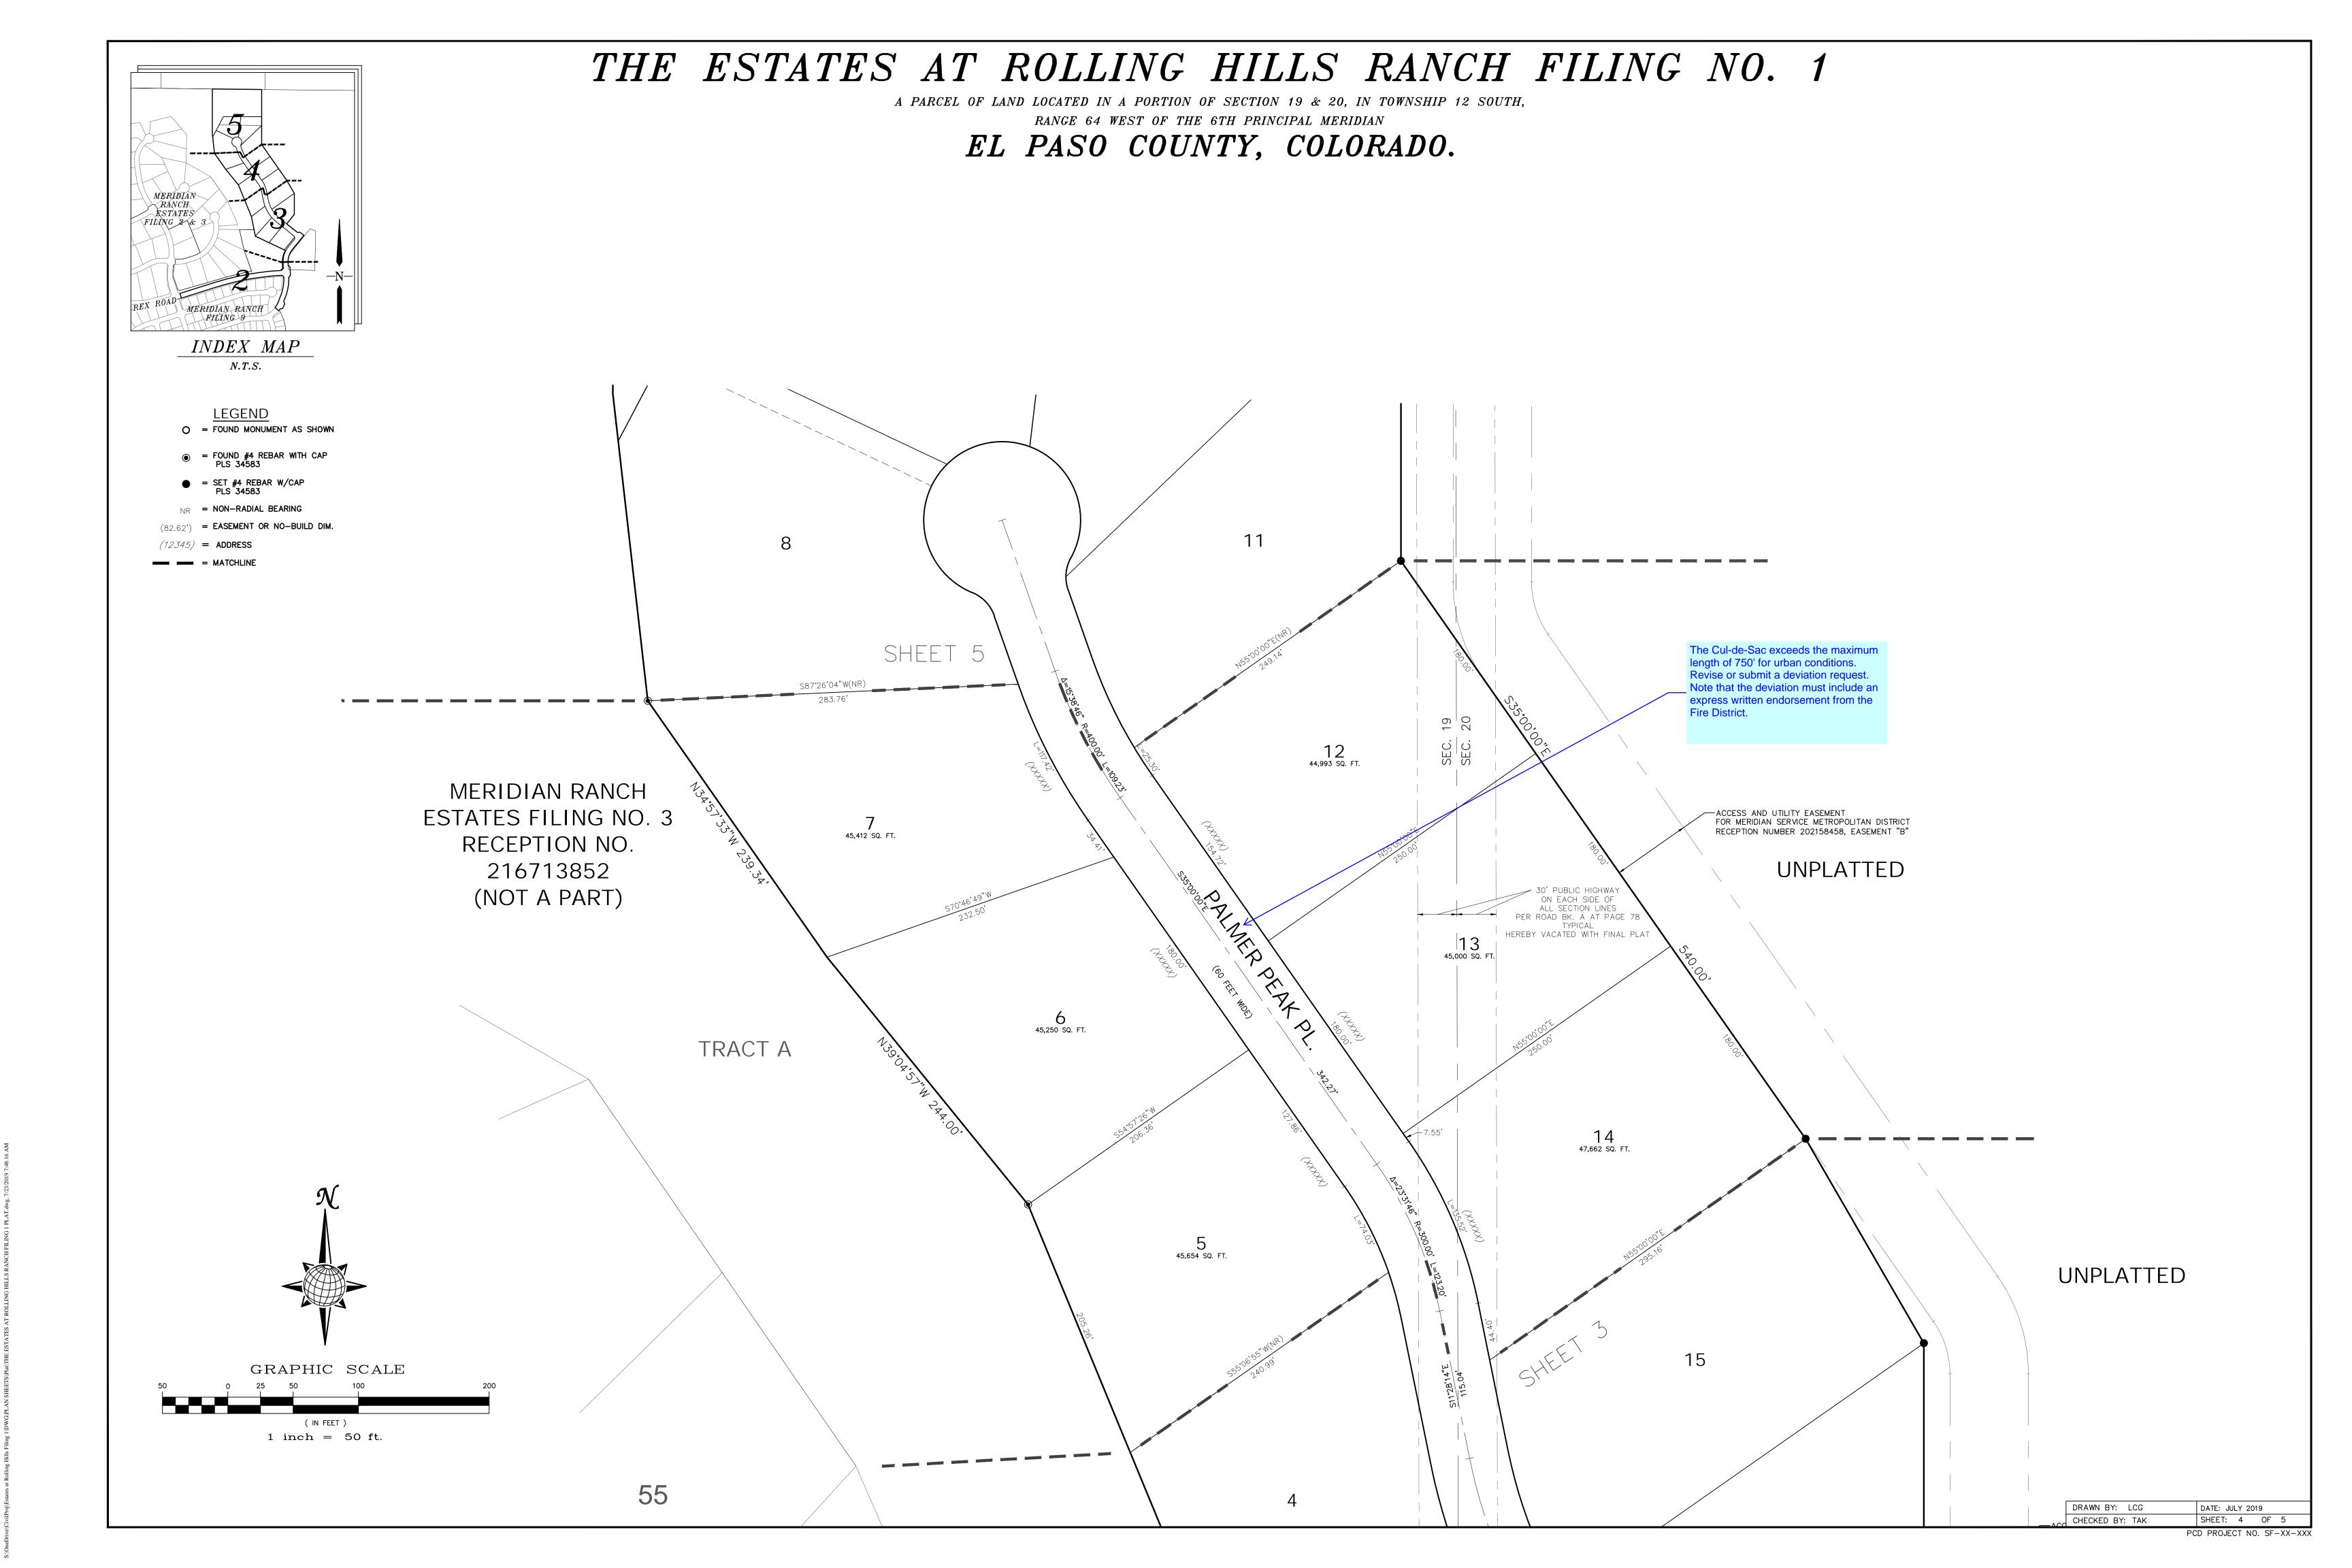

THE ESTATES AT ROLLING HILLS RANCH FILING NO. 1 A PARCEL OF LAND LOCATED IN A PORTION OF SECTION 19 & 20, IN TOWNSHIP 12 SOUTH, RANGE 64 WEST OF THE 6TH PRINCIPAL MERIDIAN EL PASO COUNTY, COLORADO. MERIDIAN RANCH ESTATES FILING 2 & 3 INDEX MAP S89°18'07"E SEC. 17 603.18 SEC. 18 · (Δ=11°27'33" R=818.50' L=163.70') $(\Delta=03^{\circ}26'16" R=1981.50' L=118.89')$ $(\Delta=06^{\circ}52'32" R=1018.50' L=122.22')$ SEC. 20 $(\Delta = 14^{\circ}53'49'' R = 481.50' L = 125.19')$ LEGEND (Δ=03°17'44" R=981.50' L=56.45')—/
(25.02') O = FOUND MONUMENT AS SHOWN (Δ=03°26'16" R=2006.50' L=120.39') (Δ=06°52'32" R=993.50' L=119.22') Δ=14°53'49" R=506.50' L=131.69') = FOUND #4 REBAR WITH CAP
 PLS 34583 (R=1006.50')(L=58.80')ACCESS AND UTILITY EASEMENT
FOR MERIDIAN SERVICE METROPOLITAN DISTRICT = SET #4 REBAR W/CAP PLS 34583 (R=325.00') (L=15.73') EASEMENT RECEPTION NUMBER 202158458, EASEMENT "B" 30' PUBLIC HIGHWAY $_{NR}$ = NON-RADIAL BEARING ON EACH SIDE OF ALL SECTION LINES
PER ROAD BK. A AT PAGE 78
TYPICAL
HEREBY VACATED WITH FINAL PLAT (82.62') = EASEMENT OR NO-BUILD DIM. (12345) = ADDRESS = MATCHLINE TRACT B TRACT A UNPLATTED MERIDIAN RANCH ACCESS AND UTILITY EASEMENT
FOR MERIDIAN SERVICE METROPOLITAN DISTRICT
RECEPTION NUMBER 202158458, EASEMENT "B" ESTATES FILING NO. 3 RECEPTION NO. (N89°18'07"W 266.44') 216713852 10 62,032 SQ. FT. (NOT A PART) 57,938 SQ. FT. Place the swale in a drainage 11 47,387 SQ. FT. 8 56,953 SQ. FT. GRAPHIC SCALE S87°26'04"W(NR) 283.76' (IN FEET) 1 inch = 50 ft.SHEET 4 DRAWN BY: LCG DATE: JULY 2019 SHEET: 5 OF 5 CHECKED BY: TAK