




LEFT ELEVATION
SCALE 1/4"=1'-0"

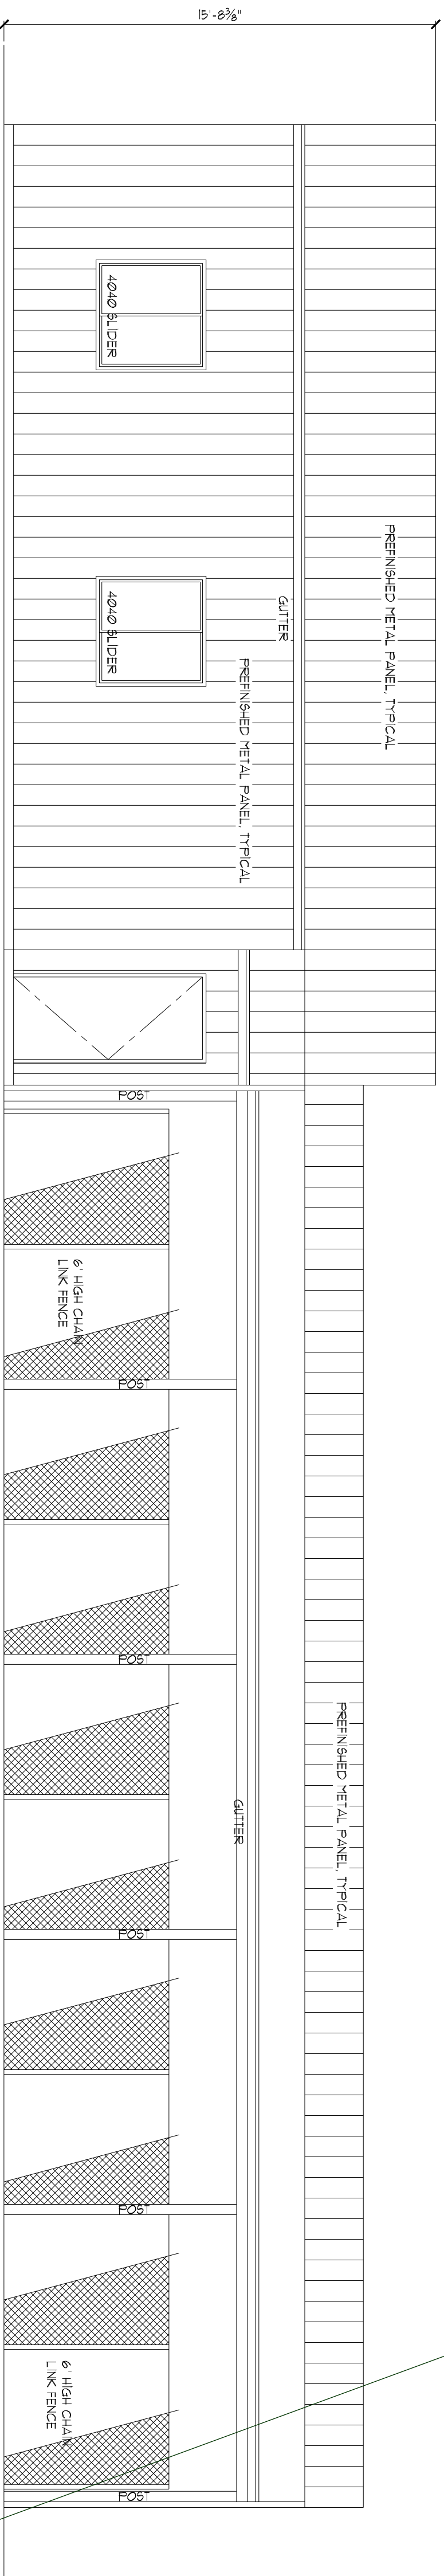

REAR ELEVATION
SCALE 1/4"=1'-0"

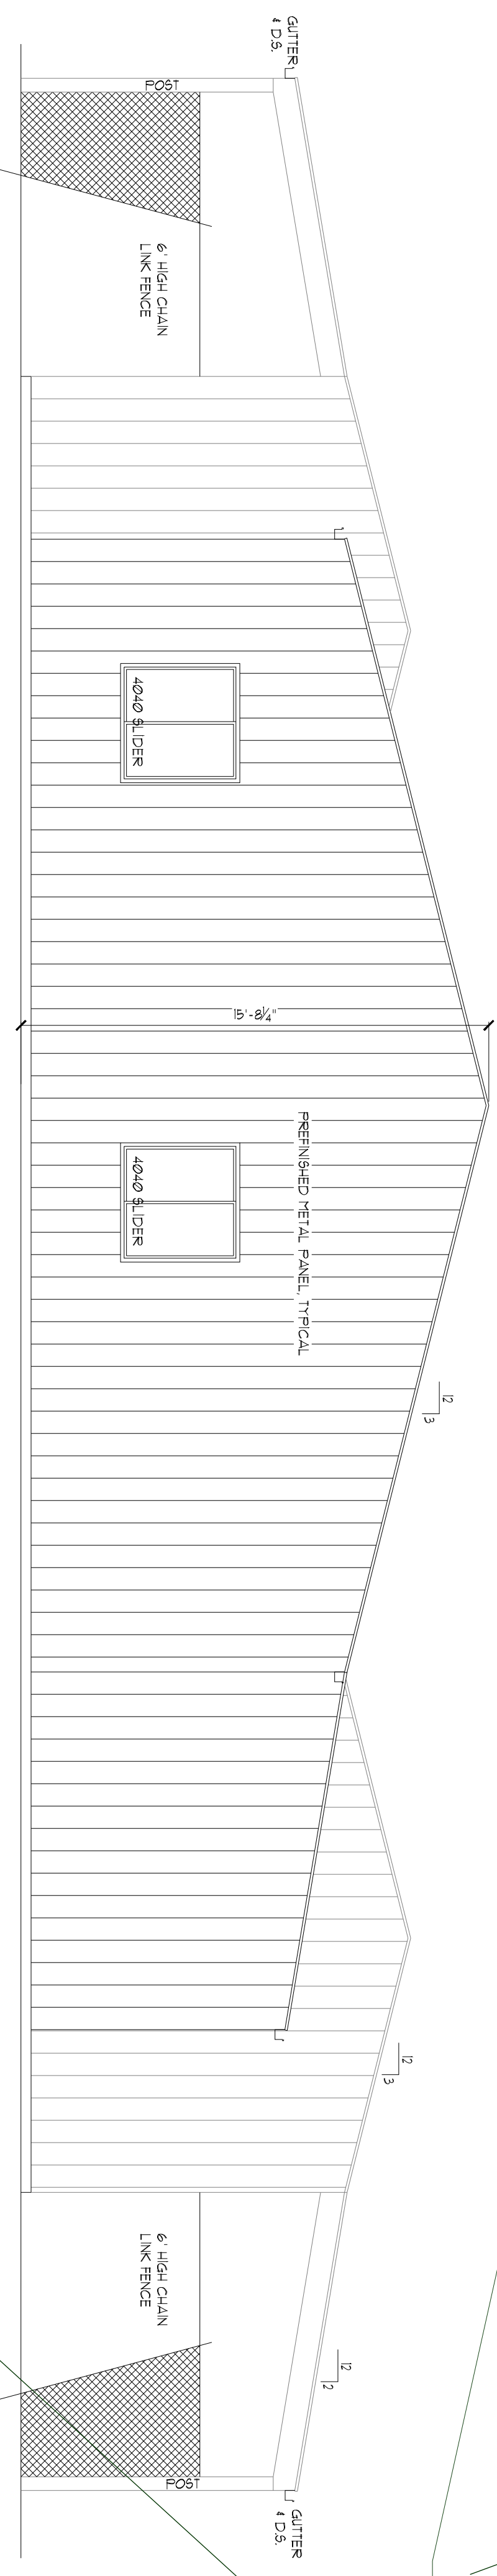

RIGHT ELEVATION
SCALE 1/4"=1'-0"

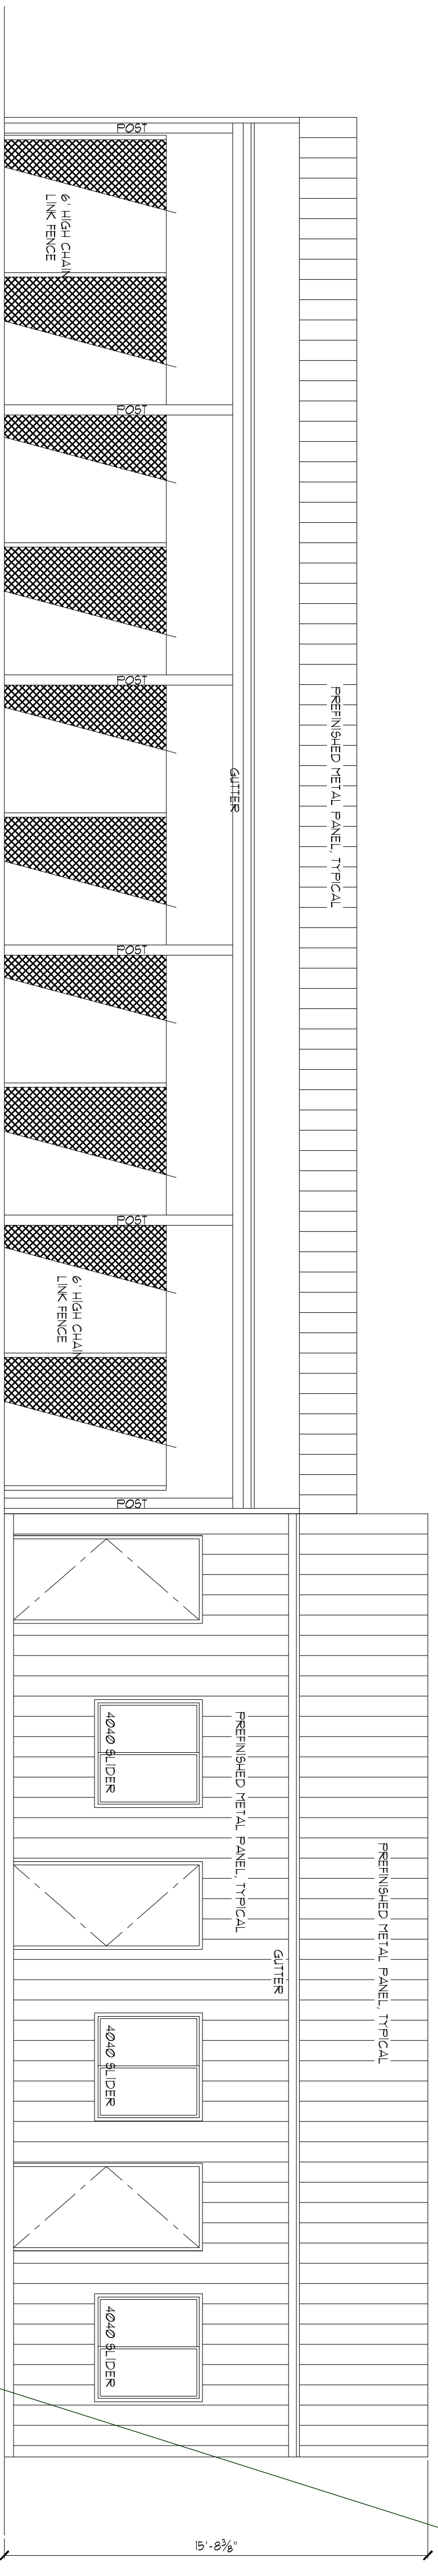

FRONT ELEVATION
SCALE 1/4"=1'-0"

Mark these as
North, South,
East, and
West.

RJM Designs
Robert J. Maixner, Architect
89 Wedgfield Drive, Hilton Head Island, SC 29926
(719) 660-6183 maxarctec@aol.com

Kramer Construction, Inc.
5030 Silver Drive, Colorado Springs, CO 80921
phone 719-243-4188
Guttenberg Kennel
14094 E Us Highway 24, Peyton, CO 80831



11 / 03 / 2011
SQUARE FOOTAGE
Office Area 14,055
Kramer Area 16,935
Tot Area 30,990


INDEX
50 Site Plan
A1 Floor Plan
A2 Excavation
A3 Structure Signs

DESIGN RJM
CHECK RJM
DATE 08 / 23 / 2011
JOB NO. 11-136
SHEET NO.

A-2


Markup Summary

1 (4)

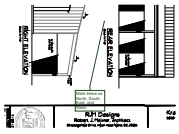


Subject: Callout
Page Label: 1
Lock: Locked
Status:
Checkmark: Unchecked
Author: dsdkendall
Date: 12/18/2017 1:00:35 PM
Color: ■
Layer:
Space:


Mark these as North, South, East, and West.

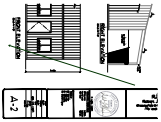

Subject: Arrow
Page Label: 1
Lock: Locked
Status:
Checkmark: Unchecked
Author: dsdkendall
Date: 12/18/2017 1:00:38 PM
Color: ■
Layer:
Space:

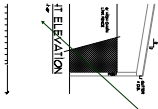

Subject: Arrow
Page Label: 1
Lock: Locked
Status:
Checkmark: Unchecked
Author: dsdkendall
Date: 12/18/2017 1:00:38 PM
Color: ■
Layer:
Space:

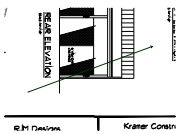

Subject: Arrow
Page Label: 1
Lock: Locked
Status:
Checkmark: Unchecked
Author: dsdkendall
Date: 12/18/2017 1:00:36 PM
Color: ■
Layer:
Space: