


PLOT PLAN DRAWING

PROJECT NAME: 5930 Pacina Ct.
 SUBMITTAL DATE: 5/10/2018
 SUBMITTED BY: A Martin
 SUBMITTAL REVIEWED BY: _____

Needs Screening

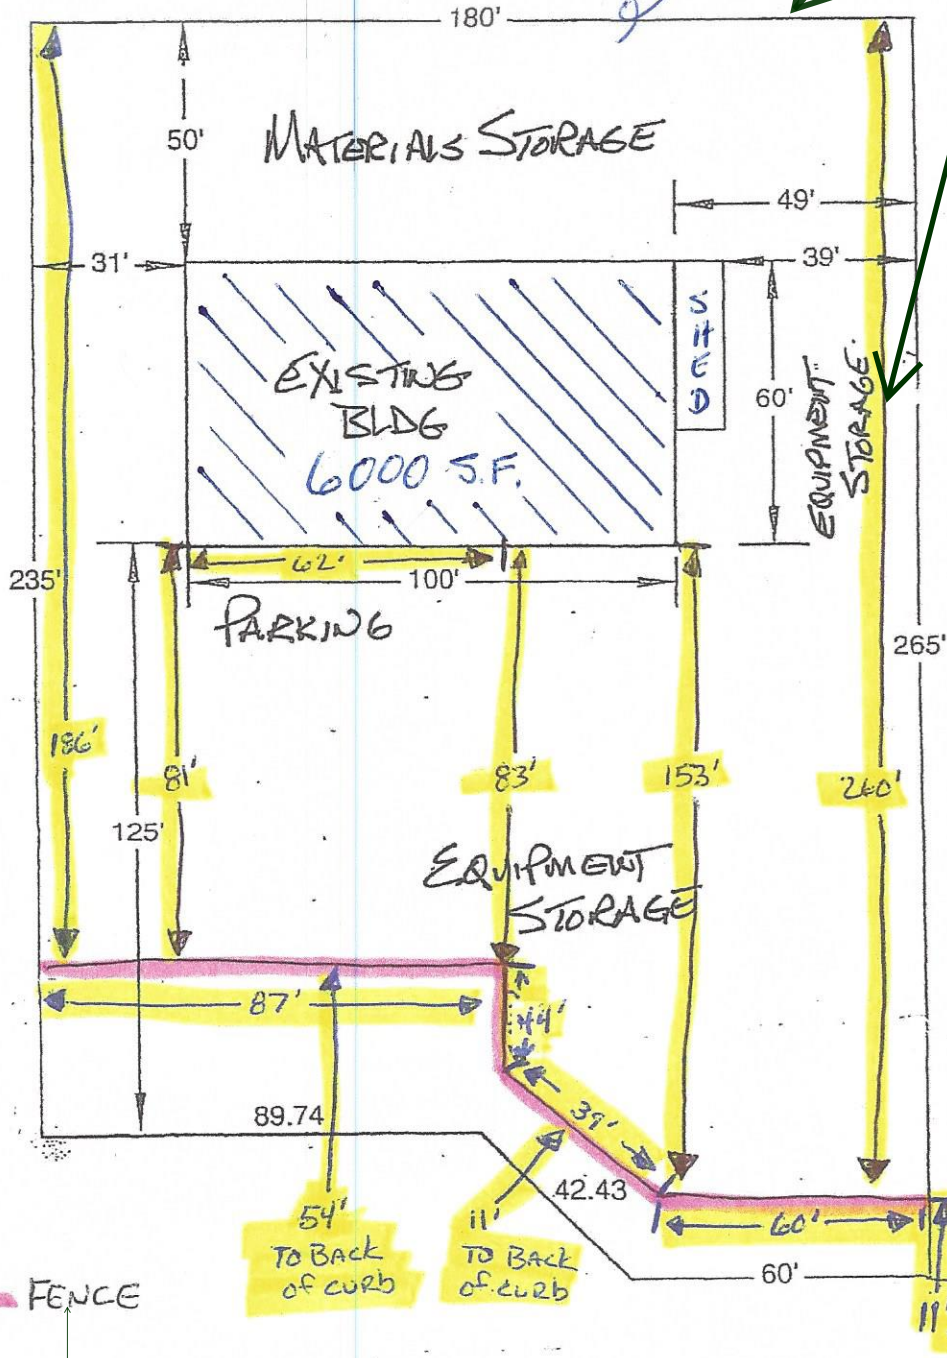


Show easements.
 Outdoor storage must be screened 100% either by 6' fence, wall, or landscaping.
 Outdoor storage not to exceed height of screening, if it does it is to be placed in the rear 1/3 of the property. (Land Development Code 5.2.38 - Outside Storage)

How tall is the fence?


Markup Summary

dsdkendall (4)

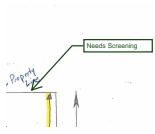


Subject: Callout
Page Label: 1
Author: dsdkendall
Date: 6/29/2018 2:00:39 PM
Color: ■

Needs Screening

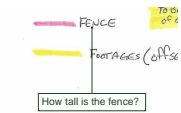


Subject: Callout
Page Label: 1
Author: dsdkendall
Date: 6/29/2018 2:04:39 PM
Color: ■

How tall is the fence?

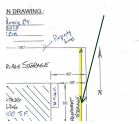

Subject: Arrow
Page Label: 1
Author: dsdkendall
Date: 6/29/2018 2:04:42 PM
Color: ■

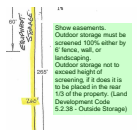

Subject: Text Box
Page Label: 1
Author: dsdkendall
Date: 6/29/2018 2:04:47 PM
Color: ■

Show easements.
Outdoor storage must be screened 100% either by 6' fence, wall, or landscaping.
Outdoor storage not to exceed height of screening, if it does it is to be placed in the rear 1/3 of the property. (Land Development Code 5.2.38 - Outside Storage)