


SCHOLZ / ORCUTT:

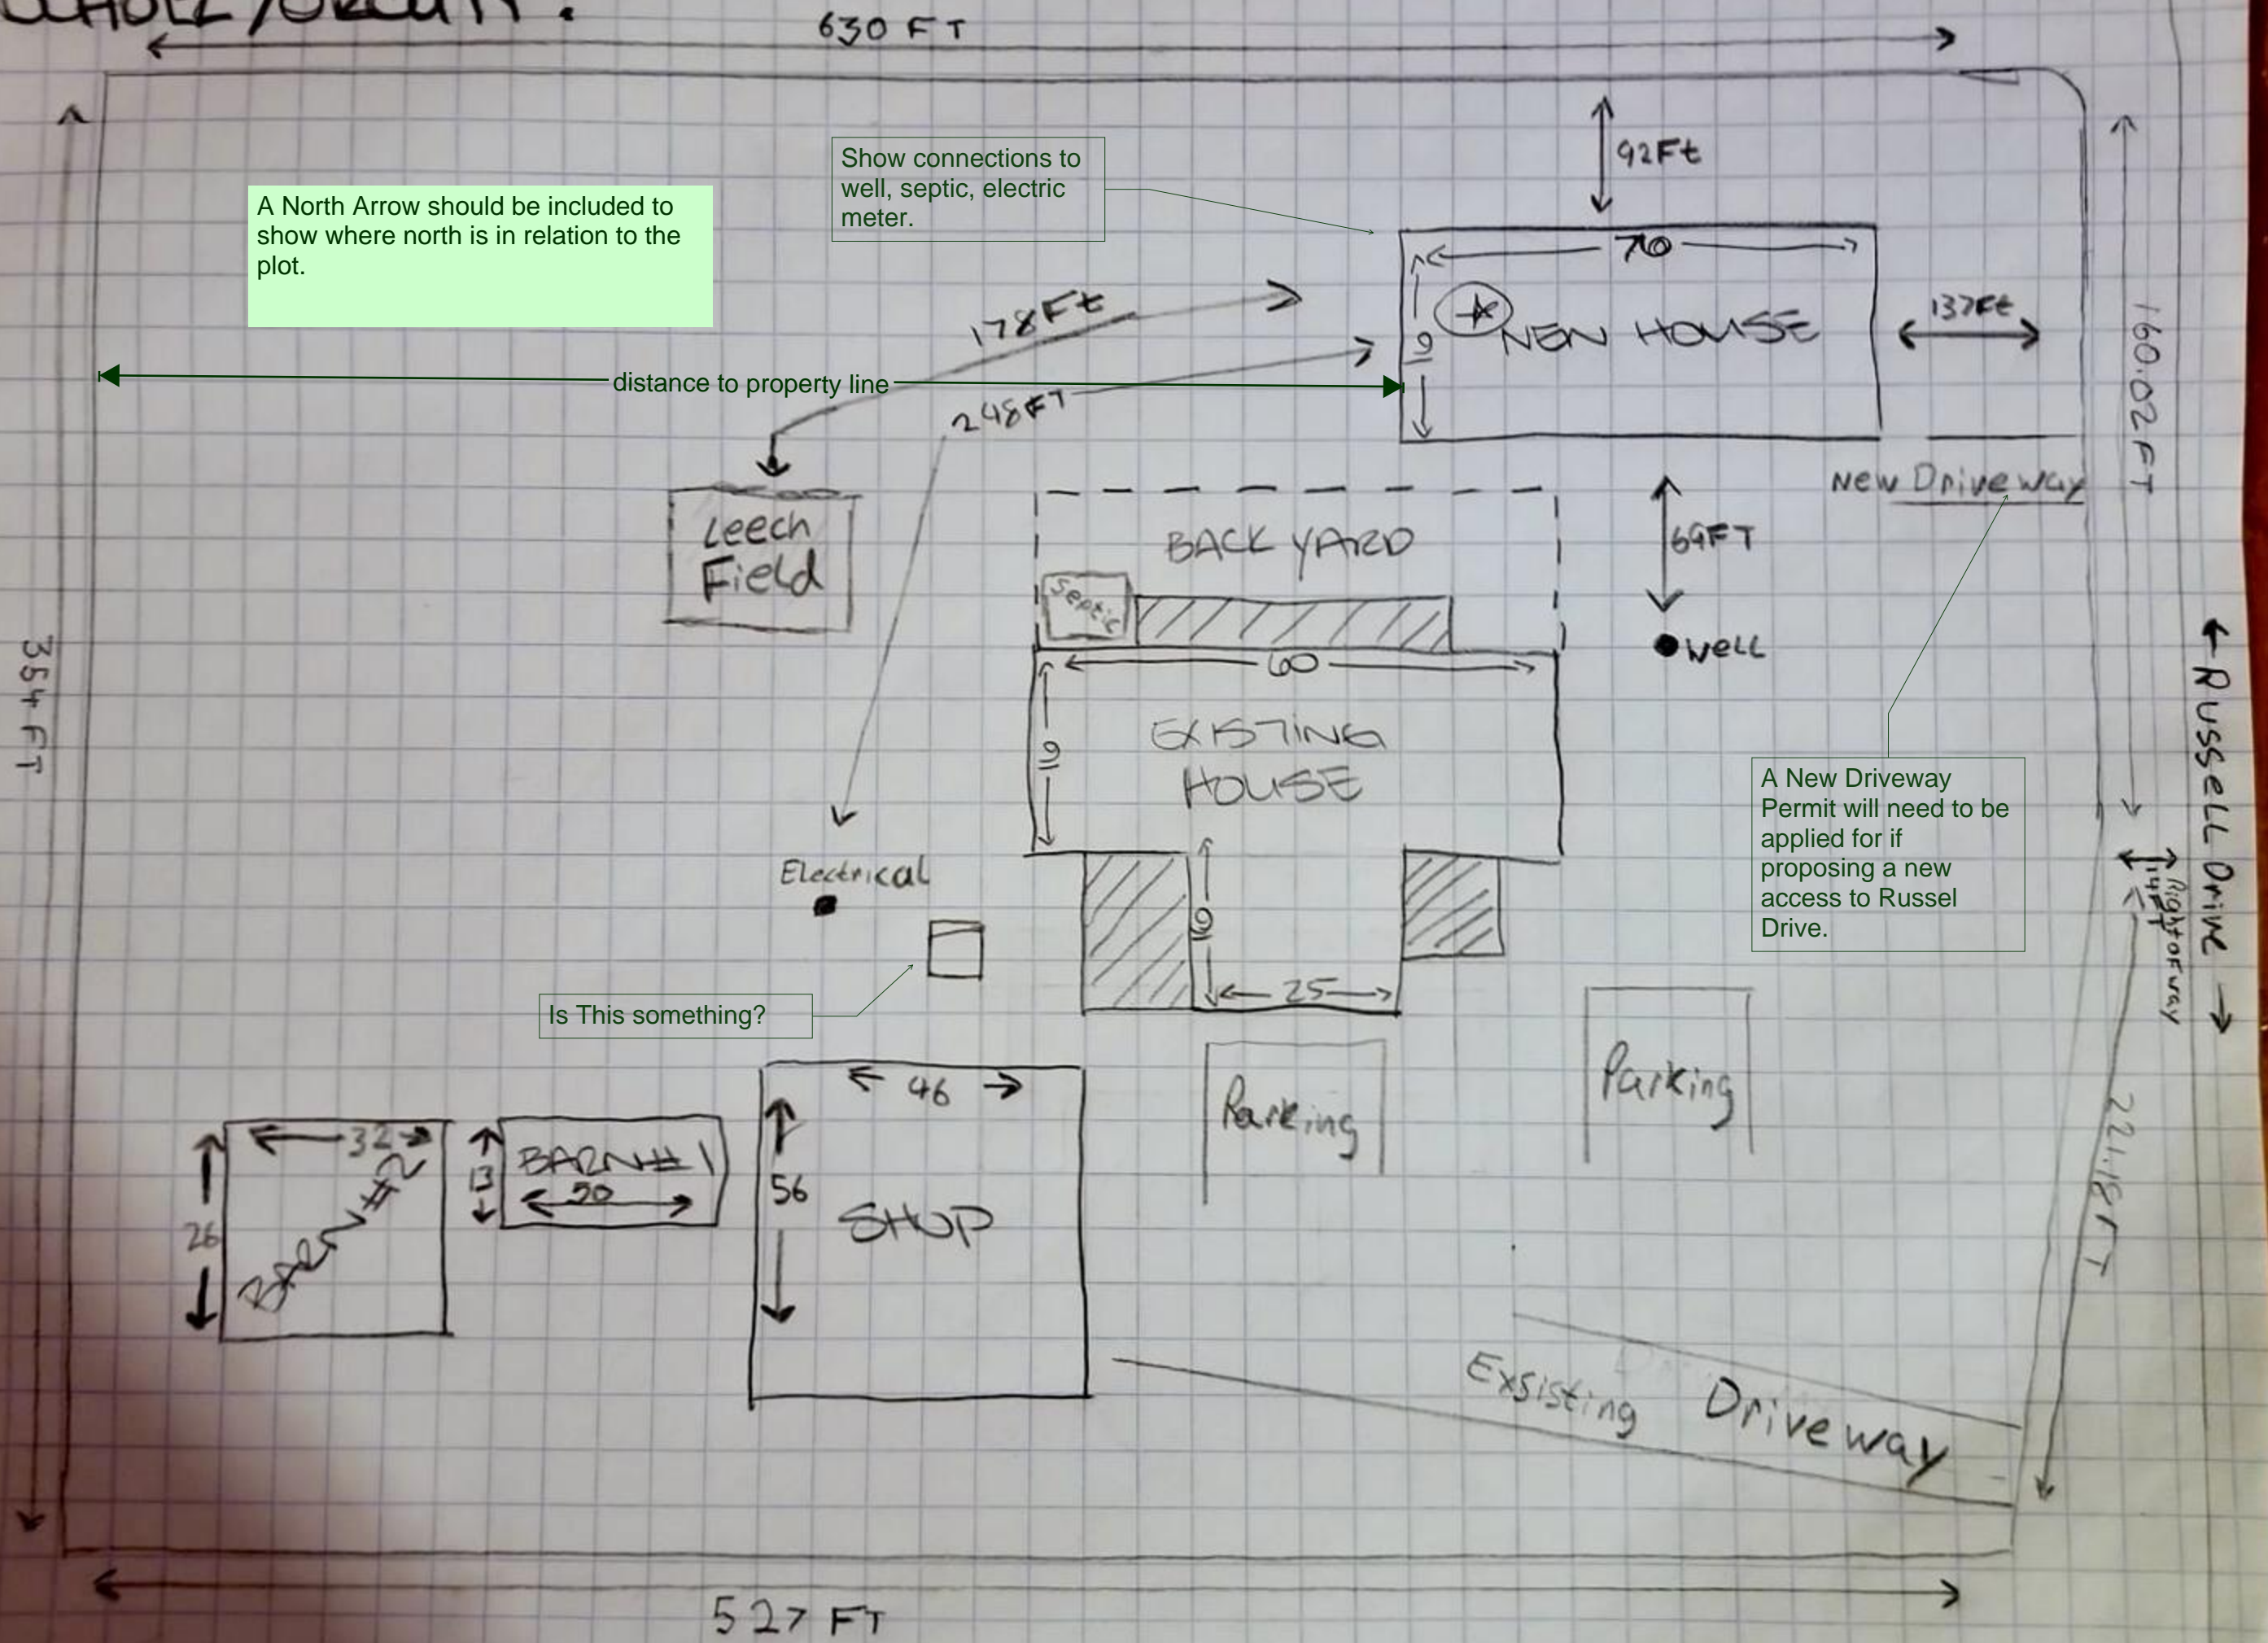

A North Arrow should be included to show where north is in relation to the plot.

Show connections to well, septic, electric meter.

Is This something?


A New Driveway Permit will need to be applied for if proposing a new access to Russel Drive.

Right of way
14 FT

RUSSELL DRIVE

Markup Summary

1 (5)

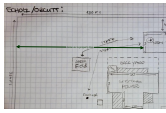

Subject: Dimension

Page Label: 1

Lock: Locked

Status:

Checkmark: Unchecked

Author: dsdkendall


Date: 11/2/2017 4:14:19 PM

Color: ■

Layer:

Space:

distance to property line

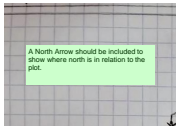

Subject: Text Box

Page Label: 1

Lock: Locked

Status:

Checkmark: Unchecked

Author: dsdkendall


Date: 11/2/2017 4:14:17 PM

Color: ■

Layer:

Space:

A North Arrow should be included to show where north is in relation to the plot.

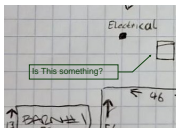

Subject: Callout

Page Label: 1

Lock: Locked

Status:

Checkmark: Unchecked

Author: dsdkendall


Date: 11/2/2017 4:14:20 PM

Color: ■

Layer:

Space:

Is This something?

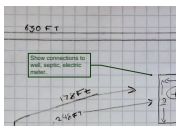

Subject: Callout

Page Label: 1

Lock: Locked

Status:

Checkmark: Unchecked

Author: dsdkendall


Date: 11/2/2017 4:14:18 PM

Color: ■

Layer:

Space:

Show connections to well, septic, electric meter.

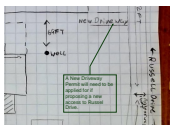

Subject: Callout

Page Label: 1

Lock: Locked

Status:

Checkmark: Unchecked

Author: dsdkendall

Date: 11/2/2017 4:14:17 PM

Color: ■

Layer:

Space:

A New Driveway Permit will need to be applied for if proposing a new access to Russel Drive.