


MOUNTAIN'S EDGE

THE NORTH HALF OF THE NORTH HALF
OF THE SOUTHWEST QUARTER OF SECTION 13, TOWNSHIP 12 SOUTH,
RANGE 63 WEST OF THE 6TH P.M., EL PASO COUNTY, COLORADO

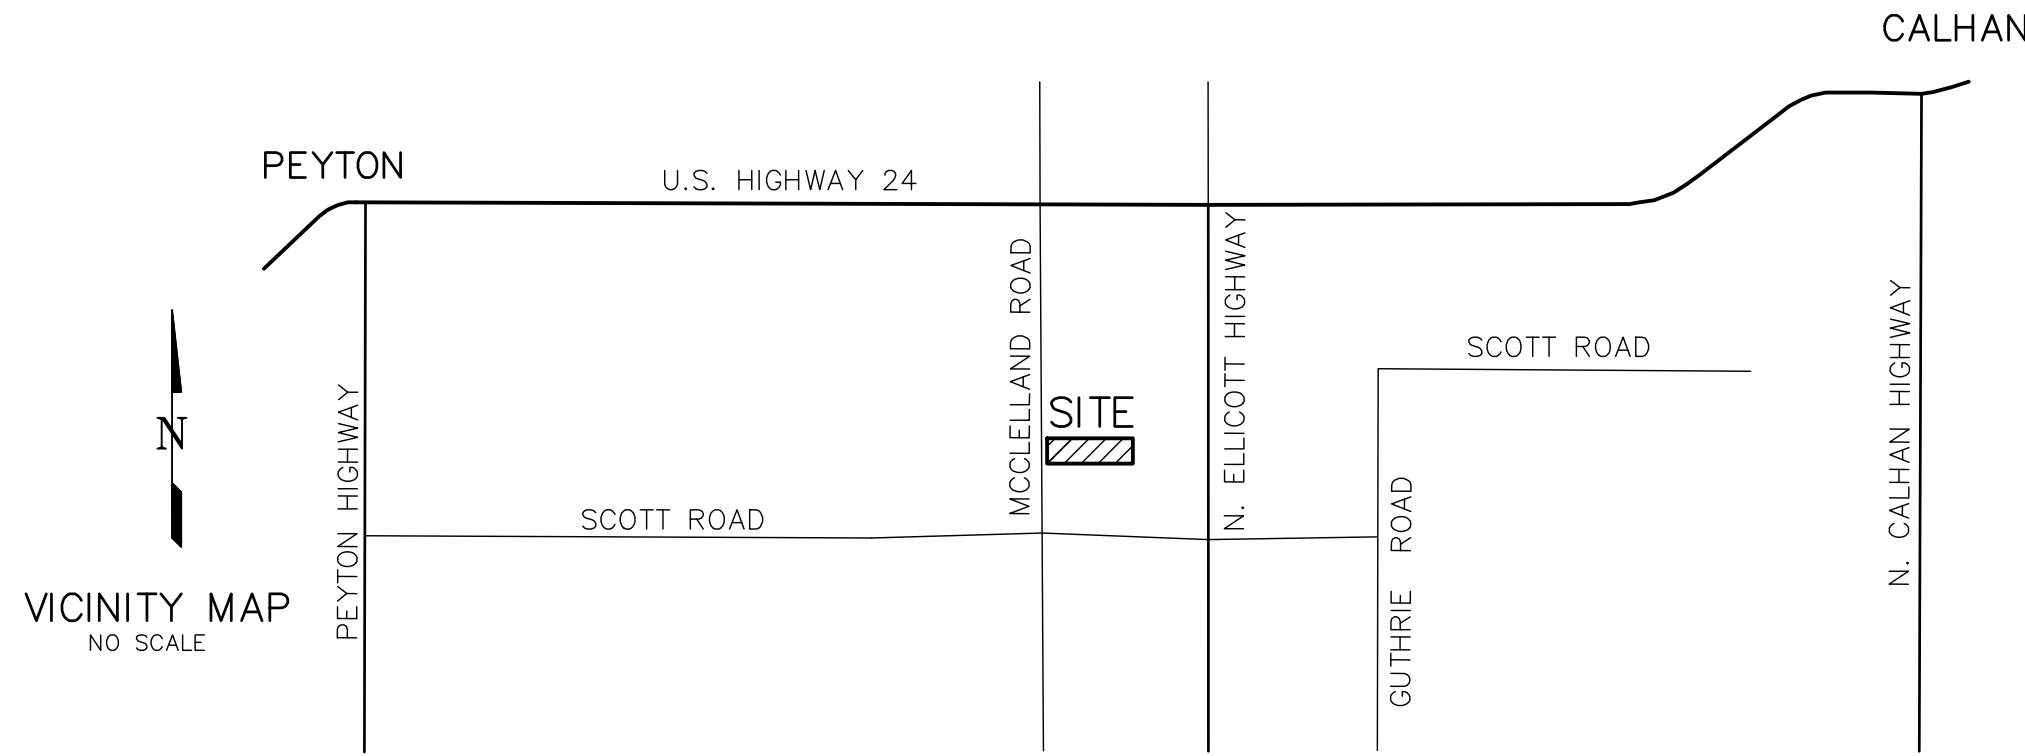

VICINITY MAP
NO SCALE

KNOW ALL MEN BY THESE PRESENTS:

That OGC RE2, LLC, a Colorado Limited Liability Company, being the owner of the following described tract of land to wit:

The North Half of the North Half of the Southwest Quarter (N1/2 N1/2 SW1/4) of Section 13, Township 12 South, Range 63 West of the 6th P.M., situate in El Paso County, Colorado, more particularly described as follows:

Beginning at the West Quarter Corner of said Section 13; thence S87°49'24"E along the North line of said N1/2 N1/2 SW1/4, 2602.49 feet to the Center Quarter Corner of said Section 13; thence S00°14'40"E along the East line of said N1/2 N1/2 SW1/4, 657.32 feet to the Southeast corner of said N1/2 N1/2 SW1/4; thence N87°48'59"W along the South line of said N1/2 N1/2 SW1/4, 2602.30 feet to the Southwest corner of said N1/2 N1/2 SW1/4; thence N00°15'44"W along the West line of said N1/2 N1/2 SW1/4, 657.01 feet to the Point of Beginning;

Containing 39.225 acres, more or less.

OWNER CERTIFICATION:

The undersigned, being all the owners, mortgagees, beneficiaries of deeds of trust and holders of other interests in the land described herein, have laid out, subdivided, and platted said lands into lots, road rights-of-way and easements as shown hereon under the name and subdivision of MOUNTAIN'S EDGE. The road rights-of-way are hereby dedicated to El Paso County for public use. All public improvements easements so platted are hereby dedicated to public use and said owner does hereby covenant and agree that the public improvements will be constructed to El Paso County standards and that proper drainage and erosion control for same will be provided at said owner's expense, all to the satisfaction of the Board of County Commissioners of El Paso County, Colorado. Upon acceptance by resolution, all public improvements so constructed will become matters of maintenance by El Paso County, Colorado. The utility easements shown hereon are hereby dedicated for public utilities and communication systems and other purposes as shown hereon. The entities responsible for providing the services for which the easements are established are hereby granted the perpetual right to use said easements for ingress and egress from and to adjacent properties for installation, maintenance, and replacement of utility lines and related facilities.

IN WITNESS WHEREOF:

The aforementioned, OGC RE2, LLC, a Colorado Limited Liability Company, has executed this instrument this ____ day of _____, 20____A.D.

OGC RE2, LLC, a Colorado Limited Liability Company

By: _____
_____, Manager

NOTARIAL:

STATE OF _____ }
COUNTY OF _____ } SS

Acknowledged before me this ____ day of _____, 20____ A.D.,

by _____, Manager of OGC RE2, LLC, a Colorado Limited Liability Company.

Witness my hand and seal _____

My commission expires _____

FEES:

Park Fee: _____ Drainage Fee: _____

School Fee: _____ Bridge Fee: _____

NOTES:

- This survey does not constitute a title search by LDC, Inc. to determine ownership or easements of record. For all information regarding easements, rights-of-way and title of record, LDC, Inc. relied upon a Commitment for Title Insurance, prepared by FIRST AMERICAN TITLE INSURANCE COMPANY, Policy No. T0065914 dated May 27, 2009 at 5:30 p.m.
- Basis of Bearings: All bearings are based upon the North line of the Southwest One-Quarter of Section 13, Township 12 South, Range 63 West of the 6th P.M., monumented as shown and assumed to bear S87°49'24"E, a distance of 2602.49 feet.
- Unless otherwise indicated, all side, front and rear lot lines are hereby platted on either side with a 10 foot public utility and drainage easement unless otherwise indicated. All exterior subdivision boundaries are hereby platted with a 20 foot public utility and drainage easement. The sole responsibility for maintenance of these easements is hereby vested with the individual property owners.
- Sewage treatment is the responsibility of each individual property owner. The El Paso County Department of Health and Environment must approve each system and, in some cases, the Department may require an engineer designed system prior to permit approval. These systems may cost more to design, install, and maintain.
- Individual wells are the responsibility of each property owner. Permits for individual wells must be obtained from the State Engineer who by law has the authority to set conditions for the issuance of these permits.

Water in the Denver Basin Aquifers is allocated based on a 100-year aquifer life; however, for El Paso County planning purposes, water in the Denver Basin Aquifer is evaluated based on a 300-year aquifer life. Applicants, the Home Owners Association and all future owners in the subdivision, should be aware that the economic life of a water supply based on wells in a given Denver Basin Aquifer may be less than either the 100 years or 300 years indicated due to anticipated water level declines. Furthermore, the water supply plan should not rely solely upon non-renewable aquifers. Alternative renewable water resources should be acquired and incorporated in a permanent water supply plan that provides future generations with a water supply.

- Geologic Hazard Note-Final Plat:** The following lots have been found to be impacted by geologic hazards. Mitigation measures and a map of the hazard area can be found in the report "Geology and Soils Report, Mountains Edge Development, El Paso County, Colorado" by Kumar & Associates, Inc. dated November 14, 2008 in file SP-10-002 available at the El Paso County **Development Services Department**:
 - Flooding, Bank Erosion and Sedimentation: Portions of Lots 2, 3, 4 and 5.
 - Accelerated Erosion: Portions of Lots 3, 4 and 5.
 - Potentially Seasonally Shallow Groundwater: Portions of Lots 2, 3, 4 and 5.
 - Man Made Fill: Portions of Lots 4 and 5.
 - Shallow Bedrock: More prevalent on Lot 1 and the west portion of Lot 2.

Due to the potential for shallow groundwater in the area, all below grade construction such as basements and crawl spaces should be provided with an underdrain system. Requirements for a foundation underdrain system should be determined based on site-specific geotechnical engineering studies performed for the individual structures once the building location has been selected.

- The following reports have been submitted in association with the Preliminary Plan or Final Plat for this subdivision and are on file at the County **Development Services Department** (SF-10-002): Transportation Impact Letter; Drainage Report; Water Resources Report; Wastewater Disposal Report; Geology and Soils Report; Fire Protection Report; Natural Features Report.
- All property owners are responsible for maintaining proper storm water drainage in and through their property. Public drainage easements as specifically noted on the plat shall be maintained by the individual lot owners unless otherwise indicated. Structures, fences, materials or landscaping that could impede the flow of runoff shall not be placed in drainage easements.
- There shall be no direct lot access to McClelland Road.
- Individual lot purchasers are responsible for constructing driveways, including necessary drainage culverts from Farmhouse Court per Land Development Code Section 6.3.3.C.2 and 6.3.3.C.3. Due to their length, some of the driveways will need to be specifically approved by the Peyton Fire Protection District.
- Developer shall comply with federal and state laws, regulations, ordinances, review and permit requirements, and other agency requirements, if any, of applicable agencies including, but not limited to, the Colorado Division of Wildlife, Colorado Department of Transportation, U.S. Army Corps of Engineers and the U.S. Fish and Wildlife Service regarding the Endangered Species Act, particularly as it relates to the listed species.
- (19339) - Indicates property address. The addresses exhibited on this plat are for informational purposes only. They are not the legal description and are subject to change.
- No driveway shall be established unless an access permit has been granted by El Paso County.
- Mailboxes shall be installed in accordance with all El Paso County and United States Postal Service regulations.
- No structures are permitted within designated "No-Build" AREA(S).

A portion of this property (as shown hereon) is located within a designated FEMA Floodplain as determined by the Flood Insurance Rate Map, Community Map Number 08041C0375 F, effective date March 17, 1997. No structures are permitted within the designated Floodplain areas.

SURVEYOR'S CERTIFICATION:

I Daniel L. Kupferer, a duly registered Professional Land Surveyor in the State of Colorado, do hereby certify that this plat truly and correctly represents the results of a survey made on July 21, 2008 by me or under my direct supervision and that all monuments exist as shown hereon; that mathematical closure errors are less than 1:10,000; and that said plat has been prepared in full compliance with all applicable laws of the State of Colorado dealing with monuments, subdivision, or surveying of land and all applicable provisions of the El Paso County Land Development Code.

I attest the above on this ____ day of _____, 20____.

Daniel L. Kupferer
Colorado Professional Land Surveyor No. 18465
For and on behalf of LDC, Inc

Add the following note:
The subdividers agree on behalf of him/herself and any developer or builder successors and assigns shall be required to pay traffic impact fees in accordance with the countywide transportation improvement fee resolution (Resolution 16-454), as amended, at or prior to the time of building permit submittals. The Fee obligation, if not paid at final plat recording, shall be documented on all sales documents and on plat notes to ensure that a title search would find the fee obligation before sale of the property.

Add a note identifying how the road impact fee will be paid: PID1, PID2, or pay the road impact fee in full, include the following note: The fee is based on the established rate at the time of building department application.

NOTES(continued):

- At the time of approval of this project, this property is located within the Peyton Fire Protection District, which has adopted codes requiring fire mitigation requirements depending upon the level of fire risk associated with the property and structures.

The Developer and all future owners agree to Sprinkler all new homes in accordance with NFPA 13D

All cost and maintenance thereof will be the responsibility of the owner thereafter

- Notice: According to Colorado law you must commence any legal action based upon any defect in this survey within three years after you first discover such defect. In no event may any action based upon any defect in this survey be commenced more than ten years from the date of the certification shown hereon.
- A design-level subsurface geotechnical investigation should be conducted at each building site prior to building. Foundation and septic designs may require mitigation based on the findings of this investigation.
- A site-specific investigation should be conducted prior to building to determine design criteria, including depth to seasonal groundwater and percolation rates. Engineered septic systems may be required for some lots.
- Seasonally shallow groundwater may be present in area of this site. Appropriate subsurface drainage should be established for utility lines and subsurface construction expected within 5 feet of the seasonally high groundwater table.
- No lot or interest therein, shall be sold, conveyed, or transferred whether by deed or by contract, nor shall building permits be issued, until and unless either the required public and common development improvements have been constructed and completed and preliminarily accepted in accordance with the Subdivision Improvements Agreement between the applicant/owner and El Paso County as recorded under Reception Number _____ in the Office of the Clerk and Recorder of El Paso County, Colorado, or, in the alternative, other collateral is provided to make provision for the completion of said improvements in accordance with the El Paso County Land Development Code and Engineering Criteria Manual. Any such alternative collateral must be approved by the Board of County Commissioners or, if permitted by the Subdivision Improvements Agreement, by the Development Services Department Director and meet the policy and procedure requirements of El Paso County prior to the release by the County of any lots for sale, conveyance or transfer. This plat restriction may be removed or rescinded by the Board of County Commissioners or, if permitted by the Subdivision Improvements Agreement, by the **Development Services Department** Director upon either approval of an alternative form of collateral or completion and preliminary acceptance by the El Paso County Board of County Commissioners of all improvements required to be constructed and completed in accordance with said Subdivision Improvements Agreement. The partial release of lots for sale, conveyance or transfer may only be granted in accordance with any planned partial release of lots authorized by the Subdivision Improvements Agreement.
- Water wells will be supplied from the Arapahoe Aquifer, and must be constructed with the Determination of Water Rights No., 1484-BD. Each well owner shall submit annual diversion records to the UBS District.
- Well spacing within the subdivision must comply with UBS District rule/regulation 14.
- The existing Denver Aquifer well will be abandoned, and the UBS District copied on the abandonment report.
- Onsite Wastewater Systems (OWS)/Individual septic systems shall be designed and utilized consisting of membrane and evaporative drain field technology as required by the Upper Black Squirrel Groundwater Management District, constructed with an impermeable liner to prevent sewage effluent from entering underlying soils and groundwater. Evapotranspiration fields shall be located in an area of unobstructed sunshine. Monitoring and maintenance of OWS must be per manufacturer/designer recommendation, with records submitted to the UBS District.
- Additional chemical analysis shall be required at time of individual well drilling meeting all EPCHS standards.

APPROVALS:

This plat for MOUNTAIN'S EDGE was approved for filing by the El Paso County, Colorado **Development Services Department** Director on the _____ day of _____, 20____ subject to any notes or conditions specified hereon.

Development Services Director

BOARD OF COUNTY COMMISSIONERS CERTIFICATE:

This plat of MOUNTAIN'S EDGE was approved for filing by the El Paso County, Colorado Board of County Commissioners on the ____ day of _____, 20____, subject to any notes specified hereon and any conditions included in the resolution of approval. The dedications of land to the public for streets and easements are accepted, but the public improvements thereon will not become the maintenance responsibility of El Paso County until preliminary acceptance of the public improvements in accordance with the requirements of the Land Development Code and Engineering Criteria Manual, and the Subdivision Improvements Agreement.

Chair, Board of County Commissioners

Date

RECORDING:

STATE OF COLORADO }
COUNTY OF EL PASO } SS


I hereby certify that this instrument was filed in my office on this ____ day of _____, 20____

and was recorded at Reception Number _____ of the records of El Paso County

El Paso County Clerk and Recorder


See MDT letter for current signature block required

Add PCD File No. SF-1826

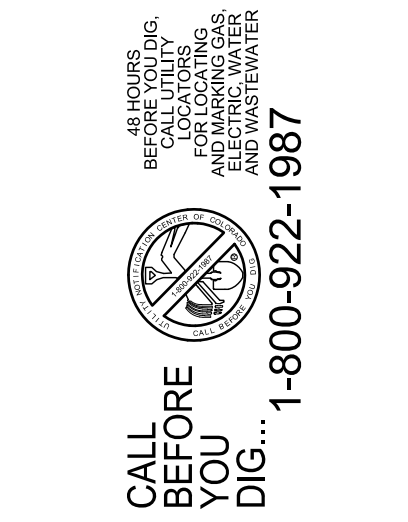

By	Date	Description
RDG	06/24/10	COUNTY COMMENTS
RDG	08/03/10	COUNTY COMMENTS
JAR	08/26/10	COUNTY COMMENTS
DLK	08/29/10	COUNTY COMMENTS NOTE REVISIONS
DLK	07/31/18	REVISED OWNER'S NAME

H Scale: 1" = 100'
V Scale: N/A
Designed By: N/A
Drawn By: KLWIRDG
Checked By:
Date: 01/09/09

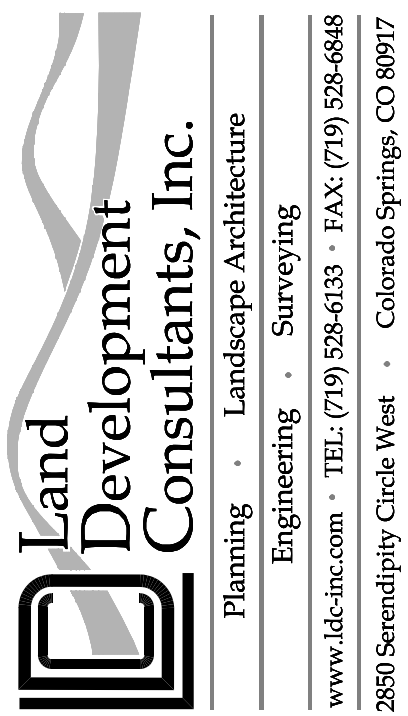


FINAL PLAT
MOUNTAIN'S EDGE

Project No.: 08019

Sheet: 1 of 2

MOUNTAIN'S EDGE

THE NORTH HALF OF THE NORTH HALF
OF THE SOUTHWEST QUARTER OF SECTION 13, TOWNSHIP 12 SOUTH,
RANGE 63 WEST OF THE 6TH P.M., EL PASO COUNTY, COLORADO

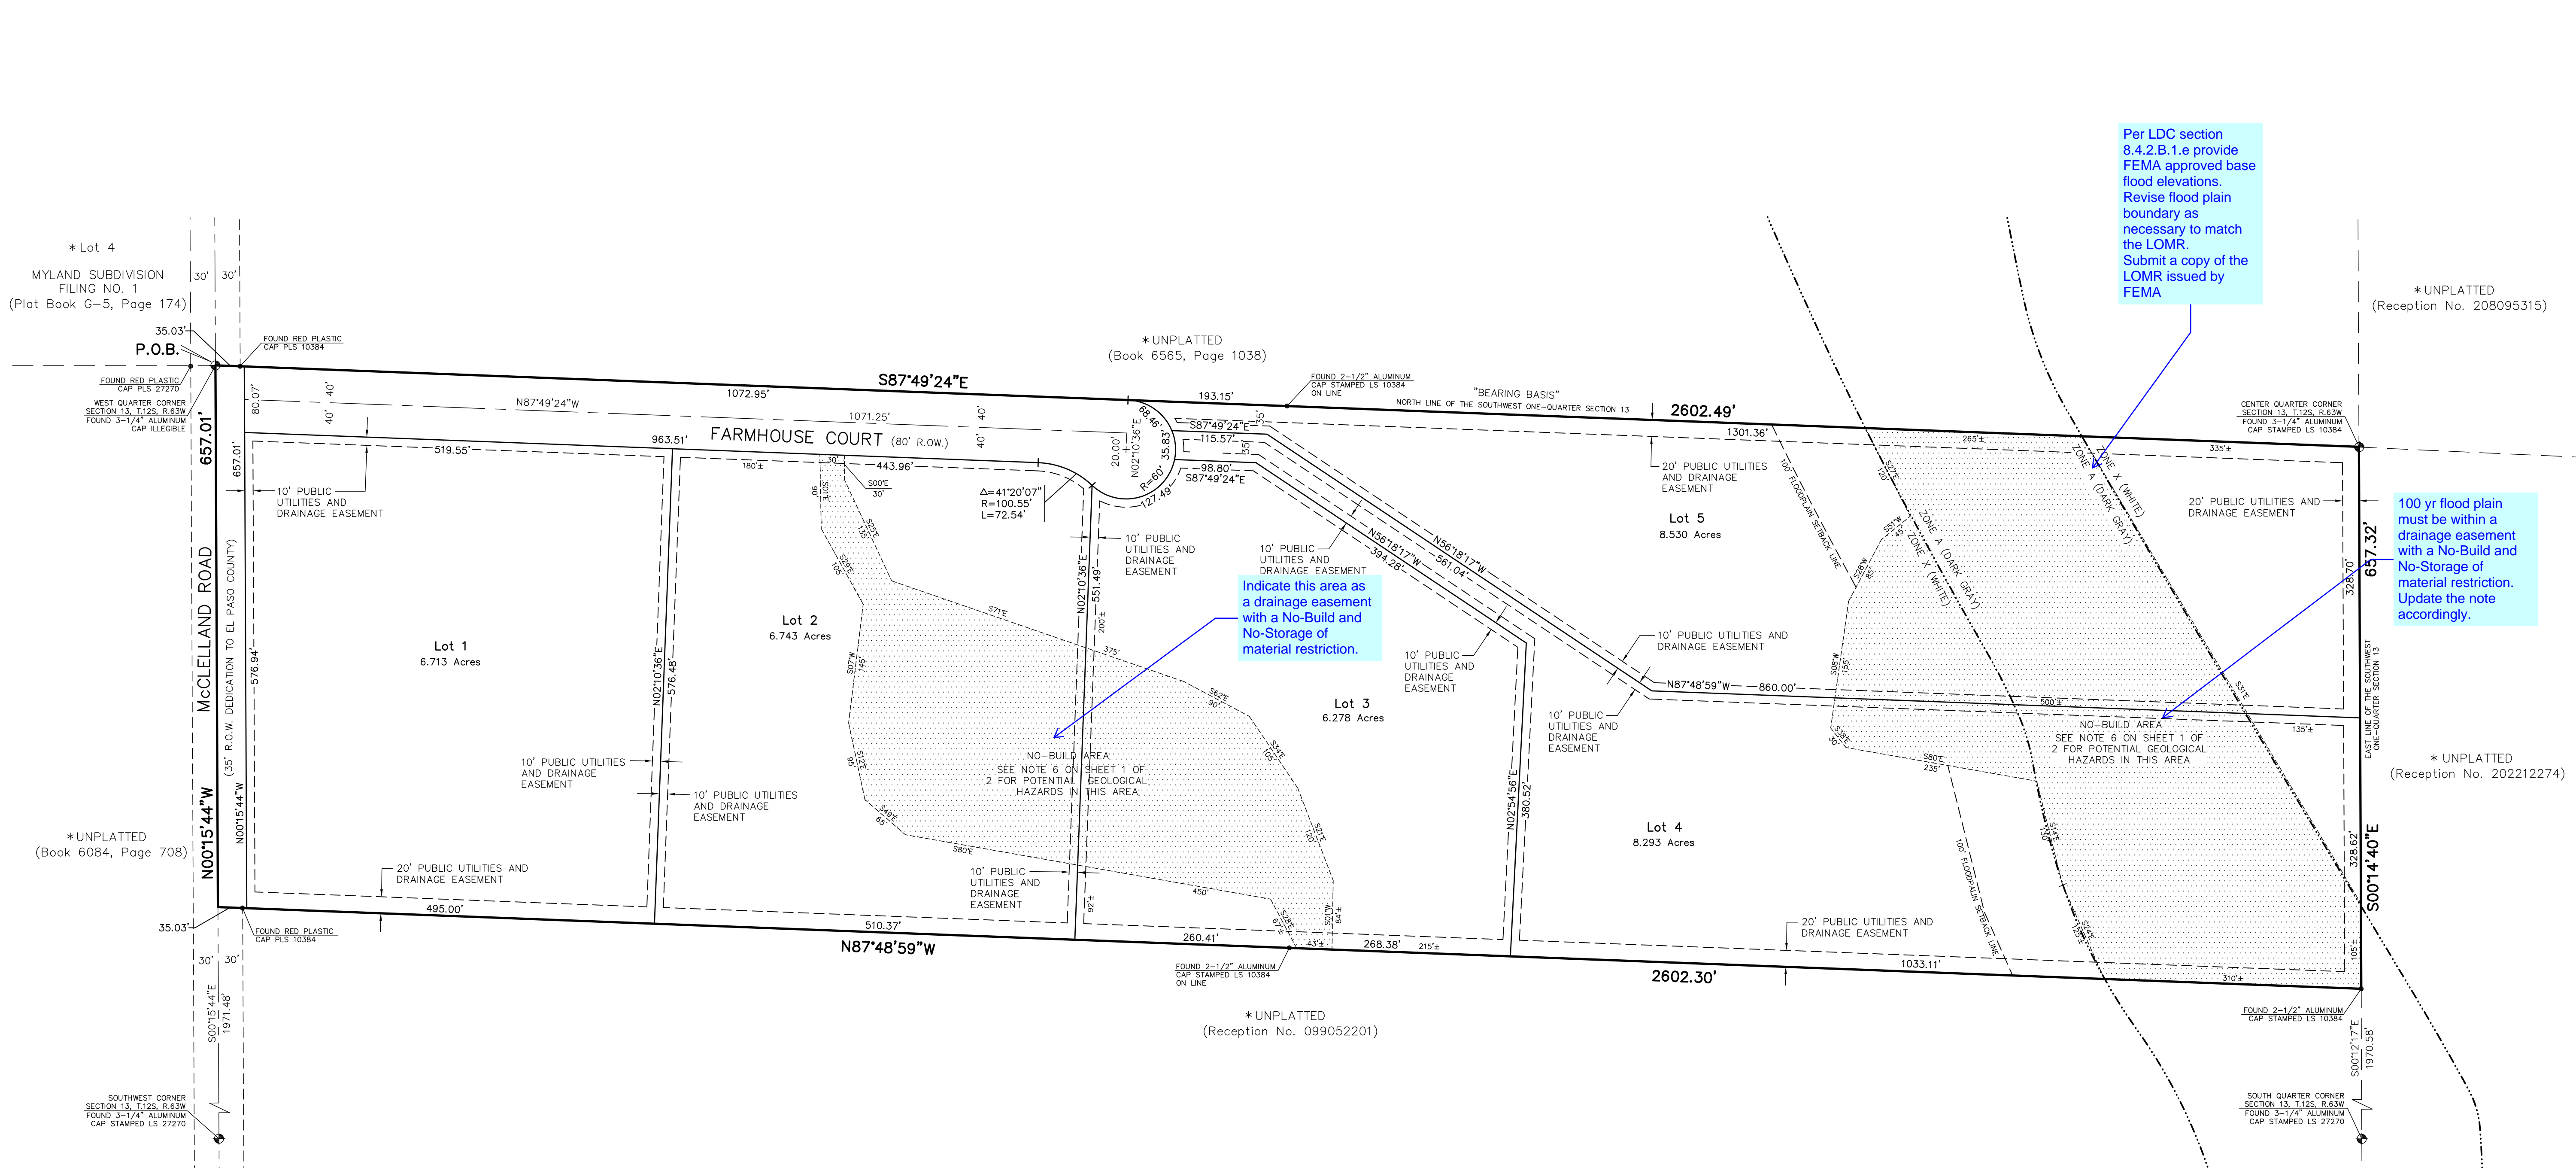


Per LDC section 8.4.2.B.1.e provide FEMA approved base flood elevations. Revise flood plain boundary as necessary to match the LOMR. Submit a copy of the LOMR issued by FEMA

Indicate this area as a drainage easement with a No-Build and No-Storage of material restriction.

100 yr flood plain must be within a drainage easement with a No-Build and No-Storage of material restriction. Update the note accordingly.

- LEGEND:**
- - Indicates survey monument set with a #4 rebar with Surveyor's Cap, PLS #20681.
 - - Indicates recovered survey monument as noted.
 - * - Indicates not a part of this subdivision.
 - - Indicates FEMA flood hazard delineation line
 - ▨ - Indicates NO-BUILD area

NOTE: The designated FEMA Floodplain shown on this plan was determined by FEMA and shown on a Flood Insurance Rate Map (FIRM). The accuracy of the floodplain boundary is based on the FIRM being at a scale of 1" = 2000' overlaid on this plan and aligned on approximate section lines; no base flood elevations determined. Ground conditions may also vary over time which could skew the boundary of the floodplain.

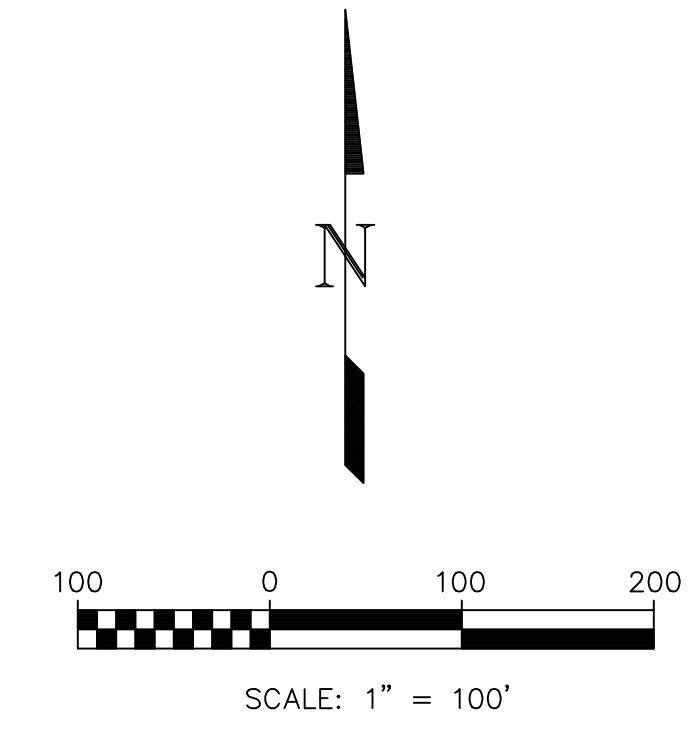

BEFORE ANY EXCAVATION OR CONSTRUCTION OF FOUNDATIONS AND WATERWORKS
CALL BEFORE YOU DIG... 1-800-922-1987

No.	Date	By	Description
1	08/03/10	RJD	COUNTY COMMENTS
2	8/26/10	JAR	COUNTY COMMENTS

H Scale:	1" = 100'
V Scale:	N/A
Designed By:	N/A
Drawn By:	KLWIRRG
Checked By:	DVH
Date:	01/09/09

Land Development Consultants, Inc.

Planning • Landscape Architecture
Engineering • Surveying

www.ldc-inc.com • TEL: (719) 528-6133 • FAX: (719) 528-6988
2850 Severidipity Circle West • Colorado Springs, CO 80917

FINAL PLAT MOUNTAIN'S EDGE

Project No.: 08019
Sheet: 2 of 2

F:\08019\08019-Mountain's Edge\2018 ONEL\08019_P_Ans

Markup Summary

Daniel Torres (15)

non-renewable aquifers, alternative renewable water sources, and a permanent water supply plan that provides for the long-term needs of the community.

6. Hazard, Note-Flood, Flood: The following lots are in flood hazard areas. Mitigation measures and a map of flood hazard areas are provided in the Flood Hazard & Associates, Inc. dated November 14, 2008 County Management Services Department:

- Flooding, Bank Erosion and Sedimentation: Port
- Accidental Erosion: Portions of Lots 3, 4 and 5
- Potentially Seasonally Shallow Groundwater: Port
- Man Made Fill: Portions of Lots 4 and 5
- Shallow Bedrock: More prevalent on Lot 1 and 2

Subject: Highlight
Page Label: 1
Lock: Locked
Author: Daniel Torres
Date: 10/22/2018 8:46:31 AM
Color:

6. Hazard, Note-Flood, Flood: The following lots are in flood hazard areas. Mitigation measures and a map of flood hazard areas are provided in the Flood Hazard & Associates, Inc. dated November 14, 2008 County Management Services Department:

- Flooding, Bank Erosion and Sedimentation: Port
- Accidental Erosion: Portions of Lots 3, 4 and 5
- Potentially Seasonally Shallow Groundwater: Port
- Man Made Fill: Portions of Lots 4 and 5
- Shallow Bedrock: More prevalent on Lot 1 and 2

Subject: Callout
Page Label: 1
Lock: Locked
Author: Daniel Torres
Date: 10/22/2018 8:46:31 AM
Color:

Update any reference from "Development Services Department" to "Planning and Community Development Department".

6. Hazard, Note-Flood, Flood: The following lots are in flood hazard areas. Mitigation measures and a map of flood hazard areas are provided in the Flood Hazard & Associates, Inc. dated November 14, 2008 County Management Services Department:

- Flooding, Bank Erosion and Sedimentation: Port
- Accidental Erosion: Portions of Lots 3, 4 and 5
- Potentially Seasonally Shallow Groundwater: Port
- Man Made Fill: Portions of Lots 4 and 5
- Shallow Bedrock: More prevalent on Lot 1 and 2

Subject: Text Box
Page Label: 1
Lock: Locked
Author: Daniel Torres
Date: 10/22/2018 8:46:37 AM
Color:

Add a note identifying how the road impact fee will be paid: PID1, PID2, or pay the road impact fee in full. include the following note: The fee is based on the established rate at the time of building department application.

6. Hazard, Note-Flood, Flood: The following lots are in flood hazard areas. Mitigation measures and a map of flood hazard areas are provided in the Flood Hazard & Associates, Inc. dated November 14, 2008 County Management Services Department:

- Flooding, Bank Erosion and Sedimentation: Port
- Accidental Erosion: Portions of Lots 3, 4 and 5
- Potentially Seasonally Shallow Groundwater: Port
- Man Made Fill: Portions of Lots 4 and 5
- Shallow Bedrock: More prevalent on Lot 1 and 2

Subject: Highlight
Page Label: 1
Lock: Locked
Author: Daniel Torres
Date: 10/22/2018 8:46:40 AM
Color:

6. Hazard, Note-Flood, Flood: The following lots are in flood hazard areas. Mitigation measures and a map of flood hazard areas are provided in the Flood Hazard & Associates, Inc. dated November 14, 2008 County Management Services Department:

- Flooding, Bank Erosion and Sedimentation: Port
- Accidental Erosion: Portions of Lots 3, 4 and 5
- Potentially Seasonally Shallow Groundwater: Port
- Man Made Fill: Portions of Lots 4 and 5
- Shallow Bedrock: More prevalent on Lot 1 and 2

Subject: Highlight
Page Label: 1
Lock: Locked
Author: Daniel Torres
Date: 10/22/2018 8:46:40 AM
Color:

APPROVALS:
This plan for MOUNTAIN'S
Services Department Direct conditions specified hereo


Subject: Highlight
Page Label: 1
Lock: Locked
Author: Daniel Torres
Date: 10/22/2018 8:46:41 AM
Color:

Add PCD File No. SF-1826


Subject: Text Box
Page Label: 1
Lock: Locked
Author: Daniel Torres
Date: 10/22/2018 8:46:41 AM
Color:


Add PCD File No. SF-1826


_____ 20____ subject to any
Development Services Direct
CERTIFICATE:
the El Paso County, Colorado Bar

Subject: Highlight
Page Label: 1
Lock: Locked
Author: Daniel Torres
Date: 10/22/2018 8:46:42 AM
Color: 

ado Development
to any notes or


Subject: Highlight
Page Label: 1
Lock: Locked
Author: Daniel Torres
Date: 10/22/2018 8:46:42 AM
Color: 

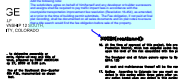

Subject: Callout
Page Label: 1
Lock: Locked
Author: Daniel Torres
Date: 10/22/2018 8:46:43 AM
Color: 


Add the following note:
The subdividers agree on behalf of him/herself and any developer or builder successors and assigns shall be required to pay traffic impact fees in accordance with the countywide transportation improvement fee resolution (Resolution 16-454), as amended, at or prior to the time of building permit submittals. The Fee obligation, if not paid at final plat recording, shall be documented on all sales documents and on plat notes to ensure that a title search would find the fee obligation before sale of the property.




Subject: Callout
Page Label: 1
Lock: Locked
Author: Daniel Torres
Date: 10/22/2018 8:46:46 AM
Color: 


Based on the comment on the next page the applicant will have to process LOMR application with FEMA for FEMA approved base flood elevations. As a result revise the flood plain statement to the following:


This property is located within a designated FEMA Floodplain as determined by the Flood Insurance Rate Map, Community Map Number 08041C0375 F, effective date March 17, 1997 and as amended by the FEMA approved Letter of Map Revision (LOMR) case number _____ dated _____. No structures are permitted within the designated Floodplain areas.

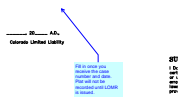

Subject: Callout
Page Label: 1
Lock: Locked
Author: Daniel Torres
Date: 10/22/2018 8:46:48 AM
Color: 

Fill in once you receive the case number and date. Plat will not be recorded until LOMR is issued.

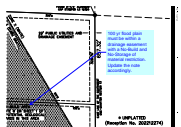


Subject: Callout
Page Label: 2
Lock: Locked
Author: Daniel Torres
Date: 10/22/2018 8:46:51 AM
Color: 

100 yr flood plain must be within a drainage easement with a No-Build and No-Storage of material restriction. Update the note accordingly.



Subject: Callout
Page Label: 2
Lock: Locked
Author: Daniel Torres
Date: 10/22/2018 8:46:52 AM
Color: 

Per LDC section 8.4.2.B.1.e provide FEMA approved base flood elevations. Revise flood plain boundary as necessary to match the LOMR. Submit a copy of the LOMR issued by FEMA

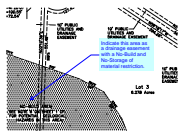

Subject: Callout
Page Label: 2
Lock: Locked
Author: Daniel Torres
Date: 10/22/2018 8:46:53 AM
Color: ■

Indicate this area as a drainage easement with a No-Build and No-Storage of material restriction.

dsdsevigny (1)



Subject: Callout
Page Label: 1
Lock: Locked
Author: dsdsevigny
Date: 10/22/2018 8:46:30 AM
Color: ■

See MDT letter for current signature block required