

PLANT MATERIAL SCHEDULE:


SYMBOL	QTY	KEY	BOTANICAL NAME	COMMON NAME	MATURE WIDTH	PLANTING SIZE	NOTES
SHADE TREES							
	3	qr	QUERCUS RUBRA	NORTHERN RED OAK	40'-60'	2" CAL.	B & B
	2	af	ACER X FREMANII	AUTUMN BLAZE MAPLE	25'-30'	2" CAL.	B & B
	2	ta	TILIA AMERICANA	AMERICAN LINDEN	25'-30'	2" CAL.	B & B
ORNAMENTAL TREES							
	2	sm	MALUS SP. 'SPRINGSNOW'	SPRINGSNOW CRABAPPLE	15'-20'	2" CAL.	B & B
EVERGREEN TREES							
	7	js	JUNIPERUS SCOPULORUM 'SKYROCKET'	SKYROCKET JUNIPER	15'-20'	6' HT.	B & B
SHRUBS							
	10	sw	SPIREA JAPONICA 'ANTHONY WATERER'	ANTHONY WATERER SPIREA	3'-4'	5 GAL.	CONT.
	12	gc	RIBES AUREUM	GOLDEN CURRANT	3'-3-6"	5 GAL.	CONT.
	10	ac	RIBES ALPNUM	ALPINE CURRANT	3'-3-6"	5 GAL.	CONT.
	14	pm	PHYSOCARPUS MANOGYNUS	MOUNTAIN NINEBARK	3'-5'	5 GAL.	CONT.
	13	ea	EUONYMUS ALTATUS 'COMPACTA'	DWARF BURNING BUSH	4'-5'	5 GAL.	CONT.
ORNAMENTAL GRASS							
	37	ca	CALAMAGROSTIS ACUTIFLORA	FEATHER REED GRASS	2'-3'	5 GAL.	CONT.

GENERAL PLANTING NOTES:

- PRIOR TO BEGINNING ANY WORK ON THE SITE THE LANDSCAPE CONTRACTOR SHALL CONTACT THE OFFICE OF THE GENERAL CONTRACTOR AND LANDSCAPE ARCHITECT FOR SPECIFIC INSTRUCTIONS RELEVANT TO THE SEQUENCING OF WORK.
- LANDSCAPE CONTRACTOR SHALL PROVIDE ALL LABOR, MATERIALS AND SERVICE NECESSARY TO FURNISH AND INSTALL PLANTINGS AND MATERIALS AS SPECIFIED HEREIN AND AS SHOWN ON PLANS.
- NO MATERIAL SUBSTITUTIONS SHALL BE MADE WITHOUT THE LANDSCAPE ARCHITECTS APPROVAL IN WRITING. ALTERNATE MATERIALS OF SIMILAR SIZE AND CHARACTER MAY BE CONSIDERED IF SPECIFIED PLANT MATERIALS CANNOT BE OBTAINED.
- LANDSCAPE ARCHITECT RESERVES THE RIGHT TO REVISE PLANT MATERIAL LIST AS DEEMED NECESSARY.
- ALL PLANT LOCATIONS ARE APPROXIMATE. ADJUST AS NECESSARY TO AVOID CONFLICTS.
- QUANTITIES OF MATERIALS SHOWN ON THE PLANTING PLAN TAKE PRECEDENCE OVER QUANTITIES SHOWN ON THE PLANT MATERIAL SCHEDULE. THE LANDSCAPE CONTRACTOR SHALL BE RESPONSIBLE FOR VERIFY ALL QUANTITIES ON THE PLANTING PLAN(S).
- LANDSCAPE CONTRACTOR SHALL LOCATE ALL UTILITIES BEFORE COMMENCEMENT OF WORK. VERIFY EXACT LOCATION OF ALL UTILITIES BY CONTACTING APPROPRIATE UTILITY COMPANIES. LANDSCAPE CONTRACTOR IS RESPONSIBLE FOR THE REPAIR / REPLACEMENT FOR ANY DAMAGE CAUSED TO UTILITIES.
- FINISH GRADE SHALL BE ADJUSTED FOR TURF THICKNESS.
- ALL PLANT MATERIALS SHALL HAVE BACKFILL, CAREFULLY PLACED AROUND BASE AND IDES OF BALL TO TWO-THIRDS (2/3) DEPTH OF BALL THEN THOROUGHLY SOAKED WITH WATER TO ALLOW SETTLEMENT. ALL WIRE, BURLAP FASTENERS, TOP ONE-THIRD (1/3) OF BURLAP AND LOOSE BURLAP SHALL BE REMOVED AT THIS TIME THE REMAINDER OF HE PIT SHALL THEN BE BACKFILLED, ALLOWING FOR THE DEPTH OF THE MULCH SAUCER AND SETTLEMENT OF BACKFILL. BACKFILL SHALL THEN BE THOROUGHLY WATERED ONCE AGAIN.
- AFTER PLANTING IS COMPLETED REPAIR INJURIES TO ALL PLANTS AS REQUIRED. LIMIT AMOUNT OF PRUNING TO A MINIMUM NECESSARY TO REMOVE DEAD OR INJURED TWIGS AND BRANCHES. PRUNE IN SUCH A MANNER AS NOT TO CHANGE THE NATURAL GROWING HABIT OR SHAPE OF THE PLANT. MAKE ALL CUTS FLUSH, LEAVING NO STUBS. CENTRAL LEADERS SHALL NOT BE REMOVED. IF THE CENTRAL LEADER OF A PLANT IS DEAD THE PLANT SHALL BE REPLACED.
- PLANT SPECIFIED GROUND COVERS WITHIN ONE FOOT OF TRUCK OF TREES AND SHRUBS PLANTED WITHIN THE AREA. PLANTING ARRANGEMENTS SHALL BE TRIANGULAR WITH PROPER SPACING BETWEEN PLANTS.
- COMMERCIAL GRADE 3/8 INCH BY 4" POWDER COATED STEEL EDGING SHALL BE USED TO SEPARATE ALL TURF AREAS FROM PLANTING BEDS. PLACE EDGING FLUSH WITH GRADE AND STAKE TO GROUND PER MANUFACTURES RECOMMENDATIONS.
- LANDSCAPE CONTRACTOR TO PROVIDE THE LANDSCAPE CONTRACTOR A SAMPLE OF PROPOSED STEEL EDGING FOR REVIEW AND APPROVAL PRIOR TO INSTALLATION.
- USE SHREDDED CEDAR MULCH IN ALL PLANTING BEDS AND TREE SAUCERS. LANDSCAPE CONTRACTOR SHALL PROVIDE A 1 CUBIC FOOT SAMPLE OF PROPOSED MULCH TO LANDSCAPE ARCHITECT FOR REVIEW AND APPROVAL.
- PLACE FOUR INCHES OF MULCH IN ALL SHRUB BEDS, PLACE FOUR INCHES OF MULCH IN ALL GROUND COVER, PERENNIAL BEDS AND PLACE 4 INCHES OF MULCH AT ALL TREE SAUCERS.
- PLANTING BEDS RECEIVING MULCH MULCH ARE TO BE FREE OF WEEDS AND GRASS. TREAT BEDS WITH A PRE-EMERGENT HERBICIDE PRIOR TO PLANTING AND MULCH PLACEMENT. DO NOT APPLY HERBICIDE IN PERENNIAL OR ANNUAL BEDS.
- LANDSCAPE CONTRACTOR TO REMOVE TREE STAKES AND ALL DEAD WOOD ON TREES AND SHRUBS ONE YEAR AFTER SUBSTANTIAL COMPLETION IS GRANTED ON THE COMPLETE PROJECT.
- REPORT ANY DISCREPANCIES IN THE PLANTING PLAN TO THE LANDSCAPE ARCHITECT PRIOR TO STARTING CONSTRUCTION.
- ALL LANDSCAPE AREAS SHALL BE IRRIGATED BY AN UNDERGROUND AUTOMATIC UNDERGROUD IRRIGATION SYSTEM. WITH SEPARATE ZONES FOR TURF AND SHRUBS / TREES / GROUNDCOVER.
- IF TRANSFORMERS, GROUND MOUNTED HVAC EQUIPMENT, UTILITY PEDESTALS, ETC. ARE NOT SHOWN ON THE SITE IMPROVEMENT PLAN, ADDITIONAL LANDSCAPE/SCREENING MAY BE REQUIRED BASED UPON FIELD CONDITIONS DISCOVERED VIA THE SITE INSPECTION BY STAFF, MADE PRIOR TO THE ISSUANCE OF CERTIFICATE OF OCCUPANCY, OR FINAL INSPECTION AS APPLICABLE.

Please see comments on Landscape Plan provided in the Site Development Plan set V2. Please make sure the correct plan is incorporated into that set, or remove from the set.

PCD File # PPR2227

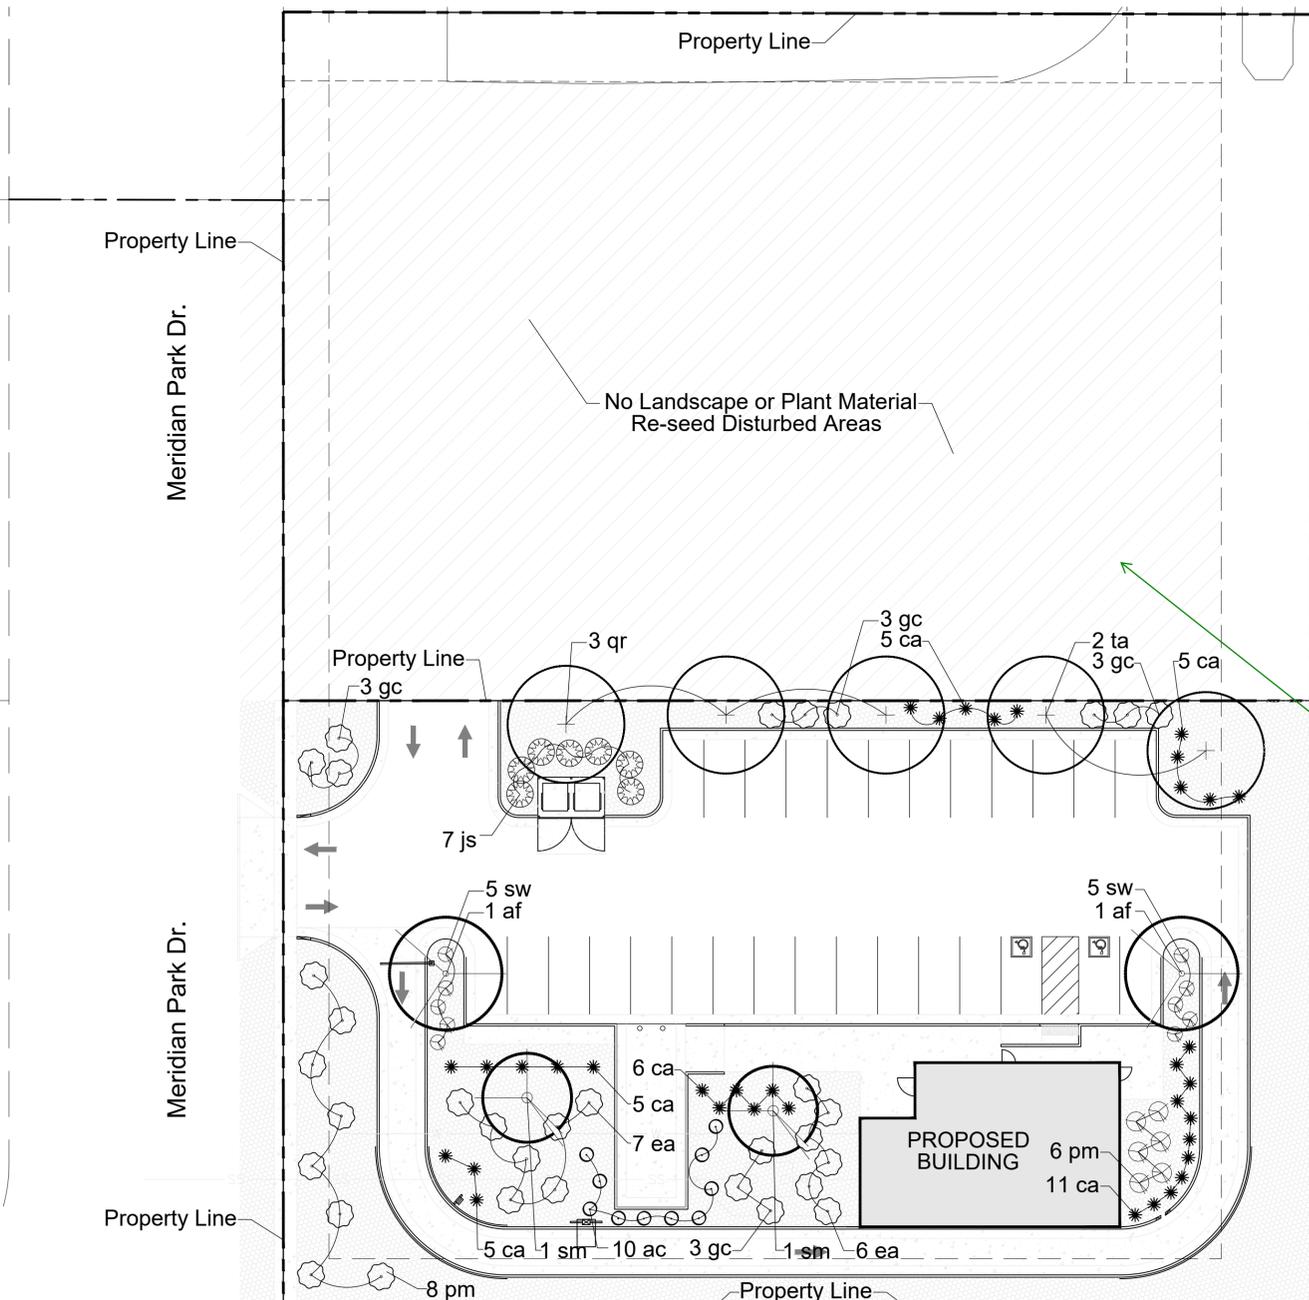

IRRIGATION NOTE

AN IRRIGATION PLAN SHALL BE SUBMITTED AND REVIEWED CONCURRENT WITH BUILDING PERMIT SUBMITTAL AND APPROVED PRIOR TO ISSUANCE OF A BUILDING PERMIT AND BEFORE ANY IRRIGATION CONSTRUCTION.



LANDSCAPE PLAN




Client:	CD BENT GRASS LLC
Address:	106 S. KYRENE RD. CHANDLER, AZ 85226
Phone:	PHONE: A.TTN: B. HAYENGA
Date:	03/22/22
Revised:	09/30/22
Initial Submittal:	
Revised Per County Comments:	
NO.:	1
DESCRIPTION:	REVISED PER COUNTY COMMENTS
W.C. CIVIL:	7220 W. JEFFERSON AVE STE. 204 LAKEWOOD, CO 80235 PHONE: (303) 390-0172
WC CIVIL:	
FINAL LANDSCAPE PLAN	
DUNKIN BENT GRASS	
SITE DEVELOPMENT PLAN	
LOT 1A, BENT GRASS EAST COMMERCIAL FILING NO. 2A,	
LOCATED IN TOWN OF PEYTON,	
COUNTY OF EL PASO, STATE OF COLORADO	
File:	
WC Civil Team:	TS, LP
Date:	2022/10/20
Engineering No.:	AS NOTED
Scale:	
Sheet No.:	9

PERMIT NO.:

Landscape Plan Drawings_V2.pdf Markup Summary

Linda.Nguyen (2)

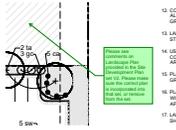

Subject: Callout
Page Label: 1
Author: Linda.Nguyen
Date: 11/23/2022 12:23:49 PM
Status:
Color: ■
Layer:
Space:

Please see comments on Landscape Plan provided in the Site Development Plan set V2. Please make sure the correct plan is incorporated into that set, or remove from the set.



Subject: Callout
Page Label: 1
Author: Linda.Nguyen
Date: 11/23/2022 12:24:31 PM
Status:
Color: ■
Layer:
Space:

PCD File # PPR2227