

BRANDING IRON AT STERLING RANCH FILING NO. 1

A REPLAT OF TRACT BB, "STERLING RANCH FILING NO. 1", SAID TRACT BEING A PORTION OF THE E 1/2 W 1/2 OF SECTION 33, TOWNSHIP 12 SOUTH, RANGE 65 WEST OF THE 6TH PRINCIPAL MERIDIAN, EL PASO COUNTY, COLORADO

BE IT KNOWN BY THESE PRESENTS:

THAT SR LAND, LLC, BEING THE OWNER OF THE FOLLOWING DESCRIBED TRACT OF LAND TO WIT:

LEGAL DESCRIPTION:

A REPLAT OF TRACT BB, "STERLING RANCH FILING NO. 1", AS RECORDED UNDER RECEPTION NO. 218714151 IN THE EL PASO COUNTY RECORDS,

SAID TRACT BEING A PORTION OF THE E 1/2 W 1/2 OF SECTION 33, TOWNSHIP 12 SOUTH, RANGE 65 WEST OF THE 6TH PRINCIPAL MERIDIAN, EL PASO COUNTY, COLORADO;

CONTAINING A CALCULATED AREA OF 459,341 SQUARE FEET (10.545 ACRES) MORE OR LESS

ACCEPTANCE CERTIFICATE FOR TRACTS:

THE DEDICATION OF TRACTS A, B, C, D, E, F, G, H, I, AND J ARE FOR LANDSCAPE PURPOSES, DRAINAGE, PEDESTRIAN ACCESS, OPEN SPACE, AND UTILITIES PURPOSES AND ARE HEREBY ACCEPTED FOR OWNERSHIP AND MAINTENANCE BY STERLING RANCH METROPOLITAN DISTRICT NO. 1.

BY _____ OF STERLING RANCH METROPOLITAN DISTRICT NO. 1

STATE OF COLORADO)
COUNTY OF EL PASO) SS

ACKNOWLEDGED BEFORE ME THIS THIS _____ DAY OF _____, 2018, A.D.
BY _____ OF STERLING RANCH METROPOLITAN DISTRICT NO. 1

WITNESS MY HAND AND OFFICIAL SEAL:

MY COMMISSION EXPIRES: _____
NOTARY PUBLIC _____

OWNERS CERTIFICATE/DEDICATION STATEMENT:

THE UNDERSIGNED, BEING ALL THE OWNERS, MORTGAGEES, BENEFICIARIES OF DEEDS OF TRUST AND HOLDERS OF OTHER INTERESTS IN THE LAND DESCRIBED HEREIN, HAVE LAID OUT, SUBDIVIDED, AND PLATTED SAID LANDS INTO LOTS, TRACTS, STREETS, AND EASEMENTS AS SHOWN HEREON UNDER THE NAME AND SUBDIVISION OF "BRANDING IRON AT STERLING RANCH FILING NO. 1". ALL PUBLIC IMPROVEMENTS SO PLATTED ARE HEREBY DEDICATED TO PUBLIC USE AND SAID OWNER DOES HEREBY COVENANT AND AGREE THAT THE PUBLIC IMPROVEMENTS WILL BE CONSTRUCTED TO EL PASO COUNTY STANDARDS AND THAT PROPER DRAINAGE AND EROSION CONTROL FOR SAME WILL BE PROVIDED AT SAID OWNER'S EXPENSE, ALL TO THE SATISFACTION OF THE BOARD OF COUNTY COMMISSIONERS OF EL PASO COUNTY, COLORADO. UPON ACCEPTANCE BY RESOLUTION, ALL PUBLIC IMPROVEMENTS SO DEDICATED WILL BECOME MATTERS OF MAINTENANCE BY EL PASO COUNTY, COLORADO. THE UTILITY EASEMENTS SHOWN HEREON ARE HEREBY DEDICATED FOR PUBLIC UTILITIES AND COMMUNICATION SYSTEMS AND OTHER PURPOSES AS SHOWN HEREON. THE ENTITIES RESPONSIBLE FOR PROVIDING THE SERVICES FOR WHICH THE EASEMENTS ARE ESTABLISHED ARE HEREBY GRANTED THE PERPETUAL RIGHT OF INGRESS AND EGRESS FROM AND TO ADJACENT PROPERTIES FOR INSTALLATION, MAINTENANCE AND REPLACEMENT OF UTILITY LINES AND RELATED FACILITIES.

THE AFOREMENTIONED, SR LAND, LLC HAS EXECUTED THIS INSTRUMENT THIS _____ DAY OF _____, 2018, A.D.

BY: _____

PRINTED NAME: _____

AS: _____ OF SR LAND, LLC

STATE OF COLORADO)
COUNTY OF EL PASO) SS

THE FOREGOING INSTRUMENT WAS ACKNOWLEDGED BEFORE ME THIS THIS _____ DAY OF _____, 2018, A.D. BY _____ OF SR LAND, LLC.

WITNESS MY HAND AND OFFICIAL SEAL:

MY COMMISSION EXPIRES: _____
NOTARY PUBLIC _____


PLAT NOTES:

- BASIS OF BEARINGS:**
BEARINGS ARE BASED ON THE SOUTH LINE OF THE SOUTHWEST QUARTER (SW1/4) OF SECTION 34, TOWNSHIP 12 SOUTH, RANGE 65 WEST OF THE 6TH P.M. AS MONUMENTED AT THE SOUTHWEST CORNER OF SAID SOUTHWEST QUARTER (SW1/4) BY A 2-1/2" ALUMINUM CAP STAMPED "LS 11624" AND AT THE SOUTHEAST CORNER OF SAID SOUTHWEST QUARTER (SW1/4) BY A 2-1/2" ALUMINUM CAP STAMPED "LS 11624". SAID LINE BEARS N89°14'14"E, A DISTANCE OF 2,722.56 FEET. THE UNITS OF MEASUREMENT IS U.S. SURVEY FEET.
- FLOODPLAIN STATEMENT:**
NO PORTION OF THIS SITE IS LOCATED WITHIN A DESIGNATED FEMA FLOODPLAIN AS DETERMINED BY THE FLOOD INSURANCE RATE MAP, COMMUNITY MAP NUMBER 08041C0535F, EFFECTIVE DATE MARCH 17, 1997.

PLAT NOTES: (CONTINUED)

- TITLE COMMITMENT:**
THIS SURVEY DOES NOT CONSTITUTE A TITLE SEARCH BY M&S CIVIL CONSULTANTS, INC., TO DETERMINE THE COMPATIBILITY OF THIS DESCRIPTION WITH THAT OF ADJACENT TRACTS OF LAND, OWNERSHIP OR EASEMENTS OF RECORD. FOR ALL INFORMATION REGARDING EASEMENTS, RIGHT-OF-WAY OR TITLE-OF-RECORD, M&S CIVIL CONSULTANTS, INC., RELIED UPON TITLE COMMITMENT FILE NO. 172091, PREPARED BY CAPSTONE TITLE, DATED JUNE 13, 2018.
- WATER SERVICE SHALL BE SUPPLIED BY STERLING RANCH METROPOLITAN DISTRICT NO. 1.
- SEWER SERVICE SHALL BE SUPPLIED BY STERLING RANCH METROPOLITAN DISTRICT NO. 1.
- ELECTRIC SERVICE SHALL BE PROVIDED BY MOUNTAIN VIEW ELECTRIC ASSOCIATION.
- NATURAL GAS SERVICE SHALL BE PROVIDED BY COLORADO SPRINGS UTILITIES.
- FIRE PROTECTION BY THE BLACK FOREST FIRE PROTECTION DISTRICT.
- ALL STRUCTURAL FOUNDATIONS SHALL BE LOCATED AND DESIGNED BY A PROFESSIONAL ENGINEER, CURRENTLY LICENSED IN THE STATE OF COLORADO.
- THE FOLLOWING REPORTS HAVE BEEN SUBMITTED IN ASSOCIATION WITH THE PRELIMINARY PLAN OR FINAL PLAN FOR THIS SUBDIVISION AND ARE ON FILE AT THE COUNTY DEVELOPMENT SERVICES DEPARTMENT: TRANSPORTATION IMPACT STUDY; DRAINAGE REPORT; WATER RESOURCES REPORT; WASTEWATER DISPOSAL REPORT; NATURAL HAZARDS REPORT; GEOLOGY AND SOILS REPORT; WETLAND STUDY/404 PERMIT.
- ALL PROPERTY OWNERS ARE RESPONSIBLE FOR MAINTAINING PROPER STORM WATER DRAINAGE IN AND THROUGH THEIR PROPERTY. PUBLIC DRAINAGE EASEMENTS AS SPECIFICALLY NOTED ON THE PLAT SHALL BE MAINTAINED BY THE INDIVIDUAL LOT OWNERS UNLESS OTHERWISE INDICATED. STRUCTURES, FENCES, MATERIALS OR LANDSCAPING THAT COULD IMPEDE THE FLOW OF RUNOFF SHALL NOT BE PLACED IN DRAINAGE EASEMENTS.
- UNLESS OTHERWISE INDICATED, ALL SIDE LOT LINES ARE HEREBY PLATTED ON EITHER SIDE WITH A 5 FOOT PUBLIC UTILITY AND DRAINAGE EASEMENT, ALL FRONT LOT LINES ARE HEREBY PLATTED WITH A 5 FOOT PUBLIC UTILITY AND DRAINAGE EASEMENT, AND ALL FRONT AND REAR LOT LINES ARE HEREBY PLATTED WITH A 10 FOOT PUBLIC UTILITY AND DRAINAGE EASEMENT. ALL EXTERIOR SUBDIVISION BOUNDARIES ARE HEREBY PLATTED WITH A 7 FOOT PUBLIC UTILITY AND DRAINAGE EASEMENT. EASEMENTS ARE HEREBY PLATTED IN THE LOCATIONS ON SHOWN SHEET 3 OF THIS PLAT. THE SOLE RESPONSIBILITY FOR THE SURFACE MAINTENANCE OF EASEMENTS IS HEREBY VESTED WITH THE INDIVIDUAL PROPERTY OWNER UNLESS OTHERWISE NOTED.
- SIDE-LOT DRAINAGE SWALES SHALL BE CONSTRUCTED WHERE NECESSARY AT THE TIME OF HOME CONSTRUCTION.
- DEVELOPER SHALL COMPLY WITH FEDERAL AND STATE LAWS, REGULATIONS, ORDINANCES, REVIEW AND PERMIT REQUIREMENTS, AND OTHER AGENCY REQUIREMENTS, IF ANY, OF APPLICABLE AGENCIES INCLUDING, BUT NOT LIMITED TO, THE COLORADO DIVISION OF WILDLIFE, COLORADO DEPARTMENT OF TRANSPORTATION, U.S. ARMY CORPS OF ENGINEERS AND THE U.S. FISH AND WILDLIFE SERVICE REGARDING THE ENDANGERED SPECIES ACT, PARTICULARLY AS IT RELATES TO THE LISTED SPECIES.
- THE ADDRESSES EXHIBITED ON THIS PLAT ARE FOR INFORMATIONAL PURPOSES ONLY. THEY ARE NOT THE LEGAL DESCRIPTION AND ARE SUBJECT TO CHANGE.
- NO DRIVEWAY SHALL BE ESTABLISHED UNLESS AN ACCESS PERMIT HAS BEEN GRANTED BY EL PASO COUNTY.
- NO LOT OR INTEREST THEREIN, SHALL BE SOLD, CONVEYED, OR TRANSFERRED WHETHER BY DEED OR BY CONTRACT, NOR SHALL BUILDING PERMITS BE ISSUED, UNTIL AND UNLESS EITHER THE REQUIRED PUBLIC AND COMMON DEVELOPMENT IMPROVEMENTS HAVE BEEN CONSTRUCTED AND COMPLETED AND PRELIMINARILY ACCEPTED IN ACCORDANCE WITH THE SUBDIVISION IMPROVEMENTS AGREEMENT BETWEEN THE APPLICANT/OWNER AND EL PASO COUNTY AS RECORDED UNDER RECEPTION NUMBER _____ IN THE OFFICE OF THE CLERK AND RECORDER OF EL PASO COUNTY, COLORADO OR, IN THE ALTERNATIVE, OTHER COLLATERAL IS PROVIDED TO MAKE PROVISION FOR THE COMPLETION OF SAID IMPROVEMENTS IN ACCORDANCE WITH THE EL PASO COUNTY LAND DEVELOPMENT CODE AND ENGINEERING CRITERIA MANUAL. ANY SUCH ALTERNATIVE COLLATERAL MUST BE APPROVED BY THE BOARD OF COUNTY COMMISSIONERS OR, IF PERMITTED BY THE SUBDIVISION IMPROVEMENTS AGREEMENT, BY THE PLANNING AND COMMUNITY DEVELOPMENT DEPARTMENT DIRECTOR AND MEET THE POLICY AND PROCEDURE REQUIREMENTS OF EL PASO COUNTY PRIOR TO THE RELEASE BY THE COUNTY OF ANY LOTS FOR SALE, CONVEYANCE OR TRANSFER.
- THIS PLAT RESTRICTION MAY BE REMOVED OR RESCINDED BY THE BOARD OF COUNTY COMMISSIONERS OR, IF PERMITTED BY THE SUBDIVISION IMPROVEMENTS AGREEMENT, BY THE PLANNING AND COMMUNITY DEVELOPMENT DEPARTMENT DIRECTOR UPON EITHER APPROVAL OF AN ALTERNATIVE FORM OF COLLATERAL OR COMPLETION AND PRELIMINARY ACCEPTANCE BY THE EL PASO BOARD OF COUNTY COMMISSIONERS OF ALL IMPROVEMENTS REQUIRED TO BE CONSTRUCTED AND COMPLETED IN ACCORDANCE WITH SAID SUBDIVISION IMPROVEMENTS AGREEMENT. THE PARTIAL RELEASE OF LOTS FOR SALE, CONVEYANCE OR TRANSFER MAY ONLY BE GRANTED IN ACCORDANCE WITH ANY PLANNED PARTIAL RELEASE OF LOTS AUTHORIZED BY THE SUBDIVISION IMPROVEMENTS AGREEMENT.
- NOTICE: THIS PROPERTY MAY BE ADVERSELY IMPACTED BY NOISE, DUST, FUMES, AND LIGHT POLLUTION CAUSED BY ADJACENT INDUSTRIAL PROPERTIES AND ACTIVITIES. THE BUYER SHOULD RESEARCH AND BE AWARE OF THIS POTENTIALITY AND THE RAMIFICATIONS THEREOF.
- ANY PERSON WHO KNOWINGLY REMOVES, ALTERS OR DEFACES ANY PUBLIC LAND SURVEY MONUMENT OR LAND BOUNDARY MONUMENT OR ACCESSORY, COMMITS A CLASS TWO (2) MISDEMEANOR PURSUANT TO CRS 18-4-508.
- ALL PROPERTY WITHIN THIS SUBDIVISION IS INCLUDED IN STERLING RANCH METROPOLITAN DISTRICT NO. 2.
- THE STERLING RANCH METROPOLITAN DISTRICT NO. 1 WILL BE RESPONSIBLE FOR MAINTENANCE OF THE ROADS UNTIL PRELIMINARY ACCEPTANCE OF THE PUBLIC IMPROVEMENTS IN ACCORDANCE WITH THE REQUIREMENTS OF THE LAND DEVELOPMENT CODE, THE ENGINEERING CRITERIA MANUAL, AND THE SUBDIVISION IMPROVEMENTS AGREEMENT.
- ALL PROPERTY WITHIN THIS SUBDIVISION IS SUBJECT TO A DECLARATION OF COVENANT AS RECORDED AT RECEPTION NO. _____ OF THE RECORDS OF THE EL PASO COUNTY CLERK AND RECORDER.
- SPECIAL DISTRICT DISCLOSURE:
A TITLE 32 SPECIAL DISTRICT ANNUAL REPORT AND DISCLOSURE FORM SATISFACTORY TO THE DEVELOPMENT SERVICES DEPARTMENT SHALL BE RECORDED WITH EACH PLAT.
- MAILBOXES SHALL BE INSTALLED IN ACCORDANCE WITH ALL EL PASO COUNTY AND UNITED STATES POSTAL SERVICE REGULATION.
- THE SUBDIVIDER(S) AGREES ON BEHALF OF HIM/HERSELF AND ANY DEVELOPER OR BUILDER SUCCESSORS AND ASSIGNEES THAT SUBDIVIDER AND/OR SAID SUCCESSORS AND ASSIGNS SHALL BE REQUIRED TO PAY TRAFFIC IMPACT FEES IN ACCORDANCE WITH THE EL PASO COUNTY ROAD IMPACT FEE PROGRAM RESOLUTION (RESOLUTION NO. 16-454), OR ANY AMENDMENTS THERETO, AT OR PRIOR TO THE TIME OF BUILDING PERMIT SUBMITTALS. THE FEE OBLIGATION, IF NOT PAID AT FINAL PLAT RECORDING, SHALL BE DOCUMENTED ON ALL SALES DOCUMENTS AND ON PLAT NOTES TO ENSURE THAT A TITLE SEARCH WOULD FIND THE FEE OBLIGATION BEFORE SALE OF THE PROPERTY. TRANSPORTATION IMPACT FEES ARE TO BE PAID AT BUILDING PERMIT.
- THE FOLLOWING LOTS HAVE BEEN FOUND TO BE IMPACTED BY GEOLOGIC HAZARDS. MITIGATION MEASURES AND A MAP OF THE HAZARD AREA CAN BE FOUND IN THE REPORT GEOLOGIC HAZARD REPORT BY ENTECH ENGINEERING, INC., DATED JANUARY 2009, IN FILE SP-14-015 AVAILABLE AT THE EL PASO COUNTY PLANNING AND COMMUNITY DEVELOPMENT DEPARTMENT. THE FOLLOWING LOTS ARE IMPACTED: POTENTIALLY SEASONAL SHALLOW GROUNDWATER: LOTS 25, 32, 33, 34, 37, 38, 41, 42, 48, 49, AND 50

You need to put the relative info from a title search post the filing 1 plat and changes since June.

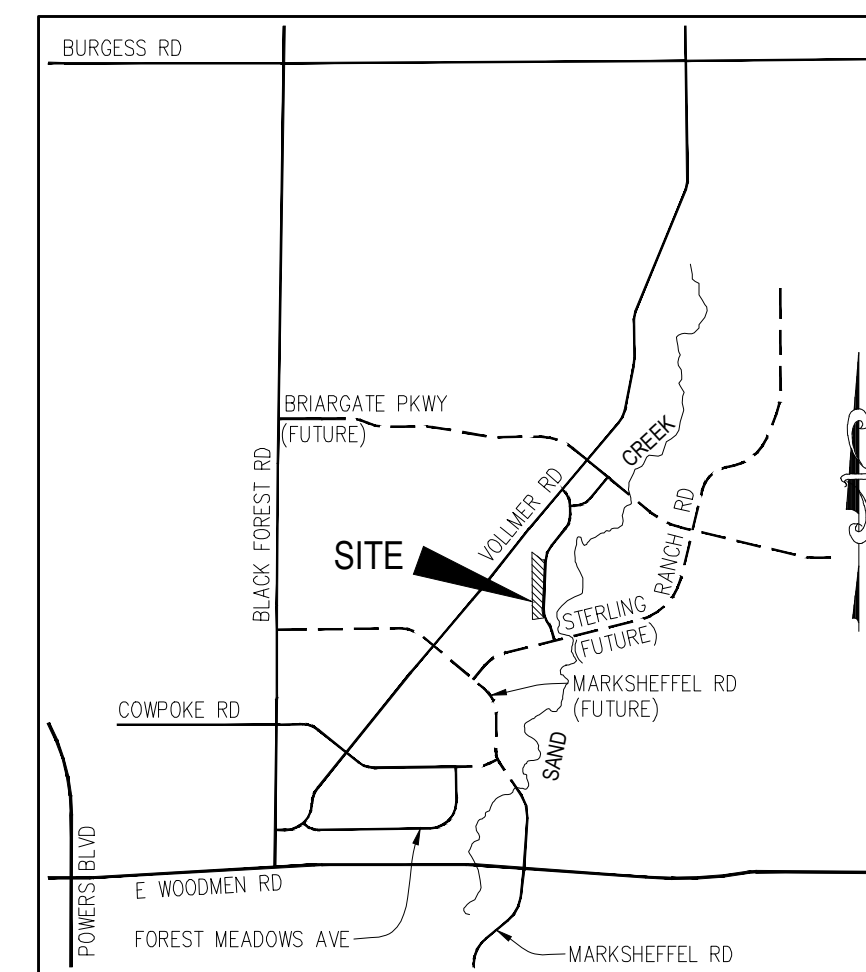

VICINITY MAP
N.T.S.

PLAT NOTES: (CONTINUED)

- THERE SHALL BE NO DIRECT RESIDENTIAL LOT ACCESS TO DINES BOULEVARD.
- A PRIVATE DETENTION POND MAINTENANCE AGREEMENT FOR PONDS, W9, 4 & 8 IS RECORDED UNDER REC. NO. 218061178, REC. NO. 218061179, & REC. NO. 218061180, OF THE RECORDS OF EL PASO COUNTY.
- A RIGHT-OF-WAY LANDSCAPE LICENSE AGREEMENT IS RECORDED UNDER REC. NO. 218061176, OF THE RECORDS OF EL PASO COUNTY.
- A LANDSCAPE EXHIBIT IS RECORDED UNDER REC. NO. 218061176, OF THE RECORDS OF EL PASO COUNTY.
- A MOUNTAIN VIEW ELECTRIC ASSOCIATION GRANT OF RIGHT-OF-WAY EASEMENT IS RECORDED UNDER REC. NO. 218054783, OF THE RECORDS OF EL PASO COUNTY.
- A RIGHT OF WAY AGREEMENT IS RECORDED UNDER REC. NO. 205161563, OF THE RECORDS OF EL PASO COUNTY.
- A PERMANENT EASEMENT AGREEMENT IS RECORDED UNDER REC. NO. 201034022, OF THE RECORDS OF EL PASO COUNTY.
- A AGREEMENT TO GRANT ACCESS AND UTILITY EASEMENTS IS RECORDED UNDER REC. NO. 214100440, OF THE RECORDS OF EL PASO COUNTY.
- A AGREEMENT TO GRANT ACCESS AND UTILITY EASEMENTS IS RECORDED UNDER REC. NO. 214100441, AND AMENDED UNDER REC. NO. 218043584, OF THE RECORDS OF EL PASO COUNTY.
- A AGREEMENT TO GRANT OF EASEMENTS IS RECORDED UNDER REC. NO. 214100442, AND AMENDED UNDER REC. NO. 218043585, OF THE RECORDS OF EL PASO COUNTY.
- A CONSOLIDATED SERVICE PLAN FOR STERLING RANCH METROPOLITAN DISTRICTS 1, 2 AND 3 IS RECORDED UNDER REC. NO. 214042782, OF THE RECORDS OF EL PASO COUNTY.
- THE PROPERTY IS SUBJECT TO RESTRICTIONS AS DEFINED BY TRUSTEE'S SPECIAL WARRANTY DEED UNDER REC. NO. 208045408, OF THE RECORDS OF EL PASO COUNTY.



TRACT TABLE				
TRACT	SIZE (ACRES)	USE	MAINTENANCE	OWNERSHIP
A	0.005	LANDSCAPE/PUBLIC IMPROVEMENTS/PUBLIC UTILITY/TRAIL	SRMD#1	SRMD#1
B	0.005	LANDSCAPE/PUBLIC IMPROVEMENTS/PUBLIC UTILITY/TRAIL	SRMD#1	SRMD#1
C	0.005	LANDSCAPE/PUBLIC IMPROVEMENTS/PUBLIC UTILITY/TRAIL	SRMD#1	SRMD#1
D	0.005	LANDSCAPE/PUBLIC IMPROVEMENTS/PUBLIC UTILITY/TRAIL	SRMD#1	SRMD#1
E	0.005	LANDSCAPE/PUBLIC IMPROVEMENTS/PUBLIC UTILITY/TRAIL	SRMD#1	SRMD#1
F	0.005	LANDSCAPE/PUBLIC IMPROVEMENTS/PUBLIC UTILITY/TRAIL	SRMD#1	SRMD#1
G	0.005	LANDSCAPE/PUBLIC IMPROVEMENTS/PUBLIC UTILITY/TRAIL	SRMD#1	SRMD#1
H	0.005	LANDSCAPE/PUBLIC IMPROVEMENTS/PUBLIC UTILITY/TRAIL	SRMD#1	SRMD#1
I	0.005	LANDSCAPE/PUBLIC IMPROVEMENTS/PUBLIC UTILITY/TRAIL	SRMD#1	SRMD#1
J	0.005	LANDSCAPE/PUBLIC IMPROVEMENTS/PUBLIC UTILITY/TRAIL	SRMD#1	SRMD#1
*SRMD#1 = STERLING RANCH METROPOLITAN DISTRICT NO. 1				

SURVEYORS CERTIFICATE

I VERNON P. TAYLOR, A DULY REGISTERED PROFESSIONAL LAND SURVEYOR IN THE STATE OF COLORADO, DO HEREBY CERTIFY THAT THIS PLAT TRULY AND CORRECTLY REPRESENTS THE RESULTS OF A SURVEY MADE ON DATE OF SURVEY, BY ME OR UNDER MY DIRECT SUPERVISION AND THAT ALL MONUMENTS EXIST AS SHOWN HEREON; THAT MATHEMATICAL CLOSURE ERRORS ARE LESS THAN 1:10,000; AND THAT SAID PLAT HAS BEEN PREPARED IN FULL COMPLIANCE WITH ALL APPLICABLE LAWS OF THE STATE OF COLORADO DEALING WITH MONUMENTS, SUBDIVISION, OR SURVEYING OF LAND AND ALL APPLICABLE PROVISIONS OF THE EL PASO COUNTY LAND DEVELOPMENT CODE.

I ATTEST THE ABOVE ON THIS _____ DAY OF _____, 2018.

VERNON P. TAYLOR
COLORADO PLS NO. 25966, FOR AND ON BEHALF OF M&S CIVIL CONSULTANTS, INC
20 BOULDER CRESCENT, SUITE 110
COLORADO SPRINGS, COLORADO 80903

NOTICE:

ACCORDING TO COLORADO LAW, YOU MUST COMMENCE ANY LEGAL ACTION BASED UPON ANY DEFECT IN THIS SURVEY WITHIN THREE YEARS AFTER YOU FIRST DISCOVER SUCH DEFECT. IN NO EVENT, MAY ANY ACTION BASED UPON ANY DEFECT IN THIS SURVEY BE COMMENCED MORE THAN TEN YEARS FROM THE DATE OF THE CERTIFICATION SHOWN HEREON.

PLANNING AND COMMUNITY DEVELOPMENT DEPARTMENT DIRECTOR CERTIFICATE:

THIS PLAT FOR "HOMESTEAD AT STERLING RANCH FILING NO. 1" WAS APPROVED FOR FILING BY THE EL PASO COUNTY PLANNING AND COMMUNITY DEVELOPMENT DEPARTMENT DIRECTOR ON THIS _____ DAY OF _____, 2018, SUBJECT TO ANY NOTES OR CONDITIONS SPECIFIED HEREON.

DIRECTOR, PLANNING AND COMMUNITY DEVELOPMENT DEPARTMENT _____ DATE _____

BOARD OF COUNTY COMMISSIONERS CERTIFICATE:

THIS PLAT FOR "BRANDING IRON AT STERLING RANCH FILING NO. 1" WAS APPROVED FOR FILING BY THE EL PASO COUNTY, COLORADO BOARD OF COUNTY COMMISSIONERS ON THIS _____ DAY OF _____, 2018. SUBJECT TO ANY NOTES SPECIFIED HEREON AND ANY CONDITIONS INCLUDED IN THE RESOLUTION OF APPROVAL. THE DEDICATIONS OF LAND TO THE PUBLIC (STREETS AND EASEMENTS) ARE ACCEPTED, BUT PUBLIC IMPROVEMENTS THEREON WILL NOT BECOME MAINTENANCE RESPONSIBILITY OF EL PASO COUNTY UNTIL PRELIMINARY ACCEPTANCE OF THE PUBLIC IMPROVEMENTS IN ACCORDANCE WITH THE REQUIREMENTS OF THE LAND DEVELOPMENT CODE AND ENGINEERING CRITERIA MANUAL AND THE SUBDIVISION IMPROVEMENTS AGREEMENT.

PRESIDENT, BOARD OF COUNTY COMMISSIONERS _____ DATE _____

CLERK AND RECORDER:

STATE OF COLORADO)
COUNTY OF EL PASO) SS

I HEREBY CERTIFY THAT THIS INSTRUMENT WAS FILED FOR RECORD IN MY OFFICE AT _____ O'CLOCK _____ M., THIS _____ DAY OF _____, 2018, A.D., AND DULY RECORDED UNDER RECEPTION NO. _____ OF THE RECORDS OF EL PASO COUNTY, COLORADO.

BY: _____
CHUCK BROERMAN, EL PASO COUNTY CLERK AND RECORDER

FEES:

DRAINAGE FEE:	_____	51 LOTS 8.334 ACRES	79.03%
BRIDGE FEE:	_____	10 TRACTS 0.050 ACRES	0.47%
SCHOOL FEE:	_____	RIGHTS-OF-WAY 2.161 ACRES	20.50%
PARK FEE:	_____	TOTAL 10.545 ACRES	100.00%

SUMMARY:


FINAL PLAT
BRANDING IRON AT
STERLING RANCH FILING NO. 1
JOB NO. 09-006
DATE PREPARED: 10/30/2017
DATE REVISED: 07/30/2018




20 BOULDER CRESCENT, SUITE 110
COLORADO SPRINGS, CO 80903
PHONE: 719.955.5485

BRANDING IRON AT STERLING RANCH FILING NO. 1

A REPLAT OF TRACT BB, "STERLING RANCH FILING NO. 1", SAID TRACT BEING A PORTION OF THE E 1/2 W 1/2 OF SECTION 33, TOWNSHIP 12 SOUTH, RANGE 65 WEST OF THE 6TH PRINCIPAL MERIDIAN, EL PASO COUNTY, COLORADO

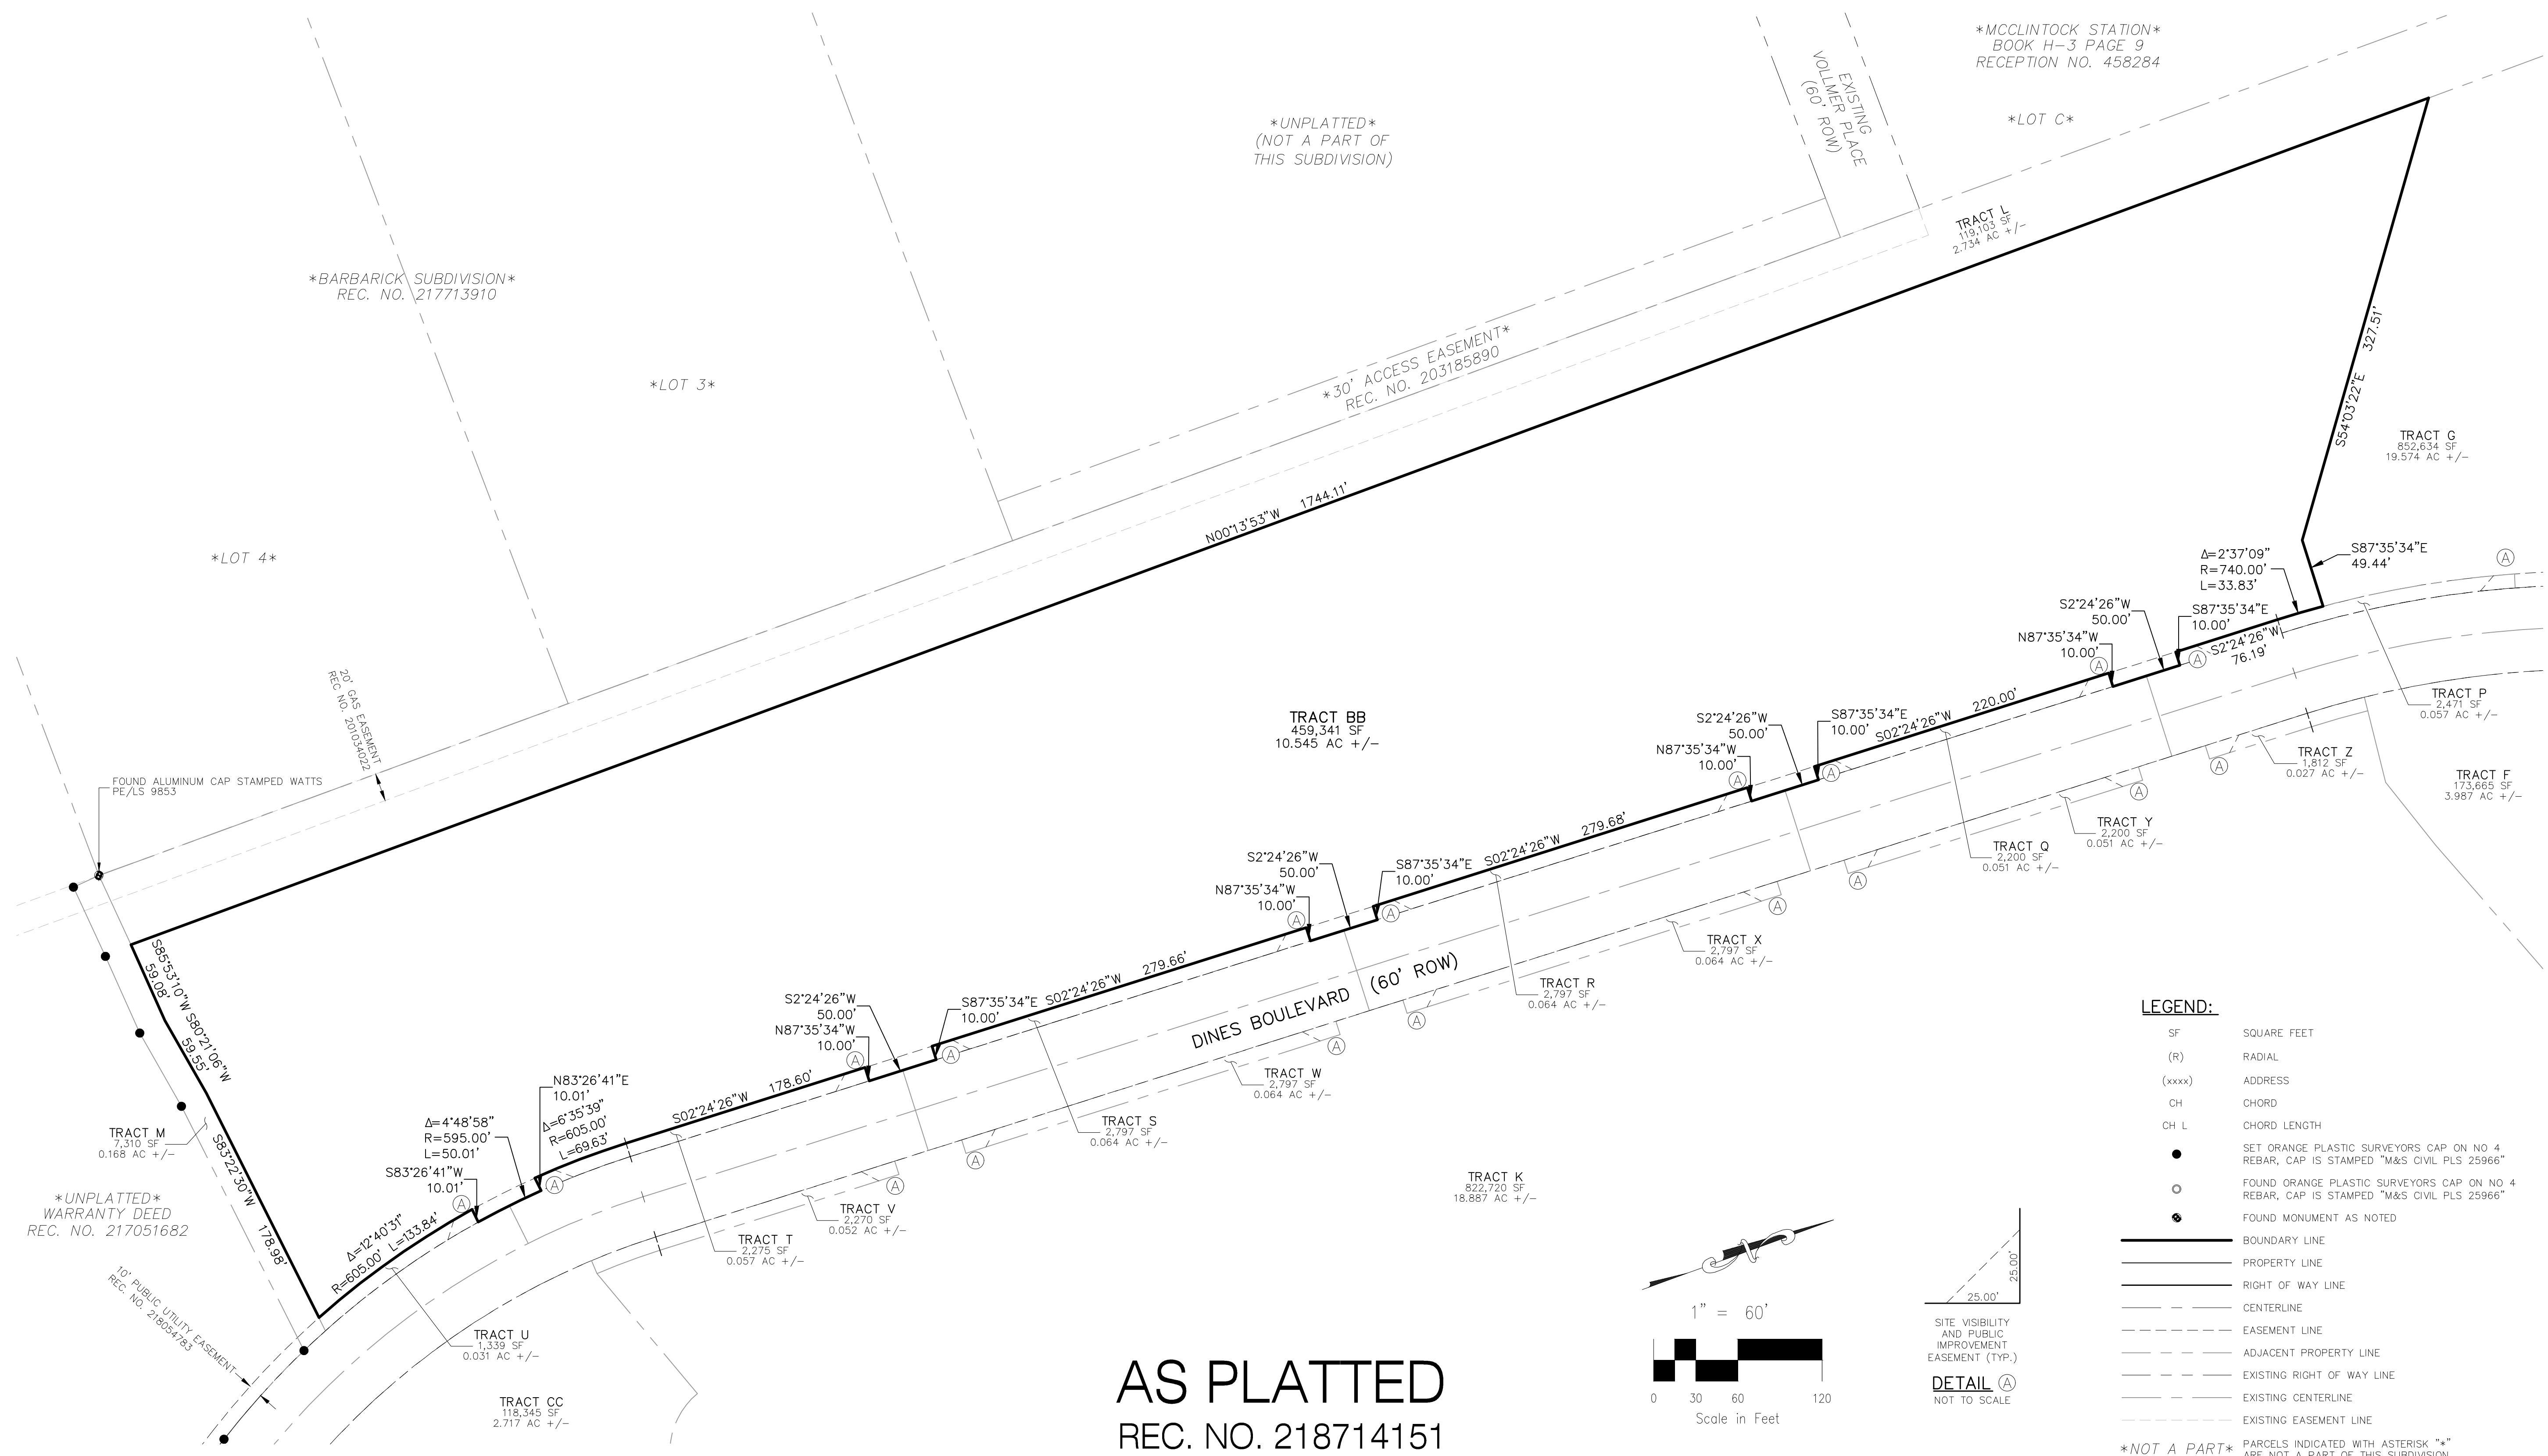

AS PLATTED
REC. NO. 218714151

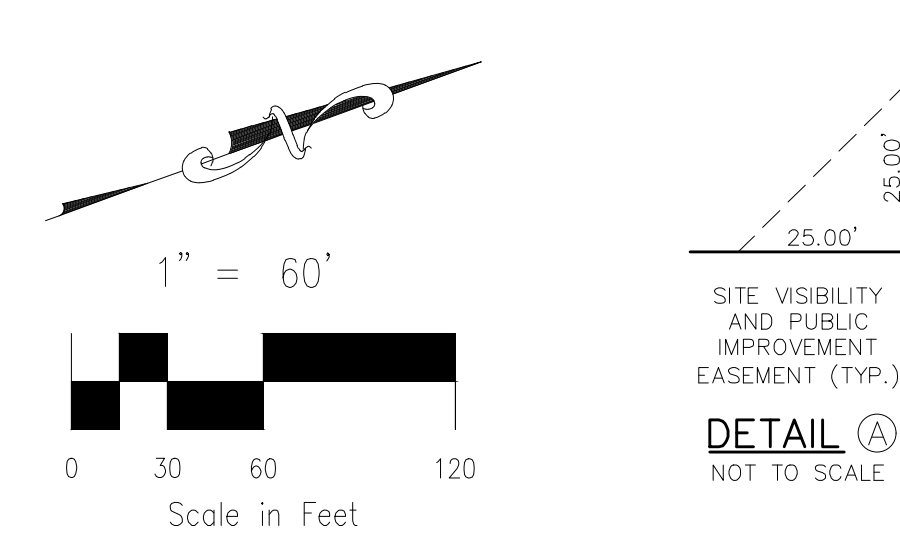

- LEGEND:**
- SF SQUARE FEET
 - (R) RADIAL
 - (xxxx) ADDRESS
 - CH CHORD
 - CH L CHORD LENGTH
 - SET ORANGE PLASTIC SURVEYORS CAP ON NO. 4 REBAR, CAP IS STAMPED "M&S CIVIL PLS 25966"
 - FOUND ORANGE PLASTIC SURVEYORS CAP ON NO. 4 REBAR, CAP IS STAMPED "M&S CIVIL PLS 25966"
 - FOUND MONUMENT AS NOTED
 - BOUNDARY LINE
 - PROPERTY LINE
 - RIGHT OF WAY LINE
 - CENTERLINE
 - EASEMENT LINE
 - ADJACENT PROPERTY LINE
 - EXISTING RIGHT OF WAY LINE
 - EXISTING CENTERLINE
 - EXISTING EASEMENT LINE
- *NOT A PART* PARCELS INDICATED WITH ASTERISK "*" ARE NOT A PART OF THIS SUBDIVISION

FINAL PLAT
BRANDING IRON AT
STERLING RANCH FILING NO. 1
JOB NO. 09-006
DATE PREPARED: 10/30/2017
DATE REVISED: 07/30/2018



20 BOULDER CRESCENT, SUITE 110
COLORADO SPRINGS, CO 80903
PHONE: 719.955.5485

File: C:\900661\Sterling Ranch No. 3\Map\Survey\Plan\09-006 Branding Iron Plat.dwg PlotStamp: 7/30/2018 12:48 PM

BRANDING IRON AT STERLING RANCH FILING NO. 1

A REPLAT OF TRACT BB, "STERLING RANCH FILING NO. 1", SAID TRACT BEING A PORTION OF THE E 1/2 W 1/2 OF SECTION 33, TOWNSHIP 12 SOUTH, RANGE 65 WEST OF THE 6TH PRINCIPAL MERIDIAN, EL PASO COUNTY, COLORADO

MCLINTOCK STATION
BOOK H-3 PAGE 9
RECEPTION NO. 458284



RIGHT-OF-WAY CURVE TABLE			
CURVE #	LENGTH	RADIUS	DELTA
RC1	24.21	30.00	46°14'47"
RC2	27.72	30.00	52°56'48"
RC3	25.01	595.00	2°24'29"
RC4	25.01	595.00	2°24'29"
RC5	26.01	30.00	49°40'47"
RC6	26.01	30.00	49°40'47"
RC7	26.01	30.00	49°40'47"
RC8	26.01	30.00	49°40'47"
RC9	26.01	30.00	49°40'47"
RC10	26.01	30.00	49°40'47"
RC11	26.01	30.00	49°40'47"
RC12	26.01	30.00	49°40'47"

LOT & TRACT CURVE TABLE			
CURVE #	LENGTH	RADIUS	DELTA
C1	17.77	30.00	33°56'01"
C2	6.45	30.00	12°18'45"
C3	27.85	55.00	29°00'39"
C4	13.00	30.00	24°49'58"
C5	13.01	30.00	24°50'49"
C6	7.21	30.00	13°45'39"
C7	18.81	30.00	35°55'08"
C8	2.41	30.00	4°36'03"
C9	23.60	30.00	45°04'44"
C10	16.11	30.00	30°45'42"
C11	9.91	30.00	18°55'05"
C12	23.80	30.00	45°26'58"
C13	2.21	30.00	4°13'49"
C14	24.22	275.00	5°02'44"
C15	10.19	275.00	2°07'25"
C16	4.91	30.00	9°23'07"
C17	21.10	30.00	40°17'40"
C18	31.49	55.00	32°48'28"
C19	25.49	55.00	26°32'57"
C20	23.47	225.00	5°58'35"

LOT & TRACT CURVE TABLE		
LINE #	DISTANCE	BEARING
L1	16.45	N83°26'41"E
L2	19.80	S75°37'56"W
L3	2.35	S87°35'34"E
L4	6.54	S87°35'34"E
L5	16.84	N87°35'34"W
L6	12.75	N69°40'03"W
L7	6.82	S54°03'22"E

RIGHT-OF-WAY LINE TABLE		
LINE #	BEARING	DISTANCE
RL1	S87°35'34"E	40.81
RL2	N87°35'34"W	40.81

CENTERLINE LINE TABLE		
LINE #	BEARING	DISTANCE
CL1	S06°33'19"E	3.78

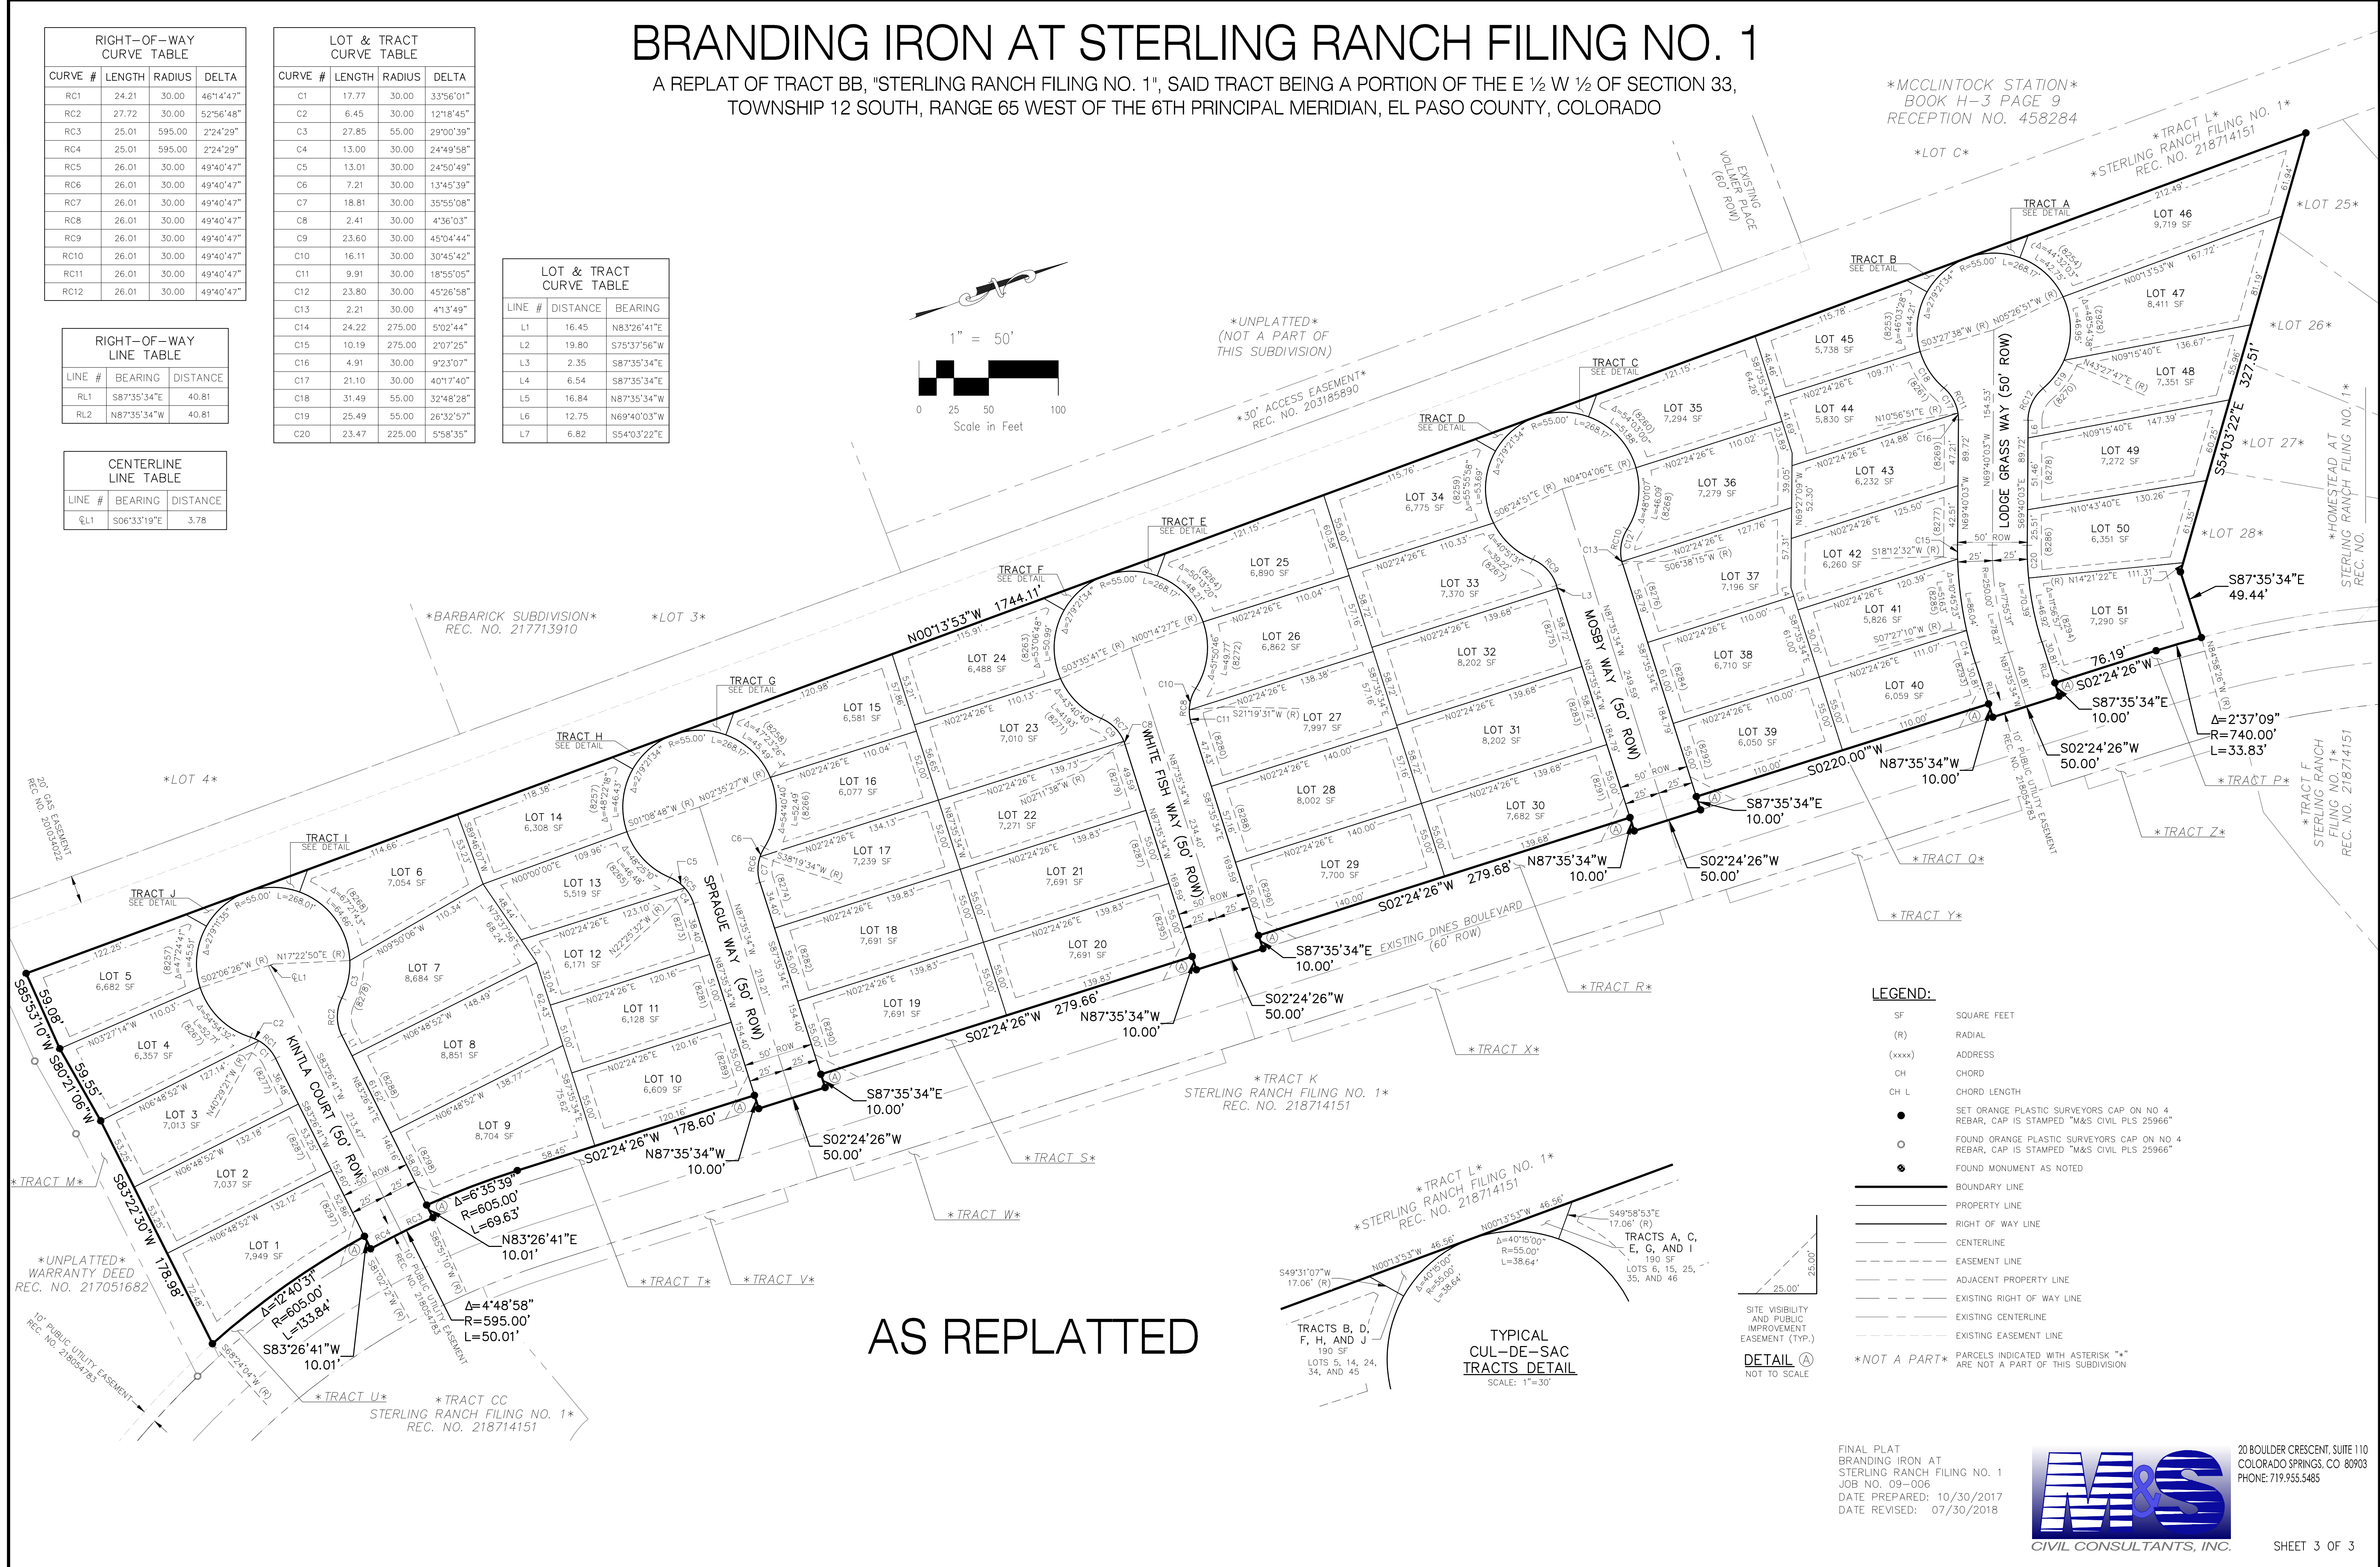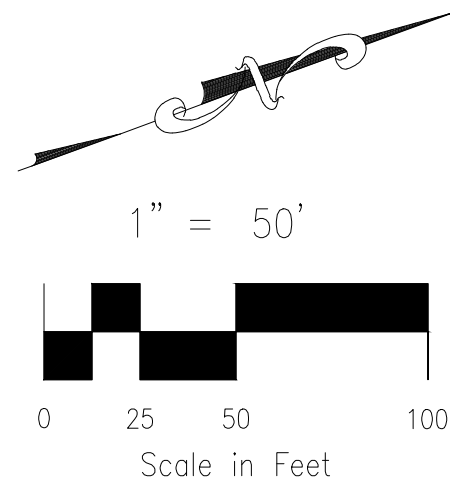

AS REPLATTED

LEGEND:

- SF SQUARE FEET
- (R) RADIAL
- (xxxx) ADDRESS
- CH CHORD
- CH L CHORD LENGTH
- SET ORANGE PLASTIC SURVEYORS CAP ON NO 4 REBAR, CAP IS STAMPED "M&S CIVIL PLS 25966"
- FOUND ORANGE PLASTIC SURVEYORS CAP ON NO 4 REBAR, CAP IS STAMPED "M&S CIVIL PLS 25966"
- FOUND MONUMENT AS NOTED
- BOUNDARY LINE
- PROPERTY LINE
- RIGHT OF WAY LINE
- CENTERLINE
- EASEMENT LINE
- ADJACENT PROPERTY LINE
- EXISTING RIGHT OF WAY LINE
- EXISTING CENTERLINE
- EXISTING EASEMENT LINE
- *NOT A PART* PARCELS INDICATED WITH ASTERISK "*" ARE NOT A PART OF THIS SUBDIVISION

SITE VISIBILITY AND PUBLIC IMPROVEMENT EASEMENT (TYP.)
DETAIL A
NOT TO SCALE

TYPICAL CUL-DE-SAC TRACTS A, C, E, G, AND I
SCALE: 1"=30'

FINAL PLAT
BRANDING IRON AT
STERLING RANCH FILING NO. 1
JOB NO. 09-006
DATE PREPARED: 10/30/2017
DATE REVISED: 07/30/2018



20 BOULDER CRESCENT, SUITE 110
COLORADO SPRINGS, CO 80903
PHONE: 719.955.5465

Markup Summary

dsdparsons (3)



Subject: Callout
Page Label: 1
Author: dsdparsons
Date: 10/18/2018 2:38:56 PM
Color: ■

Easment for the access note _____



Subject: Callout
Page Label: 1
Author: dsdparsons
Date: 10/18/2018 3:01:53 PM
Color: ■

Escrow Agrrment note shall be aded and the reception no. _____



Subject: Callout
Page Label: 1
Author: dsdparsons
Date: 10/18/2018 3:04:09 PM
Color: ■

You need to put the relative info from a title search post the filing 1 plat and changes since June.