



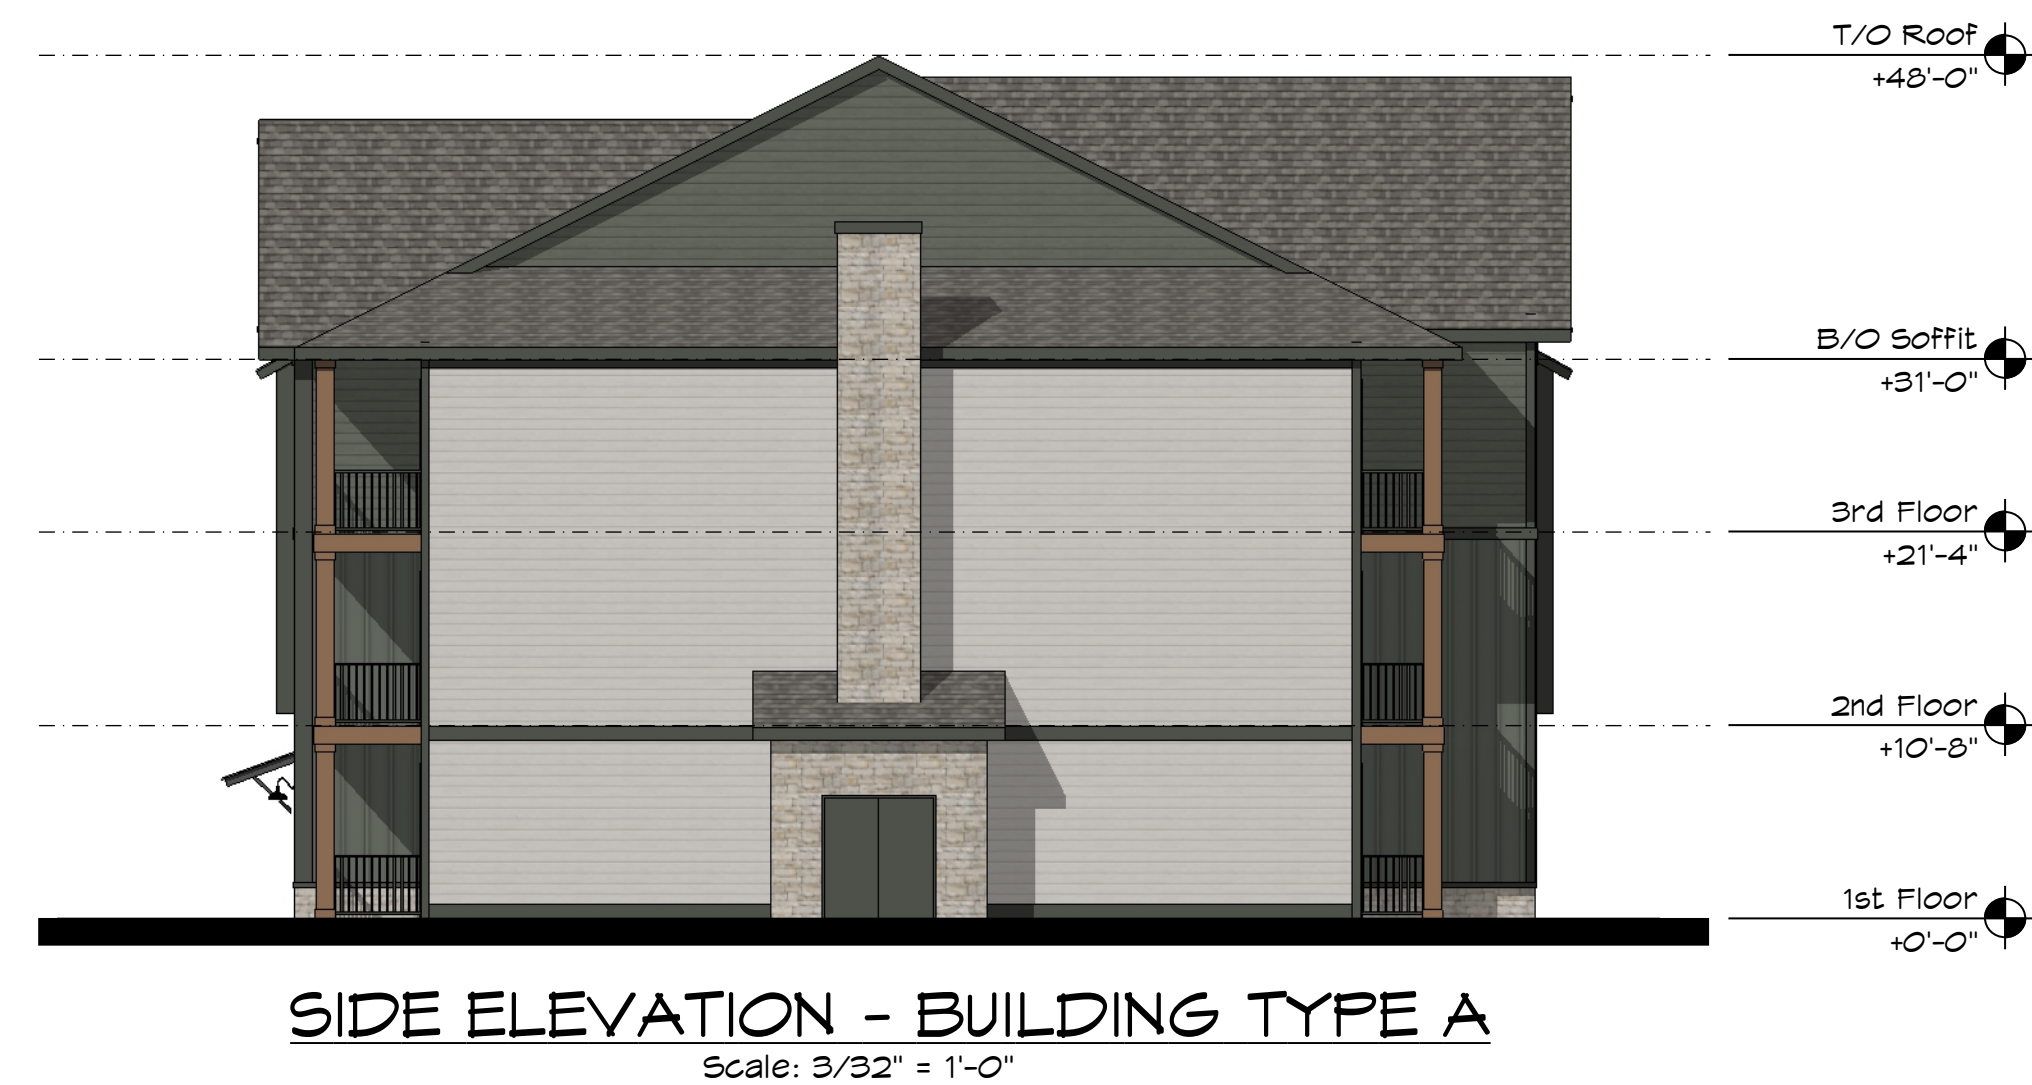
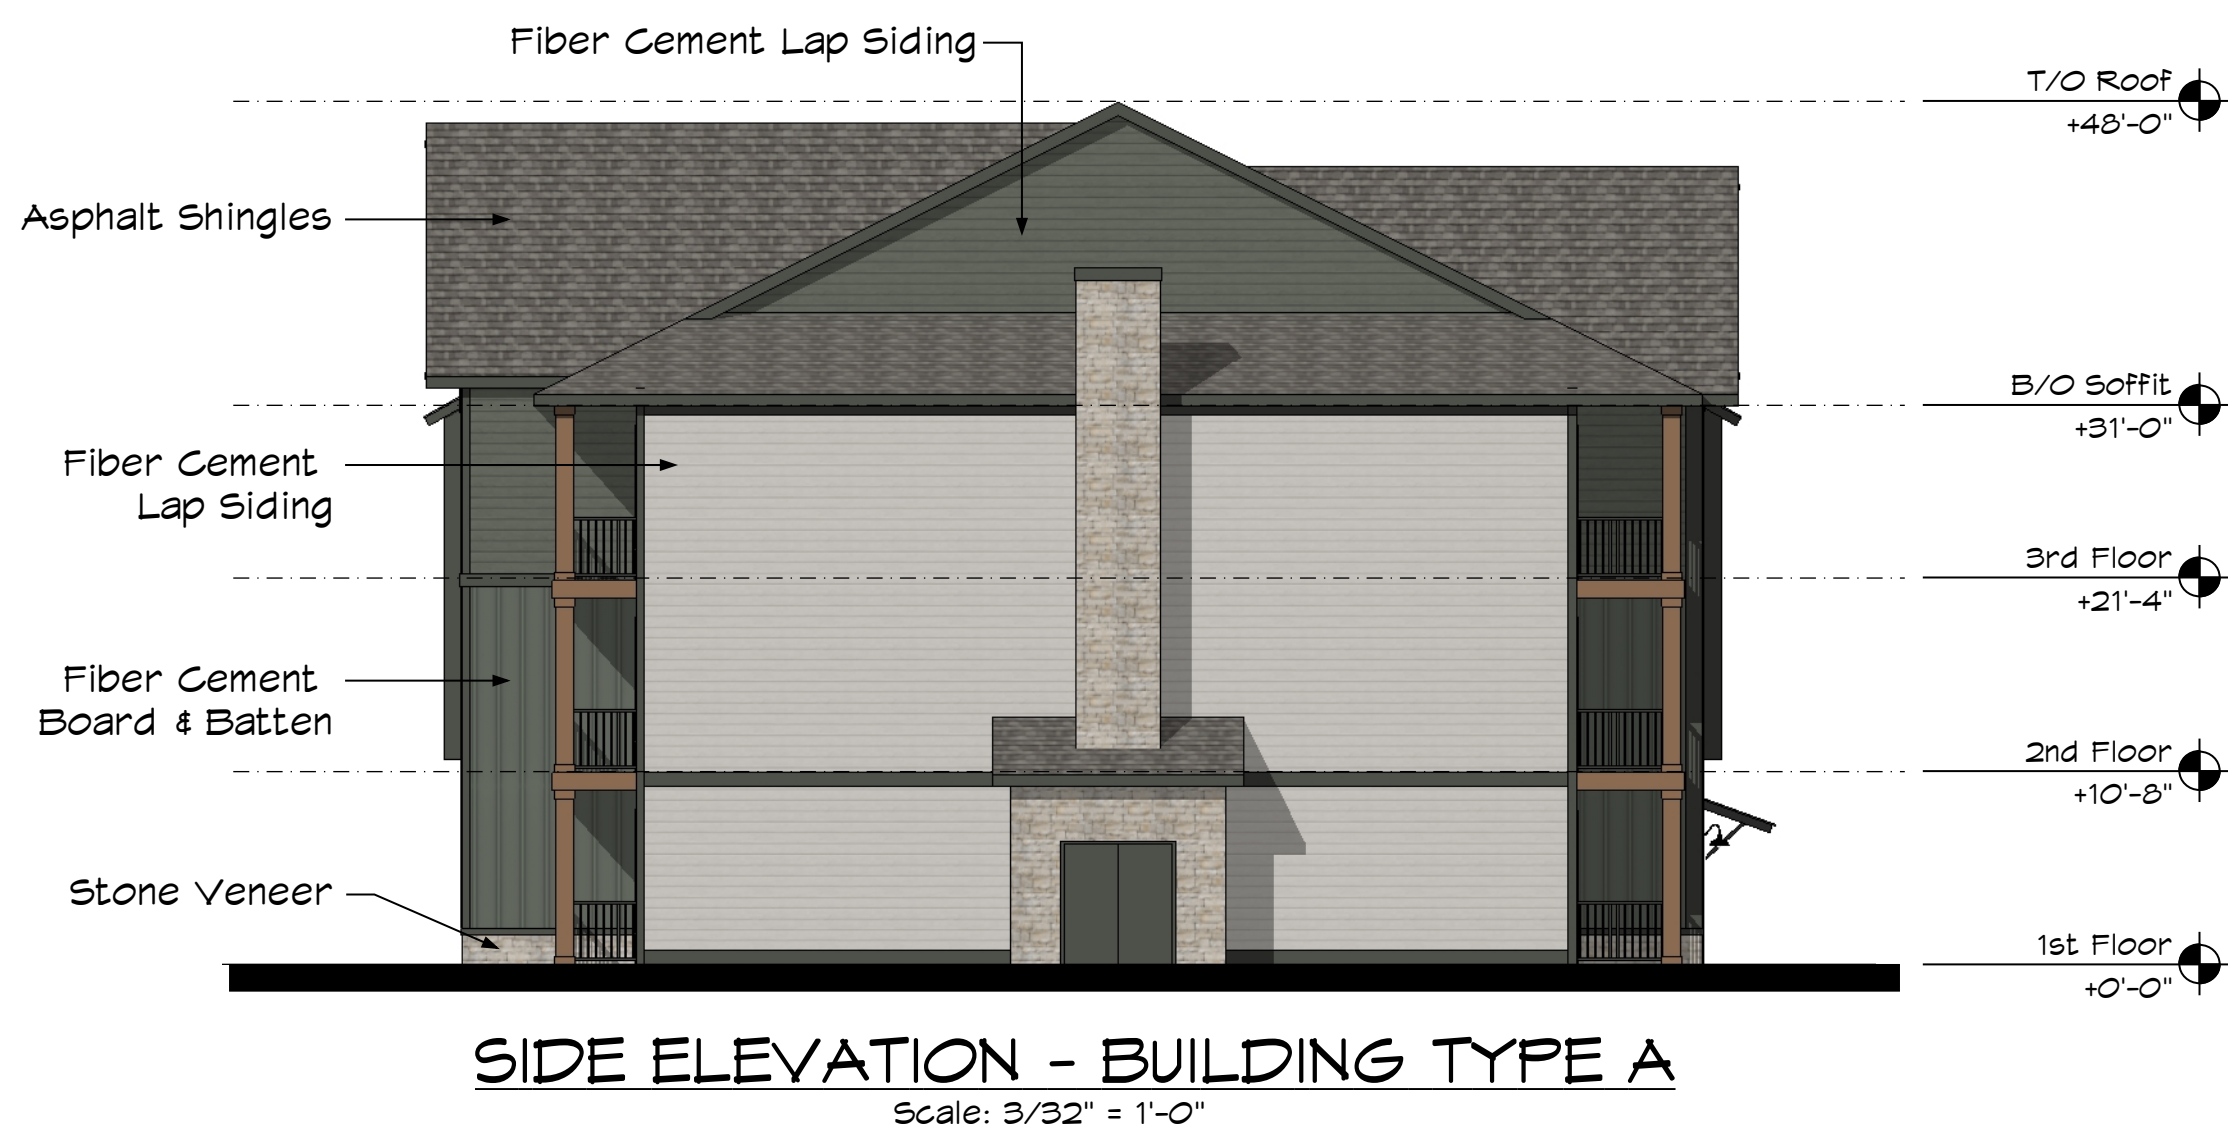
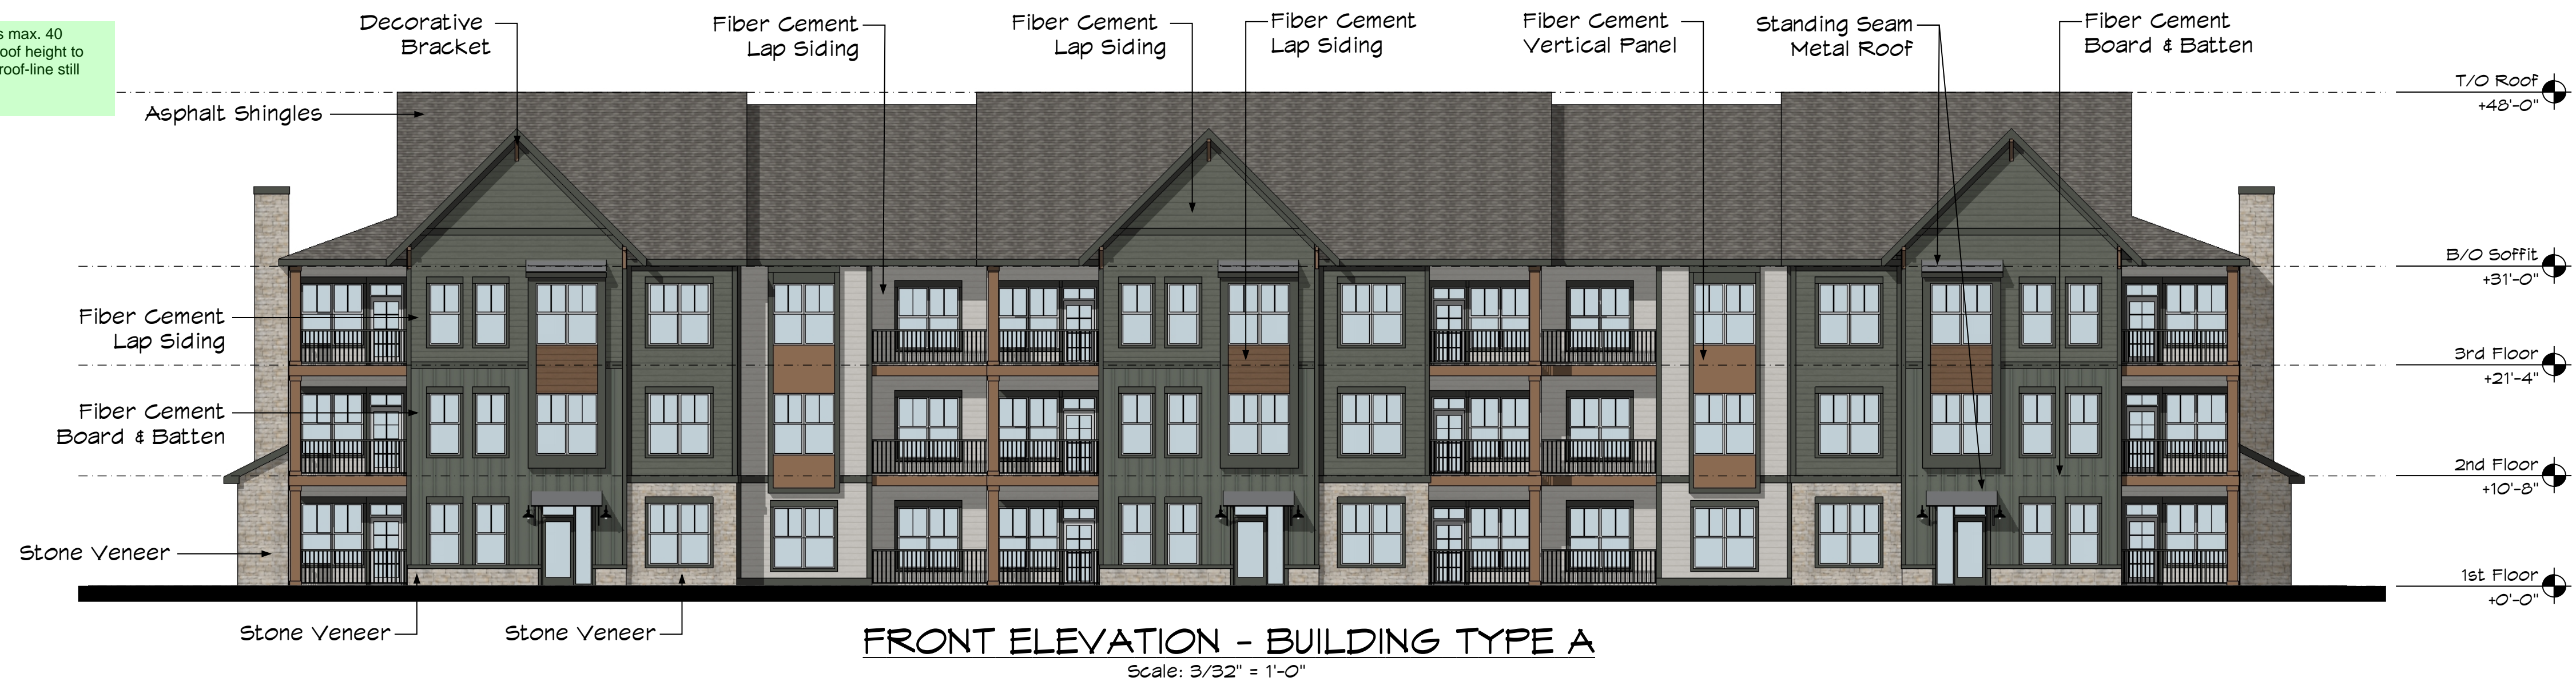
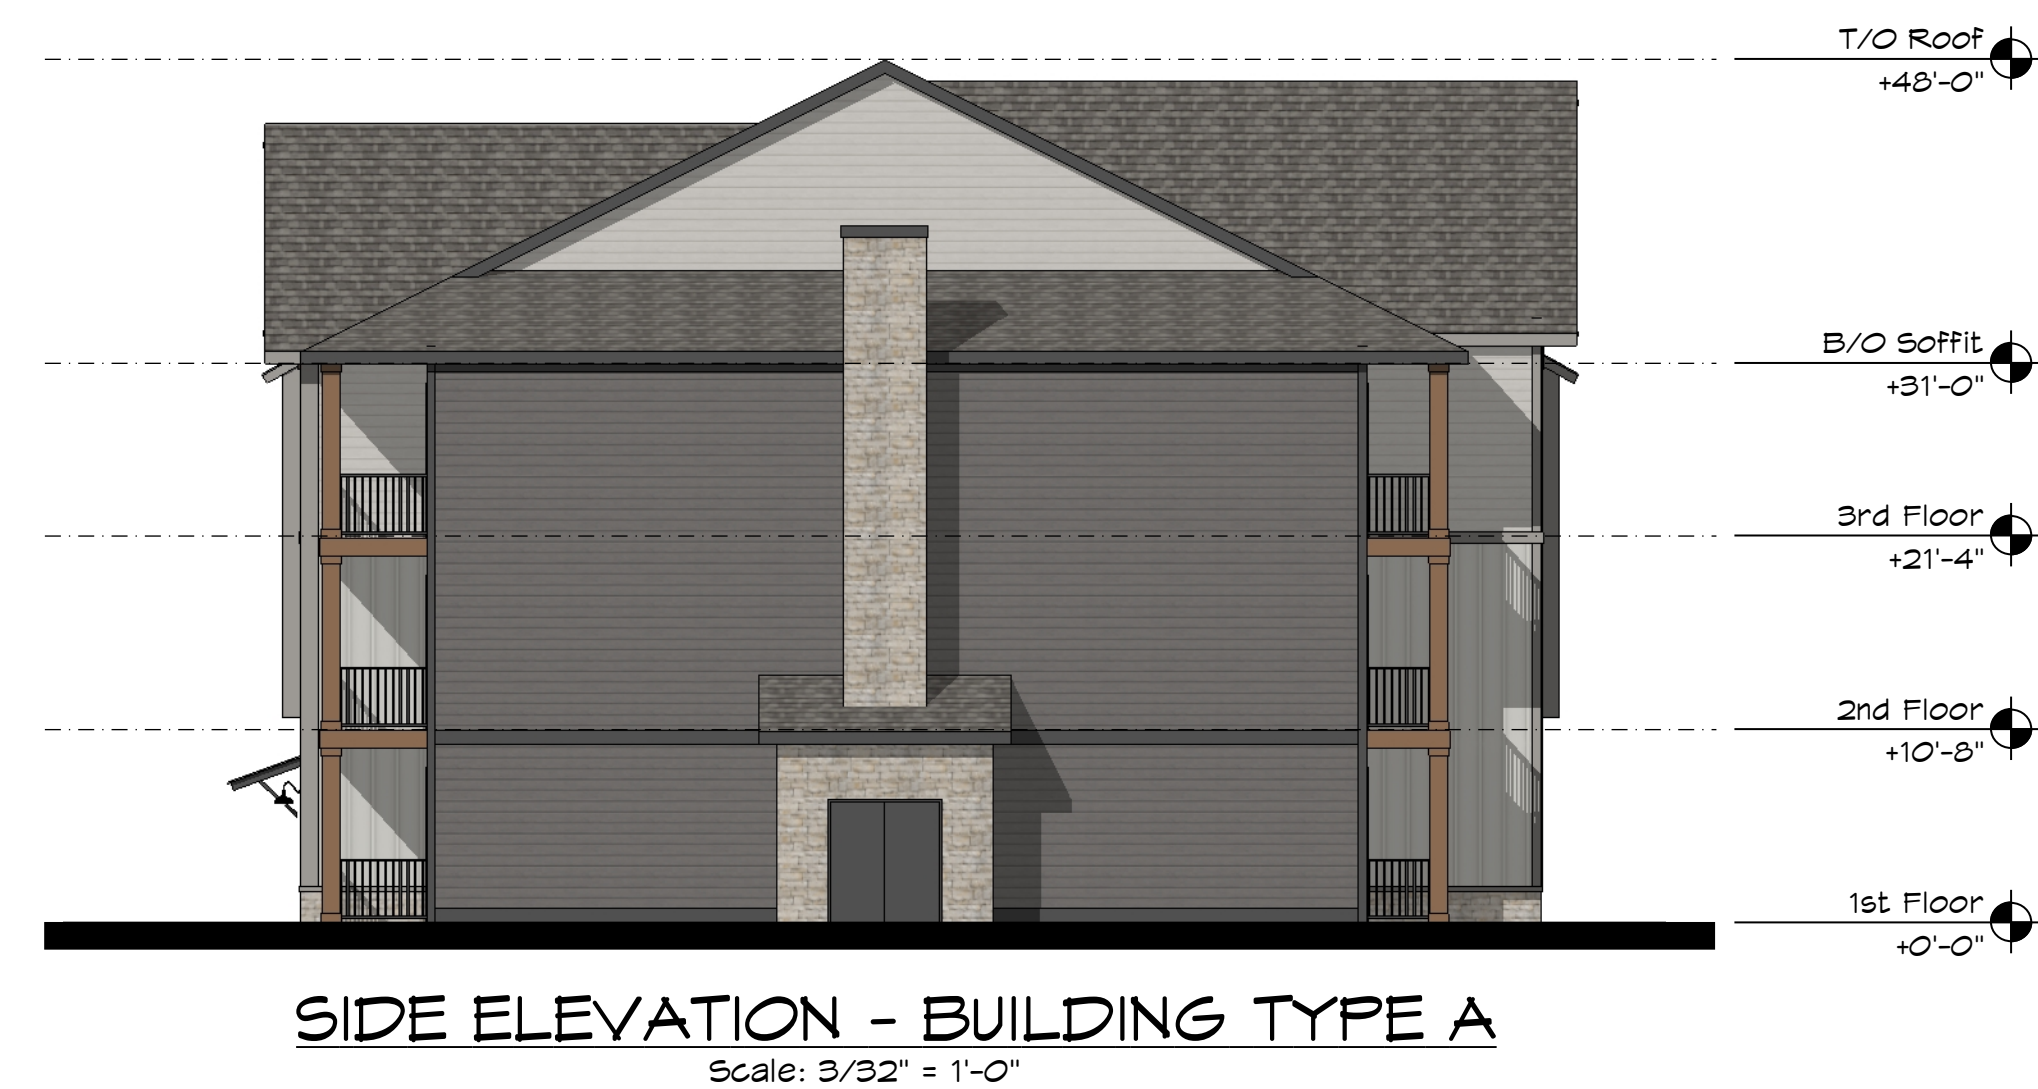
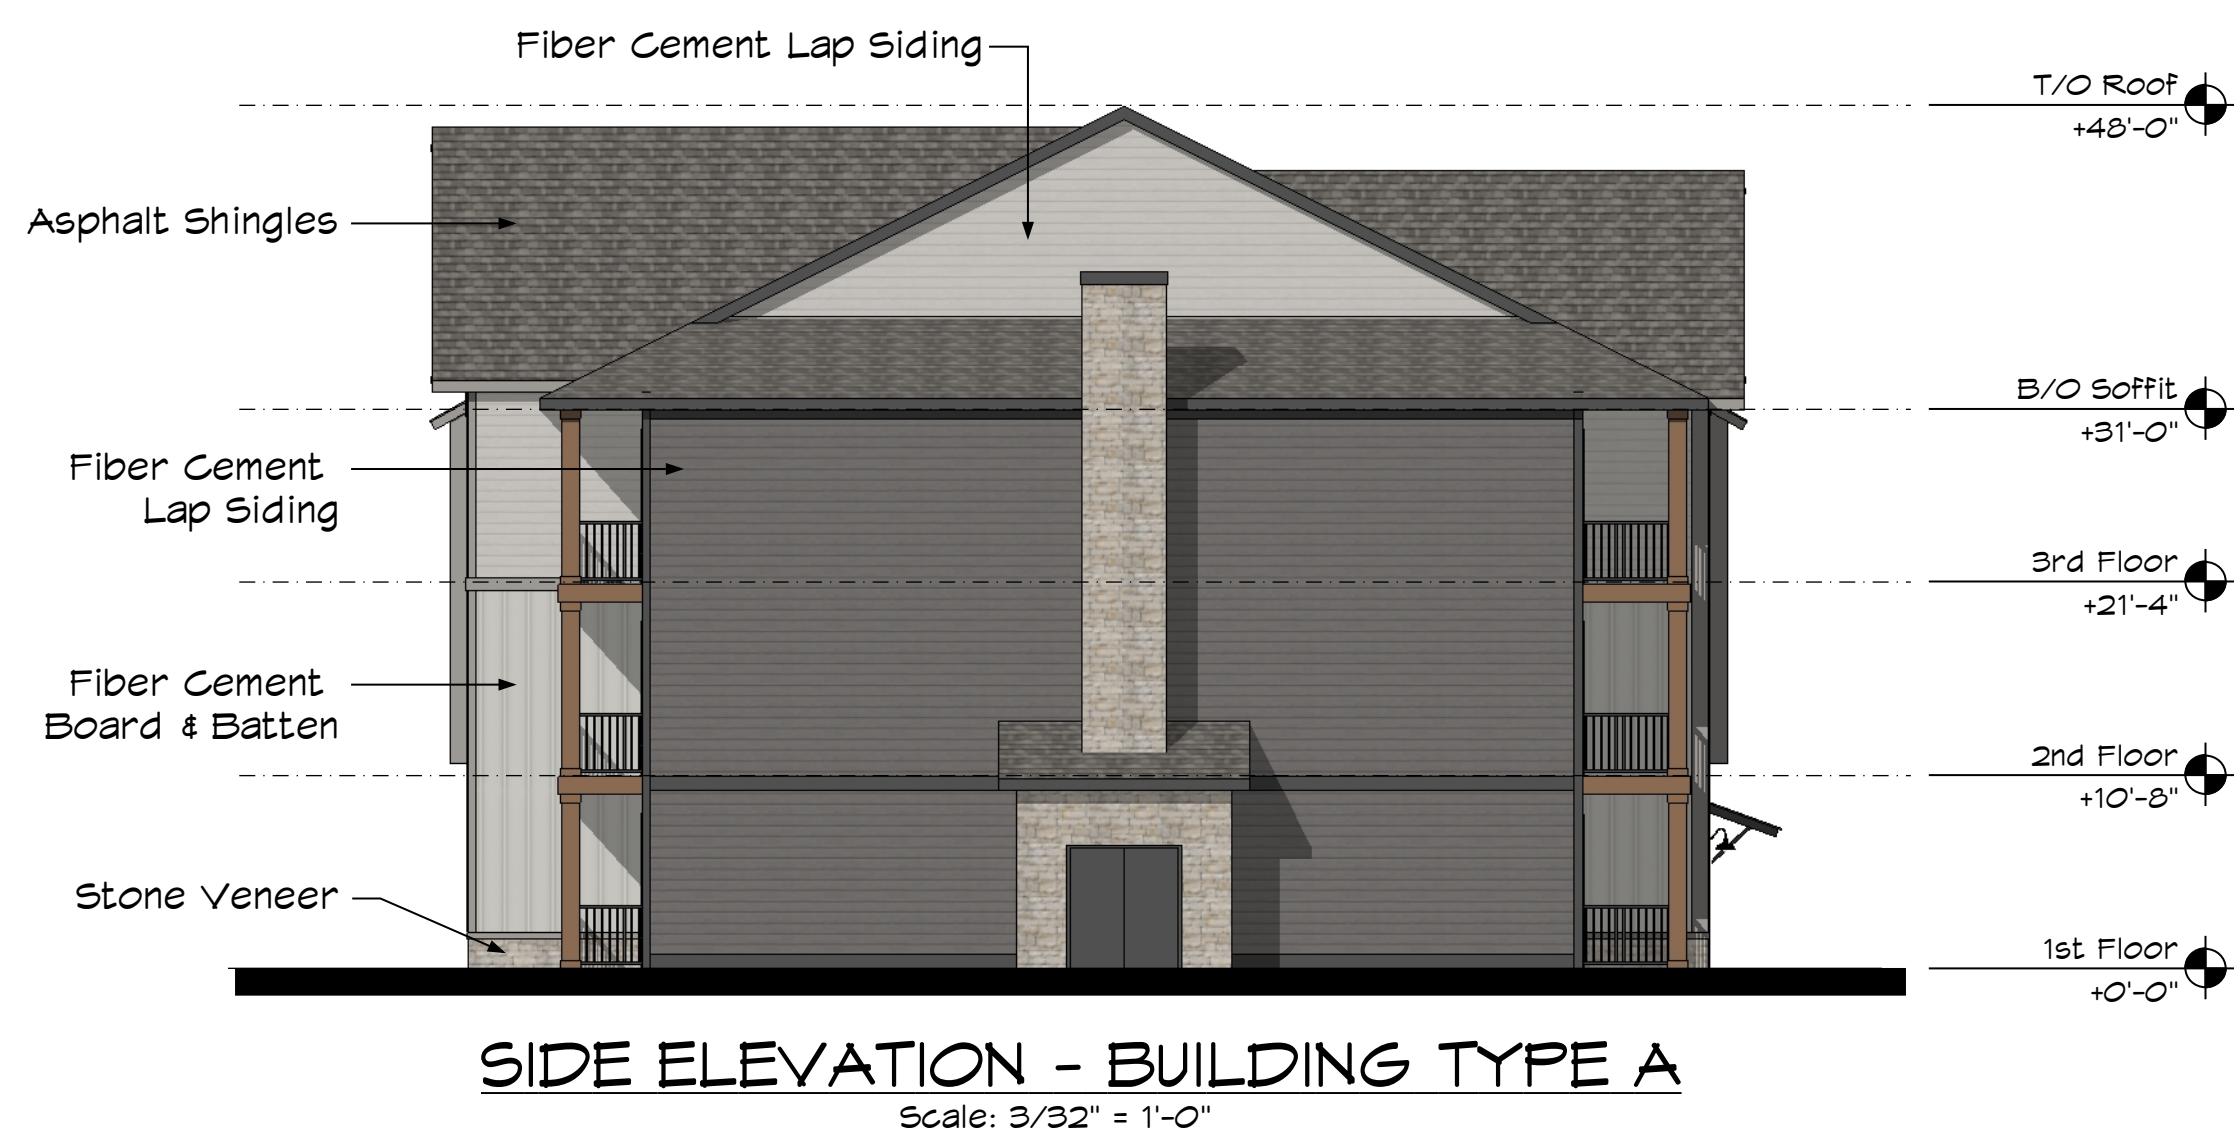
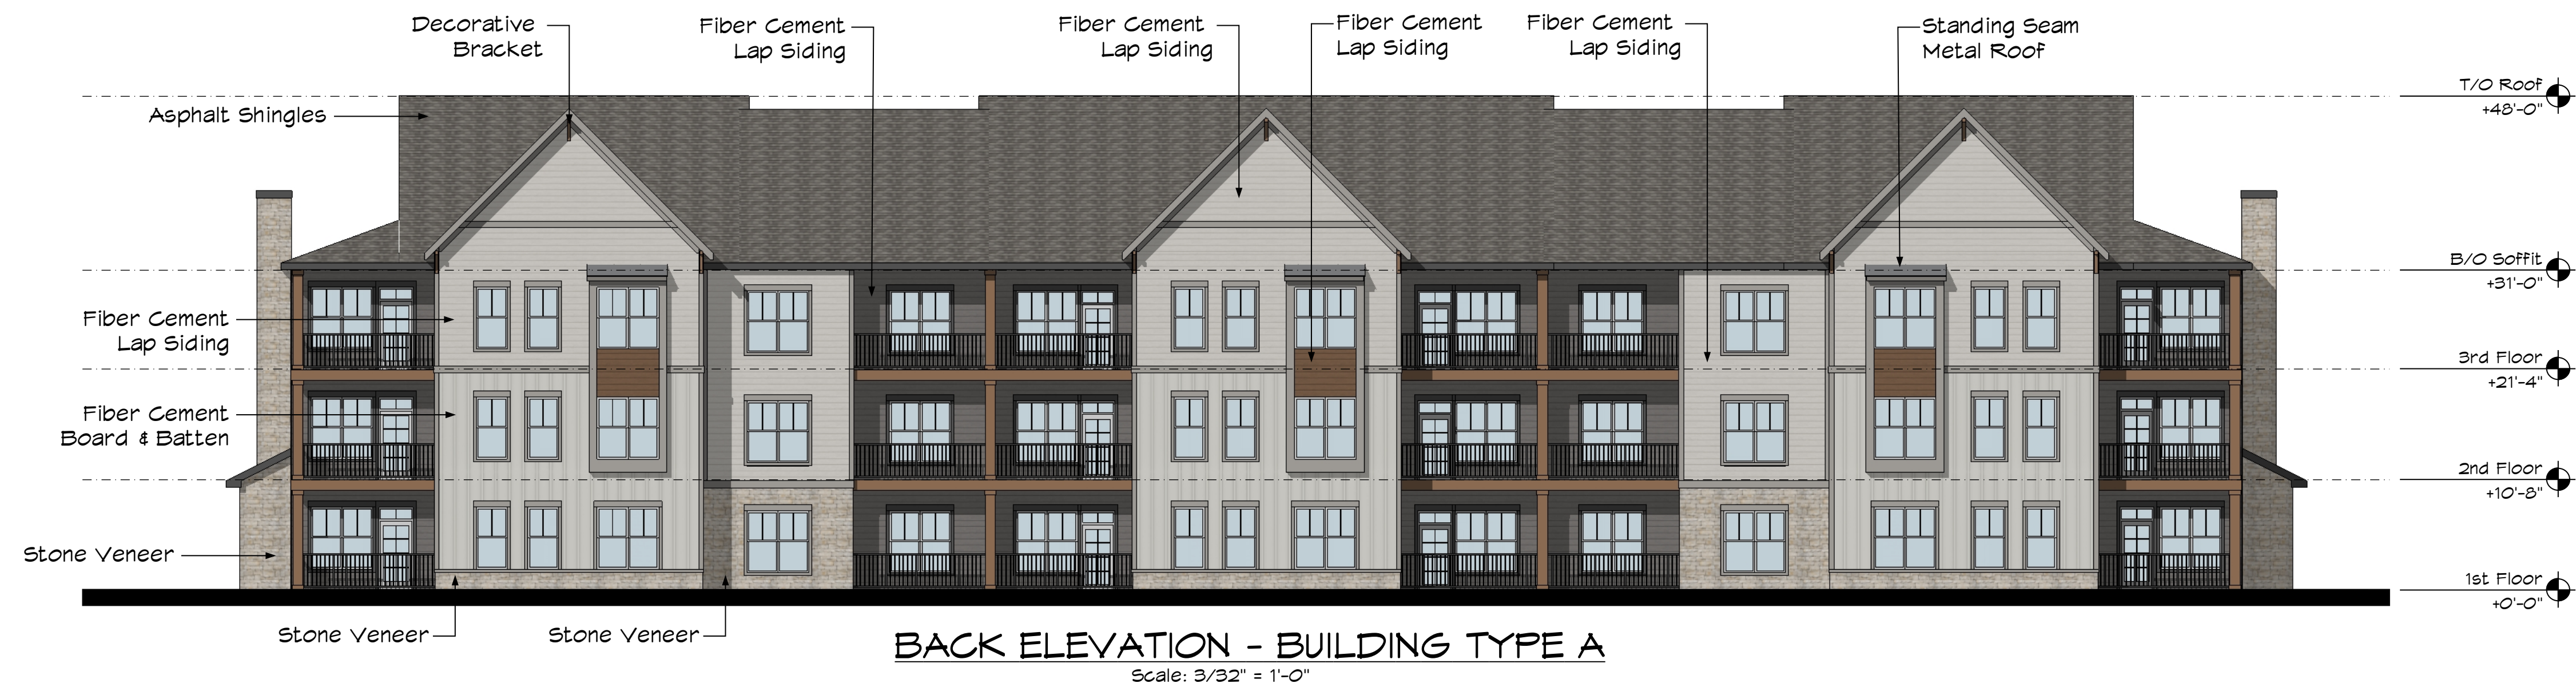
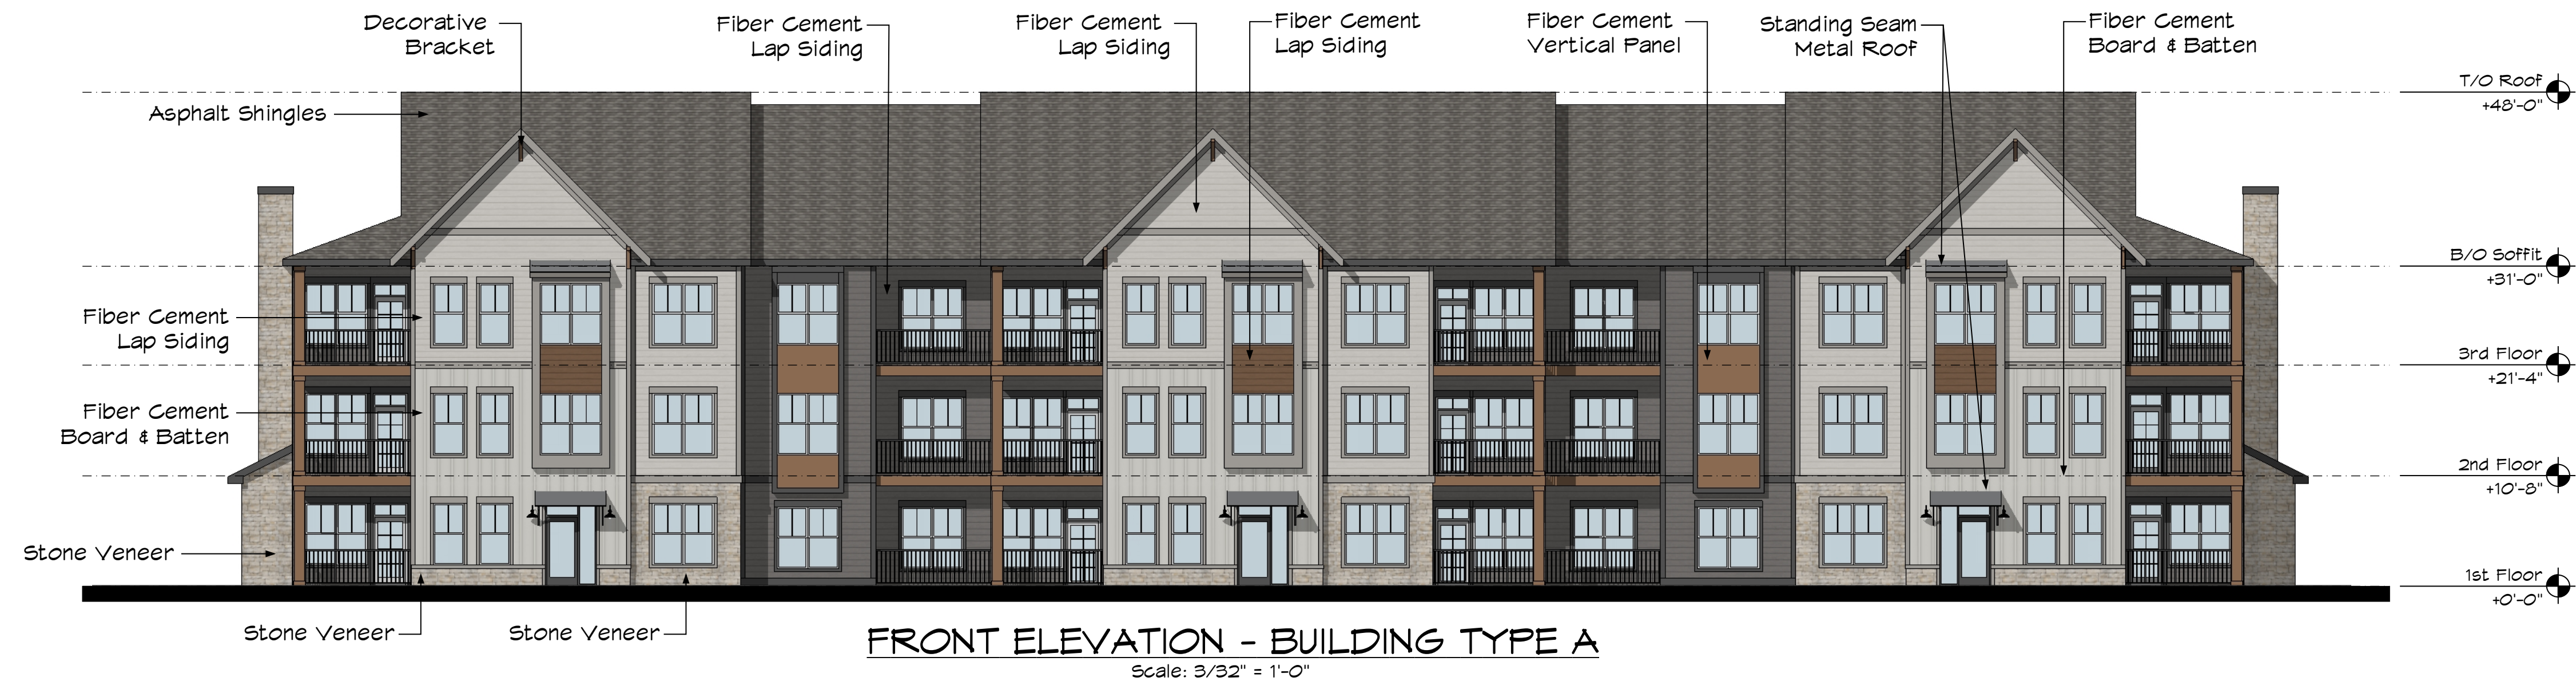
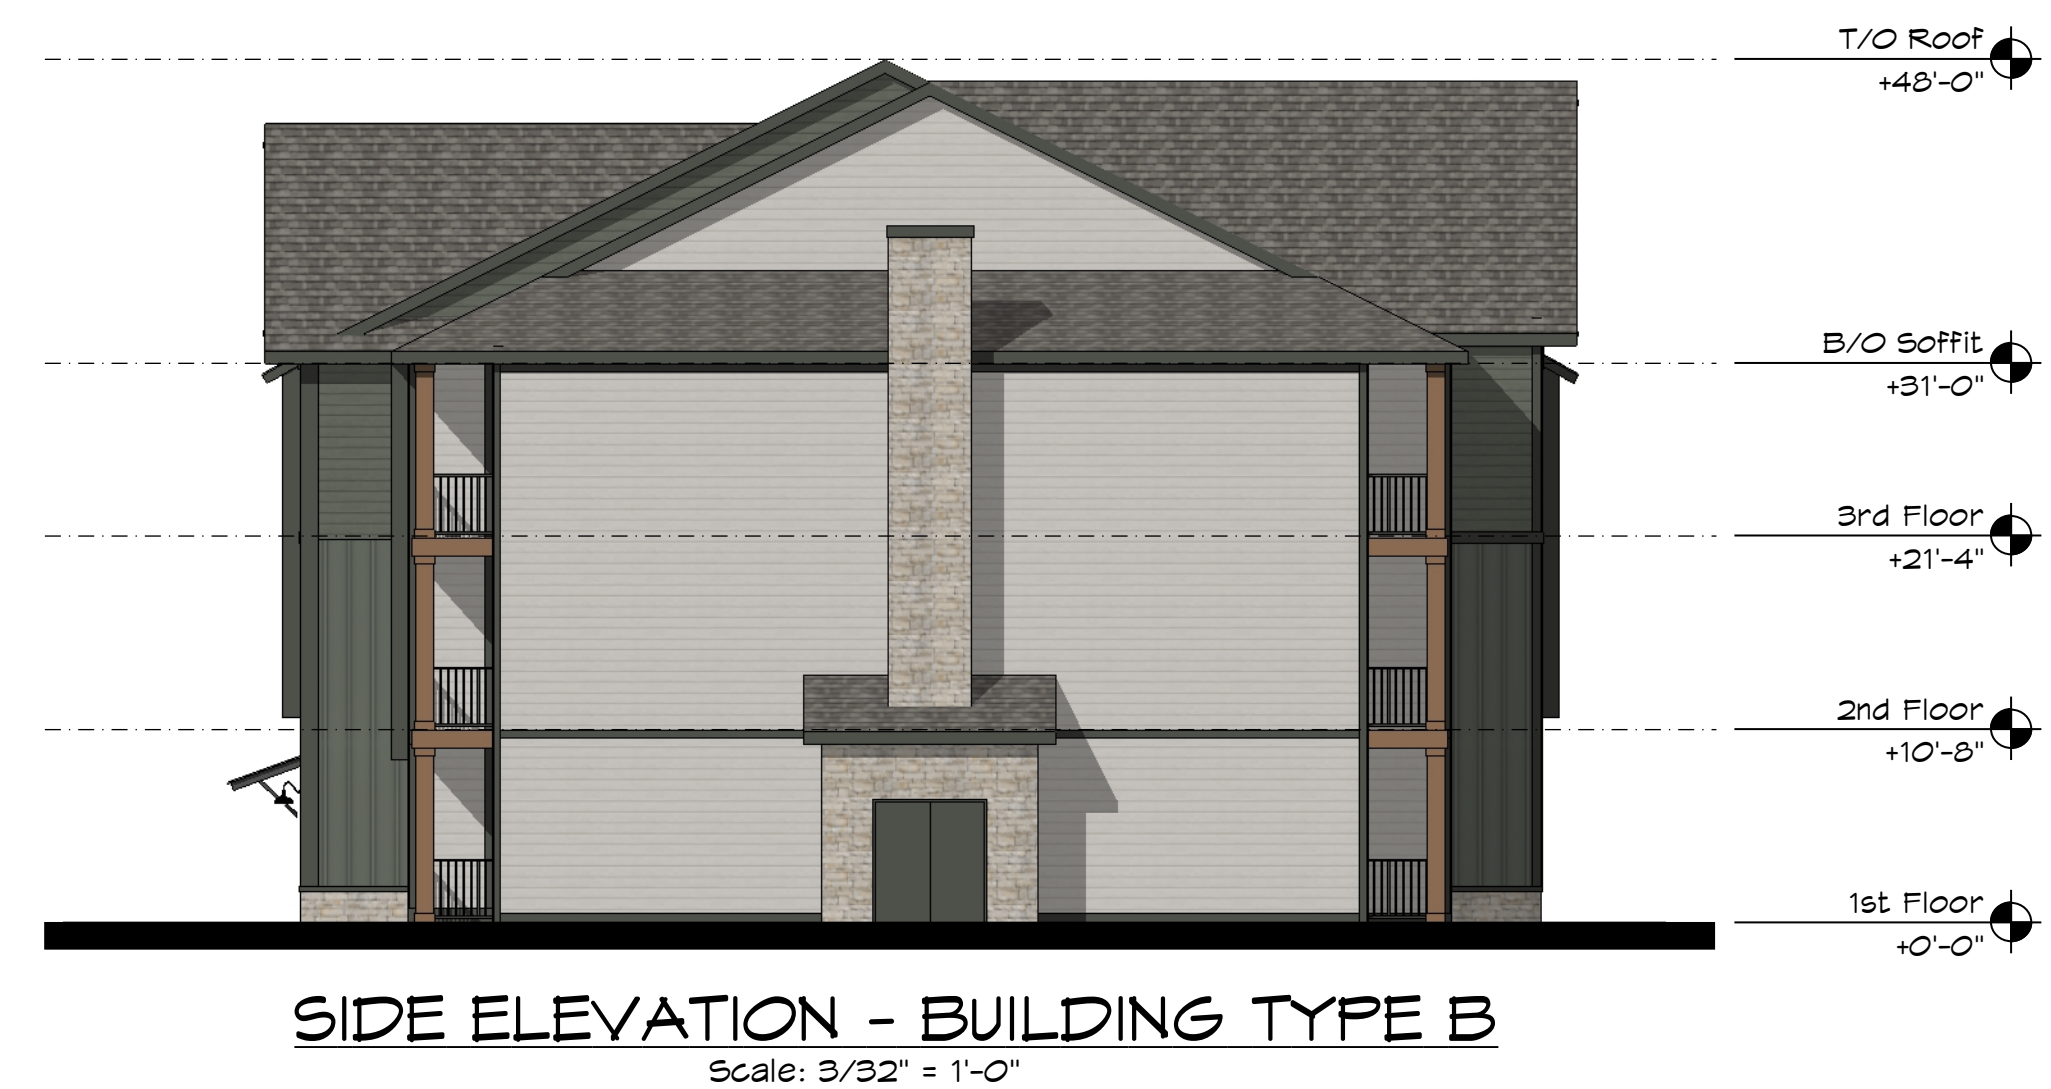
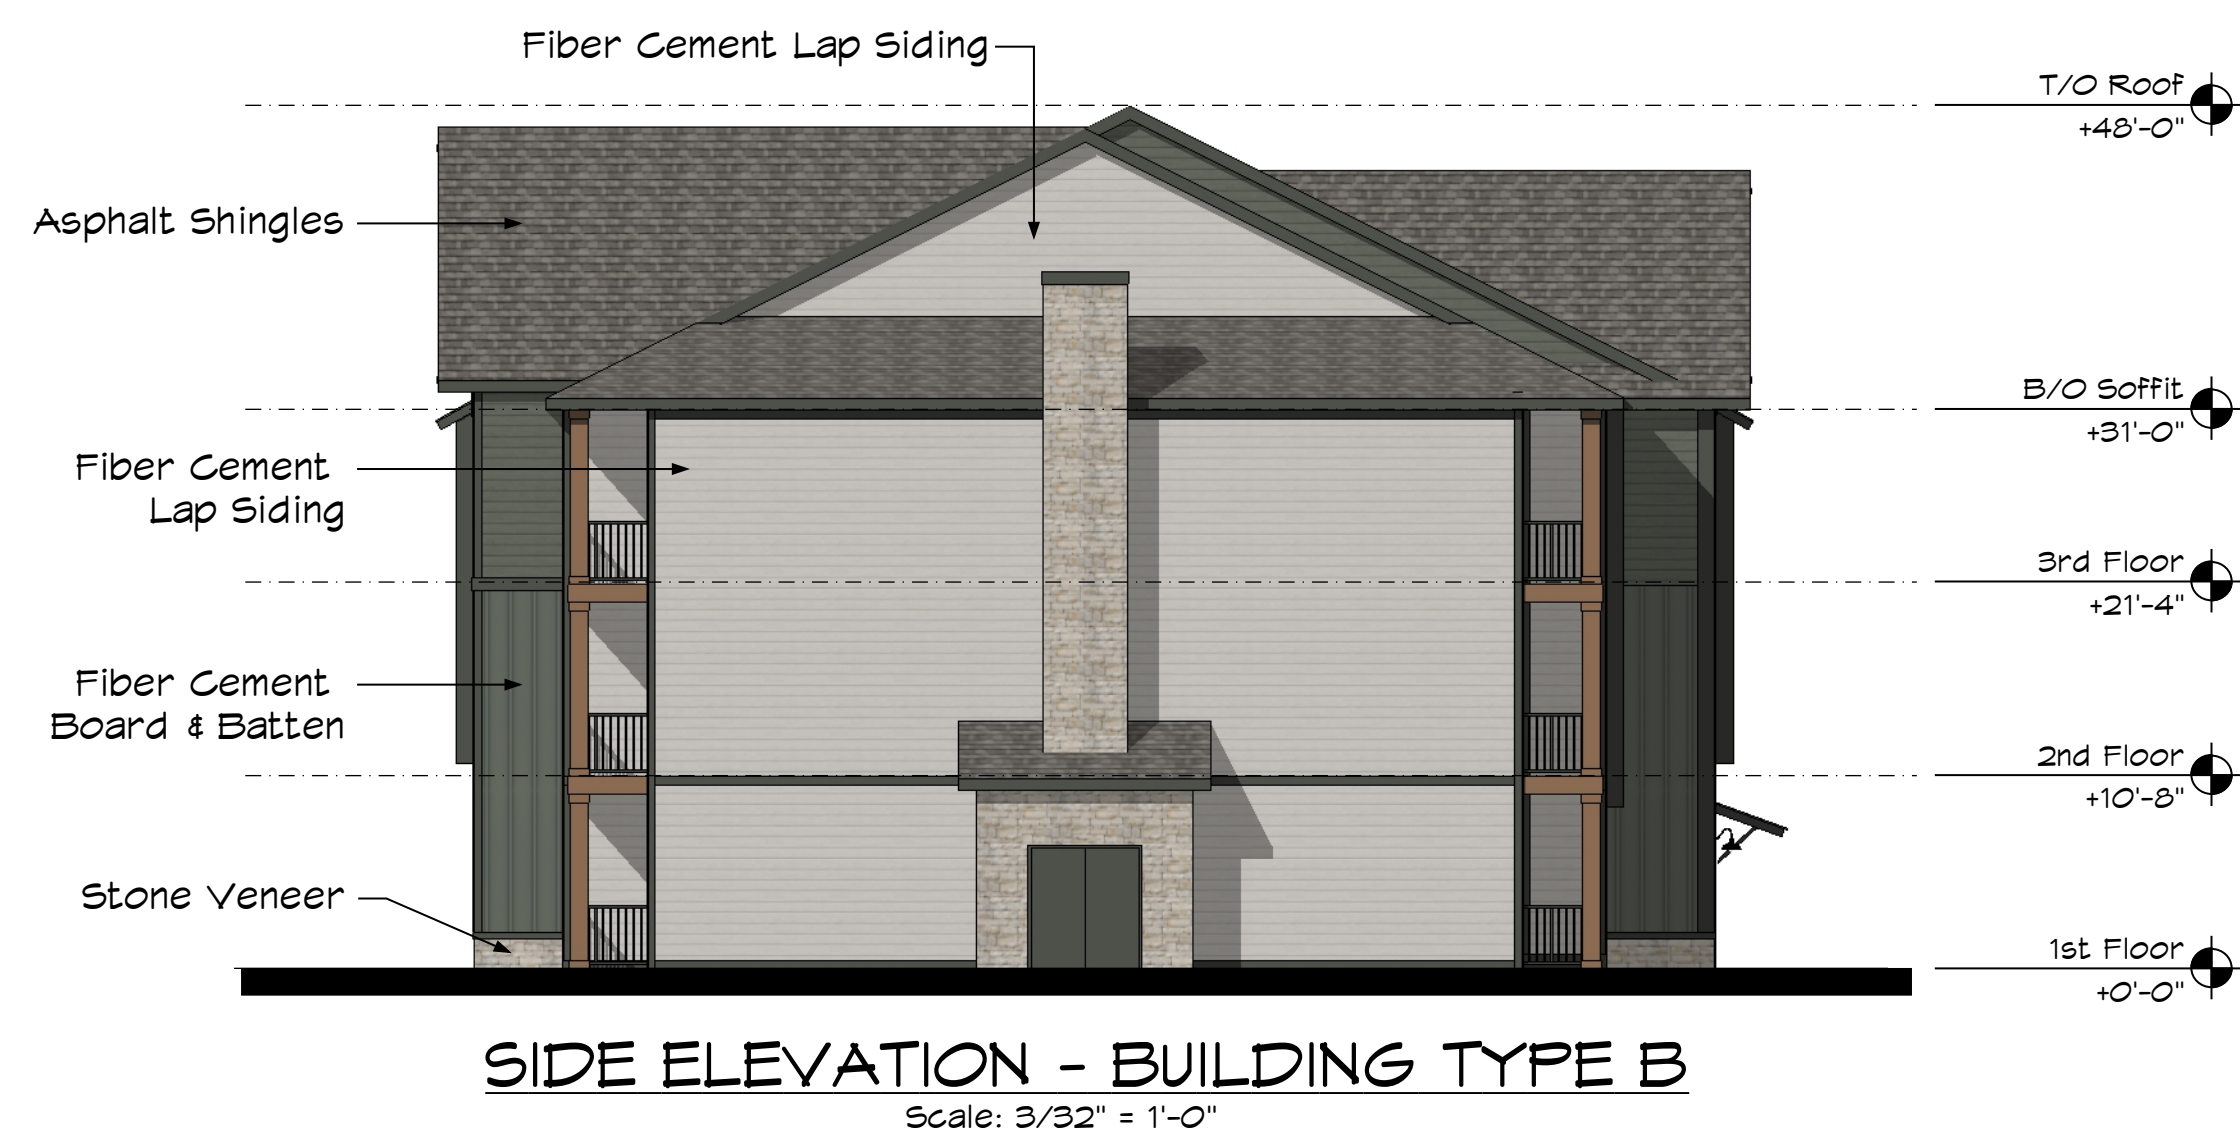



Because allowed building height is max. 40 height, please show the average roof height to demonstrate that the 48' to top of roof-line still meets the height limitations.




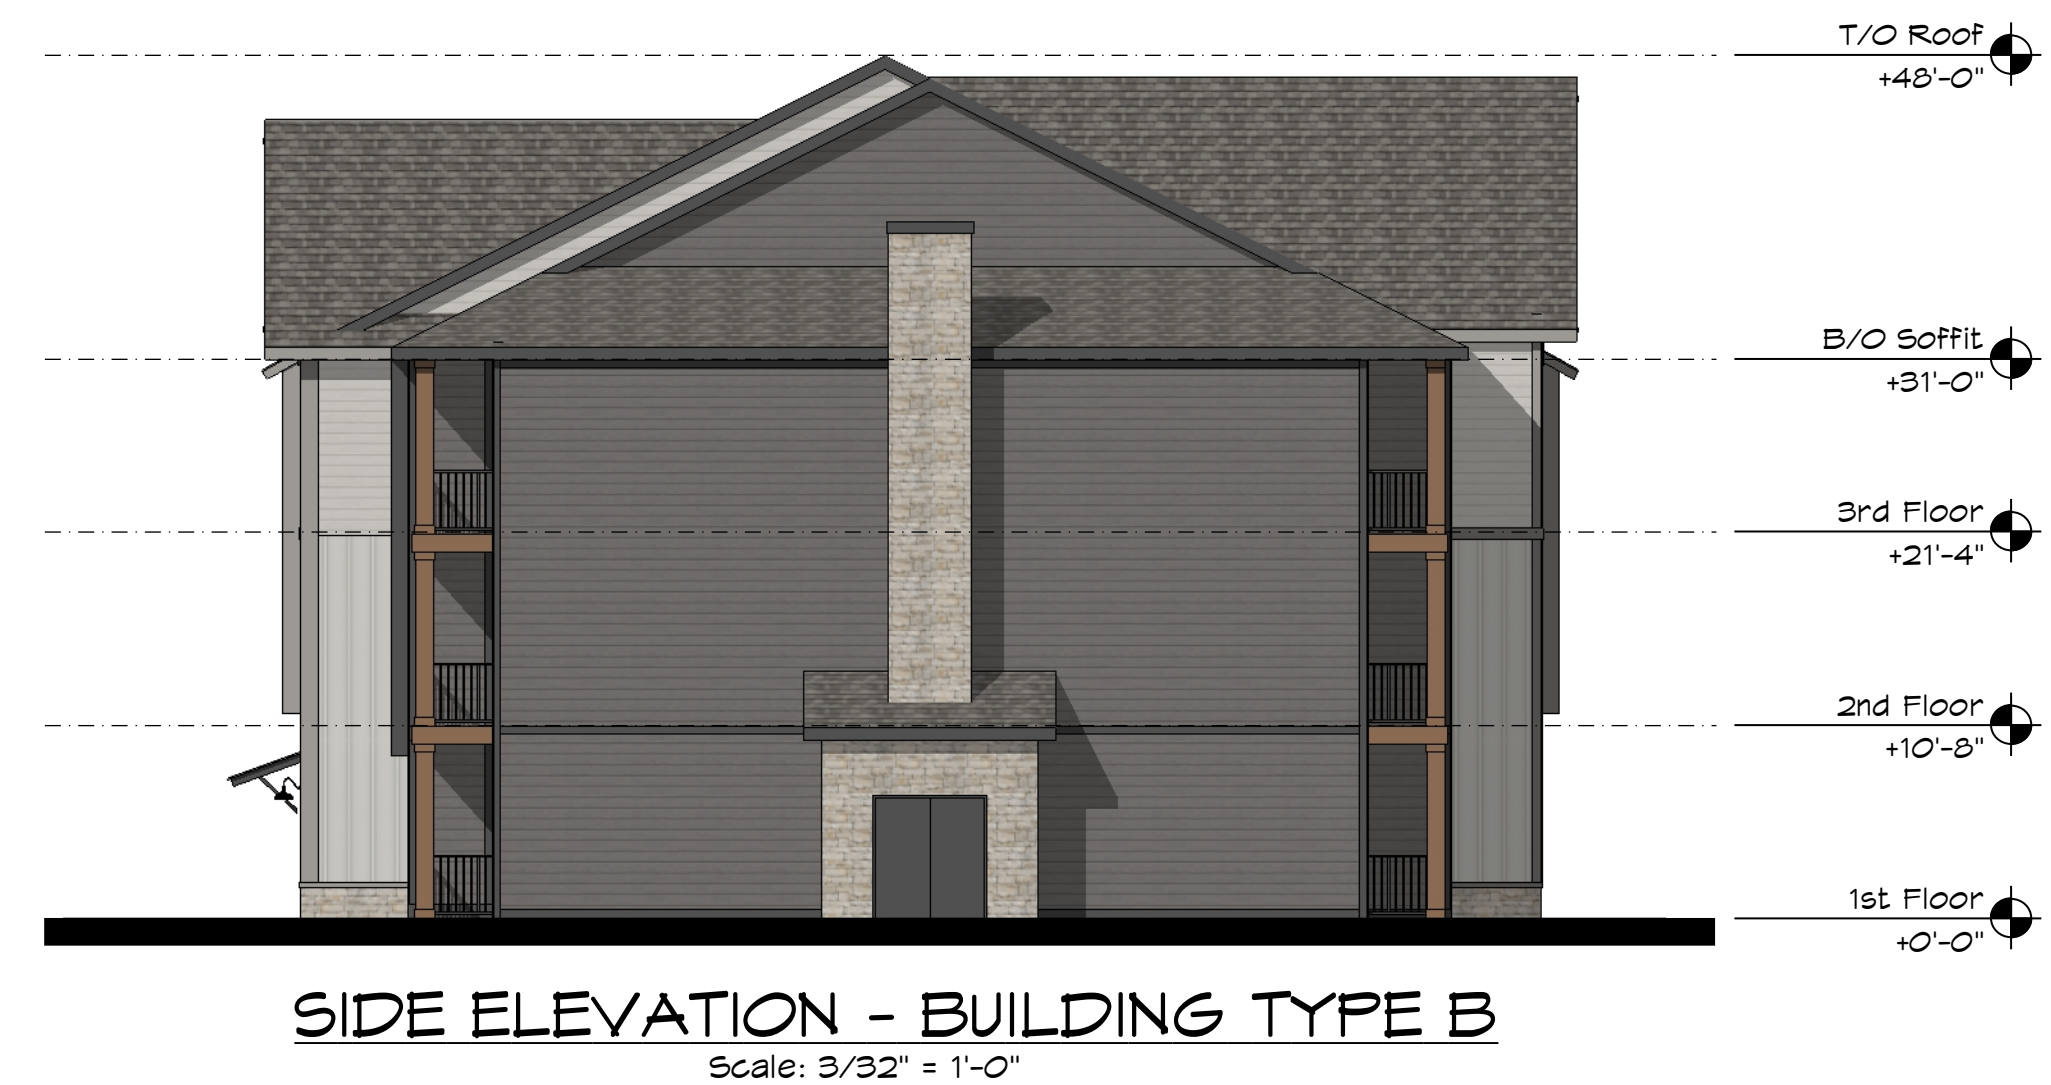




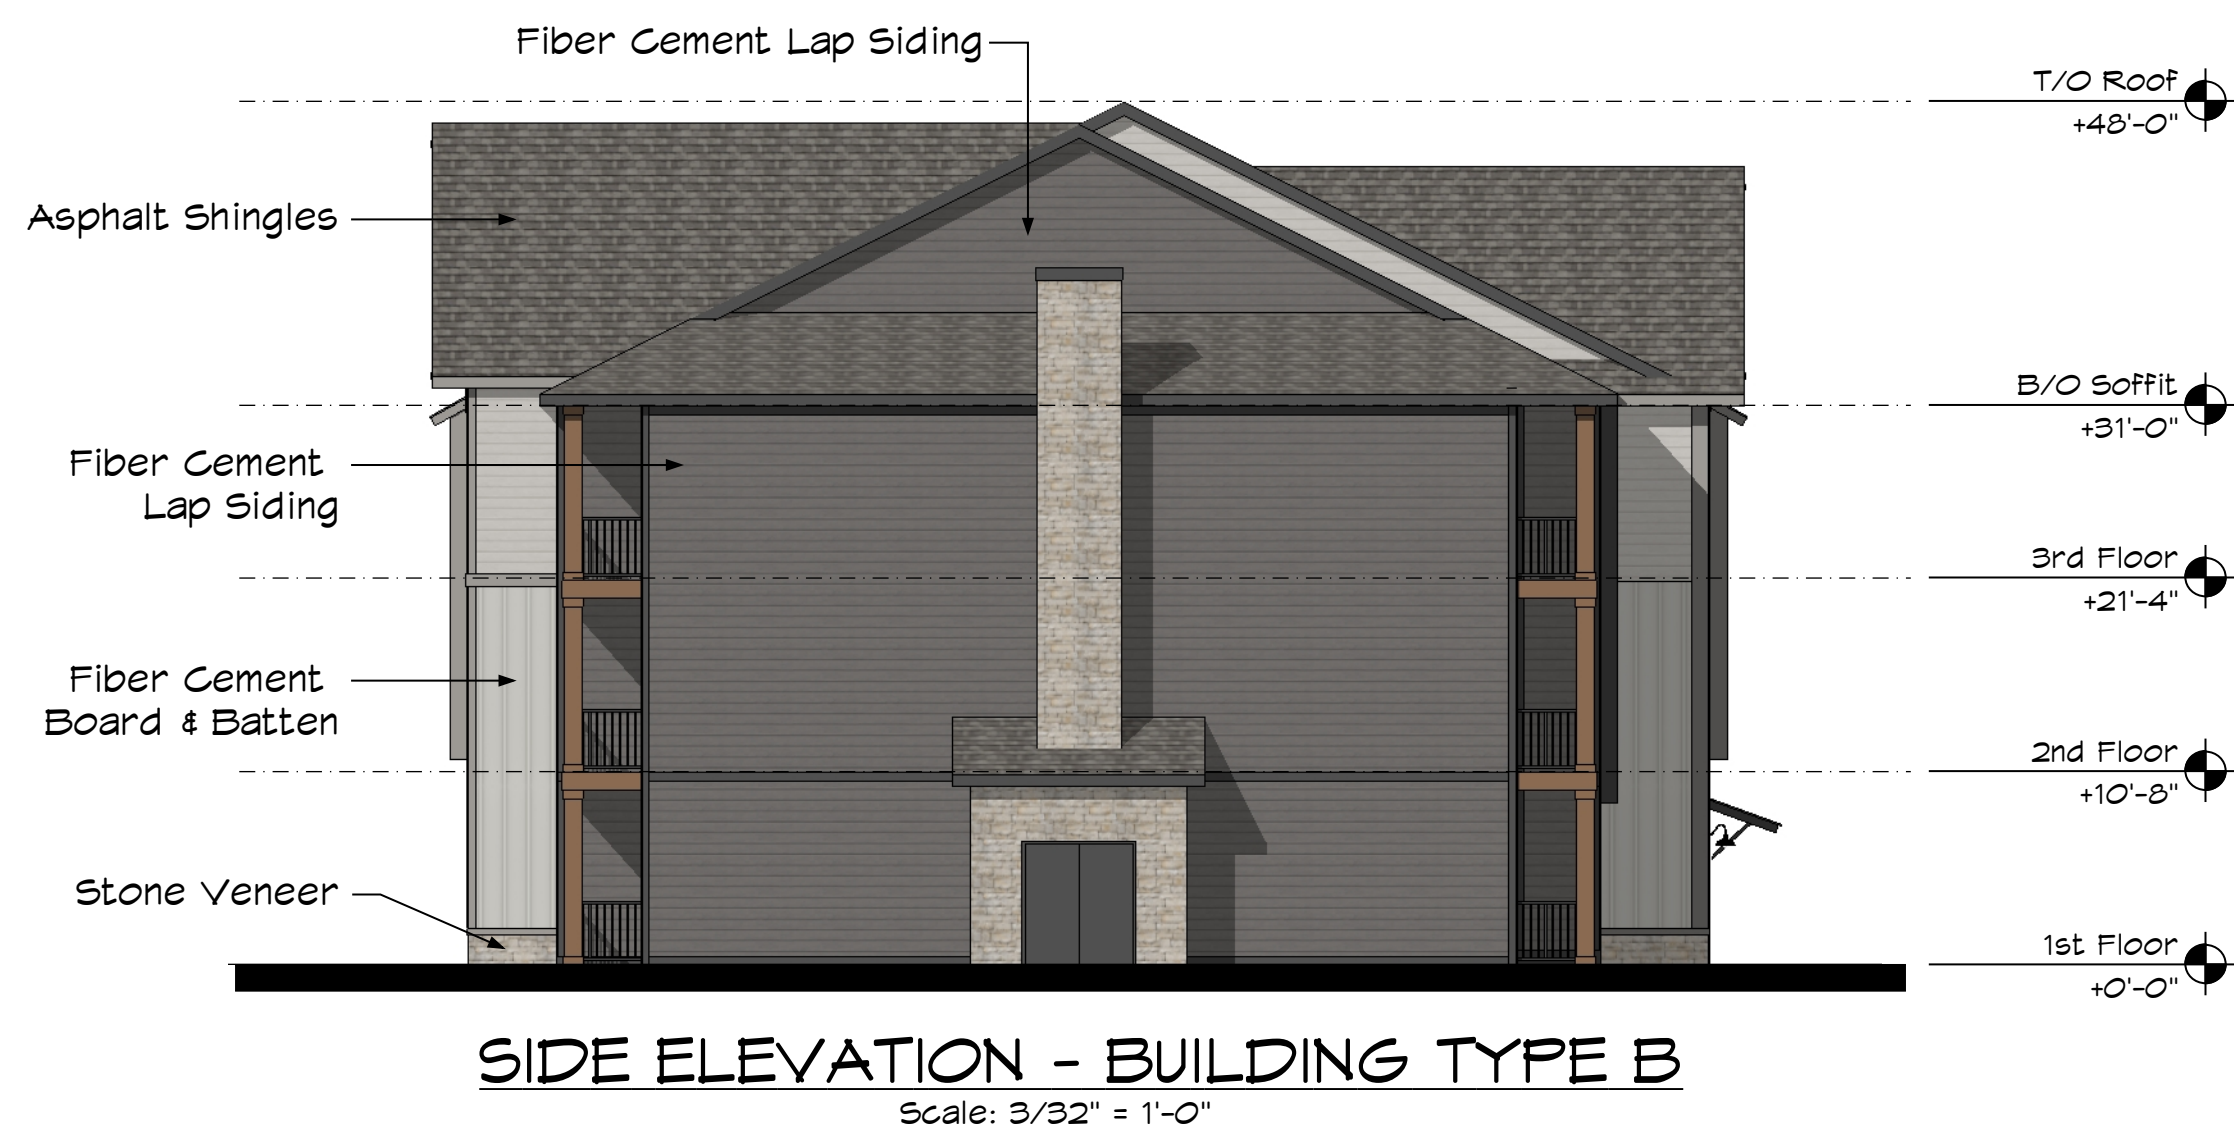





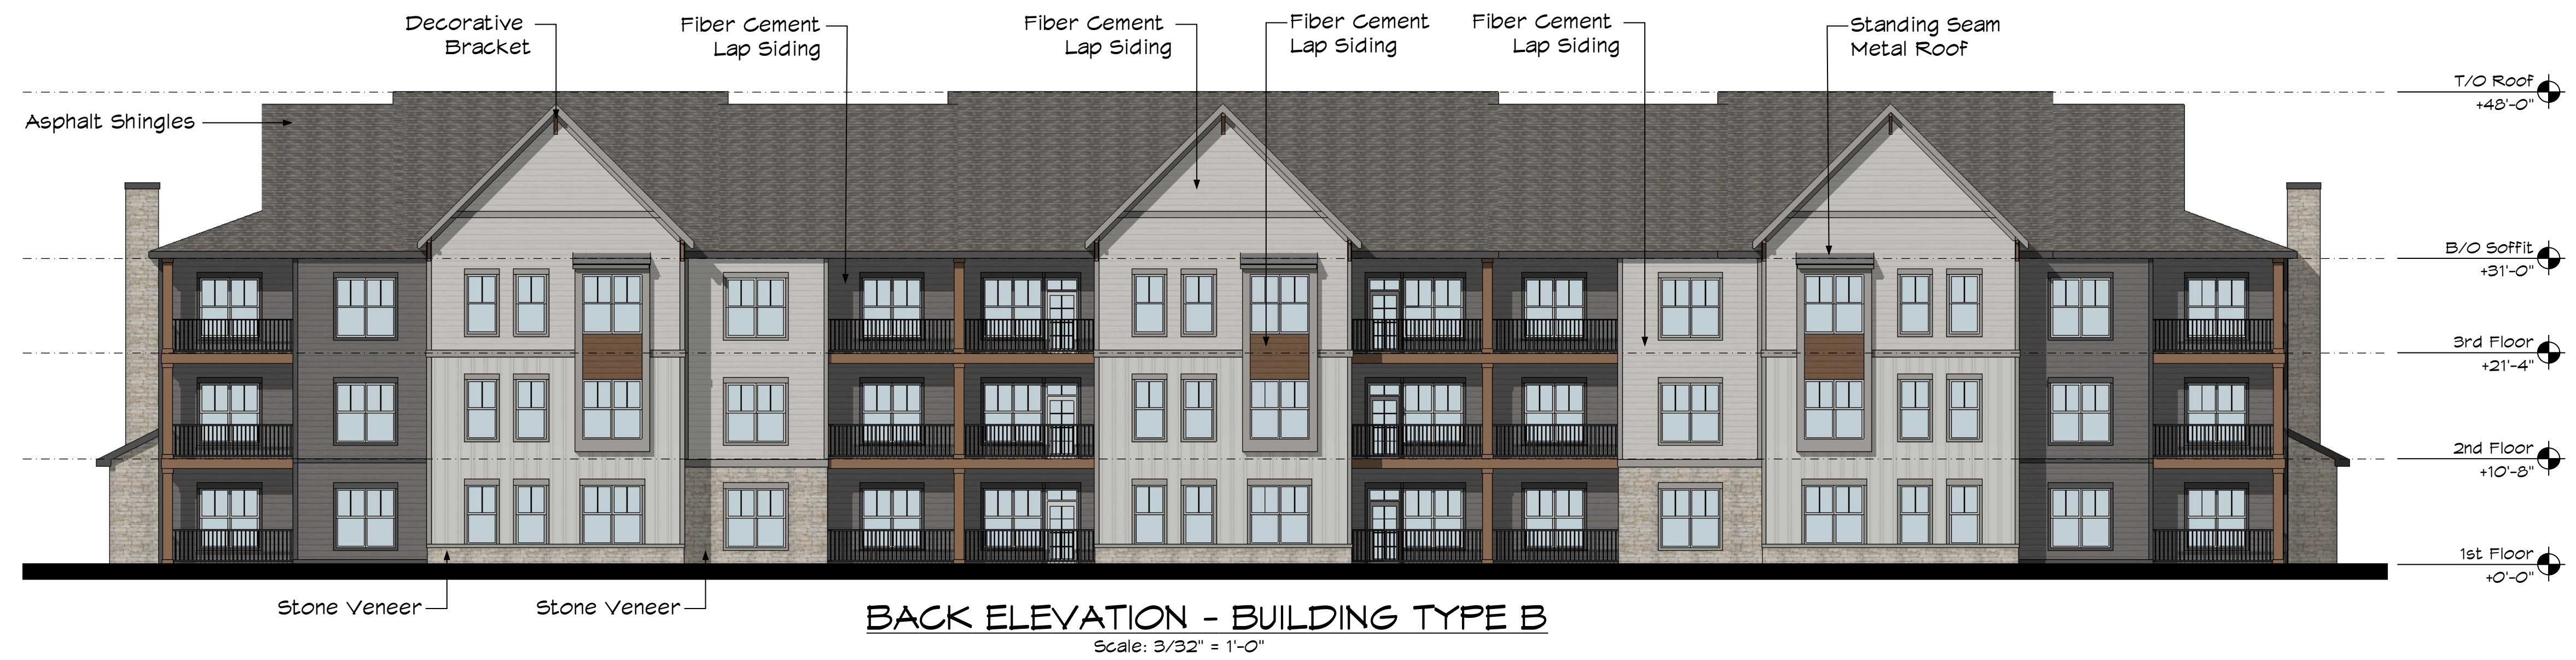


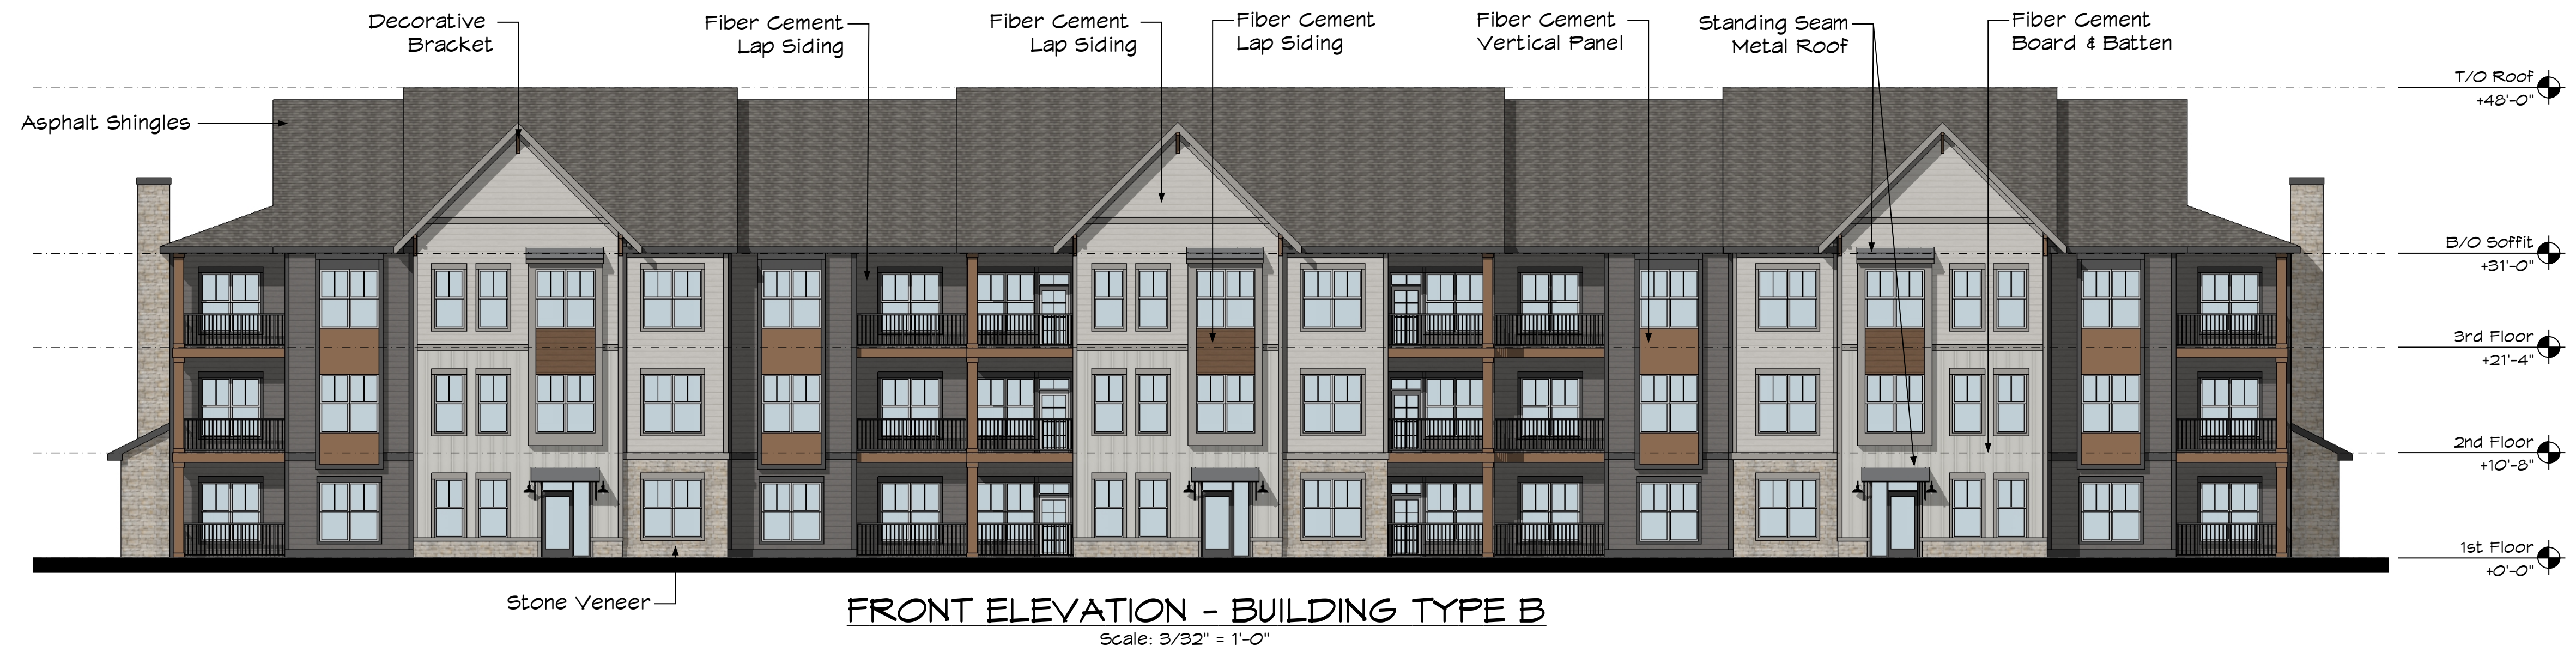

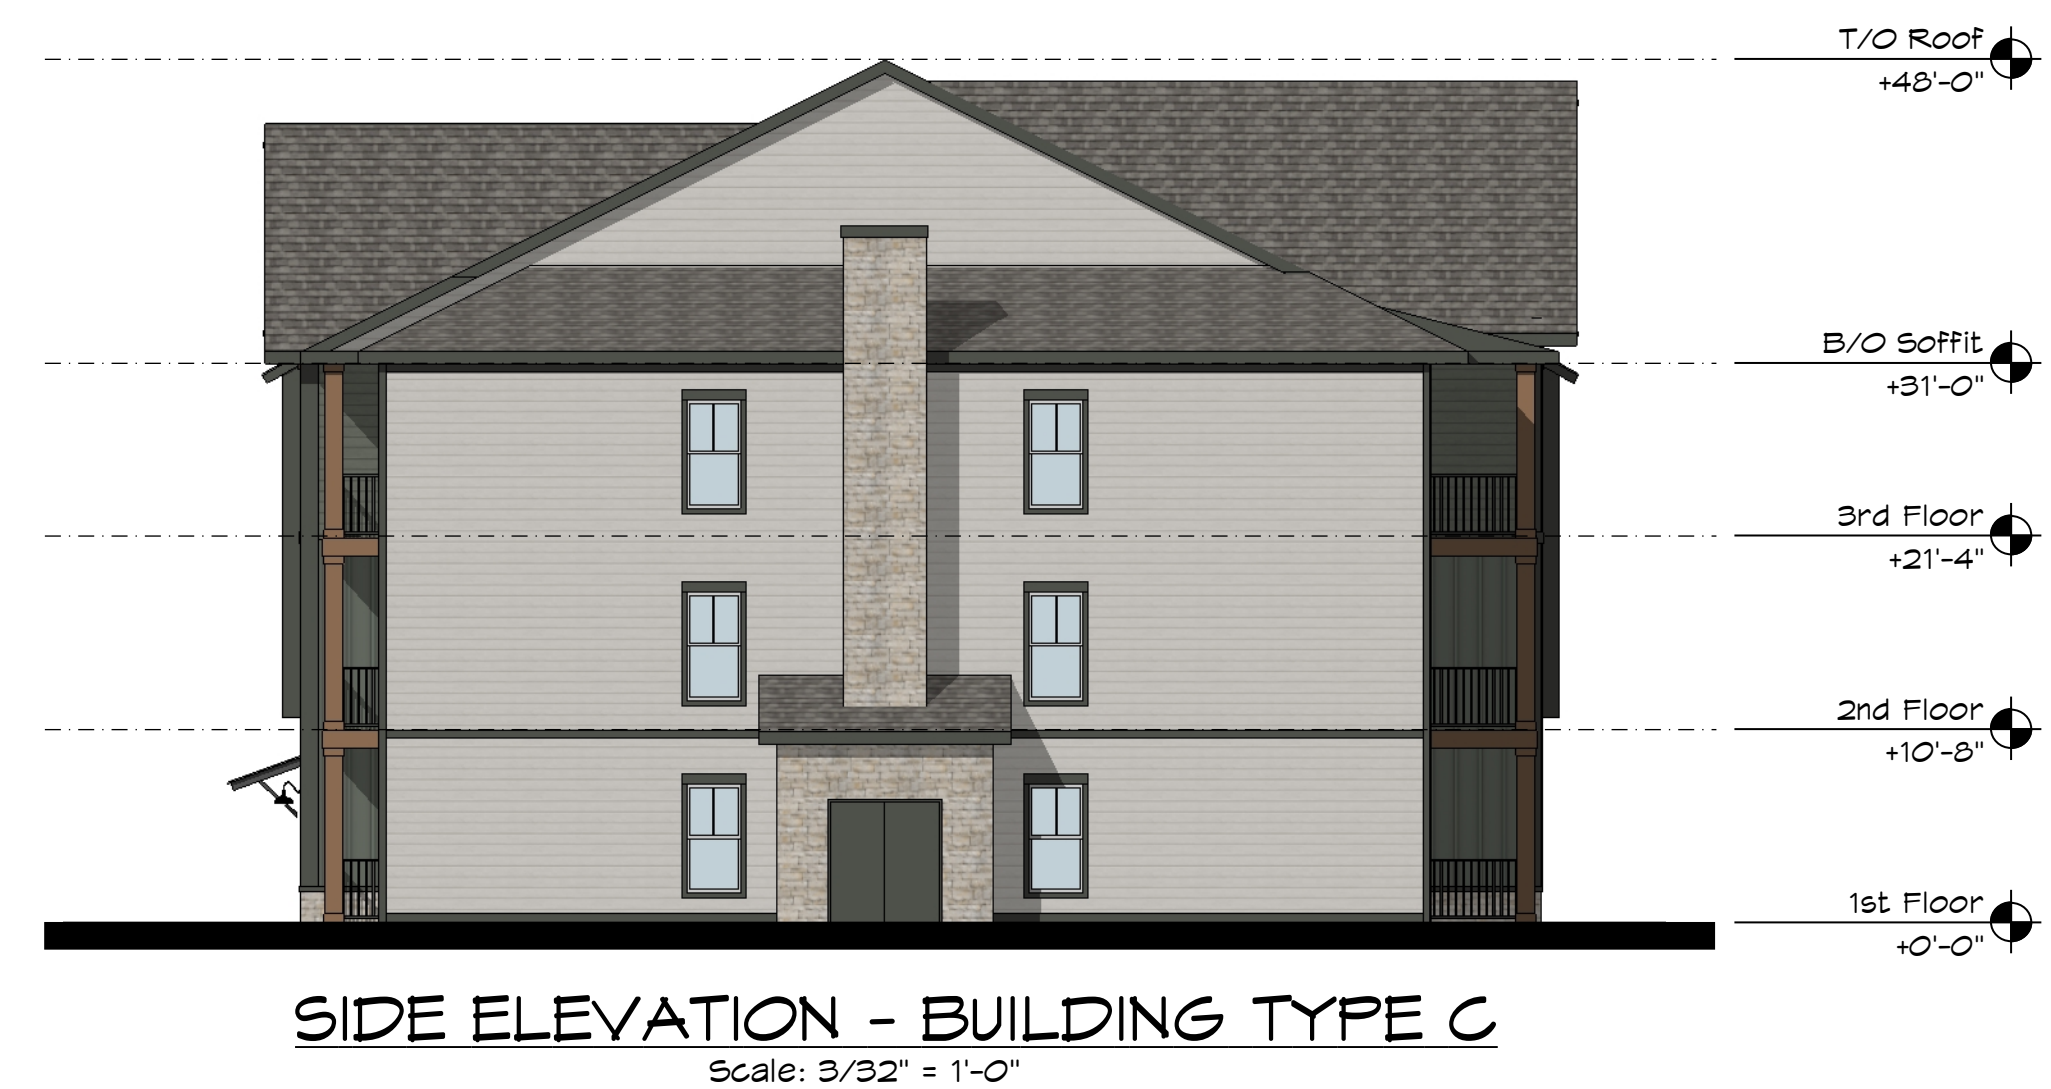

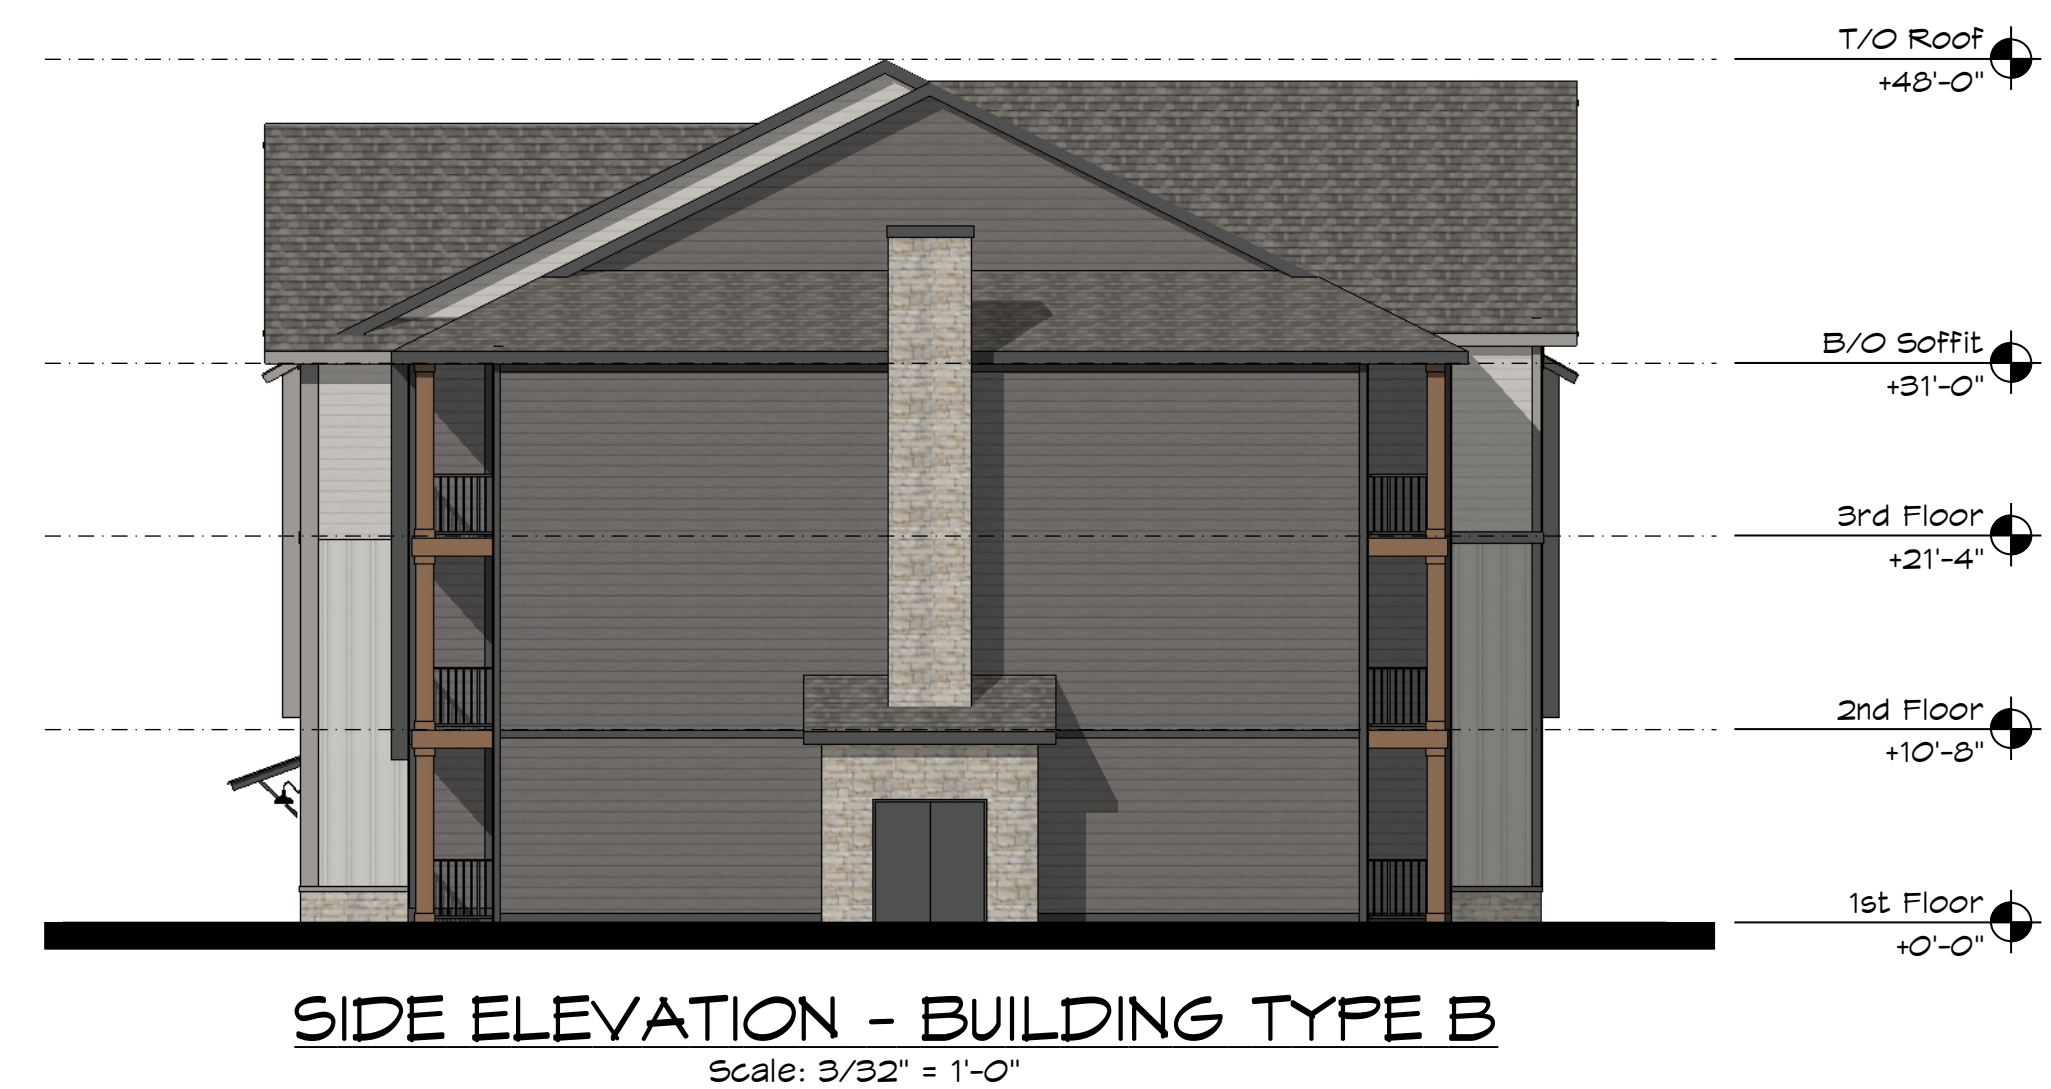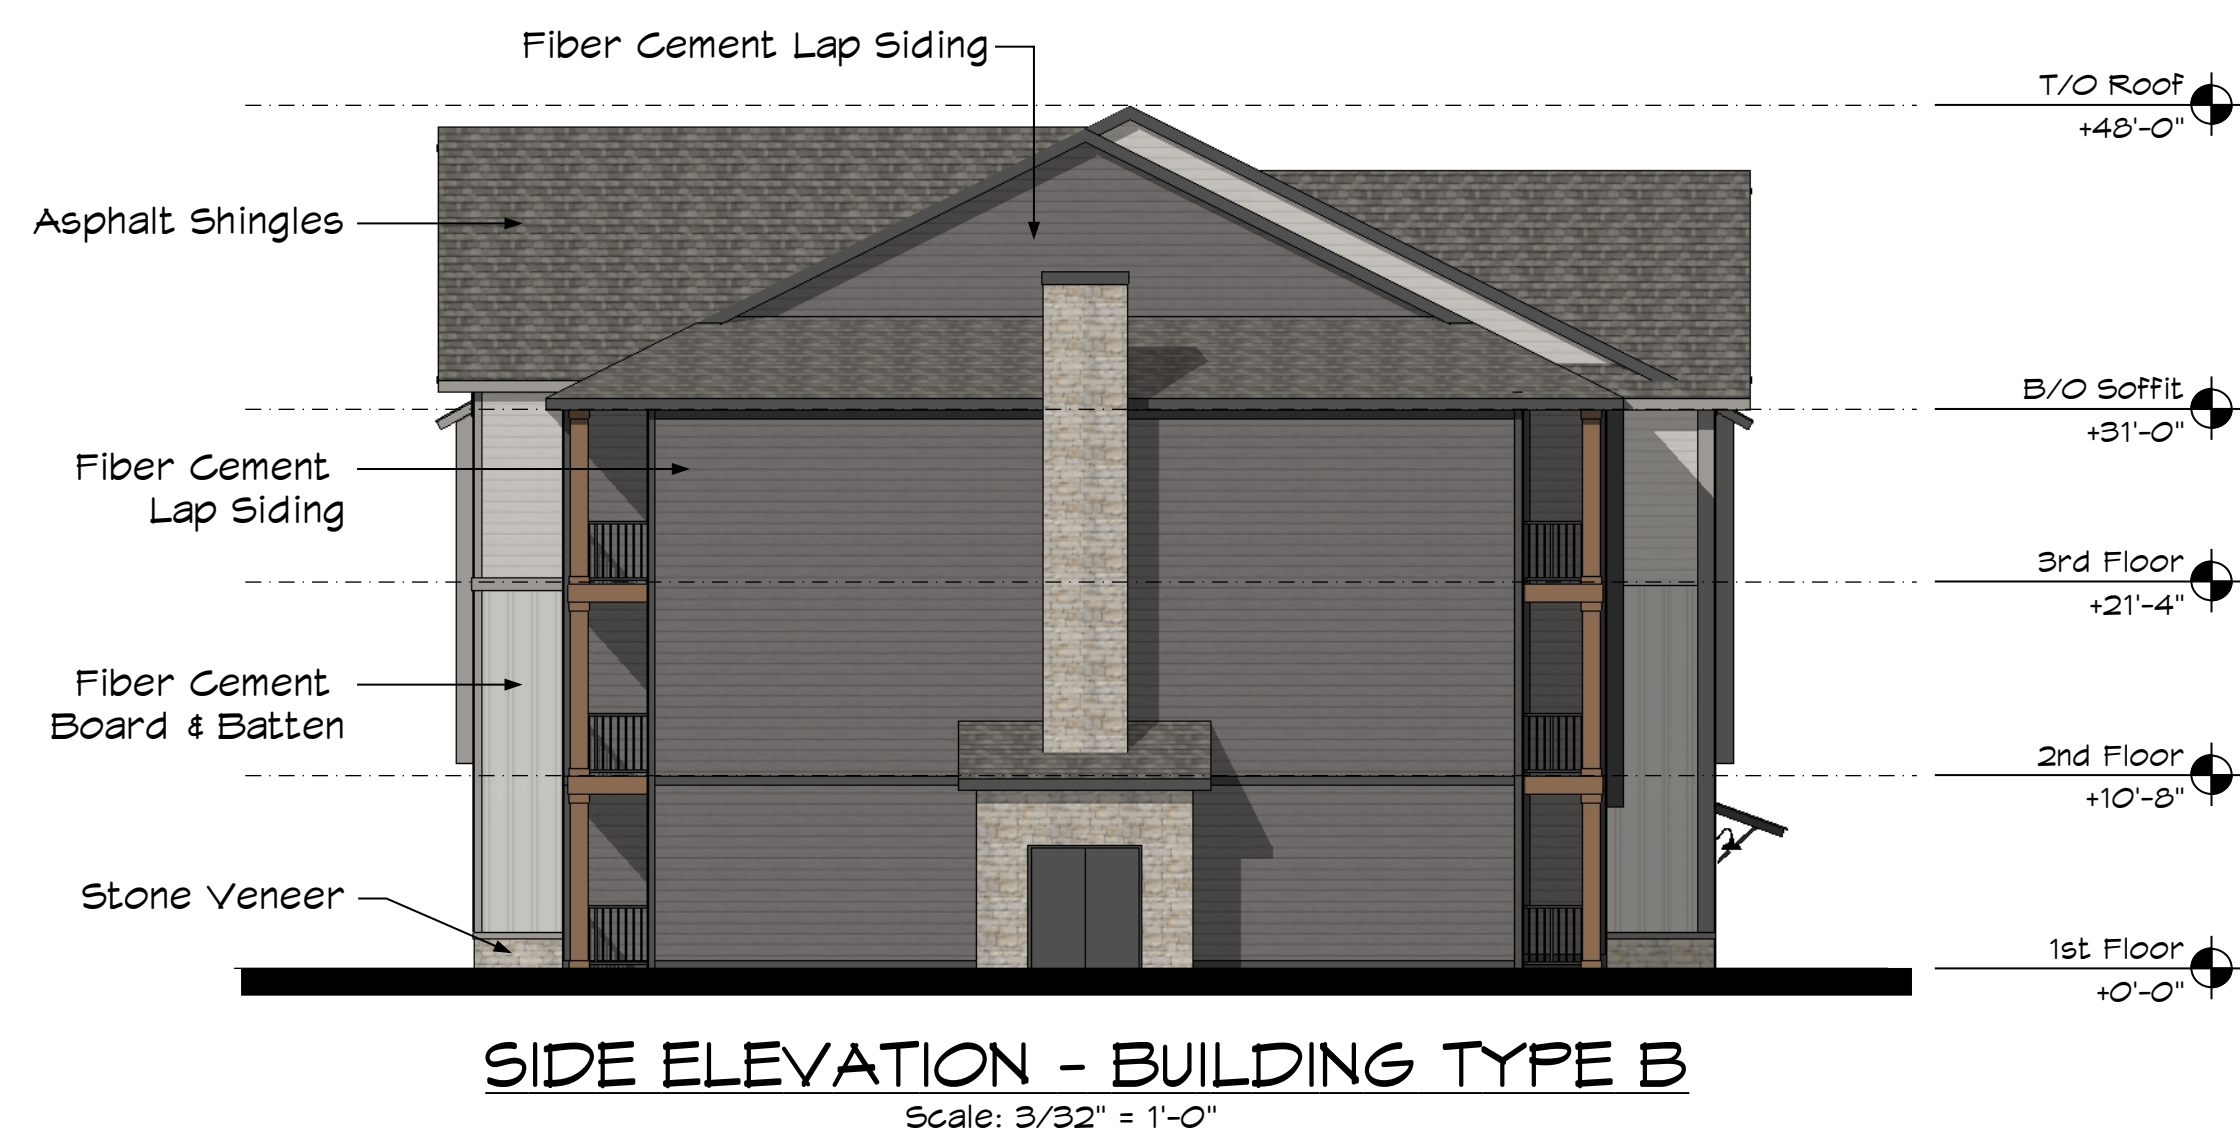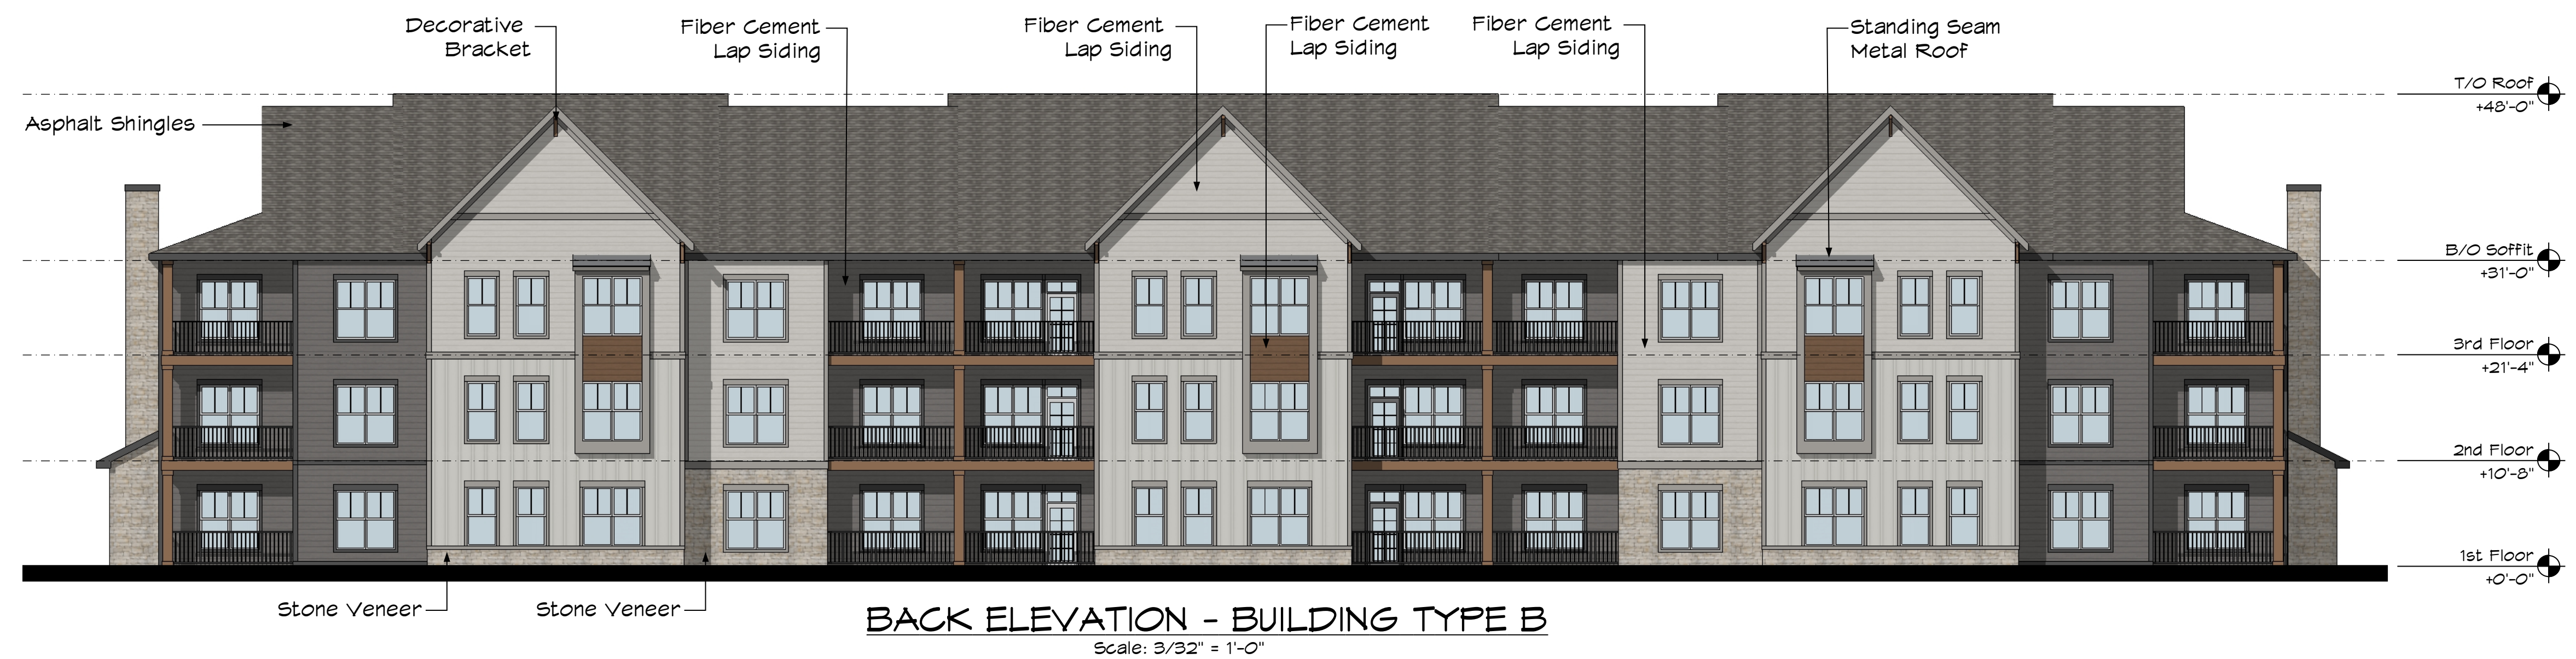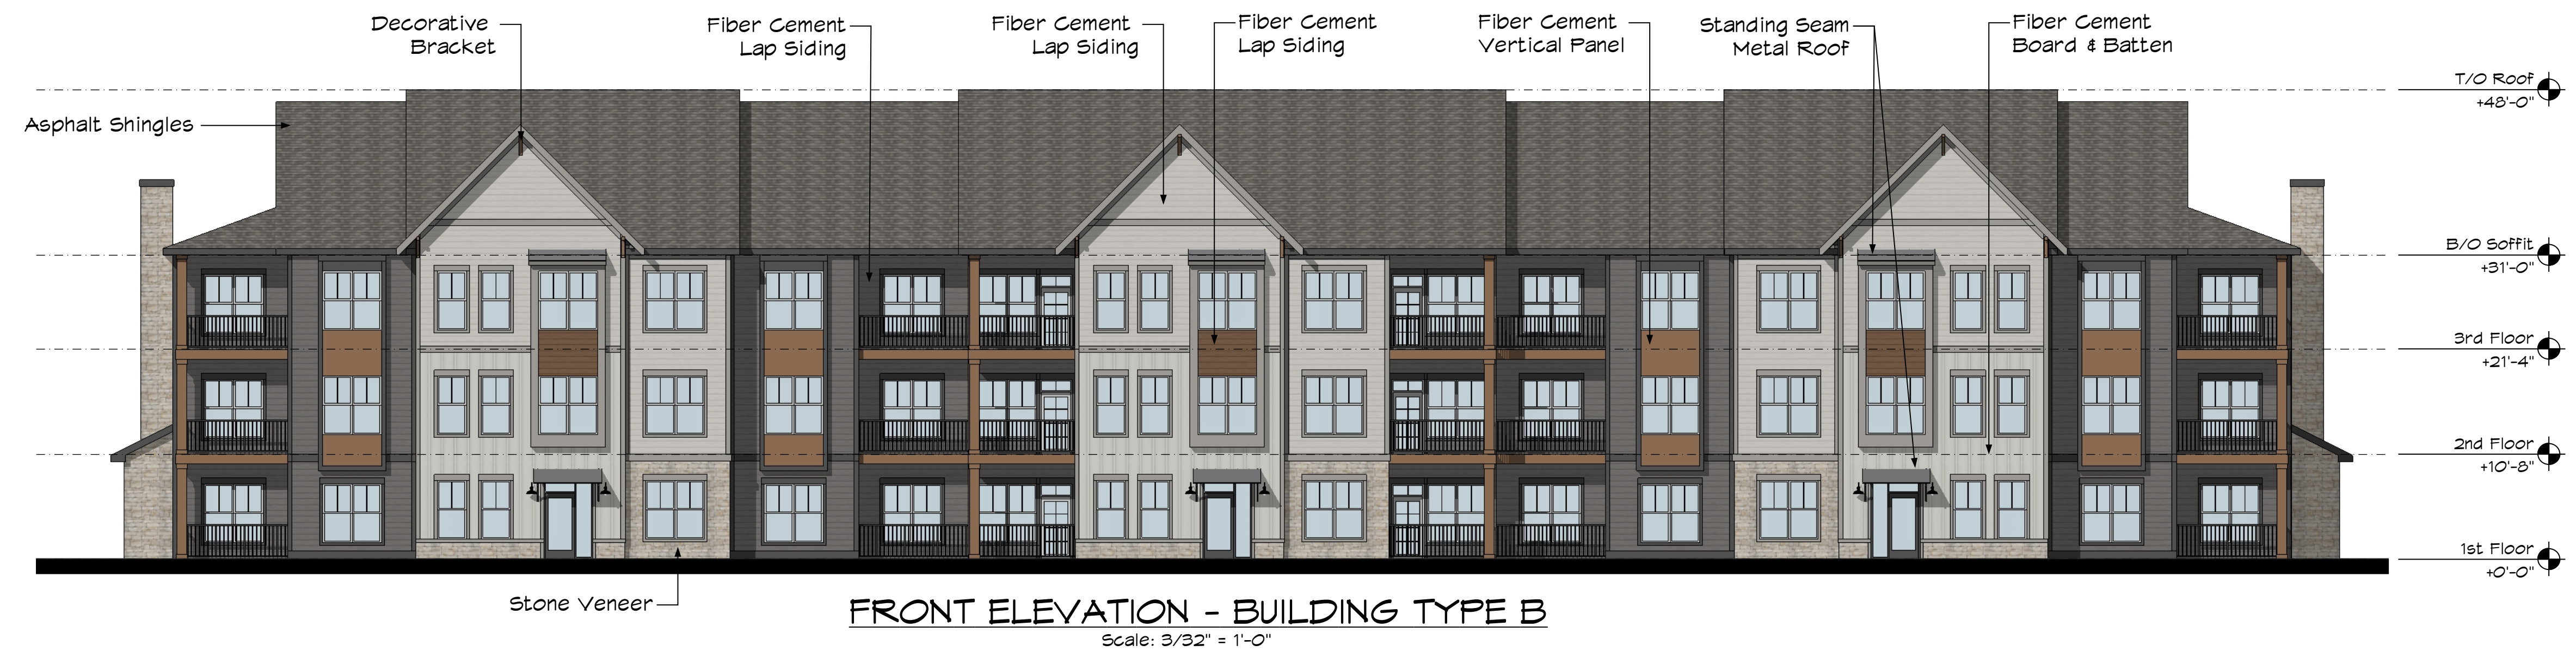

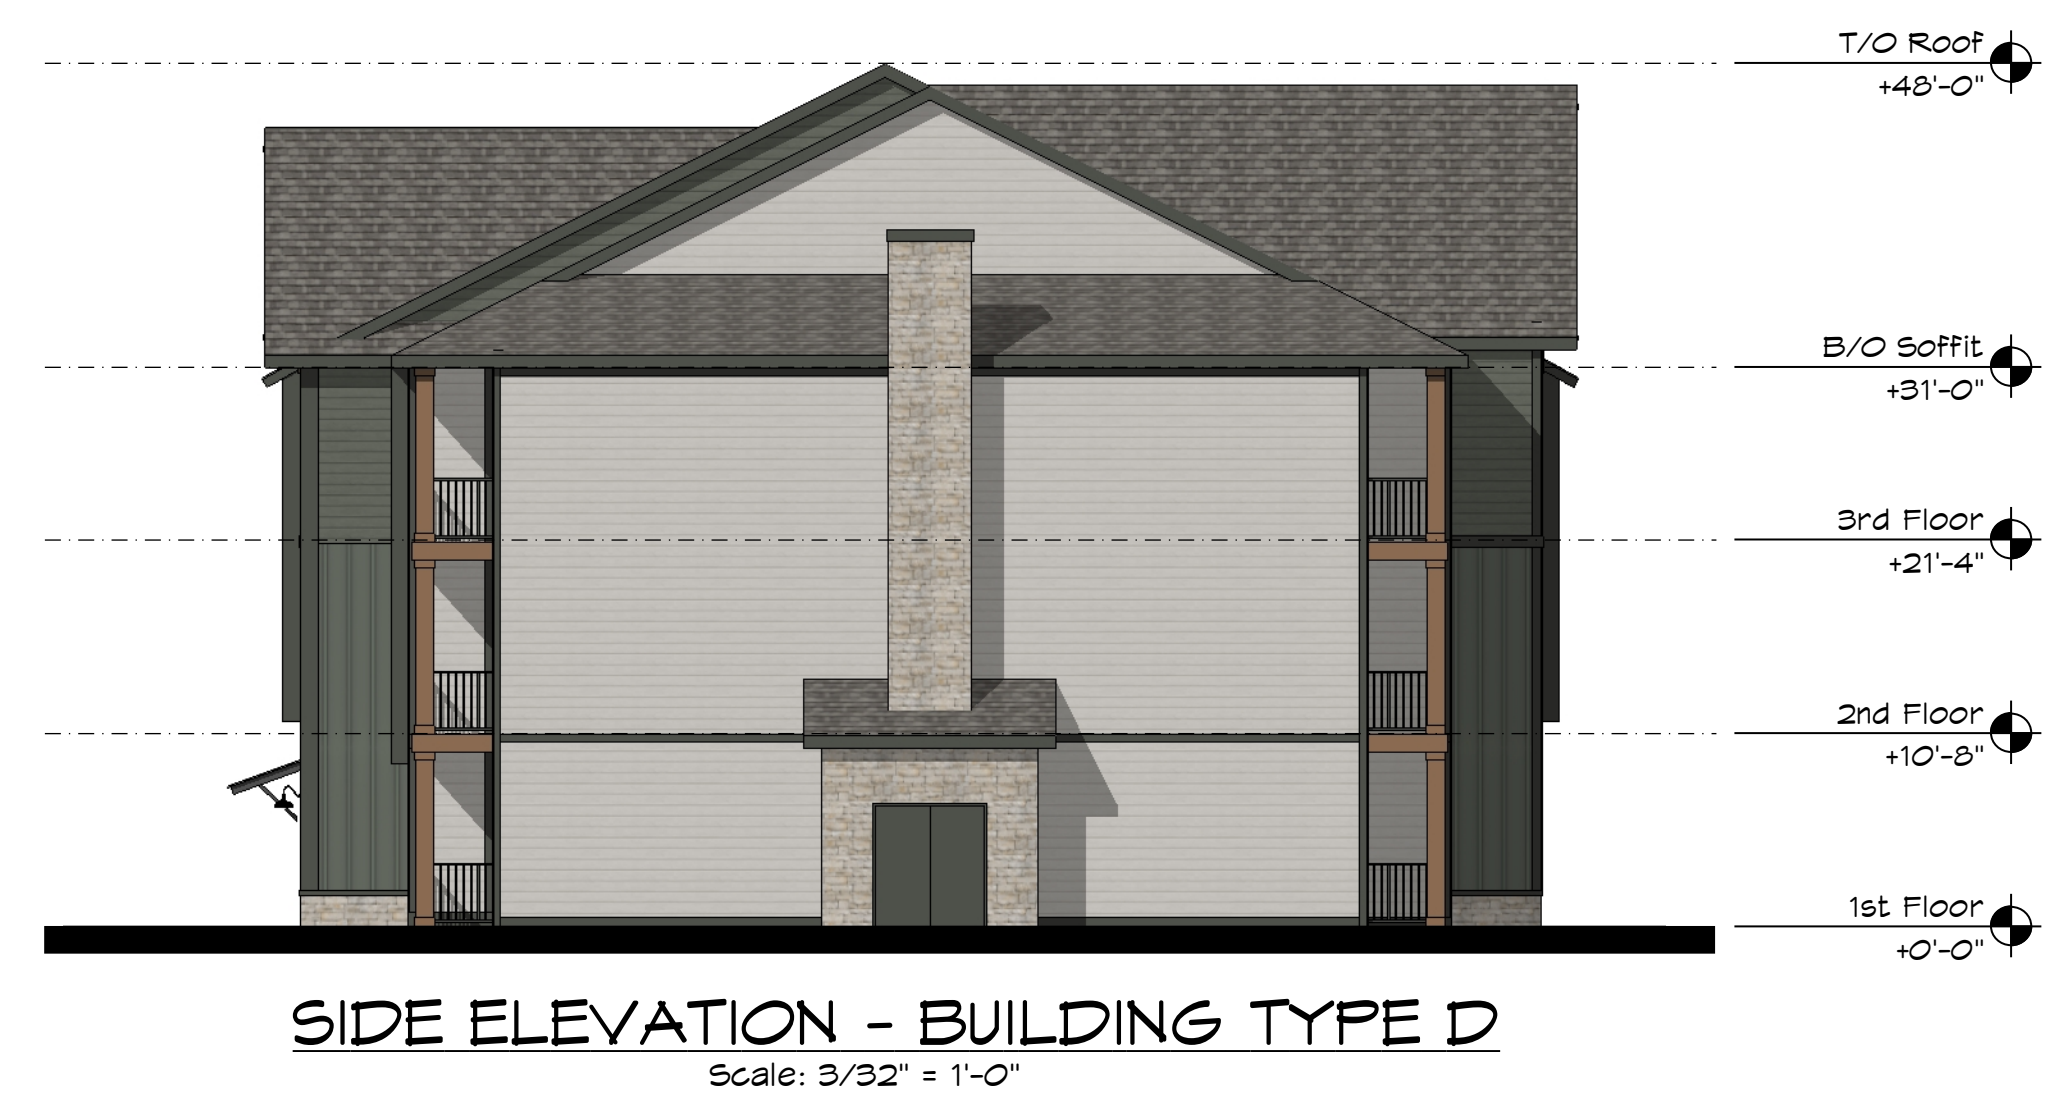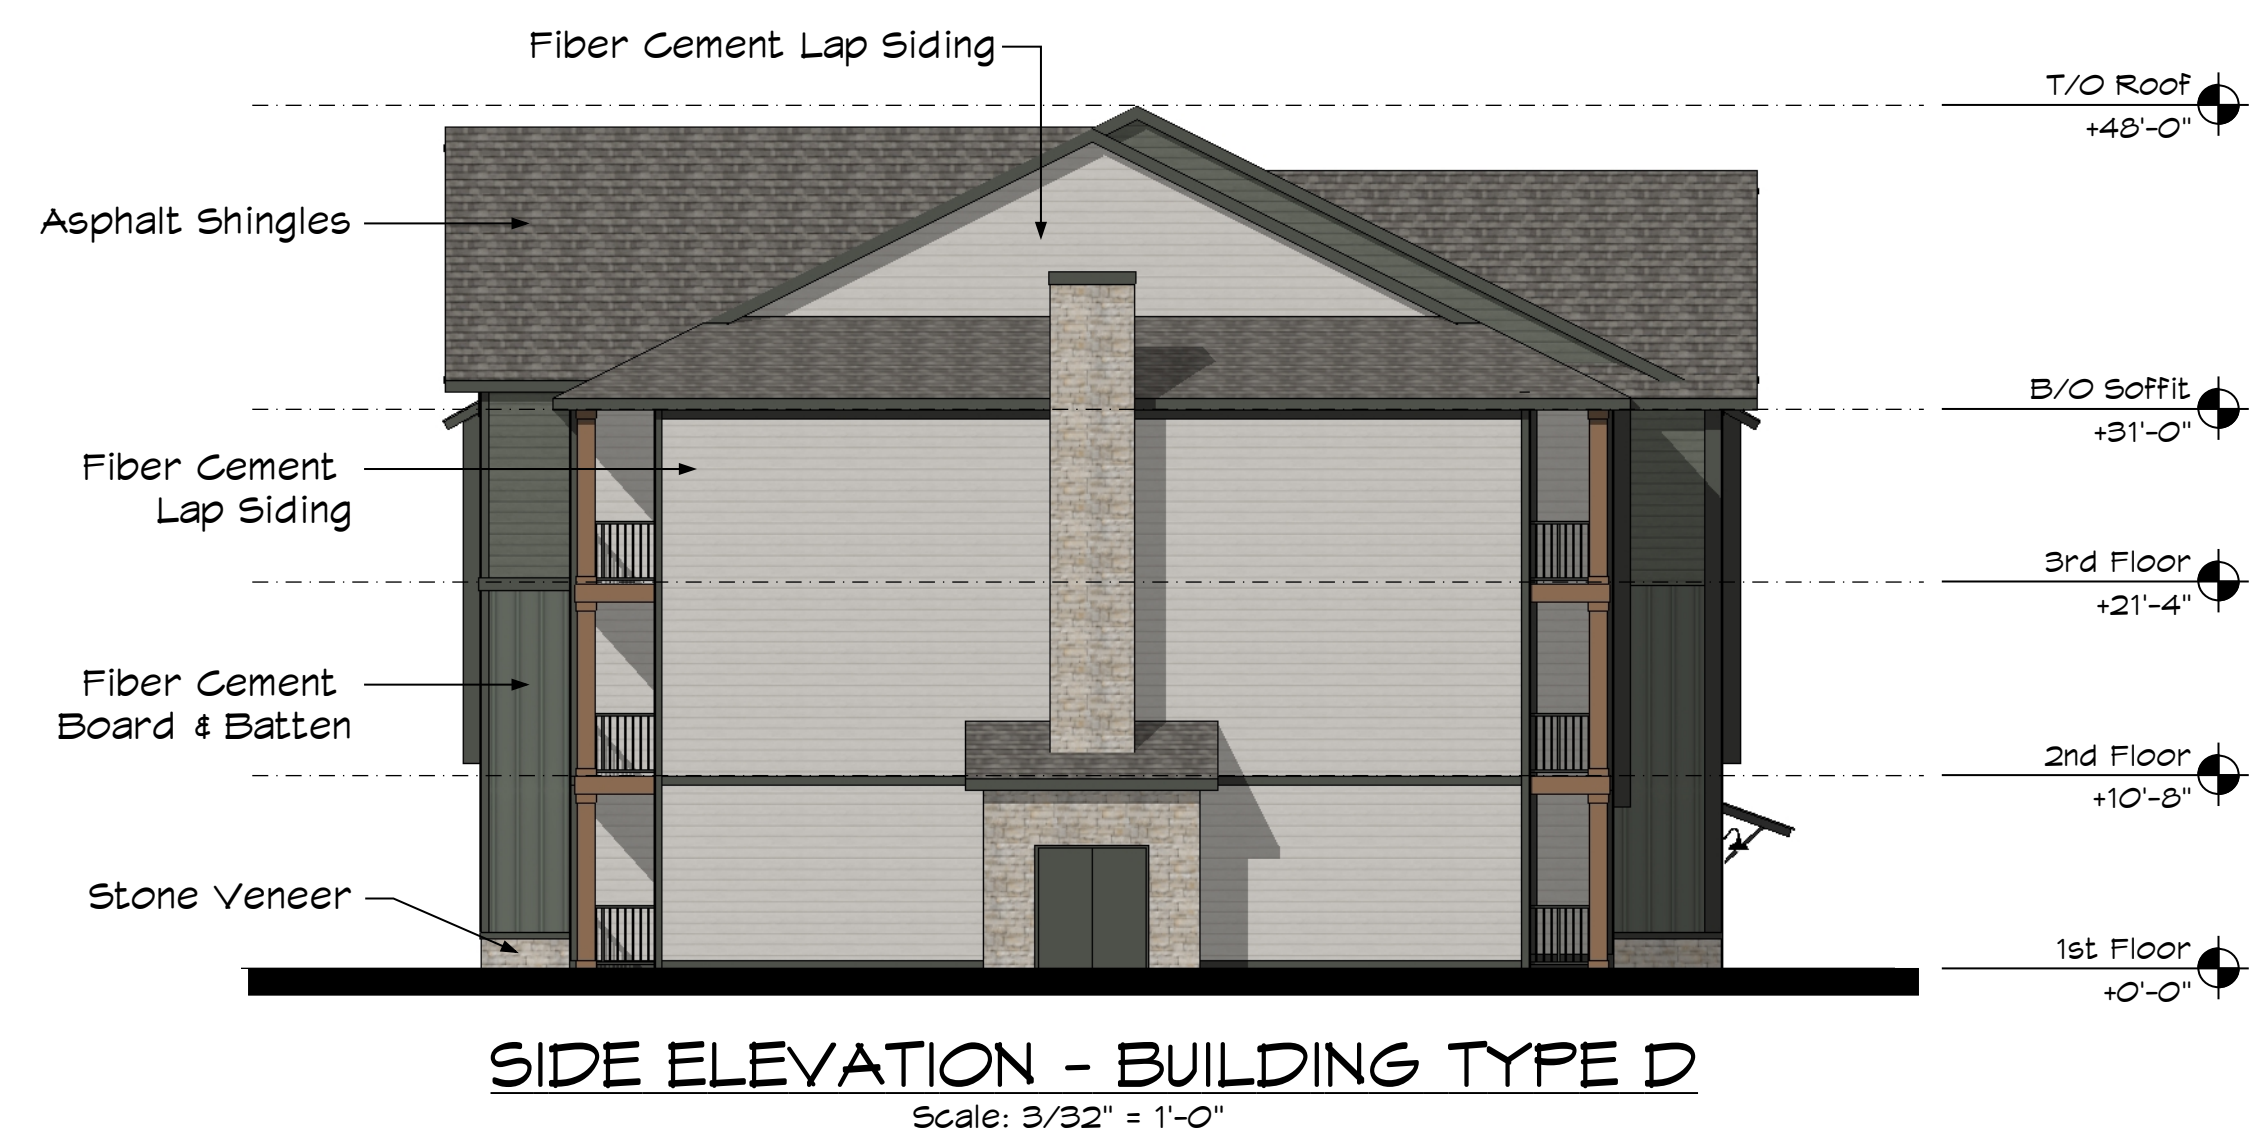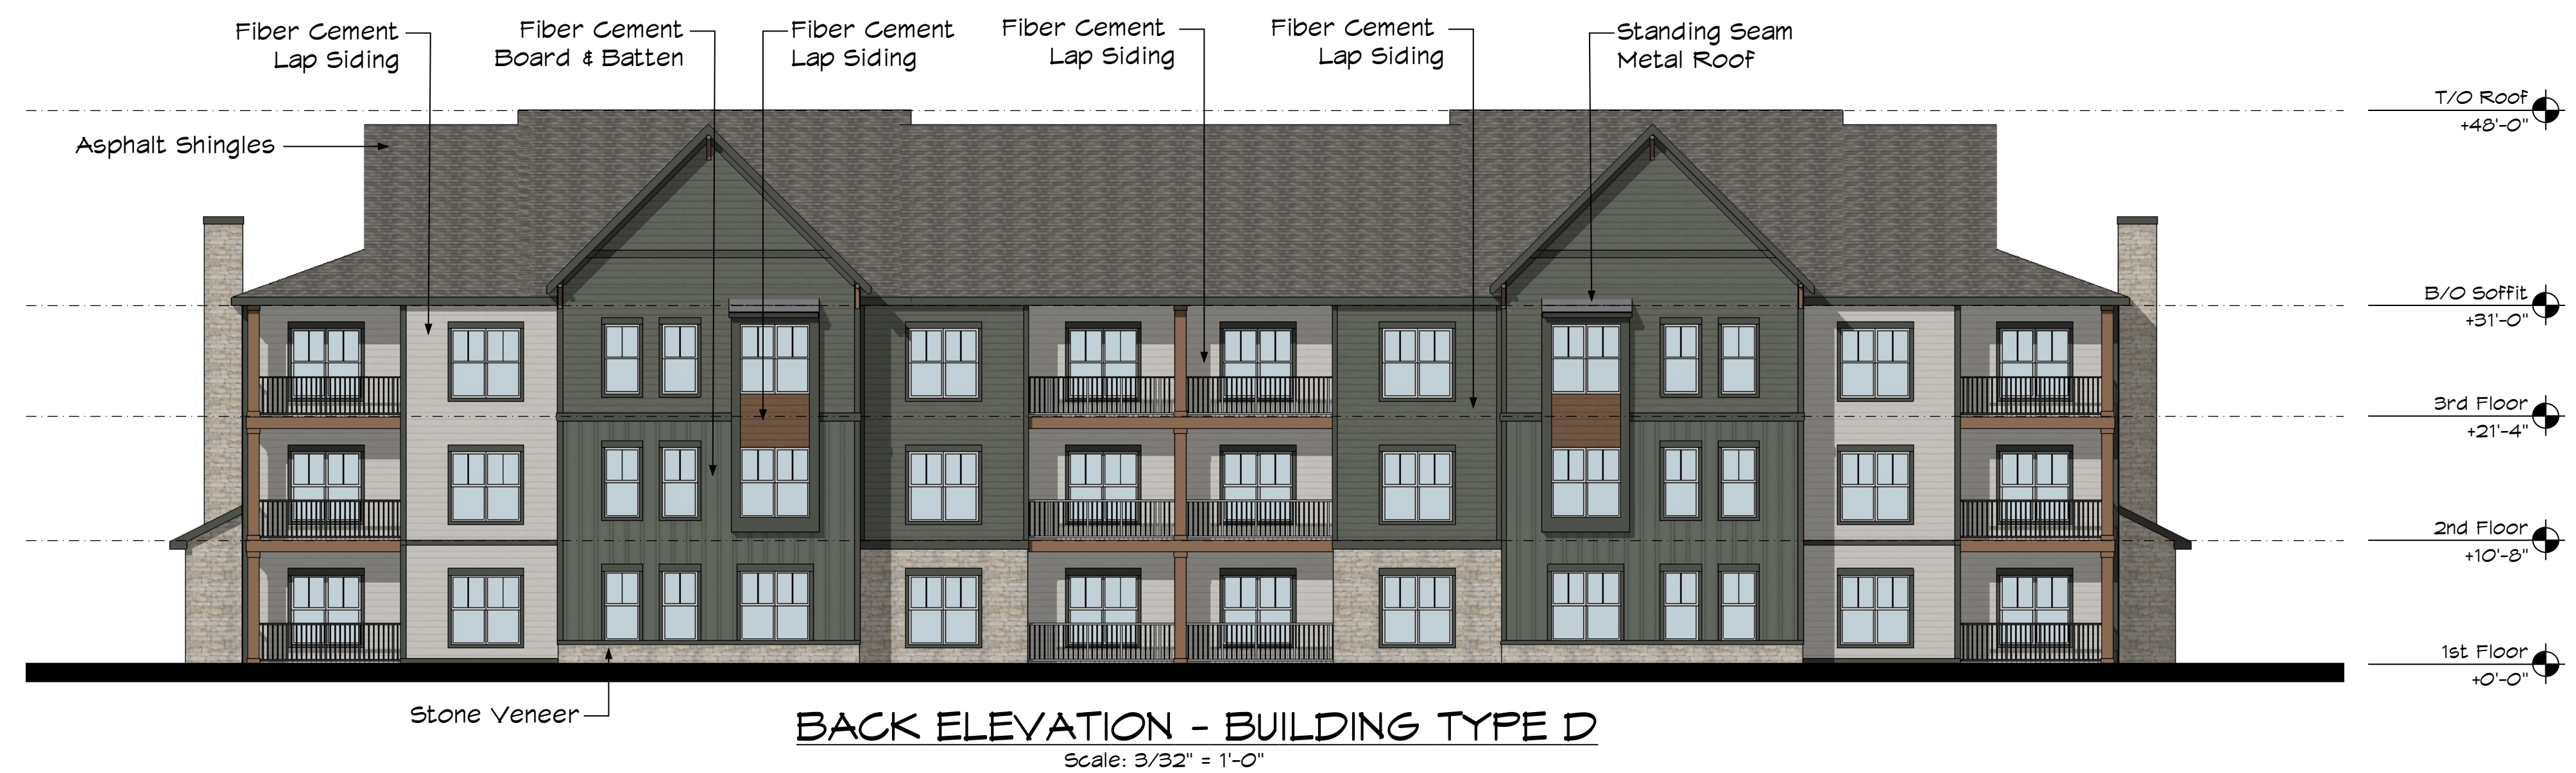

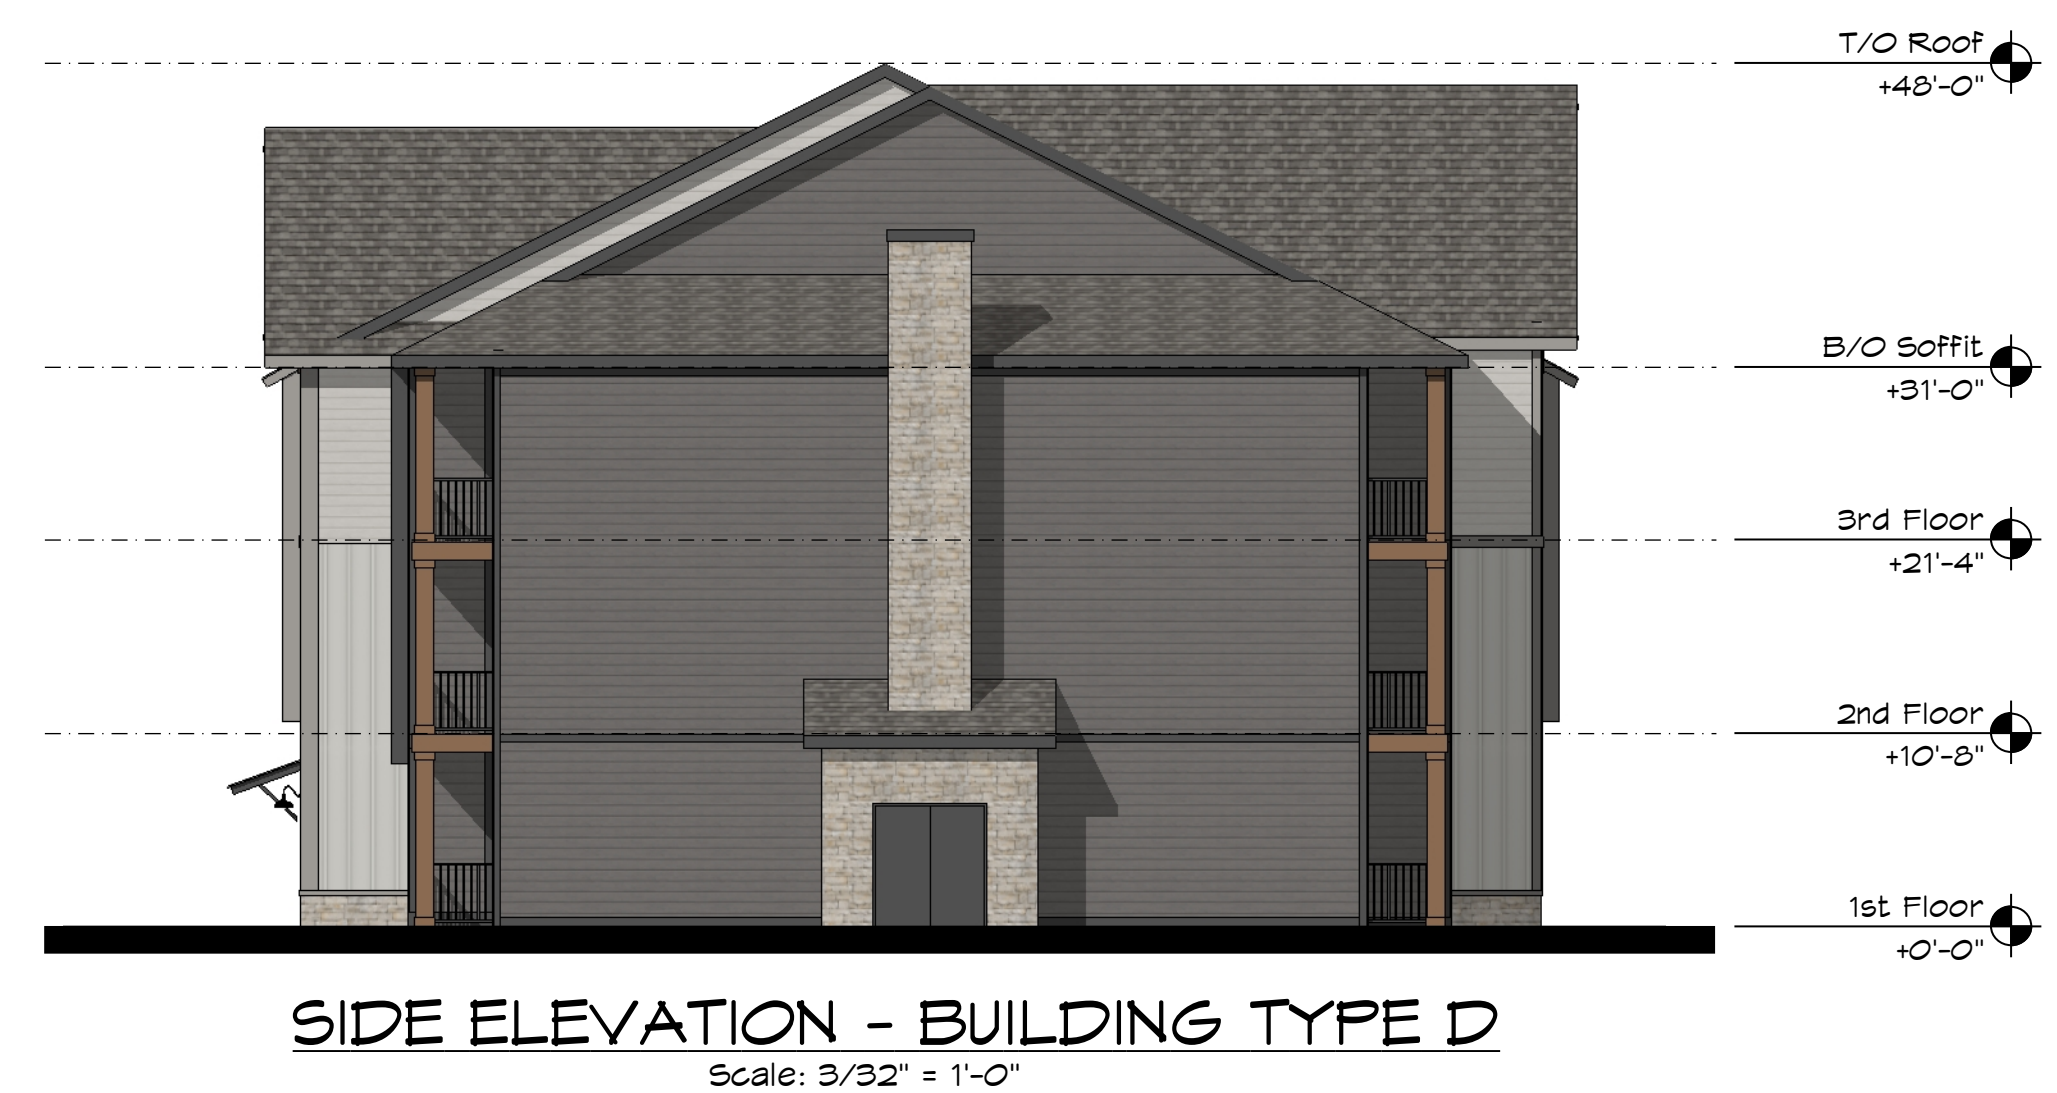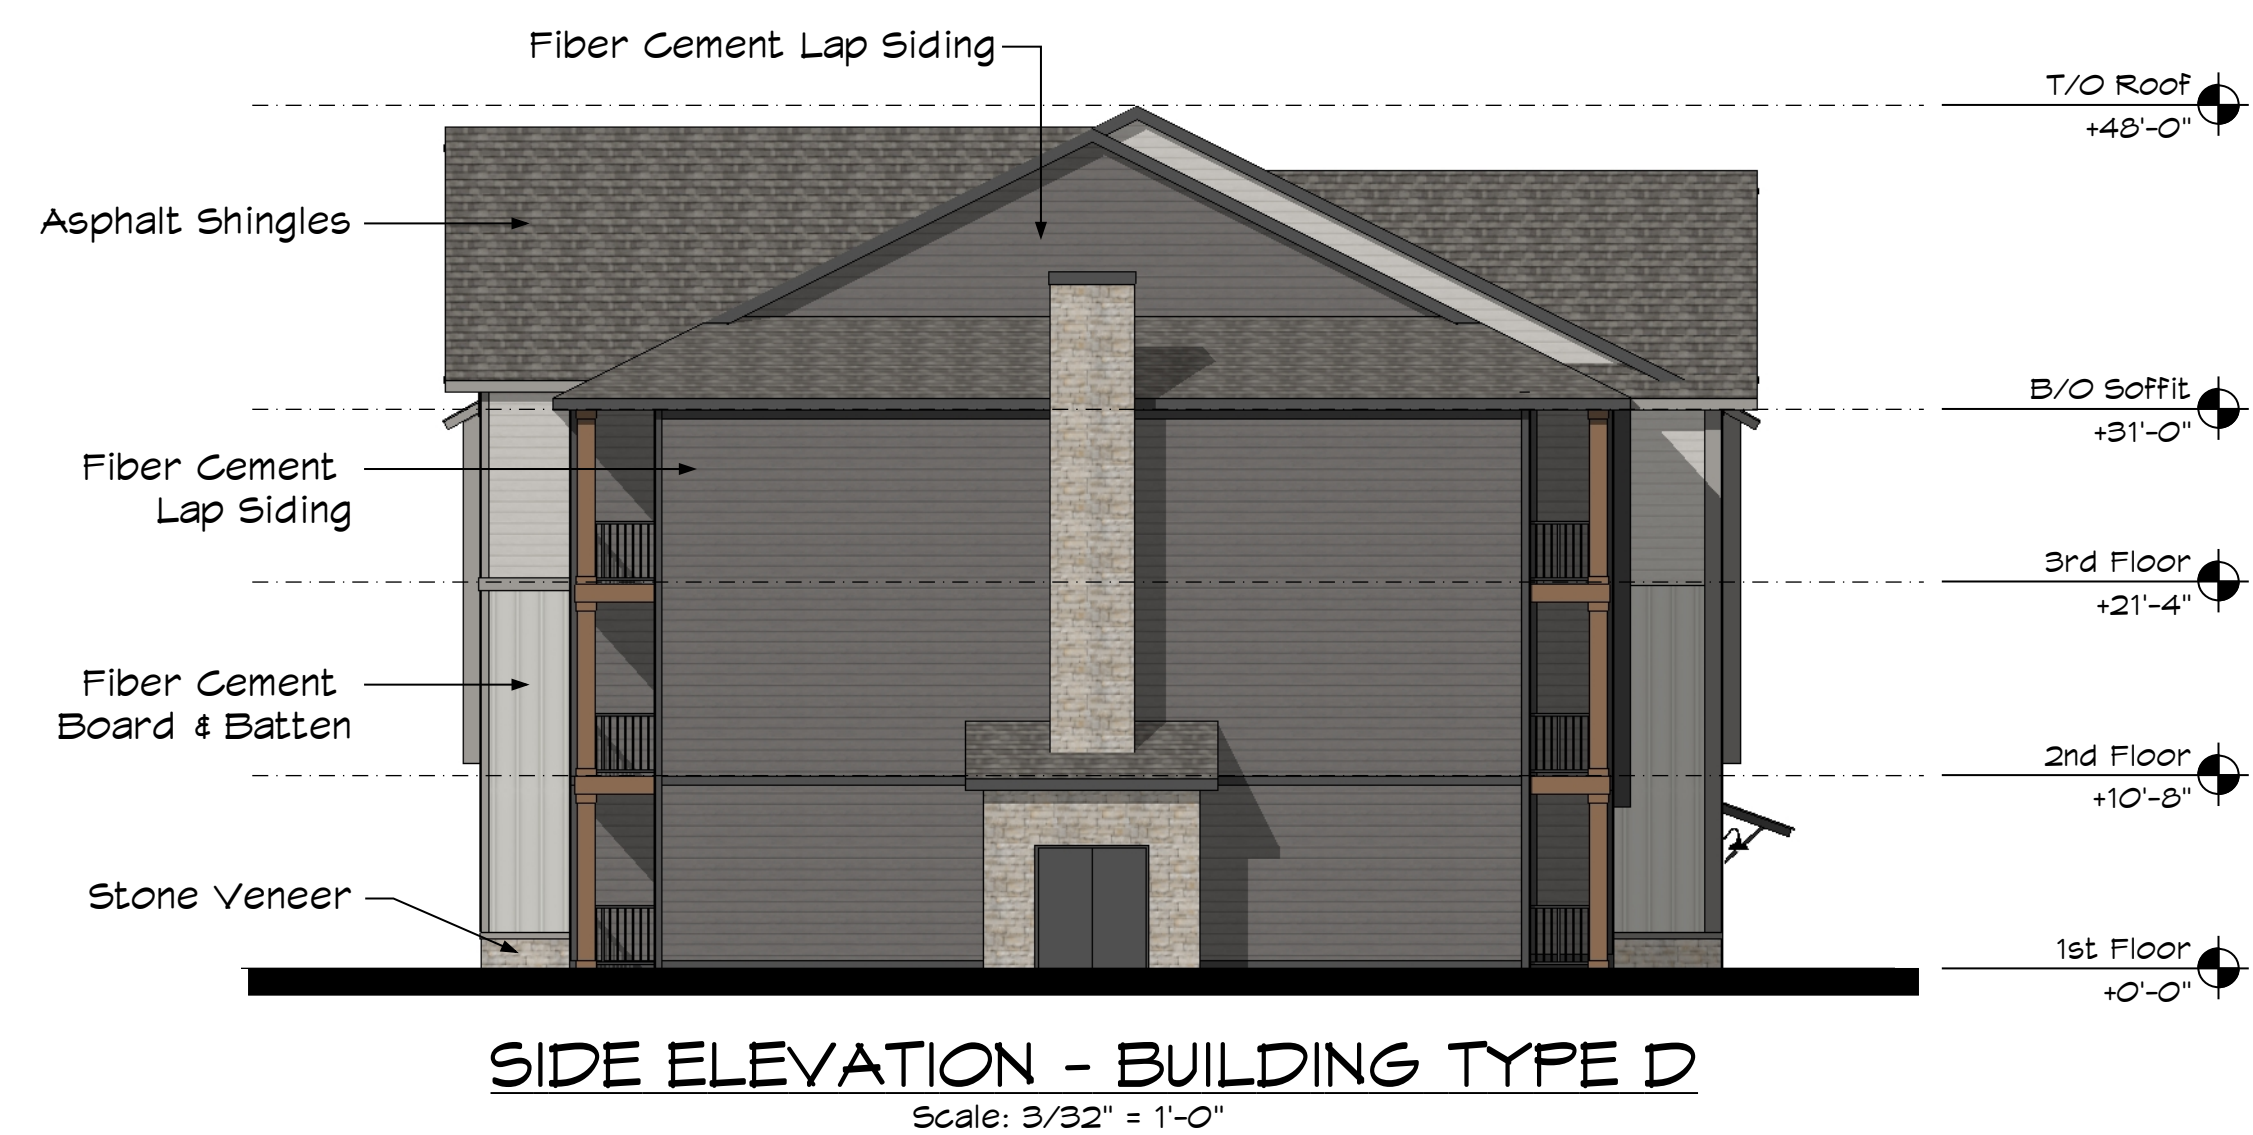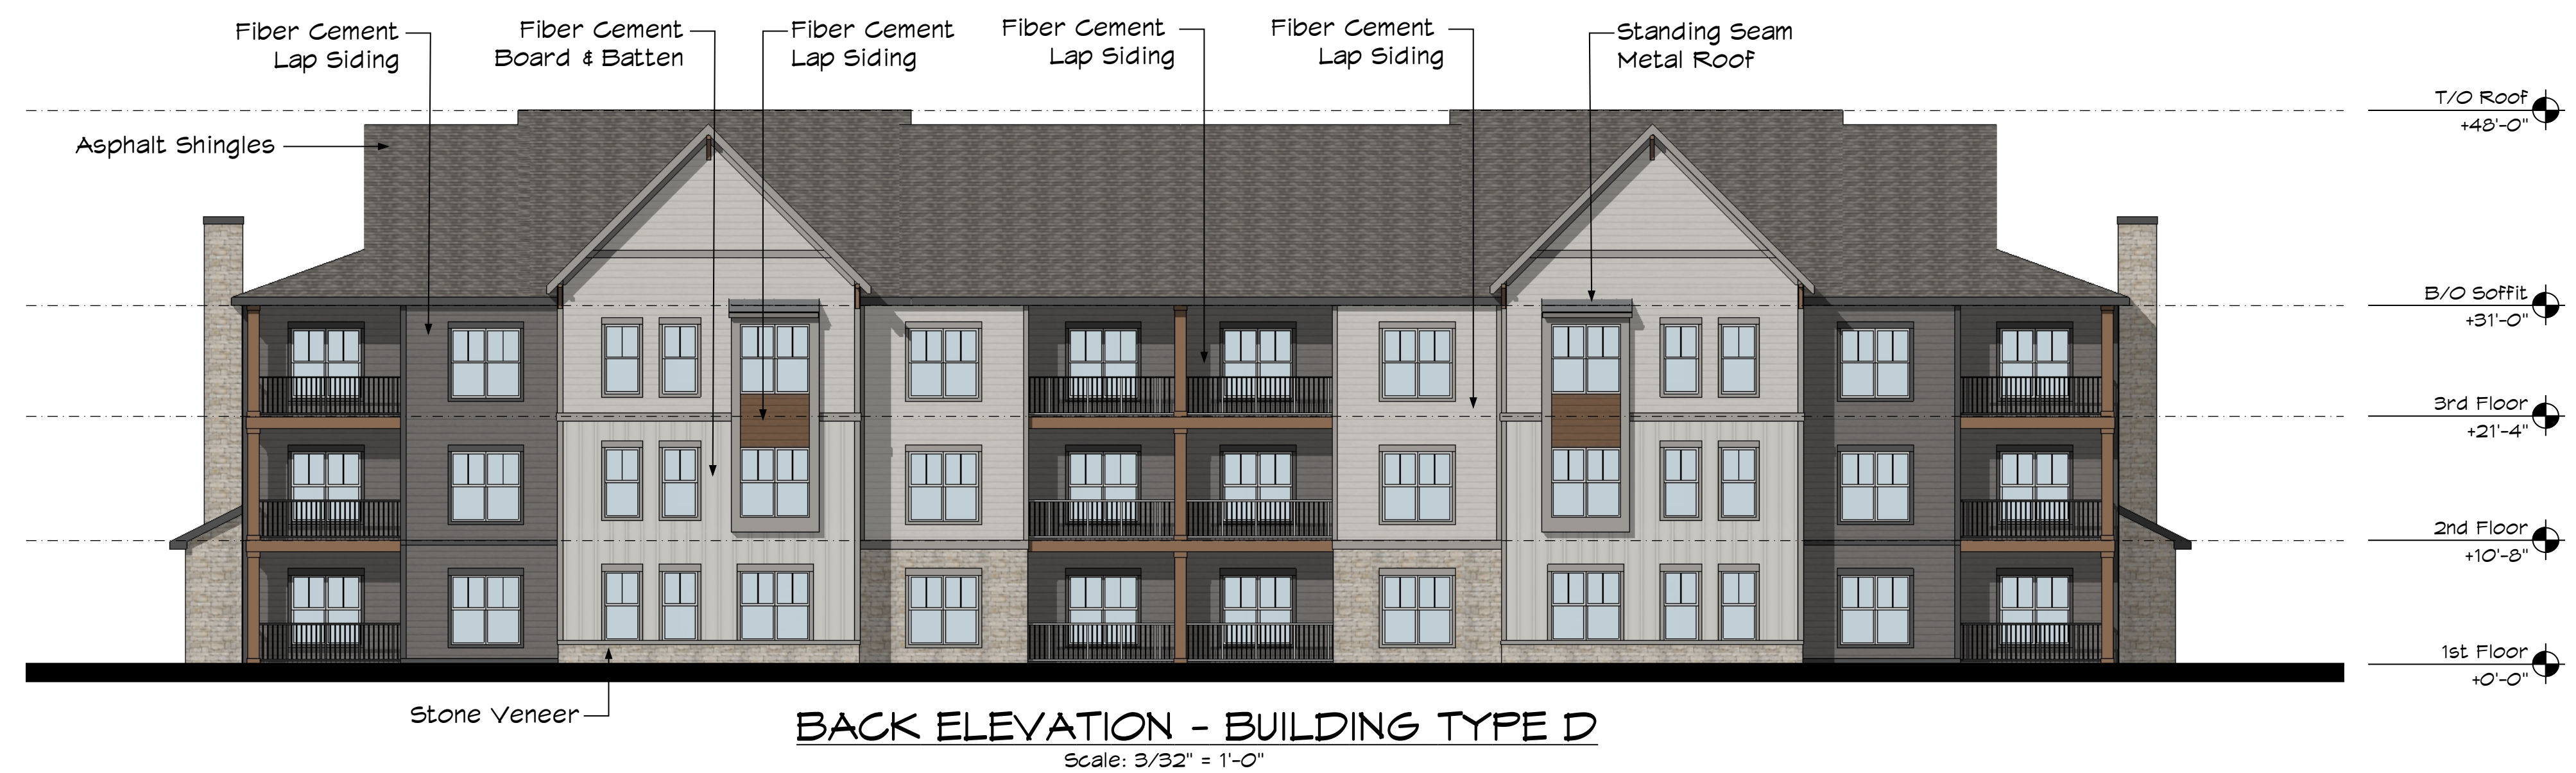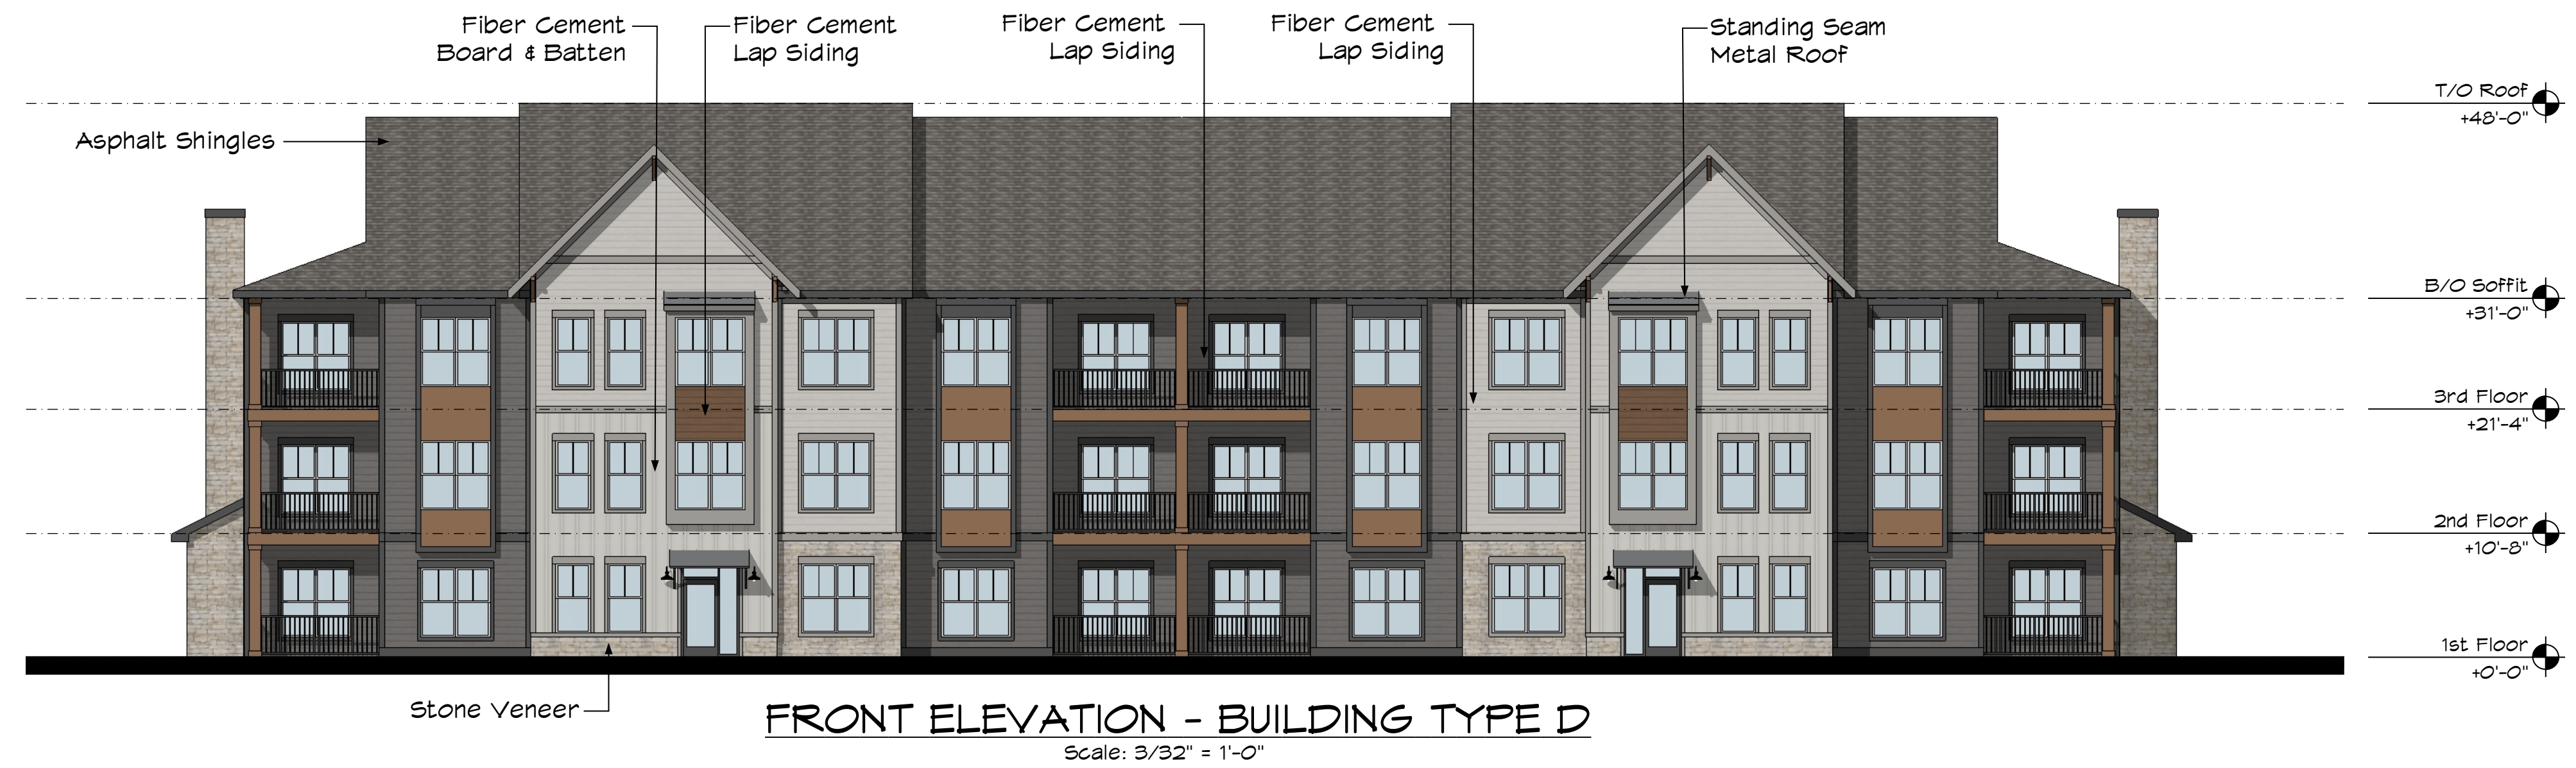


Elevation Plans_V1.pdf Markup Summary

Sophie Kiepe (1)

Because allowed building height is max. 40 height, please show the average roof height to demonstrate that the 40' to top of roof-line still meets the height limitations.

Subject: Stormwater Drainage
Page Label: 12
Author: Sophie Kiepe
Date: 3/18/2021 4:11:45 PM
Status:
Color: 
Layer:
Space:

Because allowed building height is max. 40 height, please show the average roof height to demonstrate that the 48' to top of roof-line still meets the height limitations.