


Provide name
and address for
adjacent
properties

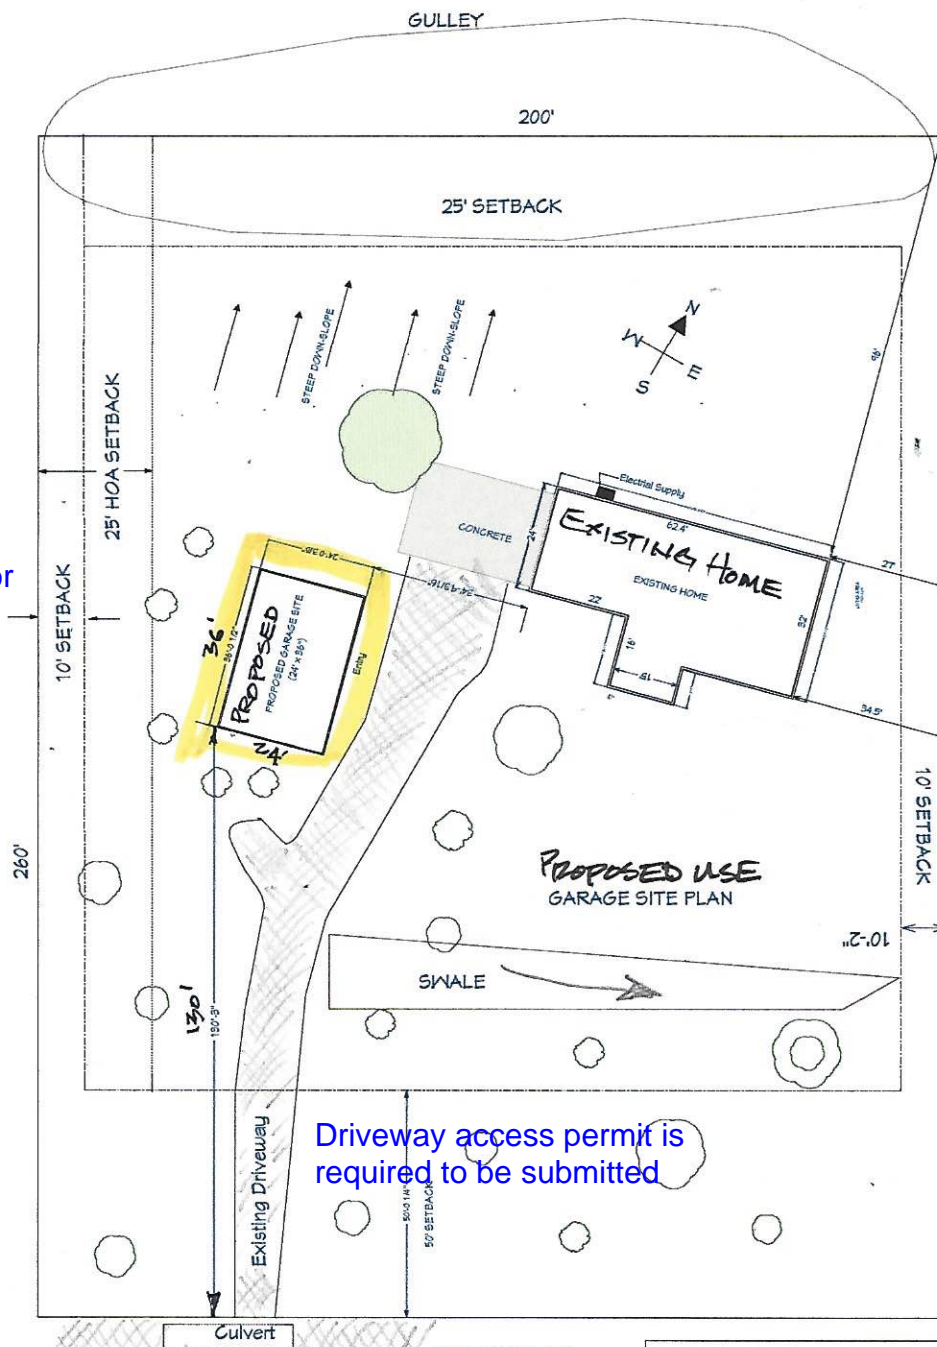


Driveway access permit is
required to be submitted

4670 LIMESTONE RD
OWNERS: Thomas and Lesa Owens

4670 LIMESTONE RD
Lot #36, Parcel# 7117005006
Zone: RR-0.5
Plat# 1435
Red Rock Ranch
Monument, CO 80132

PROPOSED USE SITE PLAN 1/2

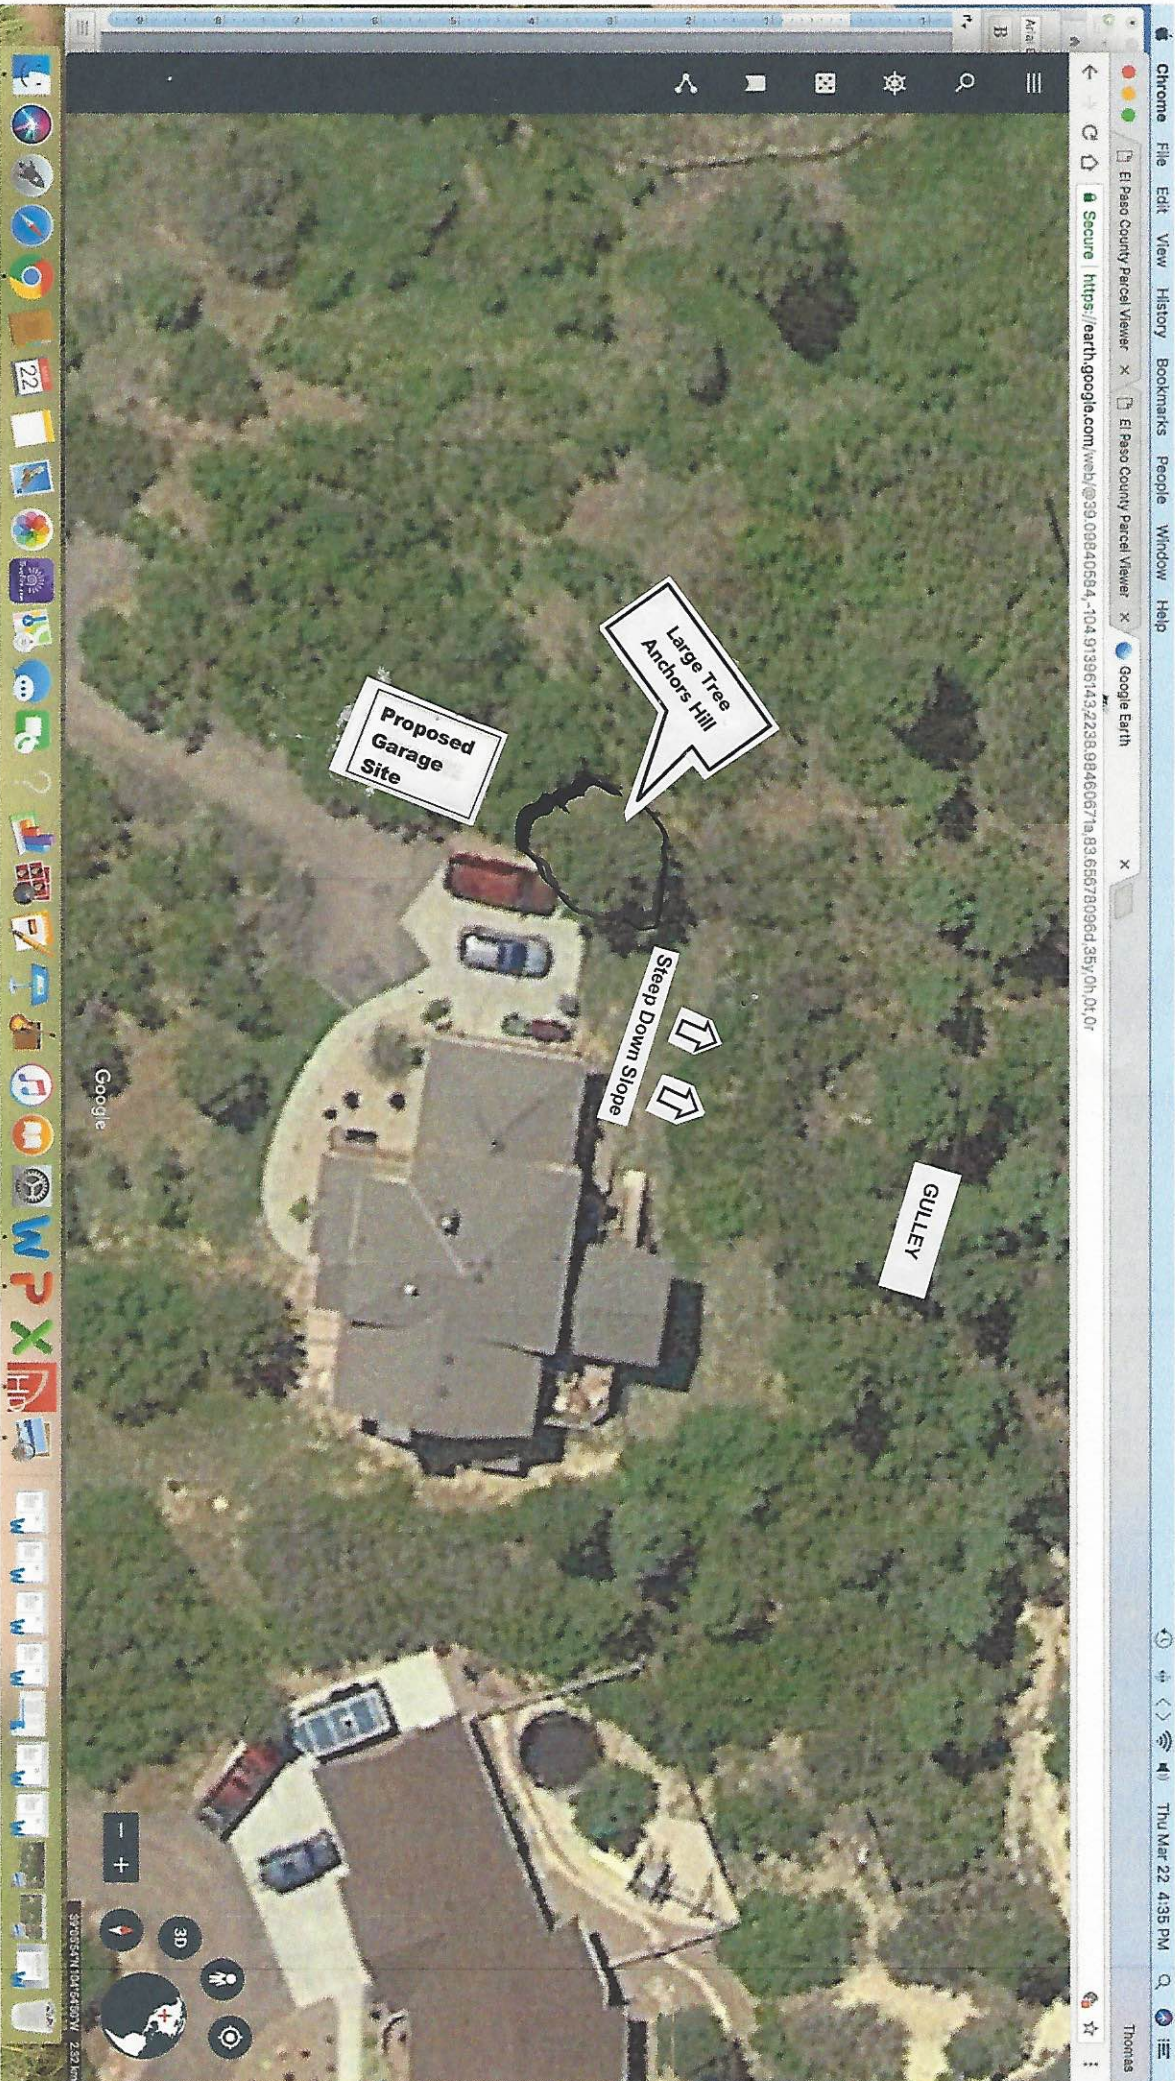

PROPOSED USE SITE PLAN 2/2
(NOT TO SCALE)

Markup Summary

Locked (2)



Subject: Text Box

Page Label: 1

Lock: Locked

Status:


Checkmark: Unchecked

Author: dsdgrimm

Date: 4/20/2018 8:36:59 AM

Color:

Driveway access permit is required to be submitted

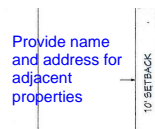

Subject: Text Box

Page Label: 1

Lock: Locked

Status:

Checkmark: Unchecked

Author: dsdgrimm

Date: 4/20/2018 8:37:00 AM

Color:

Provide name and address for adjacent properties