
## V4\_Drainage.pdf Markup Summary

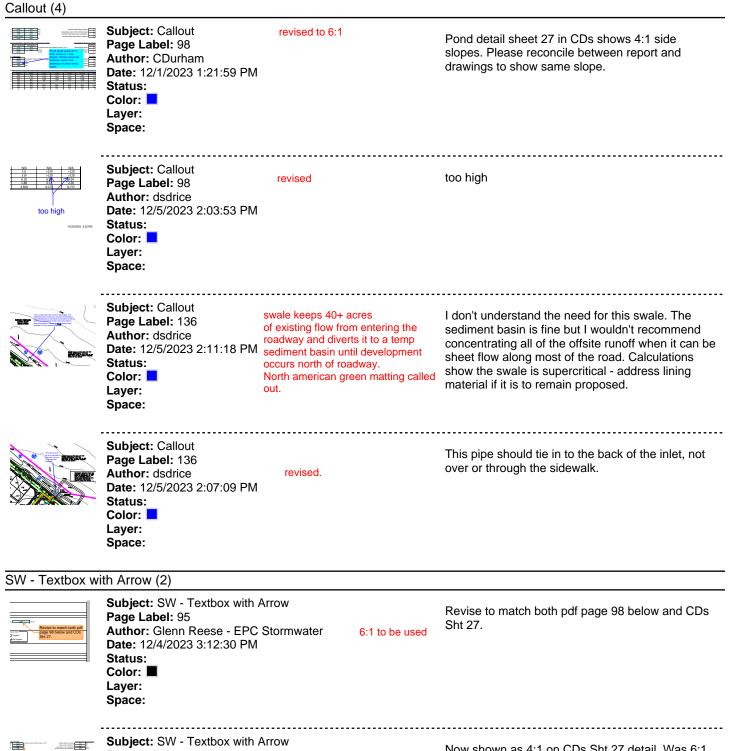

 Subject: SW - Textbox with Arrow

 Page Label: 98

 Author: Glenn Reese - EPC Stormwater

 Date: 12/4/2023 3:12:52 PM

 Status:
 6:1 to be used

 Color: ■

 Layer:

 Space:

Now shown as 4:1 on CDs Sht 27 detail. Was 6:1 on detail with the last submittal

## Text Box (2)

Include scenario for this inlet that includes that overtopping from CPS to show what decausais within report. (Can inlet all function, how deep does flow get in readway, etc)	Subject: Text Box Page Label: 48 Author: CDurham Date: 12/1/2023 1:16:45 PM Status: Color: Layer: Space:	revised inlet no overtopping required	Include scenario for this inlet that includes that overtopping from DP5 to show what happens. Include small discussion within report. (Can inlet still function, how deep does flow get in roadway, etc)
See note on plan. Add a note here and on the plan about the channel lining if it is supercritical.	Subject: Text Box Page Label: 108 Author: dsdrice Date: 12/5/2023 2:09:43 PM Status: Color: Layer: Space:	added	See note on plan. Add a note here and on the plan about the channel lining if it is supercritical.
(3)			
>120 >120 6.89	Subject: Page Label: 98 Author: dsdrice Date: 12/5/2023 1:58:28 PM Status: Color: Layer: Space:	revised.	>120
>120 >120 8.04	Subject: Page Label: 98 Author: dsdrice Date: 12/5/2023 2:03:18 PM Status: Color: Layer: Space:	revised.	>120
1.24 ft 1.293 Supercritical	Subject: Page Label: 108 Author: dsdrice Date: 12/5/2023 2:04:13 PM Status: Color: Layer: Space:	added note about fabric	Supercritical