

FOURSQUARE AT STERLING RANCH EAST FILING NO. 1

A PORTION OF SECTIONS 33 AND 34, TOWNSHIP 12 SOUTH, RANGE 65 WEST OF THE SIXTH PRINCIPAL MERIDIAN, EL PASO COUNTY, COLORADO

BE IT KNOWN BY THESE PRESENTS:

THAT CLASSIC SRJ LAND, LLC, A COLORADO LIMITED LIABILITY COMPANY BEING THE OWNER OF THE FOLLOWING DESCRIBED TRACT OF LAND TO WIT:

LEGAL DESCRIPTION:

A PARCEL OF LAND BEING A PORTION OF SECTIONS 33 AND 34, TOWNSHIP 12 SOUTH, RANGE 65 WEST OF THE SIXTH PRINCIPAL MERIDIAN, EL PASO COUNTY, COLORADO, BEING MORE PARTICULARLY DESCRIBED AS FOLLOWS:

BASIS OF BEARINGS: THE SOUTH LINE OF THE SOUTHEAST QUARTER OF THE NORTHEAST QUARTER OF SECTION 28, TOWNSHIP 12 SOUTH, RANGE 65 WEST OF THE SIXTH PRINCIPAL MERIDIAN, BEING MONUMENTED AT THE WEST END WHICH IS THE CENTER-EAST ONE-SIXTEENTH CORNER OF SAID SECTION 28, BY A 3-1/4" ALUMINUM SURVEYORS CAP STAMPED "ESI PLS 10376, 2006" AND AT THE EAST END, WHICH IS A 30' WITNESS CORNER TO THE EAST OF THE EAST QUARTER CORNER OF SAID SECTION 28, BY A 3-1/4" ALUMINUM SURVEYORS CAP STAMPED "ESI 10376, 2006", IS ASSUMED TO BEAR N89°08'28"E, A DISTANCE OF 1356.68 FEET.

COMMENCING AT THE CENTER-EAST ONE-SIXTEENTH CORNER OF SECTION 28, TOWNSHIP 12 SOUTH, RANGE 65 WEST OF THE SIXTH PRINCIPAL MERIDIAN EL PASO COUNTY, COLORADO, SAID POINT BEING THE SOUTHWESTERLY CORNER OF RETREAT AT TIMBERIDGE FILING NO. 1 RECORDED UNDER RECEPTION NO. 220714653 RECORDS OF EL PASO COUNTY, COLORADO;

THENCE S19°38'14"E, A DISTANCE OF 3075.46 FEET TO THE POINT OF BEGINNING;

THENCE S50°26'12"E, A DISTANCE OF 587.17 FEET TO A POINT OF CURVE;
THENCE ON A CURVE TO THE LEFT, HAVING A DELTA OF 26°05'19", A RADIUS OF 175.00 FEET, AND A DISTANCE OF 79.68 FEET TO A POINT OF TANGENT;
THENCE S76°31'31"E, A DISTANCE OF 326.08 FEET;
THENCE S13°28'29"W, A DISTANCE OF 316.54 FEET;
THENCE S76°31'31"E, A DISTANCE OF 864.70 FEET;
THENCE S13°28'29"W, A DISTANCE OF 564.46 FEET;
THENCE N76°31'31"W, A DISTANCE OF 819.70 FEET TO A POINT ON THE NORTHERLY RIGHT OF WAY LINE OF BRIARGATE PARKWAY AS PLATTED IN HOMESTEAD NORTH AT STERLING RANCH FILING NO. 1 RECORDED UNDER RECEPTION NO. 223715150;

THENCE ON THE NORTHERLY BOUNDARY OF SAID BRIARGATE PARKWAY THE FOLLOWING NINE (9) COURSES:

1. N76°31'31"W, A DISTANCE OF 10.00 FEET
2. N31°31'31"W, A DISTANCE OF 49.51 FEET;
3. N13°28'29"E, A DISTANCE OF 10.00 FEET;
4. N76°31'31"W, A DISTANCE OF 80.00 FEET;
5. S13°28'29"W, A DISTANCE OF 10.00 FEET;
6. S58°28'13"W, A DISTANCE OF 49.50 FEET;
7. N76°31'31"W, A DISTANCE OF 232.57 FEET TO A POINT OF CURVE;
8. ON A CURVE TO THE RIGHT, HAVING A DELTA OF 26°05'19", A RADIUS OF 1,935.00 FEET, AND A DISTANCE OF 881.07 FEET TO A POINT OF TANGENT;
9. N50°26'12"W, A DISTANCE OF 161.33 FEET;

THENCE N05°26'12"W, A DISTANCE OF 28.28 FEET;
THENCE N39°33'48"E, A DISTANCE OF 960.00 FEET TO THE POINT OF BEGINNING.

CONTAINING A CALCULATED AREA OF 36.647 ACRES (1,596,330 SF).

ACCEPTANCE CERTIFICATE FOR TRACTS

THE DEDICATION OF TRACTS A, B, C, D, E, F, G AND H WITH USE STATED IN THE TRACT TABLE, IS HEREBY ACCEPTED FOR OWNERSHIP AND MAINTENANCE BY STERLING RANCH METROPOLITAN DISTRICT NO. 3.

BY: _____

AS: _____

OF STERLING RANCH METROPOLITAN DISTRICT NO. 3.

STATE OF COLORADO)

COUNTY OF EL PASO) ss

THE FOREGOING INSTRUMENT WAS ACKNOWLEDGED BEFORE ME THIS _____ DAY OF _____, 20____, A.D. BY _____ AS _____ OF STERLING RANCH METROPOLITAN DISTRICT NO. 3.

WITNESS MY HAND AND OFFICIAL SEAL.

MY COMMISSION EXPIRES: _____ NOTARY PUBLIC

ACCEPTANCE CERTIFICATE FOR TRACTS

THE DEDICATION OF TRACT I WITH USE STATED IN THE TRACT TABLE, IS HEREBY ACCEPTED FOR MAINTENANCE BY STERLING RANCH METROPOLITAN DISTRICT NO. 3.

BY: _____

AS: _____

OF EL PASO COUNTY


STATE OF COLORADO)

COUNTY OF EL PASO) ss

THE FOREGOING INSTRUMENT WAS ACKNOWLEDGED BEFORE ME THIS _____ DAY OF _____, 20____, A.D. BY _____ AS _____ OF STERLING RANCH METROPOLITAN DISTRICT NO. 3.

WITNESS MY HAND AND OFFICIAL SEAL.

MY COMMISSION EXPIRES: _____ NOTARY PUBLIC

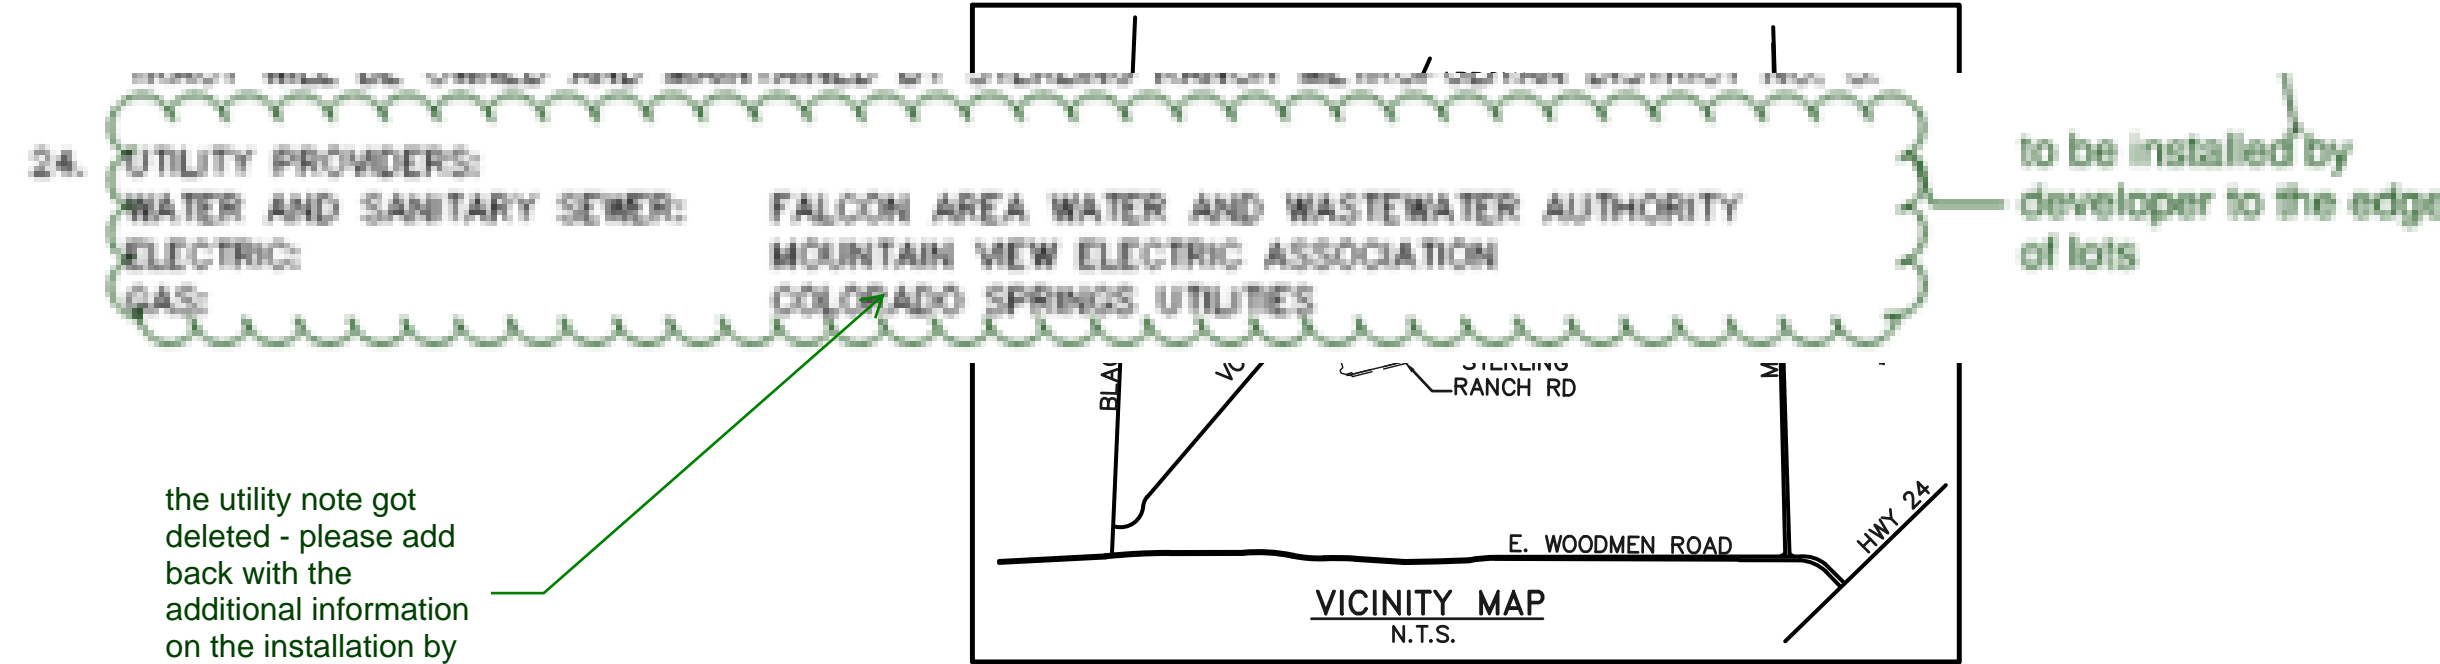

OWNERS CERTIFICATE:

THE UNDERSIGNED, BEING ALL THE OWNERS, MORTGAGEES, BENEFICIARIES OF DEEDS OF TRUST AND HOLDERS OF OTHER INTERESTS IN THE LAND DESCRIBED HEREIN, HAVE LAID OUT, SUBDIVIDED, AND PLATTED SAID LANDS INTO LOTS, TRACTS, STREETS, AND EASEMENTS AS SHOWN HEREON UNDER THE NAME AND SUBDIVISION OF FOURSQUARE AT STERLING RANCH EAST FILING NO. 1. ALL PUBLIC IMPROVEMENTS SO PLATTED ARE HEREBY DEDICATED TO PUBLIC USE AND SAID OWNER DOES HEREBY COVENANT AND AGREE THAT THE PUBLIC IMPROVEMENTS WILL BE CONSTRUCTED TO EL PASO COUNTY STANDARDS AND THAT PROPER DRAINAGE AND EROSION CONTROL FOR SAME WILL BE PROVIDED AT SAID OWNER'S EXPENSE, ALL TO THE SATISFACTION OF THE BOARD OF COUNTY COMMISSIONERS OF EL PASO COUNTY, COLORADO. UPON ACCEPTANCE BY RESOLUTION, ALL PUBLIC IMPROVEMENTS SO DEDICATED WILL BECOME MATTERS OF MAINTENANCE BY EL PASO COUNTY, COLORADO. THE UTILITY EASEMENTS SHOWN HEREON ARE HEREBY DEDICATED FOR PUBLIC UTILITIES AND COMMUNICATION SYSTEMS AND OTHER PURPOSES AS SHOWN HEREON. THE ENTITIES RESPONSIBLE FOR PROVIDING THE SERVICES FOR WHICH THE EASEMENTS ARE ESTABLISHED ARE HEREBY GRANTED THE PERPETUAL RIGHT OF INGRESS AND EGRESS FROM AND TO ADJACENT PROPERTIES FOR INSTALLATION, MAINTENANCE, AND REPLACEMENT OF UTILITY LINES AND RELATED FACILITIES.

OWNER:

THE AFOREMENTIONED, CLASSIC SRJ LAND, LLC, A COLORADO LIMITED LIABILITY COMPANY HAS EXECUTED THIS INSTRUMENT THIS ____ DAY OF _____, 20____, A.D.

BY: DOUGLAS M. STIMPLE, CEO, ELITE PROPERTIES OF AMERICA, INC. MANAGER OF CLASSIC SRJ LAND, LLC, A COLORADO LIMITED LIABILITY COMPANY.

STATE OF COLORADO)

COUNTY OF EL PASO) ss

THE FOREGOING INSTRUMENT WAS ACKNOWLEDGED BEFORE ME THIS _____ DAY OF _____, 20____, A.D. BY DOUGLAS M. STIMPLE, AS CEO, ELITE PROPERTIES OF AMERICA INC. MANAGER OF CLASSIC SRJ LAND, LLC, A COLORADO LIMITED LIABILITY COMPANY.

WITNESS MY HAND AND OFFICIAL SEAL.

MY COMMISSION EXPIRES: _____ NOTARY PUBLIC

GENERAL NOTES:

1. THE DATE OF PREPARATION IS NOVEMBER 2, 2023.
2. THE TRACT OF LAND HEREIN PLATTED LIES WITHIN SECTIONS 33 AND 34, TOWNSHIP 12 SOUTH, RANGE 65 WEST OF THE SIXTH PRINCIPAL MERIDIAN.
3. UNLESS SHOWN GREATER IN WIDTH, BOTH SIDES OF ALL SIDE LOT LINES ARE HEREBY PLATTED WITH A FIVE (5) FOOT EASEMENT FOR PUBLIC UTILITIES AND DRAINAGE, ALL REAR LOT LINES ARE HEREBY PLATTED WITH A FIVE (5) FOOT EASEMENT FOR PUBLIC UTILITIES AND DRAINAGE PURPOSES, A FIVE (5) FOOT EASEMENT ALONG THE FRONT AND/OR SIDE OF ANY LOT ABUTTING A 50' WIDE RIGHT-OF-WAY FOR PUBLIC UTILITIES AND PUBLIC IMPROVEMENT PURPOSES, AND A TEN (10) FOOT EASEMENT, AS SHOWN ON THIS PLAT, FOR PUBLIC UTILITIES, WITH THE SOLE RESPONSIBILITY FOR MAINTENANCE BEING VESTED WITH THE INDIVIDUAL PROPERTY OWNERS.
4. A FIVE (5) FOOT EASEMENT AT THE REAR LOT LINES OF LOTS 83-94 FOR WALL EASEMENT WITH THE SOLE RESPONSIBILITY FOR MAINTENANCE BEING VESTED WITH METROPOLITAN DISTRICT 3.
5. THE FOLLOWING REPORTS HAVE BEEN SUBMITTED AND ARE ON FILE AT THE COUNTY PLANNING AND COMMUNITY DEVELOPMENT: SOILS AND GEOLOGICAL STUDY, WATER AVAILABILITY STUDY, DRAINAGE REPORTS, EROSION CONTROL REPORT AND TRAFFIC STUDY IN FILE NO. PUD SP 227.
6. THE TOTAL NUMBER OF LOTS BEING PLATTED IS 158. THE TOTAL NUMBER OF TRACTS BEING PLATTED IS 9.
7. THE PROPERTY WITHIN THIS SUBDIVISION IS INCLUDED IN STERLING RANCH METROPOLITAN DISTRICT NO. 1, AS EVIDENCED BY INSTRUMENT RECORDED UNDER RECEPTION NO. 211023430 AND AS AMENDED.
8. STERLING RANCH METROPOLITAN DISTRICT NO. 3, IS EVIDENCED BY INSTRUMENT RECORDED UNDER RECEPTION NO. 211023432 AND AS AMENDED.
9. DEVELOPER SHALL COMPLY WITH FEDERAL AND STATE LAWS, REGULATIONS, ORDINANCES, REVIEW AND PERMIT REQUIREMENTS, AND OTHER AGENCY REQUIREMENTS, IF ANY, OF A APPLICABLE AGENCIES INCLUDING, BUT NOT LIMITED TO, THE COLORADO DEPARTMENT OF PARKS AND WILDLIFE, COLORADO DEPARTMENT OF TRANSPORTATION, U.S. ARMY CORP. OF ENGINEERS, THE U.S. FISH & WILDLIFE SERVICE AND/OR COLORADO DEPARTMENT OF WILDLIFE REGARDING THE ENDANGERED SPECIES ACT.
10. THE ADDRESSES () EXHIBITED ON THIS PLAT ARE FOR INFORMATIONAL PURPOSES ONLY. THEY ARE NOT THE LEGAL DESCRIPTION AND ARE SUBJECT TO CHANGE.
11. FLOODPLAIN STATEMENT: THIS SITE, FOURSQUARE AT STERLING RANCH EAST FILING NO. 1, IS NOT WITHIN A DESIGNATED F.E.M.A. FLOODPLAIN AS DETERMINED BY THE FLOOD INSURANCE RATE MAP, MAP NUMBER 0804100533G AND 0804100535G, DATED DECEMBER 7, 2018. (ZONE X)
12. NO LOT OR INTEREST THEREIN, SHALL BE SOLD, CONVEYED, OR TRANSFERRED WHETHER BY DEED OR BY CONTRACT, NOR SHALL BUILDING PERMITS BE ISSUED, UNTIL AND UNLESS EITHER THE REQUIRED PUBLIC AND COMMON DEVELOPMENT IMPROVEMENTS HAVE BEEN CONSTRUCTED AND COMPLETED AND PRELIMINARILY ACCEPTED IN ACCORDANCE WITH THE SUBDIVISION IMPROVEMENTS AGREEMENT BETWEEN THE APPLICANT/OWNER AND EL PASO COUNTY AS RECORDED UNDER RECEPTION NO. _____ IN THE OFFICE OF THE CLERK AND RECORDER OF EL PASO COUNTY, COLORADO OR, IN THE ALTERNATIVE, OTHER COLLATERAL IS PROVIDED TO MAKE PROVISION FOR THE COMPLETION OF SAID IMPROVEMENTS IN ACCORDANCE WITH THE EL PASO COUNTY LAND DEVELOPMENT CODE AND ENGINEERING CRITERIA MANUAL. ANY SUCH ALTERNATIVE COLLATERAL MUST BE APPROVED BY THE BOARD OF COUNTY COMMISSIONERS OR, IF PERMITTED BY THE SUBDIVISION IMPROVEMENTS AGREEMENT, BY THE EXECUTIVE DIRECTOR AND MEET THE POLICY AND PROCEDURE REQUIREMENTS OF EL PASO COUNTY PRIOR TO THE RELEASE BY THE COUNTY OF ANY LOTS FOR SALE OR CONVEYANCE OR TRANSFER. THIS PLAT RESTRICTION MAY BE REMOVED OR RESCINDED BY THE BOARD OF COUNTY COMMISSIONERS OR, IF PERMITTED BY THE SUBDIVISION IMPROVEMENTS AGREEMENT, BY THE PLANNING AND COMMUNITY DEVELOPMENT EXECUTIVE DIRECTOR UPON EITHER APPROVAL OF AN ALTERNATIVE FORM OF COLLATERAL OR COMPLETION AND PRELIMINARY ACCEPTANCE BY THE EL PASO BOARD OF COUNTY COMMISSIONERS OF ALL IMPROVEMENTS REQUIRED TO BE CONSTRUCTED AND COMPLETED IN ACCORDANCE WITH SAID SUBDIVISION IMPROVEMENTS AGREEMENT. THE PARTIAL RELEASE OF LOTS FOR SALE, CONVEYANCE OR TRANSFER MAY ONLY BE GRANTED IN ACCORDANCE WITH ANY PLANNED PARTIAL RELEASE OF LOTS AUTHORIZED BY THE SUBDIVISION IMPROVEMENTS AGREEMENT.

GENERAL NOTES (CONT.):

12. THIS PLAT IS REGULATED BY FOURSQUARE P.U.D. AT STERLING RANCH DEVELOPMENT PLAN P.U.D. DEVELOPMENT PLAN AND P.U.D. DEVELOPMENT GUIDELINES AS RECORDED UNDER RECEPTION NO. 223071636 OF THE RECORDS OF EL PASO COUNTY AND AS AMENDED.
13. MAILBOXES SHALL BE INSTALLED IN ACCORDANCE WITH ALL EL PASO COUNTY DEPARTMENT OF PUBLIC WORKS AND UNITED STATES POSTAL SERVICE REGULATIONS.
14. FIRE PROTECTION IS BY BLACK FOREST FIRE PROTECTION DISTRICT.
15. ANY PERSON WHO KNOWINGLY REMOVES, ALTERS OR DEFACES ANY PUBLIC LAND SURVEY MONUMENT OR LAND BOUNDARY MONUMENT OR ACCESSORY, COMMITS A CLASS TWO (2) MISDEMEANOR PURSUANT TO STATE STATUTE 18-4-508, C.R.S.
16. THIS PLAT DOES NOT CONSTITUTE A TITLE SEARCH TO DETERMINE OWNERSHIP OR EASEMENTS OF RECORD. FOR ALL INFORMATION REGARDING EASEMENTS, RIGHT-OF-WAY AND TITLE OF RECORD, CLASSIC CONSULTING ENGINEERS AND SURVEYORS AND THE SURVEYOR OF RECORD RELIED UPON THE TITLE COMMITMENT ORDER NUMBER RND55101996.4 PREPARED BY LAND TITLE GUARANTEE COMPANY, WITH AN EFFECTIVE DATE OF NOVEMBER 29, 2022 AT 5:00 P.M.
17. PURSUANT TO RESOLUTION _____, APPROVED BY THE BOARD OF DIRECTORS, EL PASO COUNTY PUBLIC IMPROVEMENT DISTRICT AND RECORDED IN THE RECORDS OF THE EL PASO COUNTY CLERK AND RECORDED AT RECEPTION NO. _____, THE PARCELS WITHIN THE PLATTED BOUNDARY OF FOURSQUARE AT STERLING RANCH EAST FILING NO. 1 IS INCLUDED WITHIN THE BOUNDARIES OF THE EL PASO COUNTY PUBLIC IMPROVEMENT DISTRICT NO. 3 AND AS SUCH ARE SUBJECT TO APPLICABLE ROAD IMPACT FEES AND MILL LEVY.
18. A DRIVEWAY PERMIT IS REQUIRED TO BE APPLIED FOR AND APPROVED BY EL PASO COUNTY PRIOR TO THE ESTABLISHMENT OF ANY DRIVEWAY.
19. ALL PROPERTY OWNERS ARE RESPONSIBLE FOR MAINTAINING PROPER STORM WATER DRAINAGE IN AND THROUGH THEIR PROPERTY. PUBLIC DRAINAGE EASEMENTS AS SPECIFICALLY NOTED ON THE PLAT SHALL BE MAINTAINED BY THE INDIVIDUAL LOT OWNERS UNLESS OTHERWISE INDICATED. HOMEOWNERS ARE RESPONSIBLE TO ENSURE PROPER DRAINAGE AROUND STRUCTURES INCLUDING ELEVATIONS OF FOUNDATIONS AND WINDOW WELLS IN RELATION TO SIDE-LOT DRAINAGE EASEMENTS AND SWALES. HOMEOWNERS SHALL NOT CHANGE THE GRADE OF THE LOT OR DRAINAGE SWALES WITHIN SAID EASEMENTS, AS CONSTRUCTED BY THE BUILDER, IN A MANNER THAT WOULD CAUSE ADVERSE DRAINAGE IMPACTS TO PROPERTIES, STRUCTURES, FENCES, MATERIALS OR LANDSCAPING THAT COULD IMPEDE THE FLOW OF RUNOFF SHALL NOT BE PLACED IN DRAINAGE EASEMENTS.
20. INDIVIDUAL LOT PURCHASERS ARE RESPONSIBLE FOR CONSTRUCTING DRIVEWAYS, INCLUDING NECESSARY DRAINAGE CULVERTS PER LAND DEVELOPMENT CODE SECTION 6.3.3.C.2 AND 6.3.3.C.3.
21. BASIS OF BEARINGS: THE SOUTH LINE OF THE SOUTHEAST QUARTER OF THE NORTHEAST QUARTER OF SECTION 28, TOWNSHIP 12 SOUTH, RANGE 65 WEST OF THE SIXTH PRINCIPAL MERIDIAN, BEING MONUMENTED AT THE WEST END WHICH IS THE SOUTHWESTERLY CORNER OF THE SOUTHEAST QUARTER OF THE NORTHEAST QUARTER OF SAID SECTION 28, BY A 3-1/4" ALUMINUM SURVEYORS CAP STAMPED "ESI PLS 10376, 2006" AND AT THE EAST END, WHICH IS A 30' WITNESS CORNER TO THE EAST OF THE EAST QUARTER CORNER OF SAID SECTION 28, BY A 3-1/4" ALUMINUM SURVEYORS CAP STAMPED "ESI PLS 10376, 2006", IS ASSUMED TO BEAR S89°08'28"W A DISTANCE OF 1356.68 FEET.
22. TRACTS A, B, C, E, F, G AND H ARE FOR LANDSCAPE, PARK, UTILITIES, PUBLIC IMPROVEMENTS, UTILITIES, STORMWATER/ DRAINAGE, MAIL KIOSK, TRAILS, FENCING. TRACT WILL BE OWNED AND MAINTAINED BY STERLING RANCH METROPOLITAN DISTRICT NO. 3. OWNERSHIP OF SAID TRACTS TO BE CONVEYED BY SEPARATE DOCUMENT.
23. TRACT D IS FOR WALL, LANDSCAPE, PARK, UTILITIES, PUBLIC IMPROVEMENTS, UTILITIES, STORMWATER/ DRAINAGE, MAIL KIOSK, TRAILS, FENCING. TRACT WILL BE OWNED AND MAINTAINED BY STERLING RANCH METROPOLITAN DISTRICT NO. 3. OWNERSHIP OF SAID TRACTS TO BE CONVEYED BY SEPARATE DOCUMENT.
24. TRACT I IS FOR LANDSCAPING, STORMWATER/DRAINAGE, PARK, OPEN SPACE, MAINTENANCE TRAIL AND PUBLIC UTILITIES. TRACT WILL BE OWNED AND MAINTAINED BY STERLING RANCH METROPOLITAN DISTRICT NO. 3.
25. CLASSIC SRJ LAND, LLC IS RESPONSIBLE FOR EXTENDING UTILITIES TO EACH LOT, TRACT OR BUILDING SITE. WATER AND WASTEWATER SERVICE IS PROVIDED BY FALCON AREA WATER AND WASTEWATER AUTHORITY SUBJECT TO THE PROVIDERS RULES, REGULATIONS AND SPECIFICATIONS. ELECTRIC SERVICE FOR THIS SUBDIVISION IS PROVIDED BY MOUNTAIN VIEW ELECTRIC ASSOCIATION SUBJECT TO THE PROVIDERS RULES, REGULATIONS AND SPECIFICATIONS. GAS SERVICE FOR THIS SUBDIVISION IS PROVIDED BY COLORADO SPRINGS UTILITIES SUBJECT TO THE PROVIDERS RULES, REGULATIONS AND SPECIFICATIONS.
26. ALL STRUCTURAL FOUNDATIONS SHALL BE DESIGNED BY A PROFESSIONAL ENGINEER CURRENTLY LICENSED IN THE STATE OF COLORADO.
27. WATER IN THE DENVER BASIN AQUIFERS IS ALLOCATED ON A 100 YEAR AQUIFER LIFE. HOWEVER, FOR EL PASO COUNTY PLANNING PURPOSES, WATER IN THE DENVER BASIN AQUIFERS IS EVALUATED BASED ON A 300 YEAR AQUIFER LIFE. APPLICANTS AND ALL FUTURE OWNERS IN THE SUBDIVISION SHOULD BE AWARE THAT THE ECONOMIC LIFE OF A WATER SUPPLY BASED ON WELLS IN A GIVEN DENVER BASIN AQUIFER MAY BE LESS THAN EITHER THE 100 YEARS OR 300 YEARS USED FOR ALLOCATION INDICATED DUE TO ANTICIPATED WATER LEVEL DECLINES. FURTHERMORE, THE WATER SUPPLY PLAN SHOULD NOT RELY SOLELY UPON NON-RENEWABLE AQUIFERS. ALTERNATIVE RENEWABLE WATER RESOURCES SHOULD BE ACQUIRED AND INCORPORATED IN A PERMANENT WATER SUPPLY PLAN THAT PROVIDES FUTURE GENERATIONS WITH A WATER SUPPLY.
28. THERE SHALL BE NO DIRECT VEHICULAR ACCESS FROM ANY LOT TO BRIARGATE PARKWAY OR STERLING RANCH ROAD.
29. THE UNDERDRAIN CONSTRUCTED BY THE DEVELOPER, ACCORDING TO PLANS APPROVED BY THE STERLING RANCH METROPOLITAN DISTRICT SHALL BE MAINTAINED BY STERLING RANCH METROPOLITAN DISTRICT NO. 3. THIS PROPERTY IS SUBJECT TO A GROUNDWATER UNDERDRAIN LICENSE AGREEMENT RECORDED UNDER RECEPTION NO. _____ OF THE RECORDS OF EL PASO COUNTY.
30. THIS PROPERTY IS SUBJECT TO A PRIVATE DETENTION BASIN/STORMWATER QUALITY BMP MAINTENANCE AGREEMENT AND EASEMENT AS RECORDED UNDER RECEPTION NO. _____ OF THE RECORDS OF EL PASO COUNTY, STERLING RANCH METROPOLITAN DISTRICT NO. 3 IS RESPONSIBLE FOR MAINTENANCE OF THE SUBJECT DRAINAGE FACILITIES.
31. SOIL AND GEOLOGY CONDITIONS: GEOLOGIC HAZARD NOTE: THE OVERALL SITE HAS BEEN FOUND TO BE IMPACTED BY GEOLOGIC HAZARDS. MITIGATION MEASURES AND A MAP OF THE HAZARD AREA CAN BE FOUND IN THE REPORT "SOIL, GEOLOGY, AND GEOLOGIC HAZARD STUDY FOR FOURSQUARE AT STERLING RANCH EAST PRELIMINARY PLAN NO. 2-PARCEL NO.19, EL PASO COUNTY, COLORADO" BY ENTECH ENGINEERING, INC. DATED SEPT. 15, 2022 IN FILE PUD SP-22-227 AVAILABLE AT THE EL PASO COUNTY PLANNING AND COMMUNITY DEVELOPMENT DEPARTMENT.
 - POTENTIALLY UNSTABLE SLOPE AREAS - THE ENTIRE SITE WILL BE REGRADED AND SLOPES WILL BE PROPERLY BENCH TO NOT CREATE ANY UNSTABLE SLOPE CONDITIONS.
 - RADON - AS THESE SINGLE FAMILY DETACHED HOMES WILL NOT BE CONSTRUCTED WITH BASEMENTS, INCREASED VENTILATION IS NOT REQUIRED.
32. NO BASEMENTS ARE ALLOWED IN THE FOURSQUARE AT STERLING RANCH DEVELOPMENT.

SUMMARY TABLE:

	SQUARE FEET	PERCENTAGE	OWNER	MAINTENANCE
TRACTS A, B, C, E, F, G & H (LANDSCAPE, PARK, TRAILS, UTILITIES, PUBLIC IMPROVEMENTS, UTILITIES, STORMWATER MAIL KIOSK, FENCING)	220,790	13.83%	METROPOLITAN DISTRICT NO. 3	METROPOLITAN DISTRICT NO. 3
TRACT D (WALL, LANDSCAPE, PARK, TRAILS, UTILITIES, PUBLIC IMPROVEMENTS, UTILITIES, STORMWATER MAIL KIOSK, FENCING)	4,220	0.27%	METROPOLITAN DISTRICT NO. 3	METROPOLITAN DISTRICT NO. 3
TRACT I (LANDSCAPE, PARK, TRAIL, OPEN SPACE, UTILITIES, STORMWATER/DRAINAGE)	485,981	30.44%	METROPOLITAN DISTRICT NO. 3	METROPOLITAN DISTRICT NO. 3
LOTS (158 TOTAL)	591,599	37.06%	INDIVIDUAL LOT OWNERS	
R.O.W.	293,740	18.40%	COUNTY	COUNTY
TOTAL	1,596,330	100.00%		

SURVEYOR'S STATEMENT:

I, ROBERT L. MEADOWS JR., A DULY LICENSED PROFESSIONAL LAND SURVEYOR IN THE STATE OF COLORADO, DO HEREBY CERTIFY THIS PLAT TRULY AND CORRECTLY REPRESENTS THE RESULTS OF A SURVEY MADE ON DATE OF SURVEY, BY ME OR UNDER MY DIRECT SUPERVISION AND THAT ALL MONUMENTS EXIST AS SHOWN HEREON; THAT MATHEMATICAL CLOSURE ERRORS ARE LESS THAN 1:10,000; AND THAT SAID PLAT HAS BEEN PREPARED IN FULL COMPLIANCE WITH ALL APPLICABLE LAWS OF THE STATE OF COLORADO DEALING WITH MONUMENTS, SUBDIVISION, OR SURVEYING OF LAND AND ALL APPLICABLE PROVISION OF THE EL PASO COUNTY LAND DEVELOPMENT CODE.

I ATTEST THE ABOVE ON THIS _____ DAY OF _____, 20____.

ROBERT L. MEADOWS JR., PROFESSIONAL LAND SURVEYOR DATE _____
COLORADO P.L.S. NO. 34977 FOR AND ON BEHALF OF
CLASSIC CONSULTING, ENGINEERS AND SURVEYORS, LLC.

NOTICE:

ACCORDING TO COLORADO LAW YOU **MUST** COMMENCE ANY LEGAL ACTION BASED UPON ANY DEFECT IN THIS SURVEY WITHIN THREE YEARS AFTER YOU FIRST DISCOVER SUCH DEFECT. IN NO EVENT, MAY ANY ACTION BASED UPON ANY DEFECT IN THIS SURVEY BE COMMENCED MORE THAN TEN YEARS FROM THE DATE OF THE CERTIFICATION SHOWN HEREON.

COUNTY APPROVAL CERTIFICATE:

THIS PLAT FOR FOURSQUARE AT STERLING RANCH EAST FILING NO. 1 WAS APPROVED FOR FILING BY THE EXECUTIVE DIRECTOR OF THE EL PASO COUNTY PLANNING AND COMMUNITY DEVELOPMENT DEPARTMENT ON THIS ____ DAY OF _____, 20____, SUBJECT TO ANY NOTES SPECIFIED HEREON AND ANY CONDITIONS INCLUDED IN THE RECORD OF ADMINISTRATIVE DETERMINATION. THE DEDICATIONS OF LAND TO THE PUBLIC (STREETS AND EASEMENTS) ARE ACCEPTED, BUT PUBLIC IMPROVEMENTS THEREON WILL NOT BECOME MAINTENANCE RESPONSIBILITY OF EL PASO COUNTY UNTIL PRELIMINARY ACCEPTANCE OF THE PUBLIC IMPROVEMENTS IN ACCORDANCE WITH THE REQUIREMENTS OF THE LAND DEVELOPMENT CODE AND ENGINEERING CRITERIA MANUAL AND THE SUBDIVISION IMPROVEMENTS AGREEMENT.

EXECUTIVE DIRECTOR OF PLANNING AND COMMUNITY DEVELOPMENT DEPARTMENT DATE _____

THE SUBDIVIDER AGREES ON BEHALF OF HIMSELF/HERSELF AND ANY DEVELOPER OR BUILDER SUCCESSORS AND ASSIGNEES THAT SUBDIVIDER AND/OR SAID SUCCESSORS AND ASSIGNS SHALL BE REQUIRED TO PAY TRAFFIC IMPACT FEES IN ACCORDANCE WITH THE EL PASO COUNTY ROAD IMPACT FEE PROGRAM RESOLUTION (RESOLUTION 19-471), OR ANY AMENDMENTS THERETO, AT OR PRIOR TO THE TIME OF BUILDING PERMIT SUBMITTALS. THE FEE OBLIGATION, IF NOT PAID AT FINAL PLAT RECORDING, SHALL BE DOCUMENTED ON ALL SALES DOCUMENTS AND ON PLAT NOTES TO ENSURE THAT A TITLE SEARCH WOULD FIND THE FEE OBLIGATION BEFORE SALE OF THE PROPERTY.

CLERK AND RECORDER:

STATE OF COLORADO)

COUNTY OF EL PASO) ss

I HEREBY CERTIFY THAT THIS INSTRUMENT WAS FILED FOR RECORD IN MY OFFICE AT O'CLOCK ____ M. THIS _____ DAY OF _____, 20____, A.D., AND IS DULY RECORDED AT RECEPTION NO. _____ OF THE RECORDS OF EL PASO COUNTY, COLORADO.

STEVE SCHLEIKER, RECORDER

BY: _____ DEPUTY

DRAINAGE: SAND CREEK

DRAINAGE BASIN: _____

DRAINAGE FEES: _____

BRIDGE FEES: _____

URBAN PARK: _____

REGIONAL PARK: _____

SCHOOL FEE: _____

ACADEMY SCHOOL DISTRICT NO. 20
FALCON SCHOOL DISTRICT NO. 49

OWNER:
CLASSIC SRJ LAND, LLC
2138 FLYING HORSE CLUB DRIVE
COLORADO SPRINGS, CO 80921

NOVEMBER 2, 2023

SHEET 1 OF 6





NO.	REVISION	DATE




FOURSQUARE AT STERLING RANCH EAST FILING NO. 1
JOB NO. 1183.23
NOVEMBER 2, 2023
SHEET 1 OF 6

FOURSQUARE AT STERLING RANCH EAST FILING NO. 1

A PORTION OF SECTIONS 33 AND 34, TOWNSHIP 12 SOUTH,
RANGE 65 WEST OF THE SIXTH PRINCIPAL MERIDIAN,
EL PASO COUNTY, COLORADO

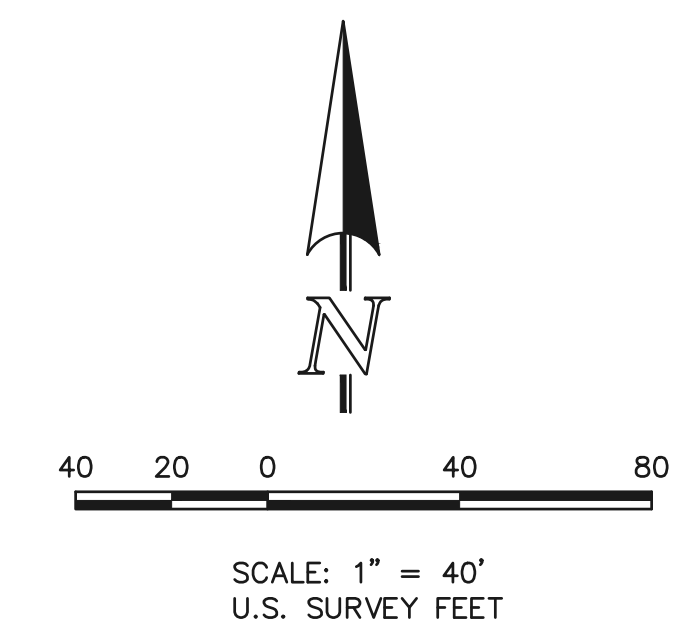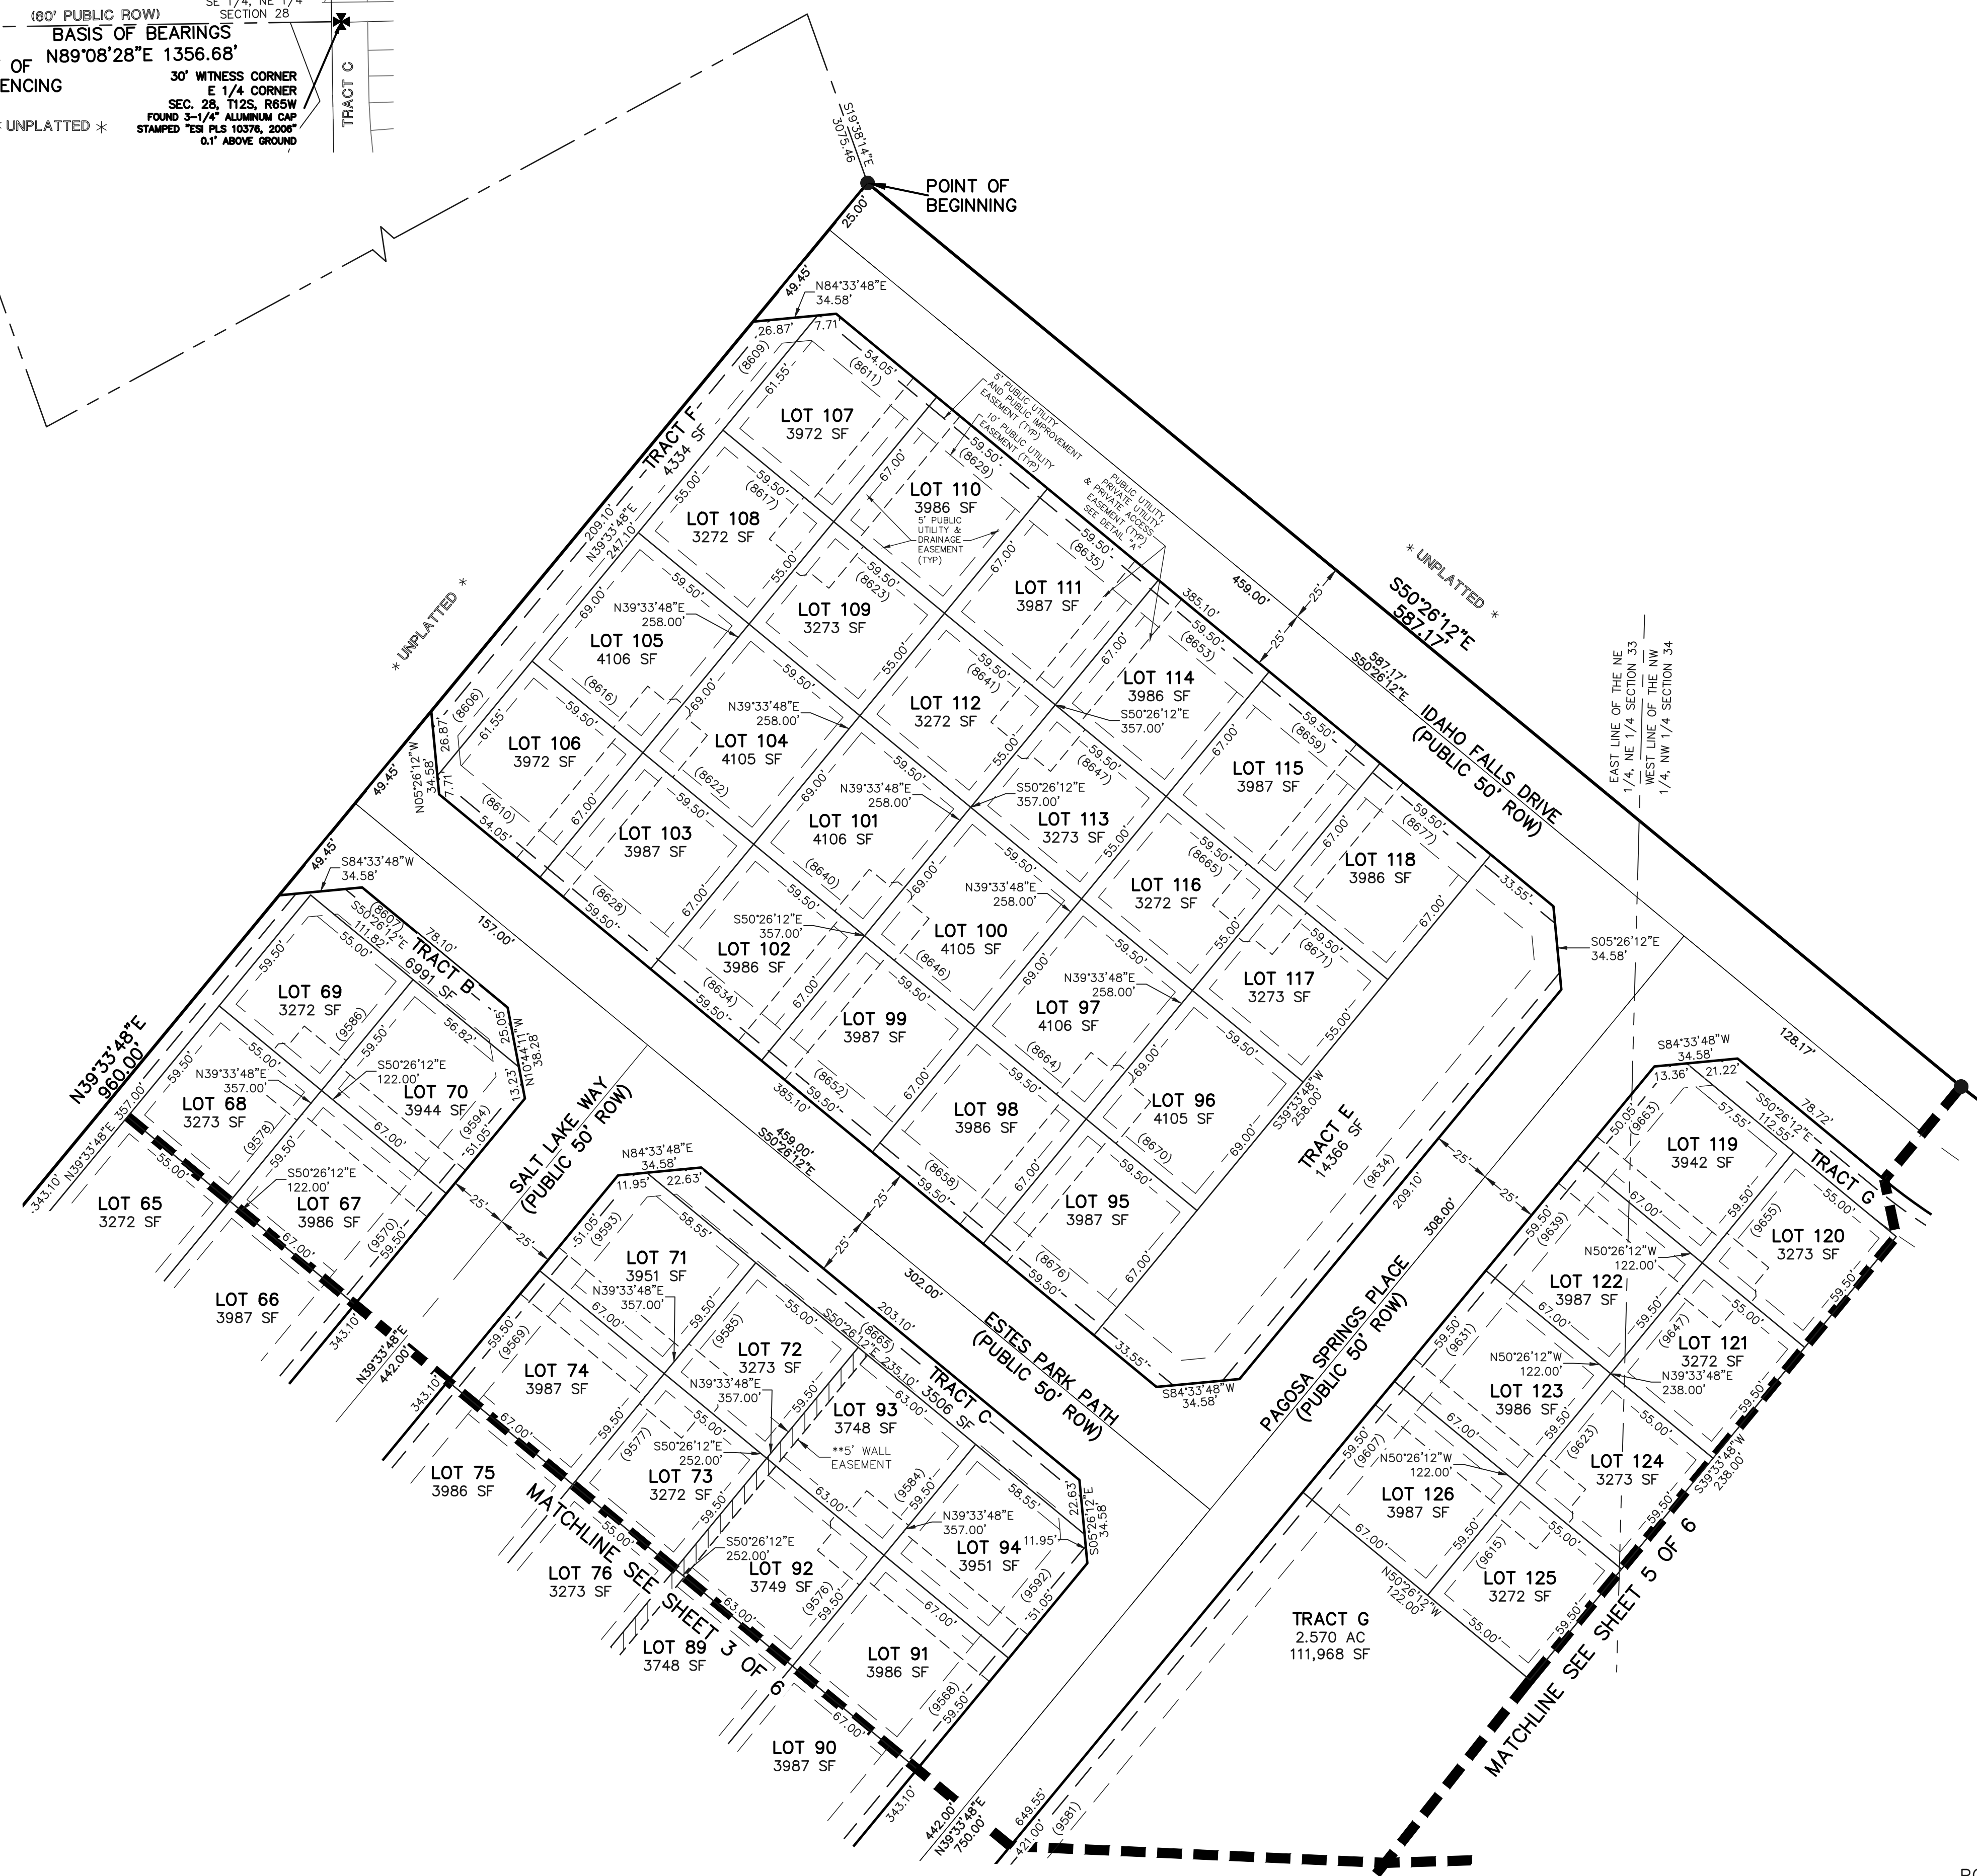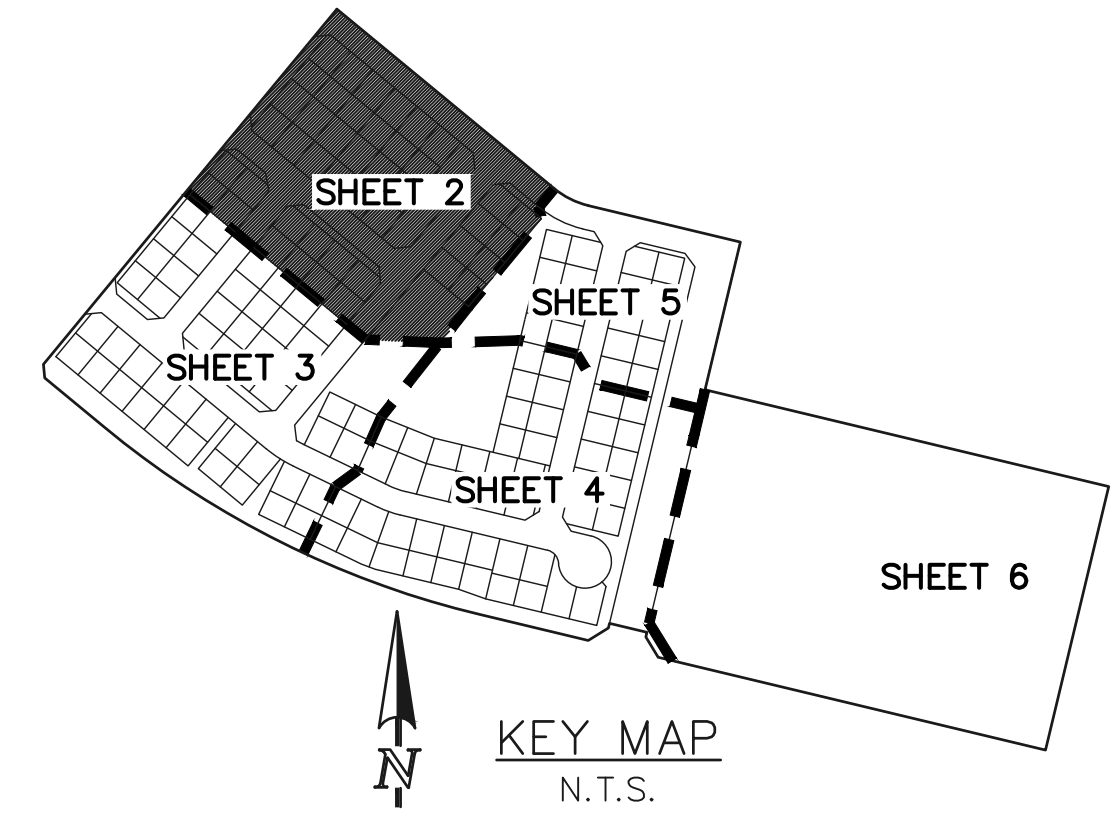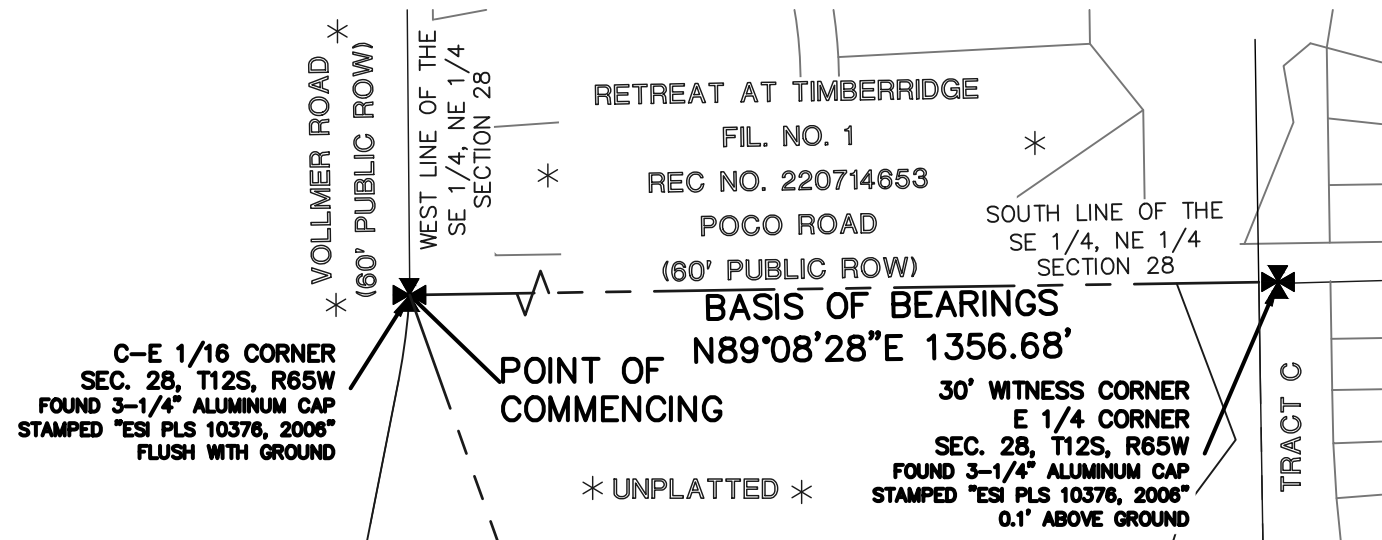

- LEGEND**
- (R) RADIAL BEARING
 - AC ACRES
 - SF SQUARE FEET
 - (XXXX) ADDRESS
 - * NOT PART OF THIS SUBDIVISION
 - 1-1/2" ALUMINUM SURVEYORS CAP STAMPED "CCES LLC PLS 34977" SET FLUSH UNLESS OTHERWISE NOTED
 - * * 5' WALL EASEMENT TO BE OWNED AND MAINTAINED BY THE METROPOLITAN DISTRICT

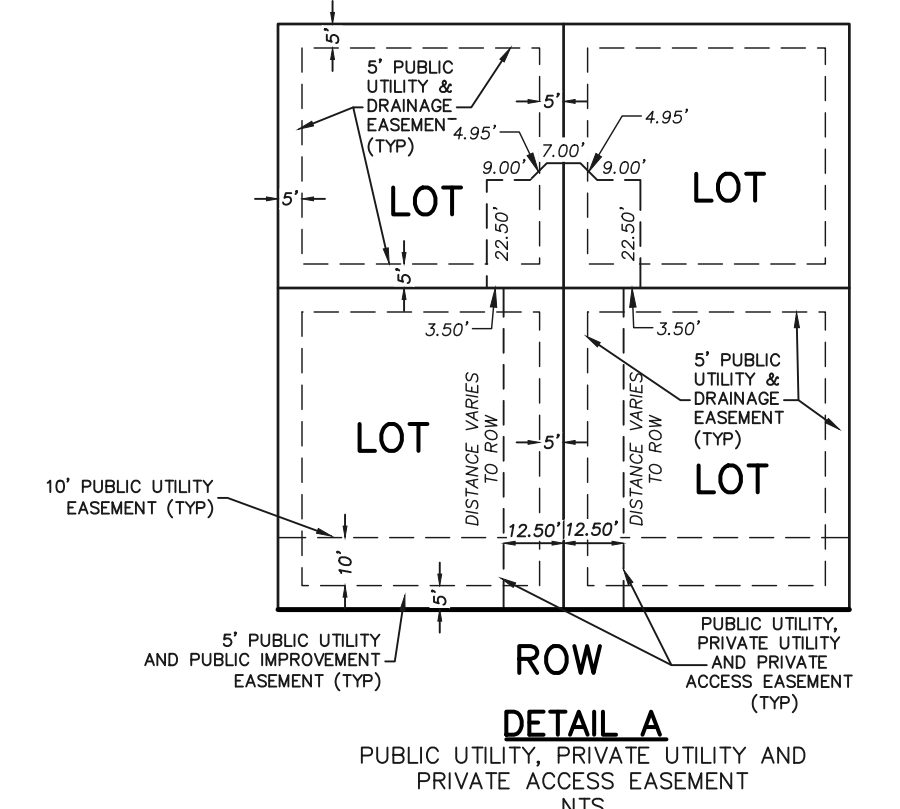


FOURSQUARE AT STERLING RANCH EAST FILING NO. 1
JOB NO. 1183.23
NOVEMBER 2, 2023
SHEET 2 OF 6





FOURSQUARE AT STERLING RANCH EAST FILING NO. 1

A PORTION OF SECTIONS 33 AND 34, TOWNSHIP 12 SOUTH,
RANGE 65 WEST OF THE SIXTH PRINCIPAL MERIDIAN,
EL PASO COUNTY, COLORADO

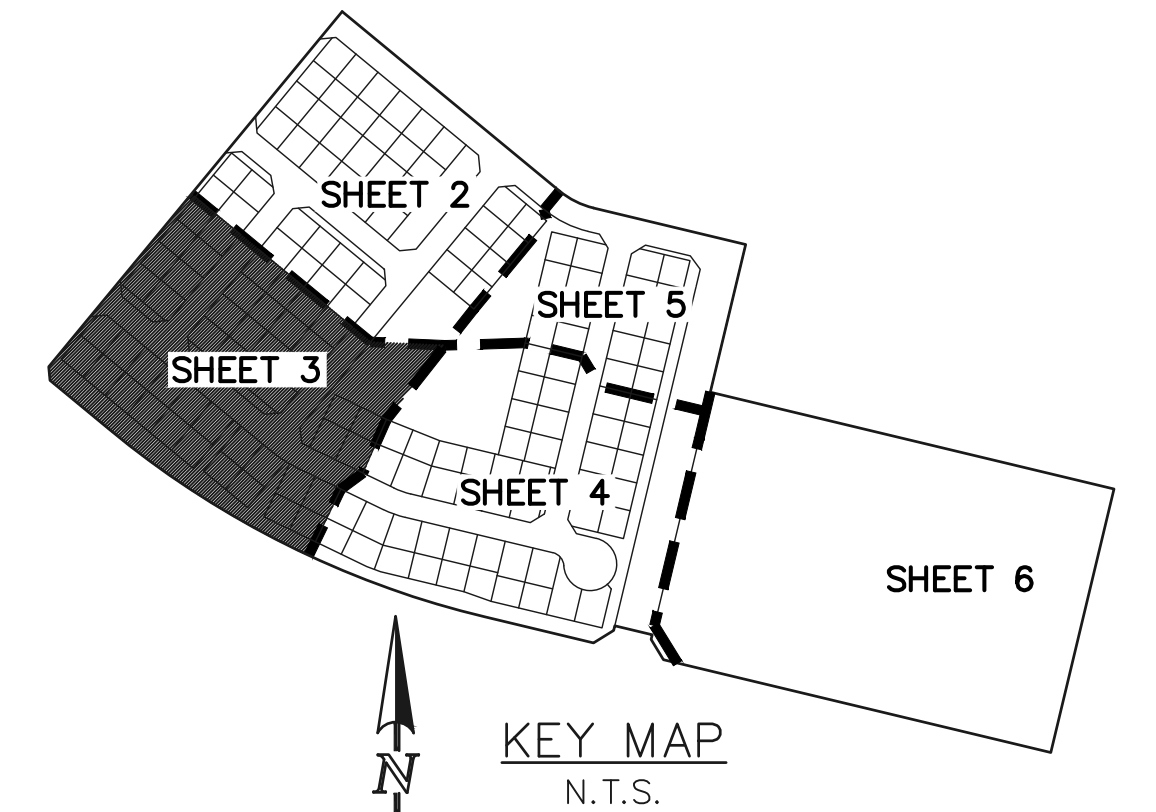

- LEGEND**
- (R) RADIAL BEARING
 - AC ACRES
 - SF SQUARE FEET
 - (XXXX) ADDRESS
 - ✱ NOT PART OF THIS SUBDIVISION
 - 1-1/2" ALUMINUM SURVEYORS CAP STAMPED "CCES LLC PLS 34977" SET FLUSH UNLESS OTHERWISE NOTED
 - * * 5' WALL EASEMENT TO BE OWNED AND MAINTAINED BY THE METROPOLITAN DISTRICT

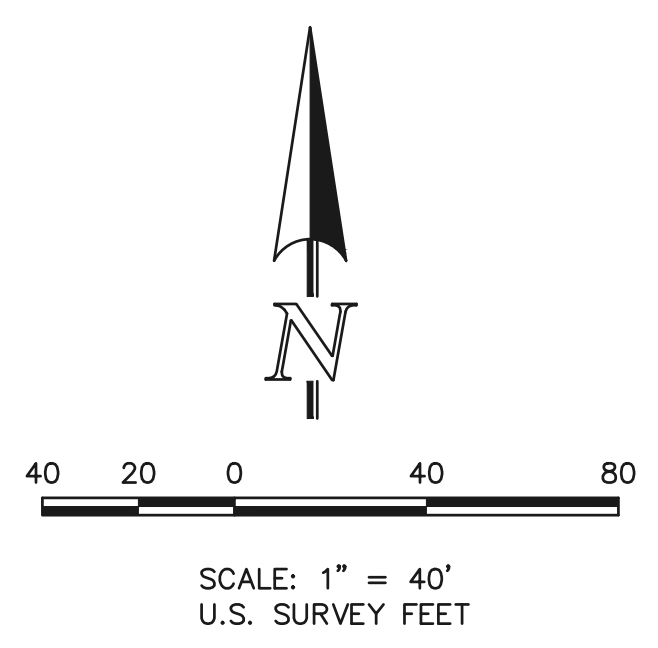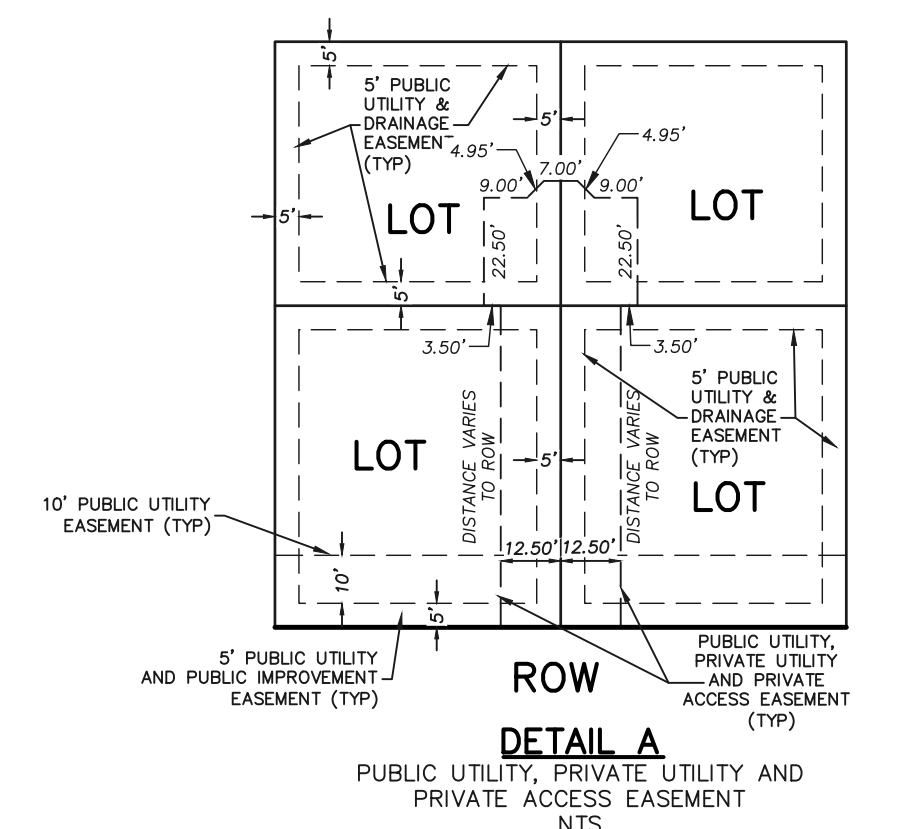

FOURSQUARE AT STERLING RANCH EAST FILING NO. 1
JOB NO. 1183.23
NOVEMBER 2, 2023
SHEET 3 OF 6





619 N. Cascade Avenue, Suite 200
Colorado Springs, Colorado 80903
(719)785-0790



PCD FILE NO.: SF-22-36

FOURSQUARE AT STERLING RANCH EAST FILING NO. 1

A PORTION OF SECTIONS 33 AND 34, TOWNSHIP 12 SOUTH,
RANGE 65 WEST OF THE SIXTH PRINCIPAL MERIDIAN,
EL PASO COUNTY, COLORADO

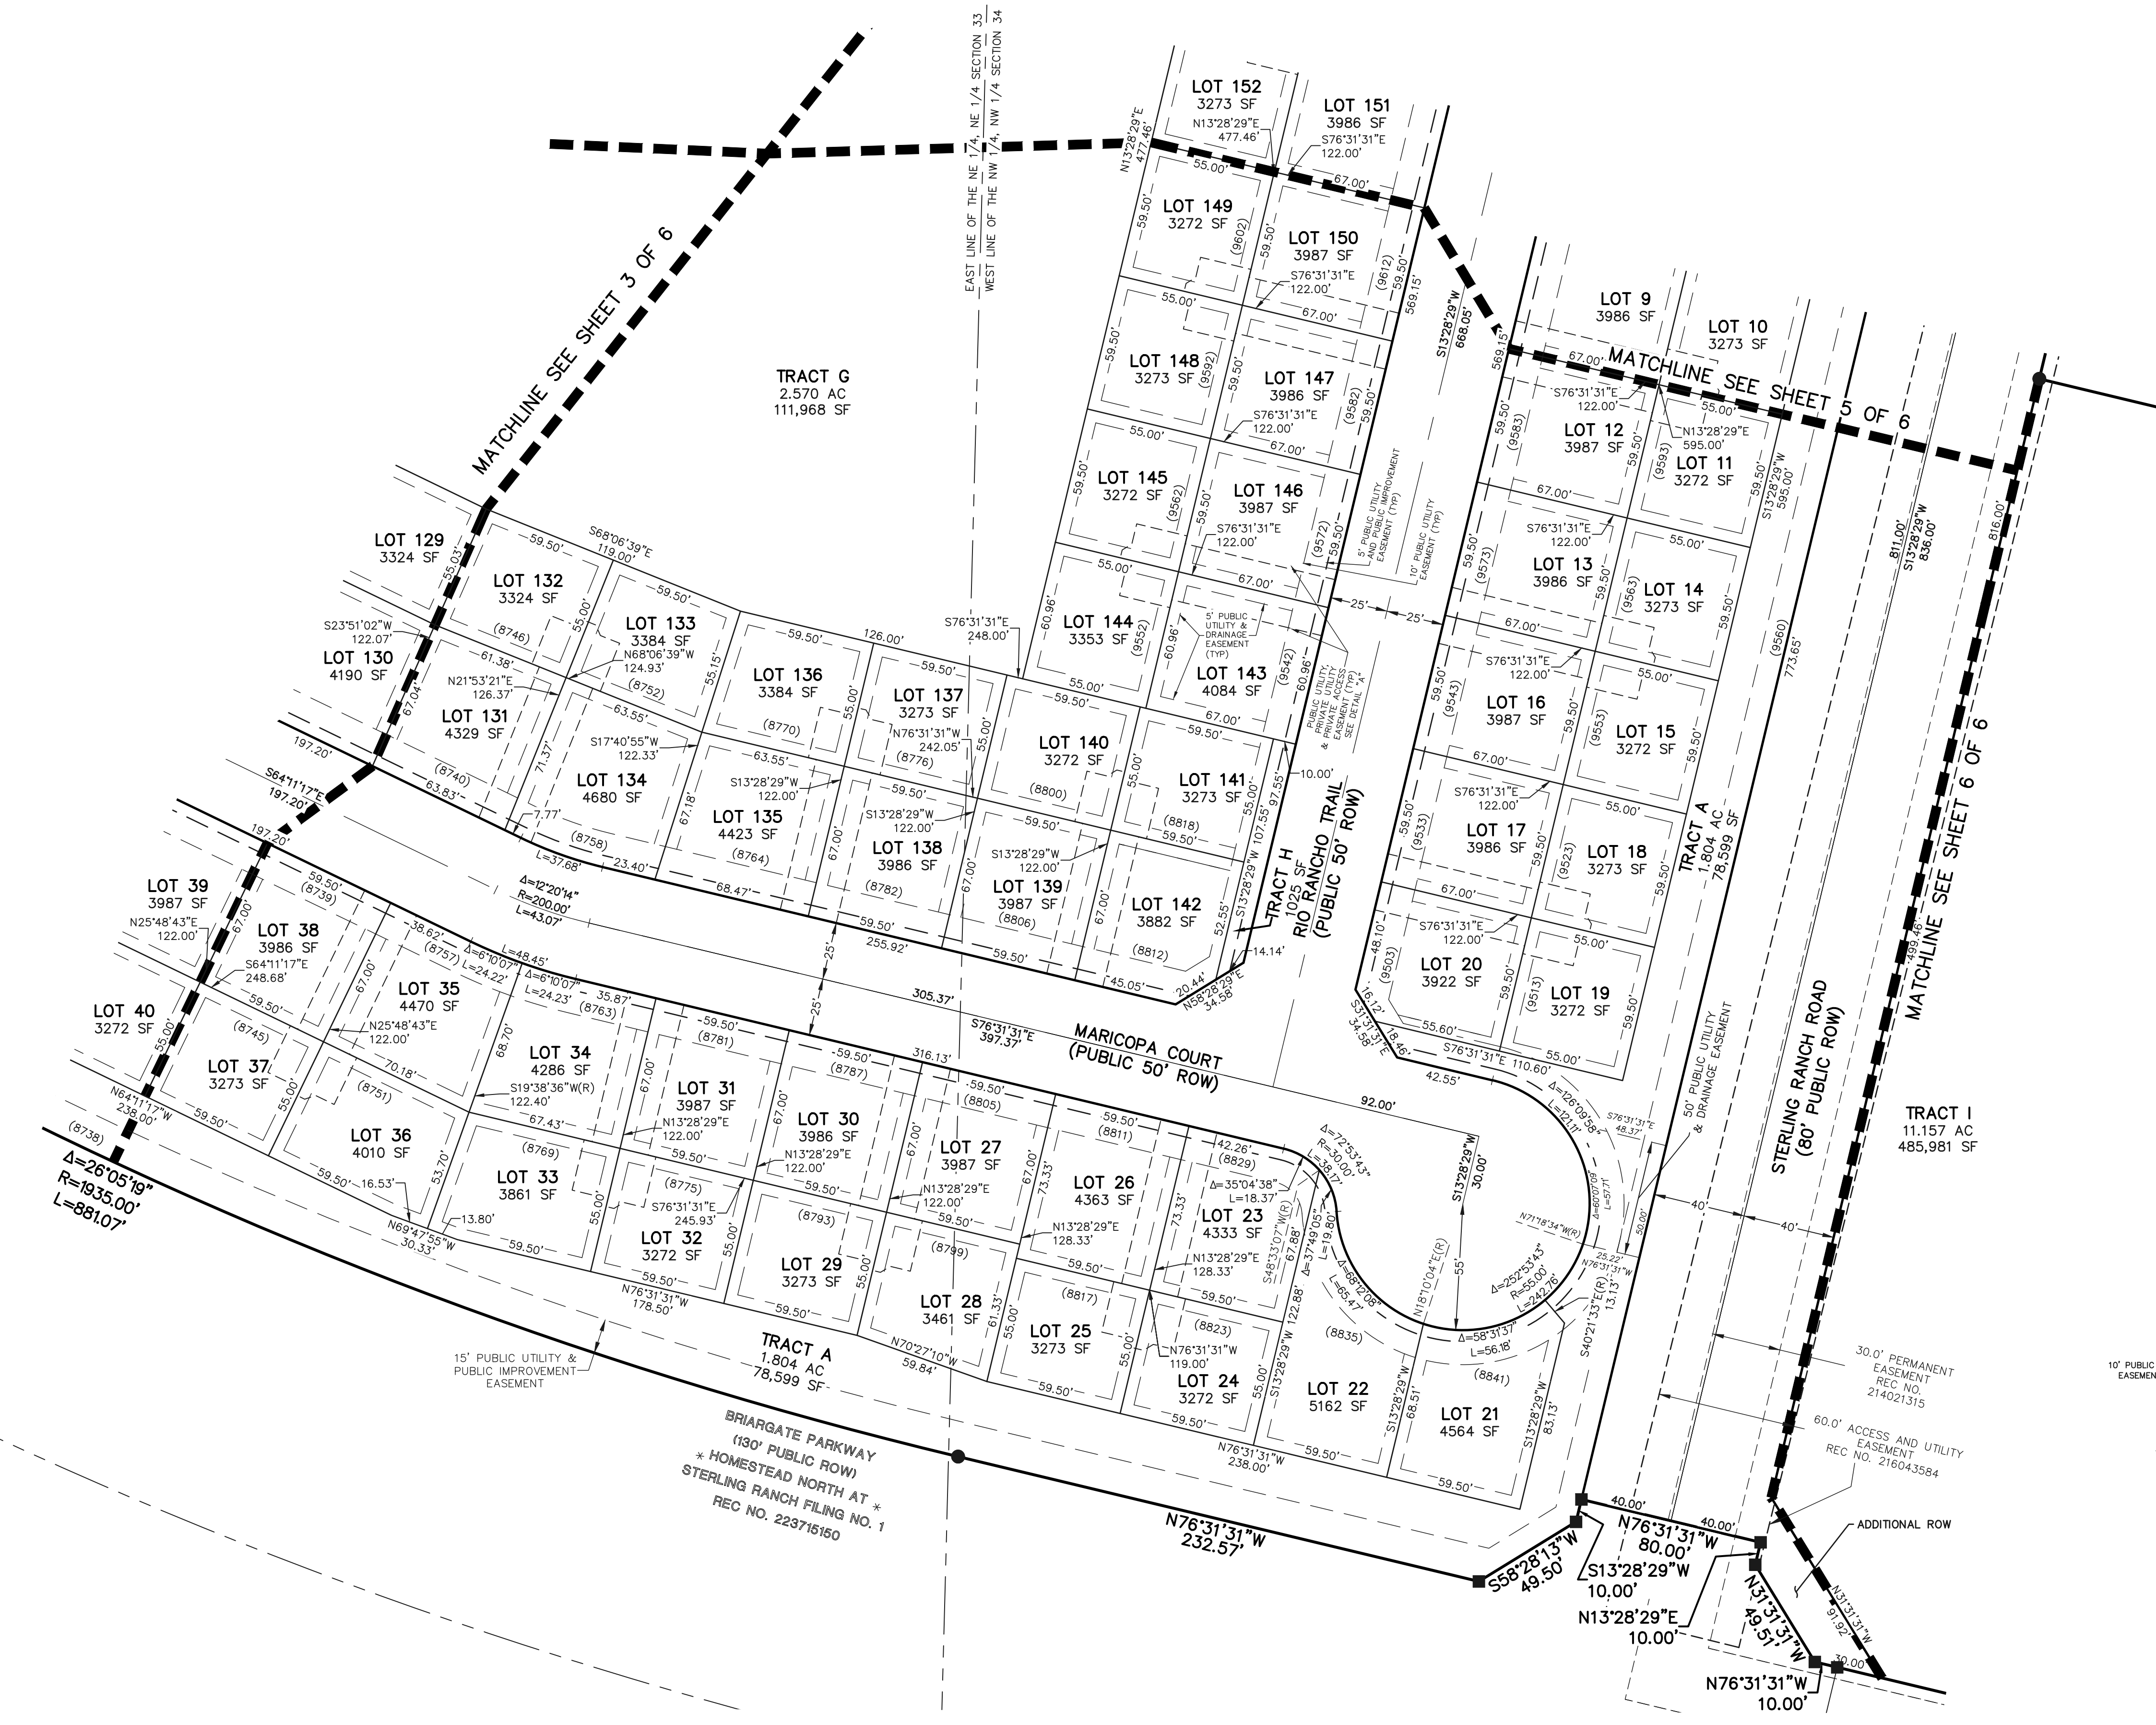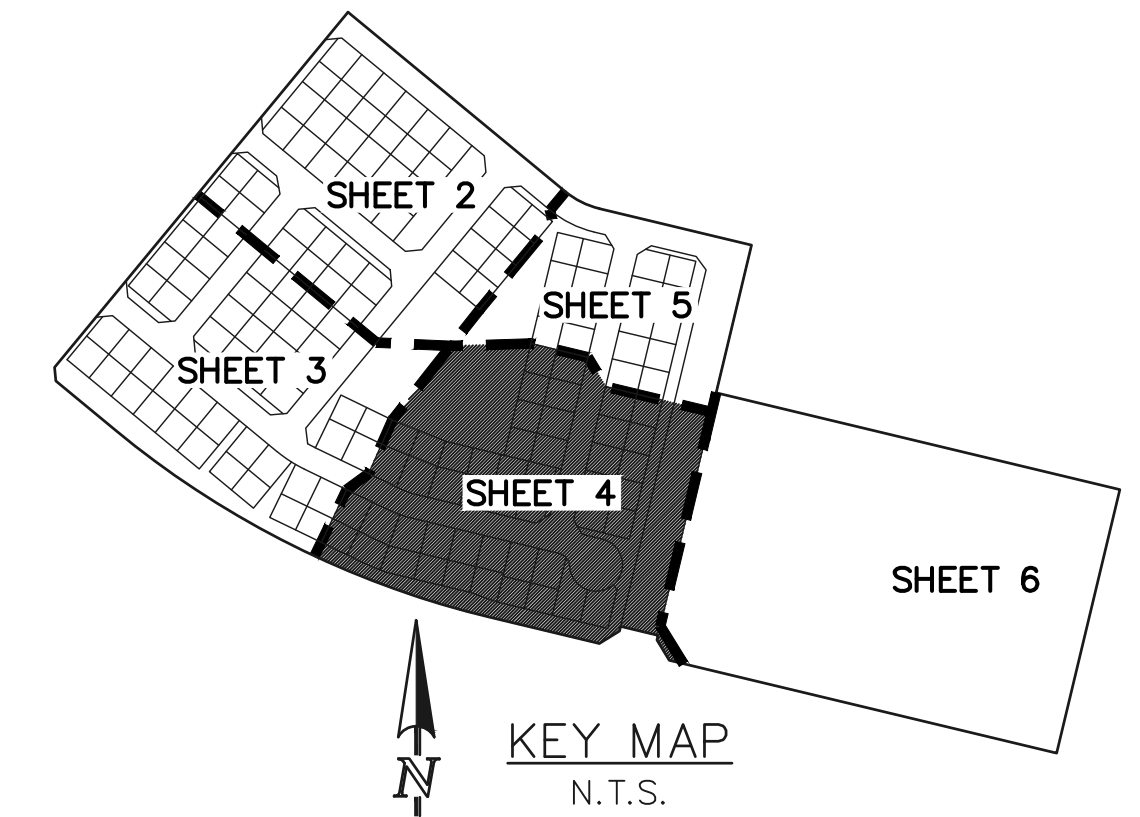

- LEGEND**
- (R) RADIAL BEARING
 - AC ACRES
 - SF SQUARE FEET
 - (XXXX) ADDRESS
 - NOT PART OF THIS SUBDIVISION
 - 1-1/2" ALUMINUM SURVEYORS CAP STAMPED "CCES LLC PLS 34977" SET FLUSH UNLESS OTHERWISE NOTED
 - 1-1/2" ALUMINUM SURVEYORS CAP STAMPED "CCES LLC PLS 34977" RECOVERED FLUSH UNLESS OTHERWISE NOTED

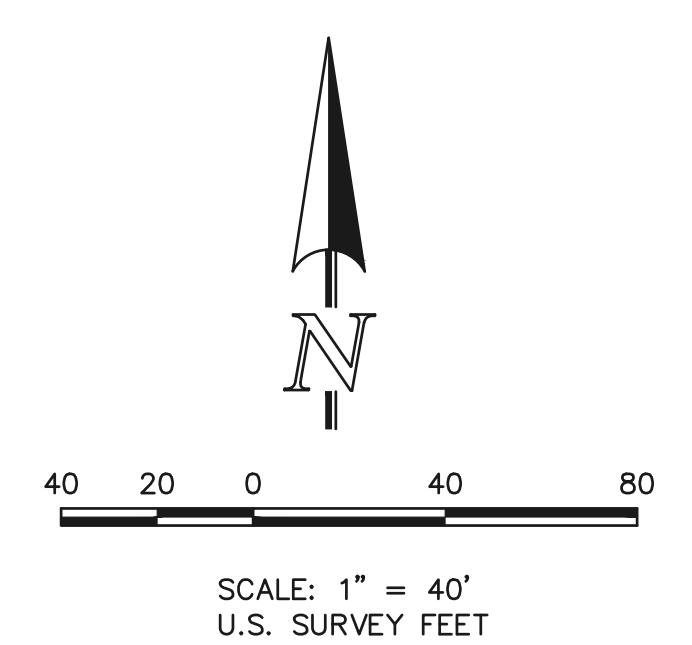
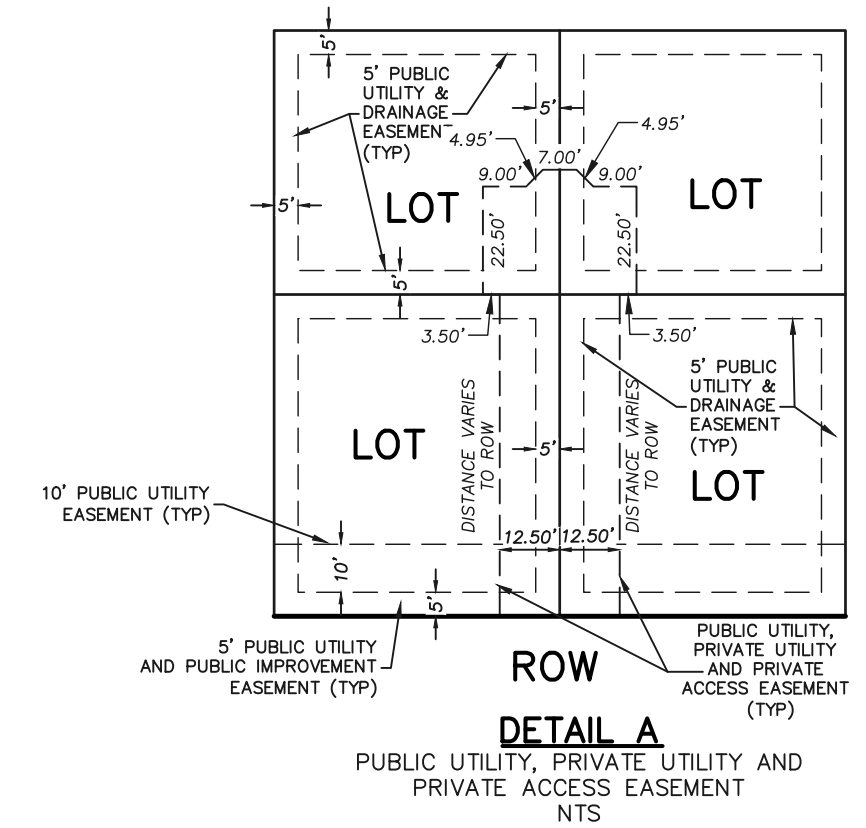


FOURSQUARE AT STERLING RANCH EAST FILING NO. 1
JOB NO. 1183.23
NOVEMBER 2, 2023
SHEET 4 OF 6





FOURSQUARE AT STERLING RANCH EAST FILING NO. 1

A PORTION OF SECTIONS 33 AND 34, TOWNSHIP 12 SOUTH,
RANGE 65 WEST OF THE SIXTH PRINCIPAL MERIDIAN,
EL PASO COUNTY, COLORADO

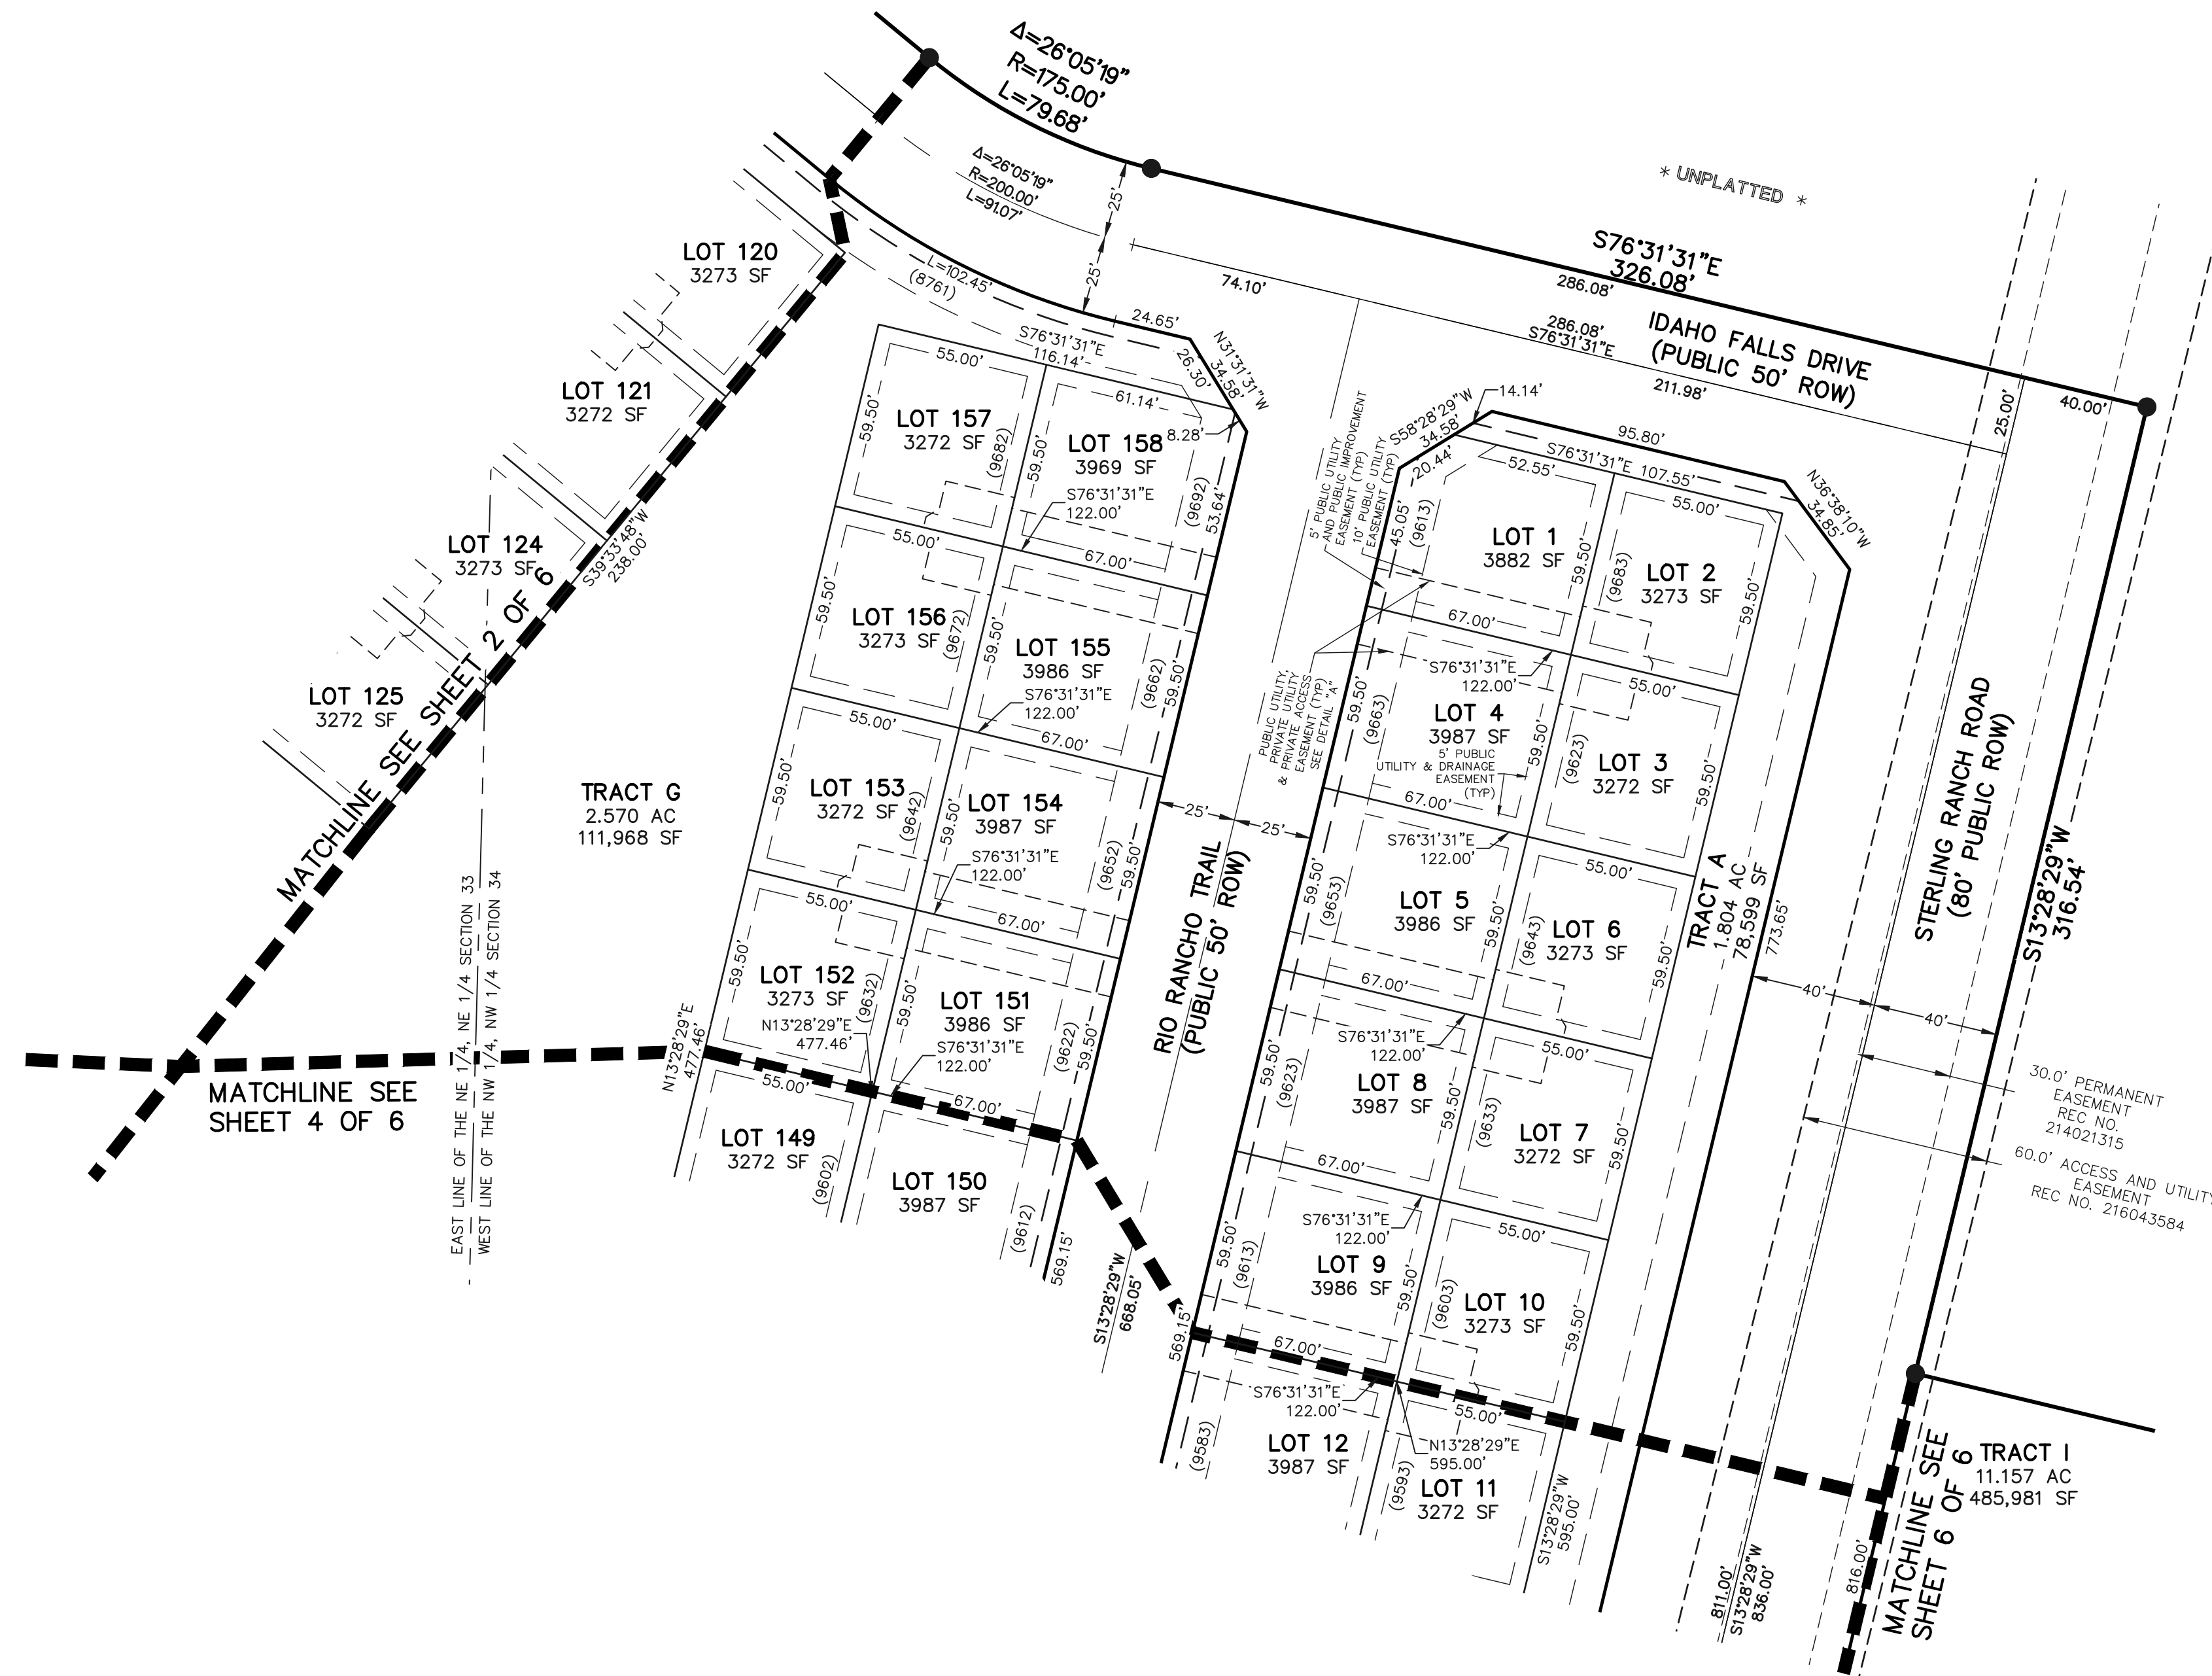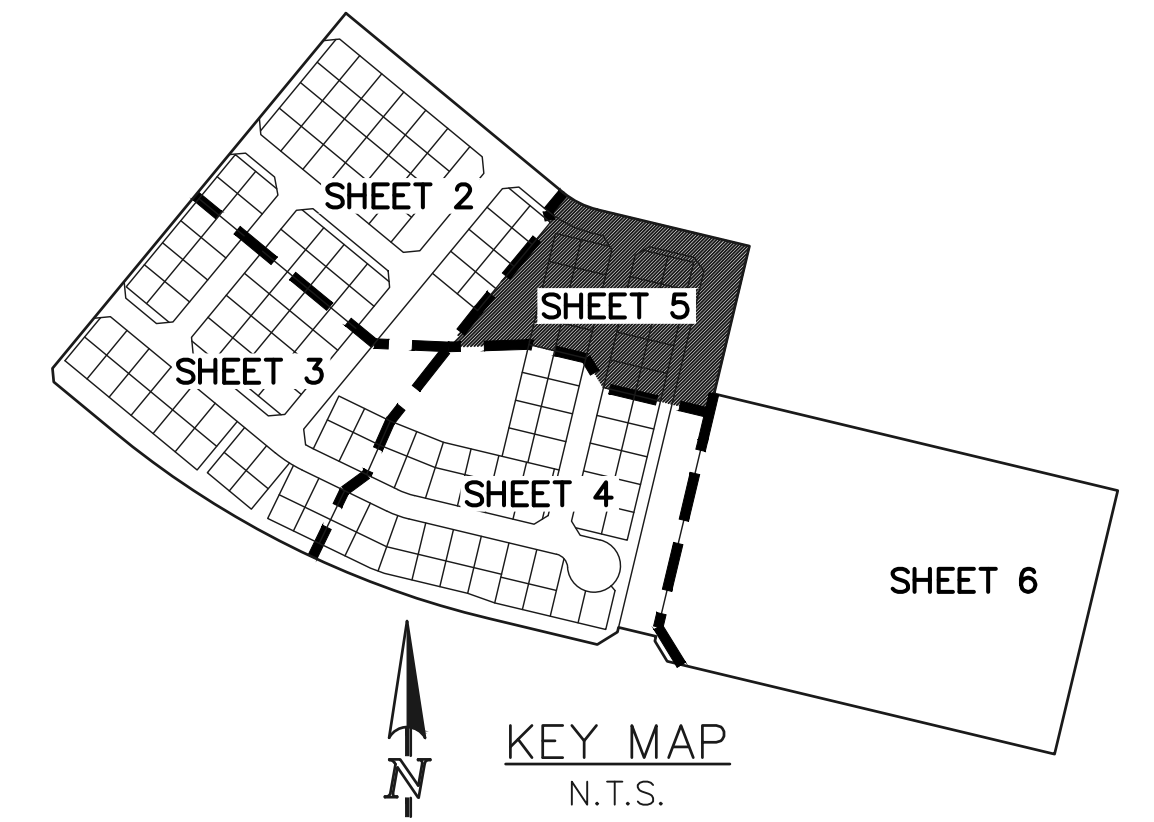

LEGEND

- (R) RADIAL BEARING
- AC ACRES
- SF SQUARE FEET
- (XXXX) ADDRESS
- ✱ NOT PART OF THIS SUBDIVISION
- 1-1/2" ALUMINUM SURVEYORS CAP STAMPED "CCES LLC PLS 34977" SET FLUSH UNLESS OTHERWISE NOTED

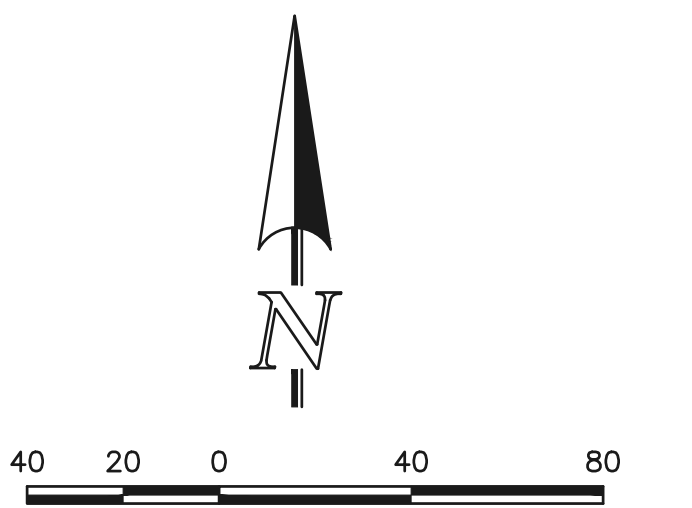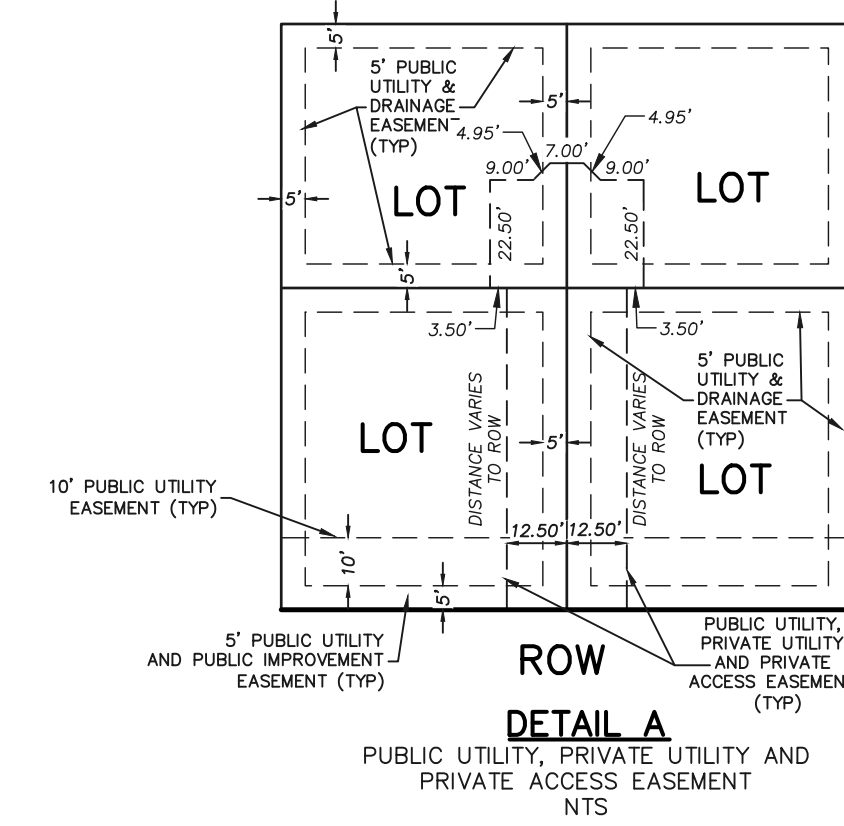



SCALE: 1" = 40'
U.S. SURVEY FEET

FOURSQUARE AT STERLING RANCH EAST FILING NO. 1
JOB NO. 1183.23
NOVEMBER 2, 2023
SHEET 5 OF 6




FOURSQUARE AT STERLING RANCH EAST FILING NO. 1

A PORTION OF SECTIONS 33 AND 34, TOWNSHIP 12 SOUTH,
RANGE 65 WEST OF THE SIXTH PRINCIPAL MERIDIAN,
EL PASO COUNTY, COLORADO

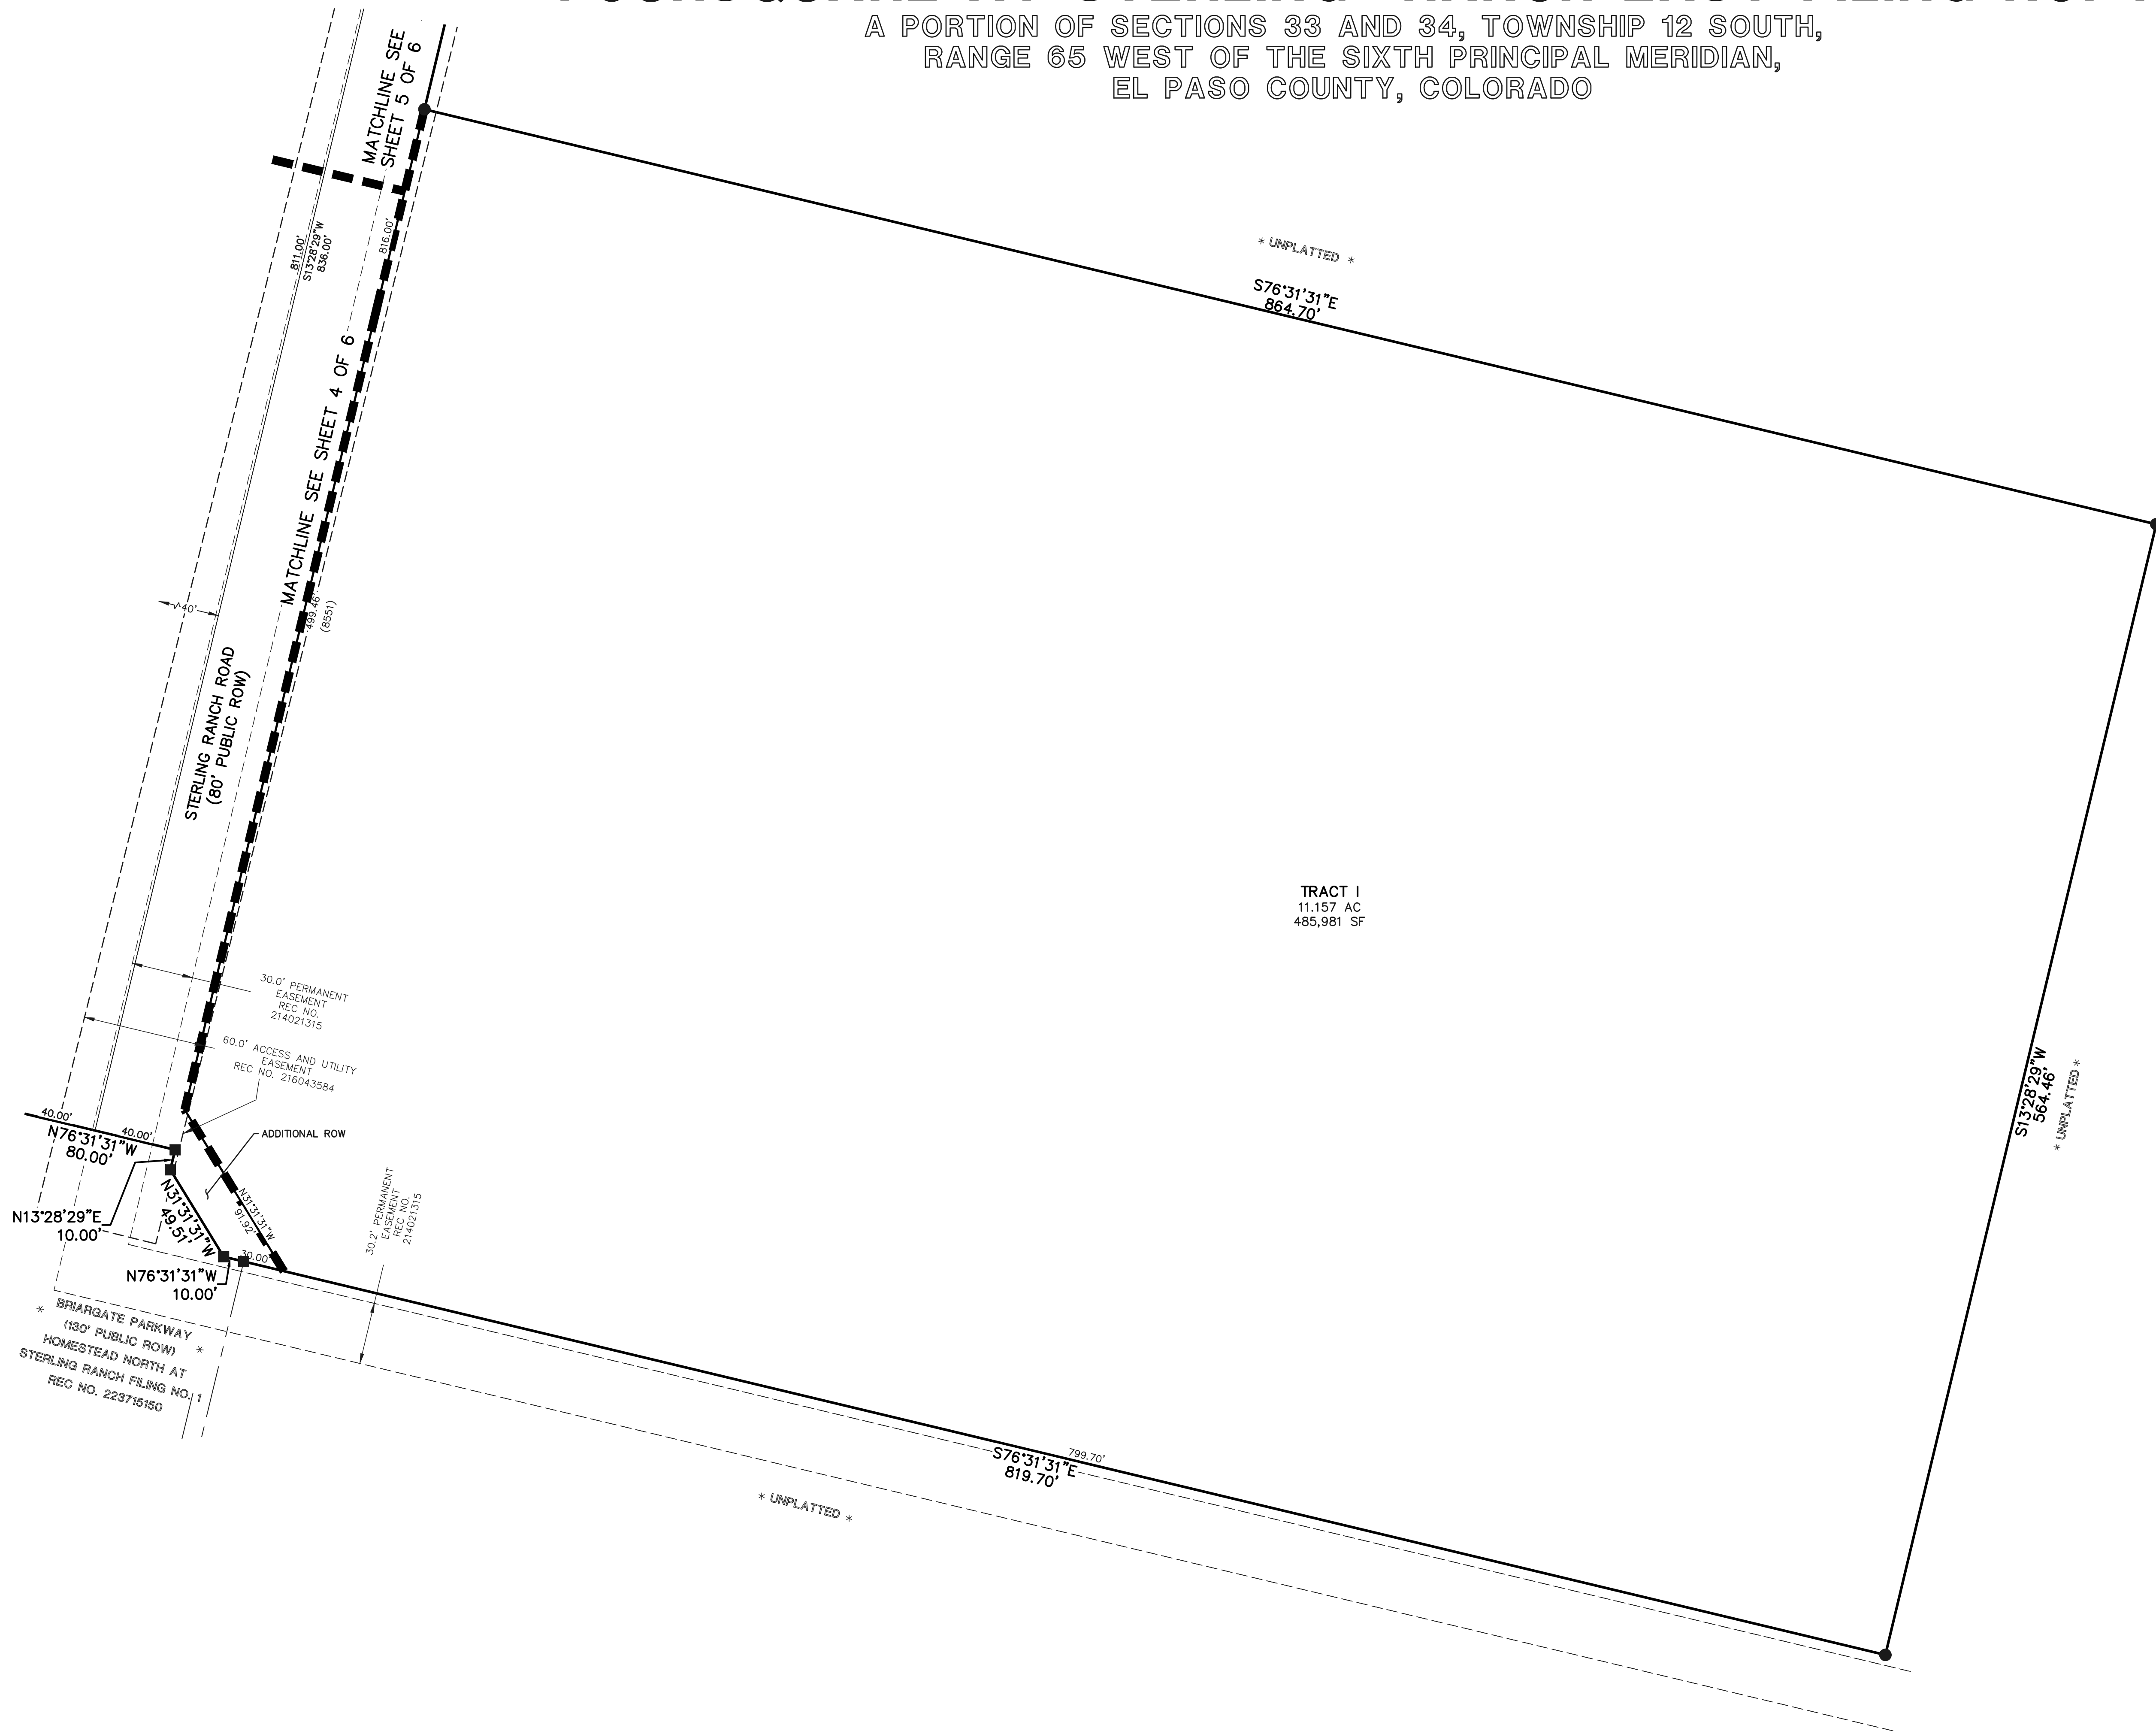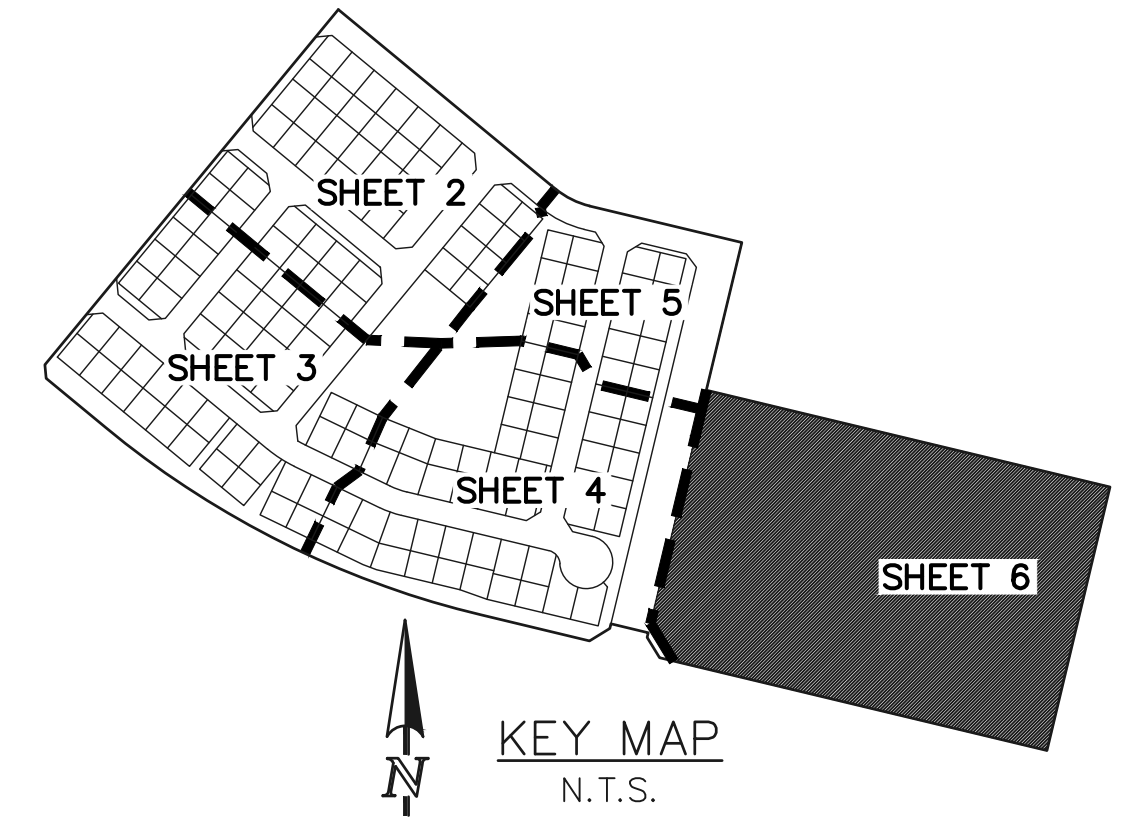

LEGEND

- (R) RADIAL BEARING
- AC ACRES
- SF SQUARE FEET
- (XXXX) ADDRESS
- * NOT PART OF THIS SUBDIVISION
- 1-1/2" ALUMINUM SURVEYORS CAP STAMPED "CCES LLC PLS 34977" SET FLUSH UNLESS OTHERWISE NOTED
- 1-1/2" ALUMINUM SURVEYORS CAP STAMPED "CCES LLC PLS 34977" RECOVERED FLUSH UNLESS OTHERWISE NOTED

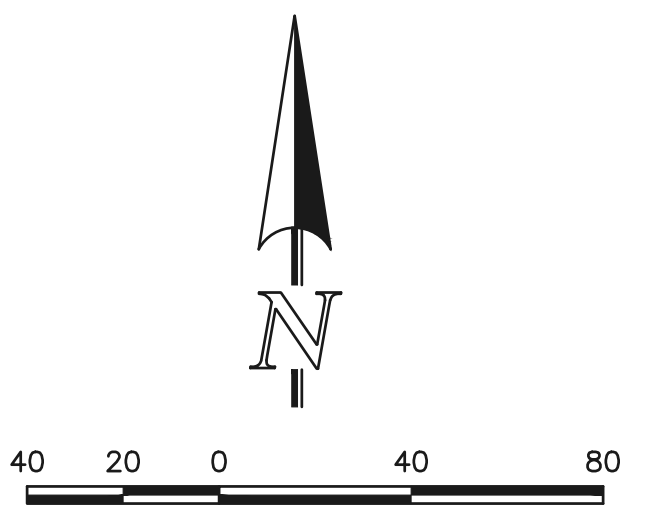

SCALE: 1" = 40'
U.S. SURVEY FEET


FOURSQUARE AT STERLING RANCH EAST FILING NO. 1
JOB NO. 1183.23
NOVEMBER 2, 2023
SHEET 6 OF 6




619 N. Cascade Avenue, Suite 200
Colorado Springs, Colorado 80903 (719)785-0790

V4_plat comments.pdf Markup Summary

dsdparsons (2)

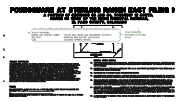

Subject: Image
Page Label: [1] 118323P1 - SH1
Author: dsdparsons
Date: 12/4/2023 11:56:41 AM
Status:
Color: ■
Layer:
Space:

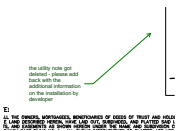

Subject: Callout
Page Label: [1] 118323P1 - SH1
Author: dsdparsons
Date: 12/4/2023 11:57:31 AM
Status:
Color: ■
Layer:
Space:

the utility note got deleted - please add back with the additional information on the installation by developer