


Building Details

(THIS IS NOT A PROPERTY SURVEY AND SHOULD NOT BE USED TO CONSTRUCT ANY IMPROVEMENTS)

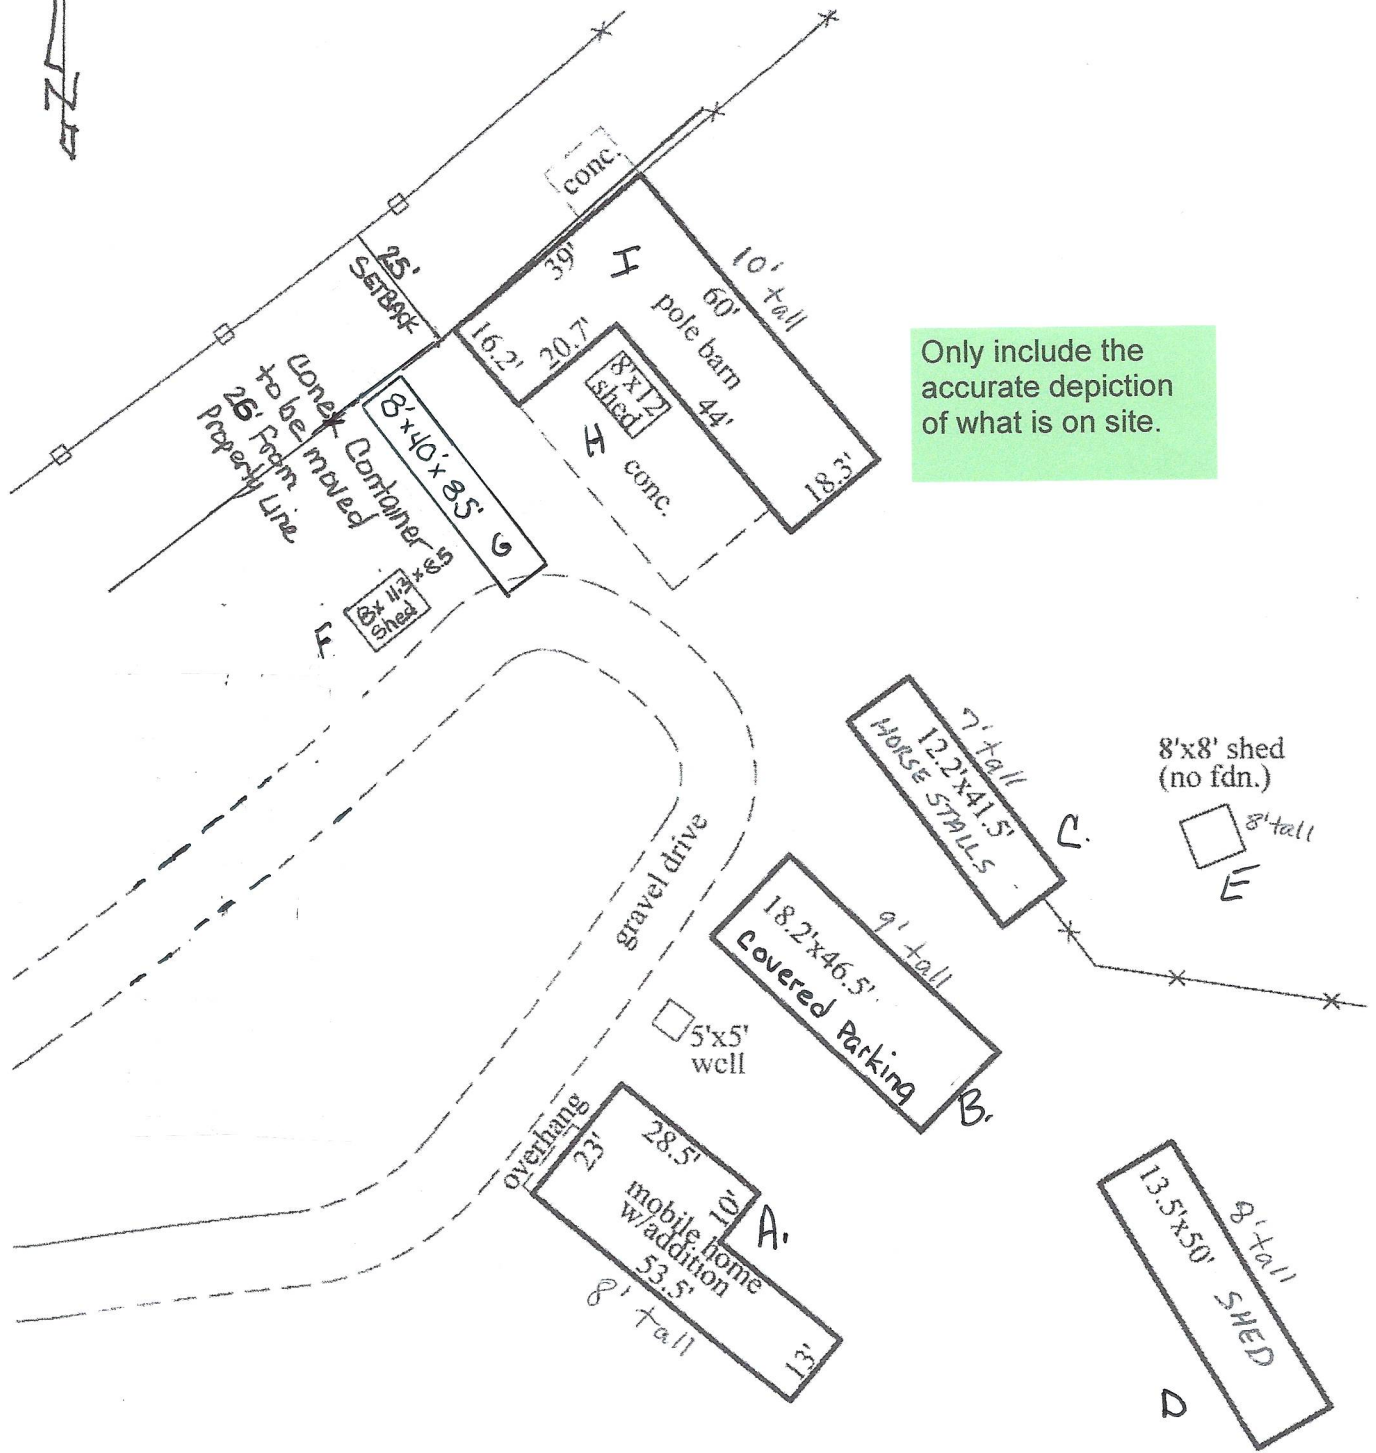

Only include the accurate depiction of what is on site.

PREPARED BY

ALESSI & ASSOCIATES, Inc.

APPRAISERS • ENGINEERS • SURVEYORS

2989 Broadmoor Valley Road
Colorado Springs, CO 80906

Tele. 719/540-8832
Fax 719/540-2781

PURPORTED STREET ADDRESS

9225 Oto Circle

**DATE: 5/8/2019

*LENDER/CLIENT: Adrienne Bieger
JOB NUMBER: 191296


Frnd. Monument - Pipe
Overhead Power Line



copy
reduced

Scale: 1" = 100'

Administrative relief
will not be approved if
a structure is showing
encroaching into the
setback.

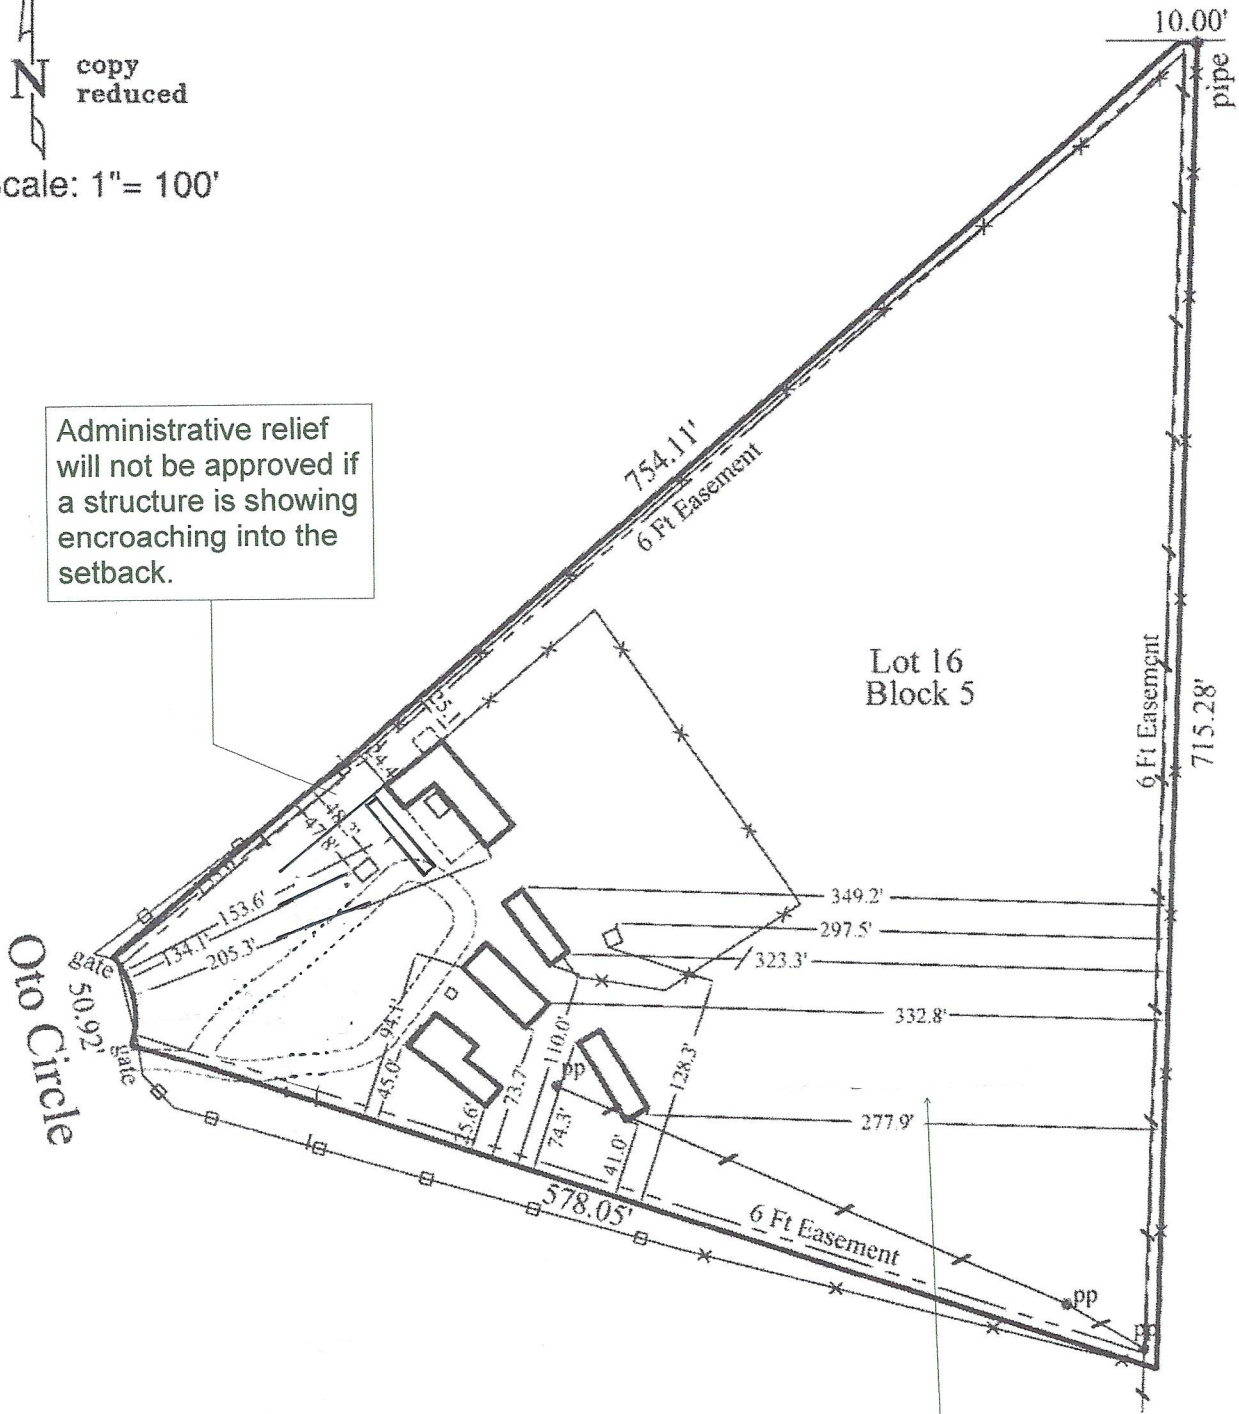

Lot 16
Block 5

Oto Circle

Page 2 should be
attached or this note
should be eliminated.

Legal Description

Lot 16, Block 5, Pawnee Rancheros Filing No. 1, County of El Paso, State of Colorado.

Site Plan_v1-redline.pdf Markup Summary

dsdkendall (3)



Subject: Callout
Page Label: 2
Lock: Locked
Author: dsdkendall
Date: 8/6/2019 11:15:36 AM
Status:
Color: ■
Layer:
Space:

Administrative relief will not be approved if a structure is showing encroaching into the setback.

Only include the accurate depiction of what is on site.

Subject: Text Box
Page Label: 1
Lock: Locked
Author: dsdkendall
Date: 8/6/2019 11:15:37 AM
Status:
Color: ■
Layer:
Space:

Only include the accurate depiction of what is on site.



Page 2 should be attached or this note should be eliminated.

Subject: Callout
Page Label: 2
Lock: Locked
Author: dsdkendall
Date: 8/6/2019 11:20:15 AM
Status:
Color: ■
Layer:
Space:

Page 2 should be attached or this note should be eliminated.