


Your parcel needs to be shown on this, mark it and resubmit.

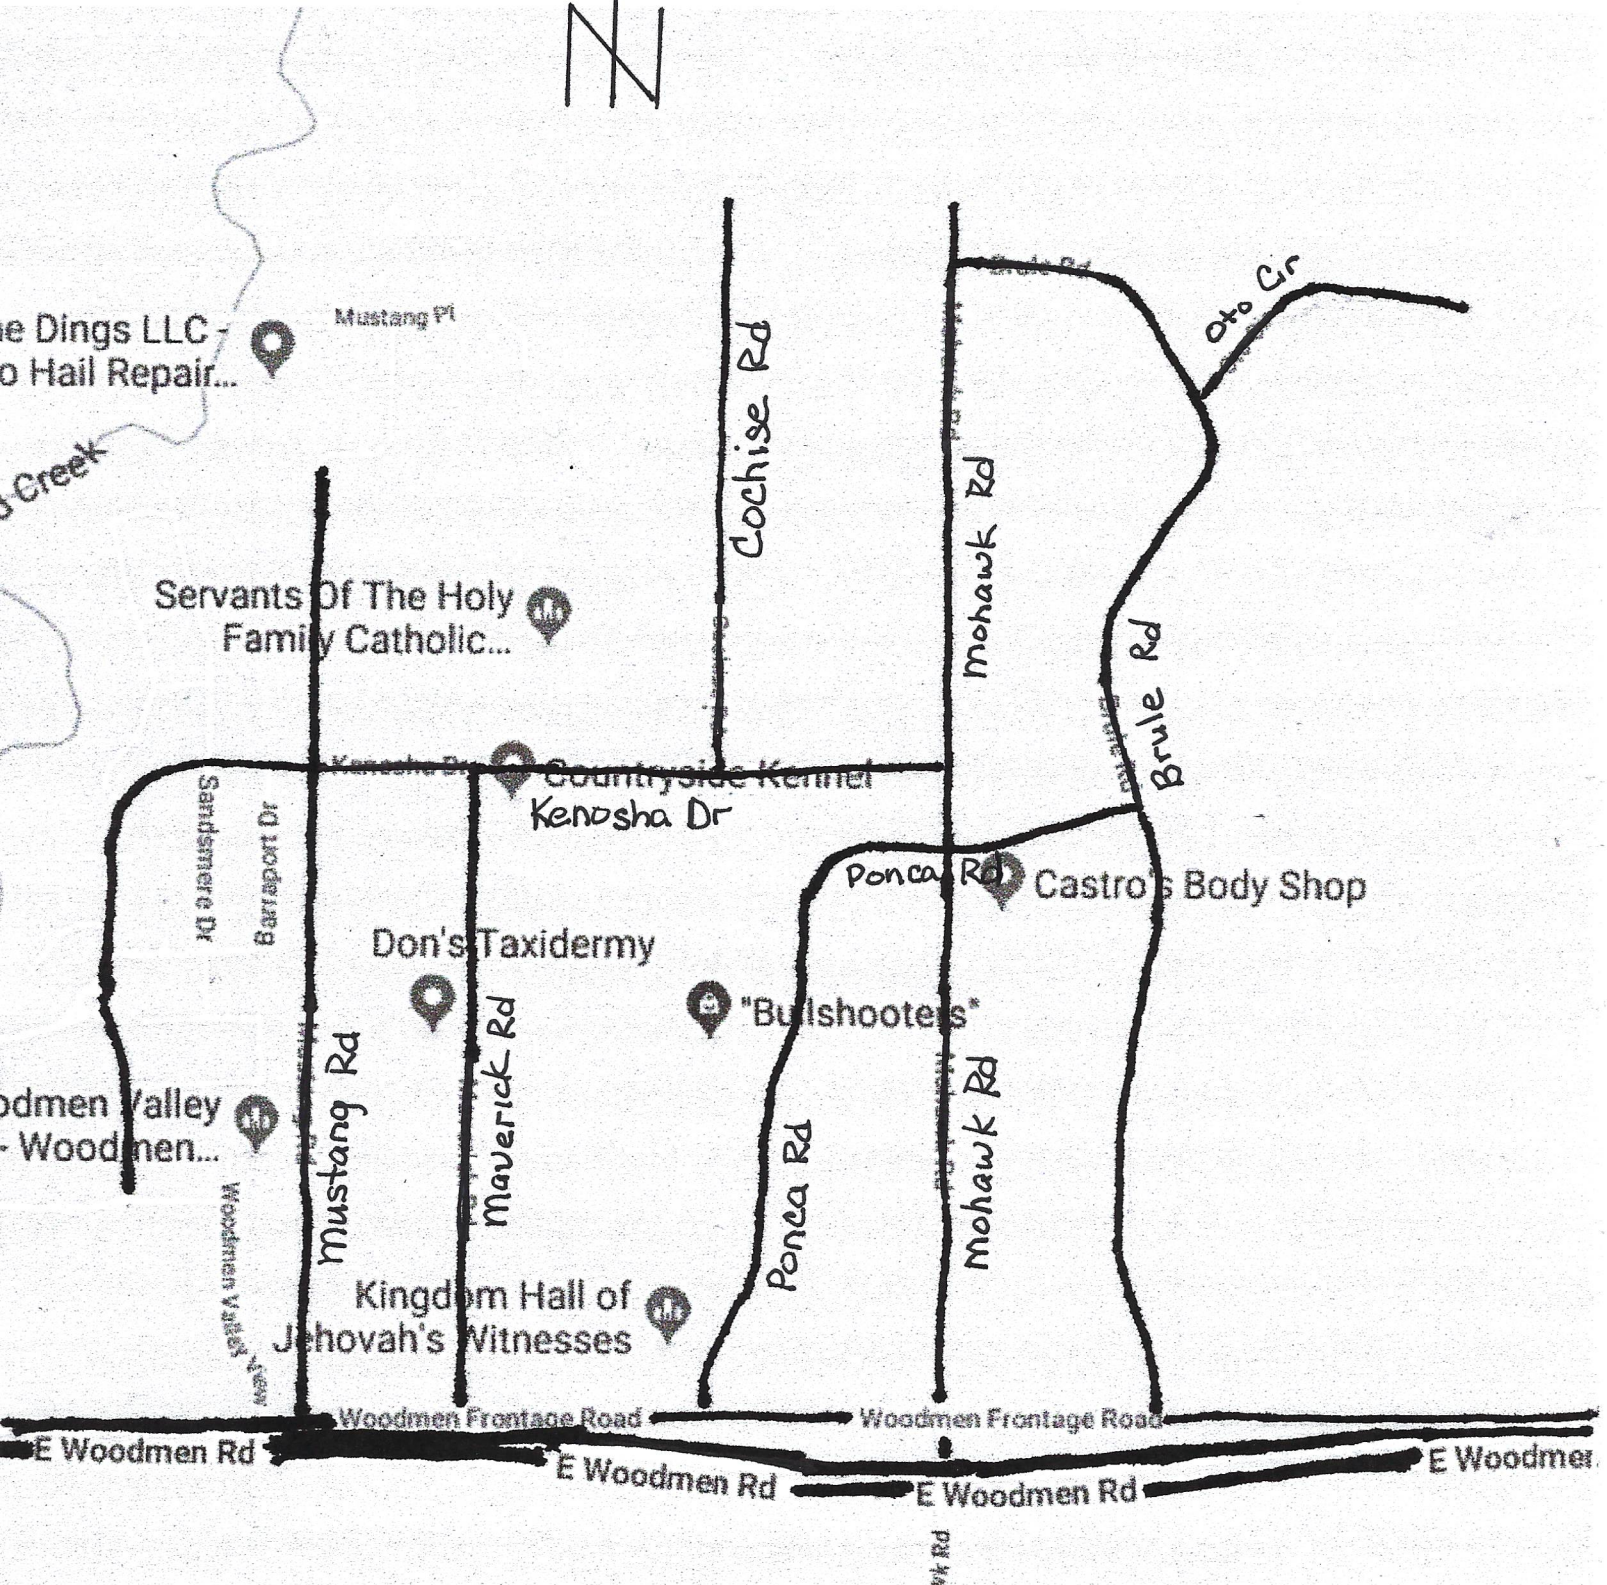

Vicinity_v1-redline.pdf Markup Summary

dskendall (1)

Your parcel needs to be shown on this, mark it and resubmit.

Subject: Text Box
Page Label: 1
Lock: Unlocked
Author: dskendall
Date: 8/6/2019 11:15:13 AM
Status:
Color: ■
Layer:
Space:

Your parcel needs to be shown on this, mark it and resubmit.