


# Building Details

(THIS IS NOT A PROPERTY SURVEY AND SHOULD NOT BE USED TO CONSTRUCT ANY IMPROVEMENTS)

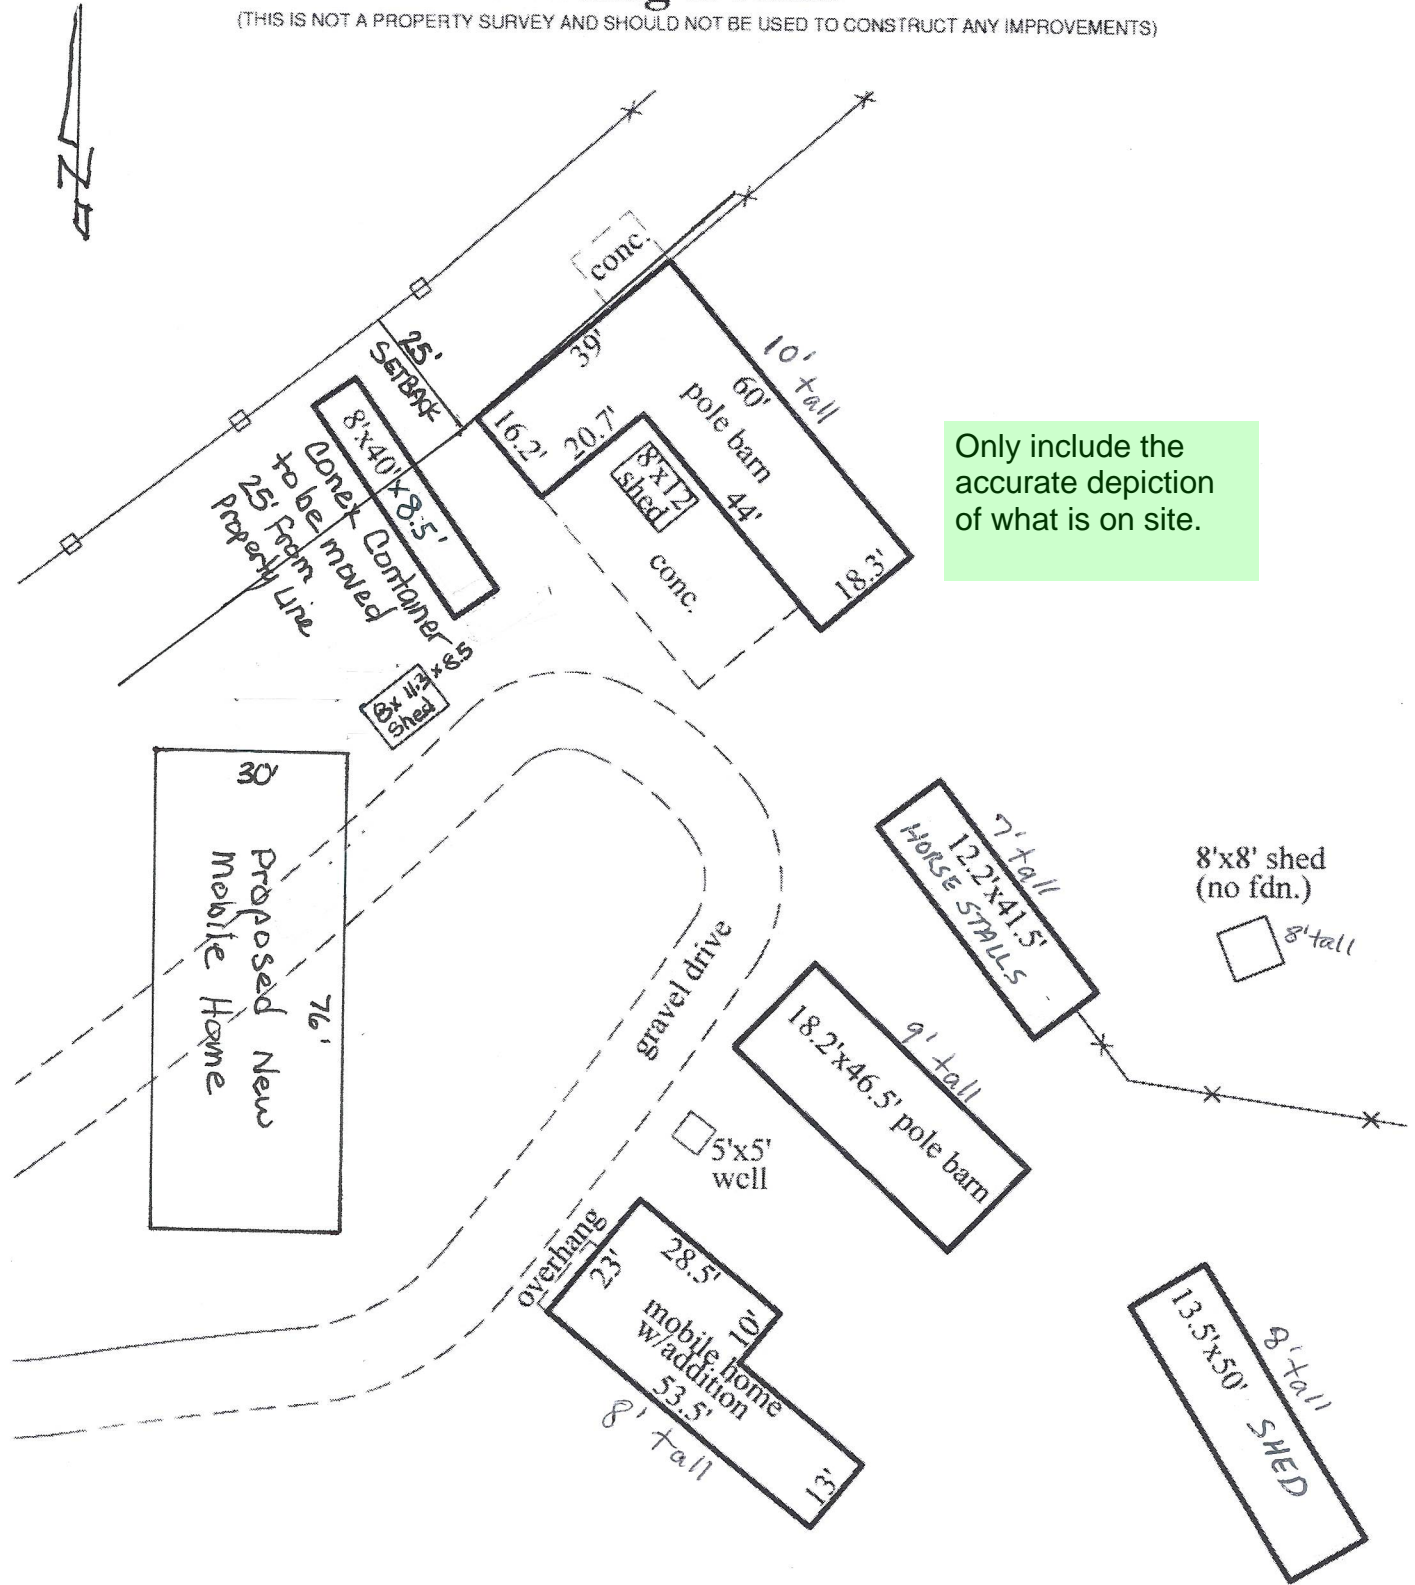

PREPARED BY

**ALESSI & ASSOCIATES, Inc.**

APPRAISERS • ENGINEERS • SURVEYORS

2989 Broadmoor Valley Road  
Colorado Springs, CO 80906

Tele. 719/540-8832  
Fax 719/540-2781

PURPORTED STREET ADDRESS:

**9225 Oto Circle**

\*\*DATE: 5/8/2019

\*LENDER/CLIENT: Adrienne Bieger

JOB NUMBER: 191296


○ # Fnd. Monument - Pipe  
# Overhead Power Line



copy  
reduced

Scale: 1" = 100'

Administrative relief  
will not be approved if  
a structure is showing  
encroaching into the  
setback.

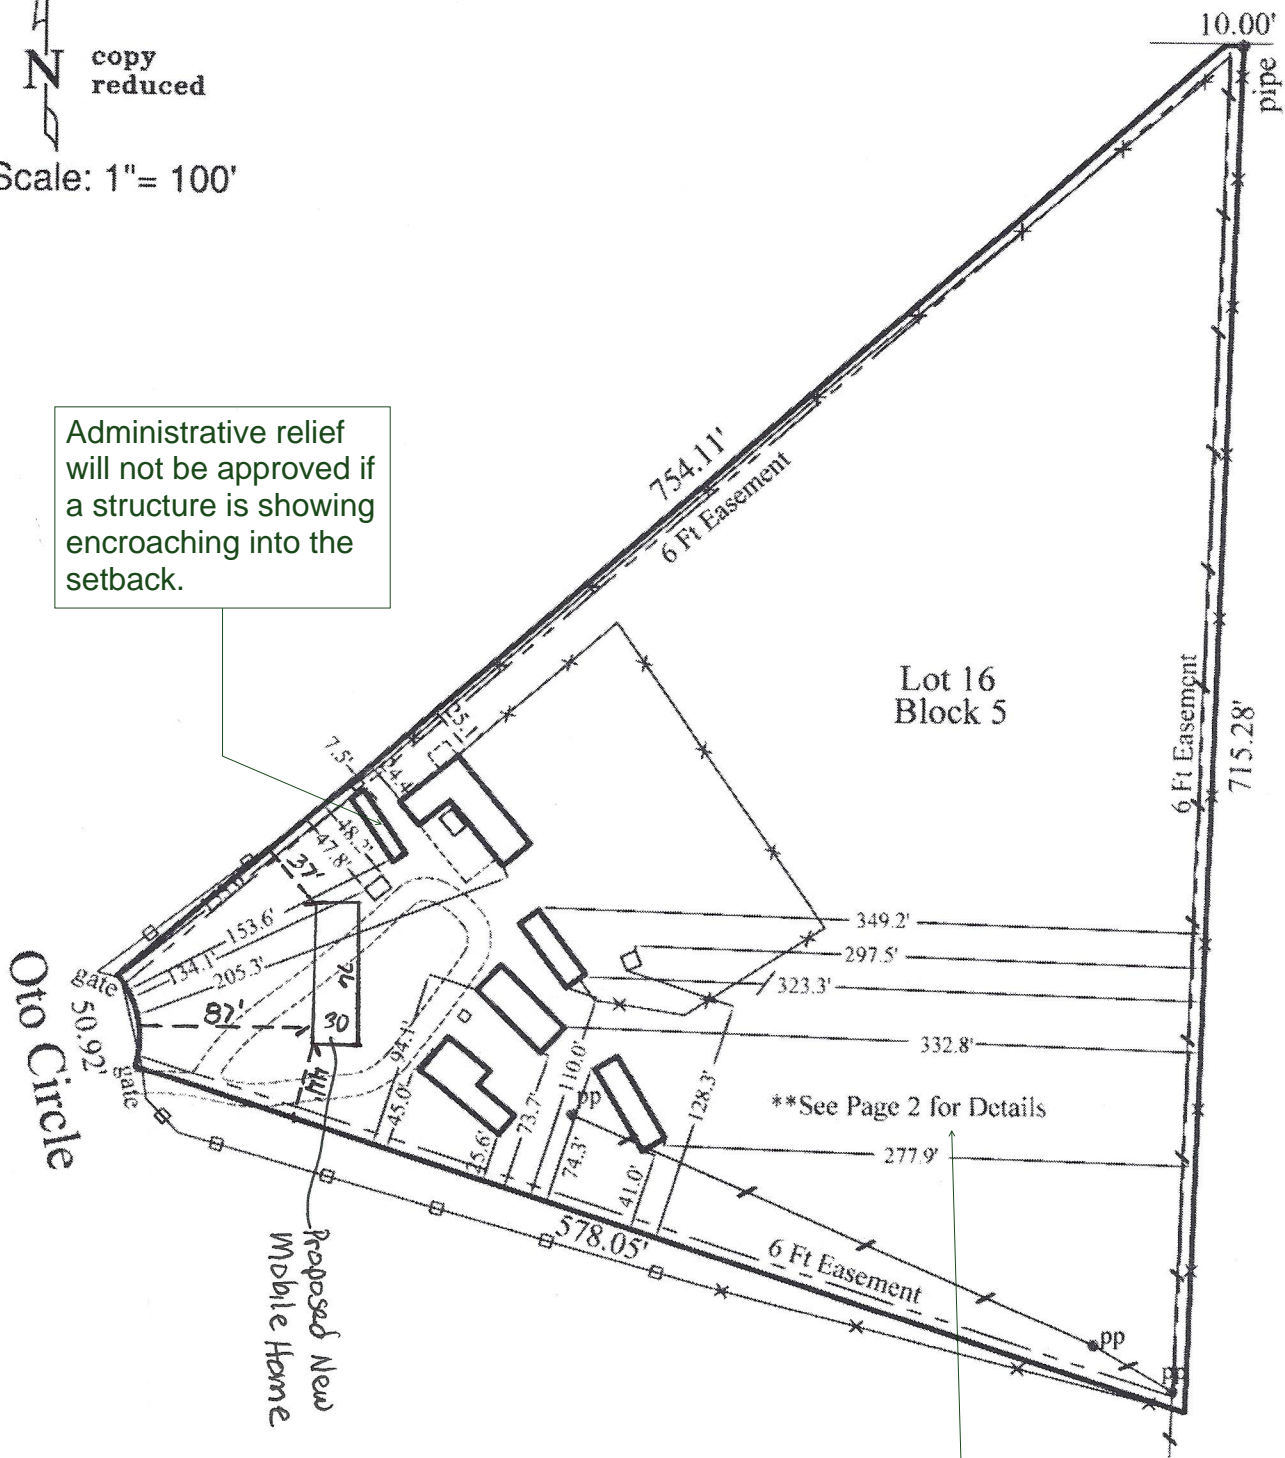


Page 2 should be  
attached or this note  
should be eliminated.

### Legal Description

Lot 16, Block 5, Pawnee Rancheros Filing No. 1, County of El Paso, State of Colorado.

# Site Plan\_v1-redline.pdf Markup Summary

dskendall (3)

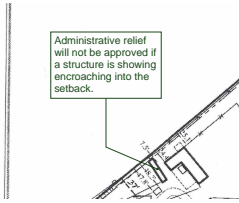


**Subject:** Callout  
**Page Label:** 2  
**Lock:** Locked  
**Author:** dskendall  
**Date:** 8/6/2019 11:15:36 AM  
**Status:**  
**Color:** ■  
**Layer:**  
**Space:**

Administrative relief will not be approved if a structure is showing encroaching into the setback.

> Only include the accurate depiction of what is on site.

**Subject:** Text Box  
**Page Label:** 1  
**Lock:** Locked  
**Author:** dskendall  
**Date:** 8/6/2019 11:15:37 AM  
**Status:**  
**Color:** ■  
**Layer:**  
**Space:**

Only include the accurate depiction of what is on site.

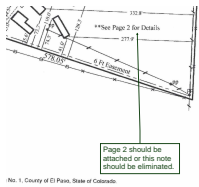

**Subject:** Callout  
**Page Label:** 2  
**Lock:** Locked  
**Author:** dskendall  
**Date:** 8/6/2019 11:20:15 AM  
**Status:**  
**Color:** ■  
**Layer:**  
**Space:**

Page 2 should be attached or this note should be eliminated.