

NOTE:

ALL EXISTING UNDERGROUND AND ABOVE GROUND UTILITY LOCATIONS, INVERTS AND SIZES ARE APPROXIMATE ONLY AND MUST BE FIELD VERIFIED PRIOR TO CONSTRUCTION. THE IN POINTS SHALL BE POTHOLED AND LOCATIONS, INVERTS AND SIZES SHALL BE FIELD VERIFIED BY THE CONTRACTOR PRIOR TO CONSTRUCTION.


STANDARD NOTES FOR EL PASO COUNTY GRADING AND EROSION CONTROL PLANS

- 1. STORMWATER DISCHARGES FROM CONSTRUCTION SITES SHALL NOT CAUSE OR THREATEN TO CAUSE POLLUTION, CONTAMINATION, OR DEGRADATION OF STATE WATERS. ALL WORK AND EARTH DISTURBANCE SHALL BE DONE IN A MANNER THAT MINIMIZES POLLUTION OF ANY ON-SITE OR OFF-SITE WATERS, INCLUDING WETLANDS.
- 2. NOTWITHSTANDING ANYTHING DEPICTED IN THESE PLANS IN WORDS OR GRAPHIC REPRESENTATION, ALL DESIGN AND CONSTRUCTION RELATED TO ROADS, STORM DRAINAGE AND EROSION CONTROL SHALL CONFORM TO THE STANDARDS AND REQUIREMENTS OF THE MOST RECENT VERSION OF THE RELEVANT ADOPTED EL PASO COUNTY STANDARDS, INCLUDING THE LAND DEVELOPMENT CODE, THE ENGINEERING CRITERIA MANUAL, THE DRAINAGE CRITERIA MANUAL, AND THE DRAINAGE CRITERIA MANUAL VOLUME 2. ANY DEVIATIONS FROM REGULATIONS AND STANDARDS MUST BE REQUESTED, AND APPROVED, IN WRITING.

WATERBURY FILING NO. 1 EL PASO COUNTY, CO CONSTRUCTION SET FEBRUARY 2023

SHEET INDEX

- COVER SHEET 1
FINAL GRADING PLAN FILING 1 2
FINAL GRADING PLAN OFFSITE POND 2 3
DETAIL SHEET 4
DETAIL SHEET 5
DETAIL SHEET 6
SAYBROOK ROAD 7
SAYBROOK ROAD CONT'D & GILBERT DR. 8
SANDY NECK CIR. 9
SUNKEN MEADOW ROAD 10
FISH CAMP DR. 11
SANDY NECK/FISH CAMP KNK. - FISH CAMP KNK. 12
MANOR HAVEN WAY 13
BEECH CIRCLE DR. 14
MUDDY POND ST. 15
MASONBORO WAY & MEGANSETT WAY 16
ROUNDBOUT CURB RETURN PROFILE 17
ROUNDBOUT DETAILED GRADING 18
SAYBROOK & ROUNDBOUT STRIPPING & SIGNING 19
STAPLETON ROAD PLAN & PROFILE 20
STAPLETON ROAD CROSS SECTIONS 21
STAPLETON ROAD SIGNAGE & STRIPING 22
STORM SEWER RUN 1 & 2 23
STORM SEWER RUN 3 & 4 24
STORM SEWER RUN 5 & 6 25
STORM SEWER RUN 7 & LATERALS 1 & 2 26
STORM SEWER RUN 8 & LATERAL 3 27
STORM LATERALS 4, 5 & 6 28
STORM SEWER RUNS 9 & 10 & LATERAL 9 & 10 29
STORM SEWER RUN 9 CONT'D & LATERAL 8 30
STORM SEWER RUN 10, 11 & 12 31
STORM LATERALS 11 & 12 32
STORM SEWER RUN 13 & 14 33
GILBERT DR. CULVERTS 34
POND 1 DETAILS 35
POND 2 DETAILS 36
POND 3 DETAILS 37
POND 3 DETAILS 38
POND 3 DETAILS 39

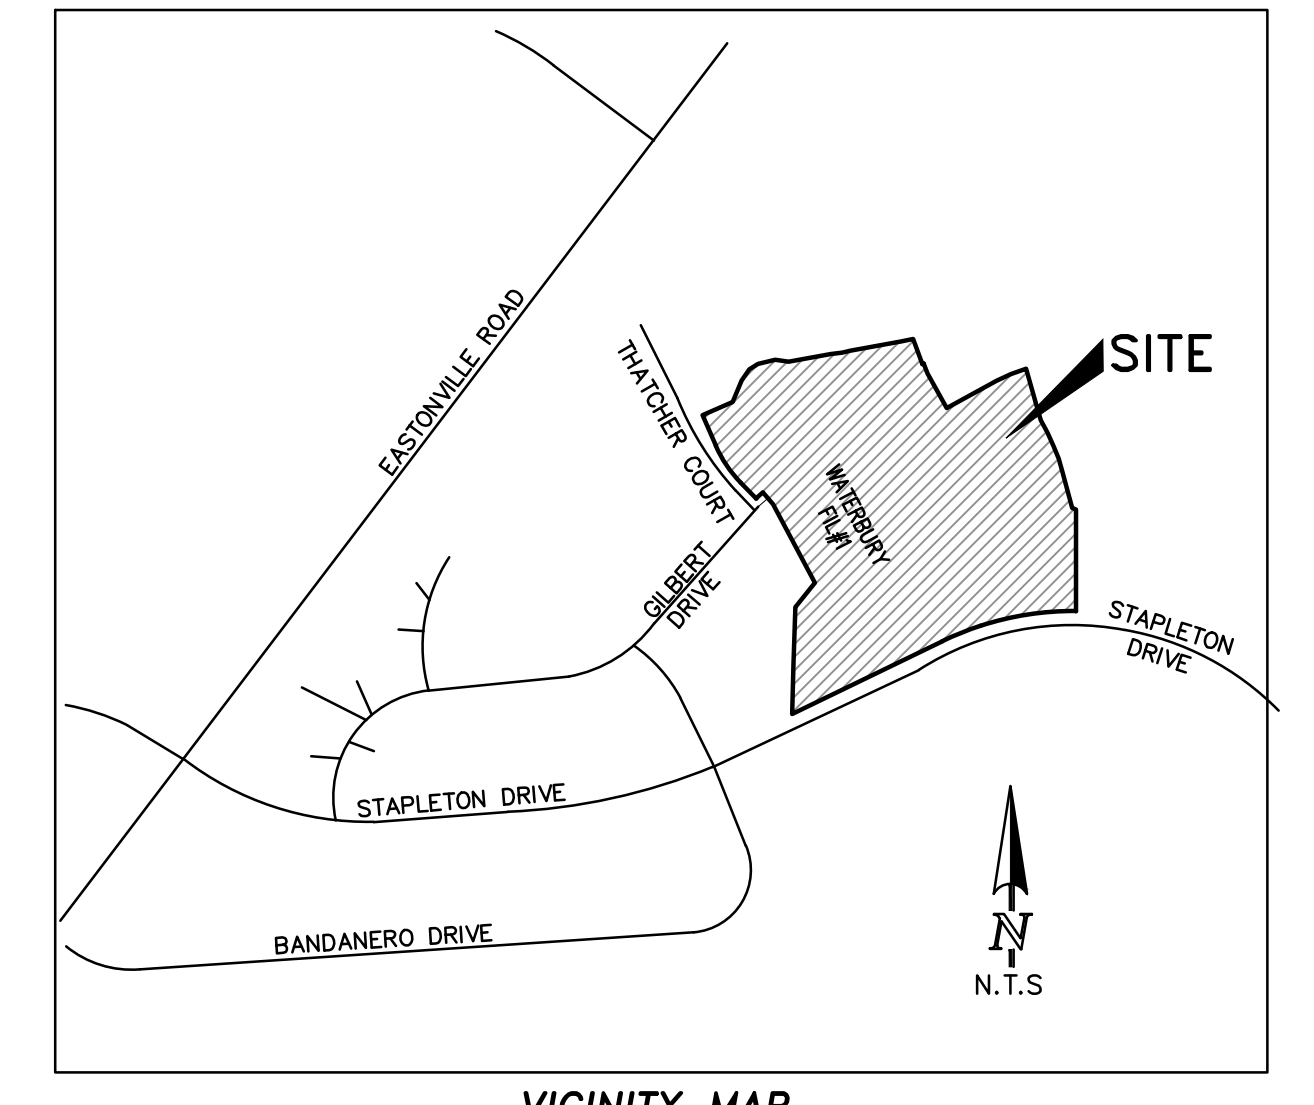

VICINITY MAP

GENERAL NOTES

- 1. IT SHALL BE THE RESPONSIBILITY OF THE CONTRACTOR TO VERIFY THE EXISTENCE AND LOCATION OF ALL UNDERGROUND UTILITIES ALONG THE SITE. THE OMISSION FROM OR THE INCLUSION OF UTILITY LOCATIONS ON THE PLANS IS NOT TO BE CONSIDERED AS THE NON-EXISTENCE OF OR A DEFINITE LOCATION OF EXISTING UNDERGROUND UTILITIES.
- 2. THE CONTRACTOR WILL TAKE THE NECESSARY PRECAUTIONS TO PROTECT EXISTING UTILITIES, BUILDINGS, FENCES, AND ROADWAYS FROM DAMAGE DUE TO THIS OPERATION. ANY DAMAGE TO THE ABOVE WILL BE REPAIRED AT THE CONTRACTOR'S EXPENSE, AND ANY SERVICE DISRUPTION WILL BE SETTLED BY THE CONTRACTOR.

CONTACT INFORMATION:

Table with columns for OWNER, CIVIL ENGINEER, ENGINEERING DIVISION, METRO DISTRICT, GAS DEPARTMENT, ELECTRIC DEPARTMENT, FIRE DEPARTMENT, TELEPHONE COMPANY, and BENCHMARKS.

EPC STORMWATER REVIEW COMMENTS IN ORANGE BOXES WITH BLACK TEXT

Will utility plans be separate? with EGP? Add roundabout lighting and landscaping plans.

BENCHMARKS

- 1. THE TOP OF A 1-1/2" X 2" ALUMINUM SURVEYORS CAP STAMPED JR LTD PLS 31161, AT THE MOST EASTERLY CORNER OF LOT 36 AS PLATED IN 4-WAY RANCH FILING NO. 1 RECORDED UNDER RECEPTION NO. 206712416 RECORDS OF EL PASO COUNTY, COLORADO ELEV= 6931.92

BASIS OF BEARING

THE NORTH LINE OF SECTION 28, TOWNSHIP 12 SOUTH, RANGE 64 WEST OF THE SIXTH PRINCIPAL MERIDIAN, EL PASO COUNTY, COLORADO BEING MONUMENTED AT EACH END BY A 3-1/4" ALUMINUM SURVEYOR'S CAP STAMPED "PSINC LS 30087 AND ASSUMED TO BEAR S89°47'04"E A DISTANCE OF 5,285.07 FEET

ENGINEER'S STATEMENT

THESE DETAILED PLANS AND SPECIFICATIONS WERE PREPARED UNDER MY DIRECTION AND SUPERVISION. SAID PLANS AND SPECIFICATIONS HAVE BEEN PREPARED ACCORDING TO THE CRITERIA ESTABLISHED BY THE COUNTY FOR DETAILED ROADWAY, DRAINAGE, GRADING AND EROSION CONTROL PLANS AND SPECIFICATIONS, AND SAID PLANS AND SPECIFICATIONS ARE IN CONFORMITY WITH APPLICABLE MASTER DRAINAGE PLANS AND MASTER TRANSPORTATION PLANS. SAID PLANS AND SPECIFICATIONS MEET THE PURPOSES FOR WHICH THE PARTICULAR ROADWAY AND DRAINAGE FACILITIES ARE DESIGNED AND ARE CORRECT TO THE BEST OF MY KNOWLEDGE AND BELIEF.

OWNER/DEVELOPER'S STATEMENT

I, THE OWNER/DEVELOPER HAVE READ AND WILL COMPLY WITH THE REQUIREMENTS SPECIFIED IN THESE DETAILED PLANS AND SPECIFICATIONS.

PETER MARTZ, OWNER
4-WAY RANCH JOINT VENTURE
P.O. BOX 50223
COLORADO SPRINGS, CO 80949

EL PASO COUNTY APPROVAL

COUNTY PLAN REVIEW IS PROVIDED ONLY FOR GENERAL CONFORMANCE WITH COUNTY DESIGN CRITERIA. THE COUNTY IS NOT RESPONSIBLE FOR THE ACCURACY AND ADEQUACY OF THE DESIGN, DIMENSIONS, AND/OR ELEVATIONS WHICH SHALL BE COVERED AT THE JOB SITE. THE COUNTY THROUGH THE APPROVAL OF THIS DOCUMENT ASSUMES NO RESPONSIBILITY FOR COMPLETENESS AND/OR ACCURACY OF THIS DOCUMENT.

IN ACCORDANCE WITH ECOM SECTION 1.12, THESE CONSTRUCTION DOCUMENTS WILL BE VALID FOR CONSTRUCTION FOR A PERIOD OF 2 YEARS FROM THE DATE SIGNED BY THE EL PASO COUNTY ENGINEER. IF CONSTRUCTION HAS NOT STARTED WITHIN THOSE 2 YEARS, THE PLANS WILL NEED TO BE RESUBMITTED FOR APPROVAL, INCLUDING PAYMENT OF REVIEW FEES AT THE PLANNING AND COMMUNITY DEVELOPMENT DIRECTORS DISCRETION.

JOSHUA PALMER, P.E.
COUNTY ENGINEER / DIRECTOR

4-WAY RANCH METROPOLITAN DISTRICT

THESE CONSTRUCTION DOCUMENTS HAVE BEEN REVIEWED AND APPROVED FOR SANITARY SEWER, WATER MAIN AND ASSOCIATED UTILITY SERVICE CONSTRUCTION.

FOR AND ON BEHALF OF THE 4-WAY RANCH METRO. DISTRICT DATE

EL PASO COUNTY STANDARD CONSTRUCTION NOTES:

- 1. ALL DRAINAGE AND ROADWAY CONSTRUCTION SHALL MEET THE STANDARDS AND SPECIFICATIONS OF THE CITY OF COLORADO SPRINGS/EL PASO COUNTY DRAINAGE CRITERIA MANUAL, VOLUMES 1 & 2 AND THE EL PASO COUNTY ENGINEERING CRITERIA MANUAL.
- 2. CONTRACTOR SHALL BE RESPONSIBLE FOR THE NOTIFICATION AND FIELD NOTIFICATION OF ALL EXISTING UTILITIES, WHETHER SHOWN ON THE PLANS OR NOT, BEFORE BEGINNING CONSTRUCTION. LOCATION OF EXISTING UTILITIES SHALL BE VERIFIED BY THE CONTRACTOR PRIOR TO CONSTRUCTION. CALL 811 TO CONTACT THE UTILITY NOTIFICATION CENTER OF COLORADO (UNCC).
- 3. CONTRACTOR SHALL KEEP A COPY OF THESE APPROVED PLANS, THE GRADING AND EROSION CONTROL PLAN, THE STORMWATER MANAGEMENT PLAN (SWMP), THE SOILS AND GEOTECHNICAL REPORT, AND THE APPROPRIATE DESIGN AND CONSTRUCTION STANDARDS AND SPECIFICATIONS AT THE JOB SITE AT ALL TIMES, INCLUDING THE FOLLOWING:
A. EL PASO COUNTY ENGINEERING CRITERIA MANUAL (ECM)
B. CITY OF COLORADO SPRINGS/EL PASO COUNTY DRAINAGE CRITERIA MANUAL, VOLUMES 1 & 2
C. COLORADO DEPARTMENT OF TRANSPORTATION (CDOT) STANDARD SPECIFICATIONS FOR ROAD AND BRIDGE CONSTRUCTION
D. CDOT M & S STANDARDS.

SIGNING AND STRIPING NOTES

- 1. ALL SIGNS AND PAVEMENT MARKINGS SHALL BE IN COMPLIANCE WITH THE CURRENT MANUAL ON UNIFORM TRAFFIC CONTROL DEVICES (MUTCD).
- 2. REMOVAL OF EXISTING PAVEMENT MARKINGS SHALL BE ACCOMPLISHED BY A METHOD THAT DOES NOT MATERIALLY DAMAGE THE PAVEMENT. THE PAVEMENT MARKINGS SHALL BE REMOVED TO THE EXTENT THAT THEY WILL NOT BE VISIBLE UNDER DAY OR NIGHT CONDITIONS. AT NO TIME WILL IT BE ACCEPTABLE TO PAINT OVER EXISTING PAVEMENT MARKINGS.
- 3. ANY DEVIATION FROM THE STRIPING AND SIGNING PLAN SHALL BE APPROVED BY EL PASO COUNTY PLANNING AND COMMUNITY DEVELOPMENT.
- 4. ALL SIGNS SHOWN ON THE SIGNING AND STRIPING PLAN SHALL BE NEW SIGNS. EXISTING SIGNS MAY REMAIN OR BE REUSED IF THEY MEET CURRENT EL PASO COUNTY AND MUTCD STANDARDS.
- 5. STREET NAME AND REGULATORY STOP SIGNS SHALL BE ON THE SAME POST AT INTERSECTIONS.
- 6. ALL REMOVED SIGNS SHALL BE DISPOSED OF IN A PROPER MANNER BY THE CONTRACTOR.
- 7. ALL STREET NAME SIGNS SHALL HAVE "D" SERIES LETTERS, WITH LOCAL ROADWAY SIGNS BEING "A" UPPER-LOWER CASE LETTERING ON 8" BLANK AND NON-LOCAL ROADWAY SIGNS BEING "B" LETTERING, UPPER-LOWER CASE ON 12" BLANK, WITH A WHITE BORDER THAT IS NOT RECESSED. MULTI-LANE ROADWAYS WITH SPEED LIMITS OF 40 MPH OR HIGHER SHALL HAVE "B" UPPER-LOWER CASE LETTERING ON 18" BLANK WITH A WHITE BORDER THAT IS NOT RECESSED. THE WIDTH OF THE NON-RECESSED WHITE BORDERS SHALL MATCH PAGE 255 OF THE 2012 MUTCD STANDARD HIGHWAY SIGNS.
- 8. ALL TRAFFIC SIGNS SHALL HAVE A MINIMUM HIGH INTENSITY PRISMATIC GRADE SHEETING.
- 9. ALL LOCAL RESIDENTIAL STREET SIGNS SHALL BE MOUNTED ON A 1.75" X 1.75" SQUARE TUBE SIGN POST AND STUB POST BASE. FOR OTHER APPLICATIONS, REFER TO THE CDOT STANDARD S-614-B REGARDING USE OF THE P2 TUBULAR STEEL POST SLIPBASE DESIGN.
- 10. ALL SIGNS SHALL BE SINGLE SHEET ALUMINUM WITH 0.100" MINIMUM THICKNESS.
- 11. ALL LIMIT LINES/STOP LINES, CROSSWALK LINES, PAVEMENT LEGENDS, AND ARROWS SHALL BE A MINIMUM 125 MIL THICKNESS PREFORMED THERMOPLASTIC PAVEMENT MARKINGS WITH TAPERED LEADING EDGES PER CDOT STANDARD S-627-1. WORD AND SYMBOL MARKINGS SHALL BE THE NARROW TYPE. STOP BARS SHALL BE 24" IN WIDTH. CROSSWALKS LINES SHALL BE 12" WIDE AND 2" LONG PER CDOT S-627-1.
- 12. ALL LONGITUDINAL LINES SHALL BE A MINIMUM 15MIL THICKNESS EPOXY PAINT. ALL NON-LOCAL RESIDENTIAL ROADWAYS SHALL INCLUDE BOTH RIGHT AND LEFT EDGE LINE STRIPING AND ANY ADDITIONAL STRIPING AS REQUIRED BY CDOT S-627-1.
- 13. THE CONTRACTOR SHALL NOTIFY EL PASO COUNTY PLANNING AND COMMUNITY DEVELOPMENT (719) 520-6819 PRIOR TO AND UPON COMPLETION OF SIGNING AND STRIPING.
- 14. THE CONTRACTOR SHALL OBTAIN A WORK IN THE RIGHT OF WAY PERMIT FROM THE EL PASO COUNTY DEPARTMENT OF PUBLIC WORKS (DPW) PRIOR TO ANY SIGNAGE OR STRIPING WORK WITHIN AN EXISTING EL PASO COUNTY ROADWAY.

TRAFFIC CONTROL NOTE

THE CONTRACTOR SHALL PROVIDE ALL TRAFFIC CONTROL DEVICES AND MONITORING NECESSARY TO SAFELY COMPLETE THE WORK SHOWN IN THESE CONSTRUCTION DOCUMENTS IN CONFORMANCE WITH M.U.T.C.D. GUIDELINES. THE CONTRACTOR SHALL COMPLETE ALL NECESSARY WORK FOR PLAN REVIEW, PERMITS AND PROCESSING. TRAFFIC CONTROL WILL NOT BE PAID SEPARATELY BUT IS INCLUDED IN THE COST OF THE PROJECT.

Update and add report Soil, Geology, and Geologic Hazard Addendum and Report (Entech Engineering, Inc., February 2, 2022 and October 18, 2021)

Department of Public Works

change PCD to DPW

DPW

Vertical sidebar containing: REVISIONS table, UNTIL SUCH TIME AS THESE DRAWINGS ARE APPROVED BY TERRA NOVA ENGINEERING, INC., APPROVES THEIR USE ONLY FOR THE PROJECT AUTHORIZED BY WRITTEN AUTHORIZATION, PREPARED FOR: 4-WAY RANCH JOINT VENTURE, ATTN: PETER MARTZ, P.O. BOX 50223, COLORADO SPRINGS, CO 80949, TERRA NOVA Engineering, Inc., 721 S. 23RD STREET, COLORADO SPRINGS, CO 80904, OFFICE: 719-635-6422, FAX: 719-635-6426, www.tnec.com, WATERBURY FILING NO. 1 & 2, CONSTRUCTION SET COVER SHEET, DESIGNED BY QNA, DRAWN BY QNA, CHECKED BY, H-SCALE AS SHOWN, V-SCALE N/A, JOB NO. 1715.00, DATE ISSUED 2/6/23, SHEET NO. 1 OF 39.

**EROSION CONTROL LEGEND**

KEY	TITLE	SYMBOL	IMPLEMENTATION PHASE
SF	SILT FENCE	— SF —	FINAL
CF	CONSTRUCTION FENCE	— CF —	FINAL
CIP	CULVERT INLET PROTECTION	[Symbol]	FINAL
IP	INLET PROTECTION	[Symbol]	FINAL
SBB	STRAW BALE BARRIER	[Symbol]	FINAL
SP	STOCKPILE PROTECTION	[Symbol]	FINAL
VTC	VEHICLE TRACKING CONTROL	[Symbol]	FINAL
CWA	CONCRETE WASHOUT AREA	[Symbol]	FINAL
SSA	STABILIZED STAGING AREA	[Symbol]	FINAL
TSM	TEMPORARY SEEDING AND MULCHING	[Symbol]	FINAL

**GRADING LEGEND**

8' EXISTING CONTOUR	6810	100-YEAR HWL HEC-RAS ANALYSIS
1' EXISTING CONTOUR	6802	
5' PROPEL CONTOUR	6810	
1' PROPEL CONTOUR	6802	
LIMITS OF DISTURBANCE/ CONSTRUCTION BOUNDARY	[Symbol]	
CUT/FILL LINE	[Symbol]	
DIRECTION OF SURFACE FLOW	[Symbol]	
HIGH POINT	HPX	
LOW POINT	LPX	
A LOT	"A"	
B LOT	"B"	
WALK OUT LOT MODIFIED	"WO"	
GARDEN LEVEL LOT MODIFIED	"G"	
100-Y FEMA FLOODPLAIN	[Symbol]	
100-Y HWL PER HECRAS ANALYSIS	[Symbol]	
AREAS OF DE-WATERING	[Symbol]	

**WETLANDS LEGEND**

EXISTING WETLANDS	[Symbol]
TEMPORARY WETLAND DISTURBANCE	[Symbol]
PERMANENT WETLAND DISTURBANCE	[Symbol]


**VEGETATION NOTE:**

EXISTING VEGETATION CONSISTS OF NATIVE PRAIRIE GRASSES AND SHRUBS WITH FAIR TO GOOD COVERAGE OF 50% TO 70%  
**NOTES:**  
 NO BATCH PLANTS ARE PROPOSED  
 ALL CONTROL MEASURES ARE BEING IMPLEMENTED BY THE OWNER/DEVELOPER/CONTRACTOR

**RUNOFF REDUCTION LEGEND**

UNCONNECTED IMPERVIOUS AREA	[Symbol]
RECEIVING PERVIOUS AREA	[Symbol]
EXCLUDED UNDEVELOPED PERVIOUS AREA PER THE EXCLUSION IN ECM APPENDIX 1.7.1.B.7 - SITES WITH LAND DISTURBANCE TO UNDEVELOPED LAND THAT WILL REMAIN UNDEVELOPED	[Symbol]

Add a general note: all areas to be vegetated with permanent seeding should also be temporary stabilized via track rolling or some other means.

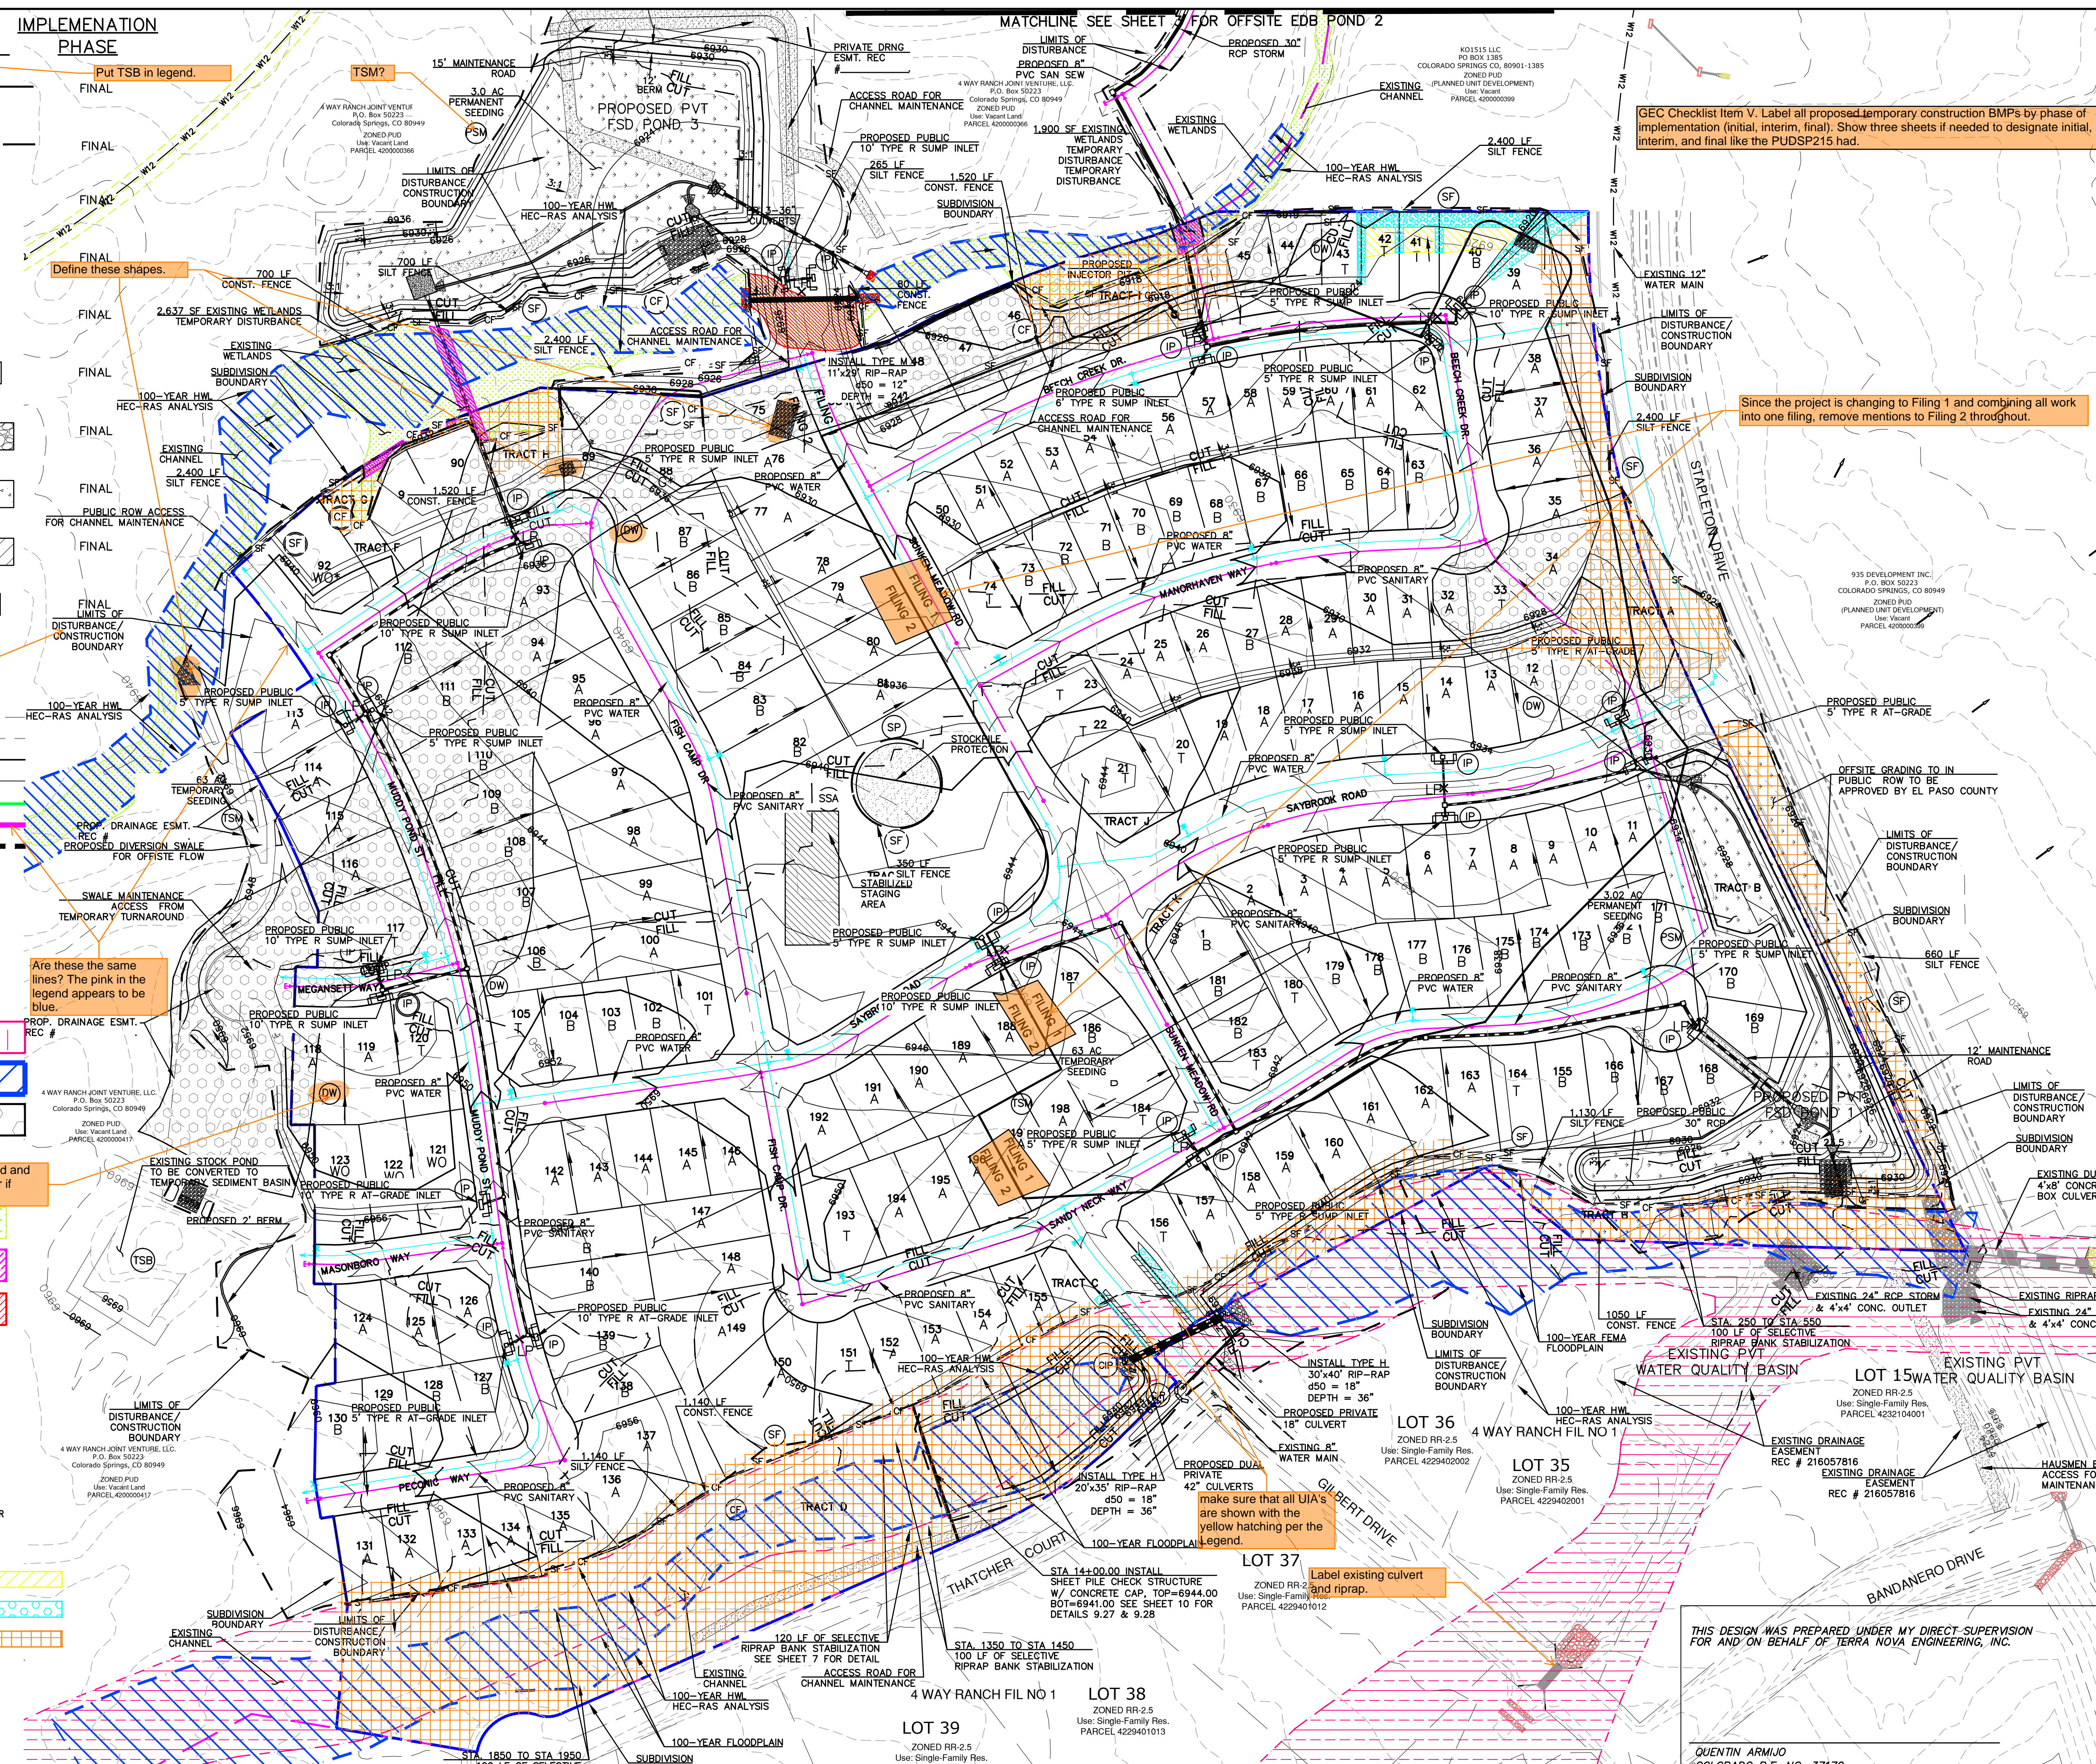

GEC Checklist Item V. Label all proposed temporary construction BMPs by phase of implementation (initial, interim, final). Show three sheets if needed to designate initial, interim, and final like the PUDSP215 had.

Since the project is changing to Filing 1 and combining all work into one filing, remove mentions to Filing 2 throughout.

Are these the same lines? The pink in the legend appears to be blue.

Put DW in legend and provide detail for if needed.

make sure that all UJA's are shown with the yellow hatching per the legend.

Label existing culvert and riprap.

THIS DESIGN WAS PREPARED UNDER MY DIRECT SUPERVISION FOR AND ON BEHALF OF TERRA NOVA ENGINEERING, INC.

DATE	
DESCRIPTION	
REVISIONS	
NO.	
UNTIL SUCH TIME AS THESE DRAWINGS ARE APPROVED BY THE REVIEWING AGENCIES OR THE TERRA NOVA ENGINEERING, INC. APPROVES THEIR USE ONLY FOR THE PROJECT AND FOR THE PURPOSES AUTHORIZED BY WRITTEN AUTHORIZATION.	
PREPARED FOR:	4-WAY RANCH JOINT VENTURE
ATTN:	PETER MARTZ
	P.O. BOX 50223
	COLORADO SPRINGS, CO 80949
	719-491-3150
DESIGNED BY	DLF
DRAWN BY	QNA
CHECKED BY	QNA
H-SCALE	1" = 100'
V-SCALE	N/A
JOB NO.	1715.00
DATE ISSUED	2/6/23
SHEET NO.	2 OF 39

**GENERAL NOTES**

- IT SHALL BE THE RESPONSIBILITY OF THE CONTRACTOR TO VERIFY THE EXISTENCE AND LOCATION OF ALL UNDERGROUND UTILITIES ALONG THE SITE. THE OMISSION FROM OR THE INCLUSION OF UTILITY LOCATIONS ON THE PLANS IS NOT TO BE CONSIDERED AS THE NON-EXISTENCE OF OR A DEFINITE LOCATION OF EXISTING UNDERGROUND UTILITIES.
- THE CONTRACTOR WILL TAKE THE NECESSARY PRECAUTIONS TO PROTECT EXISTING UTILITIES, BUILDINGS, FENCES, AND ROADWAYS FROM DAMAGE DUE TO THIS OPERATION. ANY DAMAGE TO THE ABOVE WILL BE REPAIRED AT THE CONTRACTOR'S EXPENSE, AND ANY SERVICE DISRUPTION WILL BE SETTLED BY THE CONTRACTOR.
- BULK GRADING SHALL BE COMPLETED TO A SUBGRADE TOLERANCE OF PLUS OR MINUS 0.2'.
- CONTRACTOR TO OBTAIN COPIES OF THE SOILS REPORT FROM THE GEOTECHNICAL ENGINEER AND TO BE KEPT ONSITE DURING ALL EARTHWORK OPERATIONS.
- MAXIMUM CUT/FILL SLOPES SHALL NOT EXCEED 3:1, UNLESS OTHERWISE NOTED.
- ALL BOTOM OF WALL (BW) CALLOUTS ARE FOR THE BOTTOM OF WALL AT GRADE. THEY DO NOT REPRESENT THE BOTTOM OF THE CONSTRUCTED WALL OR FOOTING, WHICH IS NOT SPECIFIED ON THESE PLANS.

**SOIL TYPES**

ONSITE SOILS ARE HYDROLOGIC GROUPS "A" (COLUMBINE GRAVELLY SANDY LOAM) AND "B" (STAPLETON SANDY LOAM) (PER NRCS WEB SOIL SURVEY MAP)

**AREA OF DISTURBANCE**


ESTIMATED AREA OF DISTURBANCE = 68.70 ACRES

**EARTHWORK VOLUMES**

ESTIMATED CUT = 73,990 CY, ESTIMATED FILL = 287,149\* CY, NET = 213,159 CY <FILL>  
 \*20% COMPACTION ASSUMED FOR PLACEMENT OF FILL

**BLACK SQUIRREL CREEK NOTE:**

IF AN UNDERDRAIN SYSTEMS ARE NEEDED FOR HOMES LOCATED WITH HIGH GROUNDWATER WILL NEED TO DISCHARGE INTO A GROUNDWATER RECHARGE FACILITY, NOT A STORM DRAIN SYSTEM.

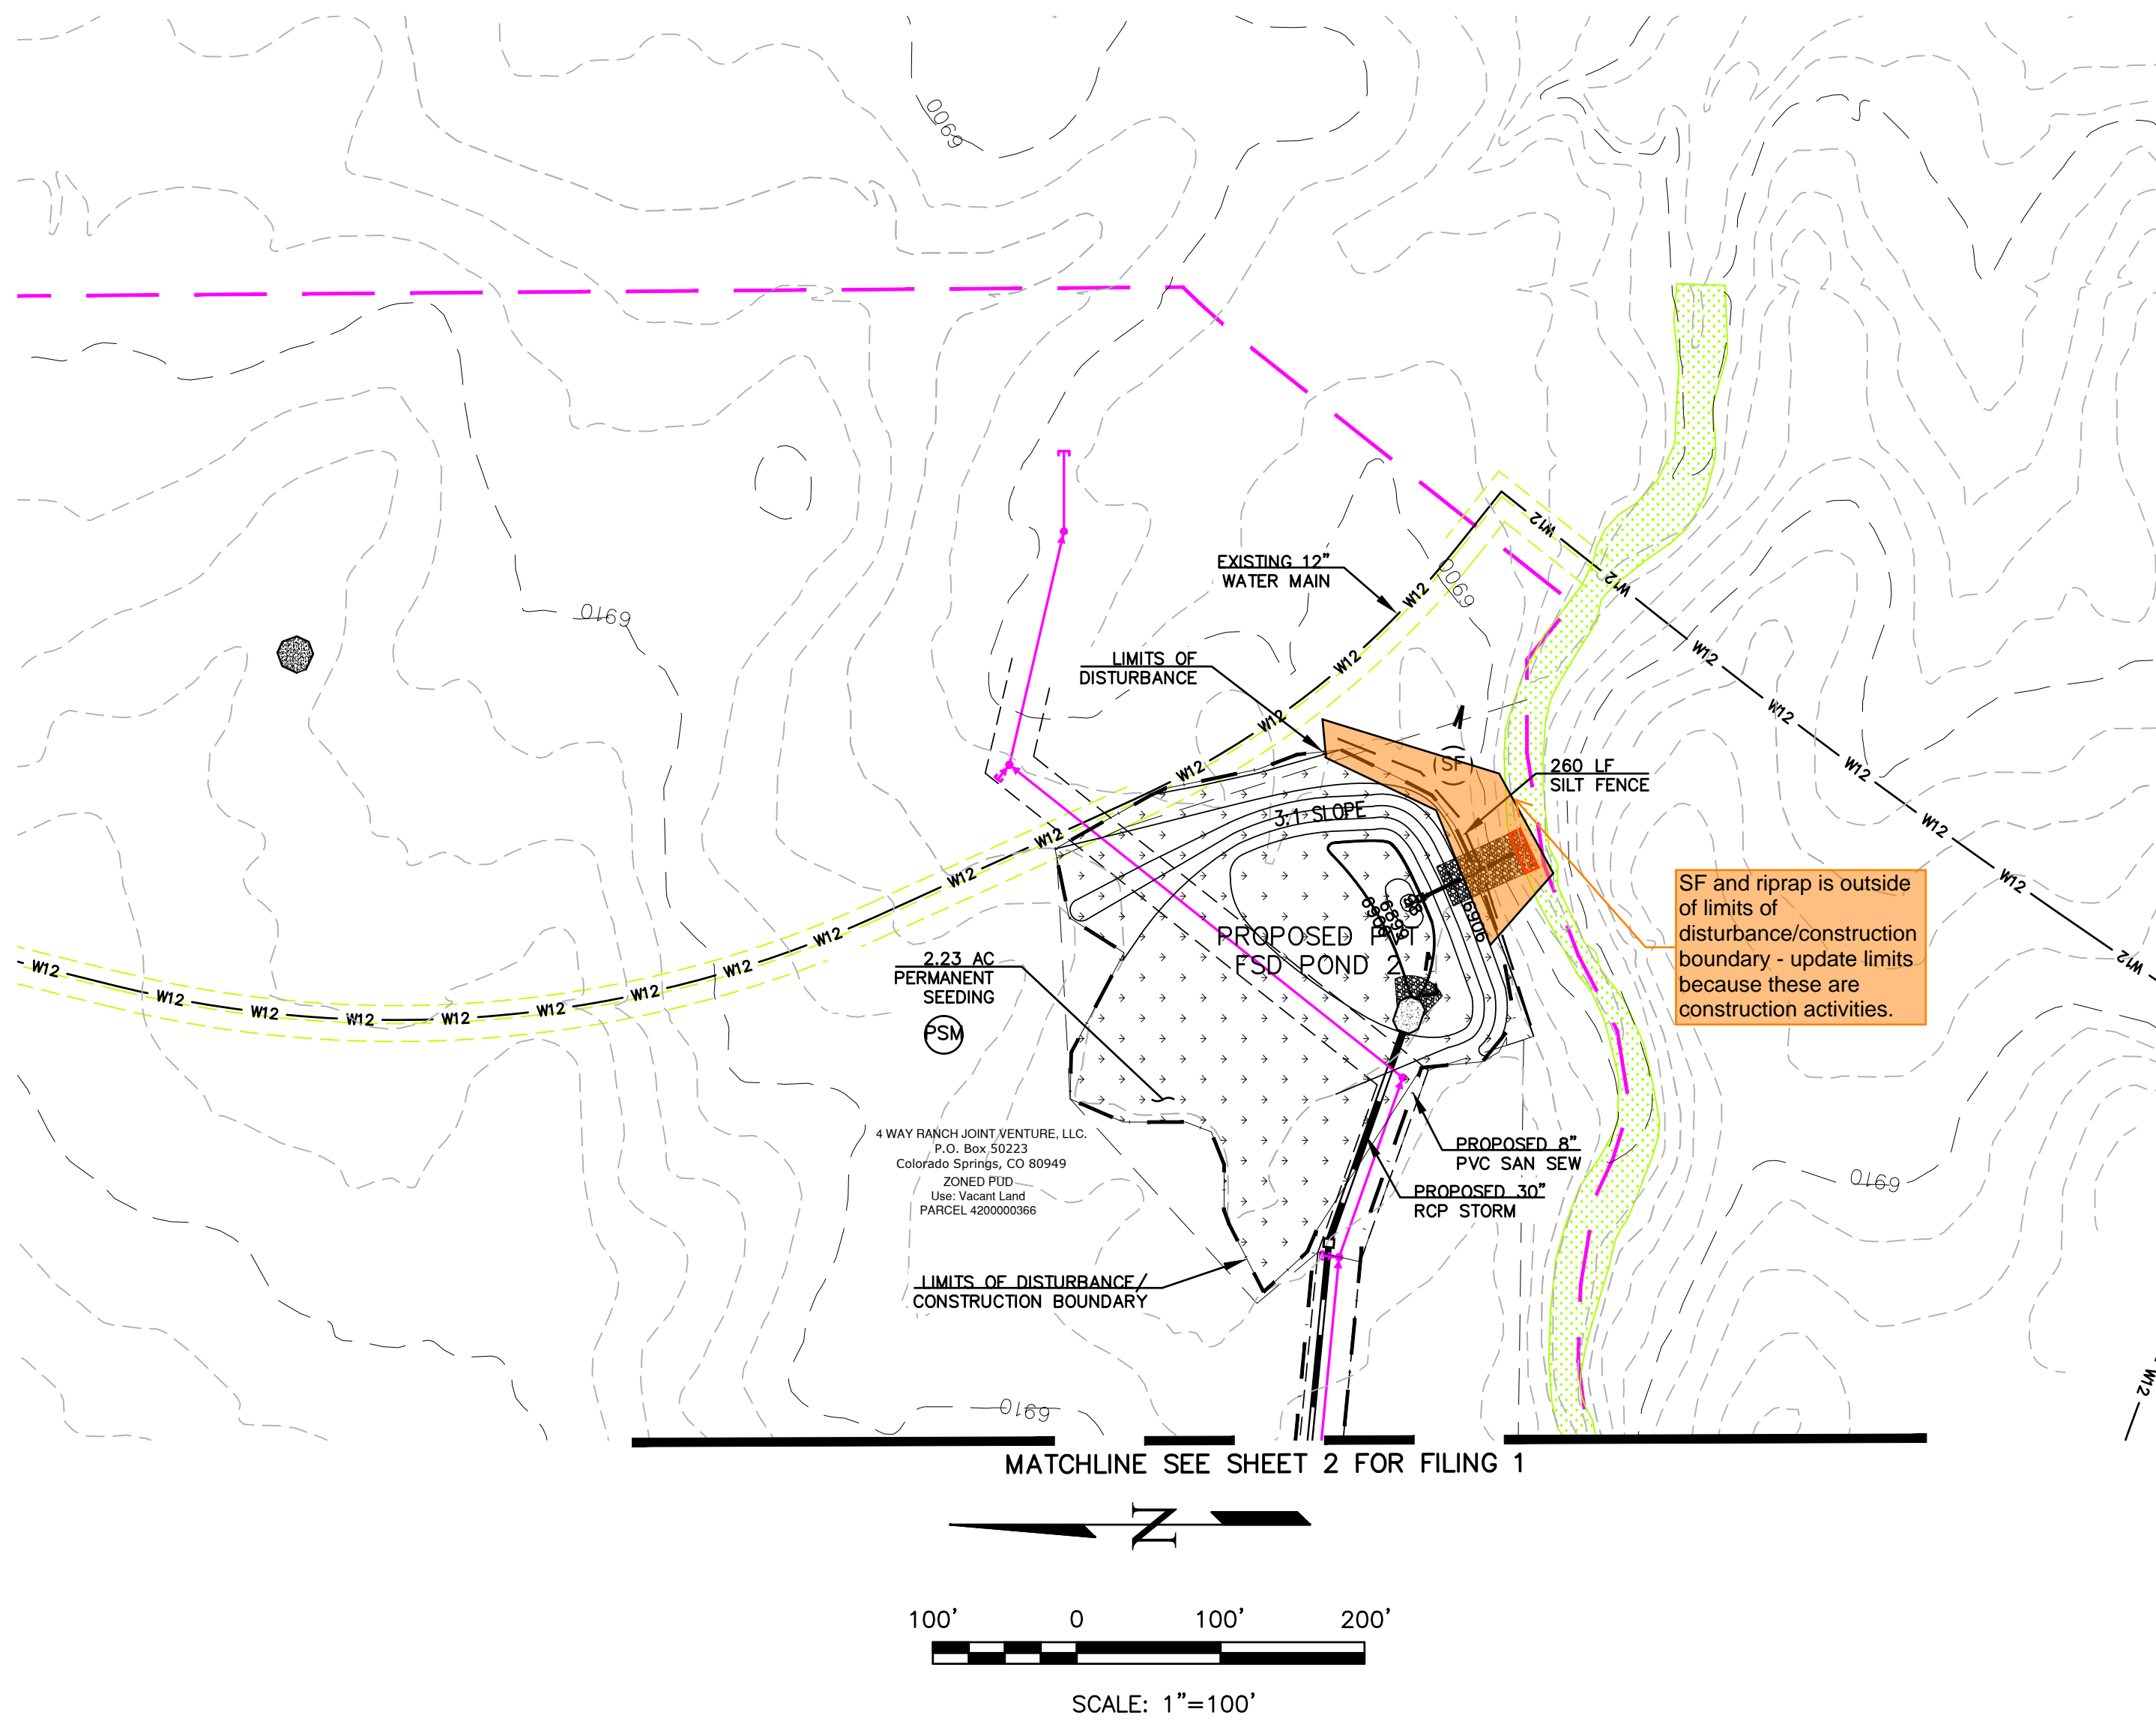

**NOTES:**  
 NO BUNCH PLANTS ARE PROPOSED  
 ALL CONTROL MEASURES ARE BEING IMPLEMENTED BY THE OWNER/DEVELOPER/CONTRACTOR

**GRADING LEGEND**

- 8' EXISTING CONTOUR
- 1' EXISTING CONTOUR
- 5' PROPEP CONTOUR
- 1' PROPEP CONTOUR
- LIMITS OF DISTURBANCE / CONSTRUCTION BOUNDARY
- SUBDIVISION BOUNDARY
- CUT/FILL LINE
- DIRECTION OF SURFACE FLOW
- HIGH POINT
- LOW POINT
- A LOT
- B LOT
- WALK OUT LOT MODIFIED
- GARDEN LEVEL LOT MODIFIED
- 100-Y FEMA FLOODPLAIN
- 100-Y HWL PER HECRAS ANLYSIS
- AREAS OF DE-WATERING

**WETLANDS LEGEND**


- EXISTING WETLANDS
- TEMPORARY WETLAND DISTURBANCE
- PERMANENT WETLAND DISTURBANCE

THIS DESIGN WAS PREPARED UNDER MY DIRECT SUPERVISION FOR AND ON BEHALF OF TERRA NOVA ENGINEERING, INC.

QUENTIN ARMUJO  
 COLORADO P.E. NO. 37170

REVISIONS NO. DESCRIPTION DATE	UNTIL SUCH TIME AS THESE DRAWINGS ARE APPROVED BY REVIEWING AGENCIES, THE TERRA NOVA ENGINEERING, INC. APPROVES THEIR USE ONLY FOR THE PROJECT AND FOR THE PURPOSES SPECIFIED BY WRITTEN AUTHORIZATION.
	PREPARED FOR: 4-WAY RANCH JOINT VENTURE ATTN: PETER MARTZ P.O. BOX 50223 COLORADO SPRINGS, CO 80949 719-491-3150
721 S. 23RD STREET COLORADO SPRINGS, CO 80904 OFFICE: 719-635-6422 FAX: 719-635-6426 www.tnengine.com	
WATERBURY FILING NO. 1 CONSTRUCTION SET GRADING EROSION & CONTROL PLAN FINAL EROSION CONTROL PLAN 2	
DESIGNED BY DLF DRAWN BY QNA CHECKED BY QNA H-SCALE N/A V-SCALE N/A JOB NO. 1715.00 DATE ISSUED 2/6/23 SHEET NO. 3 OF 39	


**SC-6 Inlet Protection (IP)**

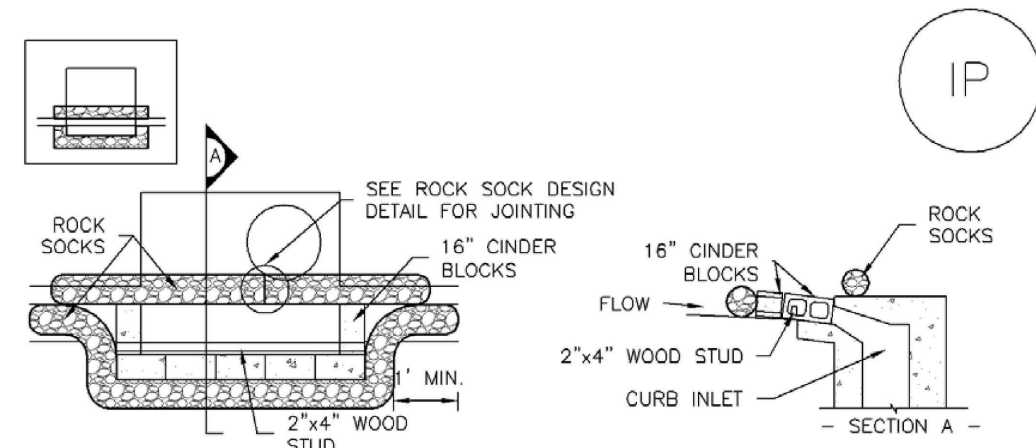

**IP-1. BLOCK AND ROCK SOCK SUMP OR ON GRADE INLET PROTECTION**

**BLOCK AND CURB SOCK INLET PROTECTION INSTALLATION NOTES**

- SEE ROCK SOCK DESIGN DETAIL FOR INSTALLATION REQUIREMENTS.
- CONCRETE "CINDER" BLOCKS SHALL BE LAID ON THEIR SIDES AROUND THE INLET IN A SINGLE ROW, ABUTTING ONE ANOTHER WITH THE OPEN END FACING AWAY FROM THE CURB.
- GRAVEL BAGS SHALL BE PLACED AROUND CONCRETE BLOCKS, CLOSELY ABUTTING ONE ANOTHER AND JOINED TOGETHER IN ACCORDANCE WITH ROCK SOCK DESIGN DETAIL.

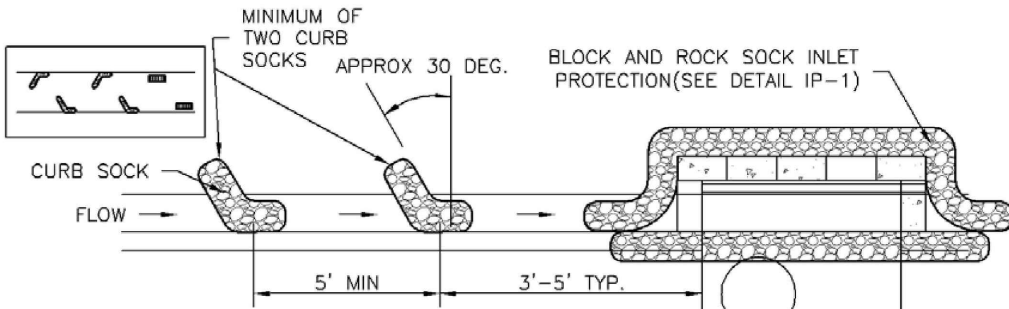

**IP-2. CURB ROCK SOCKS UPSTREAM OF INLET PROTECTION**

**CURB ROCK SOCK INLET PROTECTION INSTALLATION NOTES**

- SEE ROCK SOCK DESIGN DETAIL INSTALLATION REQUIREMENTS.
- PLACEMENT OF THE SOCK SHALL BE APPROXIMATELY 30 DEGREES FROM PERPENDICULAR IN THE OPPOSITE DIRECTION OF FLOW.
- SOCKS ARE TO BE FLUSH WITH THE CURB AND SPACED A MINIMUM OF 5 FEET APART.
- AT LEAST TWO CURB SOCKS IN SERIES ARE REQUIRED UPSTREAM OF ON-GRADE INLETS.

**SC-6 Inlet Protection (IP)**

**GENERAL INLET PROTECTION INSTALLATION NOTES**

- SEE PLAN VIEW FOR:
  - LOCATION OF INLET PROTECTION.
  - TYPE OF INLET PROTECTION (IP.1, IP.2, IP.3, IP.4, IP.5, IP.6)
- INLET PROTECTION SHALL BE INSTALLED PROMPTLY AFTER INLET CONSTRUCTION OR PAVING IS COMPLETE (TYPICALLY WITHIN 48 HOURS). IF A RAINFALL/RUNOFF EVENT IS FORECAST, INSTALL INLET PROTECTION PRIOR TO ONSET OF EVENT.
- MANY JURISDICTIONS HAVE BMP DETAILS THAT VARY FROM UDFCD STANDARD DETAILS. CONSULT WITH LOCAL JURISDICTIONS AS TO WHICH DETAIL SHOULD BE USED WHEN DIFFERENCES ARE NOTED.

**INLET PROTECTION MAINTENANCE NOTES**



- INSPECT BMPs EACH WORKDAY, AND MAINTAIN THEM IN EFFECTIVE OPERATING CONDITION. MAINTENANCE OF BMPs SHOULD BE PROACTIVE, NOT REACTIVE. INSPECT BMPs AS SOON AS POSSIBLE (AND ALWAYS WITHIN 24 HOURS) FOLLOWING A STORM THAT CAUSES SURFACE EROSION, AND PERFORM NECESSARY MAINTENANCE.
- FREQUENT OBSERVATIONS AND MAINTENANCE ARE NECESSARY TO MAINTAIN BMPs IN EFFECTIVE OPERATING CONDITION. INSPECTIONS AND CORRECTIVE MEASURES SHOULD BE DOCUMENTED THOROUGHLY.
- WHERE BMPs HAVE FAILED, REPAIR OR REPLACEMENT SHOULD BE INITIATED UPON DISCOVERY OF THE FAILURE.
- SEDIMENT ACCUMULATED UPSTREAM OF INLET PROTECTION SHALL BE REMOVED AS NECESSARY TO MAINTAIN BMP EFFECTIVENESS, TYPICALLY WHEN STORAGE VOLUME REACHES 50% OF CAPACITY, A DEPTH OF 6" WHEN SILT FENCE IS USED, OR 1/4 OF THE HEIGHT FOR STRAW BALES.
- INLET PROTECTION IS TO REMAIN IN PLACE UNTIL THE UPSTREAM DISTURBED AREA IS PERMANENTLY STABILIZED, UNLESS THE LOCAL JURISDICTION APPROVES EARLIER REMOVAL OF INLET PROTECTION IN STREETS.
- WHEN INLET PROTECTION AT AREA INLETS IS REMOVED, THE DISTURBED AREA SHALL BE COVERED WITH TOP SOIL, SEEDED AND MULCHED, OR OTHERWISE STABILIZED IN A MANNER APPROVED BY THE LOCAL JURISDICTION.

(DETAIL ADAPTED FROM TOWN OF PARKER, COLORADO AND CITY OF AURORA, COLORADO, NOT AVAILABLE IN AUTOCAD)

NOTE: MANY JURISDICTIONS HAVE BMP DETAILS THAT VARY FROM UDFCD STANDARD DETAILS. CONSULT WITH LOCAL JURISDICTIONS AS TO WHICH DETAIL SHOULD BE USED WHEN DIFFERENCES ARE NOTED.

NOTE: THE DETAILS INCLUDED WITH THIS FACT SHEET SHOW COMMONLY USED, CONVENTIONAL METHODS OF INLET PROTECTION IN THE DENVER METROPOLITAN AREA. THERE ARE MANY PROPRIETARY INLET PROTECTION METHODS ON THE MARKET. UDFCD NEITHER ENDORSES NOR DISAPPROVES USE OF PROPRIETARY INLET PROTECTION; HOWEVER, IN THE EVENT PROPRIETARY METHODS ARE USED, THE APPROPRIATE DETAIL FROM THE MANUFACTURER MUST BE INCLUDED IN THE SWMP AND THE BMP MUST BE INSTALLED AND MAINTAINED AS SHOWN IN THE MANUFACTURER'S DETAILS.

NOTE: SOME MUNICIPALITIES DISCOURAGE OR PROHIBIT THE USE OF STRAW BALES FOR INLET PROTECTION. CHECK WITH LOCAL JURISDICTION TO DETERMINE IF STRAW BALE INLET PROTECTION IS ACCEPTABLE.

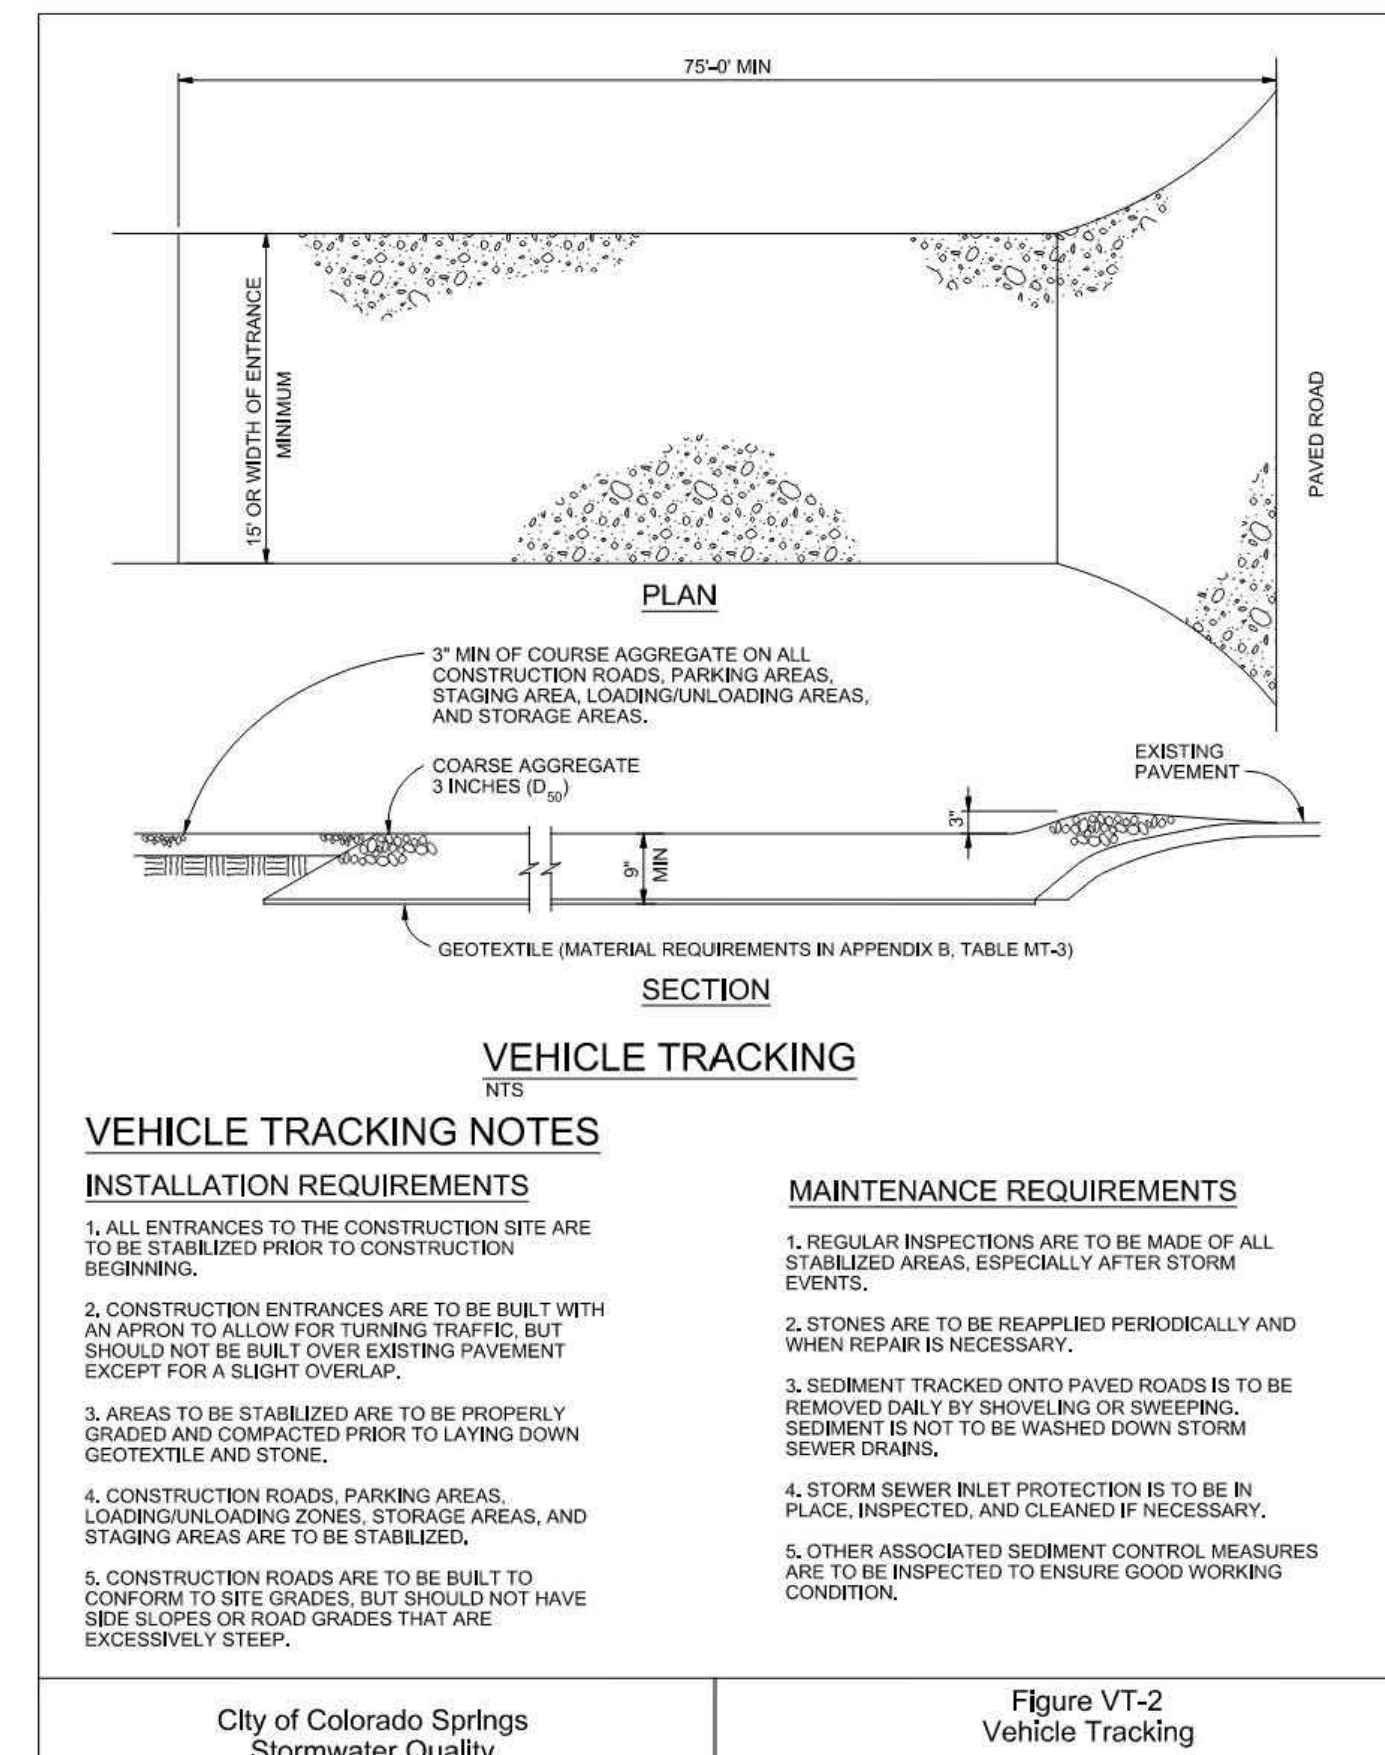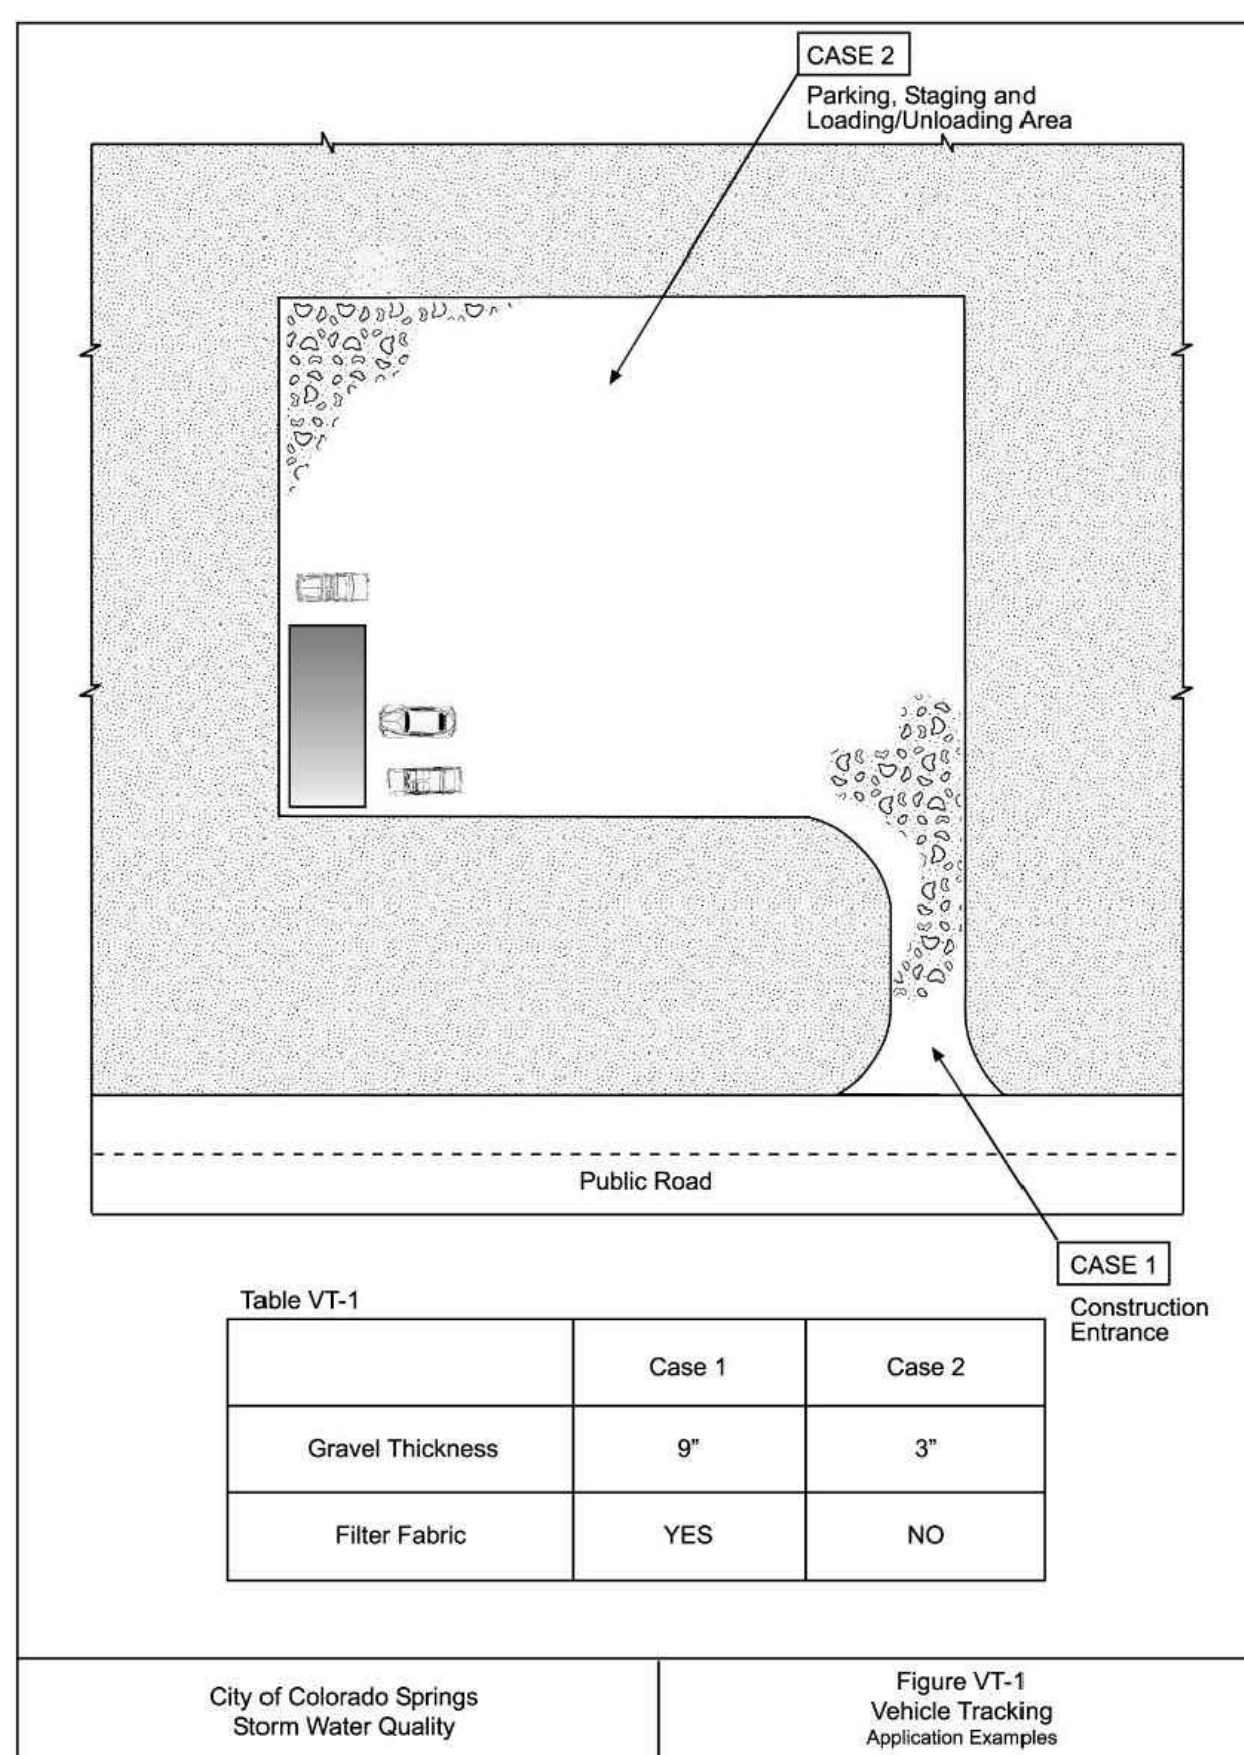

**Revegetation Chapter 14**

**Table 14-10. Recommended Seed Mix for Transition Areas<sup>1</sup>**

Common Name (Variety)	Scientific Name	Growth Season	Growth Form	Seeds/Lb	Lbs PLS/Acre Drilled	Lbs PLS/Acre Broadcast or Hydroseeded
Sheep fescue (Duras)	<i>Festuca ovina</i>	Cool	Bunch	680,000	1.3	2.6
Western wheatgrass (Arriba)	<i>Pascopyrum smithii</i>	Cool	Sod	110,000	7.9	15.8
Alkali sacaton	<i>Sporobolus airoides</i>	Warm	Bunch	1,758,000	0.5	1.0
Slender wheatgrass	<i>Elymus trachycaulus</i>	Cool	Bunch	159,000	5.5	11.0
Canadian bluegrass (Ruebens)	<i>Poa compressa</i>	Cool	Sod	2,500,000	0.3	0.6
Switchgrass (Pathfinder)	<i>Panicum virgatum</i>	Warm	Sod/Bunch	389,000	1.3	2.6
Annual rye	<i>Lolium multiflorum</i>	Cool	Cover crop	227,000	10.0	20.0
				<b>TOTAL</b>	<b>26.8</b>	<b>53.6</b>
<b>Wildflowers</b>						
Blanket flower	<i>Faillardia aristata</i>	---	---	132,000	0.25	0.50
Prairie coneflower	<i>Ratibida columnaris</i>	---	---	1,230,000	0.20	0.40
Purple prairie clover	<i>Petalostemum purpurea</i>	---	---	210,000	0.20	0.40
Gayfeather	<i>Liatris punctata</i>	---	---	138,000	0.06	0.12
Flax	<i>Linum lewisii</i>	---	---	293,000	0.20	0.40
Penstemon	<i>Penstemon strictus</i>	---	---	592,000	0.20	0.40
Yarrow	<i>Achillea millefolium</i>	---	---	2,770,000	0.03	0.06
				<b>TOTAL</b>	<b>1.14</b>	<b>2.28</b>

<sup>1</sup>For side slopes or between wet and dry areas.  
<sup>2</sup>Substitute 1.7 lbs PLS/acre of inland saltgrass (*Distichlis spicata*) in salty soils.

**SEED MIX FOR POND BOTTOMS**

THE CITY OF COLORADO SPRINGS ENGINEERING DEPARTMENT GENERAL SPECIFICATIONS SHOULD BE USED AS A RESOURCE WHEN DEVELOPING TECHNICAL SPECIFICATIONS FOR RE-VEGETATION. GENERAL GUIDELINES AND RECOMMENDATIONS FOR RE-VEGETATION INCLUDE:


- SEED MIXTURES SHOULD BE SOWN AT THE PROPER TIME OF YEAR FOR THE MIXTURE. GENERALLY, THERE ARE TWO OPTIMAL SEEDING PERIODS DURING THE YEAR. THE FIRST PERIOD IS IN THE SPRING, MARCH TO MAY. THE SECOND PERIOD IS IN LATE SUMMER TO EARLY FALL, AUGUST TO SEPTEMBER.
- SEED SHOULD BE DRILL-SEEDED, WHENEVER POSSIBLE.
- BROADCAST SEEDING OR HYDRO-SEEDED MAY BE SUBSTITUTED ON SLOPES STEEPER THAN 3:1 OR ON OTHER AREAS NOT PRACTICAL TO DRILL SEED.
- SEEDING RATES SHOULD BE DOUBLED FOR BROADCAST SEEDING OR INCREASED BY 50% IF USING A BRILLION DRILL OR HYDRO-SEEDED.
- BROADCAST SEED SHOULD BE LIGHTLY HAND-RAKED INTO THE SOIL.
- SEED DEPTH SHOULD BE 3/8 TO 1/2 INCH FOR MOST MIXTURES.
- SEEDED AREAS SHOULD BE MULCHED, AND THE MULCH SHOULD BE ADEQUATELY SECURED.
- IF HYDRO-SEEDED IS CONDUCTED, MULCHING SHOULD BE CONDUCTED AS A SEPARATE, SECOND OPERATION.
- CONTAINERIZED NURSERY STOCK SHOULD BE KEPT IN A LIVE AND HEALTHY CONDITION PRIOR TO INSTALLATION.
- CONTAINERIZED TREES AND SHRUBS SHOULD BE INSTALLED ACCORDING TO THE PLANTING DETAILS PROVIDED IN THE COLORADO SPRINGS LANDSCAPE CODE AND POLICY MANUAL, UNIT FOUR, APPENDICES FOR TREE AND SHRUB PLANTING DETAILS.
- LIVE STAKES, POLES AND WILLOW BUNDLES SHOULD BE INSTALLED WHEN DORMANT (LATE WINTER AND EARLY SPRING).
- IF BEAVER ARE KNOWN TO BE IN THE AREA, BEAVER PROTECTION SHOULD BE PROVIDED FOR TREES AND SHRUBS.

**ALLOWABLE PLANT VARIETIES (SEE DRAINAGE CRITERIA MANUAL, VOLUME 1, CHAPTER 14, TABLE 14-5)**

- SPECIES**
- WESTERN WHEATGRASS (PASCOPYRUM SMITHII)
  - SWITCHGRASS (PANICUM VIRGATUM)
  - SLENDER WHEATGRASS (ELYMUS TRACHYCAULUS SSP. TRACHYCAULUS)
  - PUBESCENT WHEATGRASS (TRIGIA INTERMEDIA SSP. TRICHOPHORUM)
  - INDIAN GRASS (ACHNATHERUM HYMENOIDES)
  - BIG BLUESTEM (POA AMPLA)
  - BLUE GRAMA (BOUTELLOUA GRACILIS)
  - SWITCHGRASS (PANICUM VIRGATUM)
  - SIDE-OATS GRAMA (BOUTELLOUA CURTIPENDULA)
  - NEEDLE AND THREAD (HESPEROSTIPA COMATA SSP. COMATA)


\*SEED MIX SHOULD BE APPROVED BY THE COUNTY

**Sediment Control Log (SCL) SC-2**

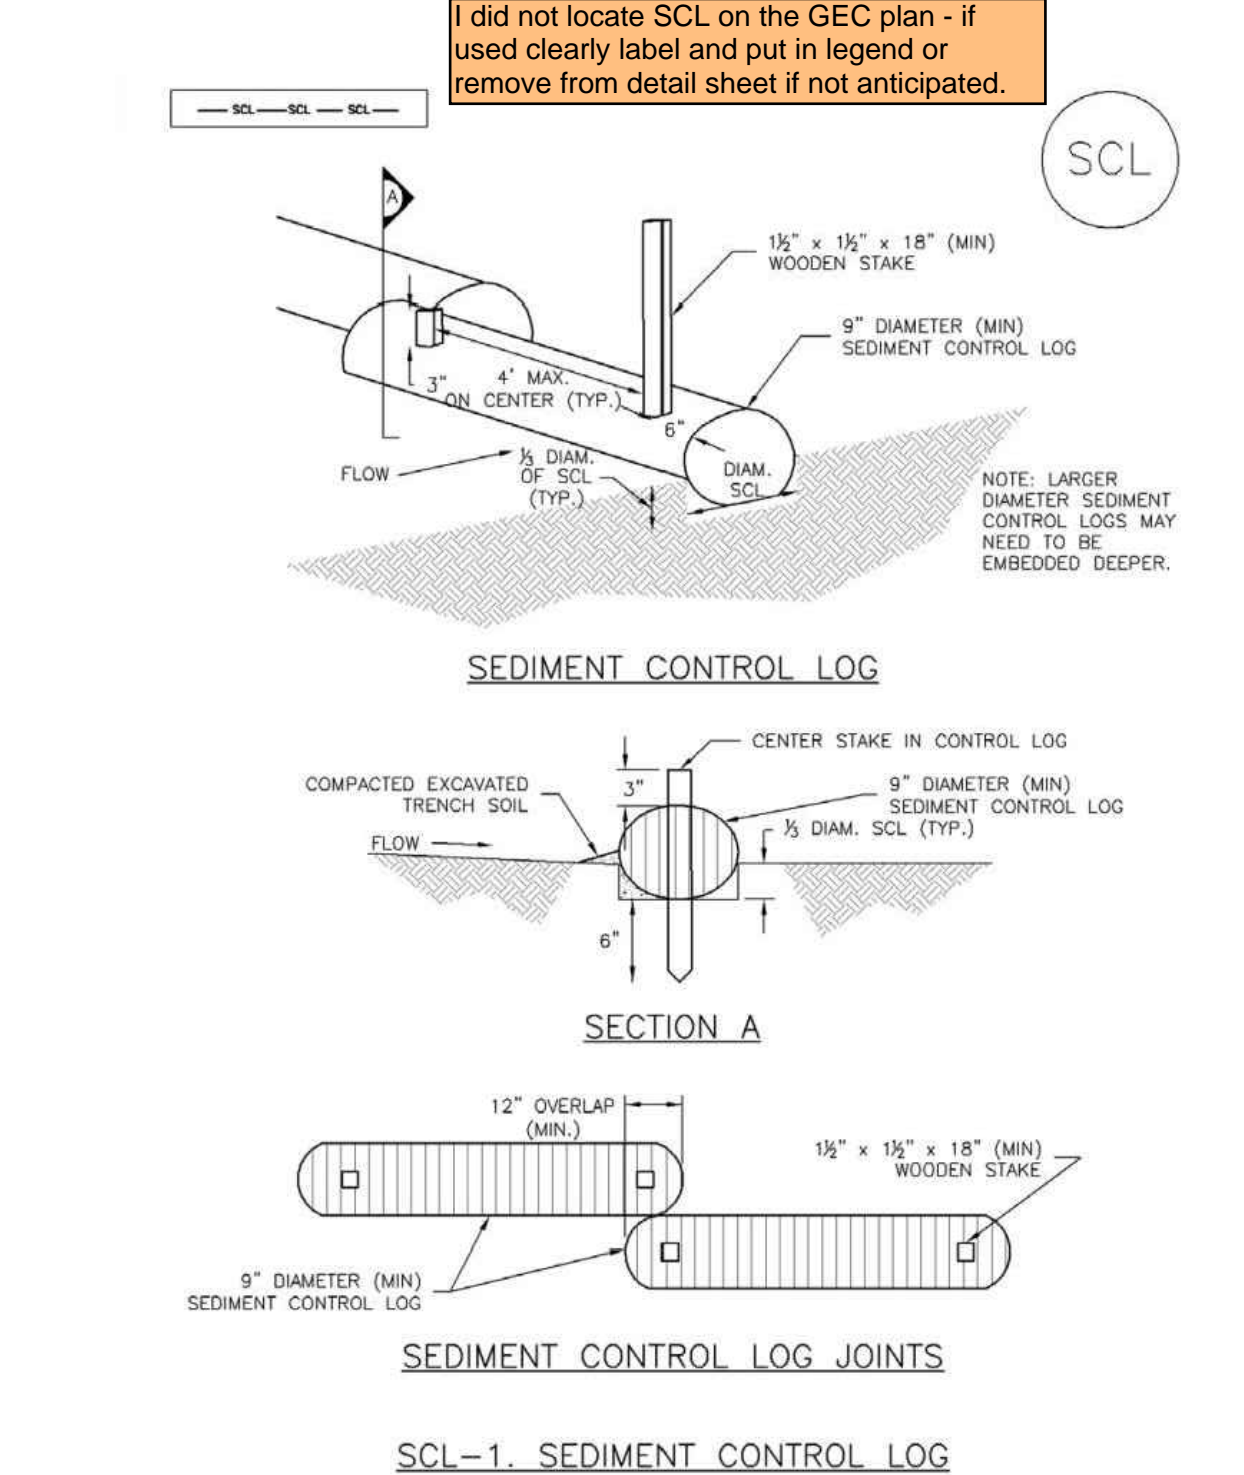

**SCL-1. SEDIMENT CONTROL LOG**

**Sediment Control Log (SCL) SC-2**

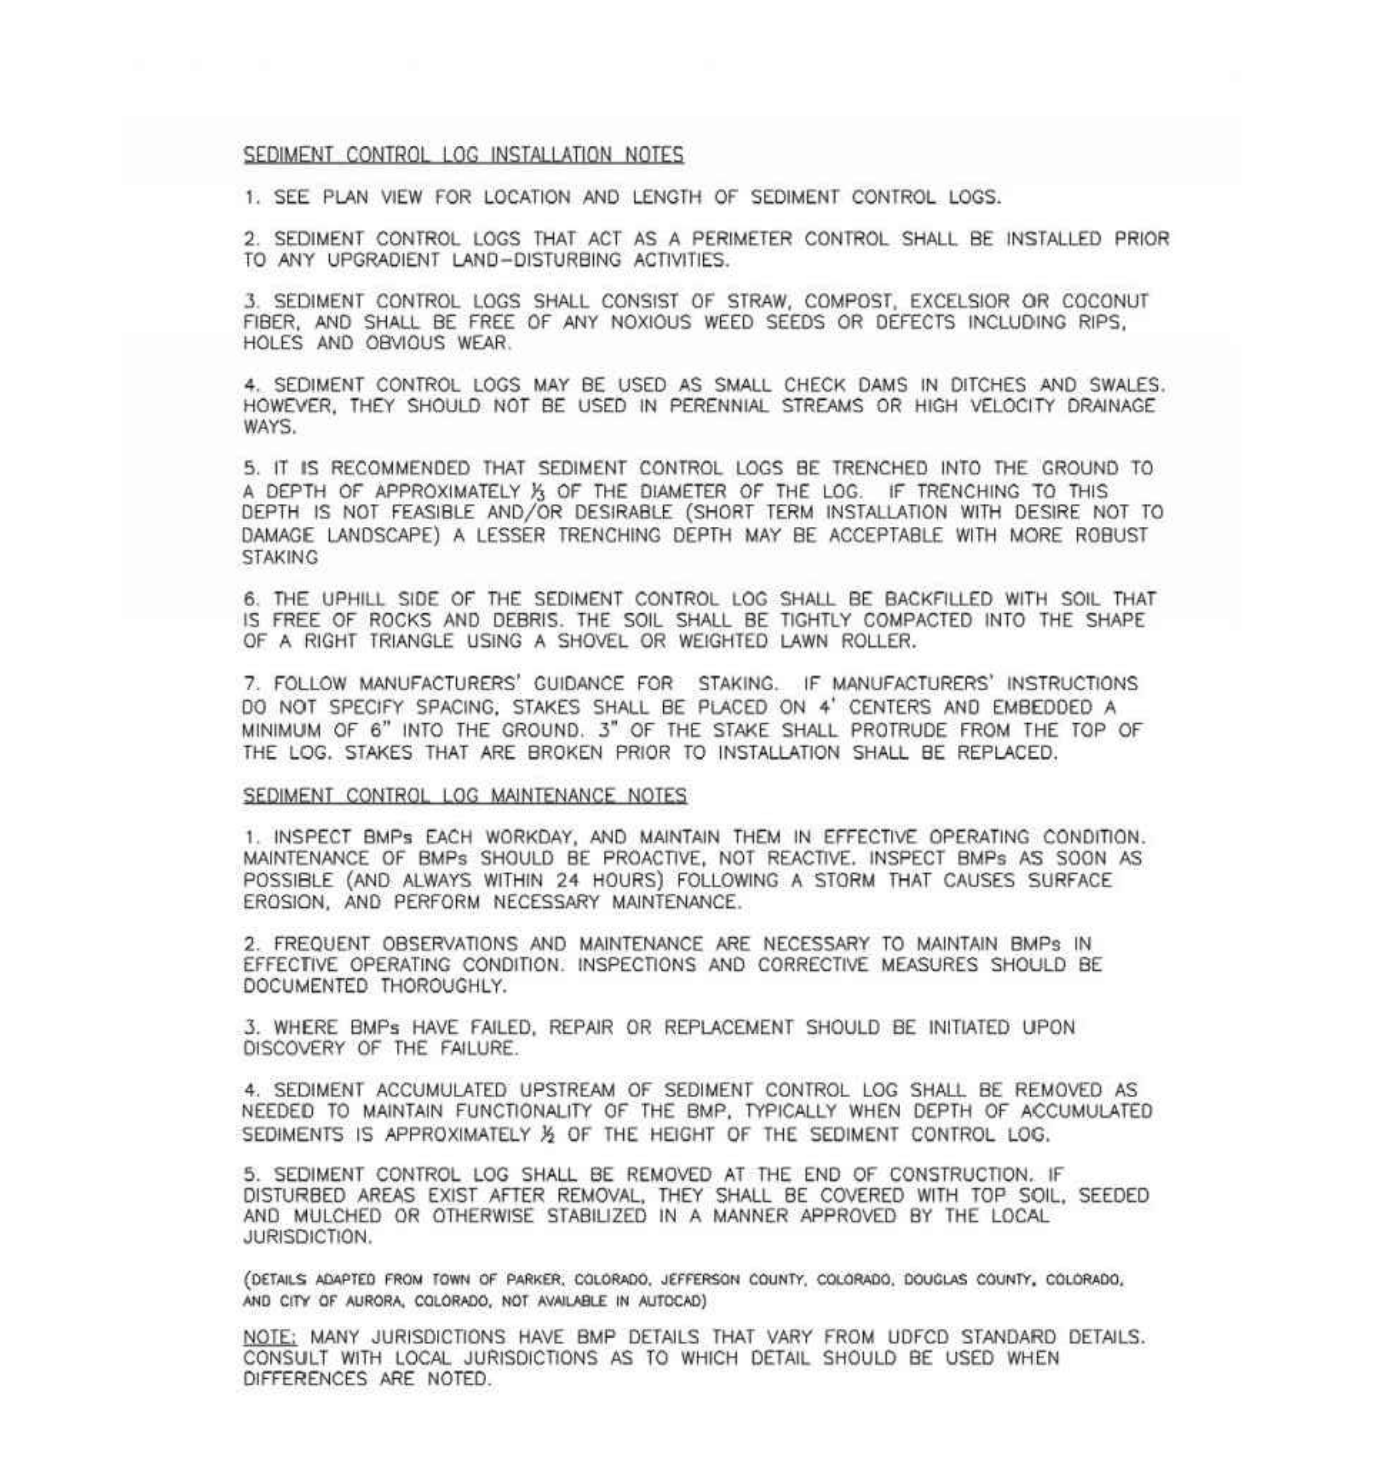

**SCL-1. SEDIMENT CONTROL LOG**

REVISIONS NO. DESCRIPTION DATE

UNTIL SUCH TIME AS THESE DRAWINGS ARE APPROVED BY THE REVIEWING AGENCIES, THE TERRA NOVA ENGINEERING, INC. APPROVES THEIR USE ONLY FOR THE PROJECT AND FOR THE MOST RECENT WRITTEN AUTHORIZATION.

PREPARED FOR: 4-WAY RANCH JOINT VENTURE  
ATTN: PETER MARTZ  
P.O. BOX 50223  
COLORADO SPRINGS, CO 80949  
719-491-3150

Terra Nova Engineering, Inc.  
Civil Engineer  
721 S. ZUBO STREET  
COLORADO SPRINGS, CO 80904  
OFFICE: 719-635-6422  
FAX: 719-635-6426  
www.tnec.com

WATERBURY FILING NO. 1

CONSTRUCTION SET  
GRADING EROSION & STORMWATER CONTROL PLAN  
EROSION CONTROL DETAILS


DESIGNED BY DLF  
DRAWN BY QNA  
CHECKED BY QNA

H-SCALE NA  
V-SCALE N/A

JOB NO. 1715.00  
DATE ISSUED 2/6/23  
SHEET NO. 4 OF 39

Concrete Washout Area (CWA)

MM-1

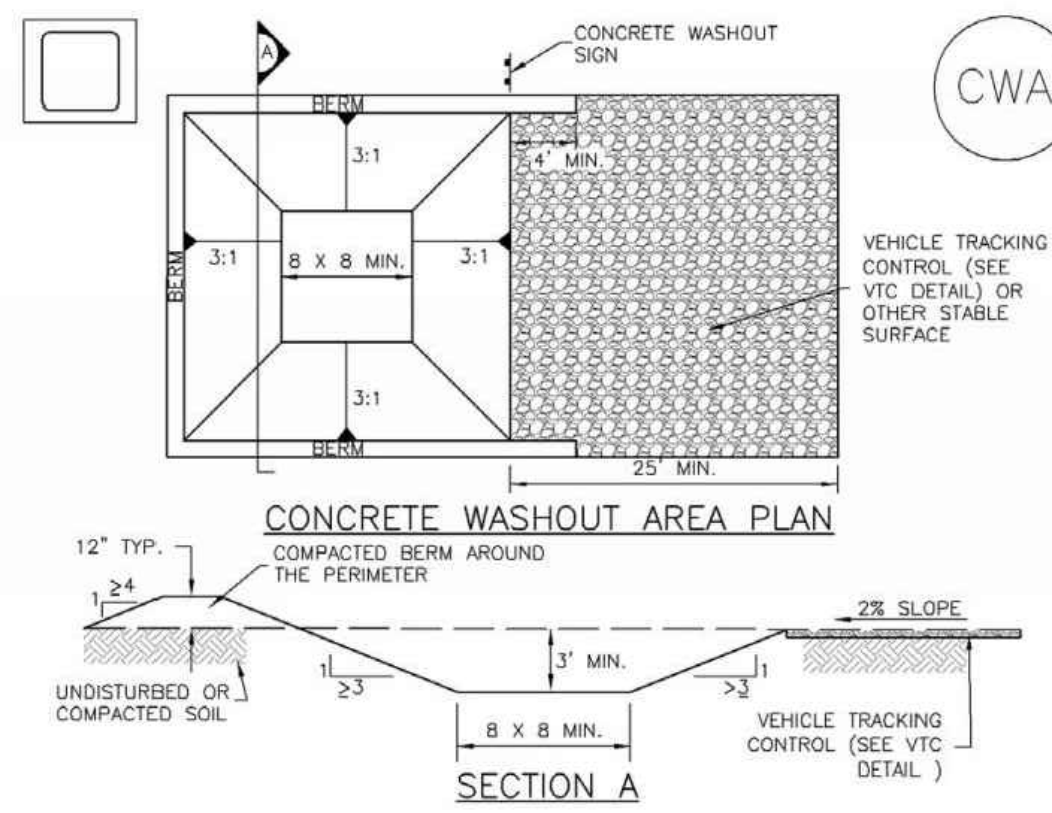

CWA-1. CONCRETE WASHOUT AREA

CWA INSTALLATION NOTES

- SEE PLAN VIEW FOR:
  - CWA INSTALLATION LOCATION.
- DO NOT LOCATE AN UNLINED CWA WITHIN 400' OF ANY NATURAL DRAINAGE PATHWAY OR WATERBODY. DO NOT LOCATE WITHIN 1,000' OF ANY WELLS OR DRINKING WATER SOURCES. IF SITE CONSTRAINTS MAKE THIS INFEASIBLE, OR IF HIGHLY PERMEABLE SOILS EXIST ON SITE, THE CWA MUST BE INSTALLED WITH AN IMPERMEABLE LINER (1/8 MIL MIN. THICKNESS) OR SURFACE STORAGE ALTERNATIVES USING PREFABRICATED CONCRETE WASHOUT DEVICES OR A LINED ABOVE GROUND STORAGE ARE SHOULD BE USED.
- THE CWA SHALL BE INSTALLED PRIOR TO CONCRETE PLACEMENT ON SITE.
- CWA SHALL INCLUDE A FLAT SUBSURFACE PIT THAT IS AT LEAST 8' BY 8' SLOPES LEADING OUT OF THE SUBSURFACE PIT SHALL BE 3:1 OR FLATTER. THE PIT SHALL BE AT LEAST 3' DEEP.
- BERM SURROUNDING SIDES AND BACK OF THE CWA SHALL HAVE MINIMUM HEIGHT OF 1'.
- VEHICLE TRACKING PAD SHALL BE SLOPED 2% TOWARDS THE CWA.
- SIGNS SHALL BE PLACED AT THE CONSTRUCTION ENTRANCE, AT THE CWA, AND ELSEWHERE AS NECESSARY TO CLEARLY INDICATE THE LOCATION OF THE CWA TO OPERATORS OF CONCRETE TRUCKS AND PUMP TRUCKS.
- USE EXCAVATED MATERIAL FOR PERIMETER BERM CONSTRUCTION.

November 2010 Urban Drainage and Flood Control District CWA-3  
Urban Storm Drainage Criteria Manual Volume 3

MM-1

Concrete Washout Area (CWA)


CWA MAINTENANCE NOTES

- INSPECT BMPs EACH WORKDAY, AND MAINTAIN THEM IN EFFECTIVE OPERATING CONDITION. MAINTENANCE OF BMPs SHOULD BE PROACTIVE, NOT REACTIVE. INSPECT BMPs AS SOON AS POSSIBLE (AND ALWAYS WITHIN 24 HOURS) FOLLOWING A STORM THAT CAUSES SURFACE EROSION, AND PERFORM NECESSARY MAINTENANCE.
  - FREQUENT OBSERVATIONS AND MAINTENANCE ARE NECESSARY TO MAINTAIN BMPs IN EFFECTIVE OPERATING CONDITION. INSPECTIONS AND CORRECTIVE MEASURES SHOULD BE DOCUMENTED THOROUGHLY.
  - WHERE BMPs HAVE FAILED, REPAIR OR REPLACEMENT SHOULD BE INITIATED UPON DISCOVERY OF THE FAILURE.
  - THE CWA SHALL BE REPAIRED, CLEANED, OR ENLARGED AS NECESSARY TO MAINTAIN CAPACITY FOR CONCRETE WASTE. CONCRETE MATERIALS, ACCUMULATED IN PIT, SHALL BE REMOVED ONCE THE MATERIALS HAVE REACHED A DEPTH OF 2'.
  - CONCRETE WASHOUT WATER, WASTED PIECES OF CONCRETE AND ALL OTHER DEBRIS IN THE SUBSURFACE PIT SHALL BE TRANSPORTED FROM THE JOB SITE IN A WATER-TIGHT CONTAINER AND DISPOSED OF PROPERLY.
  - THE CWA SHALL REMAIN IN PLACE UNTIL ALL CONCRETE FOR THE PROJECT IS PLACED.
  - WHEN THE CWA IS REMOVED, COVER THE DISTURBED AREA WITH TOP SOIL, SEED AND MULCH OR OTHERWISE STABILIZED IN A MANNER APPROVED BY THE LOCAL JURISDICTION.
- (DETAIL ADAPTED FROM DOUGLAS COUNTY, COLORADO AND THE CITY OF PARKER, COLORADO, NOT AVAILABLE IN AUTOCAD)
- NOTE: MANY JURISDICTIONS HAVE BMP DETAILS THAT VARY FROM UDFCD STANDARD DETAILS. CONSULT WITH LOCAL JURISDICTIONS AS TO WHICH DETAIL SHOULD BE USED WHEN DIFFERENCES ARE NOTED.

CWA-4 Urban Drainage and Flood Control District November 2010  
Urban Storm Drainage Criteria Manual Volume 3

Stockpile Management (SP)

MM-2

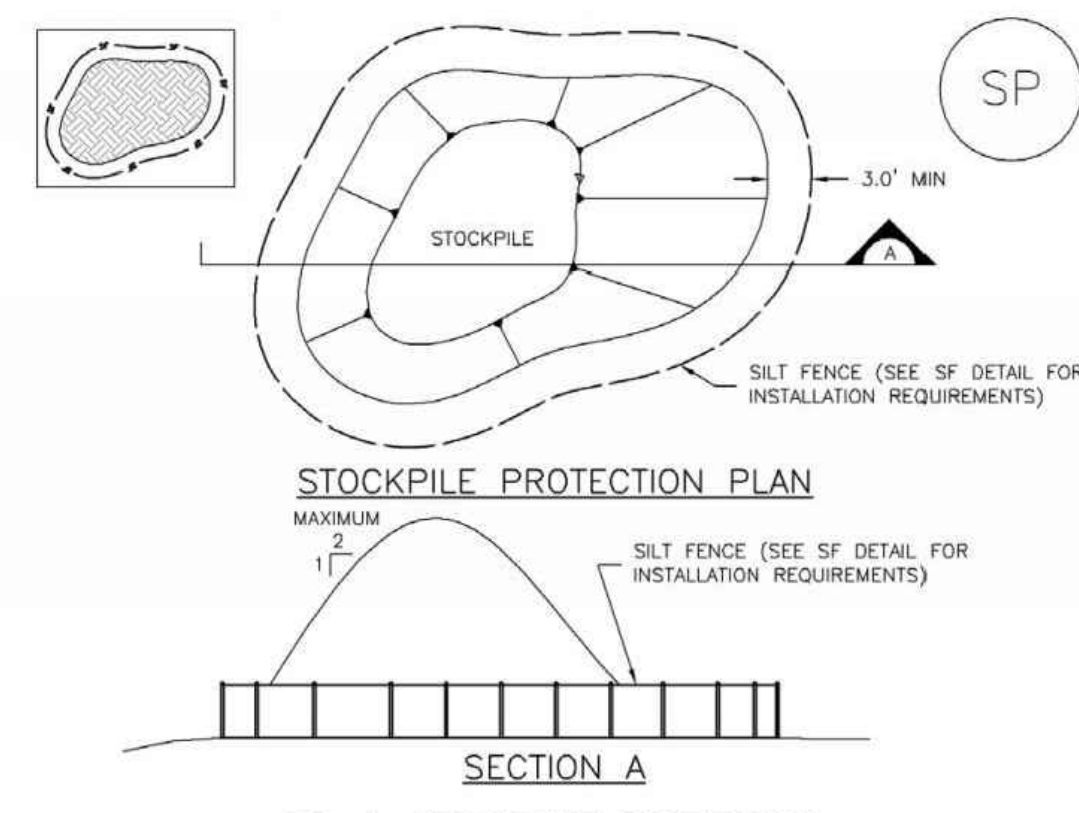

SP-1. STOCKPILE PROTECTION

STOCKPILE PROTECTION INSTALLATION NOTES

- SEE PLAN VIEW FOR:
  - LOCATION OF STOCKPILES.
  - TYPE OF STOCKPILE PROTECTION.
- INSTALL PERIMETER CONTROLS IN ACCORDANCE WITH THEIR RESPECTIVE DESIGN DETAILS. SILT FENCE IS SHOWN IN THE STOCKPILE PROTECTION DETAILS; HOWEVER, OTHER TYPES OF PERIMETER CONTROLS INCLUDING SEDIMENT CONTROL LOGS OR ROCK SOCKS MAY BE SUITABLE IN SOME CIRCUMSTANCES. CONSIDERATIONS FOR DETERMINING THE APPROPRIATE TYPE OF PERIMETER CONTROL FOR A STOCKPILE INCLUDE WHETHER THE STOCKPILE IS LOCATED ON A PERVIOUS OR IMPERVIOUS SURFACE, THE RELATIVE HEIGHTS OF THE PERIMETER CONTROL AND STOCKPILE, THE ABILITY OF THE PERIMETER CONTROL TO CONTAIN THE STOCKPILE WITHOUT FAILING IN THE EVENT THAT MATERIAL FROM THE STOCKPILE SEEDS OR SLUMPS AGAINST THE PERIMETER, AND OTHER FACTORS.
- STABILIZE THE STOCKPILE SURFACE WITH SURFACE ROUGHENING, TEMPORARY SEEDING AND MULCHING, EROSION CONTROL BLANKETS, OR SOIL BINDERS. SOILS STOCKPILED FOR AN EXTENDED PERIOD (TYPICALLY FOR MORE THAN 60 DAYS) SHOULD BE SEED AND MULCHED WITH A TEMPORARY GRASS COVER ONCE THE STOCKPILE IS PLACED (TYPICALLY WITHIN 14 DAYS). USE OF MULCH ONLY OR A SOIL BINDER IS ACCEPTABLE IF THE STOCKPILE WILL BE IN PLACE FOR A MORE LIMITED TIME PERIOD (TYPICALLY 30-60 DAYS).
- FOR TEMPORARY STOCKPILES ON THE INTERIOR PORTION OF A CONSTRUCTION SITE, WHERE OTHER DOWNGRADIENT CONTROLS, INCLUDING PERIMETER CONTROL, ARE IN PLACE, STOCKPILE PERIMETER CONTROLS MAY NOT BE REQUIRED.

November 2010 Urban Drainage and Flood Control District SP-3  
Urban Storm Drainage Criteria Manual Volume 3

MM-2

Stockpile Management (SM)


STOCKPILE PROTECTION MAINTENANCE NOTES

- INSPECT BMPs EACH WORKDAY, AND MAINTAIN THEM IN EFFECTIVE OPERATING CONDITION. MAINTENANCE OF BMPs SHOULD BE PROACTIVE, NOT REACTIVE. INSPECT BMPs AS SOON AS POSSIBLE (AND ALWAYS WITHIN 24 HOURS) FOLLOWING A STORM THAT CAUSES SURFACE EROSION, AND PERFORM NECESSARY MAINTENANCE.
  - FREQUENT OBSERVATIONS AND MAINTENANCE ARE NECESSARY TO MAINTAIN BMPs IN EFFECTIVE OPERATING CONDITION. INSPECTIONS AND CORRECTIVE MEASURES SHOULD BE DOCUMENTED THOROUGHLY.
  - WHERE BMPs HAVE FAILED, REPAIR OR REPLACEMENT SHOULD BE INITIATED UPON DISCOVERY OF THE FAILURE.
  - IF PERIMETER PROTECTION MUST BE MOVED TO ACCESS SOIL STOCKPILE, REPLACE PERIMETER CONTROLS BY THE END OF THE WORKDAY.
  - STOCKPILE PERIMETER CONTROLS CAN BE REMOVED ONCE ALL THE MATERIAL FROM THE STOCKPILE HAS BEEN USED.
- (DETAILS ADAPTED FROM PARKER, COLORADO, NOT AVAILABLE IN AUTOCAD)
- NOTE: MANY JURISDICTIONS HAVE BMP DETAILS THAT VARY FROM UDFCD STANDARD DETAILS. CONSULT WITH LOCAL JURISDICTIONS AS TO WHICH DETAIL SHOULD BE USED WHEN DIFFERENCES ARE NOTED.


SP-4 Urban Drainage and Flood Control District November 2010  
Urban Storm Drainage Criteria Manual Volume 3

Silt Fence (SF)

SC-1

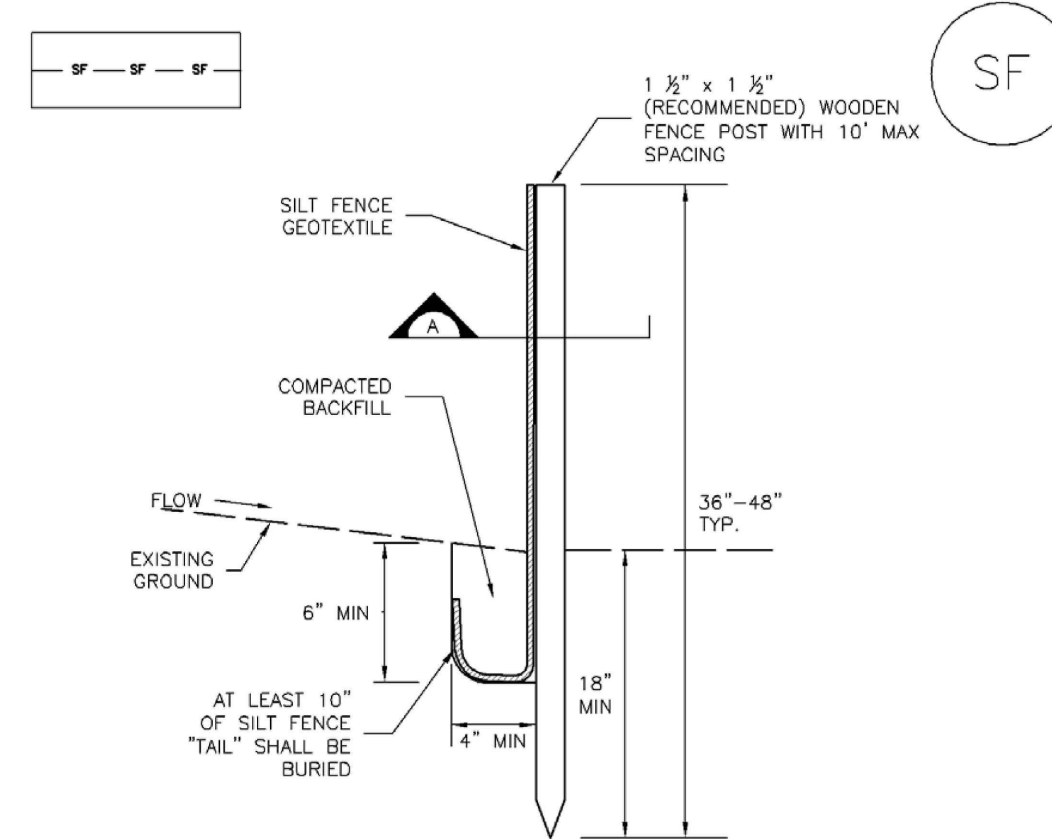

SILT FENCE

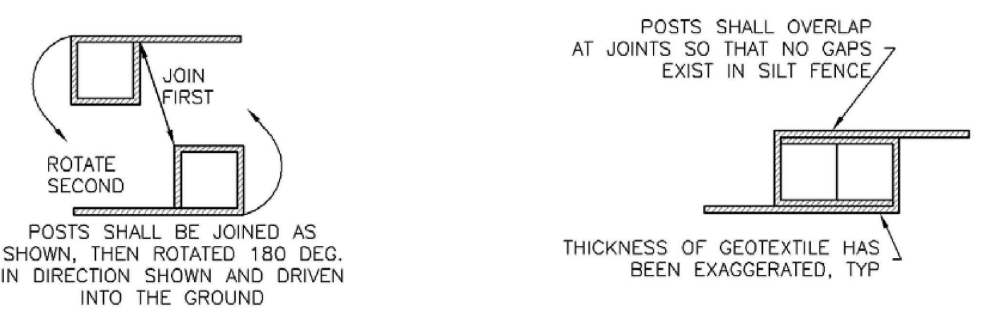

SECTION A

SF-1. SILT FENCE

November 2010 Urban Drainage and Flood Control District SF-3  
Urban Storm Drainage Criteria Manual Volume 3

SC-1

Silt Fence (SF)

SILT FENCE INSTALLATION NOTES

- SILT FENCE MUST BE PLACED AWAY FROM THE TOE OF THE SLOPE TO ALLOW FOR WATER PONDING. SILT FENCE AT THE TOE OF A SLOPE SHOULD BE INSTALLED IN A FLAT LOCATION AT LEAST SEVERAL FEET (2-5 FT) FROM THE TOE OF THE SLOPE TO ALLOW ROOM FOR PONDING AND DEPOSITION.
- A UNIFORM 6" X 4" ANCHOR TRENCH SHALL BE EXCAVATED USING TRENCHER OR SILT FENCE INSTALLATION DEVICE. NO ROAD GRADERS, BACKHOES, OR SIMILAR EQUIPMENT SHALL BE USED.
- COMPACT ANCHOR TRENCH BY HAND WITH A "JUMPING JACK" OR BY WHEEL ROLLING. COMPACTION SHALL BE SUCH THAT SILT FENCE RESISTS BEING PULLED OUT OF ANCHOR TRENCH BY HAND.
- SILT FENCE SHALL BE PULLED TIGHT AS IT IS ANCHORED TO THE STAKES. THERE SHOULD BE NO NOTICEABLE SAG BETWEEN STAKES AFTER IT HAS BEEN ANCHORED TO THE STAKES.
- SILT FENCE FABRIC SHALL BE ANCHORED TO THE STAKES USING 1" HEAVY DUTY STAPLES OR NAILS WITH 1" HEADS. STAPLES AND NAILS SHOULD BE PLACED 3" ALONG THE FABRIC DOWN THE STAKE.
- AT THE END OF A RUN OF SILT FENCE ALONG A CONTOUR, THE SILT FENCE SHOULD BE TURNED PERPENDICULAR TO THE CONTOUR TO CREATE A "J-HOOK." THE "J-HOOK" EXTENDING PERPENDICULAR TO THE CONTOUR SHOULD BE OF SUFFICIENT LENGTH TO KEEP RUNOFF FROM FLOWING AROUND THE END OF THE SILT FENCE (TYPICALLY 10' - 20').
- SILT FENCE SHALL BE INSTALLED PRIOR TO ANY LAND DISTURBING ACTIVITIES.


SILT FENCE MAINTENANCE NOTES

- INSPECT BMPs EACH WORKDAY, AND MAINTAIN THEM IN EFFECTIVE OPERATING CONDITION. MAINTENANCE OF BMPs SHOULD BE PROACTIVE, NOT REACTIVE. INSPECT BMPs AS SOON AS POSSIBLE (AND ALWAYS WITHIN 24 HOURS) FOLLOWING A STORM THAT CAUSES SURFACE EROSION, AND PERFORM NECESSARY MAINTENANCE.
  - FREQUENT OBSERVATIONS AND MAINTENANCE ARE NECESSARY TO MAINTAIN BMPs IN EFFECTIVE OPERATING CONDITION. INSPECTIONS AND CORRECTIVE MEASURES SHOULD BE DOCUMENTED THOROUGHLY.
  - WHERE BMPs HAVE FAILED, REPAIR OR REPLACEMENT SHOULD BE INITIATED UPON DISCOVERY OF THE FAILURE.
  - SEDIMENT ACCUMULATED UPSTREAM OF THE SILT FENCE SHALL BE REMOVED AS NEEDED TO MAINTAIN THE FUNCTIONALITY OF THE BMP, TYPICALLY WHEN DEPTH OF ACCUMULATED SEDIMENTS IS APPROXIMATELY 6".
  - REPAIR OR REPLACE SILT FENCE WHEN THERE ARE SIGNS OF WEAR, SUCH AS SAGGING, TEARING, OR COLLAPSE.
  - SILT FENCE IS TO REMAIN IN PLACE UNTIL THE UPSTREAM DISTURBED AREA IS STABILIZED AND APPROVED BY THE LOCAL JURISDICTION, OR IS REPLACED BY AN EQUIVALENT PERIMETER SEDIMENT CONTROL BMP.
  - WHEN SILT FENCE IS REMOVED, ALL DISTURBED AREAS SHALL BE COVERED WITH TOPSOIL, SEED AND MULCH OR OTHERWISE STABILIZED AS APPROVED BY LOCAL JURISDICTION.
- (DETAIL ADAPTED FROM TOWN OF PARKER, COLORADO AND CITY OF AURORA, NOT AVAILABLE IN AUTOCAD)
- NOTE: MANY JURISDICTIONS HAVE BMP DETAILS THAT VARY FROM UDFCD STANDARD DETAILS. CONSULT WITH LOCAL JURISDICTIONS AS TO WHICH DETAIL SHOULD BE USED WHEN DIFFERENCES ARE NOTED.


SF-4 Urban Drainage and Flood Control District November 2010  
Urban Storm Drainage Criteria Manual Volume 3

SC-3


Straw Bale Barrier (SBB)

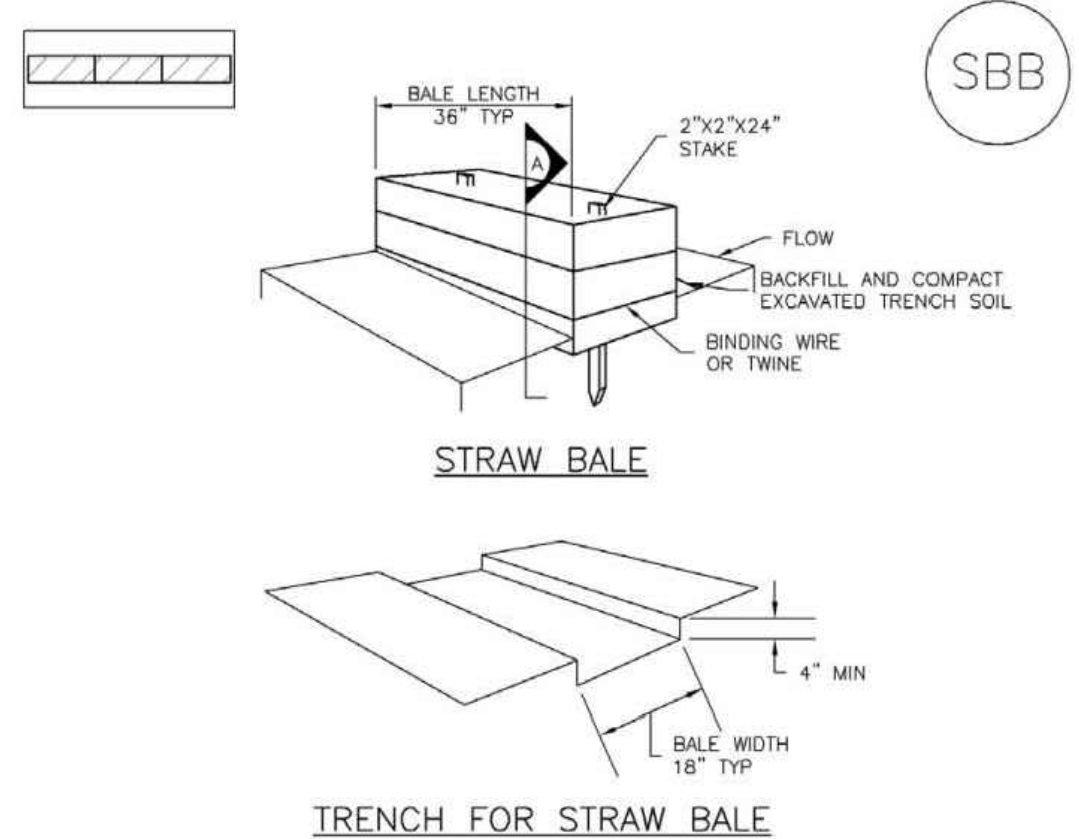

STRAW BALE

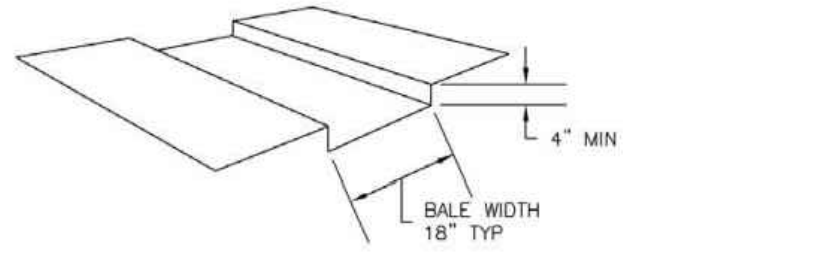

TRENCH FOR STRAW BALE

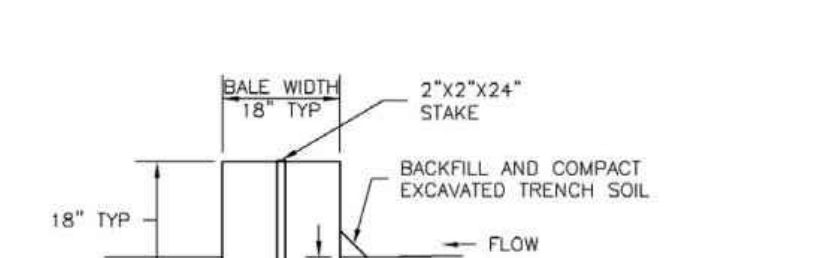

SECTION A

SBB-1. STRAW BALE

SBB-2 Urban Drainage and Flood Control District November 2010  
Urban Storm Drainage Criteria Manual Volume 3

Straw Bale Barrier (SBB)

SC-3

STRAW BALE INSTALLATION NOTES

- SEE PLAN VIEW FOR:
  - LOCATION(S) OF STRAW BALES.
- STRAW BALES SHALL CONSIST OF CERTIFIED WEED FREE STRAW OR HAY. LOCAL JURISDICTIONS MAY REQUIRE PROOF THAT BALES ARE WEED FREE.
- STRAW BALES SHALL CONSIST OF APPROXIMATELY 5 CUBIC FEET OF STRAW OR HAY AND WEIGH NOT LESS THAN 35 POUNDS.
- WHEN STRAW BALES ARE USED IN SERIES AS A BARRIER, THE END OF EACH BALE SHALL BE TIGHTLY ABUTTING ONE ANOTHER.
- STRAW BALE DIMENSIONS SHALL BE APPROXIMATELY 36"x18"x18".
- A UNIFORM ANCHOR TRENCH SHALL BE EXCAVATED TO A DEPTH OF 4". STRAW BALES SHALL BE PLACED SO THAT BINDING TWINE IS ENCOMPASSING THE VERTICAL SIDES OF THE BALES(S). ALL EXCAVATED SOIL SHALL BE PLACED ON THE UPHILL SIDE OF THE STRAW BALE(S) AND COMPACTED.
- TWO (2) WOODEN STAKES SHALL BE USED TO HOLD EACH BALE IN PLACE. WOODEN STAKES SHALL BE 2"x2"x24". WOODEN STAKES SHALL BE DRIVEN 6" INTO THE GROUND.

STRAW BALE MAINTENANCE NOTES

- INSPECT BMPs EACH WORKDAY, AND MAINTAIN THEM IN EFFECTIVE OPERATING CONDITION. MAINTENANCE OF BMPs SHOULD BE PROACTIVE, NOT REACTIVE. INSPECT BMPs AS SOON AS POSSIBLE (AND ALWAYS WITHIN 24 HOURS) FOLLOWING A STORM THAT CAUSES SURFACE EROSION, AND PERFORM NECESSARY MAINTENANCE.
  - FREQUENT OBSERVATIONS AND MAINTENANCE ARE NECESSARY TO MAINTAIN BMPs IN EFFECTIVE OPERATING CONDITION. INSPECTIONS AND CORRECTIVE MEASURES SHOULD BE DOCUMENTED THOROUGHLY.
  - WHERE BMPs HAVE FAILED, REPAIR OR REPLACEMENT SHOULD BE INITIATED UPON DISCOVERY OF THE FAILURE.
  - STRAW BALES SHALL BE REPLACED IF THEY BECOME HEAVILY SOILED, ROTTEN, OR DAMAGED BEYOND REPAIR.
  - SEDIMENT ACCUMULATED UPSTREAM OF STRAW BALE BARRIER SHALL BE REMOVED AS NEEDED TO MAINTAIN FUNCTIONALITY OF THE BMP, TYPICALLY WHEN DEPTH OF ACCUMULATED SEDIMENTS IS APPROXIMATELY 6" OF THE HEIGHT OF THE STRAW BALE BARRIER.
  - STRAW BALES ARE TO REMAIN IN PLACE UNTIL THE UPSTREAM DISTURBED AREA IS STABILIZED AND APPROVED BY THE LOCAL JURISDICTION.
  - WHEN STRAW BALES ARE REMOVED, ALL DISTURBED AREAS SHALL BE COVERED WITH TOPSOIL, SEED AND MULCH OR OTHERWISE STABILIZED AS APPROVED BY LOCAL JURISDICTION.
- (DETAILS ADAPTED FROM TOWN OF PARKER, COLORADO, NOT AVAILABLE IN AUTOCAD)
- NOTE: MANY JURISDICTIONS HAVE BMP DETAILS THAT VARY FROM UDFCD STANDARD DETAILS. CONSULT WITH LOCAL JURISDICTIONS AS TO WHICH DETAIL SHOULD BE USED WHEN DIFFERENCES ARE NOTED.

November 2010 Urban Drainage and Flood Control District SBB-3  
Urban Storm Drainage Criteria Manual Volume 3

REVISIONS	NO.	DESCRIPTION	DATE
UNTIL SUCH TIME AS THESE DRAWINGS ARE APPROVED BY TERRA NOVA ENGINEERING, INC. APPROVES THEIR USE ONLY FOR THE PROJECT AND FOR THE MOST PART BY WRITTEN AUTHORIZATION.			

PREPARED FOR:  
4-WAY RANCH JOINT VENTURE  
ATTN: PETER MARTZ  
P.O. BOX 50223  
COLORADO SPRINGS, CO 80949  
719-491-3150

**Terra Nova**  
Engineering, Inc.  
Civil/Environmental Engineers

721 S. ZARD STREET  
COLORADO SPRINGS, CO 80904  
OFFICE: 719-635-6422  
FAX: 719-635-6426  
www.terrainsc.com


WATERBURY FILING NO. 1

CONSTRUCTION SET  
GRADING AND EROSION CONTROL PLAN  
EROSION CONTROL DETAILS


DESIGNED BY DLF
DRAWN BY QNA
CHECKED BY QNA
H-SCALE NA
V-SCALE N/A
JOB NO. 1715.00
DATE ISSUED 2/6/23
SHEET NO. 5 OF 39

Dewatering Operations (DW)


SM-9

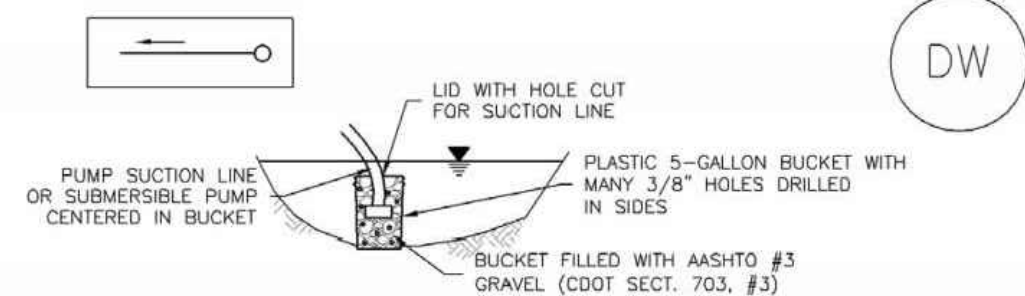

DW-1. DEWATERING POND ALREADY FILLED WITH WATER

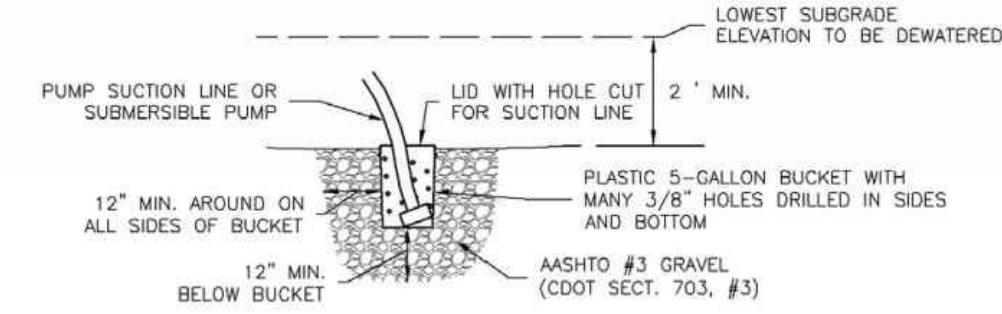


DW-2. DEWATERING SUMP FOR SUBMERSED PUMP

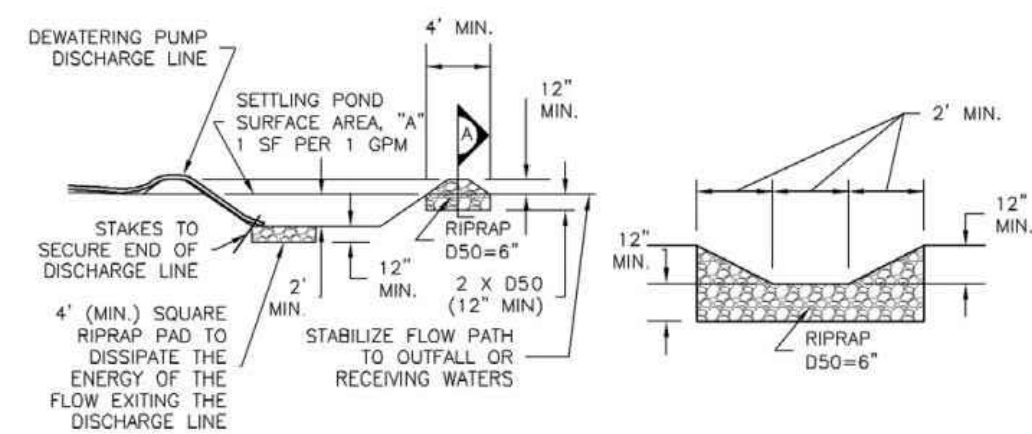

DW-3. SUMP DISCHARGE SETTLING BASIN SECTION A

November 2010 Urban Drainage and Flood Control District Urban Storm Drainage Criteria Manual Volume 3 DW-3

SM-9 Dewatering Operations (DW)

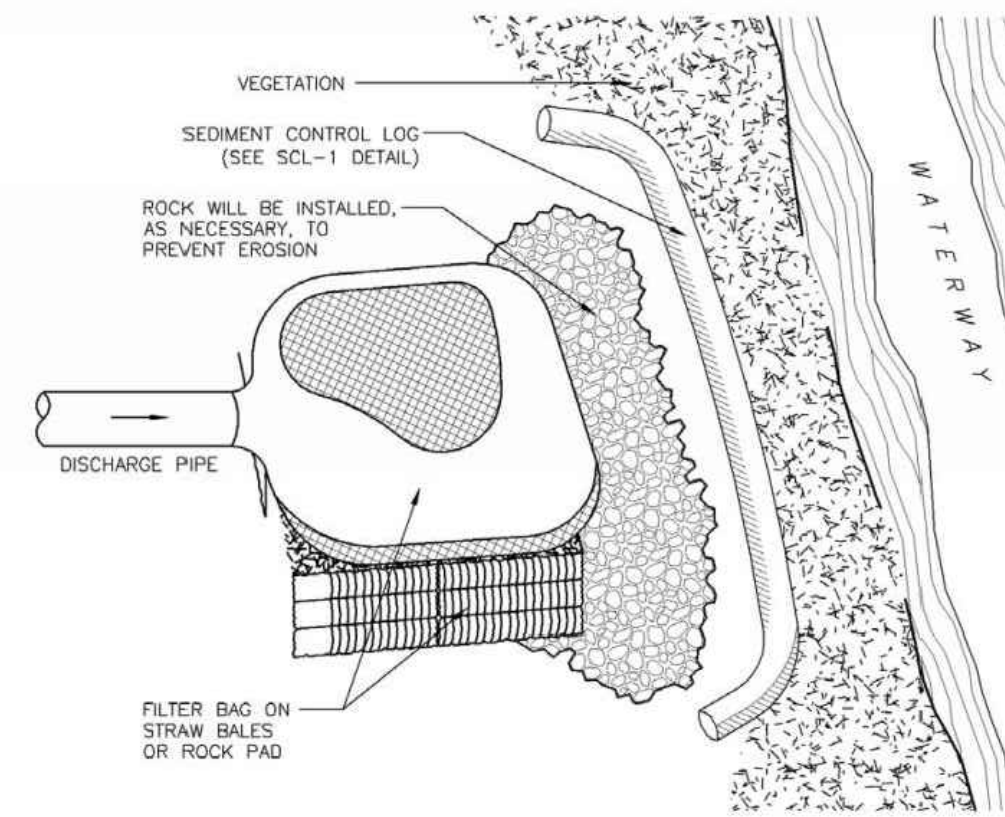

DW-4. DEWATERING FILTER BAG

- DEWATERING INSTALLATION NOTES
- SEE PLAN VIEW FOR:
    - LOCATION OF DEWATERING EQUIPMENT.
    - TYPE OF DEWATERING OPERATION (DW-1 TO DW-4).
  - THE OWNER OR CONTRACTOR SHALL OBTAIN A CONSTRUCTION DISCHARGE (DEWATERING) PERMIT FROM THE STATE PRIOR TO ANY DEWATERING OPERATIONS DISCHARGING FROM THE SITE. ALL DEWATERING SHALL BE IN ACCORDANCE WITH THE REQUIREMENTS OF THE PERMIT.
  - THE OWNER OR OPERATOR SHALL PROVIDE, OPERATE, AND MAINTAIN DEWATERING SYSTEMS OF SUFFICIENT SIZE AND CAPACITY TO PERMIT EXCAVATION AND SUBSEQUENT CONSTRUCTION IN DRY CONDITIONS AND TO LOWER AND MAINTAIN THE GROUNDWATER LEVEL A MINIMUM OF 2- FEET BELOW THE LOWEST POINT OF EXCAVATION AND CONTINUOUSLY MAINTAIN EXCAVATIONS FREE OF WATER UNTIL BACK-FILLED TO FINAL GRADE.

DW-4 Urban Drainage and Flood Control District Urban Storm Drainage Criteria Manual Volume 3 November 2010

Dewatering Operations (DW)

SM-9

- DEWATERING INSTALLATION NOTES
- DEWATERING OPERATIONS SHALL USE ONE OR MORE OF THE DEWATERING SUMPS SHOWN ABOVE, WELL POINTS, OR OTHER MEANS APPROVED BY THE LOCAL JURISDICTION TO REDUCE THE PUMPING OF SEDIMENT, AND SHALL PROVIDE A TEMPORARY SEDIMENT BASIN OR FILTRATION BMP TO REDUCE SEDIMENT TO ALLOWABLE LEVELS PRIOR TO RELEASE OFF SITE OR TO A RECEIVING WATER. A SEDIMENT BASIN MAY BE USED IN LIEU OF SUMP DISCHARGE SETTLING BASIN SHOWN ABOVE IF A 4-FOOT-SQUARE RIPRAP PAD IS PLACED AT THE DISCHARGE POINT AND THE DISCHARGE END OF THE LINE IS STAKED IN PLACE TO PREVENT MOVEMENT OF THE LINE.
- DEWATERING MAINTENANCE NOTES
- INSPECT BMPs EACH WORKDAY, AND MAINTAIN THEM IN EFFECTIVE OPERATING CONDITION. MAINTENANCE OF BMPs SHOULD BE PROACTIVE, NOT REACTIVE. INSPECT BMPs AS SOON AS POSSIBLE (AND ALWAYS WITHIN 24 HOURS) FOLLOWING A STORM THAT CAUSES SURFACE EROSION, AND PERFORM NECESSARY MAINTENANCE.
  - FREQUENT OBSERVATIONS AND MAINTENANCE ARE NECESSARY TO MAINTAIN BMPs IN EFFECTIVE OPERATING CONDITION. INSPECTIONS AND CORRECTIVE MEASURES SHOULD BE DOCUMENTED THOROUGHLY.
  - WHERE BMPs HAVE FAILED, REPAIR OR REPLACEMENT SHOULD BE INITIATED UPON DISCOVERY OF THE FAILURE.
  - DEWATERING BMPs ARE REQUIRED IN ADDITION TO ALL OTHER PERMIT REQUIREMENTS.
  - TEMPORARY SETTLING BASINS SHALL BE REMOVED WHEN NO LONGER NEEDED FOR DEWATERING OPERATIONS. ANY DISTURBED AREA SHALL BE COVERED WITH TOPSOIL, SEEDED AND MULCHED OR OTHERWISE STABILIZED IN A MANNER APPROVED BY THE LOCAL JURISDICTION.
- NOTE: MANY JURISDICTIONS HAVE BMP DETAILS THAT VARY FROM UDFCD STANDARD DETAILS. CONSULT WITH LOCAL JURISDICTIONS AS TO WHICH DETAIL SHOULD BE USED WHEN DIFFERENCES ARE NOTED.
- (DETAILS ADAPTED FROM DOUGLAS COUNTY, COLORADO, NOT AVAILABLE IN AUTOCAD)

November 2010 Urban Drainage and Flood Control District Urban Storm Drainage Criteria Manual Volume 3 DW-5




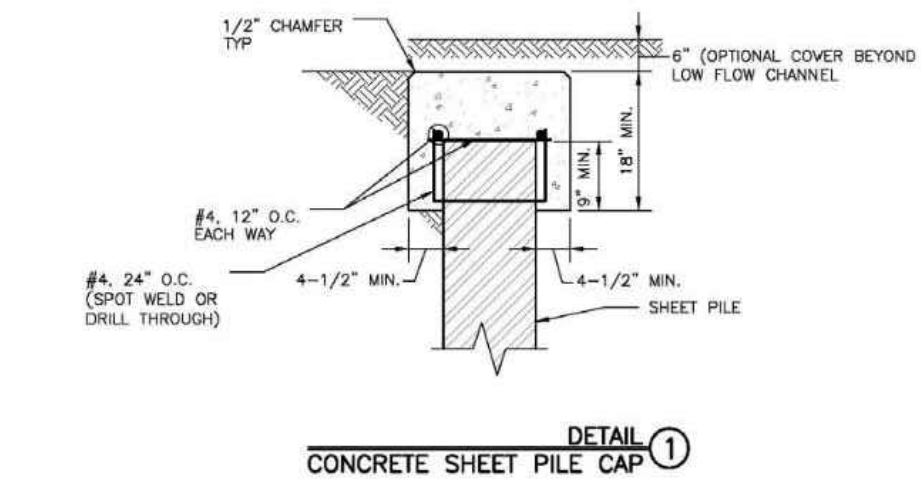


Figure 9-28. Check structure details (Part 3 of 3)

September 2017 Urban Drainage and Flood Control District Urban Storm Drainage Criteria Manual Volume 2 9-57

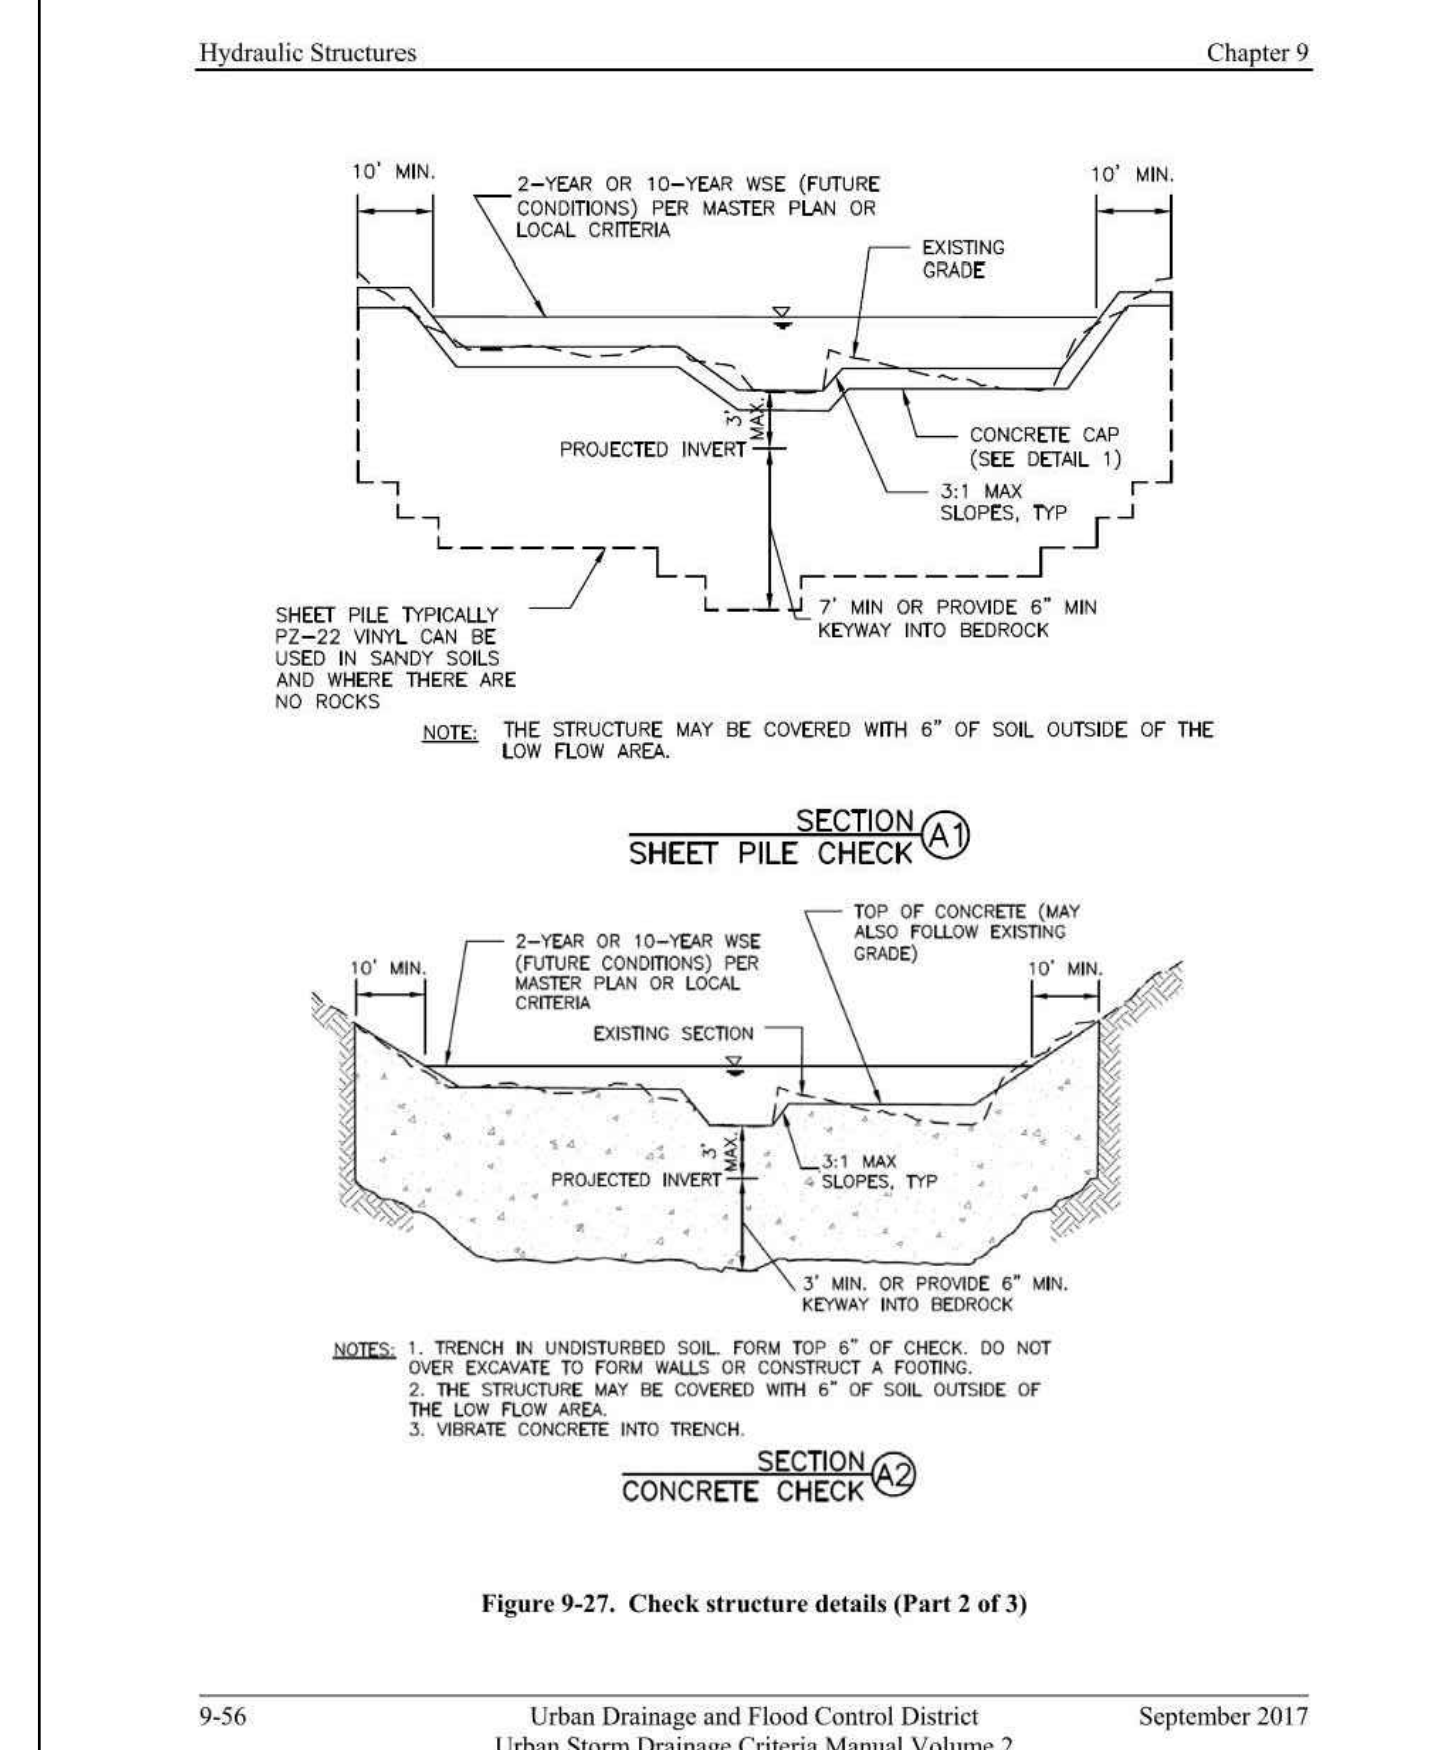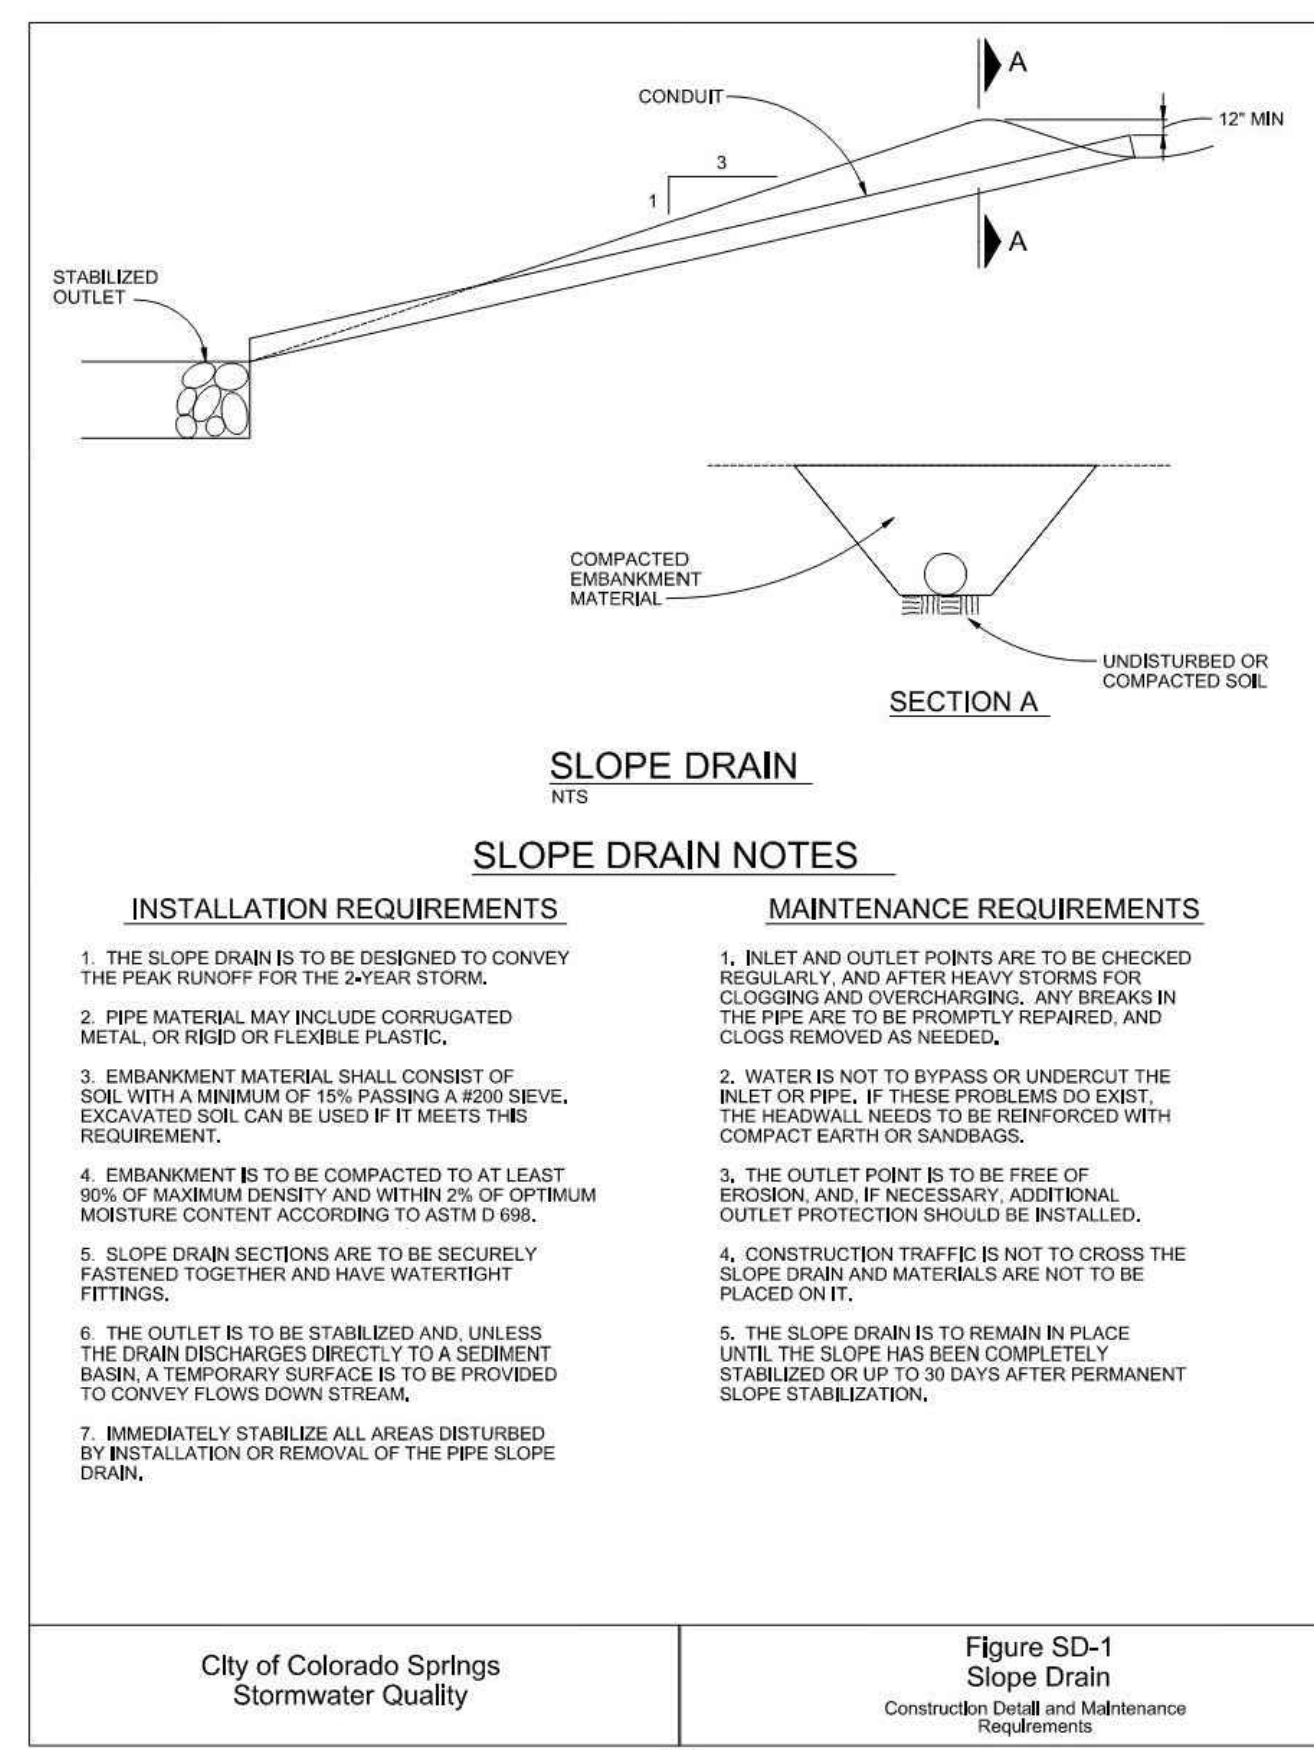

Add details for the construction fence and culvert inlet protection.

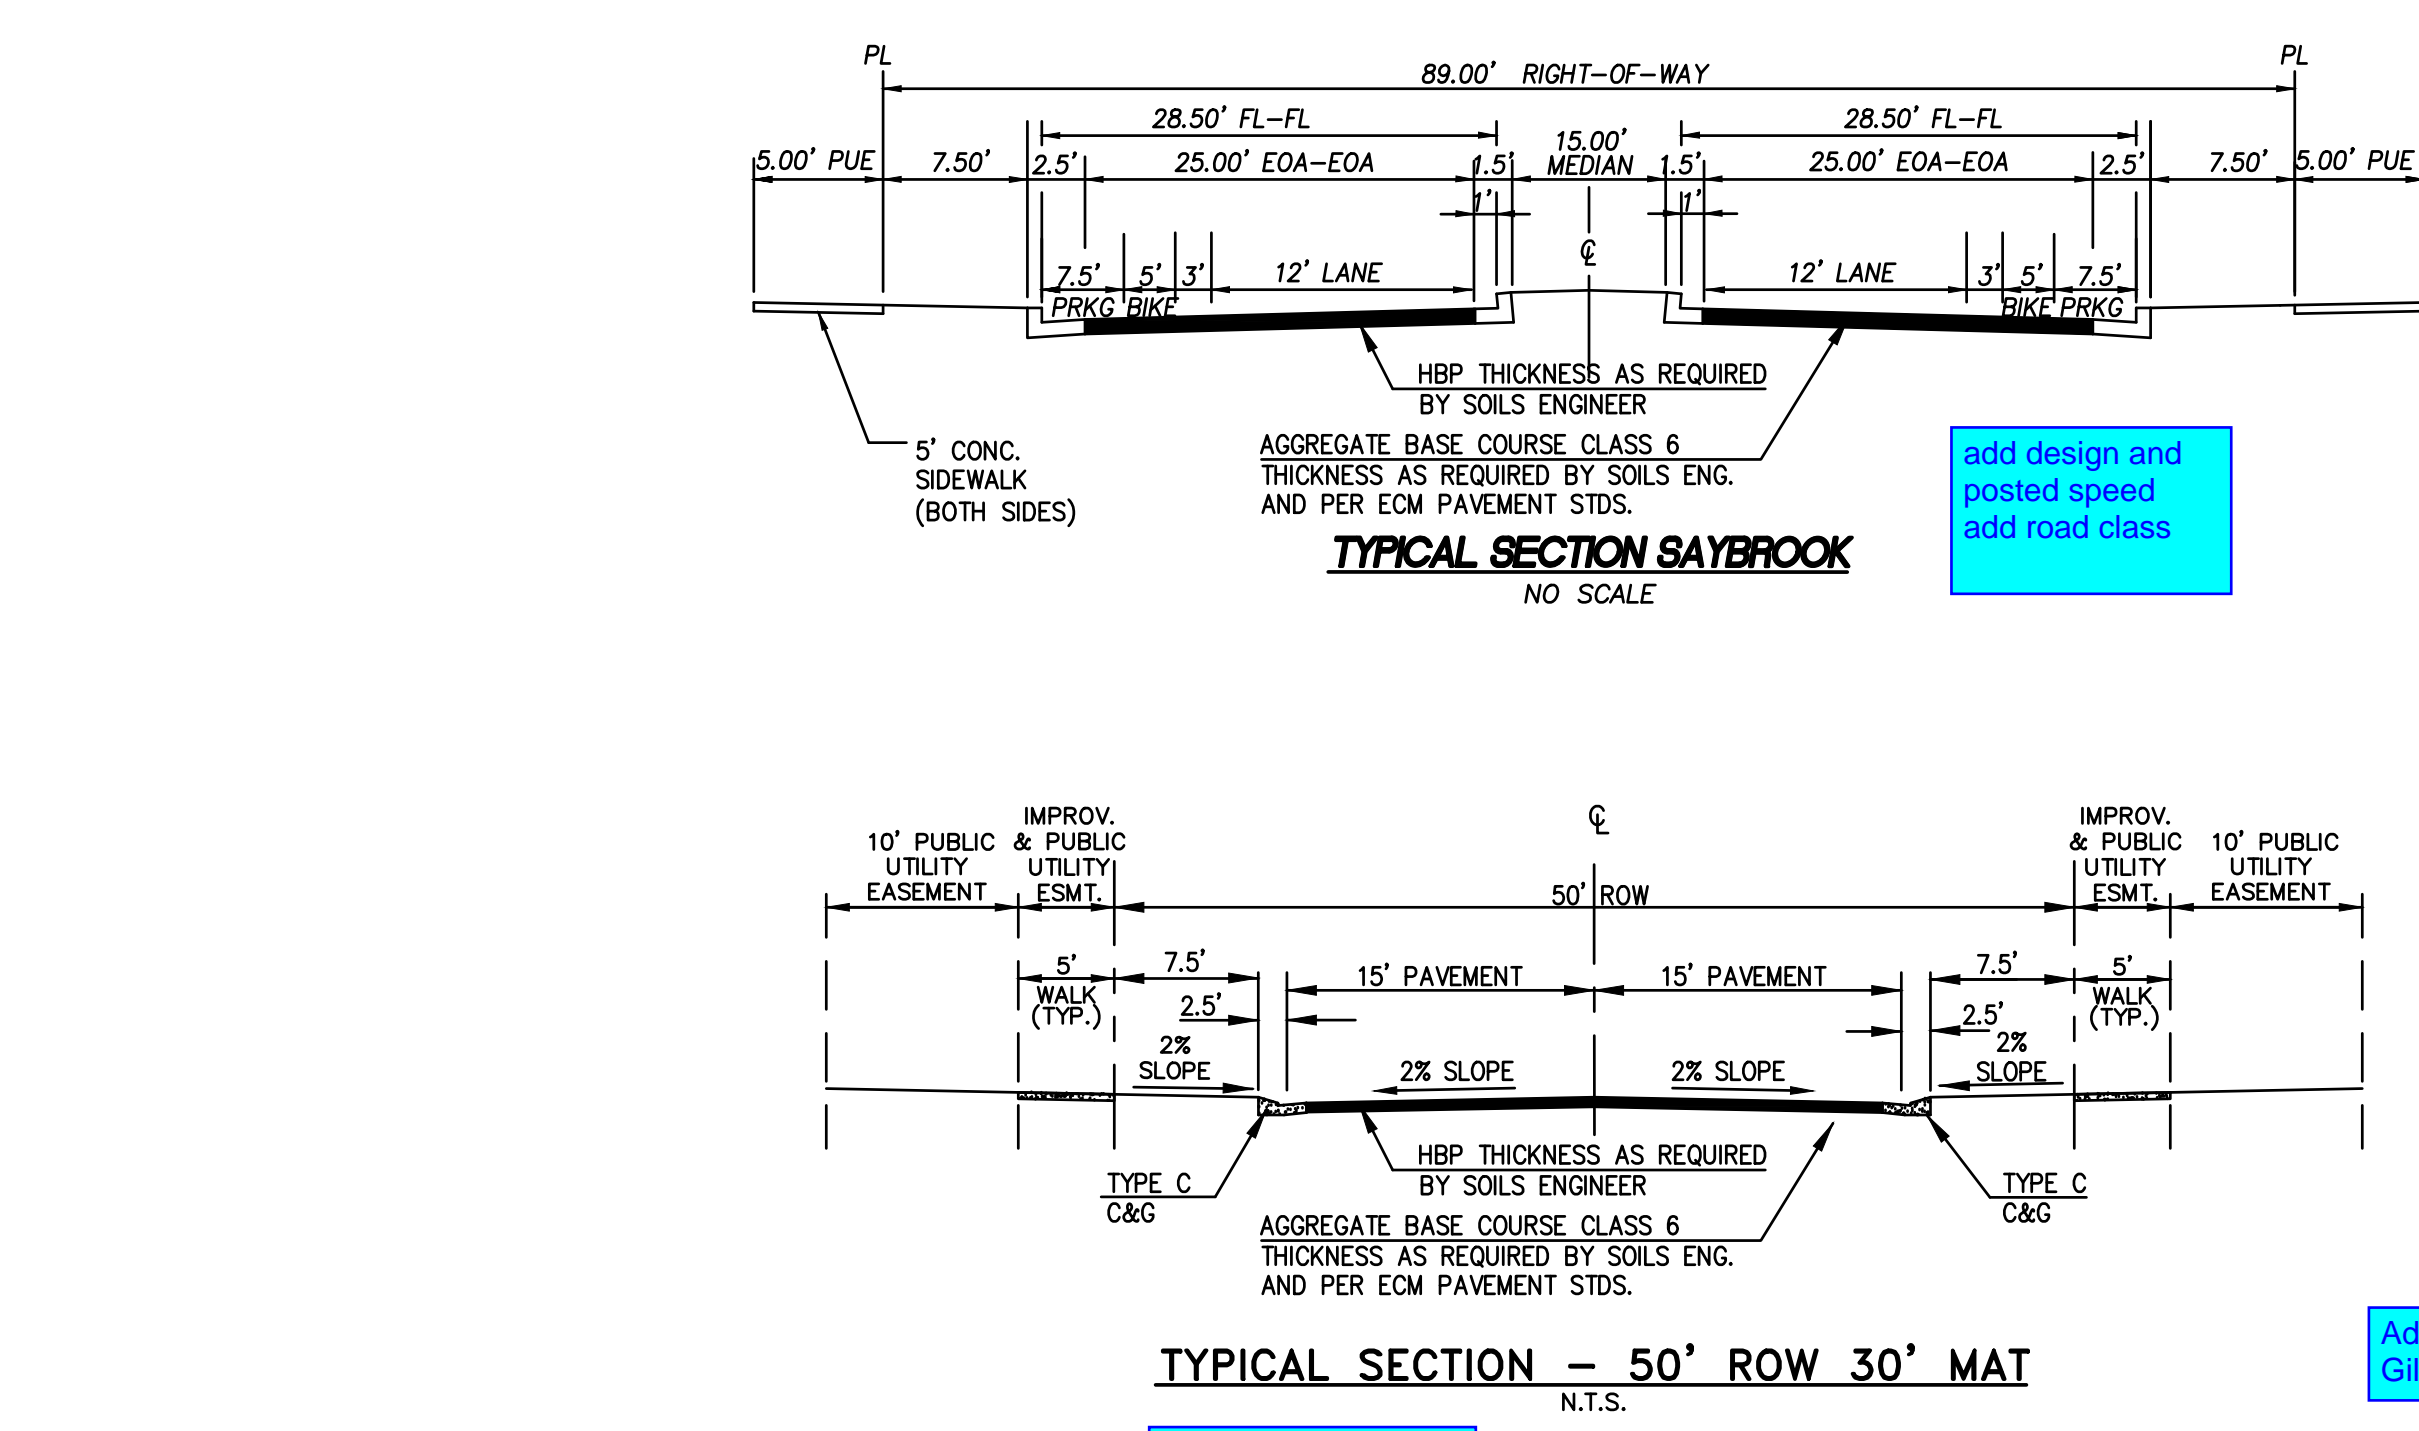


REVISIONS	NO.	DESCRIPTION	DATE
UNTIL SUCH TIME AS THESE DRAWINGS ARE APPROVED BY THE ENGINEER, THE ENGINEER, TERRA NOVA ENGINEERING, INC. APPROVES THEIR USE ONLY FOR THE PROJECT AND FOR THE SITE SPECIFIC BY WRITTEN AUTHORIZATION.			

PREPARED FOR:  
4-WAY RANCH JOINT VENTURE  
ATTN: PETER MARTZ  
P.O. BOX 50223  
COLORADO SPRINGS, CO 80949  
719-491-3150

Terra Nova Engineering, Inc.  
Civil/Environmental Engineers  
721 S. 23RD STREET  
COLORADO SPRINGS, CO 80904  
OFFICE: 719-635-6422  
FAX: 719-635-6426  
www.tneshinc.com

DESIGNED BY DLF	DRAWN BY QNA
CHECKED BY QNA	H-SCALE NA
V-SCALE N/A	JOB NO. 1715.00
DATE ISSUED 2/6/23	SHEET NO. 6 OF 39

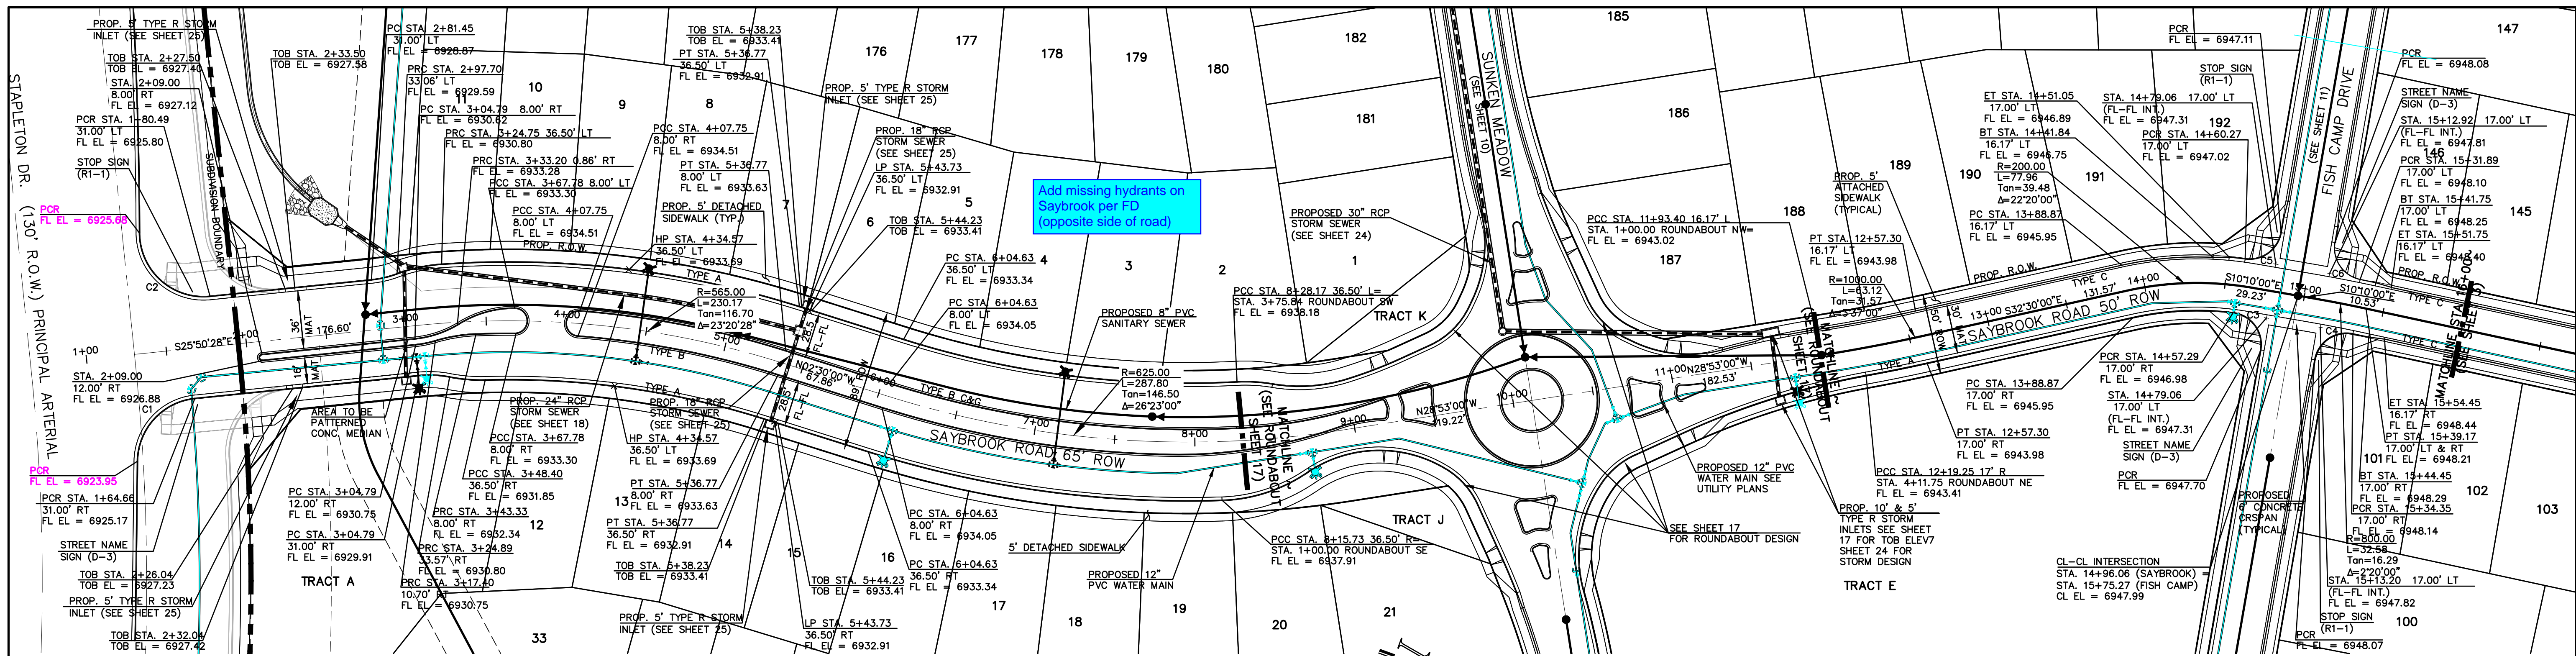


CURVE	LENGTH	RADIUS	DELTA
C1	58.27'	40.00'	83°28'17"
C2	66.73'	40.00'	95°35'02"
C3	32.37'	20.00'	92°43'54"
C4	32.11'	20.00'	91°59'17"
C5	30.76'	20.00'	88°07'18"
C6	30.78'	20.00'	88°11'16"

**SAYBROOK ROAD**  
 STA. 1+00.00 - 8+28.17 - RES. COLLECTOR  
 (DESIGN SPEED 35 MPH)

POSTED SPEED LIMIT IS 30 M.P.H.

Add speed limit sign on entry to subdivision

SEE APPROVED DEVIATION REQUESTS FOR LEFT AND RIGHT TURN LANES, MEDIAN WITHIN SAYBROOK ROAD AND POSTED SPEED LIMIT REDUCTION.

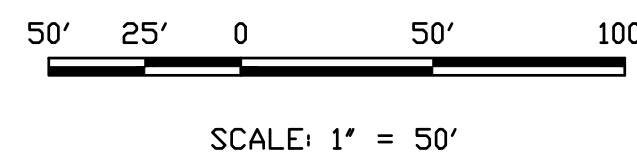

**SAYBROOK ROAD**  
 STA. 11+94.17 - 16+00.00 - LOCAL  
 (DESIGN SPEED 25 MPH)

POSTED SPEED LIMIT IS 25 M.P.H.

Add speed limit sign

Note: street and storm plan and profile review was preliminary on this submittal; more detailed review will be provided with the next submittal.

THIS DESIGN WAS PREPARED UNDER MY DIRECT SUPERVISION FOR AND ON BEHALF OF TERRA NOVA ENGINEERING, INC.

QUENTIN N. ARMJO, PROFESSIONAL ENGINEER  
 COLORADO P.E. NO. 37170


UNLESS SHOWN OTHERWISE, DRAWINGS ARE APPROVED AS SHOWN BY REVIEWING AGENCIES AS THE ENGINEER OF RECORD. TERRA NOVA ENGINEERING, INC. AND SURVEYING, INC. APPROVE FOR USE ONLY APPROVED FOR USE ONLY DESIGNATED BY WRITTEN AUTHORIZATION.

REVISIONS

NO.	DESCRIPTION	DATE

PREPARED FOR:  
**4-WAY RANCH JOINT VENTURE**  
**PETER MARTZ**  
 P.O. BOX 50223  
 COLORADO SPRINGS, CO 80949  
 719-491-3150


Terra Nova Engineering, Inc.  
 721 S. 2900 STREET  
 COLORADO SPRINGS, CO 80904  
 OFFICE: 719-635-6422  
 FAX: 719-635-6426  
 www.tneshc.com

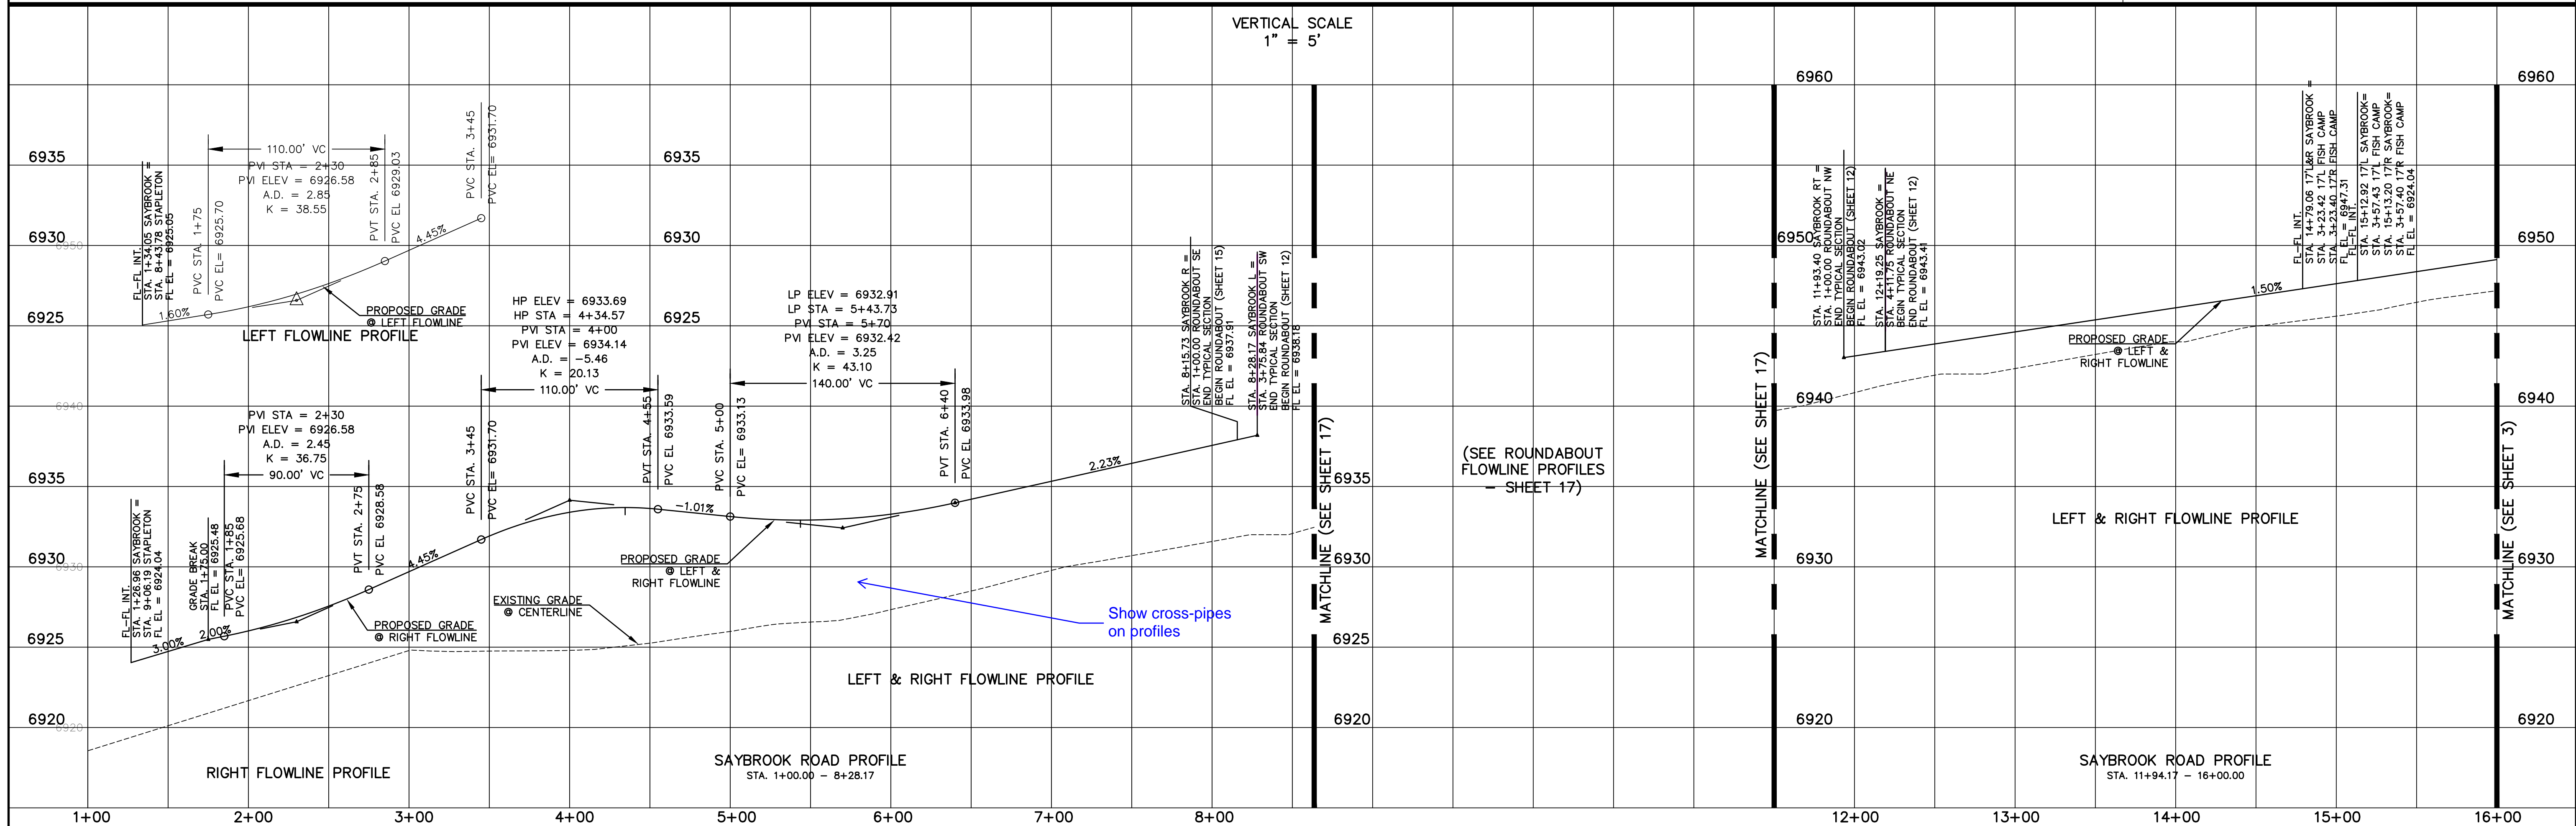


DESIGNED BY QNA  
 DRAWN BY QNA  
 CHECKED BY

H-SCALE 1"=50'  
 V-SCALE 1"=5'


JOB NO. 1715.00  
 DATE ISSUED 2/6/23  
 SHEET NO. 7 OF 39

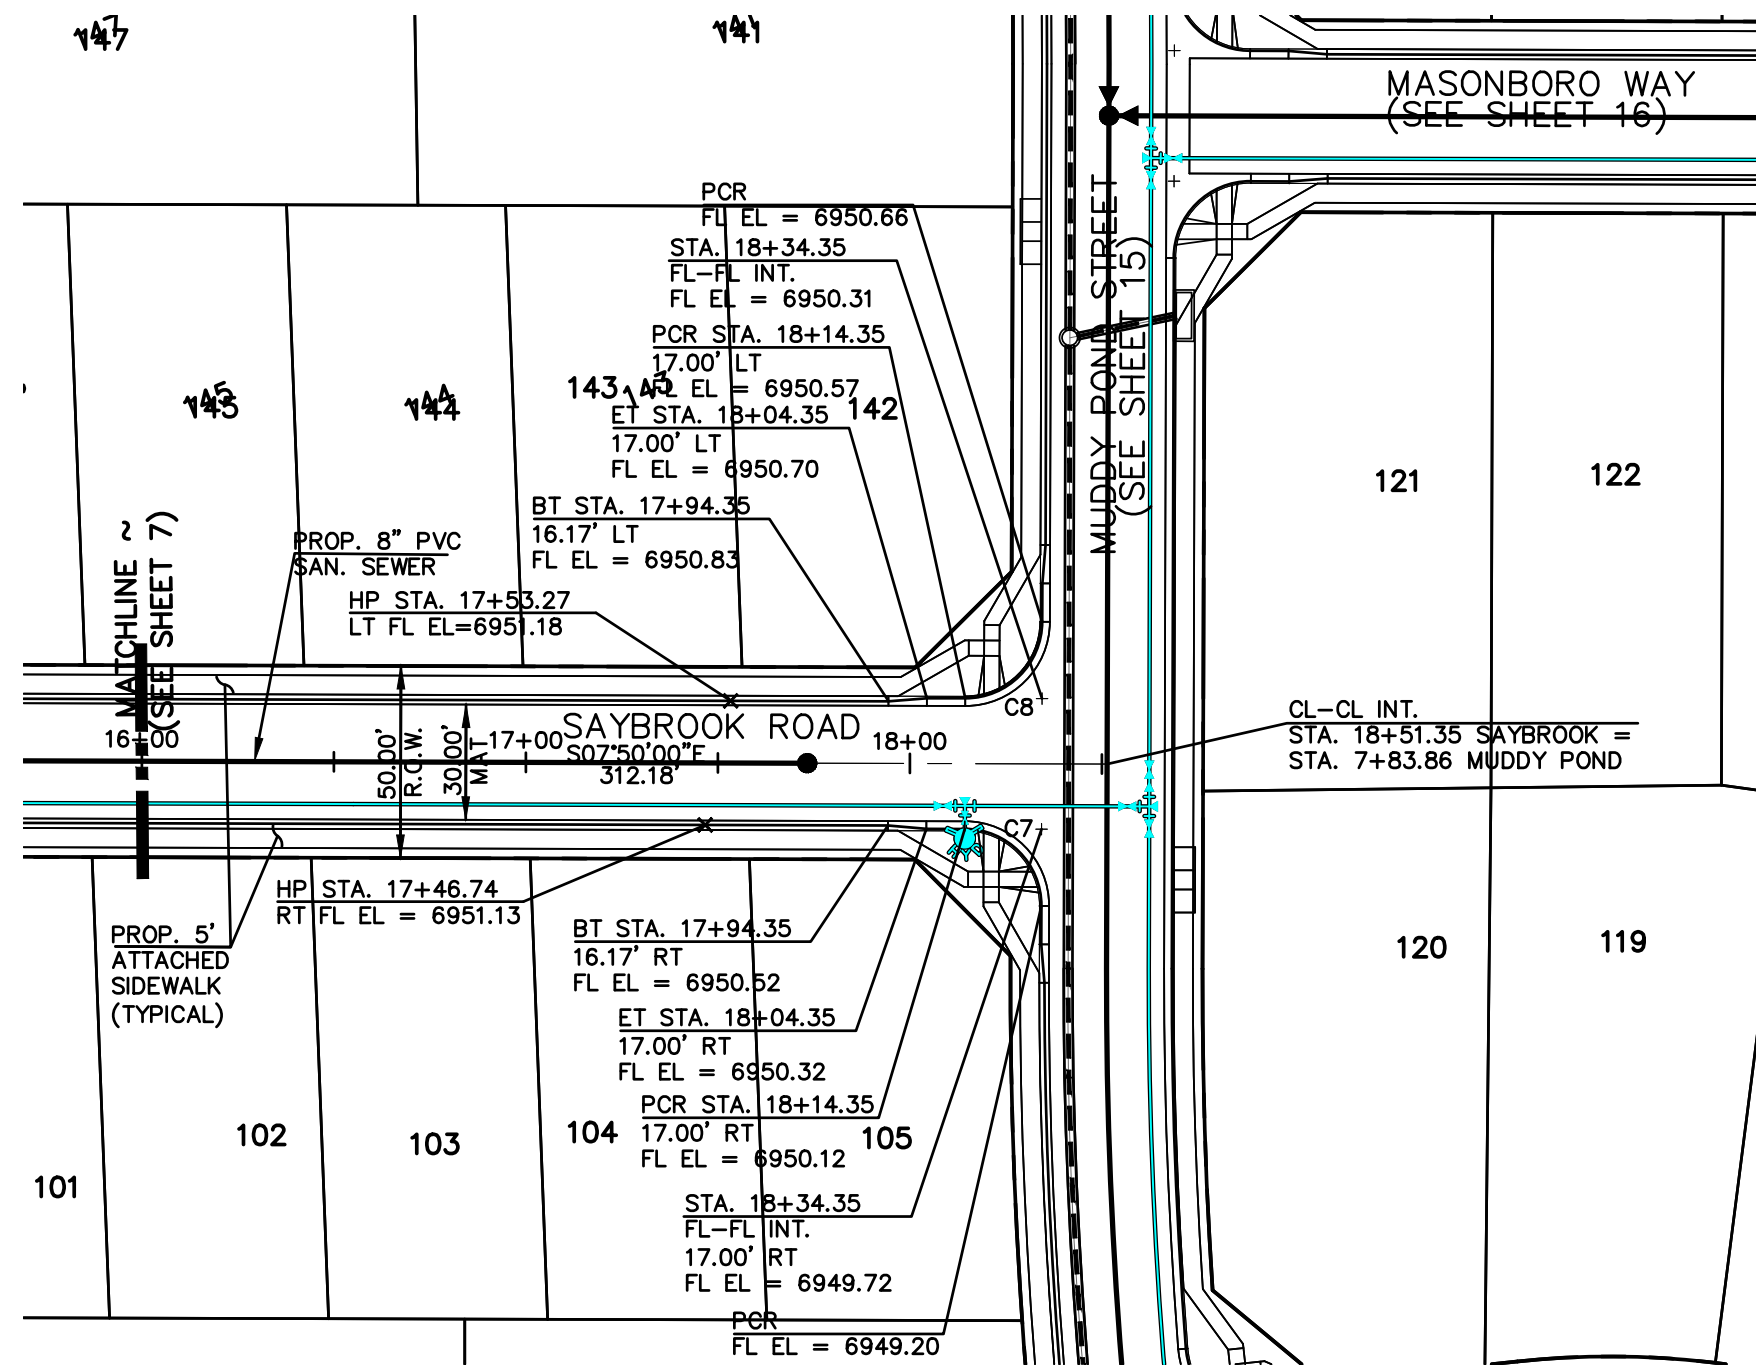

CURVE	LENGTH	RADIUS	DELTA
C7	31.42'	20.00'	90°00'00"
C8	31.42'	20.00'	90°00'00"
C9	33.05'	20.00'	94°41'12"
C10	30.14'	20.00'	86°20'39"

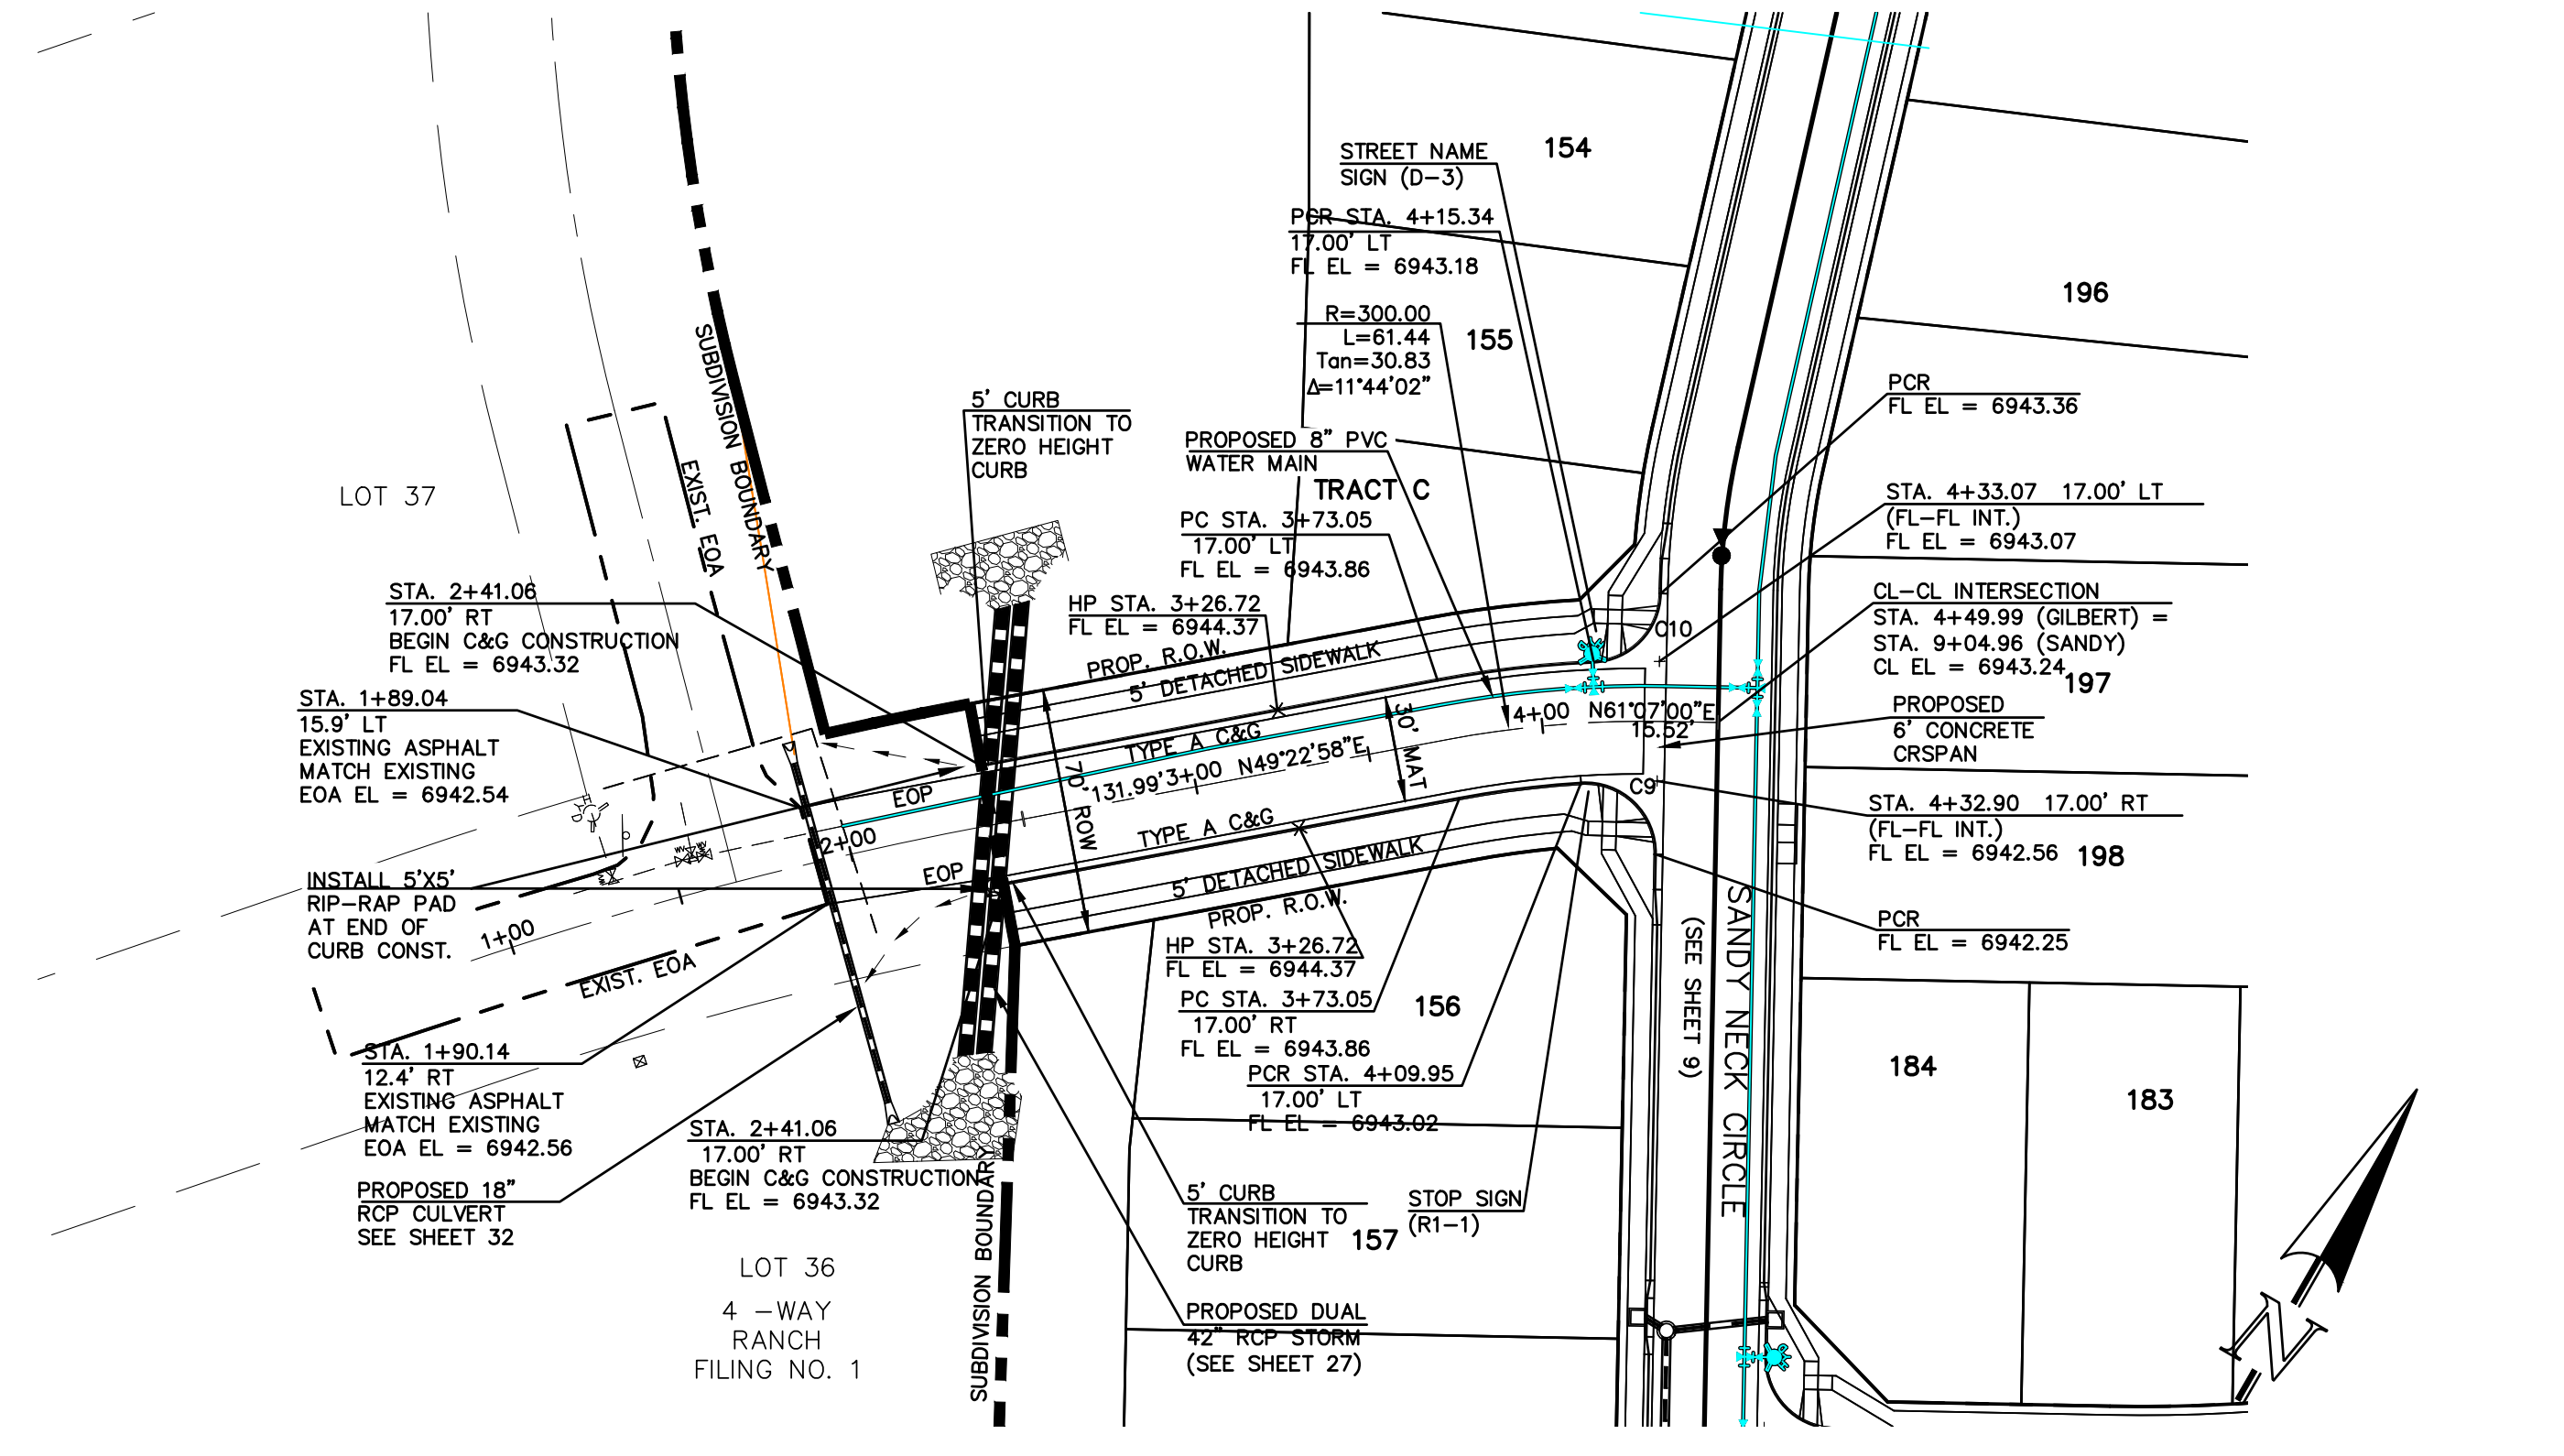

CURVE	LENGTH	RADIUS	DELTA
C7	31.42'	20.00'	90°00'00"
C8	31.42'	20.00'	90°00'00"
C9	33.05'	20.00'	94°41'12"
C10	30.14'	20.00'	86°20'39"

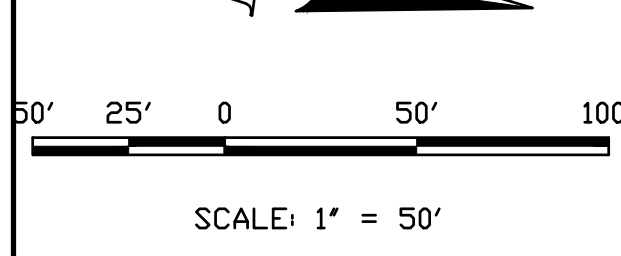

**SAYBROOK ROAD**  
 STA. 16+00.00 - 18+34.35 - URBAN LOCAL  
 (DESIGN SPEED 25 MPH)  
 (POSTED SPEED LIMIT IS 25 MPH)

**GILBERT DRIVE (70' ROW)**  
 STA. 1+90.24 - 4+33.08 - URBAN LOCAL  
 (DESIGN SPEED 25 MPH)  
 (POSTED SPEED LIMIT IS 25 MPH)

THIS DESIGN WAS PREPARED UNDER MY DIRECT SUPERVISION  
 FOR AND ON BEHALF OF TERRA NOVA ENGINEERING, INC.

QUENTIN N. ARMUJO, PROFESSIONAL ENGINEER  
 COLORADO P.E. NO. 37170

UNTL SUCH TIME AS APPROVED  
 DRAWINGS ARE THESE  
 REVISIONS

NO.	DESCRIPTION	DATE

PREPARED FOR:  
**4-WAY RANCH JOINT VENTURE**  
 PETER MARTZ  
 P.O. BOX 50223  
 COLORADO SPRINGS, CO 80949  
 719-491-3150

APPROVED FOR USE ONLY  
 AND SURVEYING, INC.  
 TERRA NOVA ENGINEERING, INC.  
 REVISIONS



**SAYBROOK ROAD PROFILE**  
 STA. 16+00.00 - 18+34.35

**GILBERT DRIVE**  
 STA. 2+14.16 - 4+33.08

721 S. 2900 STREET  
 COLORADO SPRINGS, CO 80904  
 OFFICE: 719-635-6422  
 FAX: 719-635-6426  
 www.tneshc.com

**Terra Nova**  
 Engineering, Inc.  
 Professional Engineer


DESIGNED BY QNA  
 DRAWN BY QNA  
 CHECKED BY

H-SCALE 1"=50'  
 V-SCALE 1"=5'

JOB NO. 1715.00  
 DATE ISSUED 2/6/23  
 SHEET NO. 8 OF 39

WATERBURY FILING NO. 1  
 CONSTRUCTION SET  
 STREET PLAN AND PROFILE  
 SAYBROOK ROAD CONT'D & GILBERT ROAD



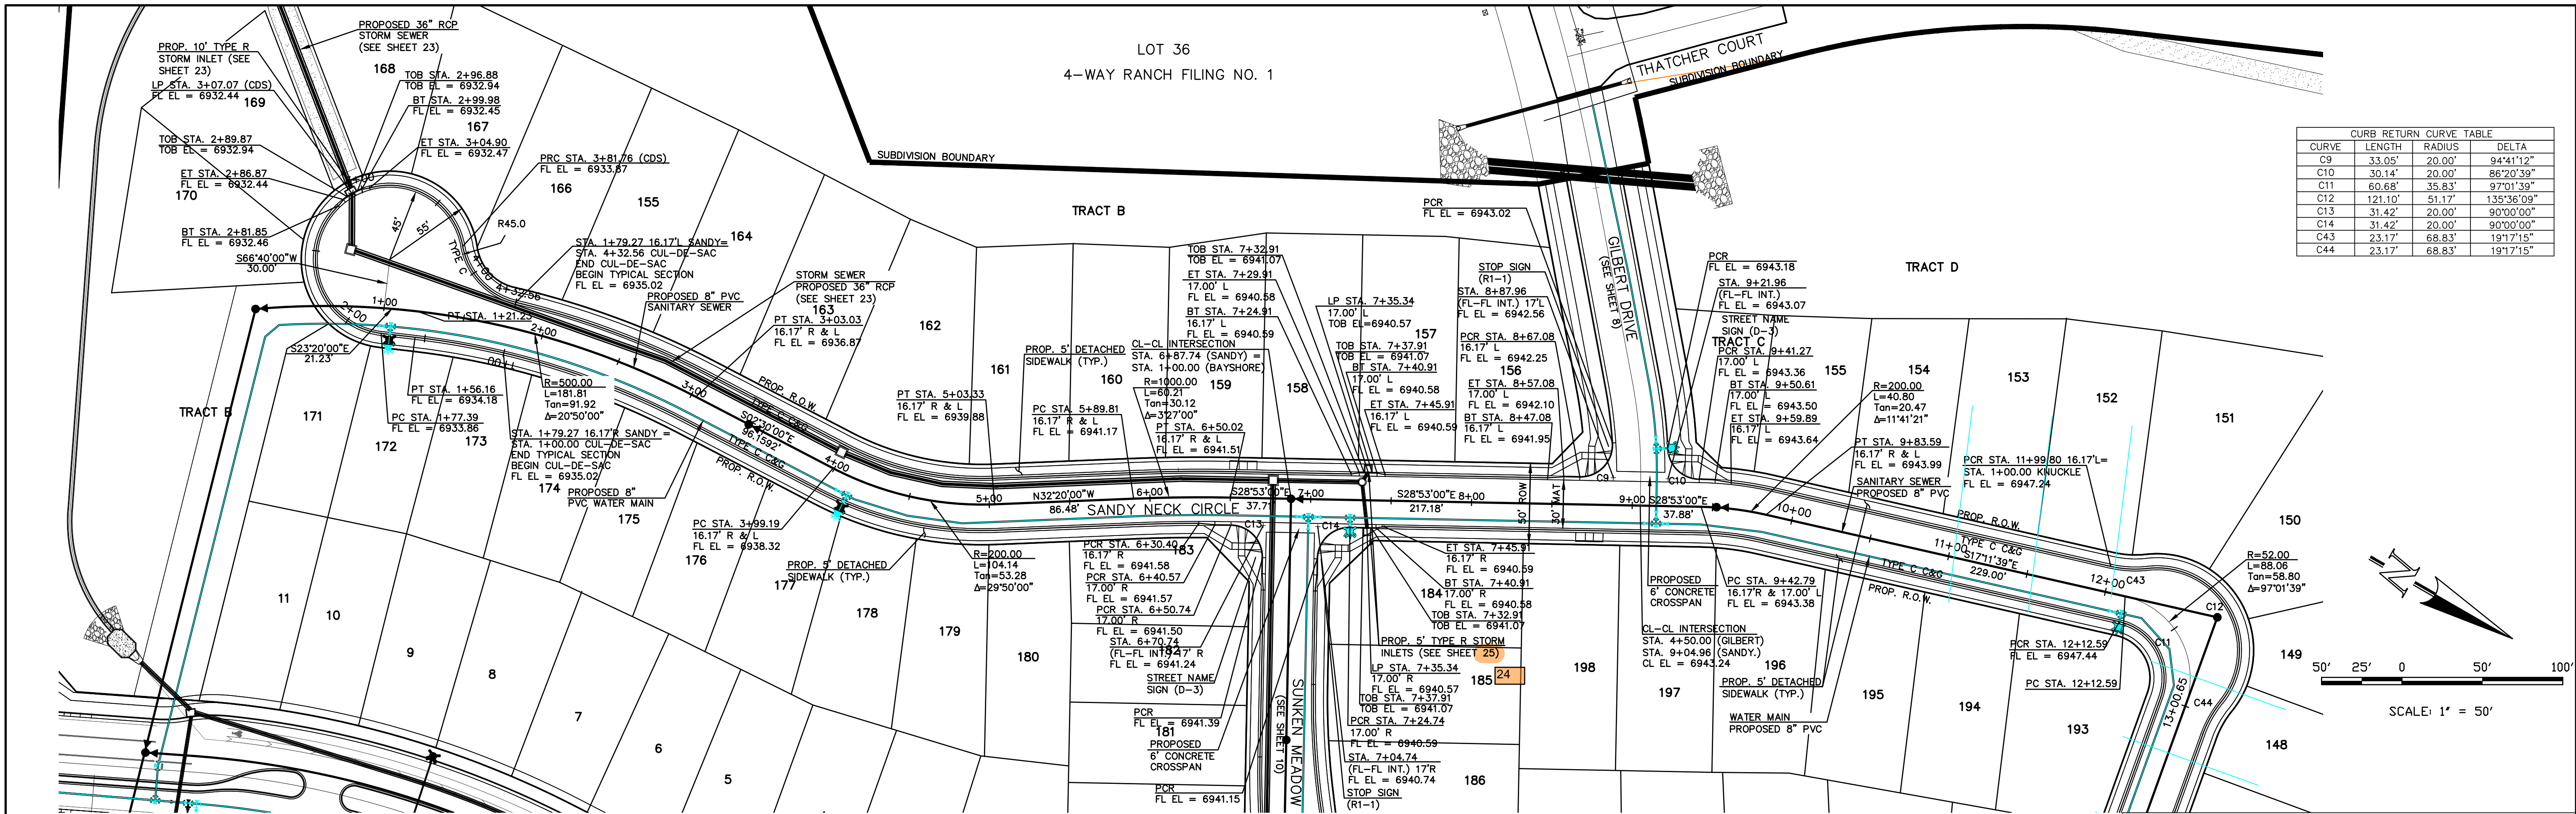

**SANDY NECK CIRCLE (50' ROW)**  
 STA. 1+00.00 - 11+00.00 URBAN LOCAL  
 (DESIGN SPEED 25 MPH)  
 (POSTED SPEED LIMIT IS 25 MPH)

POSTED SPEED LIMIT IS 25 M.P.H.

THIS DESIGN WAS PREPARED UNDER MY DIRECT SUPERVISION FOR AND ON BEHALF OF TERRA NOVA ENGINEERING, INC.

QUENTIN N. ARMUO, PROFESSIONAL ENGINEER  
 COLORADO P.E. NO. 37170


REVISIONS

NO.	DESCRIPTION	DATE

UNTIL SUCH TIME AS THESE DRAWINGS ARE APPROVED BY THE REVIEWING AGENCIES FOR THE TERRA NOVA ENGINEERING AND SURVEYING, INC. APPROVED FOR THEIR USE ONLY DESIGNATED BY WRITTEN AUTHORIZATION.

PREPARED FOR:  
**4-WAY RANCH JOINT VENTURE**  
**PETER MARTZ**  
 P.O. BOX 50223  
 COLORADO SPRINGS, CO 80949  
 719-491-3150

Terra Nova Engineering, Inc.  
 A Terra Group Company  
 721 S. 2900 STREET  
 COLORADO SPRINGS, CO 80904  
 OFFICE: 719-635-6422  
 FAX: 719-635-6426  
 www.tneshc.com

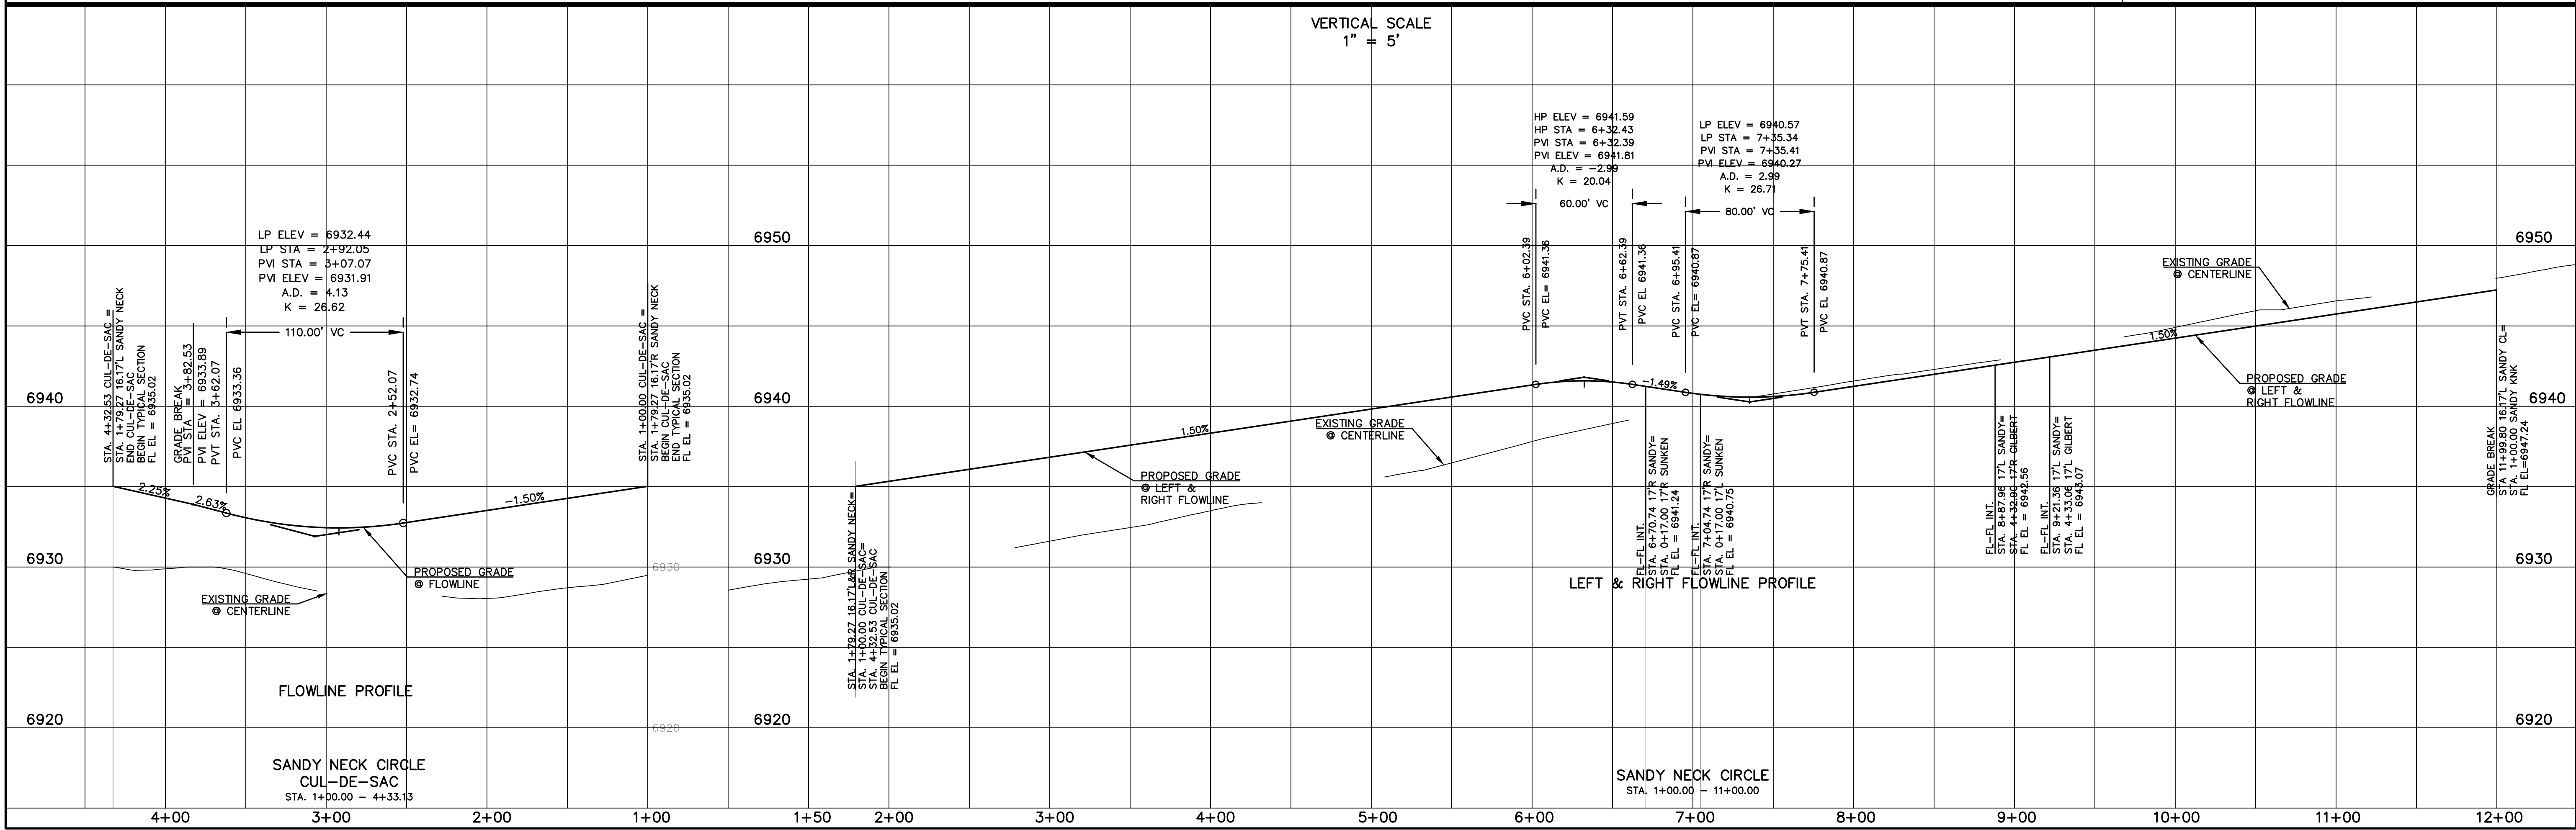


**WATERBURY FILING NO. 1**

CONSTRUCTION SET  
 STREET PLAN AND PROFILE  
 SAYBROOK ROAD

DESIGNED BY QNA  
 DRAWN BY QNA  
 CHECKED BY

H-SCALE 1"=50'  
 V-SCALE 1"=5'

JOB NO. 1715.00  
 DATE ISSUED 2/6/23  
 SHEET NO. 9 OF 39

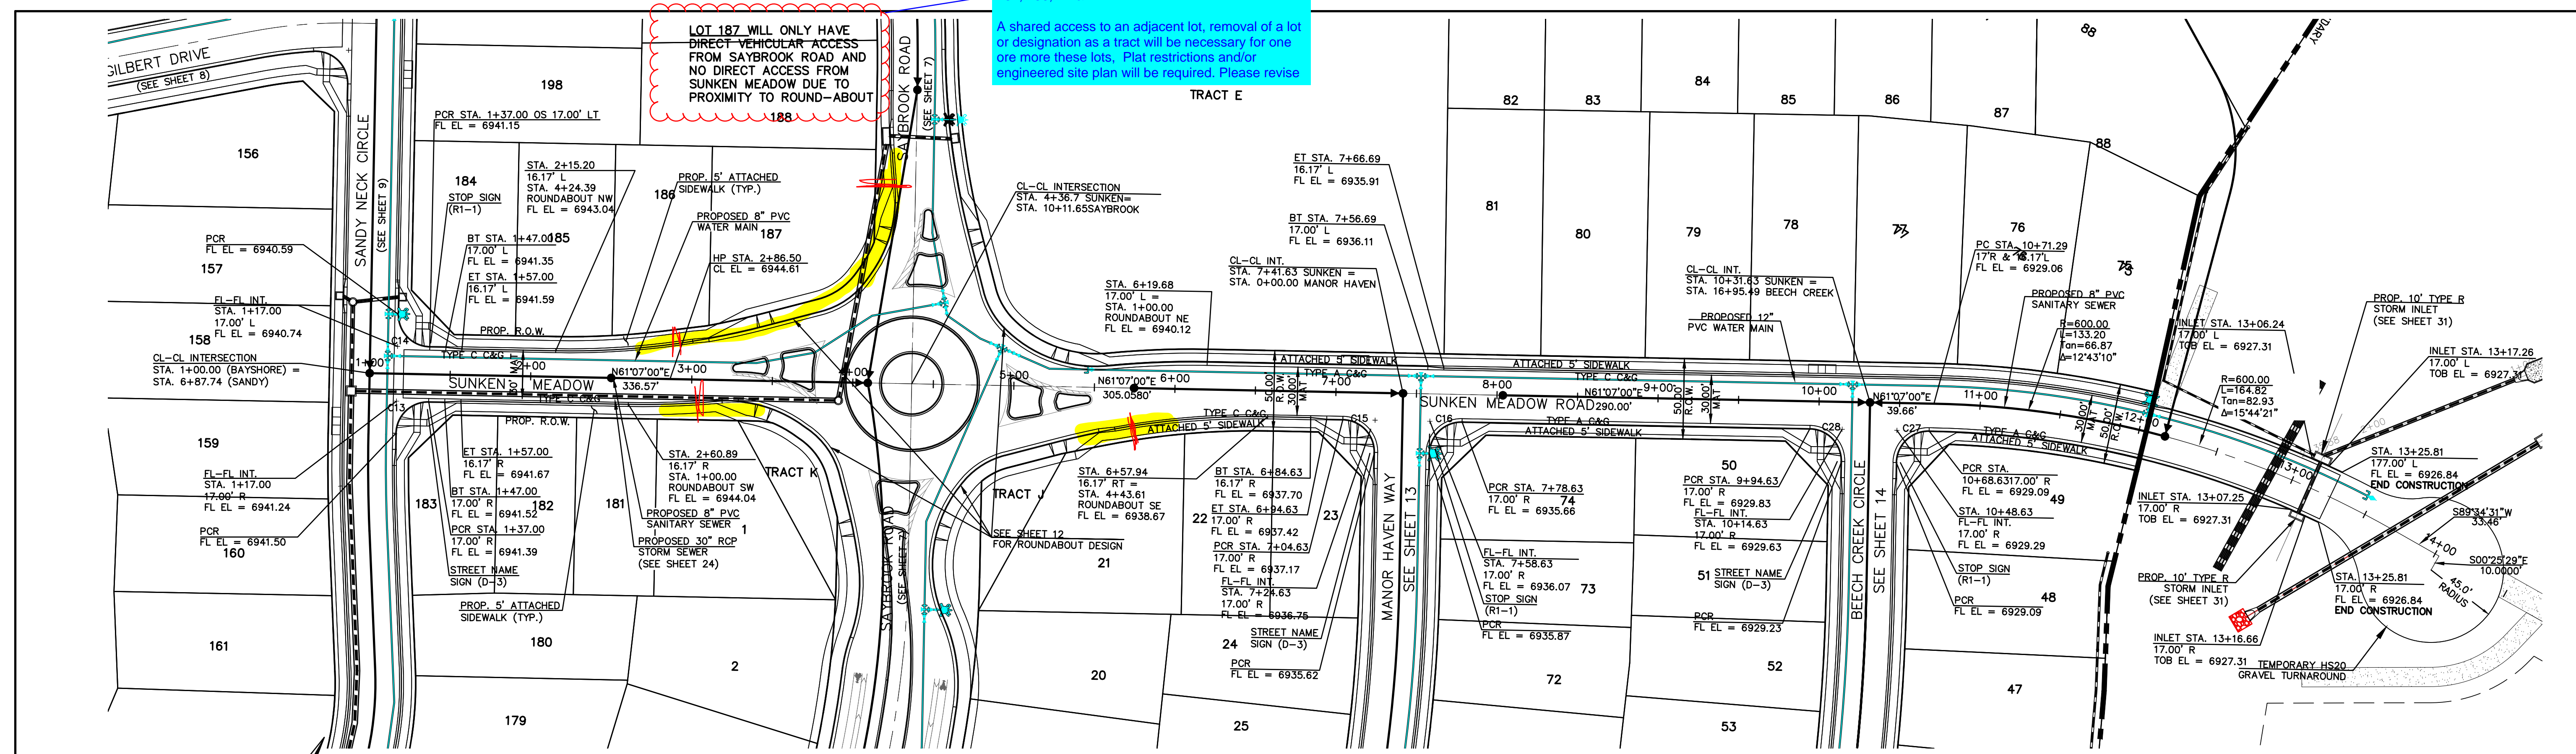

CURB RETURN CURVE TABLE


CURVE	LENGTH	RADIUS	DELTA
C13	31.42'	20.00'	90°00'00"
C14	31.42'	20.00'	90°00'00"
C15	31.42'	20.00'	90°00'00"
C16	32.51'	20.00'	93°07'57"
C27	31.42'	20.00'	90°00'00"
C28	31.42'	20.00'	90°00'00"

**SUNKEN MEADOW ROAD**  
 STA. 1+00.00 - STA. 13+25.81 - URBAN LOCAL  
 (DESIGN SPEED 25 MPH)  
 (POSTED SPEED LIMIT IS 25 MPH)

Please provide complete Roundabout Report

THIS DESIGN WAS PREPARED UNDER MY DIRECT SUPERVISION FOR AND ON BEHALF OF TERRA NOVA ENGINEERING, INC.


QUENTIN N. ARMJO, PROFESSIONAL ENGINEER  
 COLORADO P.E. NO. 37170

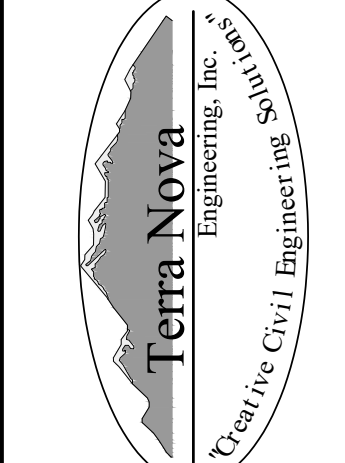

721 S. 2960 STREET  
 COLORADO SPRINGS, CO 80904  
 OFFICE: 719-635-6422  
 FAX: 719-635-6426  
 www.tneshc.com

WATERBURY FILING NO. 1

DESIGNED BY QNA  
 DRAWN BY QNA  
 CHECKED BY  
 H-SCALE 1"=50'  
 V-SCALE 1"=5'  
 JOB NO. 1715.00  
 DATE ISSUED 2/6/23  
 SHEET NO. 10 OF 39

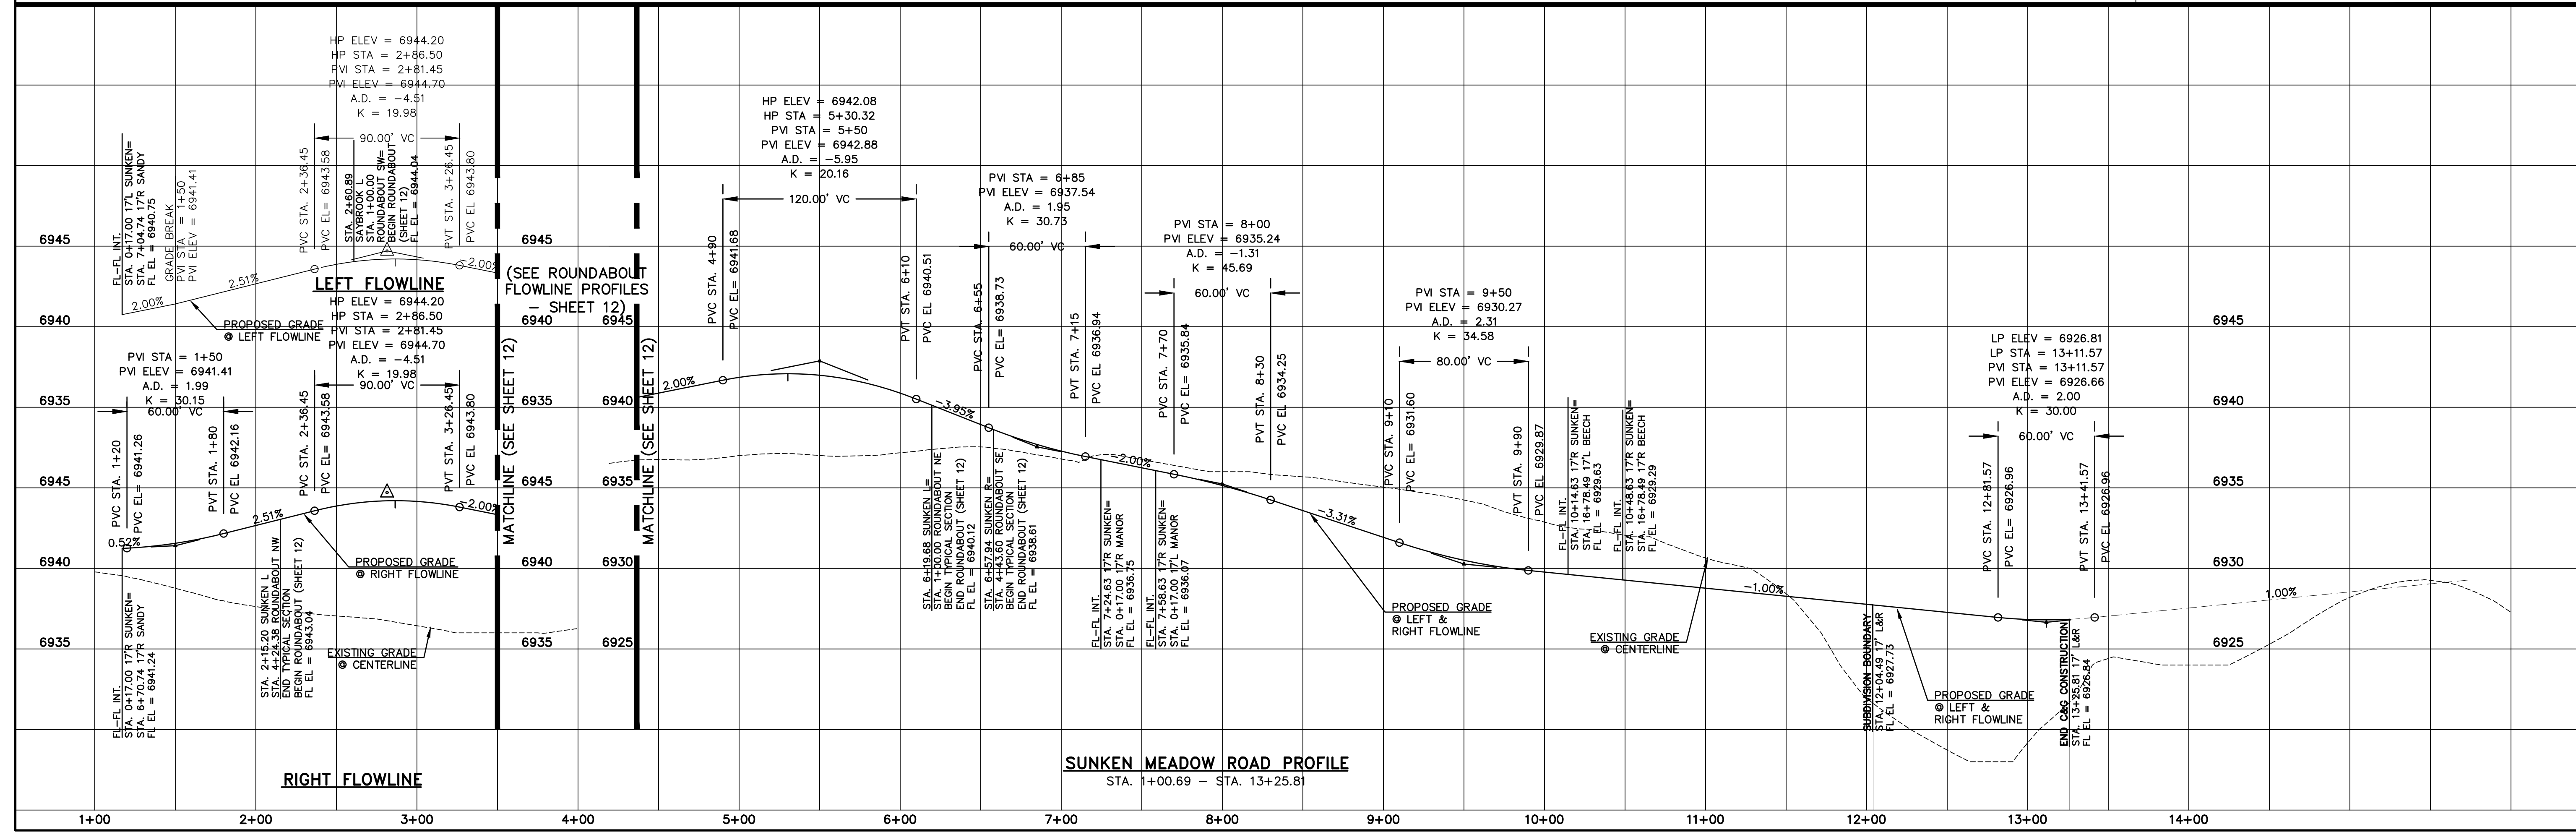

REVISIONS


NO.	DESCRIPTION	DATE

UNTIL SUCH TIME AS THESE DRAWINGS ARE APPROVED BY THE BOARD OF COUNTY COMMISSIONERS, THE DESIGN SHALL BE THE PROPERTY OF TERRA NOVA ENGINEERING, INC. AND NO PARTS THEREOF SHALL BE REPRODUCED OR USED FOR ANY OTHER PROJECT WITHOUT THE WRITTEN AUTHORIZATION OF TERRA NOVA ENGINEERING, INC.

PREPARED FOR:  
**4-WAY RANCH JOINT VENTURE**  
 PETER MARTZ  
 AND SURVEYING, INC.  
 APPROVED FOR USE ONLY  
 COLORADO SPRINGS, CO 80949  
 719-491-3150






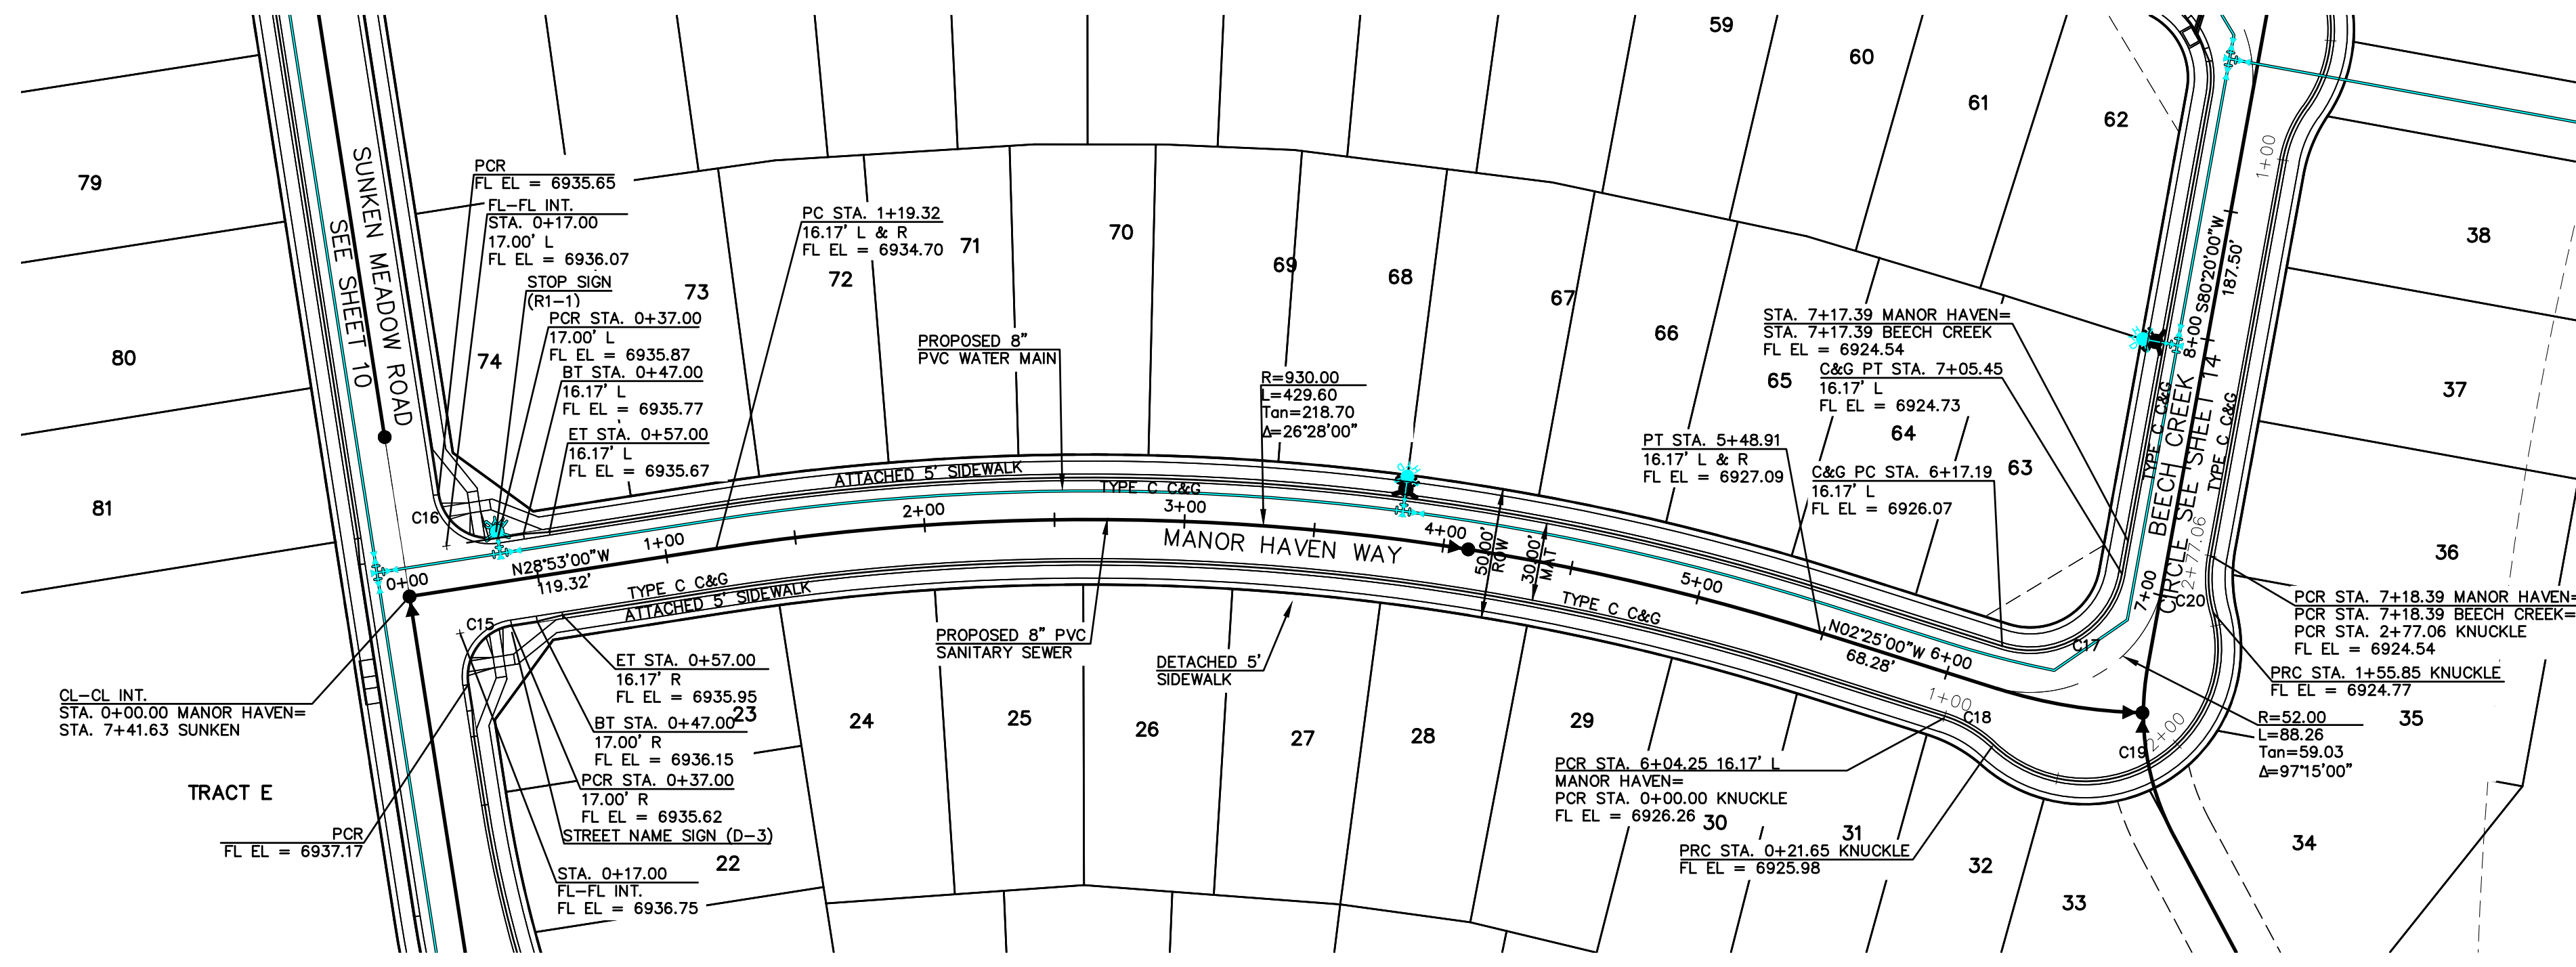

CURVE	LENGTH	RADIUS	DELTA
C15	31.42'	20.00'	90°00'00"
C16	32.51'	20.00'	93°07'57"
C17	60.82'	35.83'	97°15'00"
C18	22.02'	48.83'	25°50'31"
C19	133.01'	51.17'	148°56'02"
C20	22.02'	48.83'	25°50'31"


**MANOR HAVEN WAY KNUCKLE PLAN**  
 STA. 1+00.00 - 2+77.05 - URBAN LOCAL  
 (DESIGN SPEED 25 MPH)  
 (POSTED SPEED LIMIT IS 25 MPH)

**MANOR HAVEN WAY**  
 STA. 0+00.00 - 7+17.39 - URBAN LOCAL  
 (DESIGN SPEED 25 MPH)  
 (POSTED SPEED LIMIT IS 25 MPH)

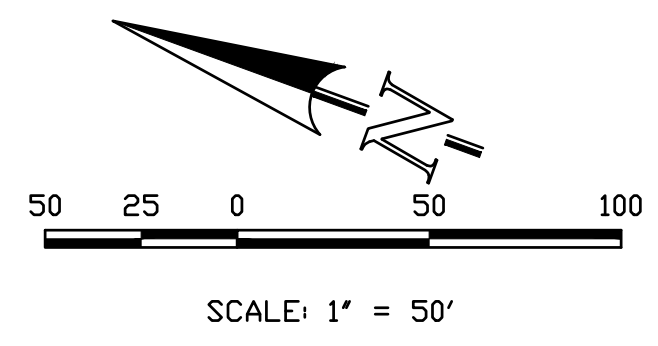

THIS DESIGN WAS PREPARED UNDER MY DIRECT SUPERVISION  
 FOR AND ON BEHALF OF TERRA NOVA ENGINEERING, INC.


QUENTIN N. ARMUO, PROFESSIONAL ENGINEER  
 COLORADO P.E. NO. 37170

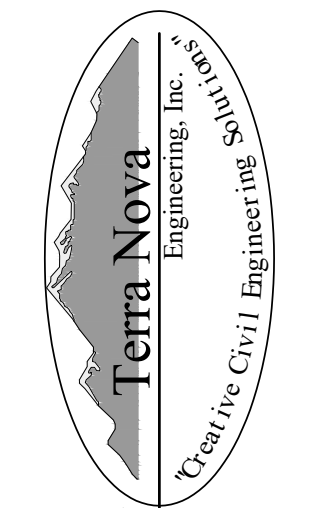

721 S. 2960 STREET  
 COLORADO SPRINGS, CO 80904  
 OFFICE: 719-635-6422  
 FAX: 719-635-6426  
 www.tneshc.com

**WATERBURY FILING NO. 1**  
 CONSTRUCTION SET  
 STREET PLAN AND PROFILE  
 MANOR HAVEN WAY

DESIGNED BY QNA  
 DRAWN BY QNA  
 CHECKED BY  
 H-SCALE 1"=50'  
 V-SCALE 1"=5'  
 JOB NO. 1715.00  
 DATE ISSUED 2/6/23  
 SHEET NO. 13 OF 39

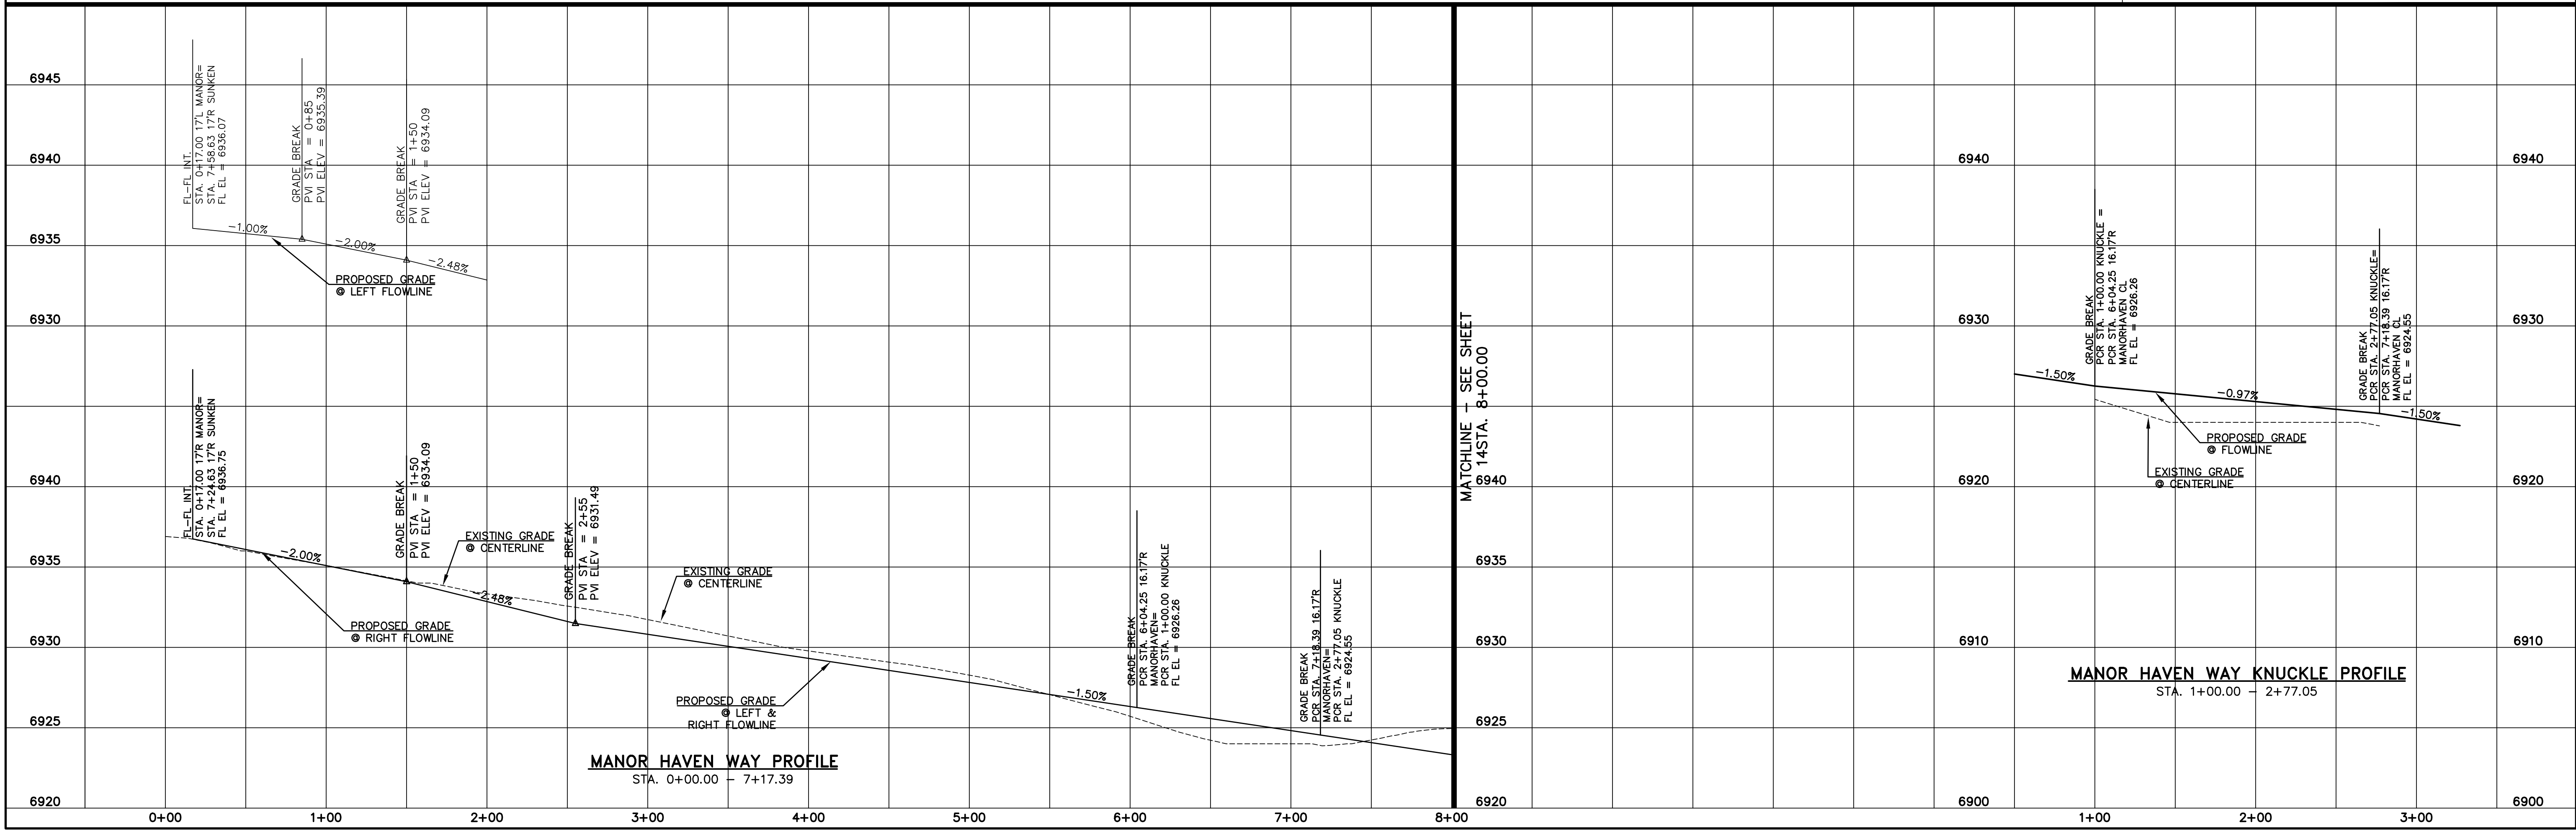

**MANOR HAVEN WAY PROFILE**  
 STA. 0+00.00 - 7+17.39

**MANOR HAVEN WAY KNUCKLE PROFILE**  
 STA. 1+00.00 - 2+77.05


NO.	DESCRIPTION	DATE

UNTIL SUCH TIME AS THESE  
 DRAWINGS ARE APPROVED  
 BY THE APPROPRIATE  
 REVIEWING AGENCIES, THE  
 TERRA NOVA ENGINEERING,  
 AND SURVEYING, INC. ONLY  
 APPROVED FOR THEIR USE ONLY  
 AUTHORIZED BY WRITTEN  
 AUTHORIZATION.


PREPARED FOR:  
**4-WAY RANCH JOINT VENTURE**  
**PETER MARTZ**  
 P.O. BOX 50223  
 COLORADO SPRINGS, CO 80949  
 719-491-3150

**BEECH CREEK KNUCKLE PLAN**  
 STA. 1+00.00 - 2+77.05 - URBAN LOCAL  
 (DESIGN SPEED 25 MPH)  
 (POSTED SPEED LIMIT IS 25 MPH)

CURB RETURN CURVE TABLE			
CURVE	LENGTH	RADIUS	DELTA
C21	22.02'	48.83'	25°50'31"
C22	45.94'	51.17'	51°26'26"
C23	49.27'	51.17'	55°10'01"
C24	22.02'	48.83'	25°50'31"
C25	15.04'	35.83'	24°03'23"
C26	12.80'	35.83'	20°27'48"
C27	31.42'	20.00'	90°00'00"
C28	31.42'	20.00'	90°00'00"

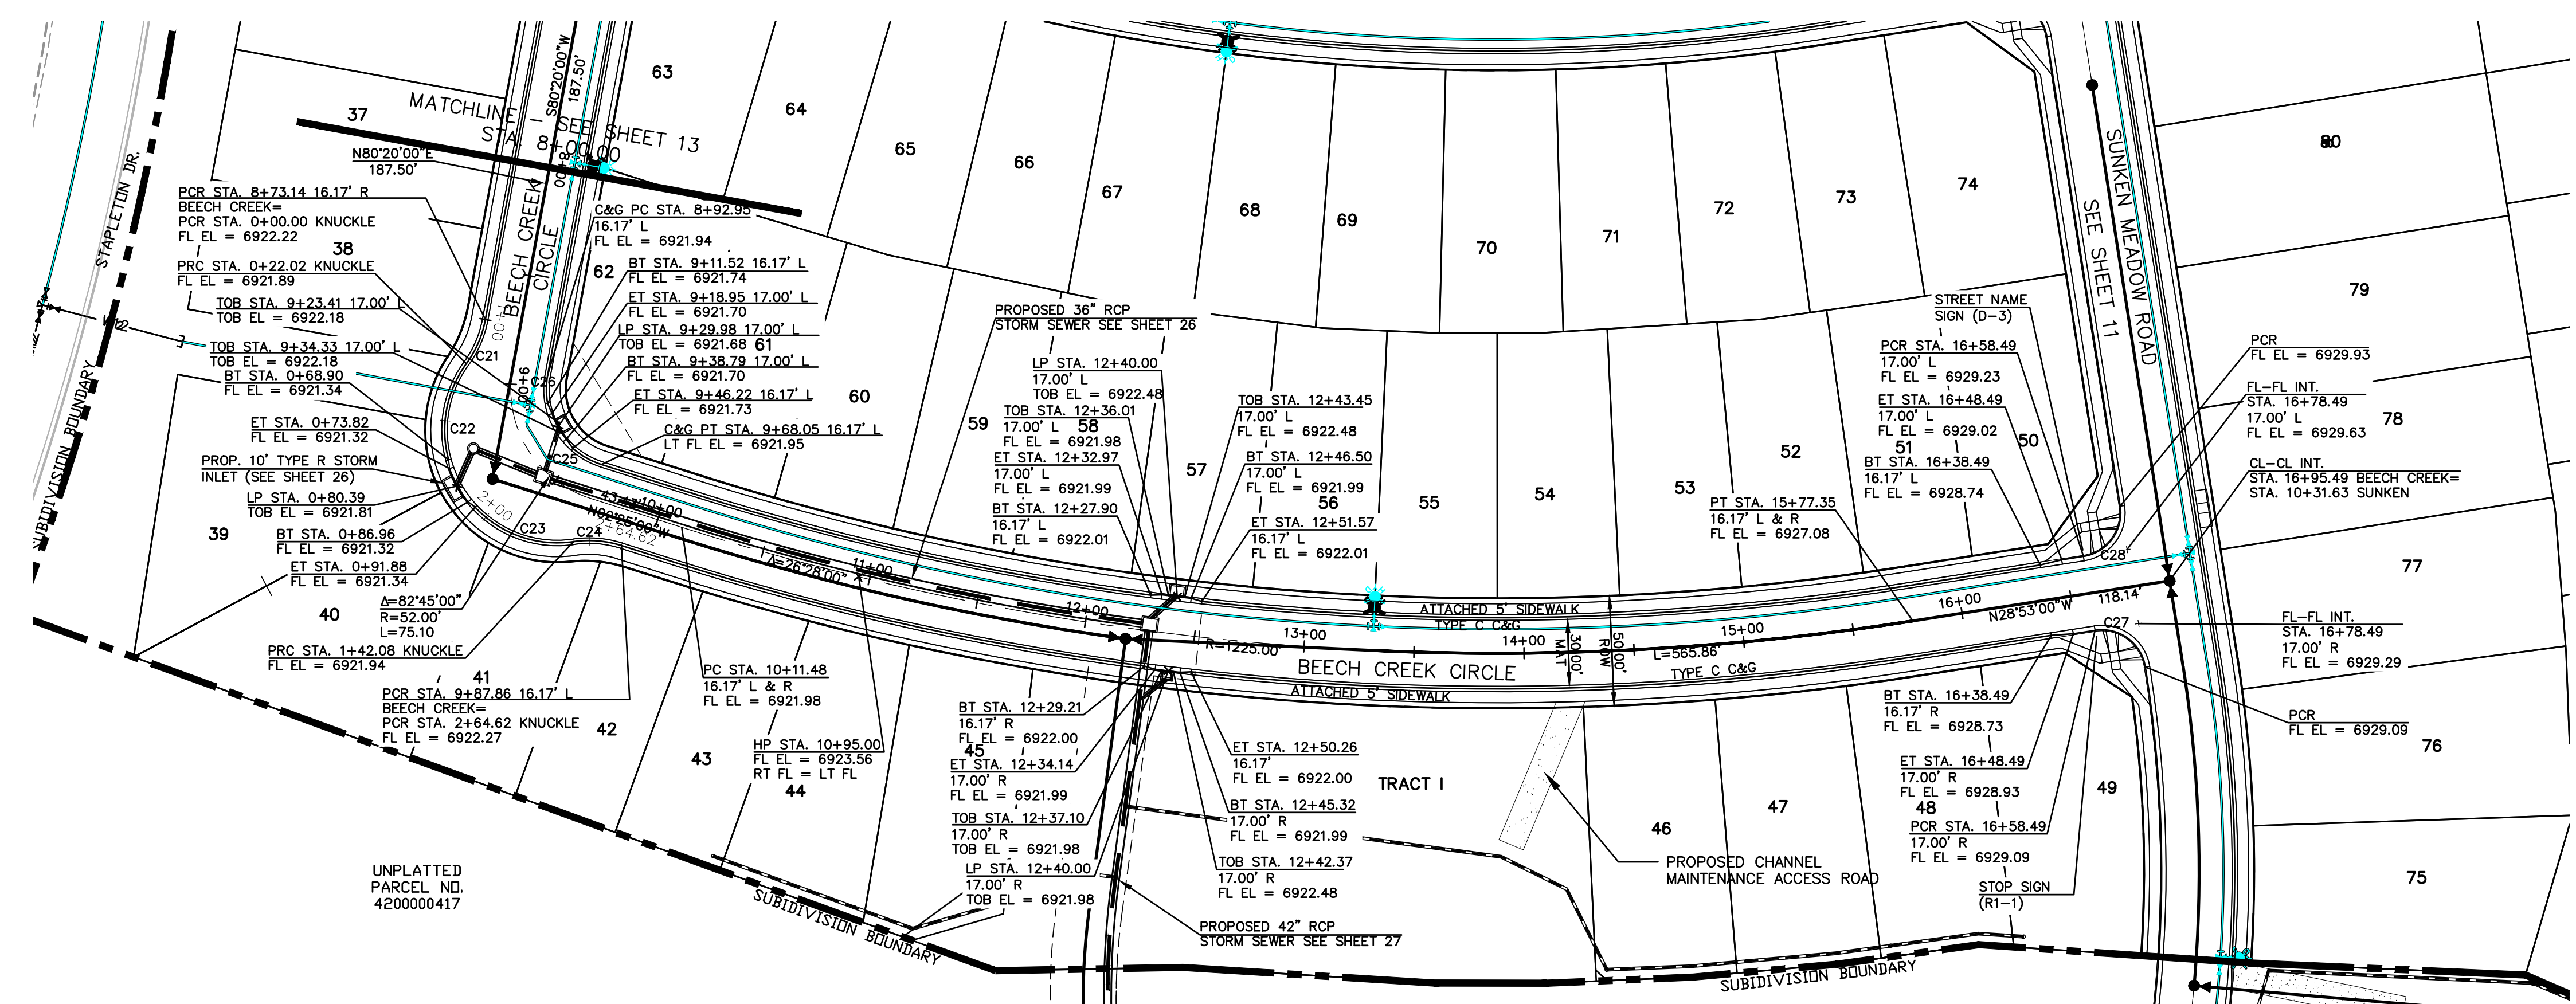

**BEECH CREEK CIRCLE**  
 STA. 8+00.00 - 16+95.49 - URBAN LOCAL  
 (DESIGN SPEED 25 MPH)  
 (POSTED SPEED LIMIT IS 25 MPH)

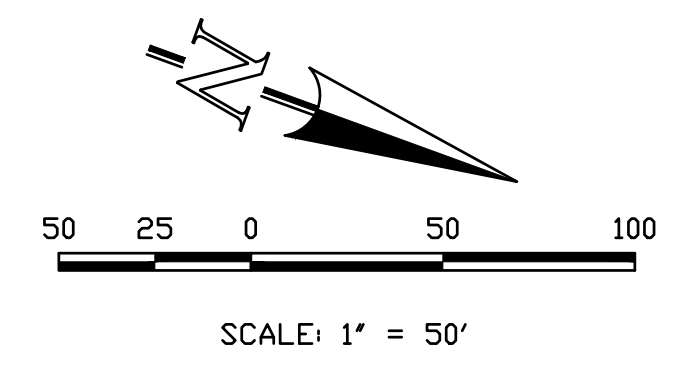

THIS DESIGN WAS PREPARED UNDER MY DIRECT SUPERVISION  
 FOR AND ON BEHALF OF TERRA NOVA ENGINEERING, INC.

QUENTIN N. ARMUO, PROFESSIONAL ENGINEER  
 COLORADO P.E. NO. 37170

NO.	REVISIONS	DESCRIPTION	DATE

UNTIL SUCH TIME AS THESE DRAWINGS ARE APPROVED BY THE BOARD OF COUNTY COMMISSIONERS, THE BOARD OF SUPERVISORS, THE BOARD OF DIRECTORS, THE BOARD OF APPOINTMENT, OR THE BOARD OF APPOINTMENT, THIS DESIGN IS NOT TO BE USED FOR ANY OTHER PROJECT WITHOUT THE WRITTEN AUTHORIZATION OF TERRA NOVA ENGINEERING, INC.


PREPARED FOR:  
**4-WAY RANCH JOINT VENTURE**  
**PETER MARTZ**  
 P.O. BOX 50223  
 COLORADO SPRINGS, CO 80949  
 719-491-3150

721 S. 2960 STREET  
 COLORADO SPRINGS, CO 80904  
 OFFICE: 719-635-6422  
 FAX: 719-635-6426  
 www.tneshc.com

**WATERBURY FILING NO. 1**


CONSTRUCTION SET  
 STREET PLAN AND PROFILE  
 BEECH CREEK CIRCLE

DESIGNED BY QNA  
 DRAWN BY QNA  
 CHECKED BY  
 H-SCALE 1"=50'  
 V-SCALE 1"=5'  
 JOB NO. 1715.00  
 DATE ISSUED 2/6/23  
 SHEET NO. 14 OF 39

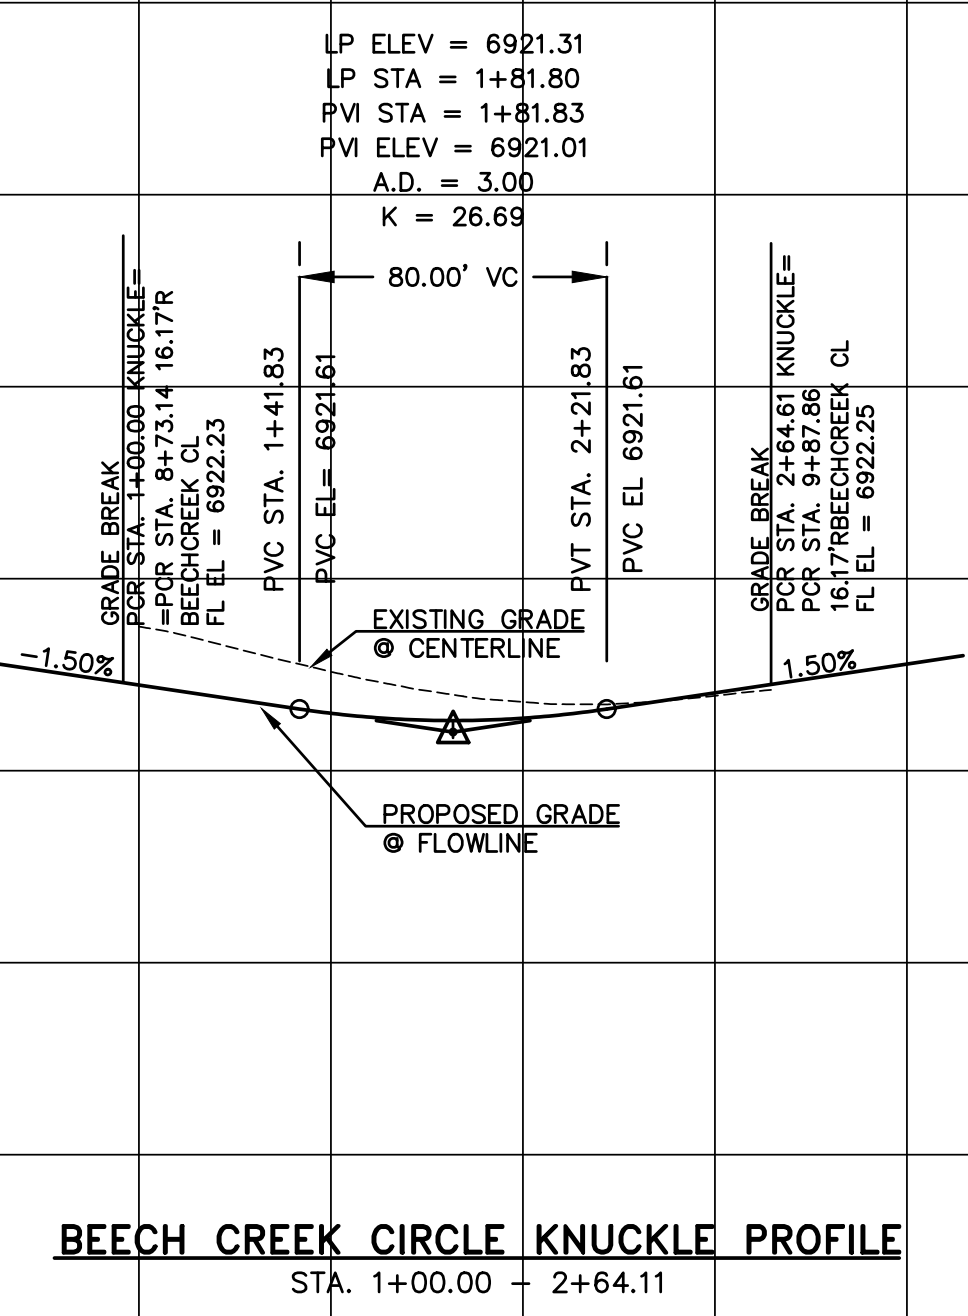


**BEECH CREEK CIRCLE KNUCKLE PROFILE**  
 STA. 1+00.00 - 2+64.11

MATCHLINE - STA. 8+00.00  
 SEE SHEET 13

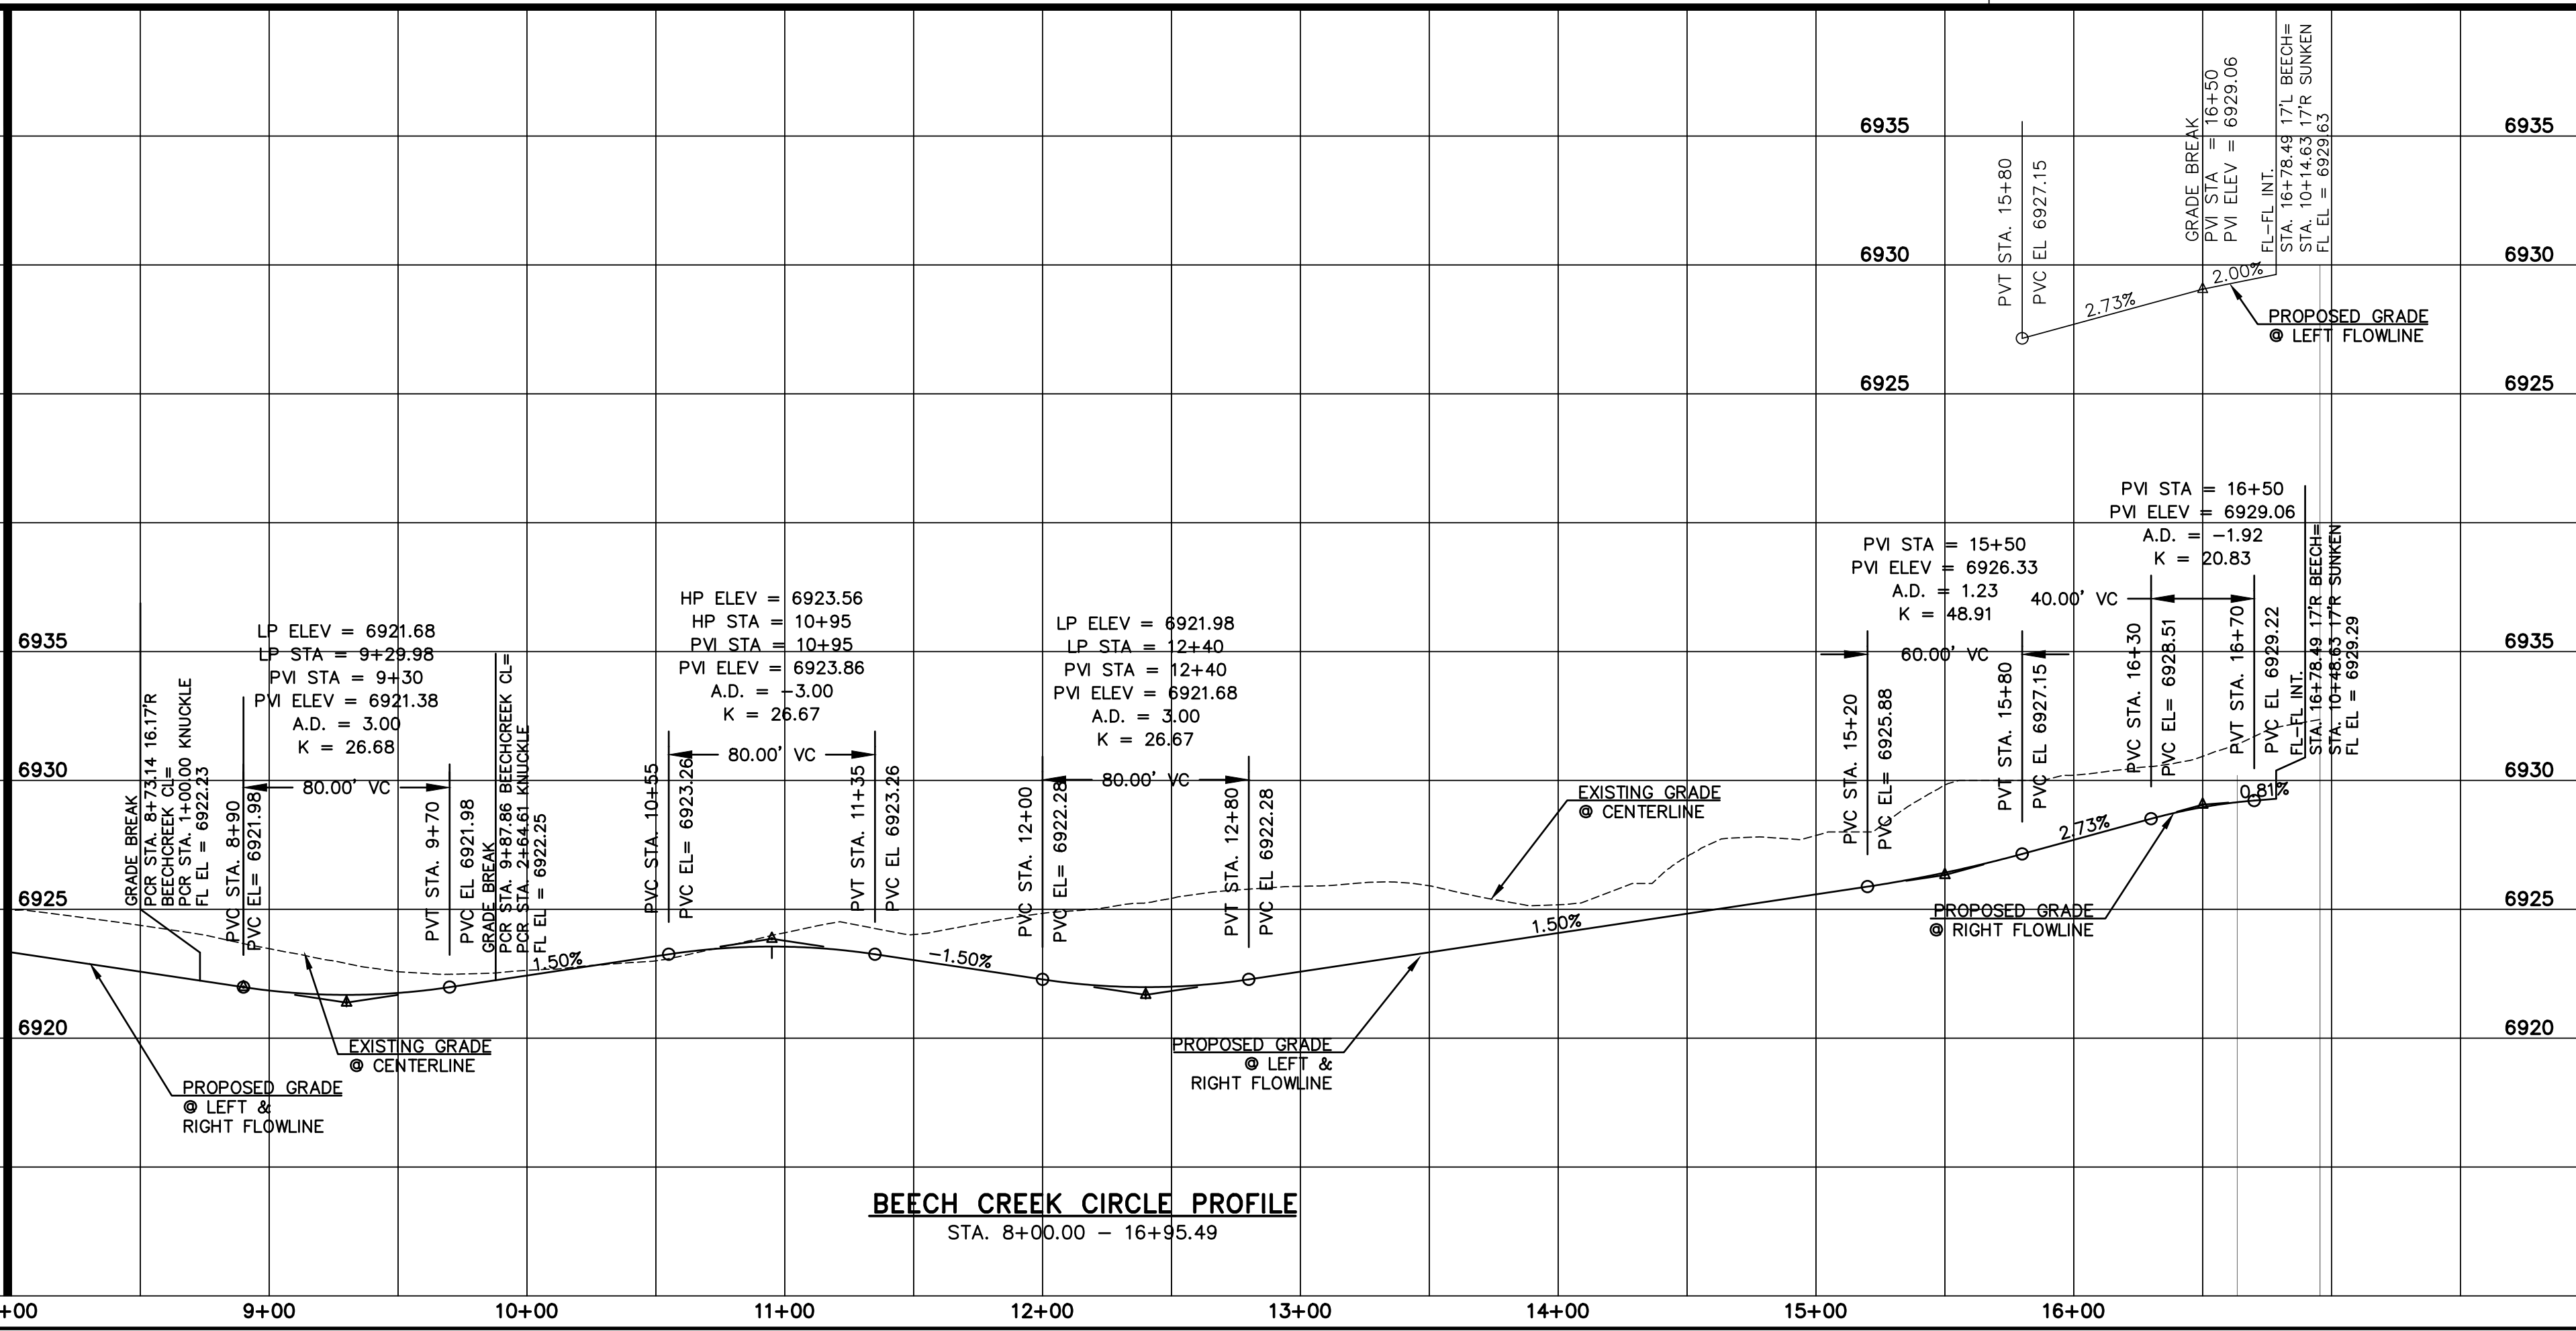


**BEECH CREEK CIRCLE PROFILE**  
 STA. 8+00.00 - 16+95.49



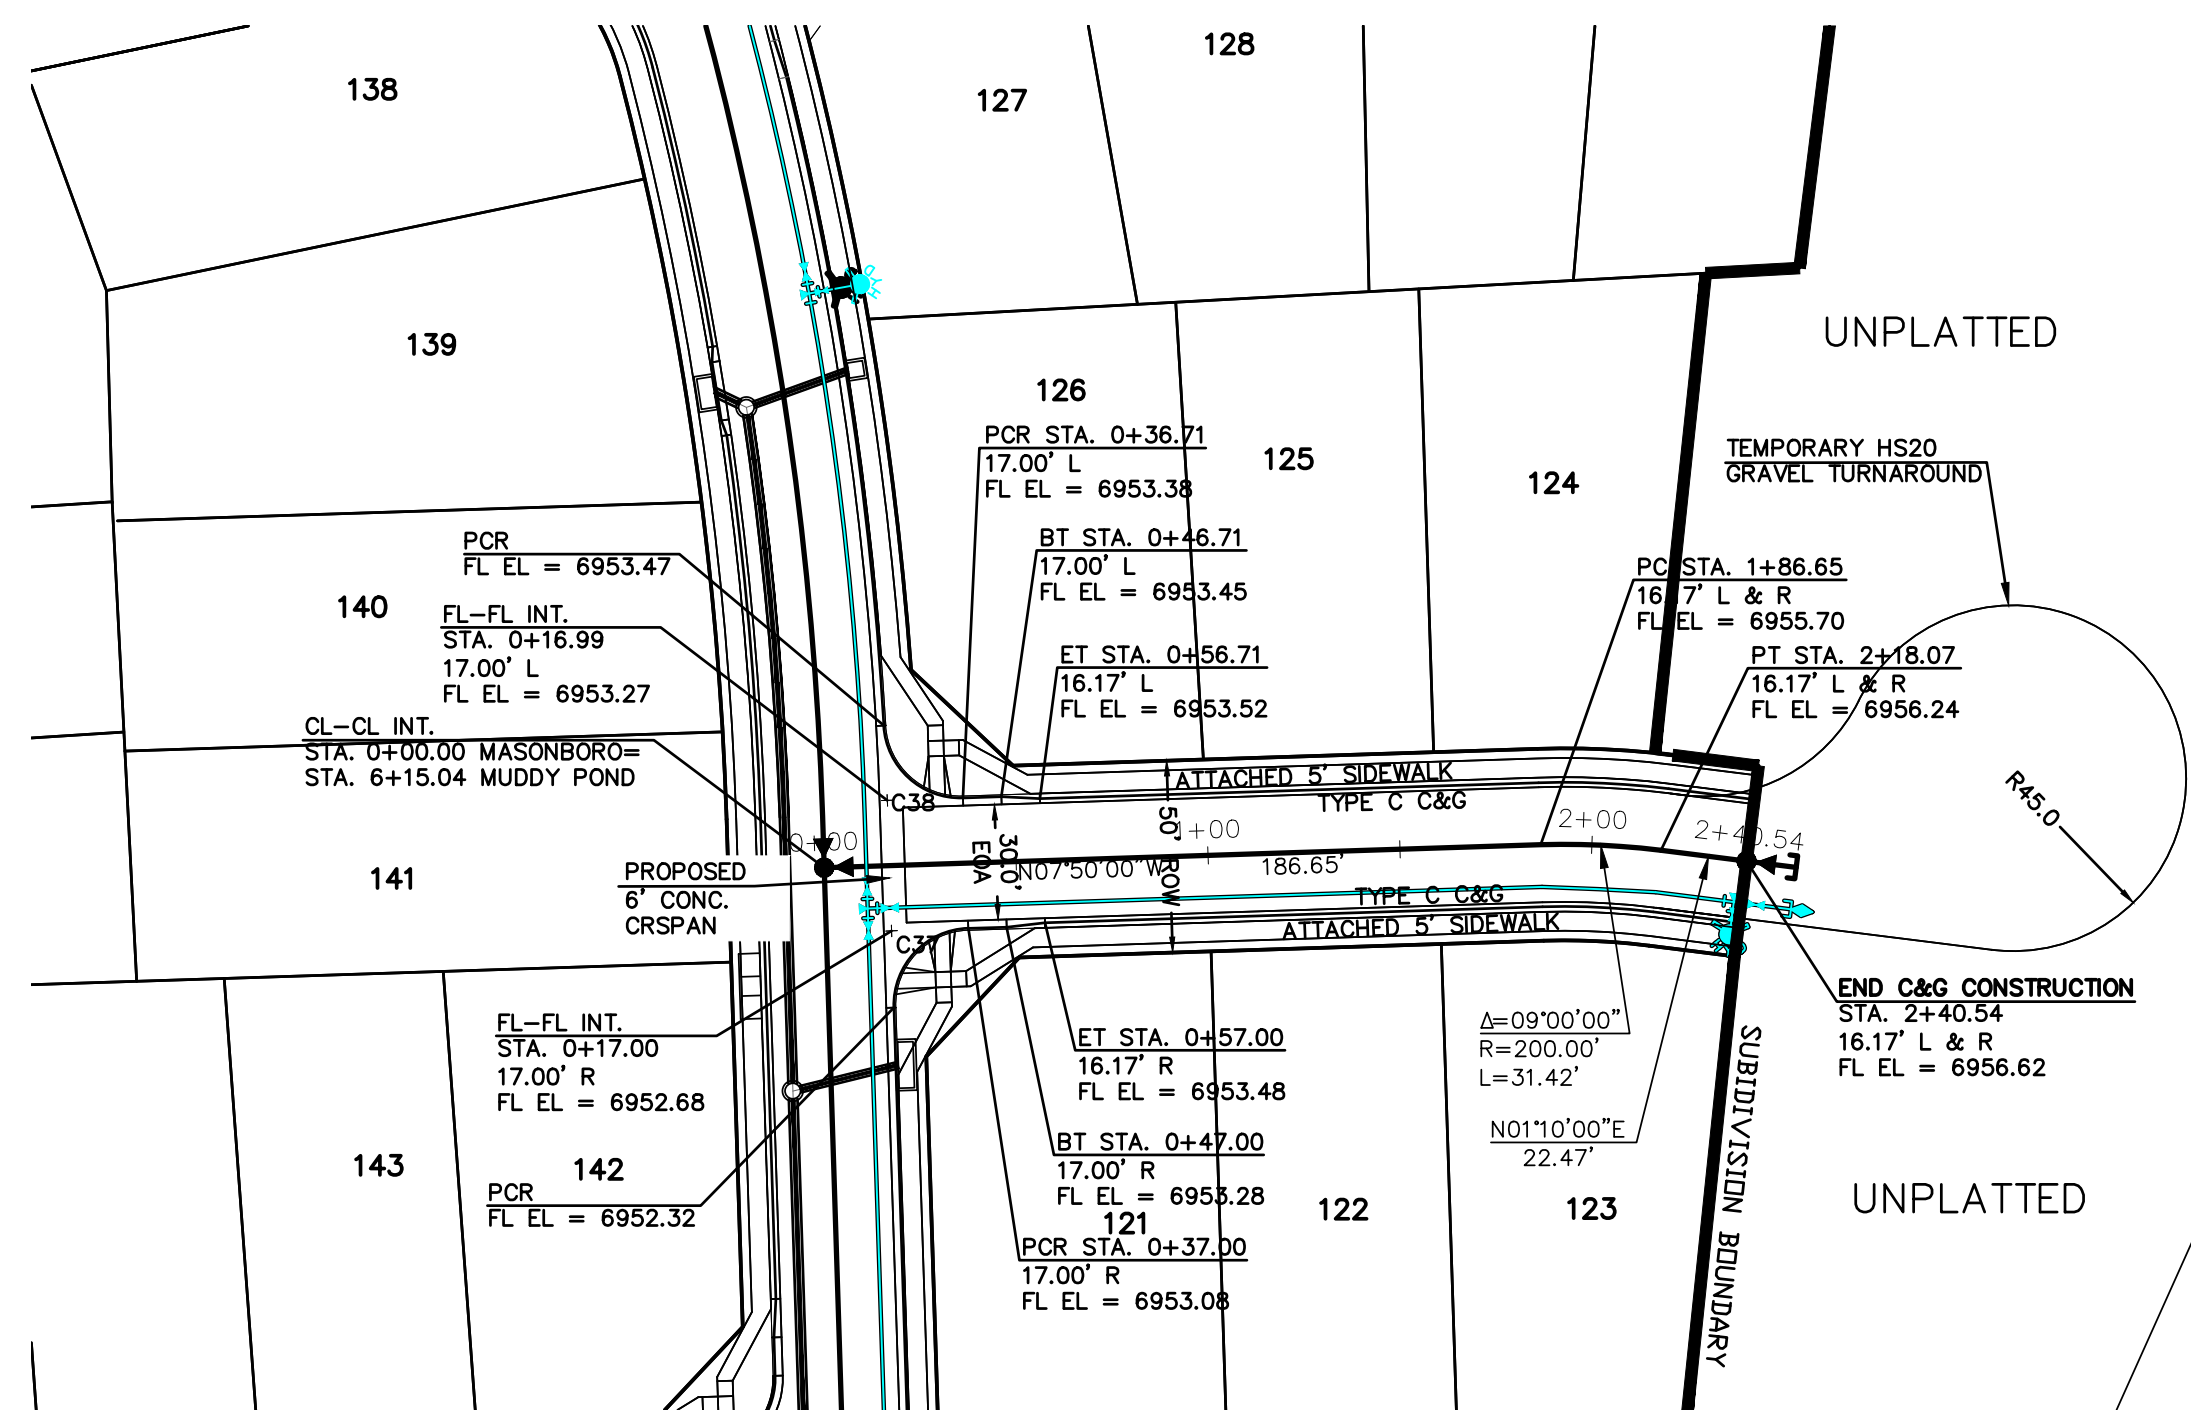

CURB RETURN CURVE TABLE			
CURVE	LENGTH	RADIUS	DELTA
C35	32.03'	20.00'	91°44'53"
C36	32.03'	20.00'	91°44'53"
C37	31.42'	20.00'	90°00'00"
C38	30.92'	20.00'	88°34'27"

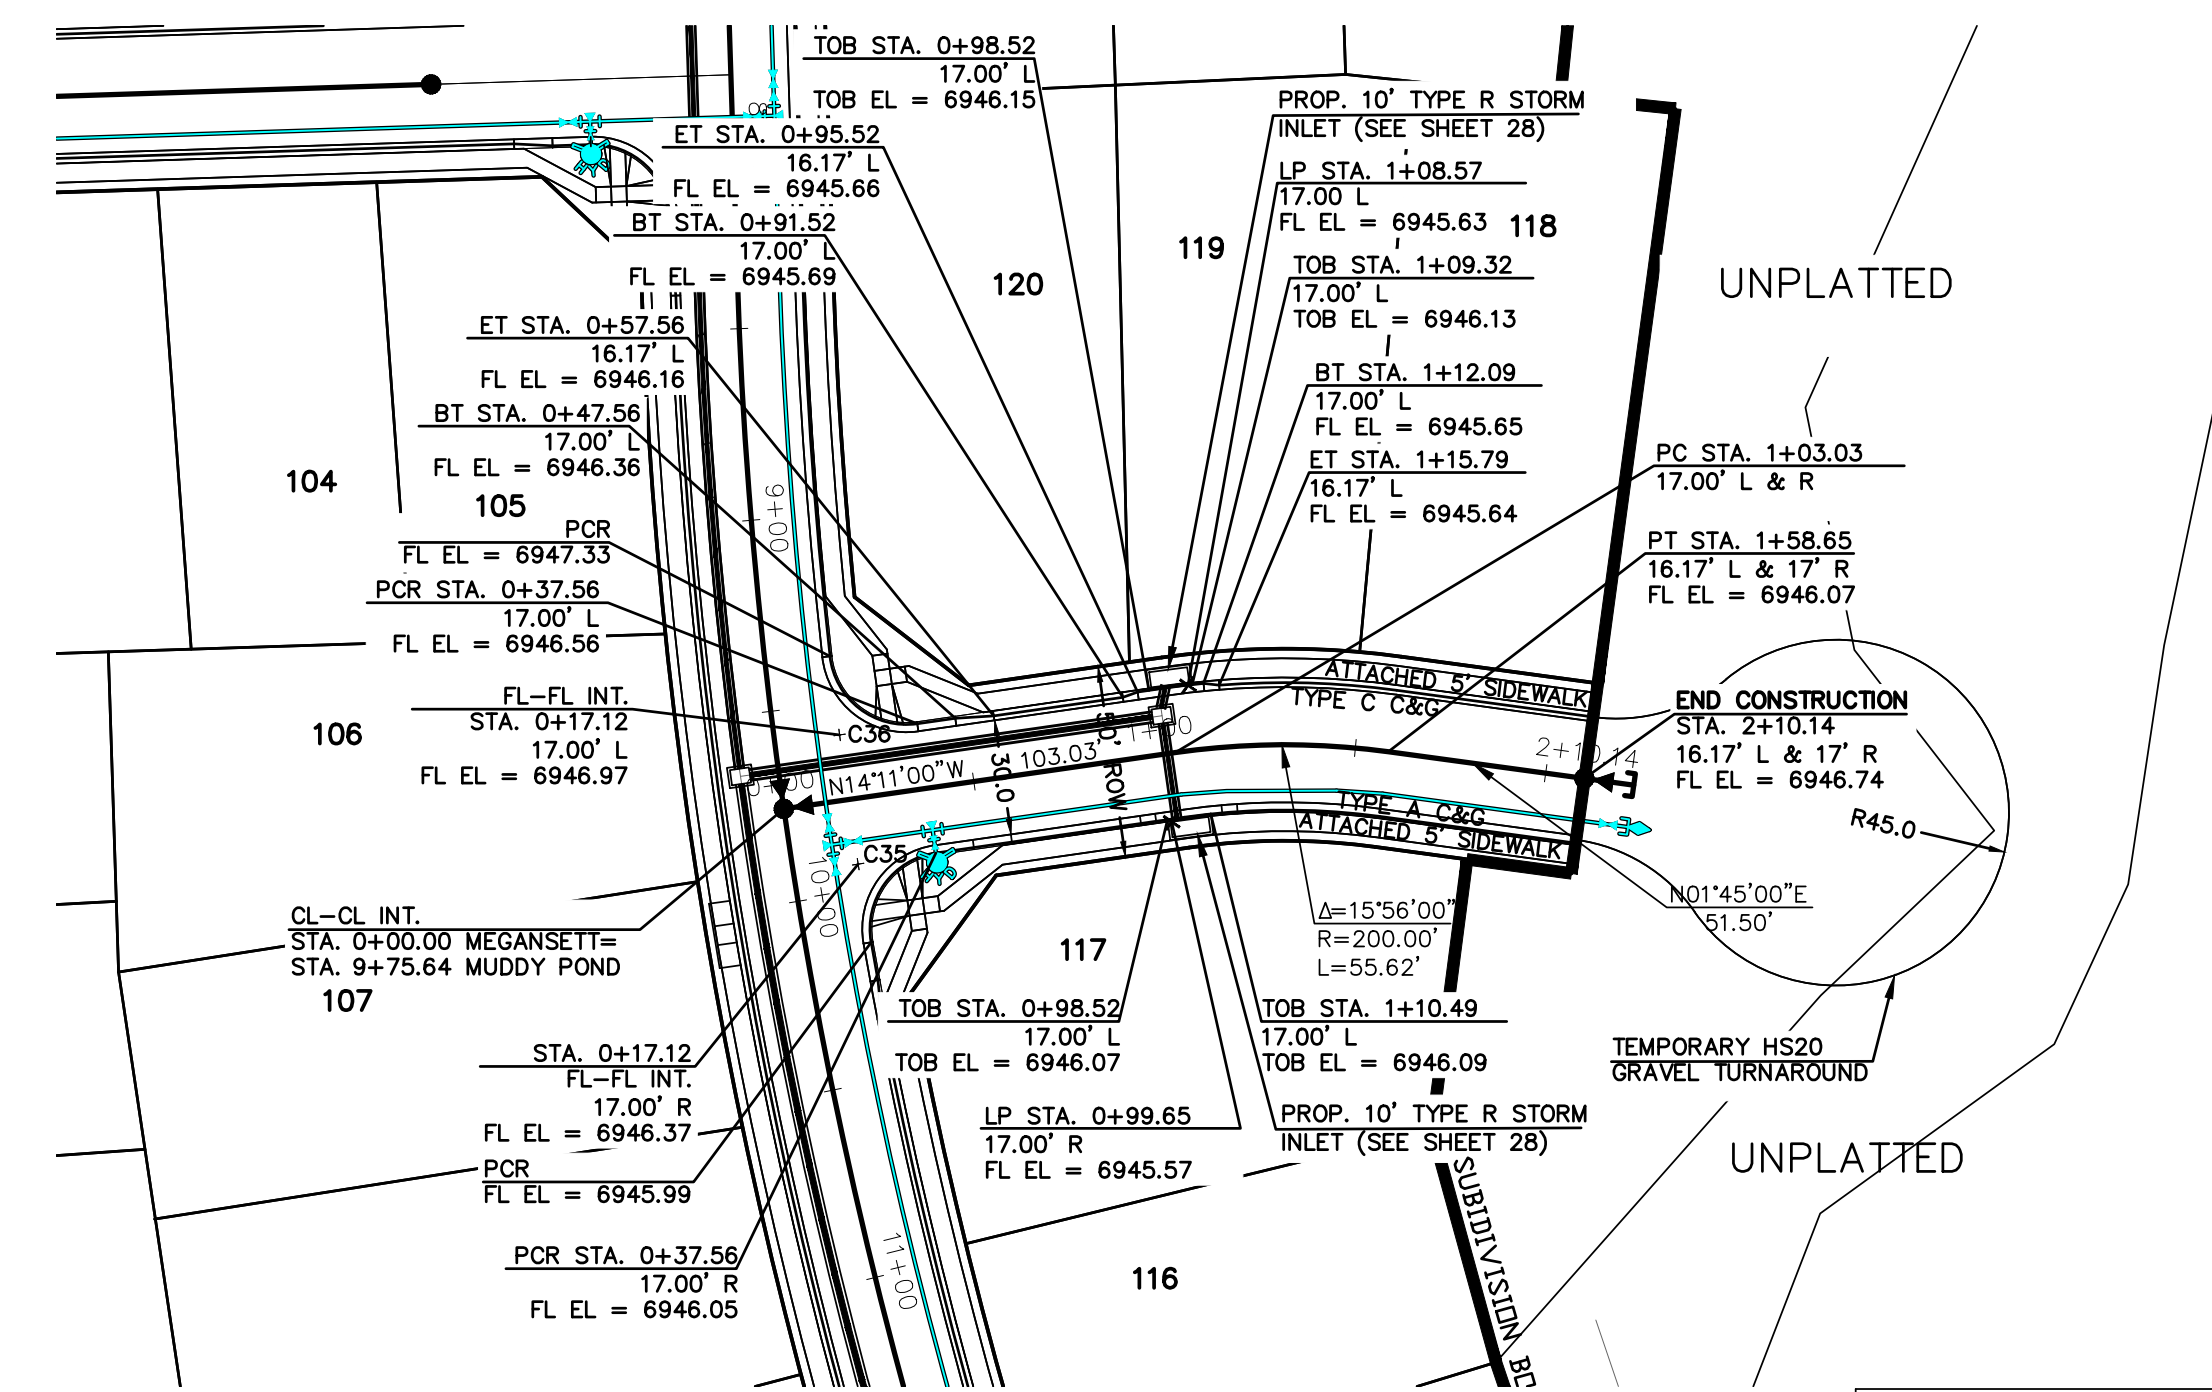


**MASONBORO WAY**  
 STA. 0+00.00 - 2+40.54 - URBAN LOCAL  
 (DESIGN SPEED 25 MPH)  
 (POSTED SPEED LIMIT IS 25 MPH)


**MEGANSETT WAY**  
 STA. 0+00.00 - 2+10.14 - URBAN LOCAL  
 (DESIGN SPEED 25 MPH)  
 (POSTED SPEED LIMIT IS 25 MPH)

THIS DESIGN WAS PREPARED UNDER MY DIRECT SUPERVISION  
 FOR AND ON BEHALF OF TERRA NOVA ENGINEERING, INC.

QUENTIN N. ARMUO, PROFESSIONAL ENGINEER  
 COLORADO P.E. NO. 37170

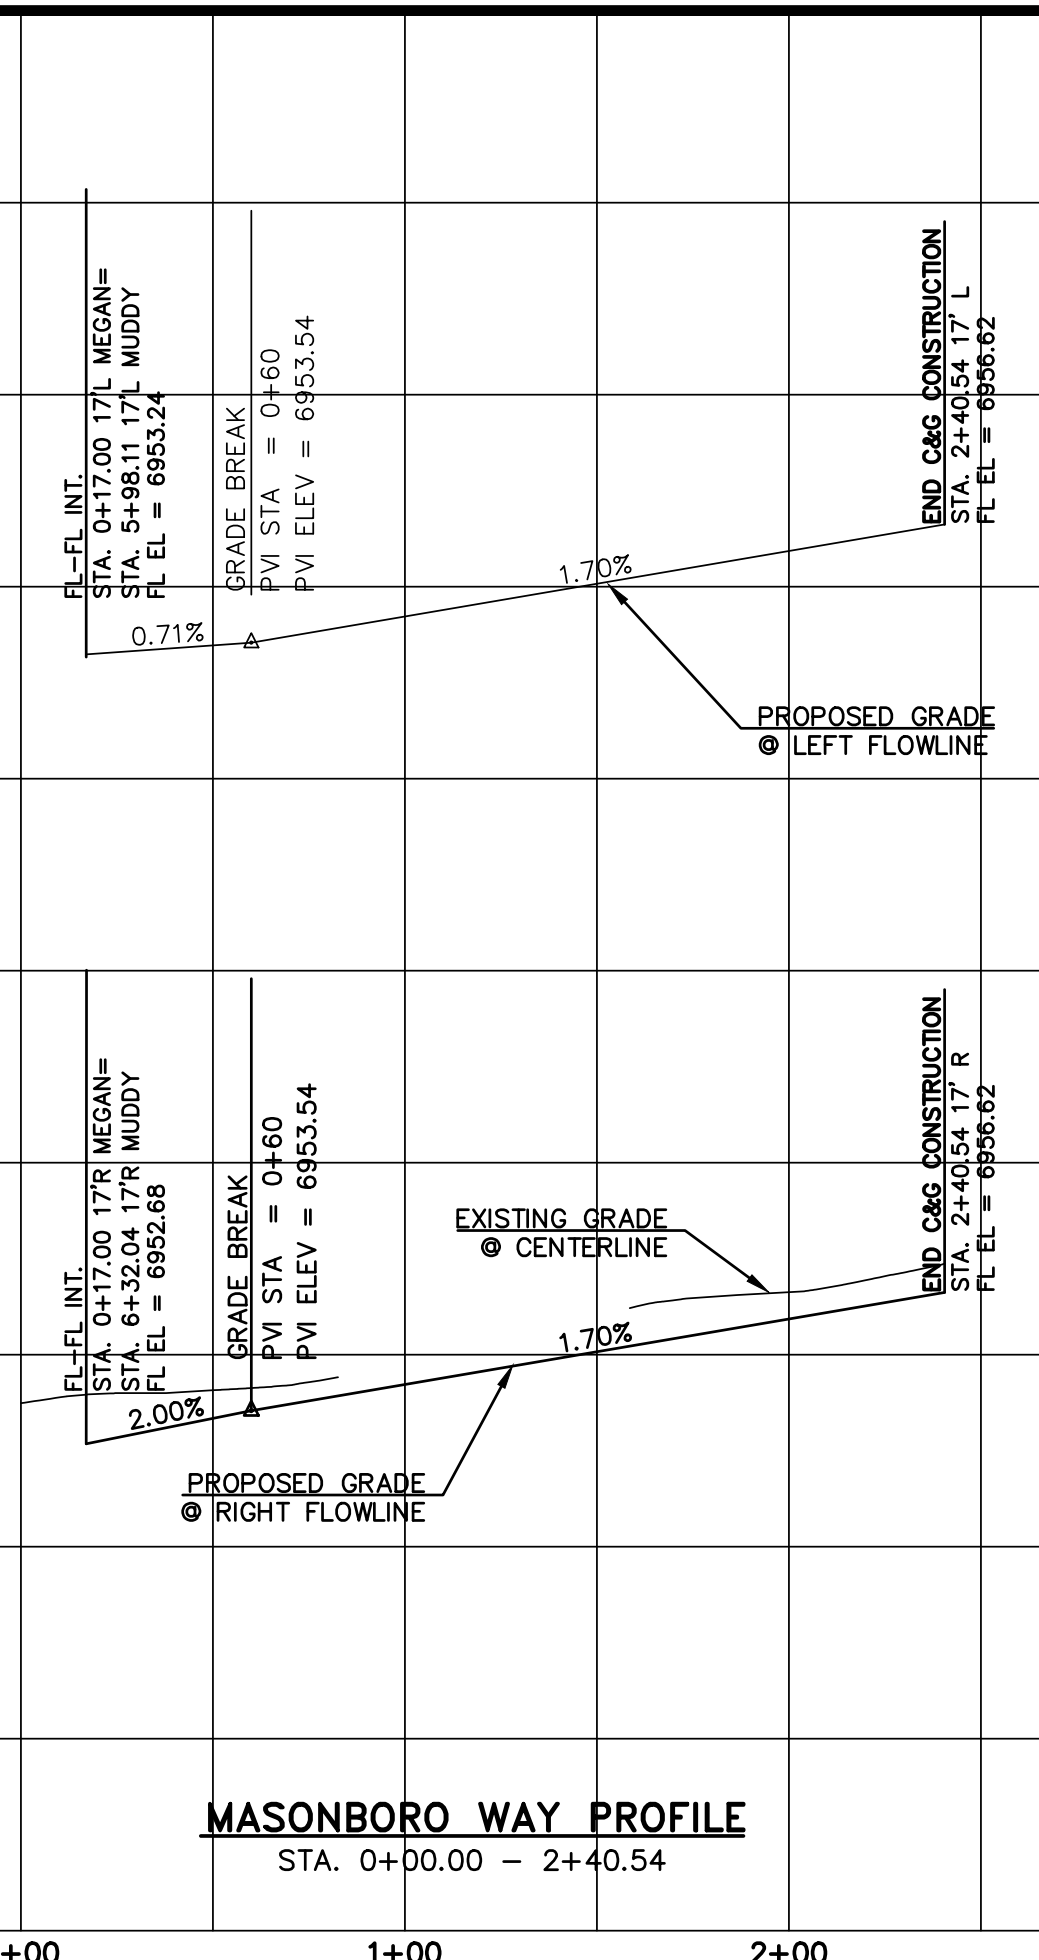

**MASONBORO WAY PROFILE**  
 STA. 0+00.00 - 2+40.54

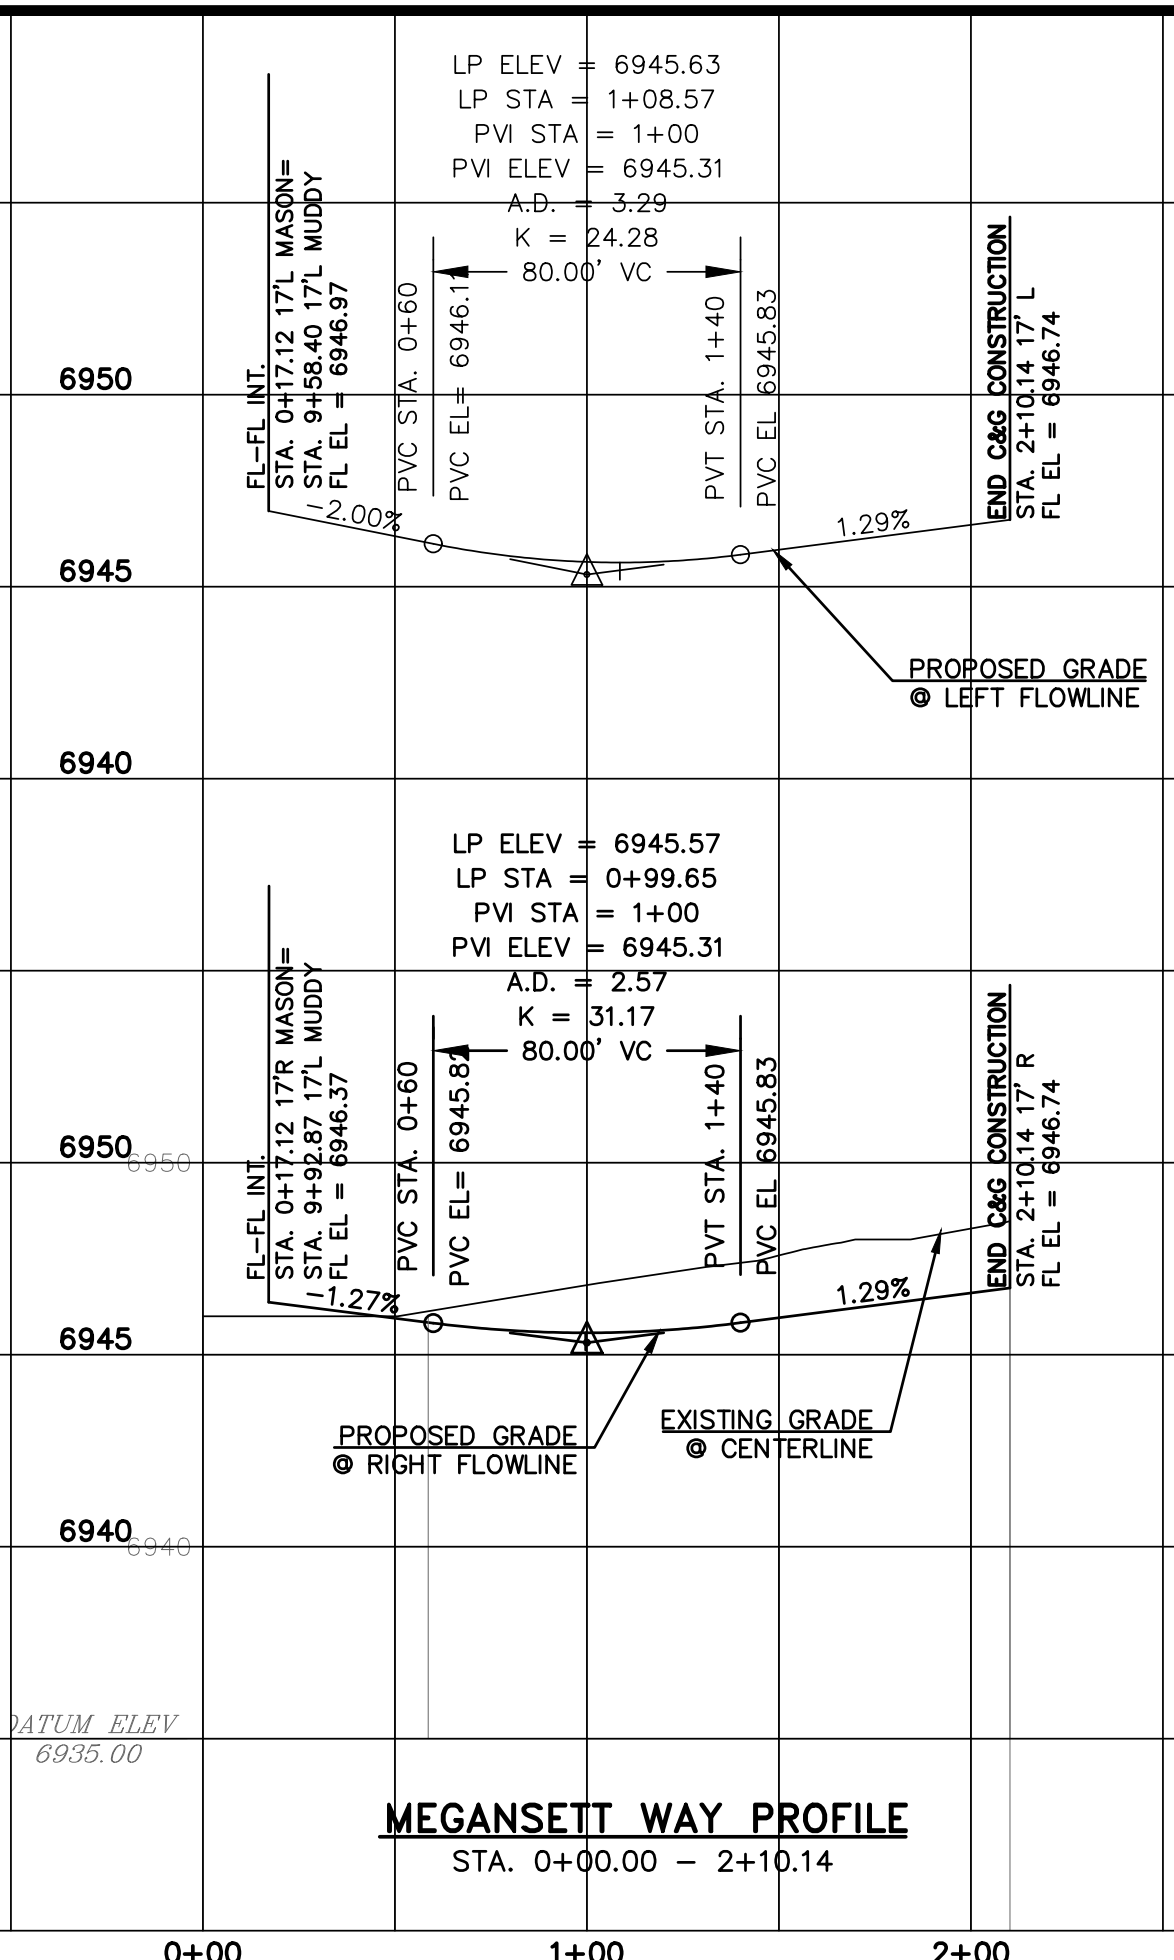


**MEGANSETT WAY PROFILE**  
 STA. 0+00.00 - 2+10.14

REVISIONS	NO.	DESCRIPTION	DATE

UNTIL SUCH TIME AS THESE DRAWINGS ARE APPROVED BY THE REVIEW AGENCIES FOR THE TERRA NOVA ENGINEERING AND SURVEYING, INC. APPROVED FOR THEIR USE ONLY AS DESIGNATED BY WRITTEN AUTHORIZATION.

PREPARED FOR:  
**4-WAY RANCH JOINT VENTURE**  
**PETER MARTZ**  
 P.O. BOX 50223  
 COLORADO SPRINGS, CO 80949  
 719-491-3150





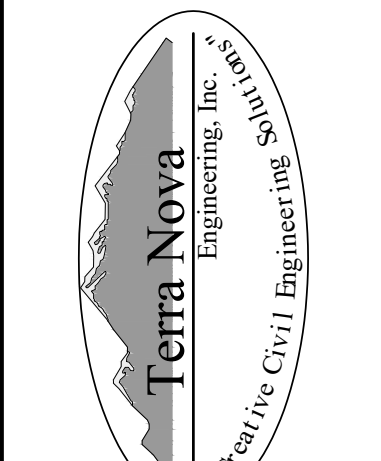


721 S. 2960 STREET  
 COLORADO SPRINGS, CO 80904  
 OFFICE: 719-635-6422  
 FAX: 719-635-6426  
 www.tneshinc.com


**WATERBURY FILING NO. 1**  
 CONSTRUCTION SET  
 STREET PLAN AND PROFILE  
 MANOR HAVEN WAY

DESIGNED BY QNA  
 DRAWN BY QNA  
 CHECKED BY  
 H-SCALE 1"=50'  
 V-SCALE 1"=5'  
 JOB NO. 1715.00  
 DATE ISSUED 2/6/23  
 SHEET NO. 16 OF 39



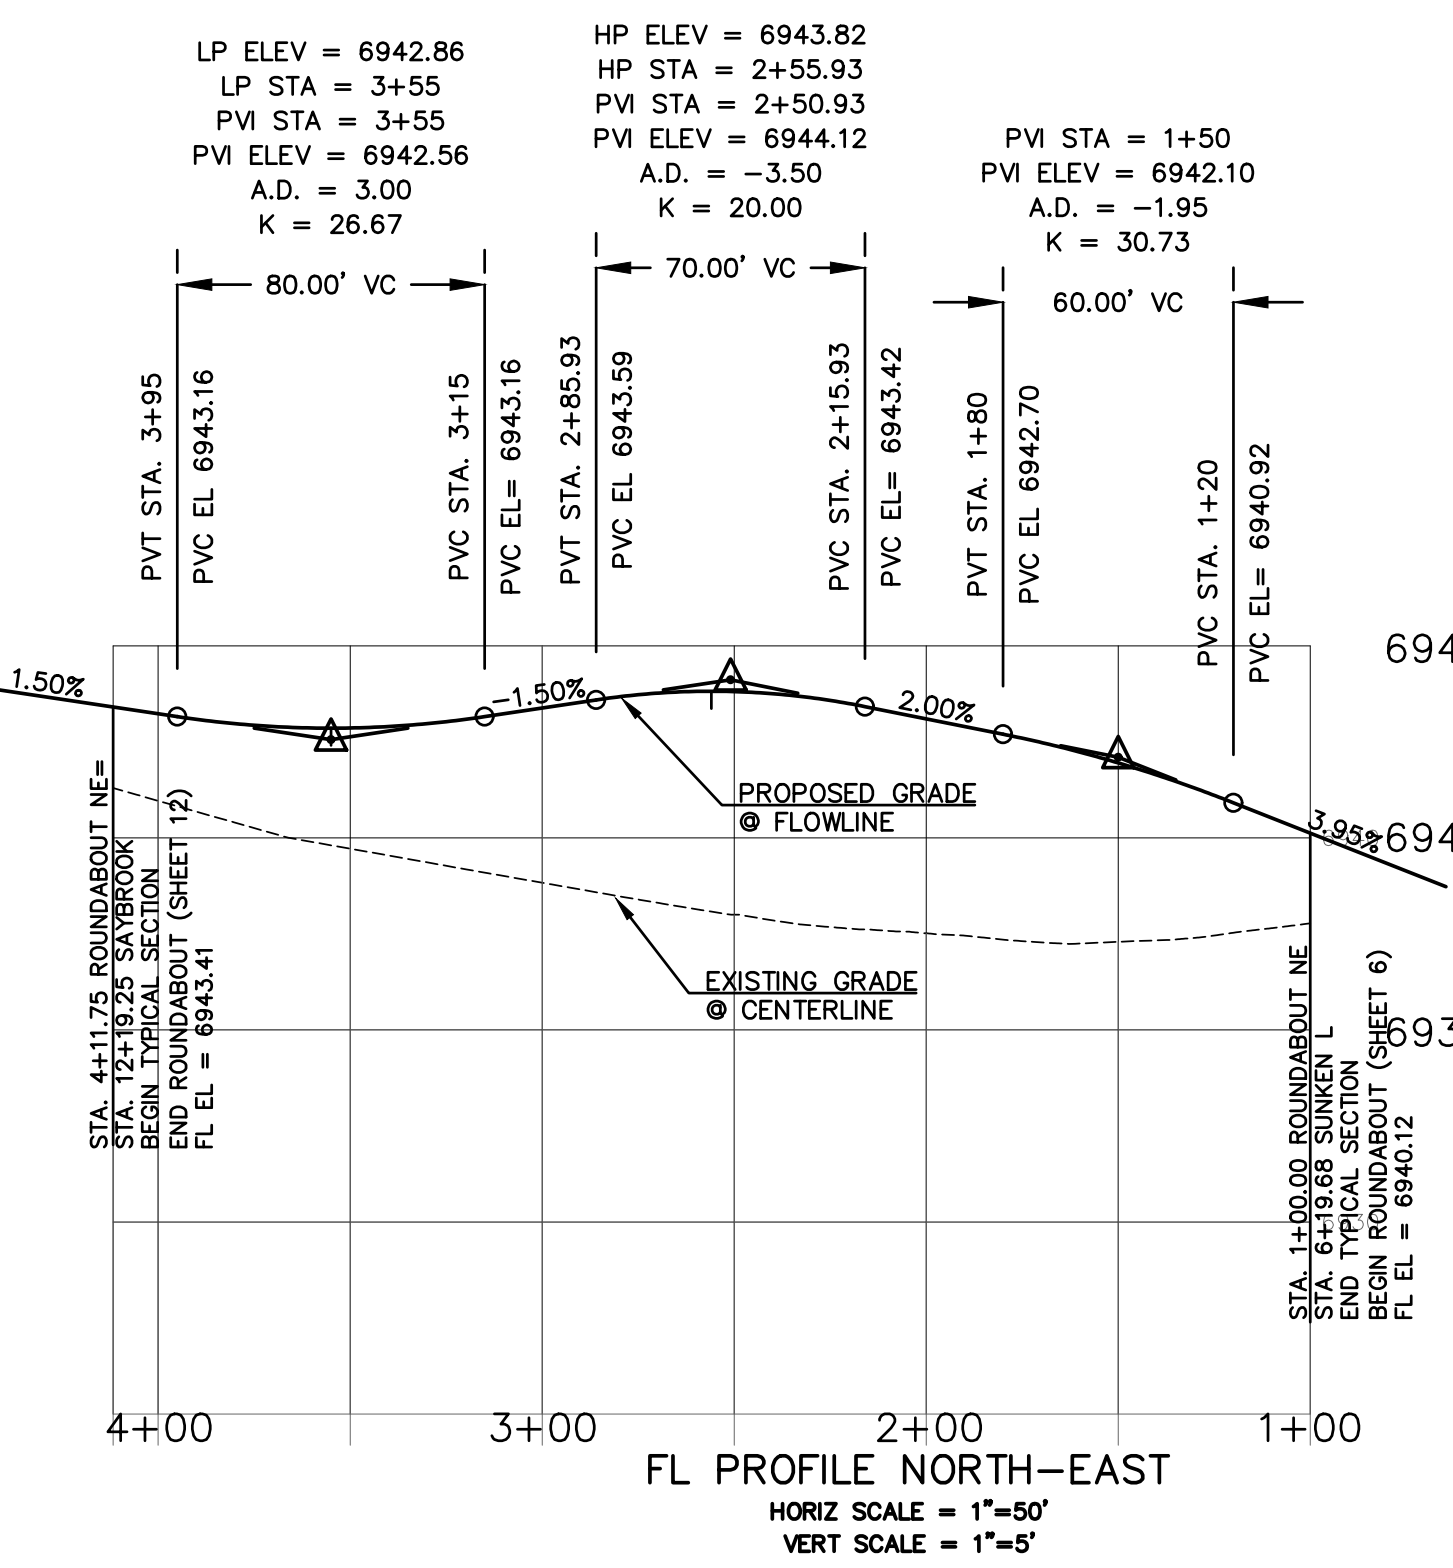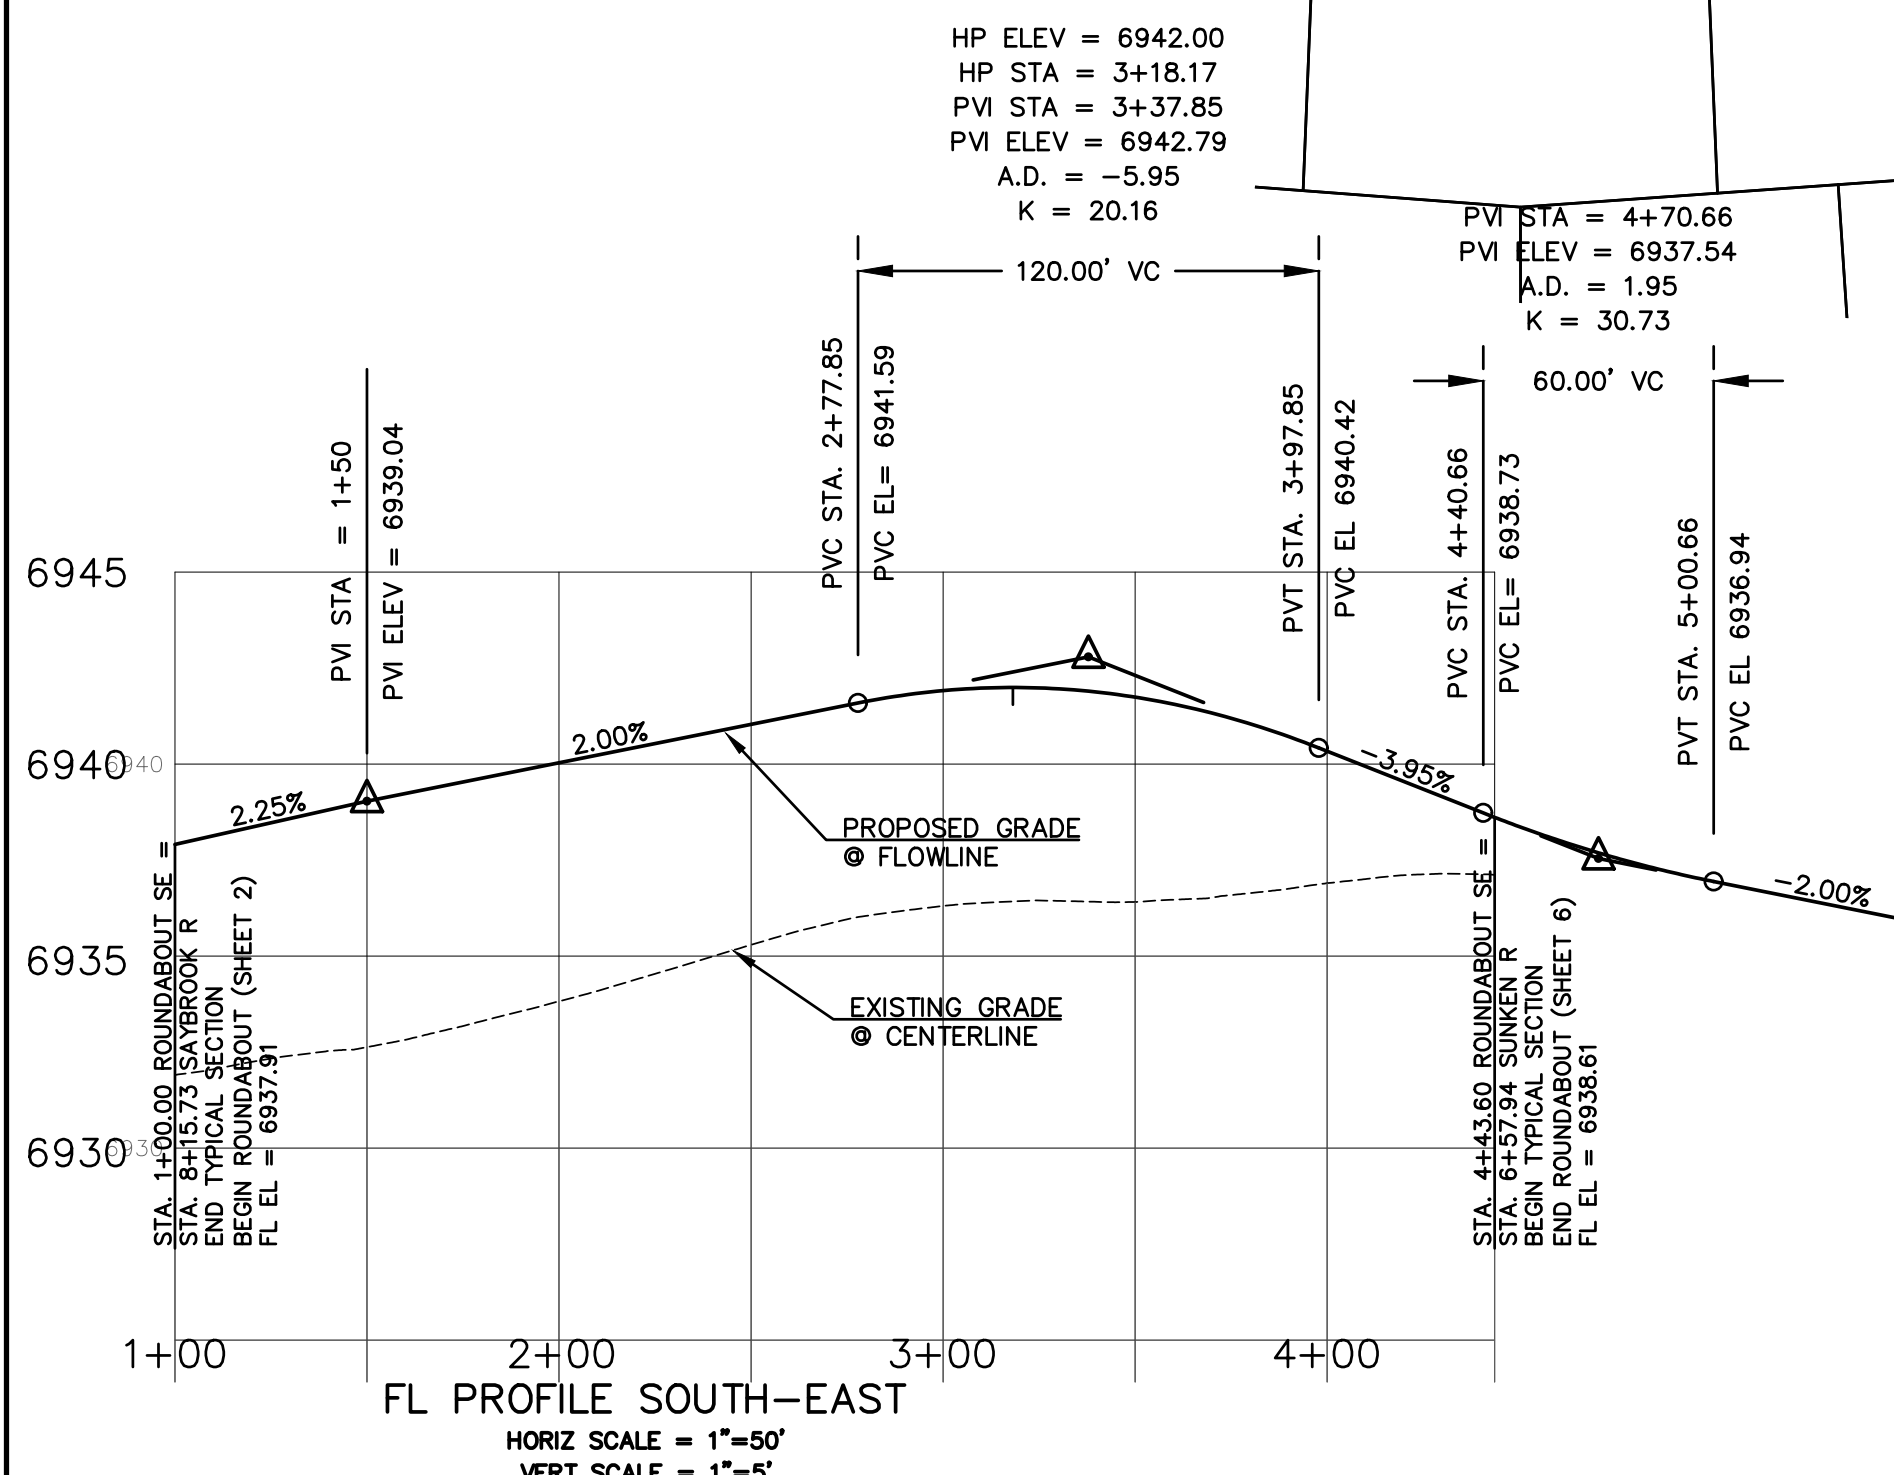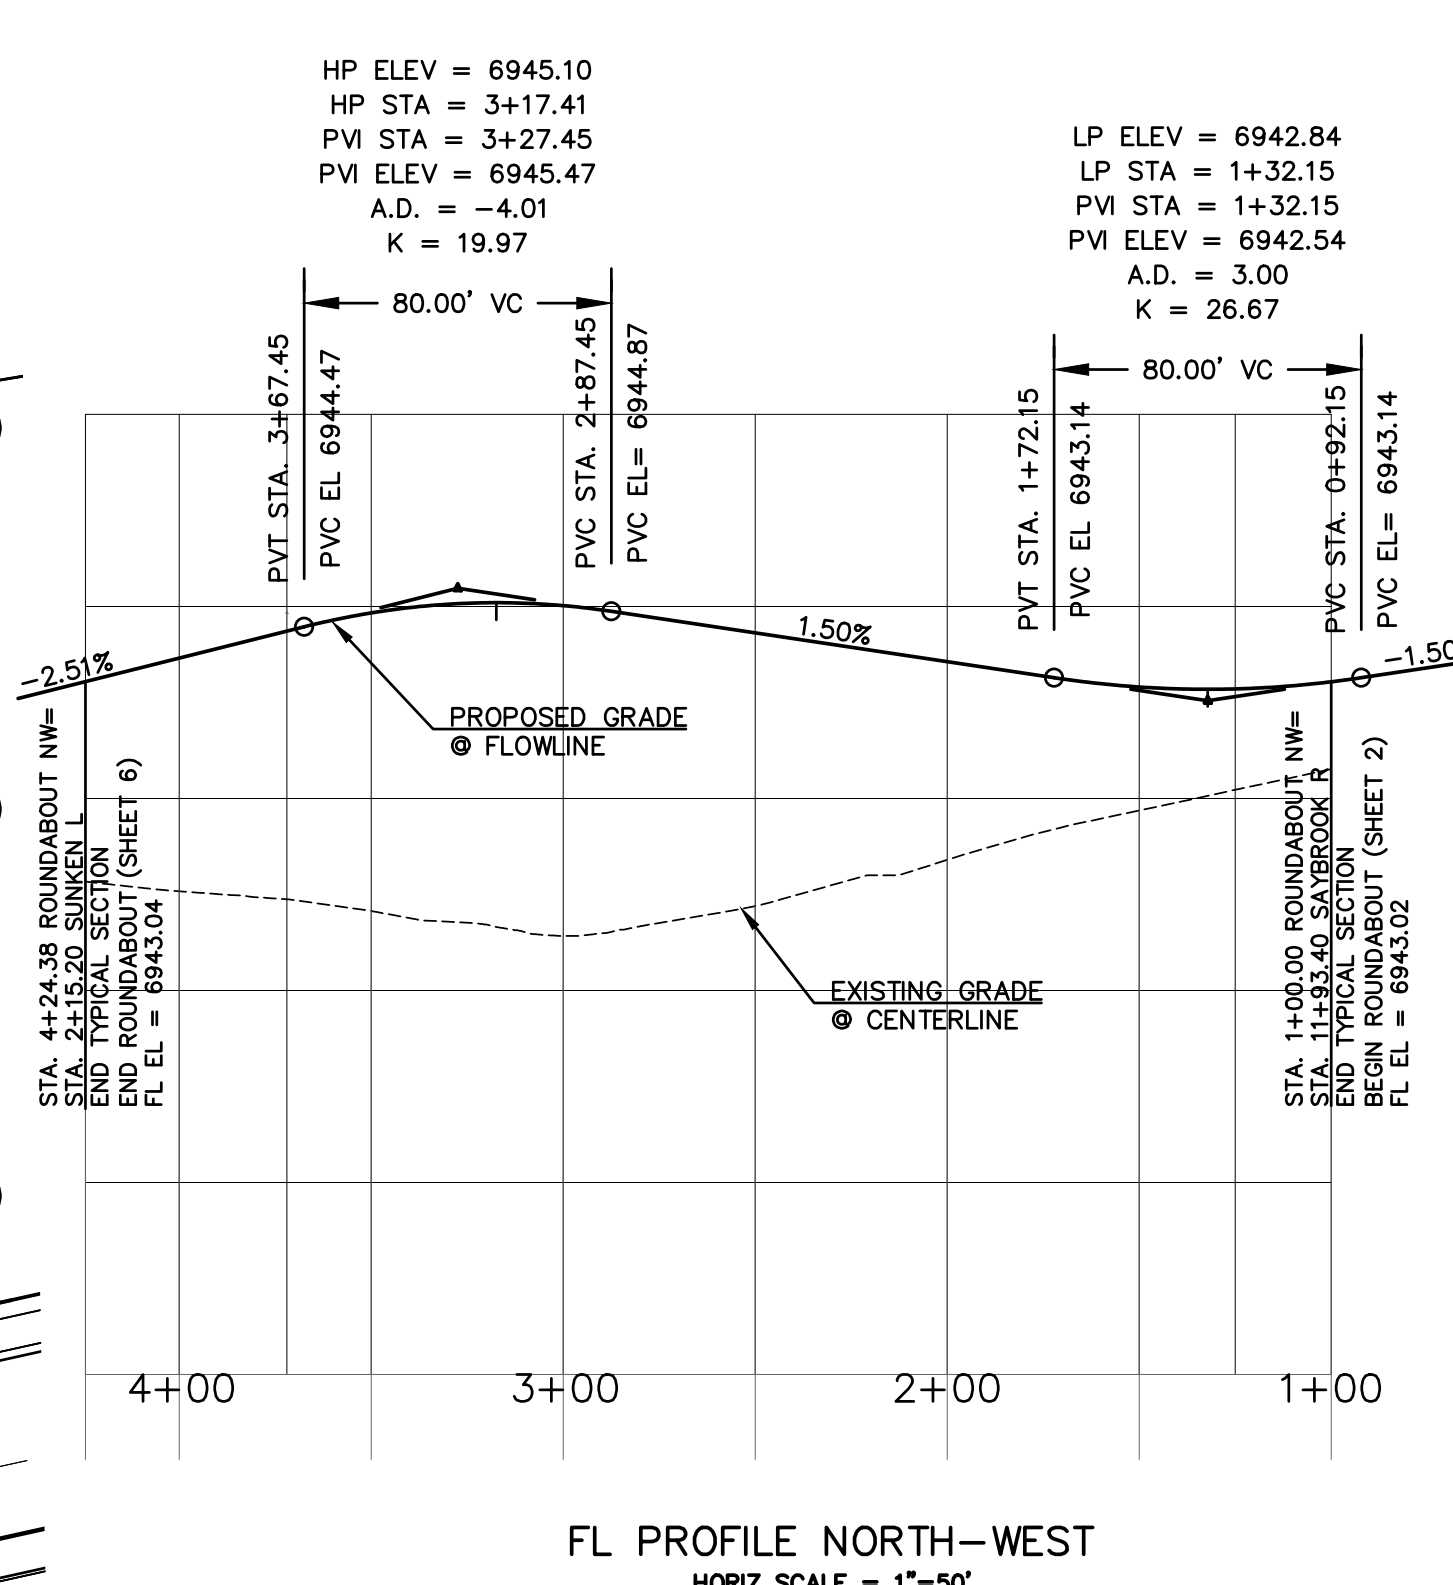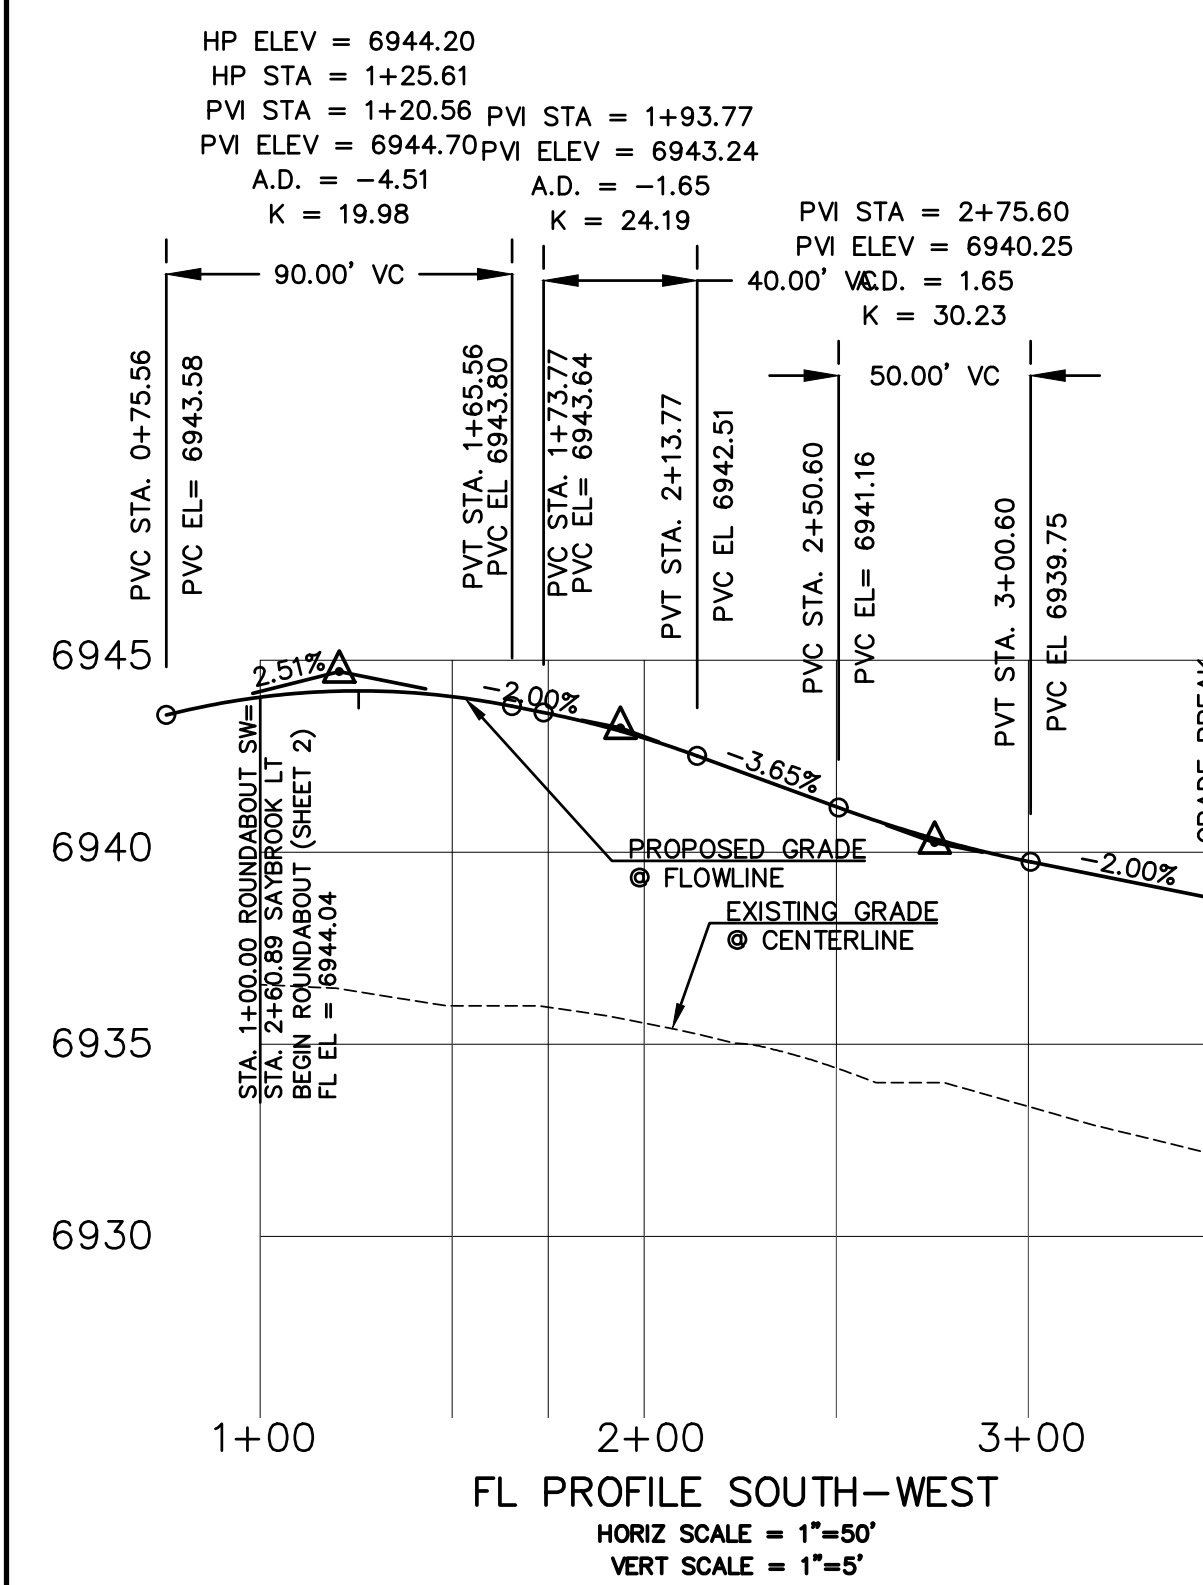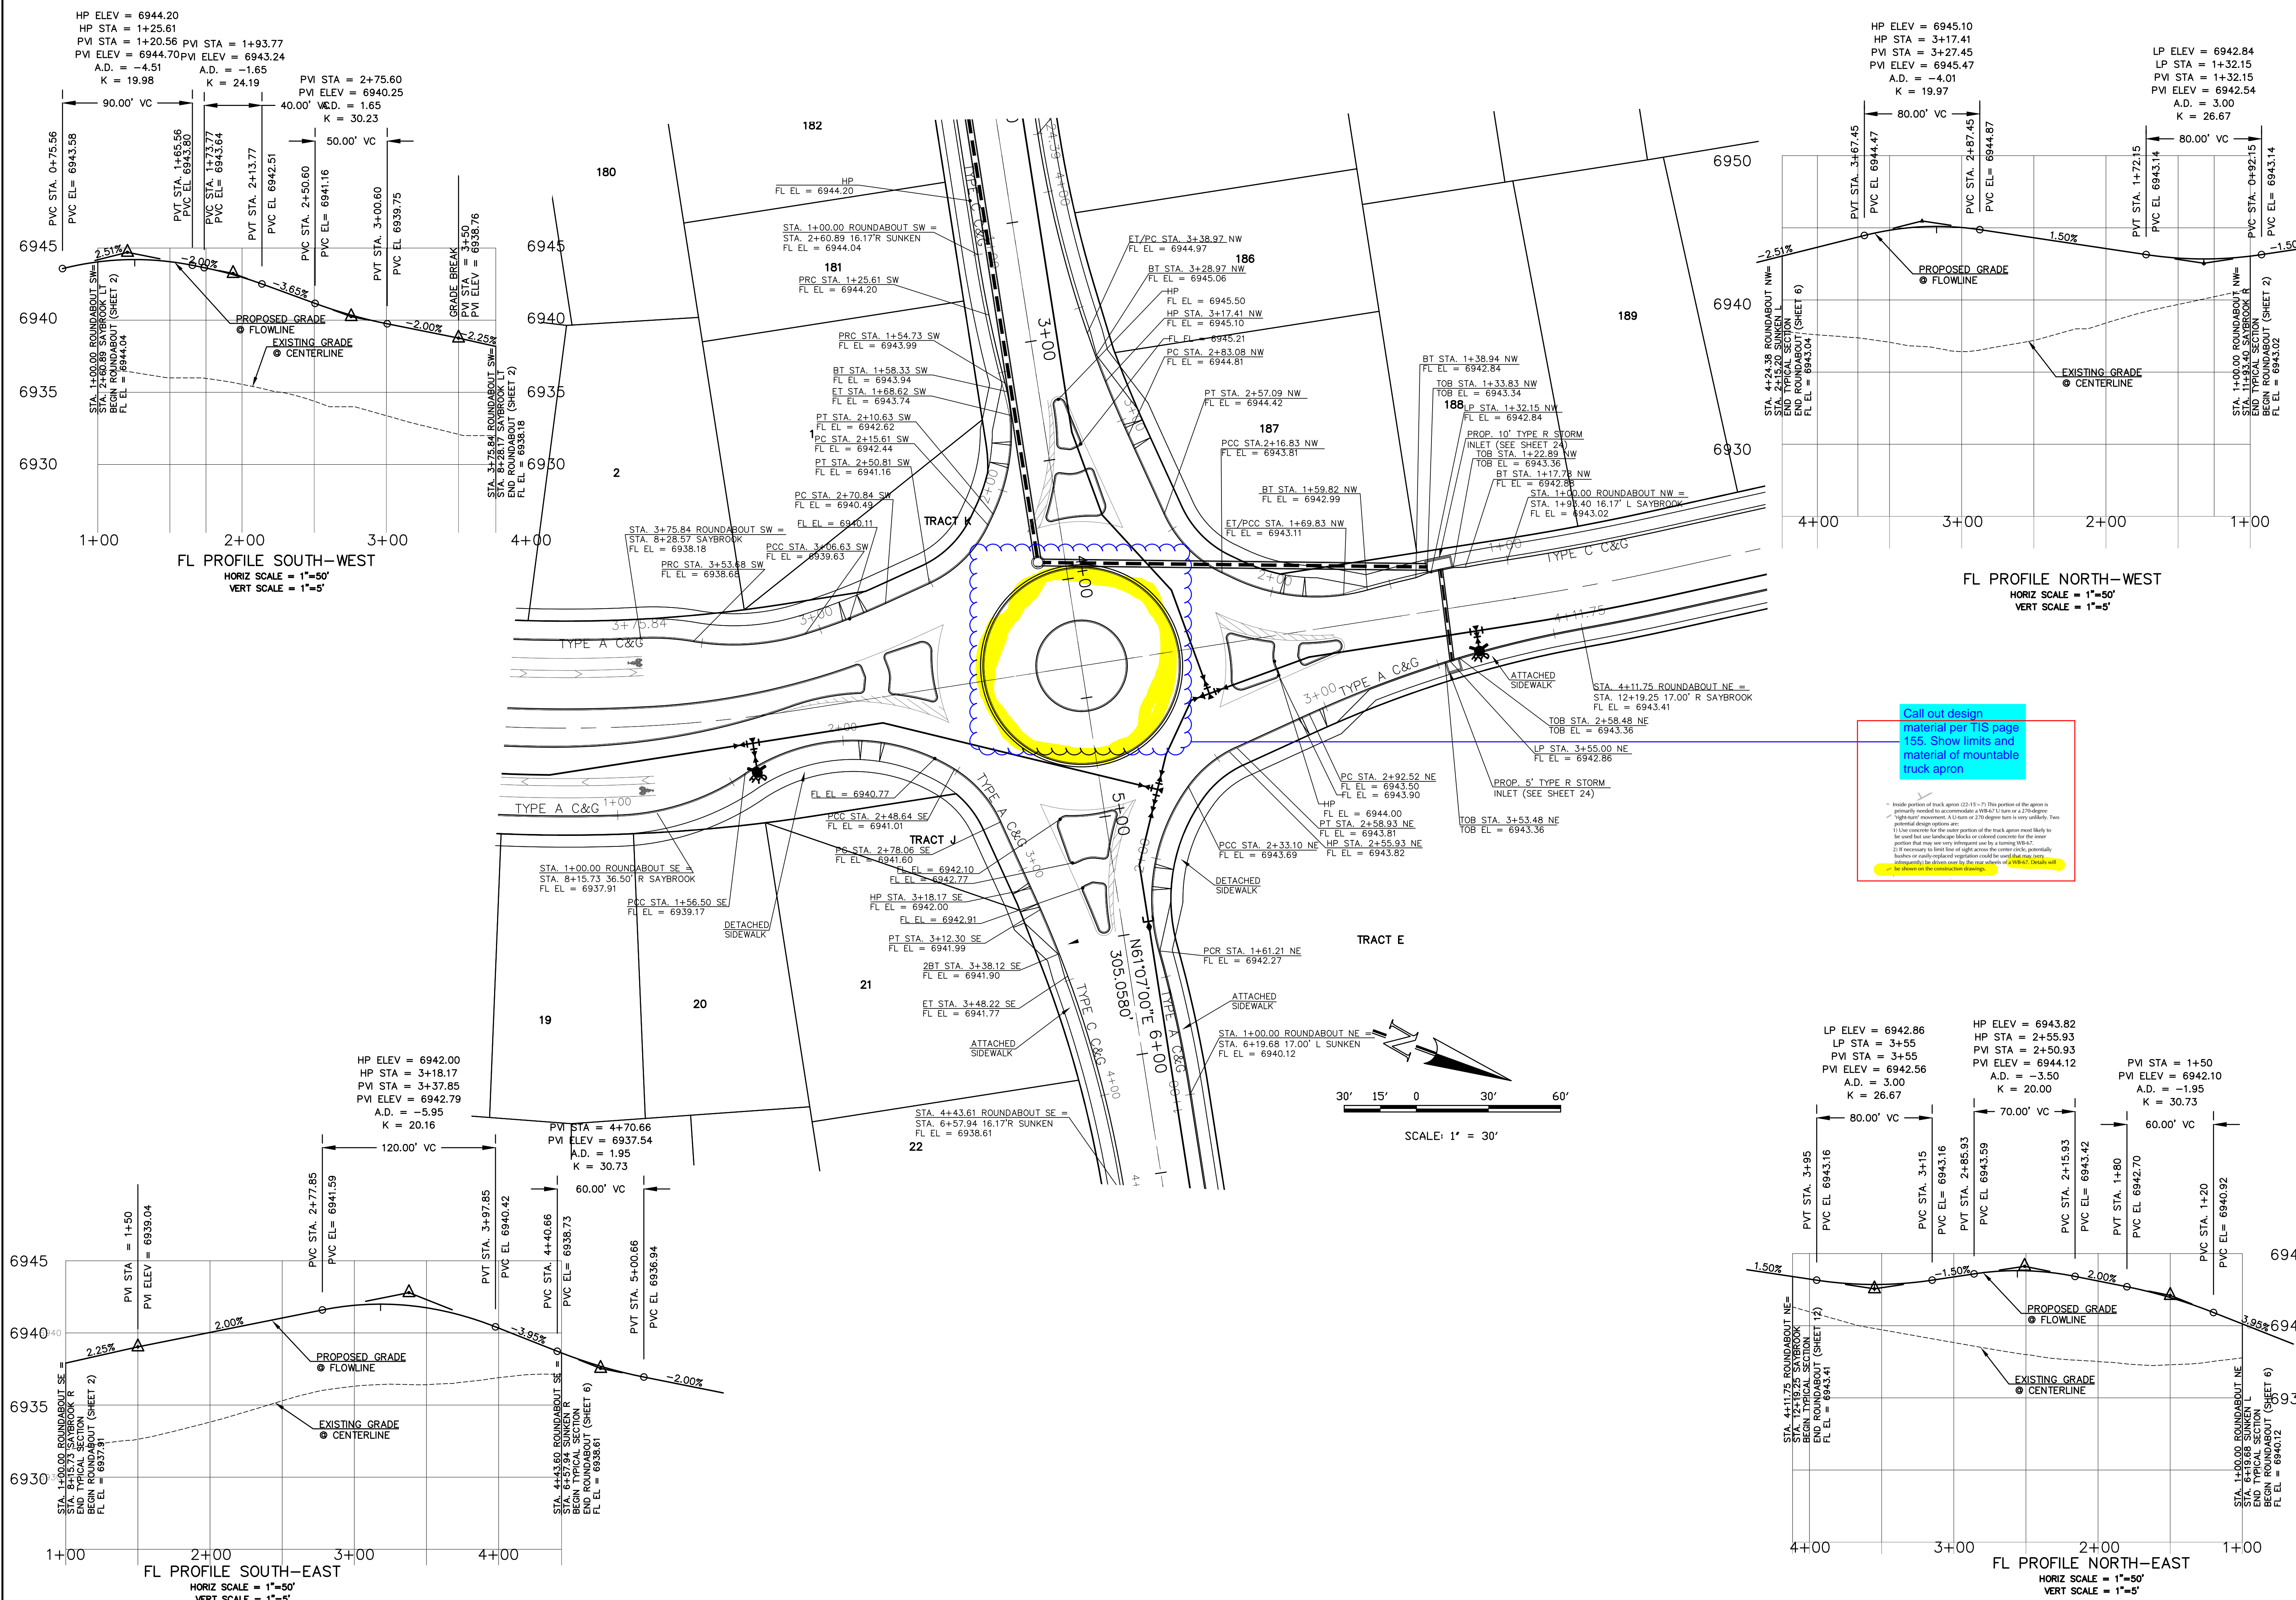


DATE	
DESCRIPTION	
NO.	
REVISIONS	
UNTIL SUCH TIME AS THESE DRAWINGS ARE APPROVED BY THE ENGINEER, THE USER SHALL BE RESPONSIBLE FOR ANY ERRORS OR OMISSIONS. TERRA NOVA ENGINEERING, INC. APPROVES THEIR USE ONLY FOR THE PROJECT AND SITE SPECIFICALLY IDENTIFIED BY WRITTEN AUTHORIZATION.	
PREPARED FOR: <b>4-WAY RANCH JOINT VENTURE</b> ATTN: PETER MARTZ COLORADO SPRINGS, CO 80949 P.O. BOX 50223 COLORADO SPRINGS, CO 80949 719-491-3150	
721 S. Z3RD STREET COLORADO SPRINGS, CO 80904 OFFICE: 719-635-6422 FAX: 719-635-6426 www.tnainc.com	
<b>WATERBURY FILING NO. 1</b> CONSTRUCTION SET ROUNDABOUT DETAILED GRADING	
DESIGNED BY DLF DRAWN BY QNA CHECKED BY QNA H-SCALE NA V-SCALE N/A JOB NO. 1715.00 DATE ISSUED 2/6/23 SHEET NO. 17 OF 39	

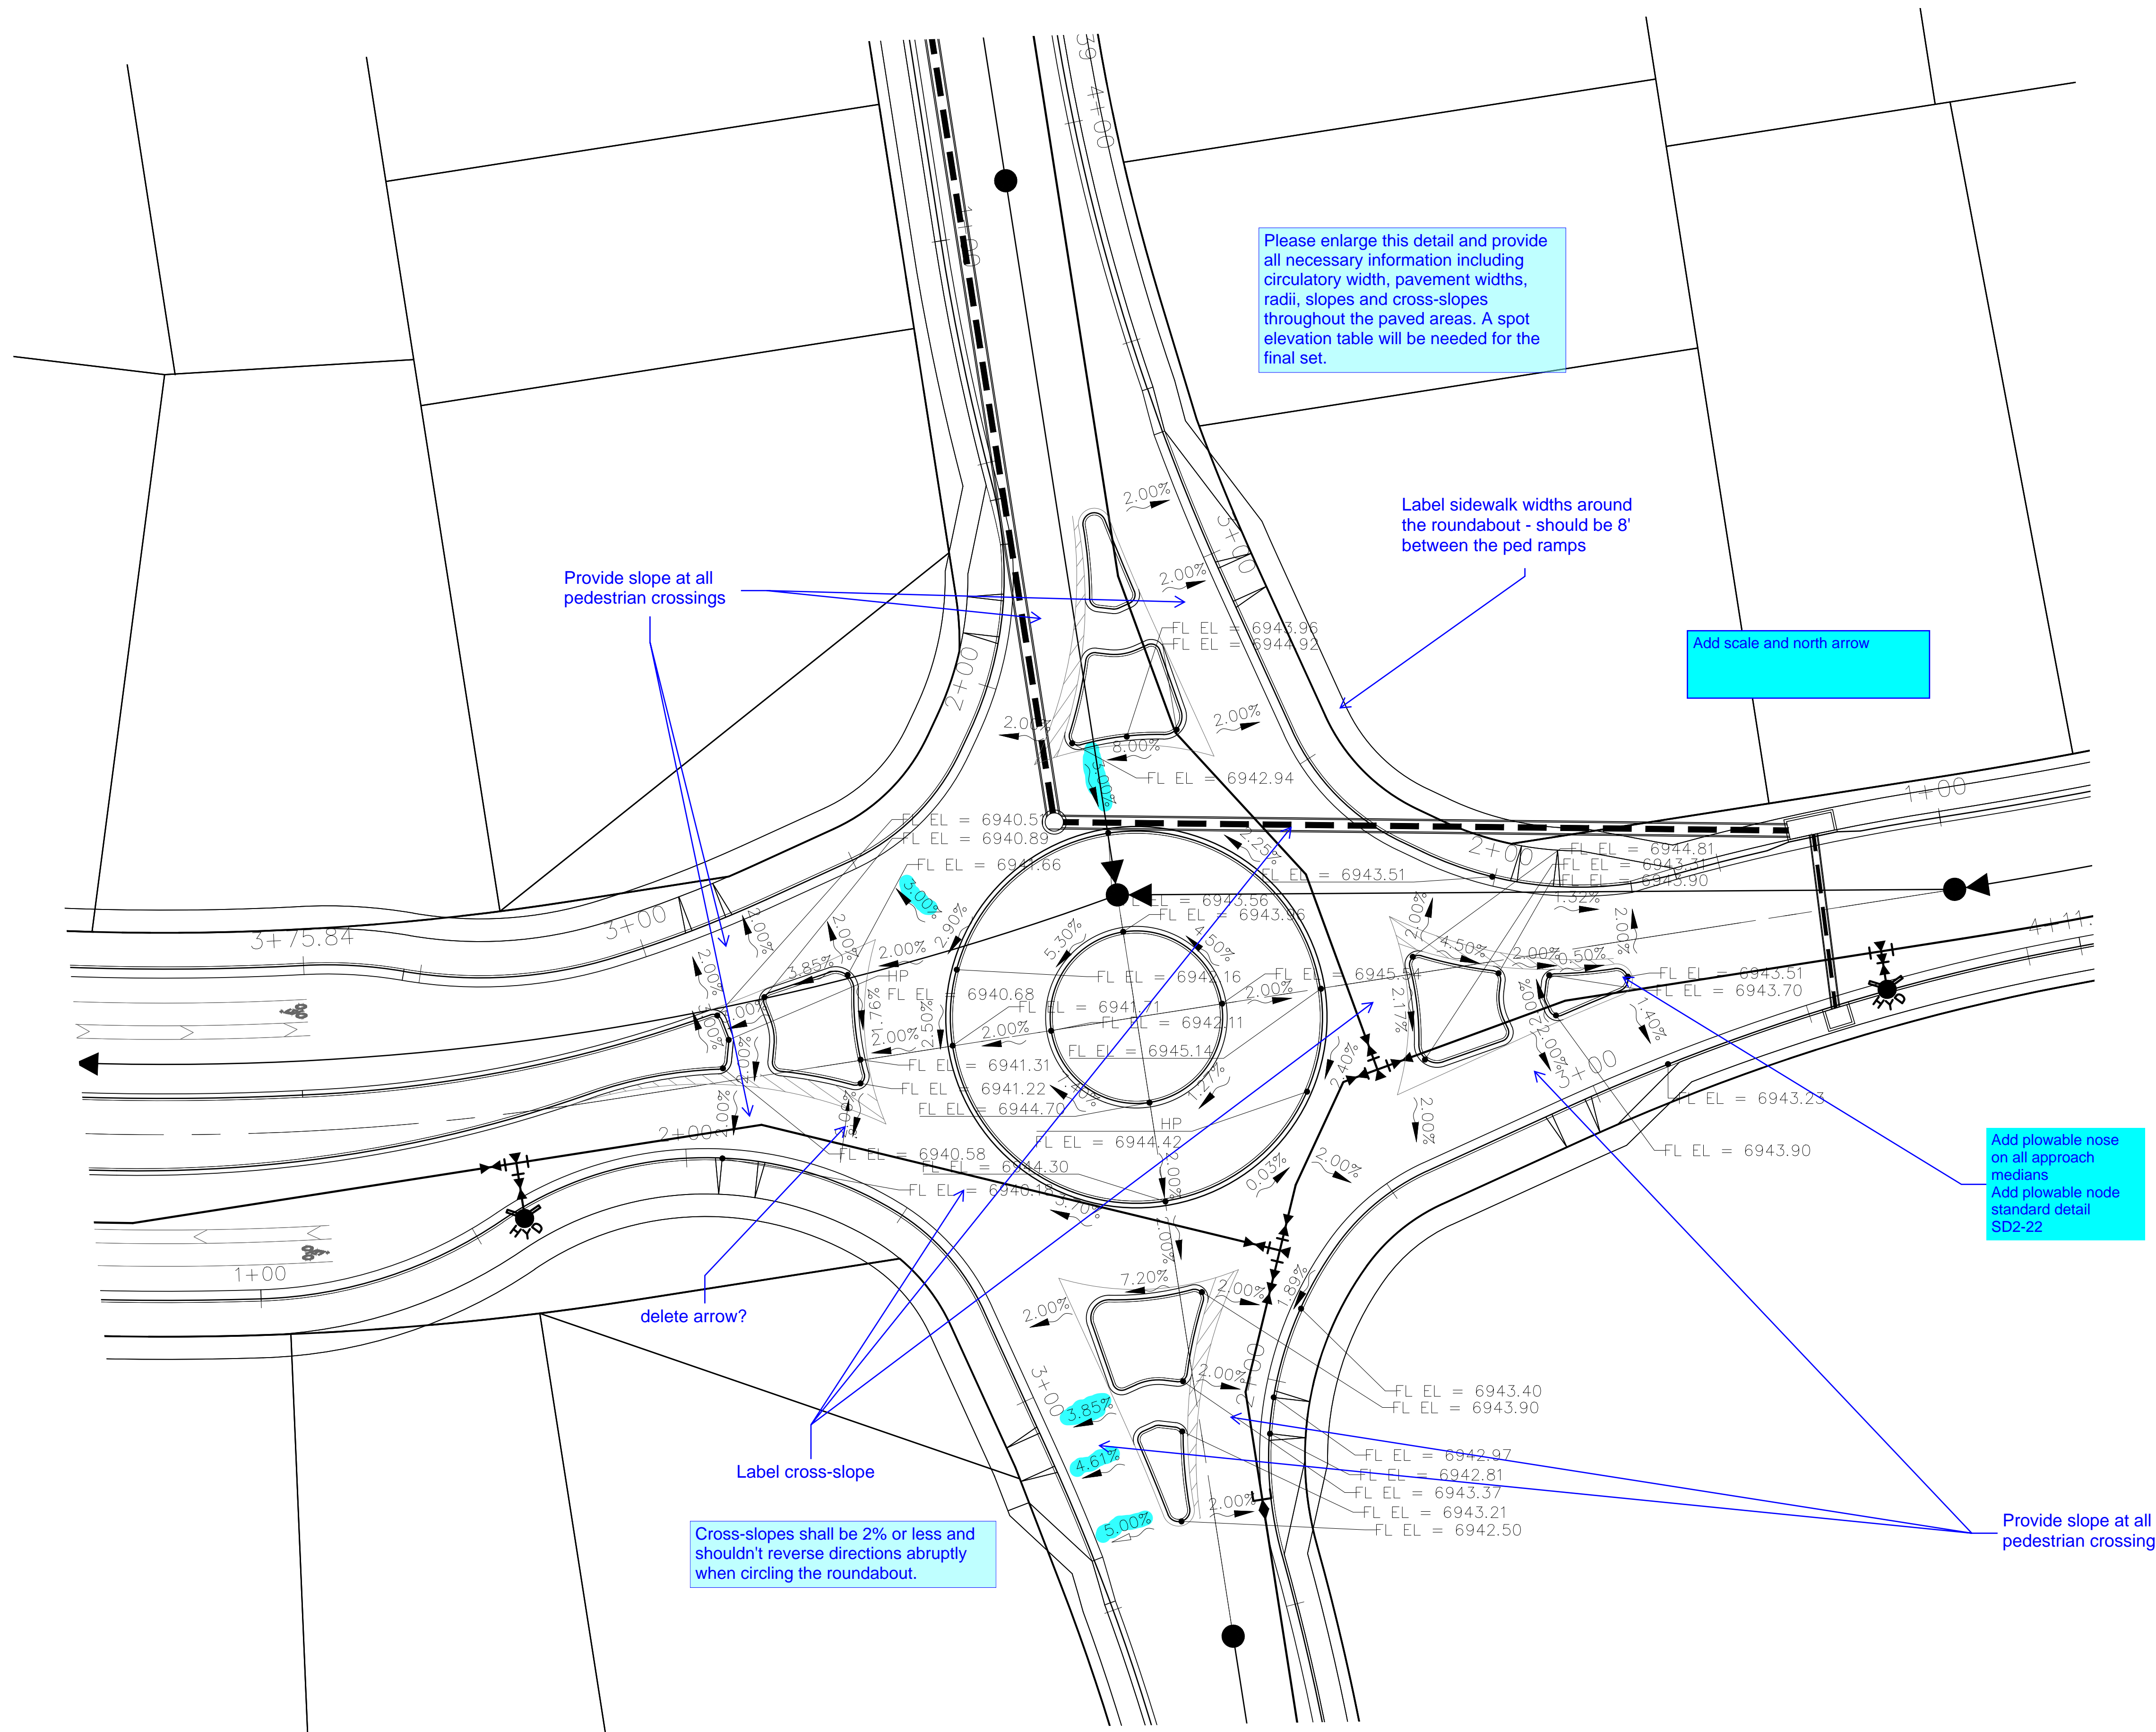

REVISIONS	DESCRIPTION	DATE

UNTIL SUCH TIME AS THESE DRAWINGS ARE APPROVED BY THE LOCAL AGENCIES OR THE TERRA NOVA ENGINEERING, INC. APPROVES THEIR USE ONLY FOR THE PROJECT AND FOR THE PURPOSES AUTHORIZED BY WRITTEN AUTHORIZATION.


PREPARED FOR:  
**4-WAY RANCH JOINT VENTURE**  
 ATTN: PETER MARTZ  
 P.O. BOX 50223  
 COLORADO SPRINGS, CO 80949  
 719-491-3150

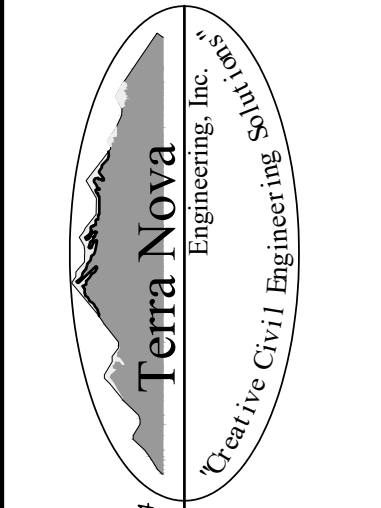

721 S. 23RD STREET  
 COLORADO SPRINGS, CO 80904  
 OFFICE: 719-635-6422  
 FAX: 719-635-6426  
 www.tnainc.com


**WATERBURY FLING NO. 1**  
 CONSTRUCTION SET  
 ROUNDABOUT DETAILED GRADING

DESIGNED BY DLF  
 DRAWN BY QNA  
 CHECKED BY QNA  
 H-SCALE N/A  
 V-SCALE N/A  
 JOB NO. 1715.00  
 DATE ISSUED 2/6/23  
 SHEET NO. 18 OF 39

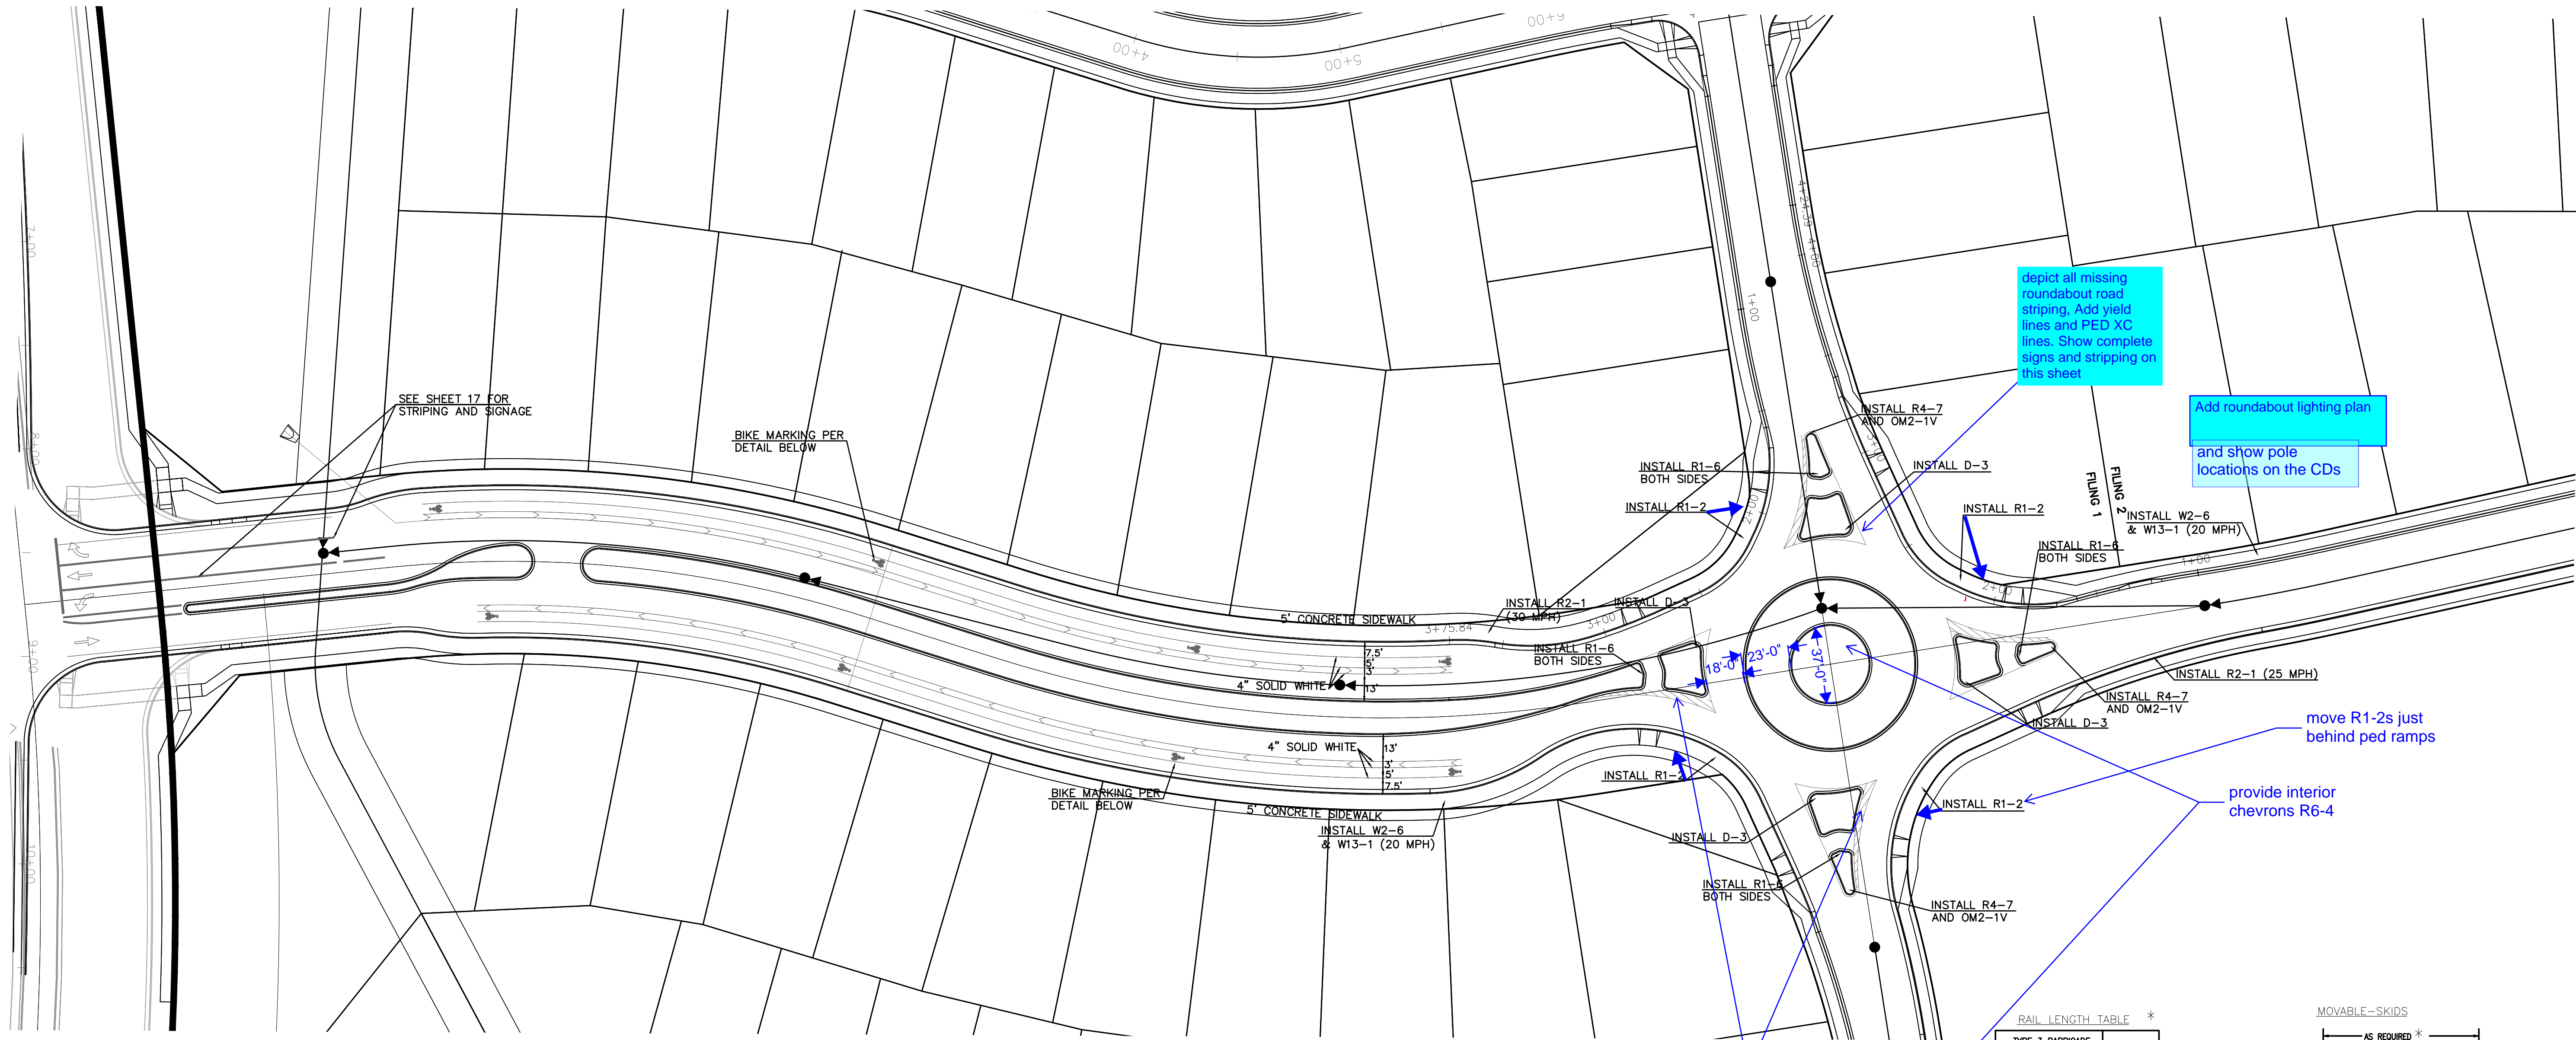

RAIL LENGTH TABLE \*

TYPE 3 BARRICADE		LENGTH
FIXED	MOVABLE	
F - A	M - A	8' - 14'
F - B	M - B	15' - 24'
F - C	M - C	25' - 35'
F - D	M - D	> 35'

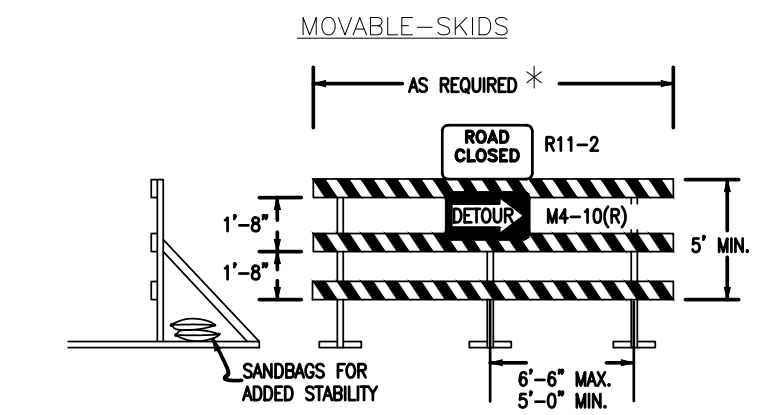

- NOTES
- TYPE 3 BARRICADES HAVE 3 REFLECTORIZED RAIL FACES IF FACING TRAFFIC IN ONE DIRECTION AND 6 IF FACING TRAFFIC IN TWO DIRECTIONS.
  - THE PORTION OF THE POST ABOVE THE GROUND LINE SHALL BE PAINTED IN ACCORDANCE WITH THE APPROPRIATE GENERAL NOTE.
  - DETACHABLE EXTENSION WING RAILS FOR DISPOSING OF CONSTRUCTION EQUIPMENT ARE PERMITTED, WHEN NECESSARY, ON FIXED OR MOVABLE TYPE 3 BARRICADES. THE LENGTH SHALL BE ADEQUATE TO CLOSE THE BORROW PIT AND/OR SHOULDER AS REQUIRED.

TYPICAL TYPE 3 BARRICADES




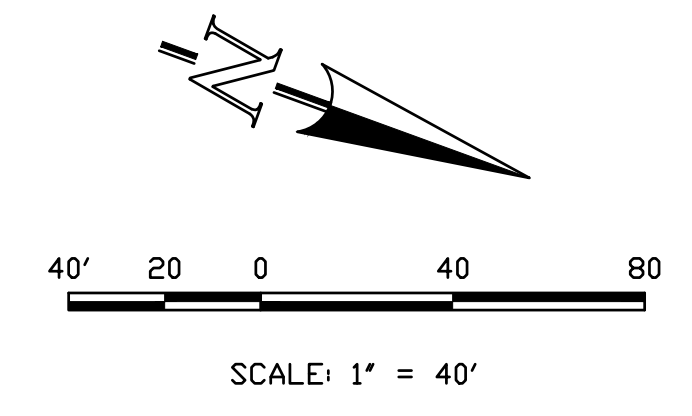


Figure 9C-3. Word, Symbol, and Arrow Pavement Markings for Bicycle Lanes

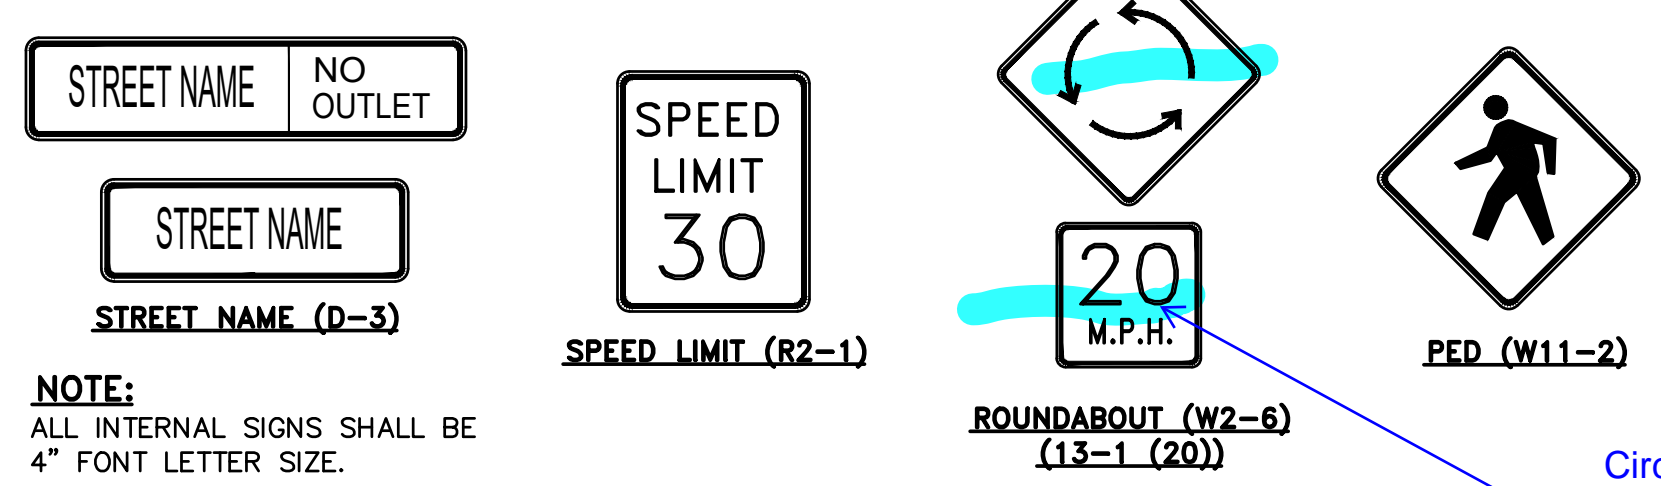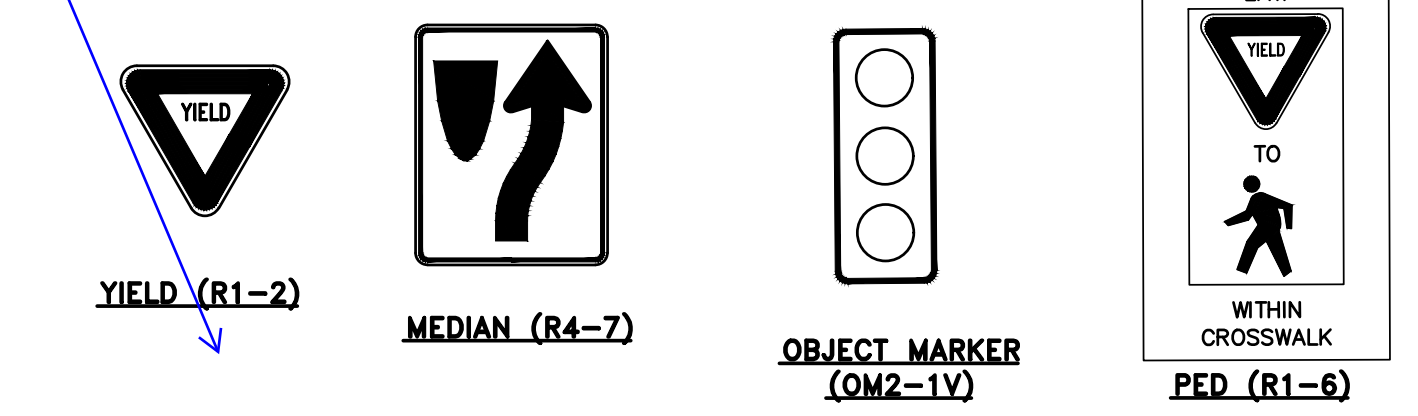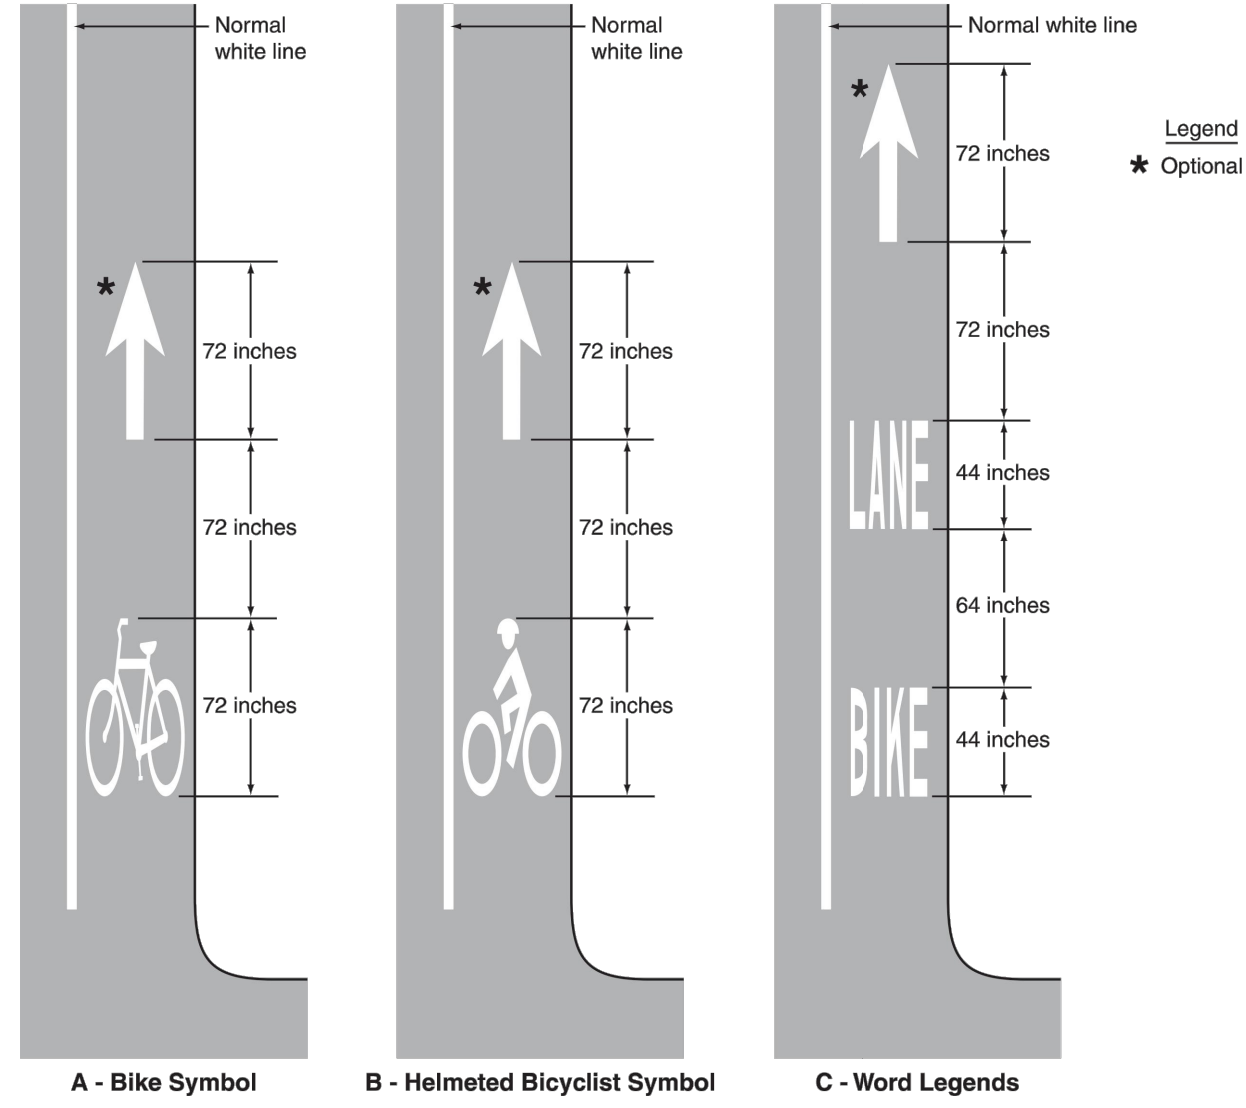

NOTE:  
ALL INTERNAL SIGNS SHALL BE 4" FONT LETTER SIZE.

48 HOURS BEFORE YOU DIG,

Per TIS pg 155. Add hatch pavement marking details if painted or different surface. Call these areas out as concrete and provide detail (see Lorson Fontaine roundabout details). This detail will be shown on the construction drawings.

REVISIONS

NO.	DESCRIPTION	DATE


UNTIL SUCH TIME AS THESE DRAWINGS ARE APPROVED BY THE BOARD OF DIRECTORS OF TERRA NOVA ENGINEERING, INC. APPROVES THEIR USE ONLY FOR THE PROJECT AND FOR THE PURPOSES AUTHORIZED BY WRITTEN AUTHORIZATION.

PREPARED FOR:  
4-WAY RANCH JOINT VENTURE  
ATTN: PETER MARTZ  
P.O. BOX 50223  
COLORADO SPRINGS, CO 80949  
719-491-3150


Terra Nova Engineering, Inc.  
Civil/City/Engineer/Int'l  
721 S. ZARO STREET  
COLORADO SPRINGS, CO 80904  
OFFICE: 719-635-6422  
FAX: 719-635-6426  
www.tnec.com

WATERBURY FILING NO. 1  
CONSTRUCTION SET  
SIGNING & STRIPING  
SAYBROOK & ROUNDABOUT



DESIGNED BY DLF  
DRAWN BY QNA  
CHECKED BY QNA  
H-SCALE NA  
V-SCALE N/A  
JOB NO. 1715.00  
DATE ISSUED 2/6/23  
SHEET NO. 19 OF 39

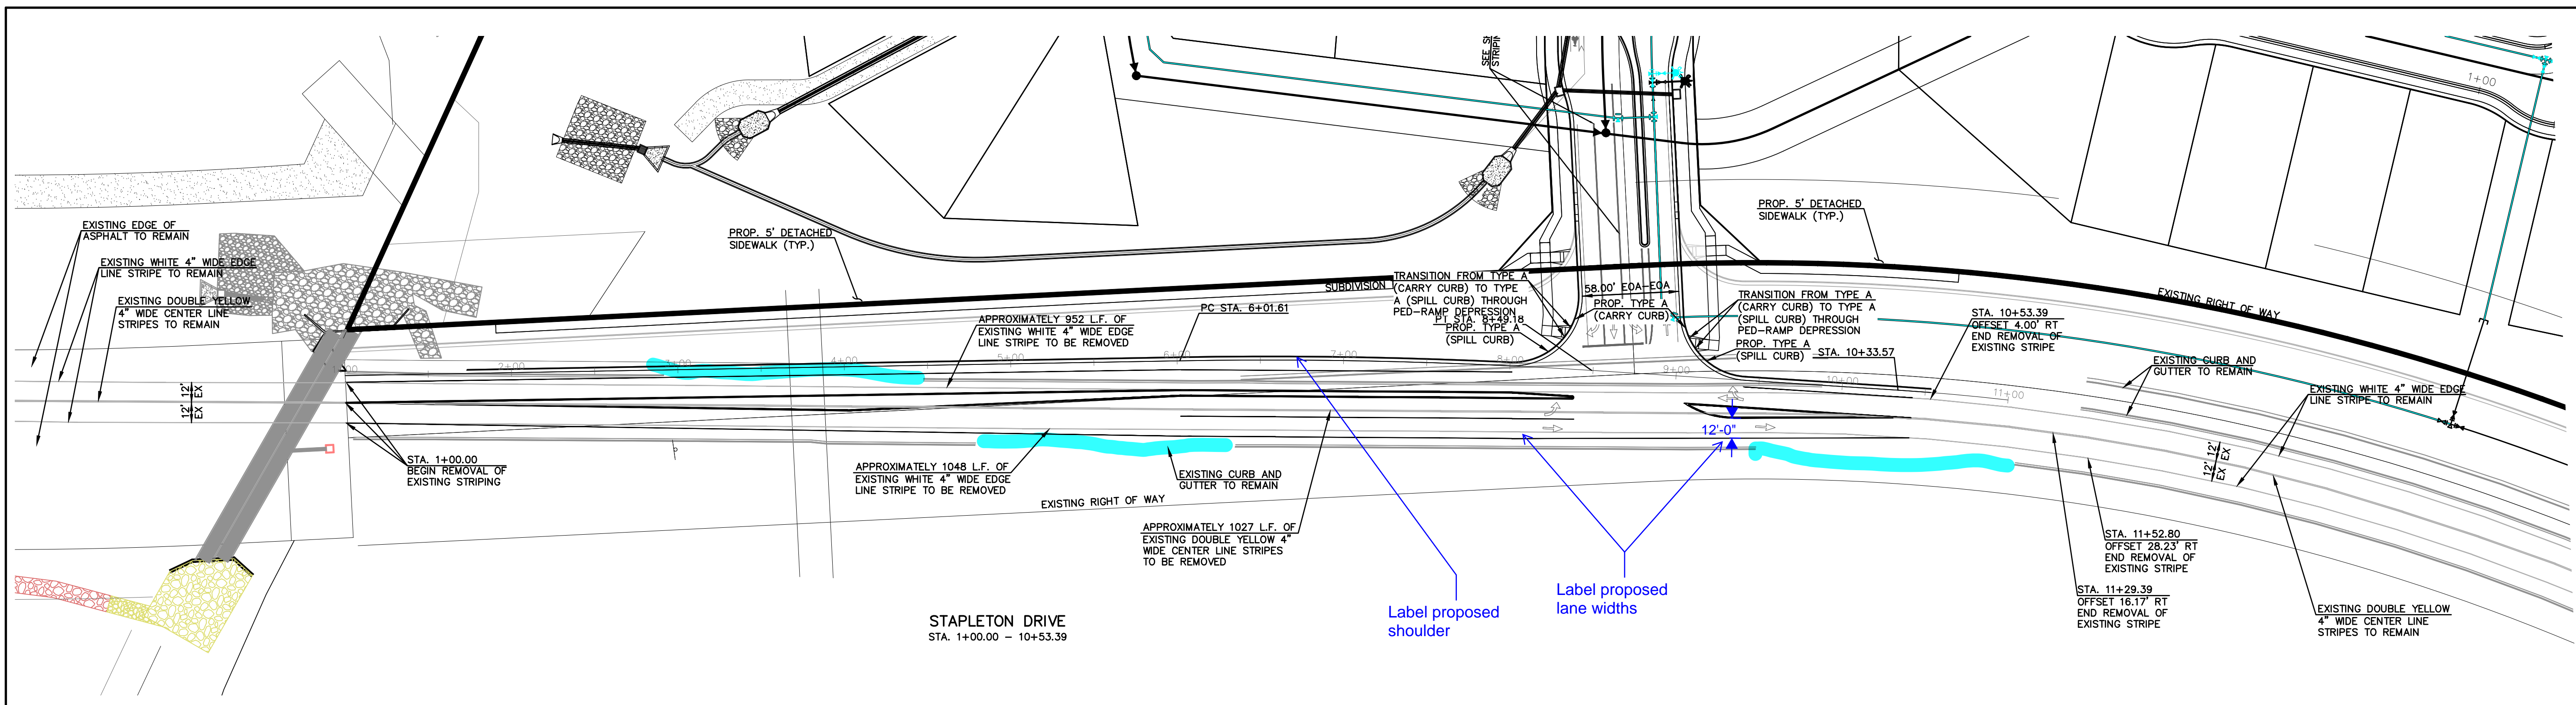

STAPLETON DRIVE  
STA. 1+00.00 - 10+53.39

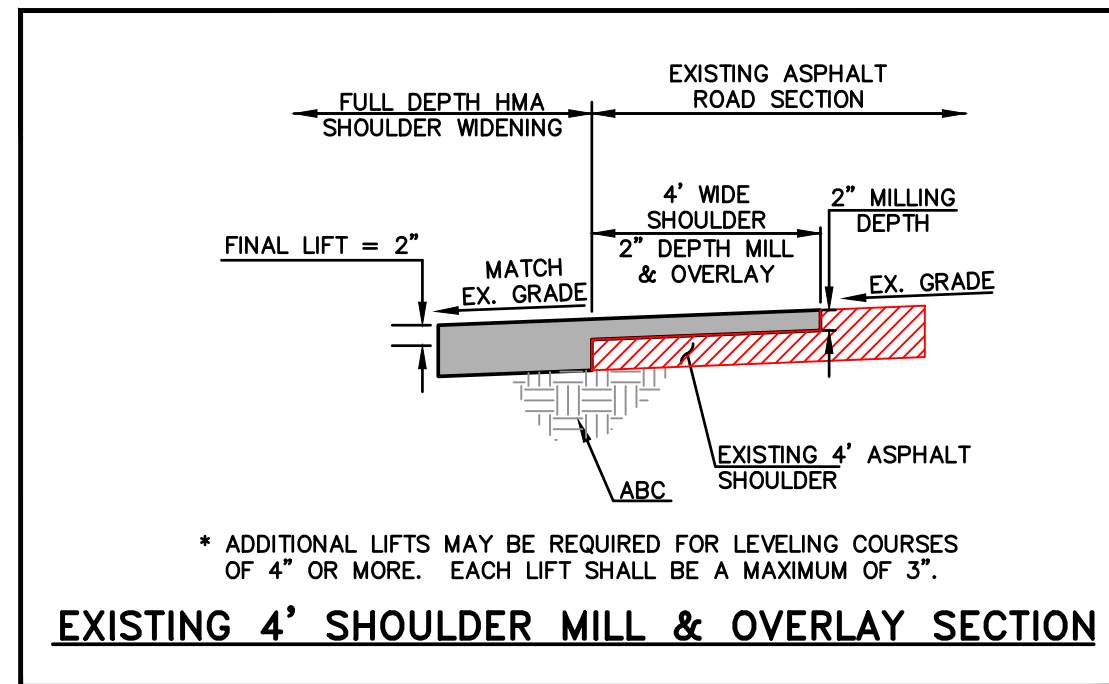


DESIGN SPEED  
IS 50 M.P.H.

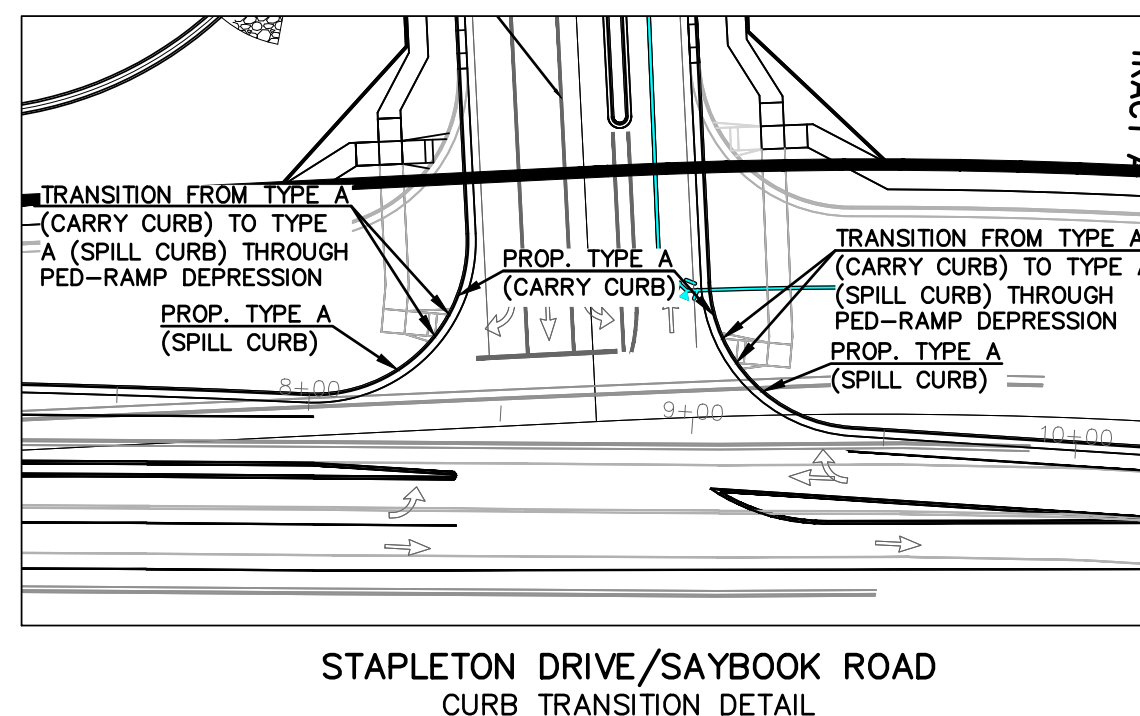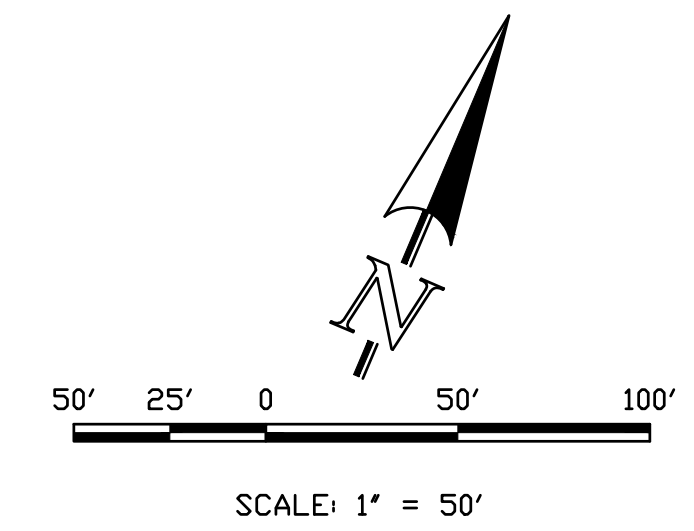

CURB FL CURVE TABLE				
CURVE	LENGTH	RADIUS	DELTA	ANGLE
1	66.73	40.00	95°35'02"	
2	58.27	40.00	83°28'17"	

THIS DESIGN WAS PREPARED UNDER MY DIRECT SUPERVISION  
FOR AND ON BEHALF OF TERRA NOVA ENGINEERING, INC.

QUENTIN N. ARMUO, PROFESSIONAL ENGINEER  
COLORADO P.E. NO. 37170

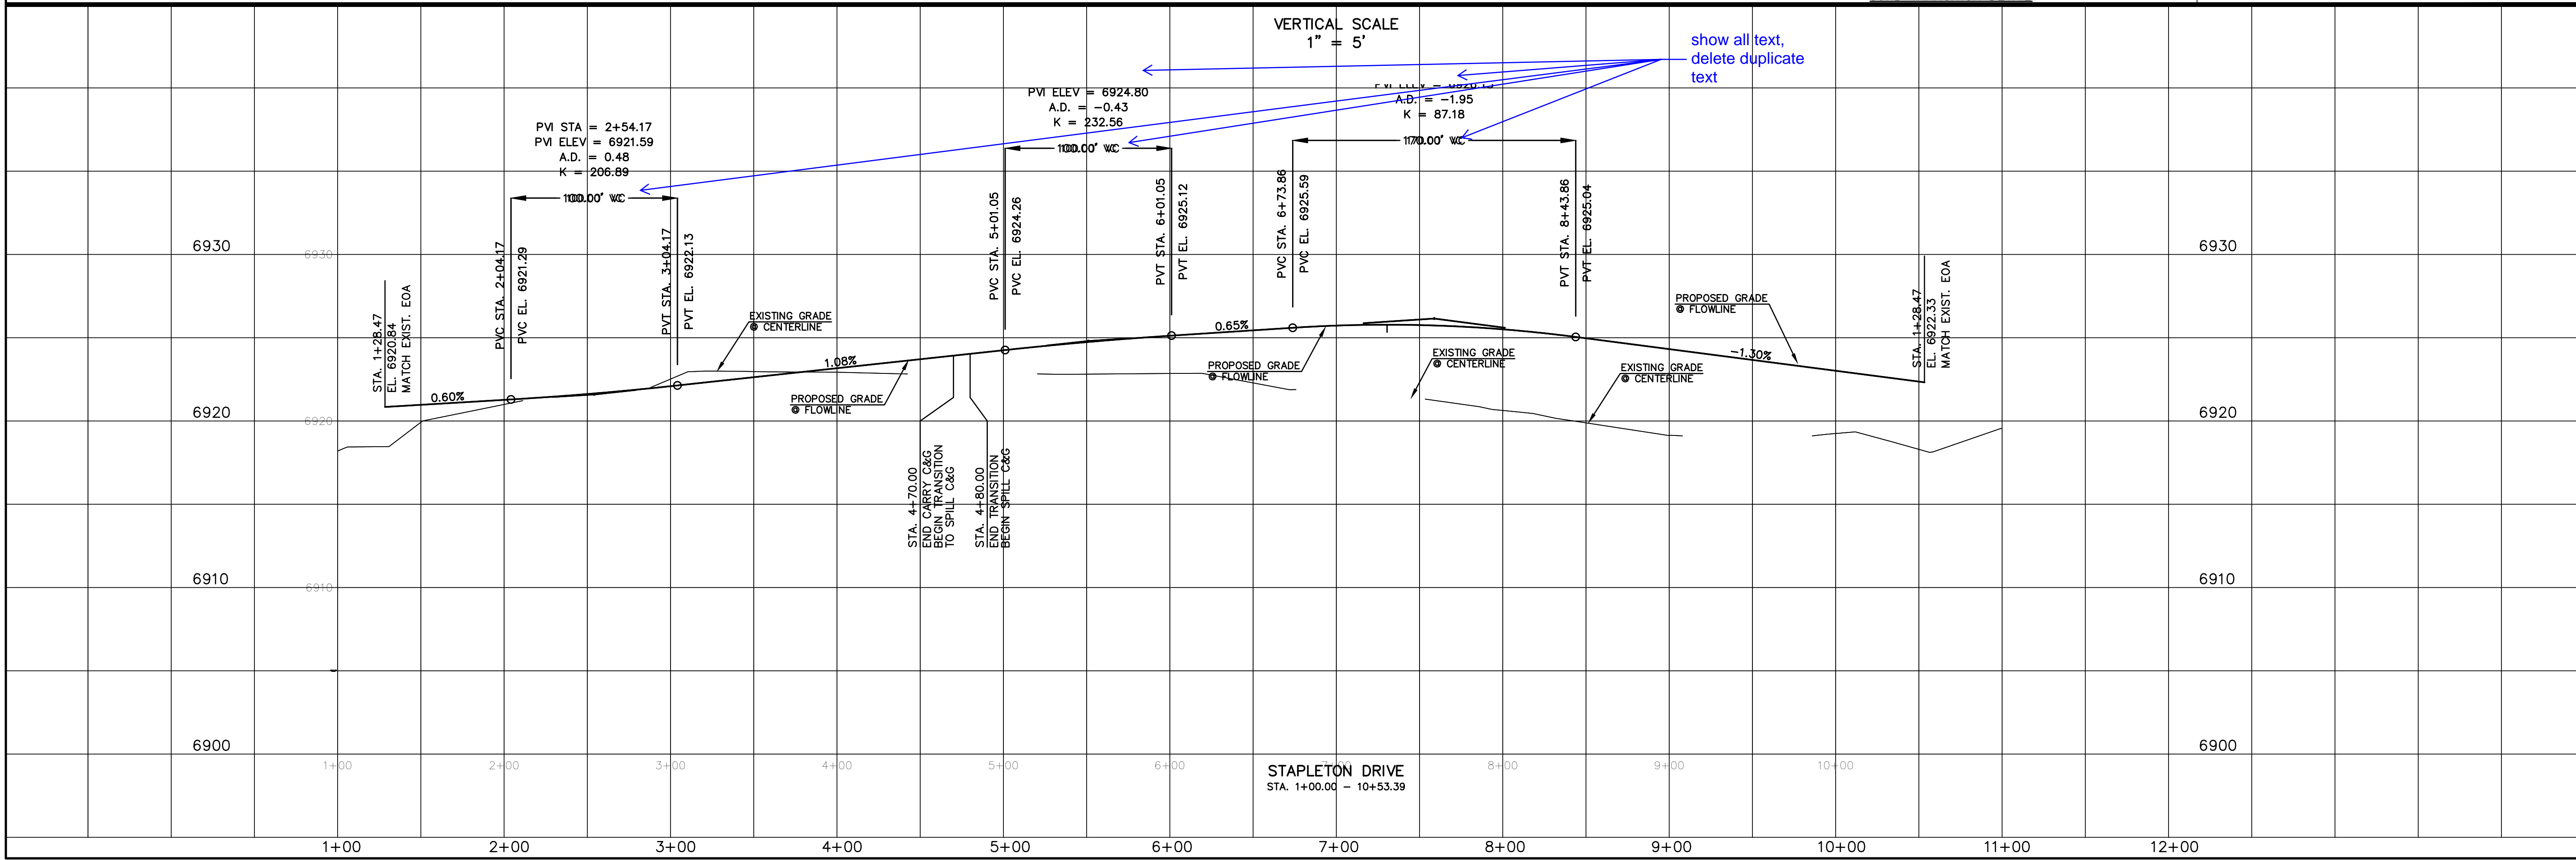

DATE: \_\_\_\_\_

REVISIONS: \_\_\_\_\_

NO. \_\_\_\_\_

DESCRIPTION: \_\_\_\_\_

UNTIL SUCH TIME AS THESE DRAWINGS ARE APPROVED BY THE REVIEWING AGENCIES, THE REVIEWING AGENCIES, TERRA NOVA ENGINEERING AND SURVEYING, INC. APPROVES THEIR USE ONLY AS AUTHORIZED BY WRITTEN AUTHORIZATION.

PREPARED FOR:  
4-WAY RANCH JOINT VENTURE  
PETER MARTZ  
P.O. BOX 50223  
COLORADO SPRINGS, CO 80949  
719-491-3150

DESIGNED BY QNA  
DRAWN BY QNA  
CHECKED BY \_\_\_\_\_


H-SCALE 1"=50'  
V-SCALE 1"=5'

JOB NO. 1715.00  
DATE ISSUED 2/6/23  
SHEET NO. 20 OF 39


WATERBURY FILING NO. 1  
CONSTRUCTION SET  
STREET PLAN AND PROFILE  
STAPLETON ROAD

721 S. 2900 STREET  
COLORADO SPRINGS, CO 80904  
OFFICE: 719-635-6422  
FAX: 719-635-6426  
www.tneshc.com


Terra Nova  
Engineering, Inc.  
Professional Engineer  
Civil Engineer No. 1715

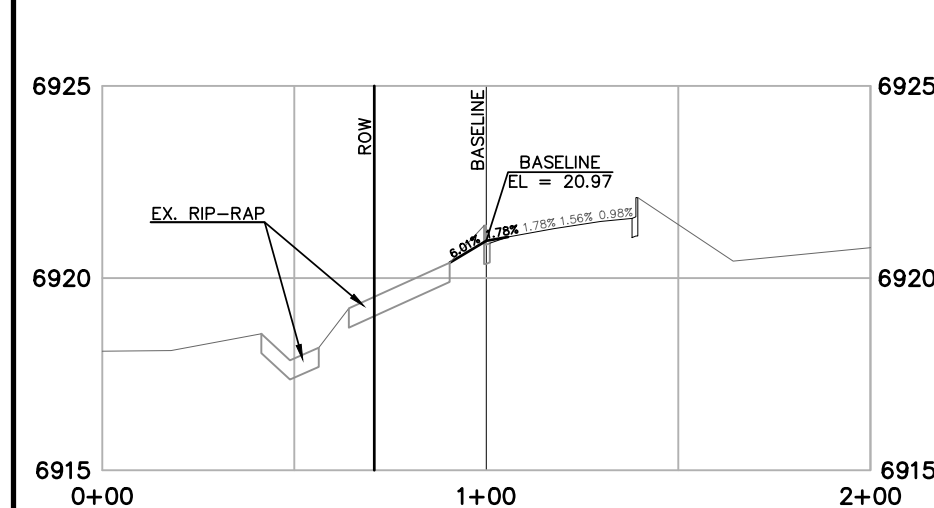


STAPLETON DRIVE  
SECTION 1+50.00  
HORIZONTAL SCALE: 1" = 50'  
VERTICAL SCALE: 1"=5'

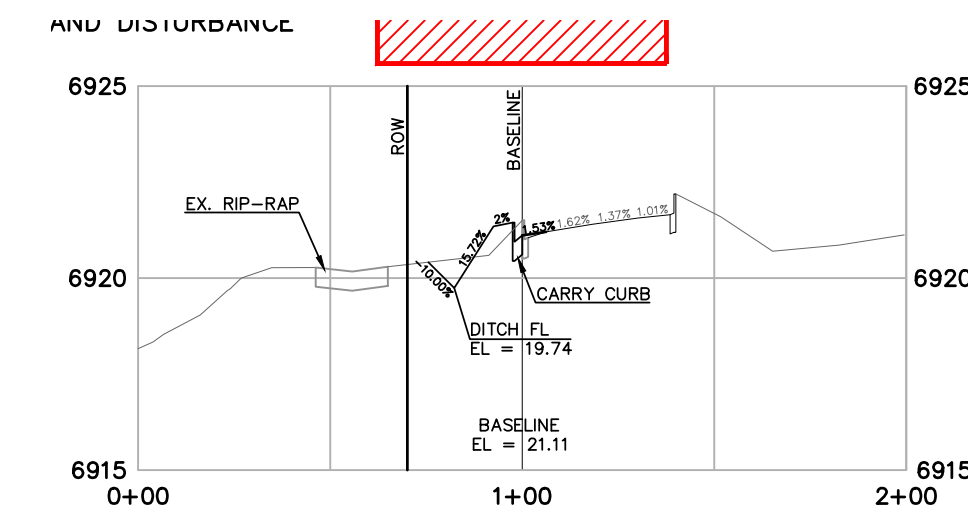


STAPLETON DRIVE  
SECTION 1+73.24  
HORIZONTAL SCALE: 1" = 50'  
VERTICAL SCALE: 1"=5'

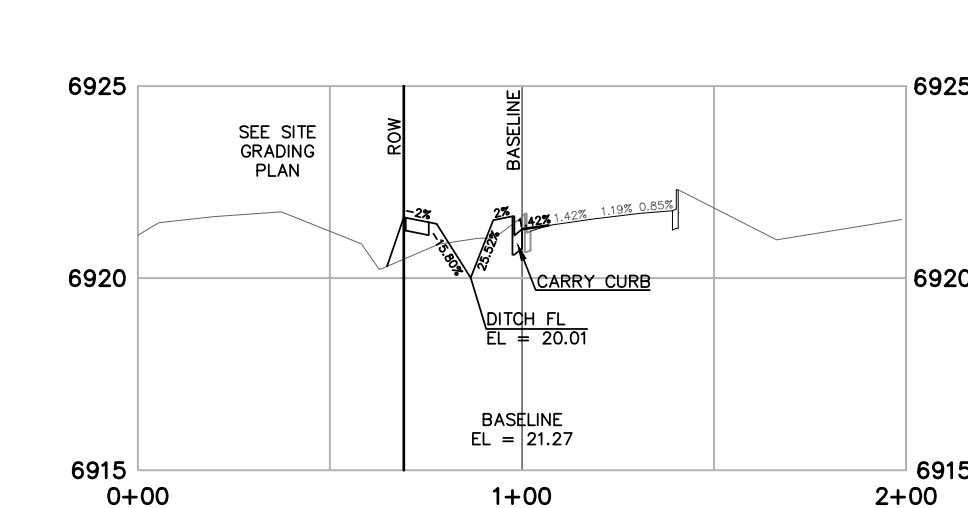


STAPLETON DRIVE  
SECTION 2+00.00  
HORIZONTAL SCALE: 1" = 50'  
VERTICAL SCALE: 1"=5'

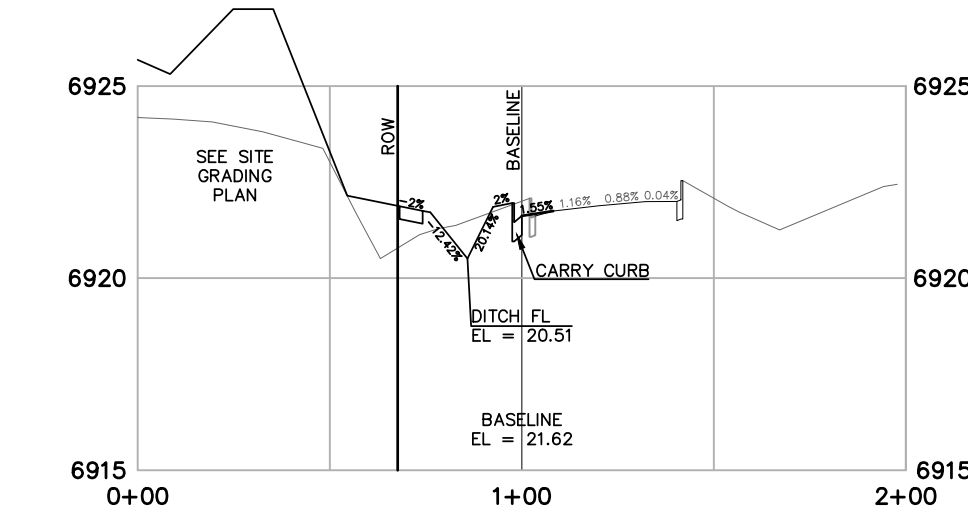


STAPLETON DRIVE  
SECTION 2+50.00  
HORIZONTAL SCALE: 1" = 50'  
VERTICAL SCALE: 1"=5'

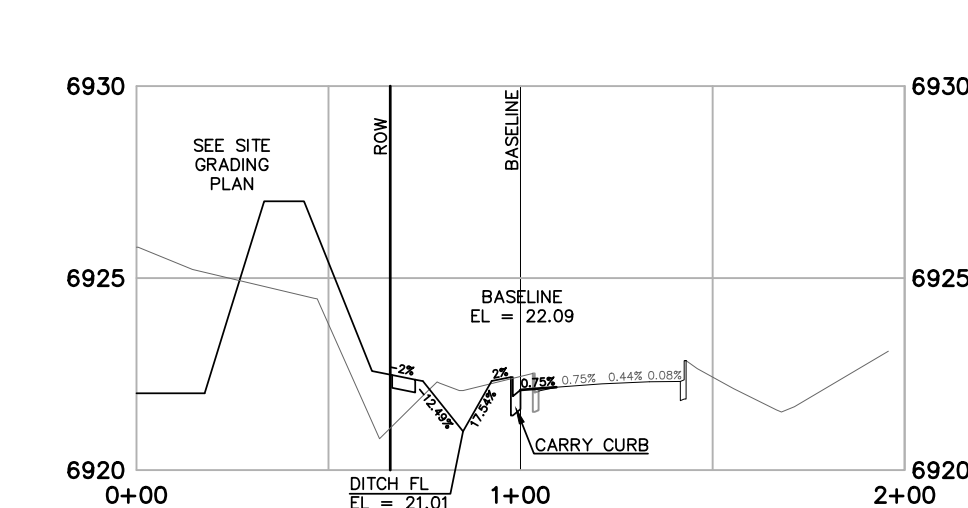


STAPLETON DRIVE  
SECTION 3+00.00  
HORIZONTAL SCALE: 1" = 50'  
VERTICAL SCALE: 1"=5'

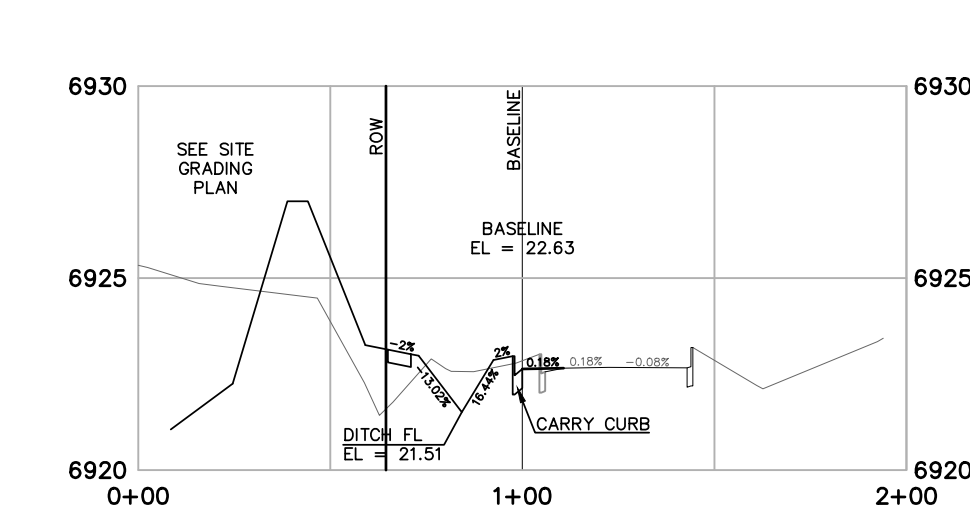


STAPLETON DRIVE  
SECTION 3+50.00  
HORIZONTAL SCALE: 1" = 50'  
VERTICAL SCALE: 1"=5'

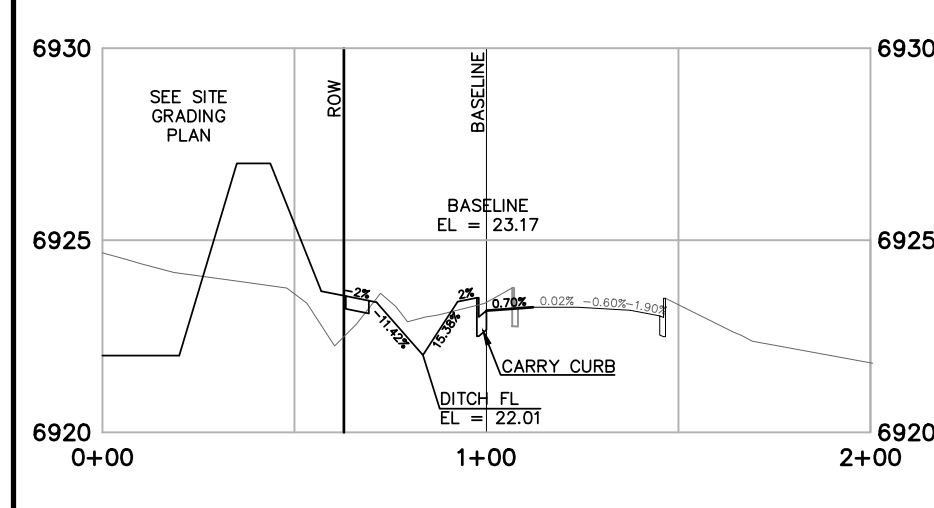


STAPLETON DRIVE  
SECTION 4+00.00  
HORIZONTAL SCALE: 1" = 50'  
VERTICAL SCALE: 1"=5'

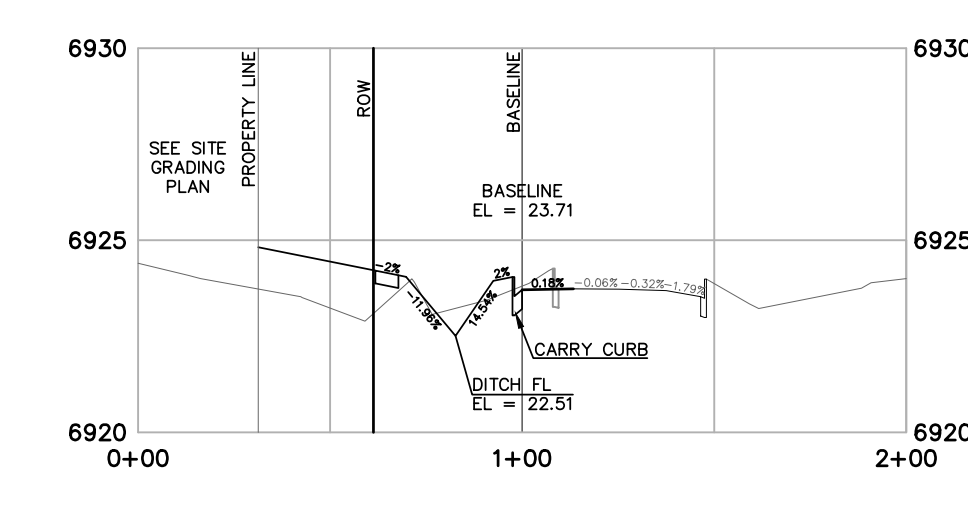


STAPLETON DRIVE  
SECTION 4+50.00  
HORIZONTAL SCALE: 1" = 50'  
VERTICAL SCALE: 1"=5'

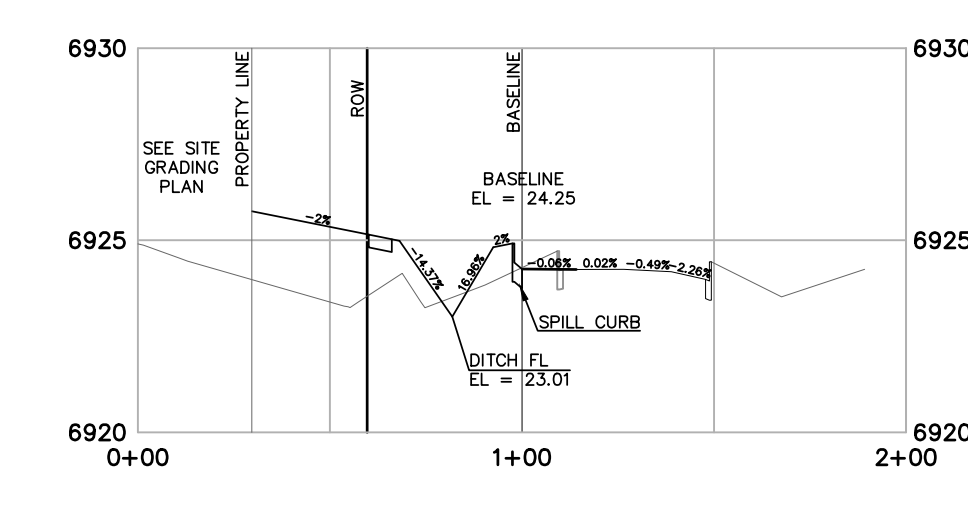


STAPLETON DRIVE  
SECTION 5+00.00  
HORIZONTAL SCALE: 1" = 50'  
VERTICAL SCALE: 1"=5'

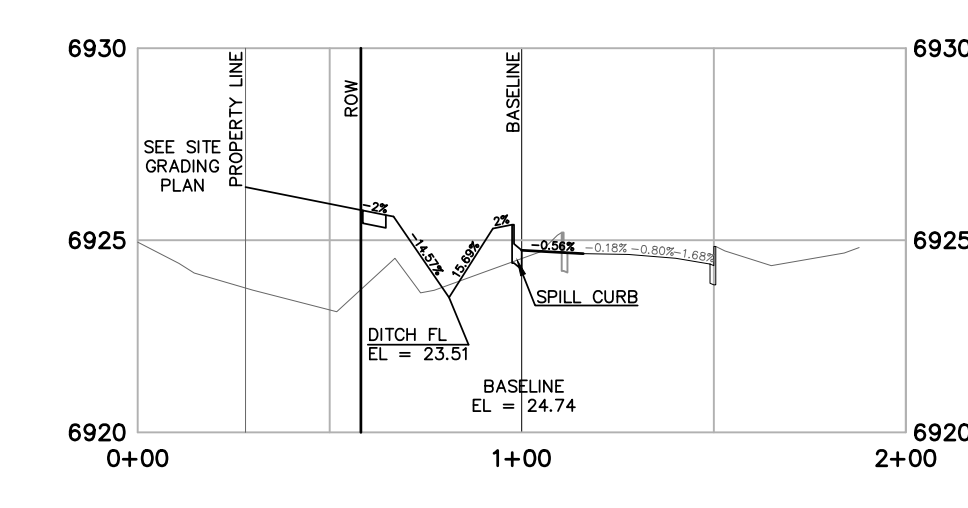


STAPLETON DRIVE  
SECTION 5+50.00  
HORIZONTAL SCALE: 1" = 50'  
VERTICAL SCALE: 1"=5'

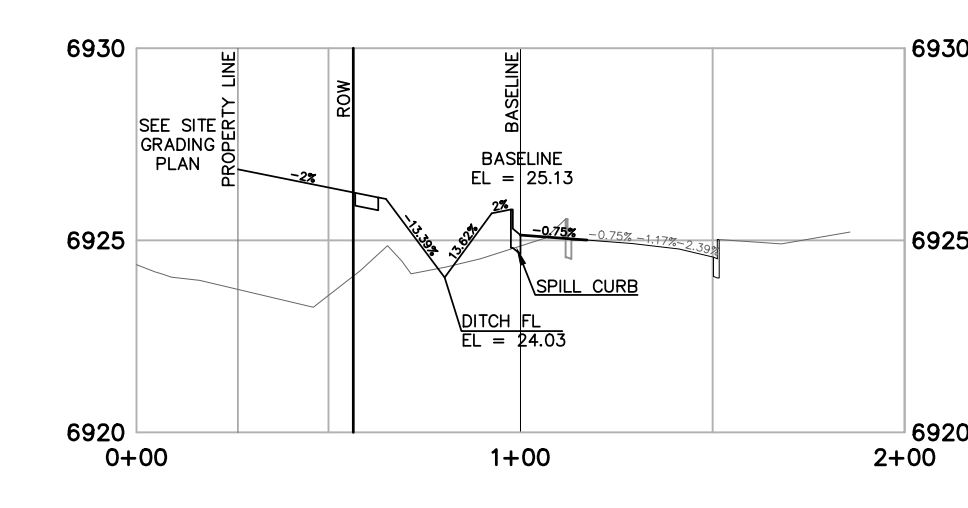


STAPLETON DRIVE  
SECTION 6+01.61  
HORIZONTAL SCALE: 1" = 50'  
VERTICAL SCALE: 1"=5'

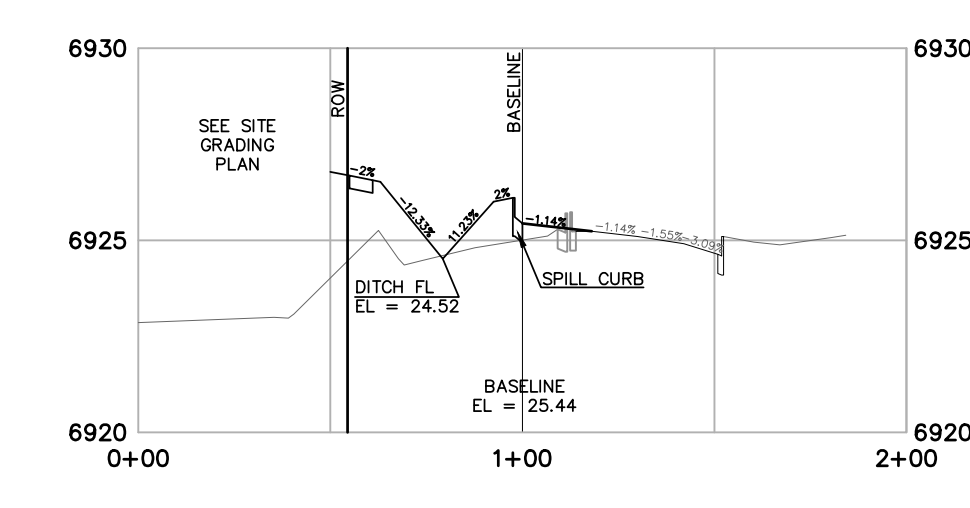


STAPLETON DRIVE  
SECTION 6+50.00  
HORIZONTAL SCALE: 1" = 50'  
VERTICAL SCALE: 1"=5'

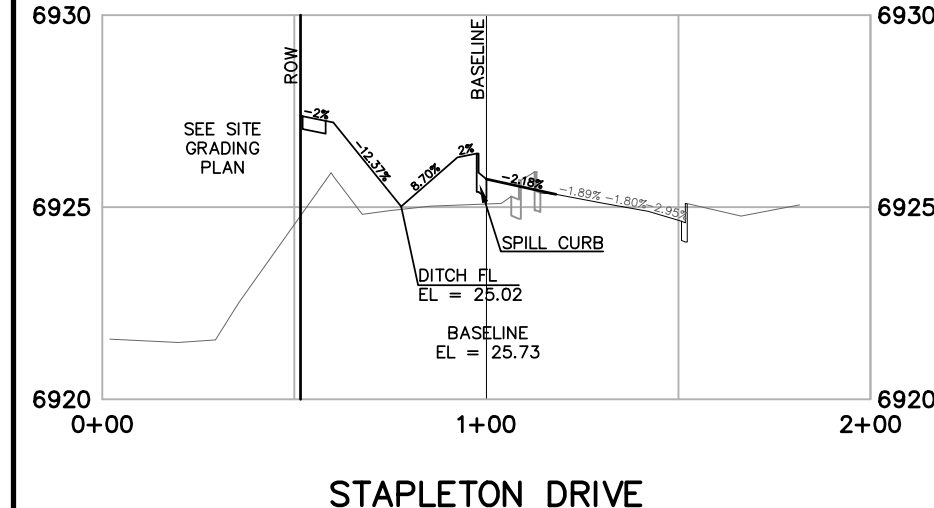


STAPLETON DRIVE  
SECTION 7+00.00  
HORIZONTAL SCALE: 1" = 50'  
VERTICAL SCALE: 1"=5'

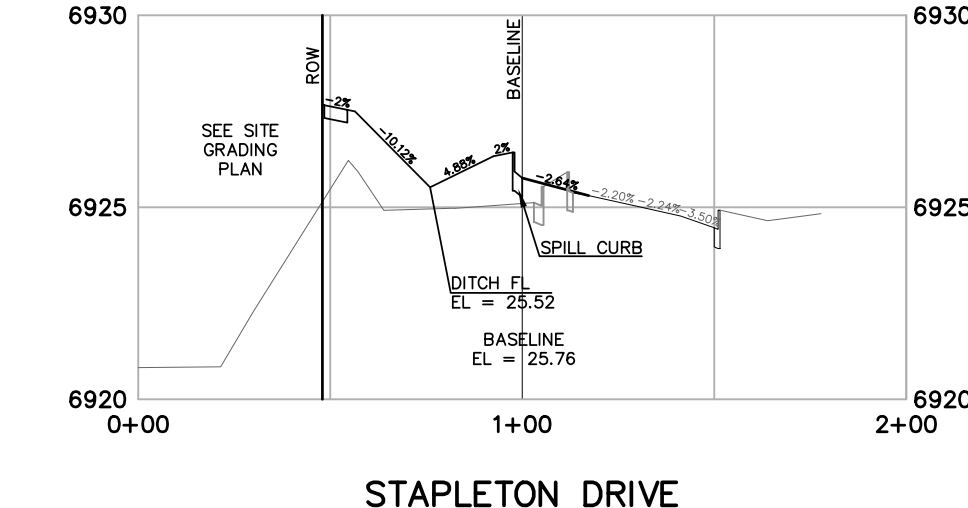


STAPLETON DRIVE  
SECTION 7+50.00  
HORIZONTAL SCALE: 1" = 50'  
VERTICAL SCALE: 1"=5'

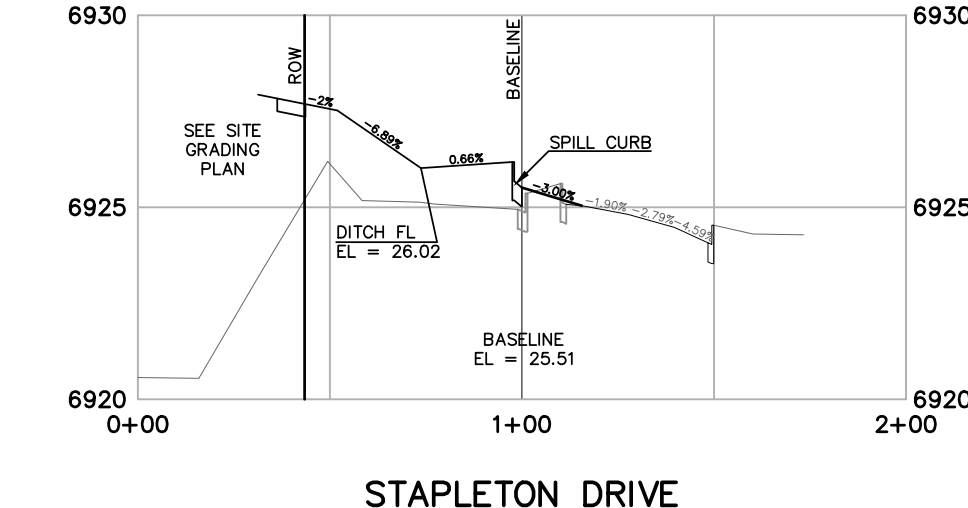


STAPLETON DRIVE  
SECTION 7+99.45  
HORIZONTAL SCALE: 1" = 50'  
VERTICAL SCALE: 1"=5'

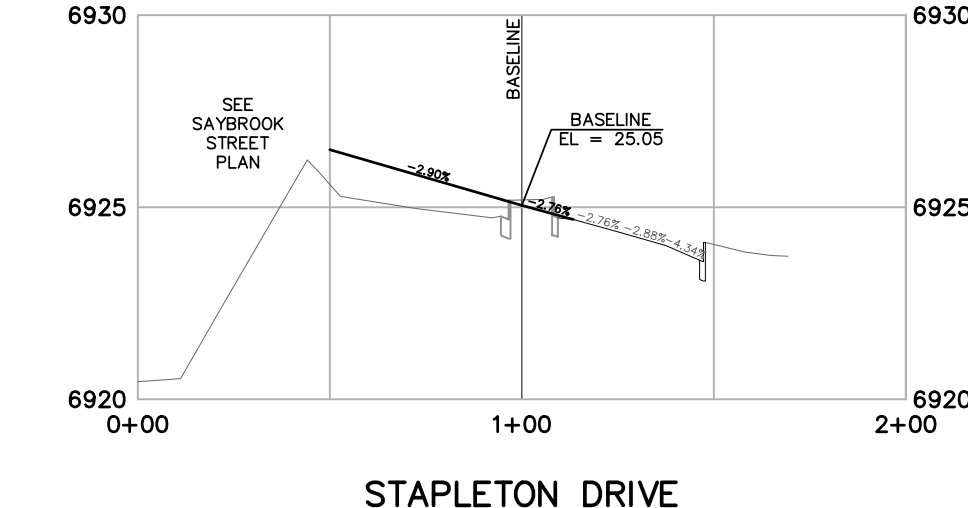


STAPLETON DRIVE  
SECTION 8+43.78  
HORIZONTAL SCALE: 1" = 50'  
VERTICAL SCALE: 1"=5'

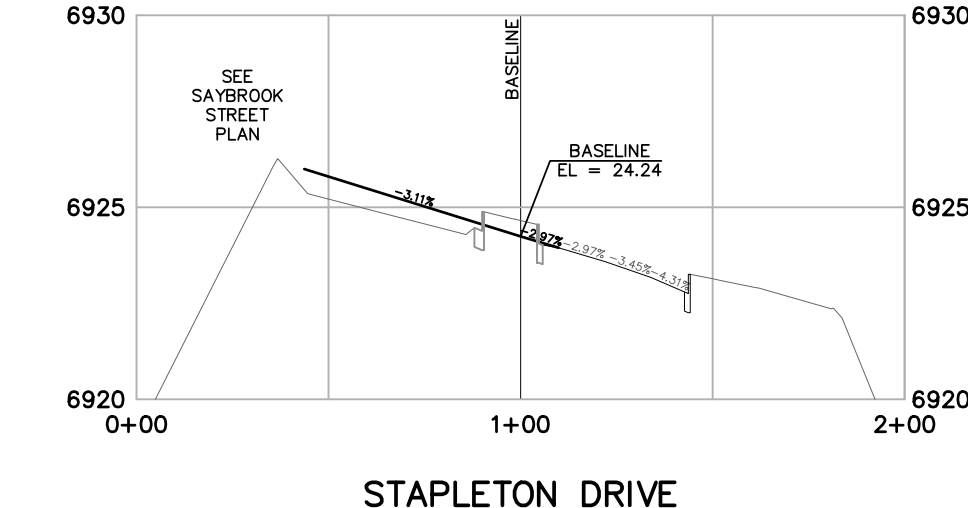


STAPLETON DRIVE  
SECTION 9+06.19  
HORIZONTAL SCALE: 1" = 50'  
VERTICAL SCALE: 1"=5'

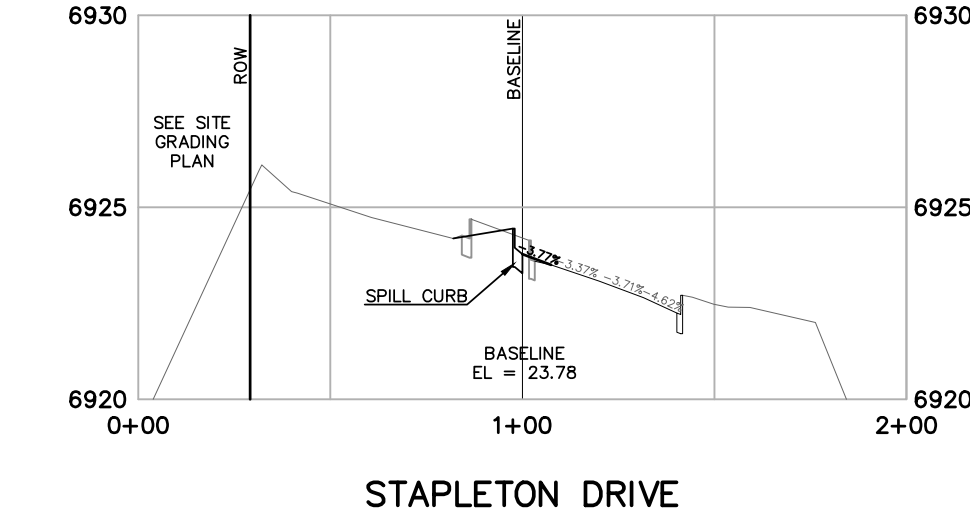

STAPLETON DRIVE  
SECTION 9+41.64  
HORIZONTAL SCALE: 1" = 50'  
VERTICAL SCALE: 1"=5'

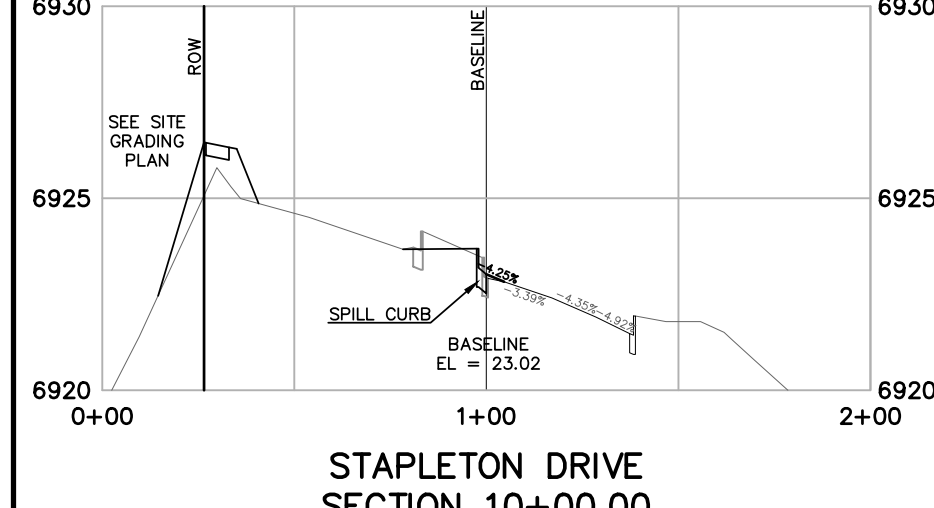

STAPLETON DRIVE  
SECTION 10+00.00  
HORIZONTAL SCALE: 1" = 50'  
VERTICAL SCALE: 1"=5'

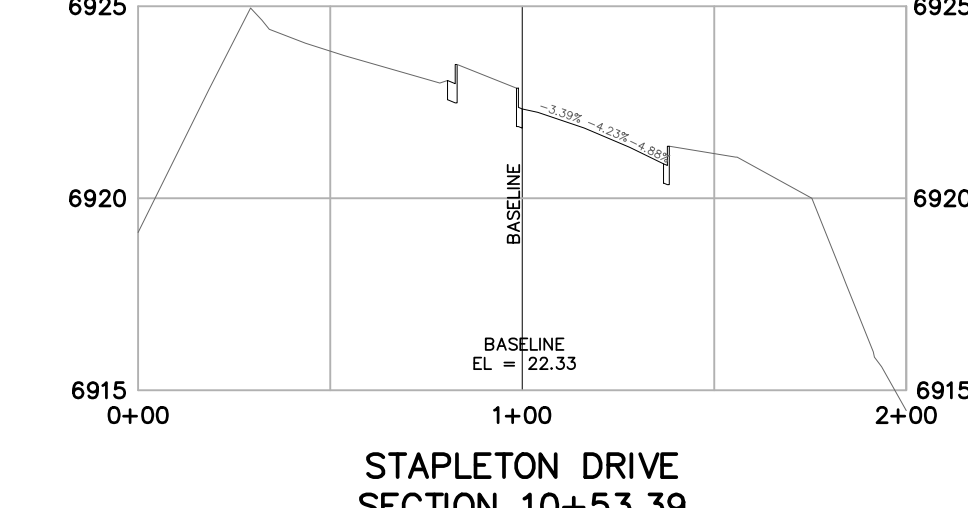


STAPLETON DRIVE  
SECTION 10+53.39  
HORIZONTAL SCALE: 1" = 50'  
VERTICAL SCALE: 1"=5'

REVISIONS	NO.	DESCRIPTION	DATE

UNTIL SUCH TIME AS THESE DRAWINGS ARE APPROVED BY THE ENGINEER, THE USER SHALL BE RESPONSIBLE FOR ANY ERRORS OR OMISSIONS. TERRA NOVA ENGINEERING, INC. APPROVES THEIR USE ONLY FOR THE PROJECT AND ONLY FOR THE PURPOSES AUTHORIZED BY WRITTEN AUTHORIZATION.


PREPARED FOR:  
4-WAY RANCH JOINT VENTURE  
ATTN: PETER MARTZ  
P.O. BOX 50223  
COLORADO SPRINGS, CO 80949  
719-491-3150

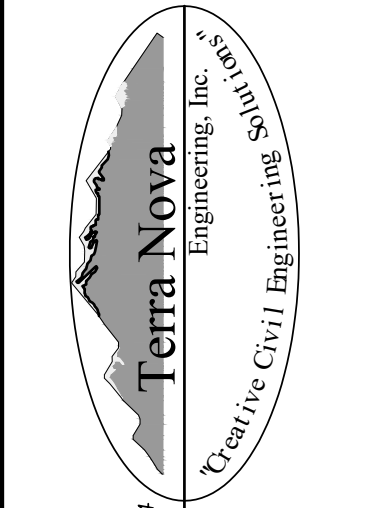



721 S. 23RD STREET  
COLORADO SPRINGS, CO 80904  
OFFICE: 719-635-6422  
FAX: 719-635-6426  
www.tnainc.com

WATERBURY FILING NO. 1  
CONSTRUCTION SET  
STAPLETON DRIVE  
CROSS SECTIONS

DESIGNED BY	DLF
DRAWN BY	QNA
CHECKED BY	QNA
H-SCALE	NA
V-SCALE	N/A
JOB NO.	1715.00
DATE ISSUED	2/6/23
SHEET NO.	21 OF 39

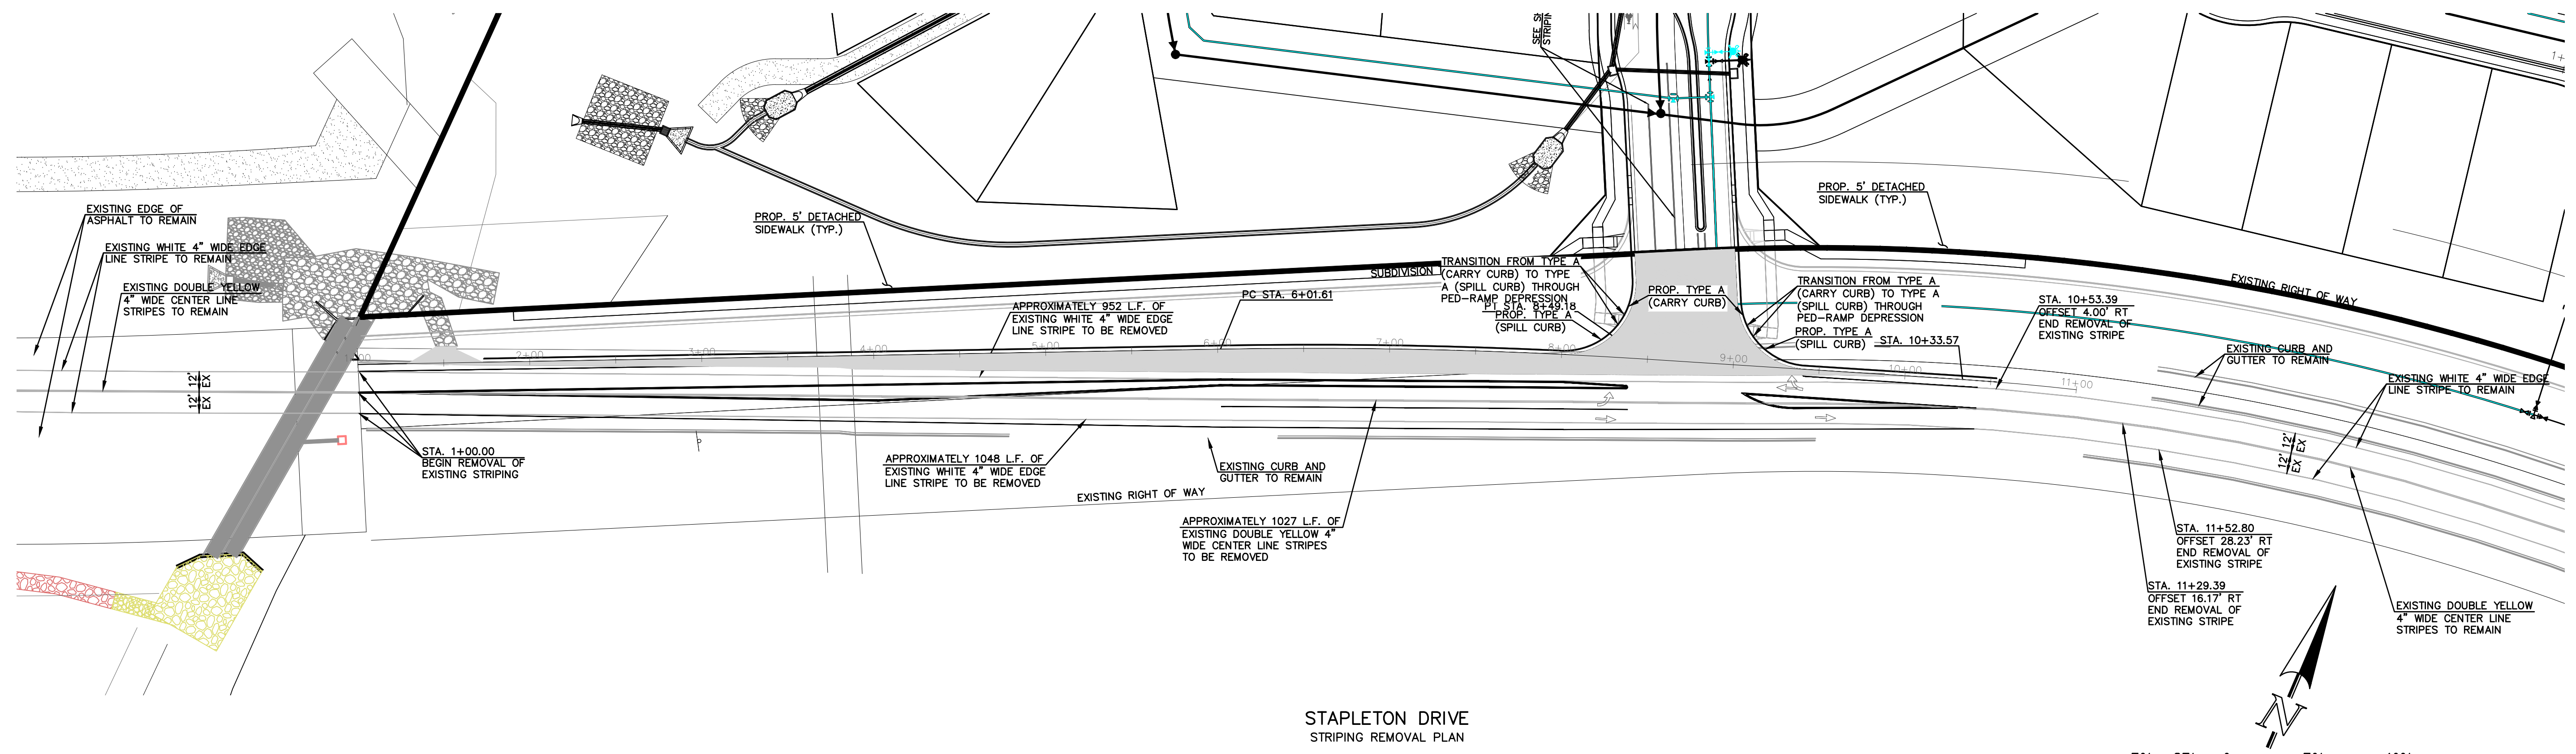

STAPLETON DRIVE  
STRIPING REMOVAL PLAN

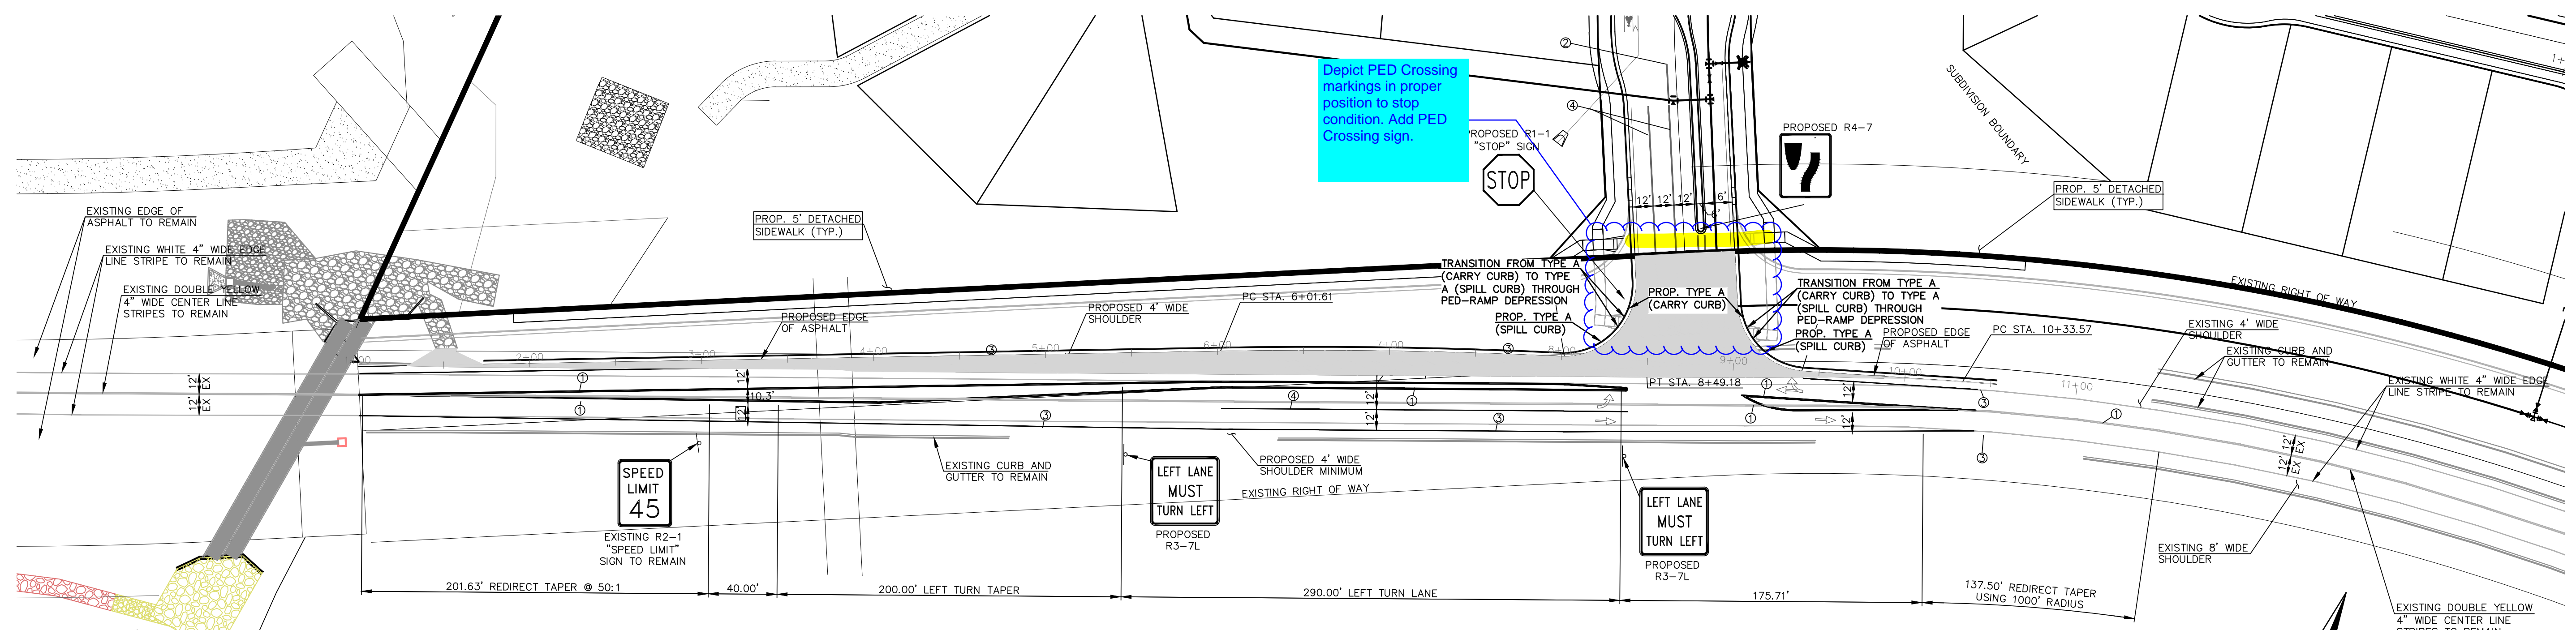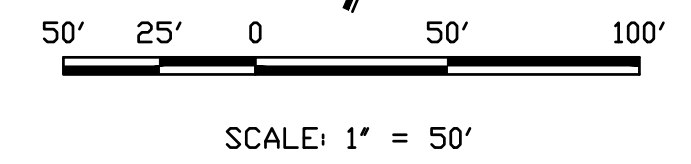

Depict PED Crossing markings in proper position to stop condition. Add PED Crossing sign.

**NOTE TO CONTRACTOR**  
SIGNS AND POLES SHALL BE PER CDOT STANDARDS S-614-8, S-614-2, AND S-614-3, LATEST REVISION.


ALL SIGNAGE INSTALLATION IS TO BE IN COMPLIANCE WITH THE MANUAL ON UNIFORM TRAFFIC CONTROL DEVICES.

ALL 4", 8" SOLID OR SKIP PAVEMENT MARKING ARE TO BE EPOXY.

STOP BARS ARE TO BE 90 MIL PREFORMED THERMOPLASTIC PAVEMENT MARKING TYPE B. (INLAYED)

STAPLETON DRIVE  
SIGNAGE AND STRIPING PLAN

DESIGN SPEED IS 50 M.P.H.

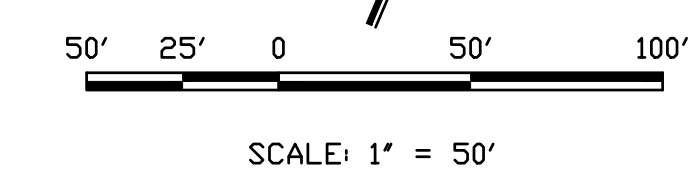

STRIPING LEGEND		
STRIPE	PAVEMENT MARKINGS	MARKING DESCRIPTION
1	CENTER LINES (EPOXY)	DOUBLE SOLID YELLOW, 4" WIDE-SPACED 3" APART
2	LANE LINES (EPOXY)	BROKEN WHITE, 4" WIDE-10' SEGMENTS WITH 30' GAPS
3	EDGE LINES (EPOXY)	SOLID WHITE, 4" WIDE
4	CHANNELIZING LINES (EPOXY)	SOLID WHITE, 8" WIDE
5	STOP LINES (THERMO PLASTIC)	SOLID WHITE, 24" WIDE

\*NOTE: ALL STRIPING INSTALLATION SHALL BE PER COLORADO DEPARTMENT OF TRANSPORTATION "M&S STANDARDS" STANDARD PLAN NO. S-627-1

REVISIONS	NO.	DESCRIPTION	DATE

UNTL SUCH TIME AS THESE DRAWINGS ARE APPROVED BY THE REVIEWING AGENCIES, THE REVIEWING AGENCIES, TERRA NOVA ENGINEERING, INC. APPROVES THEIR USE ONLY FOR THE PROJECT AND FOR THE MOST PART BY WRITTEN AUTHORIZATION.

PREPARED FOR:  
4-WAY RANCH JOINT VENTURE  
ATTN: PETER MARTZ  
P.O. BOX 50223  
COLORADO SPRINGS, CO 80949  
719-491-3150


721 S. 23RD STREET  
COLORADO SPRINGS, CO 80904  
OFFICE: 719-635-6422  
FAX: 719-635-6426  
www.tnove.com

Terra Nova  
Engineering, Inc.  
Civil/City/Engineer/Int'l



WATERBURY FILING NO. 1

SIGNING AND STRIPING  
STAPLETON DRIVE


DESIGNED BY DLF  
DRAWN BY QNA  
CHECKED BY QNA  
H-SCALE NA  
V-SCALE N/A  
JOB NO. 1715.00  
DATE ISSUED 2/6/23  
SHEET NO. 22 OF 39

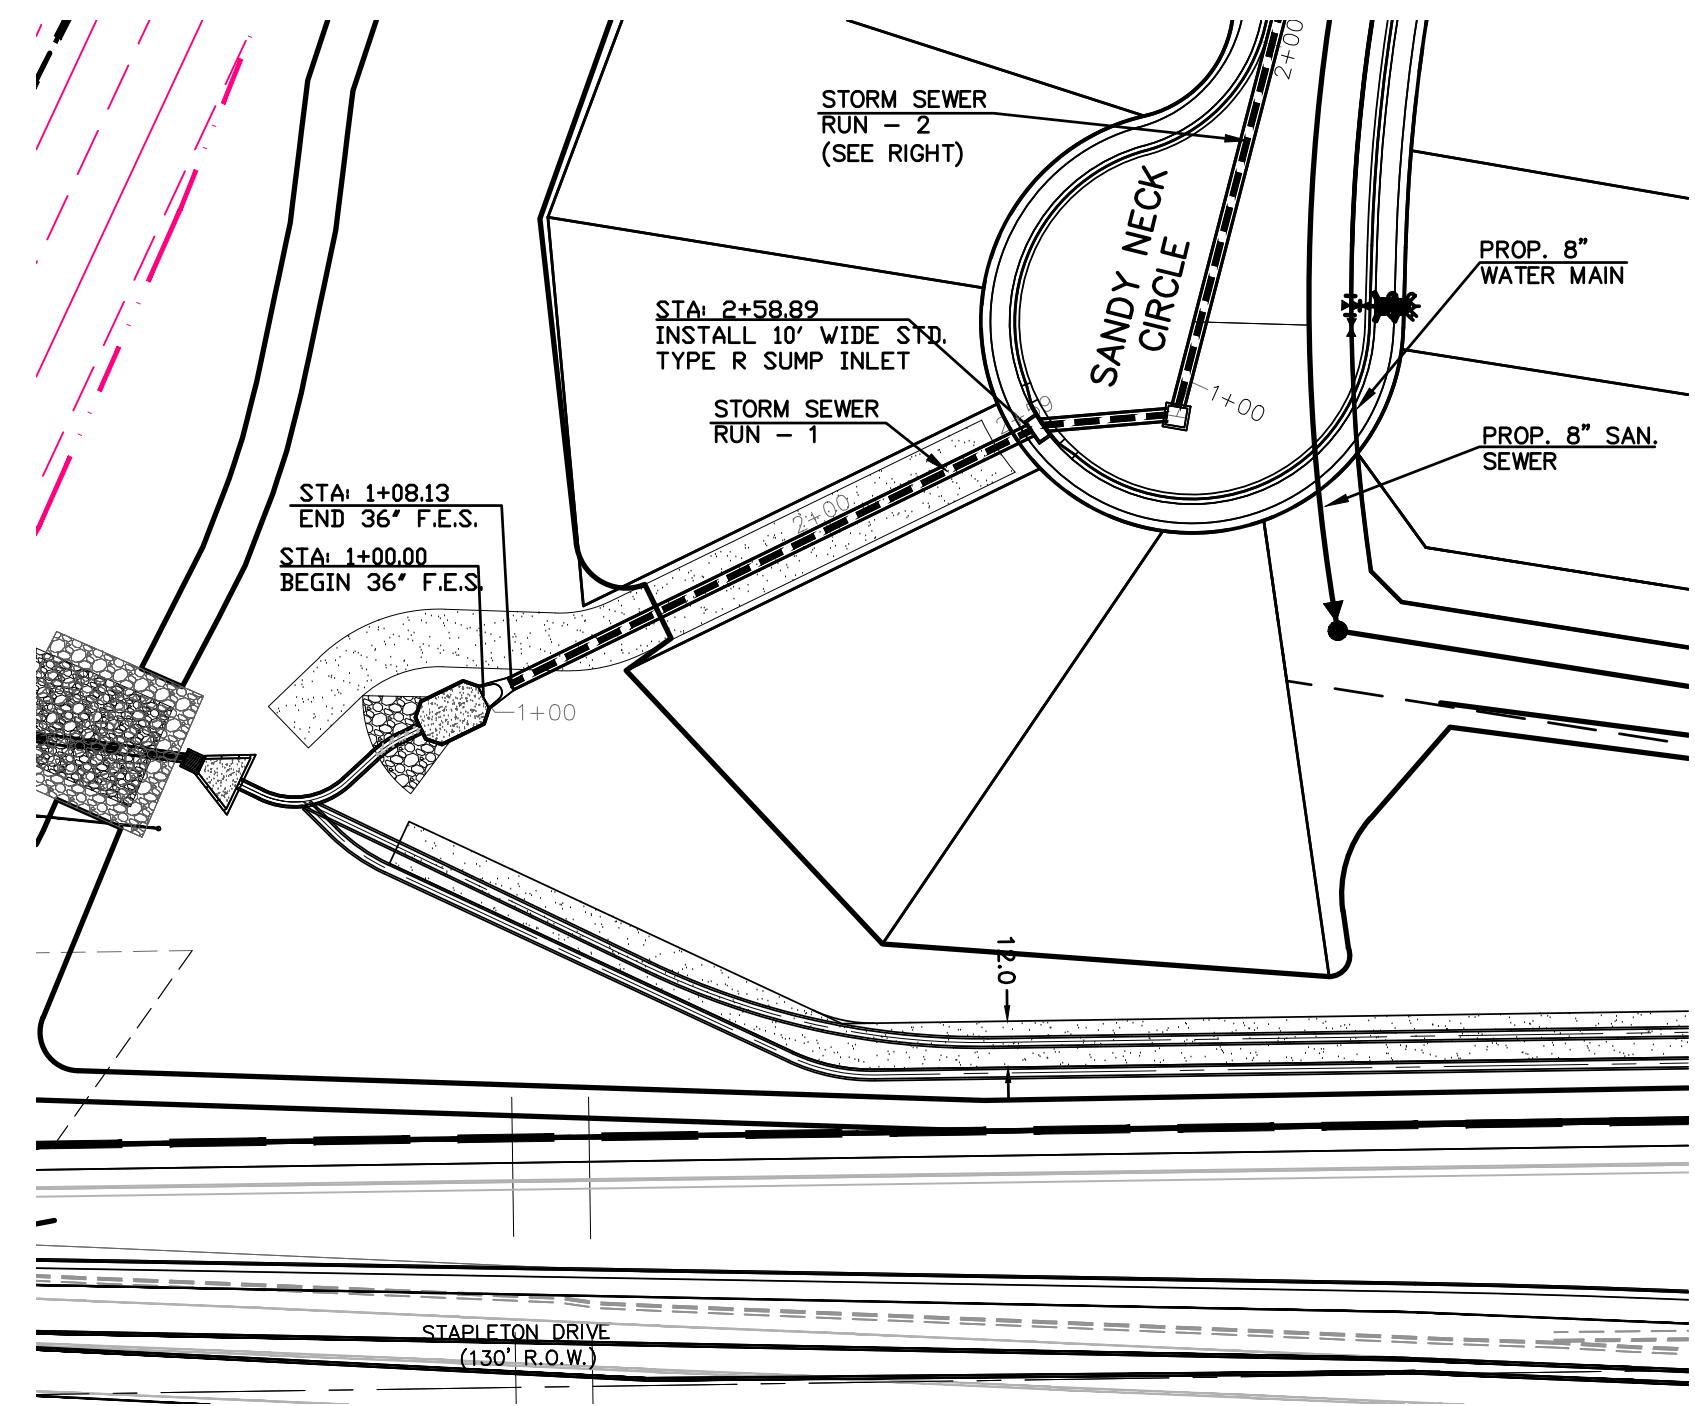

**STORM SEWER RUN-1 (PIPE RUN 7)**  
 PROPOSED PUBLIC RCP STORM SEWER  
 1" = 50' HORIZ. 1" = 5' VERT.

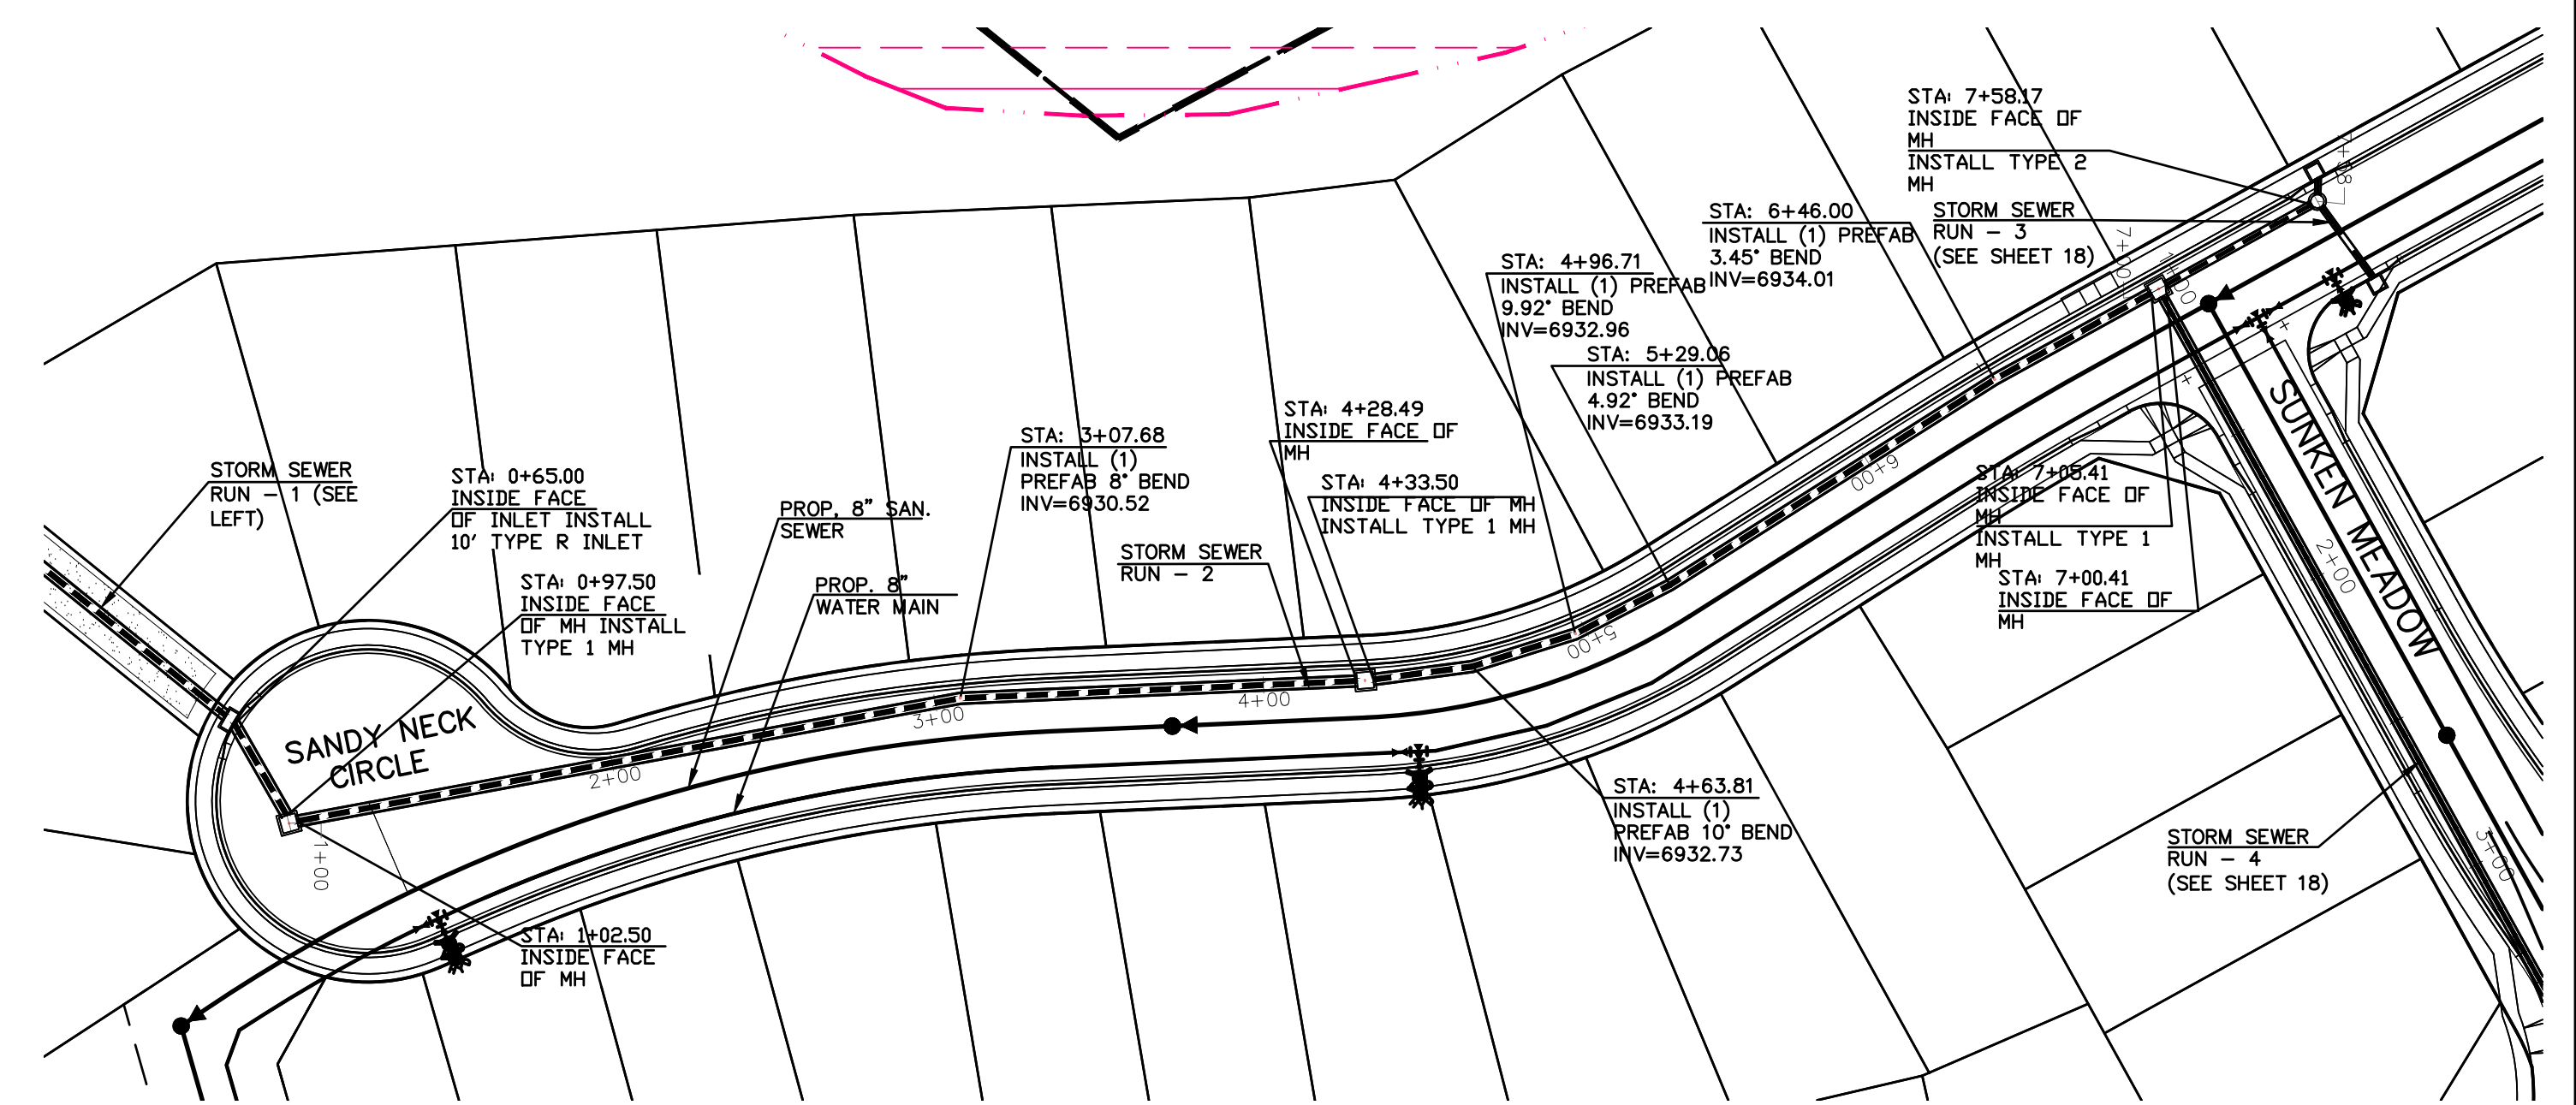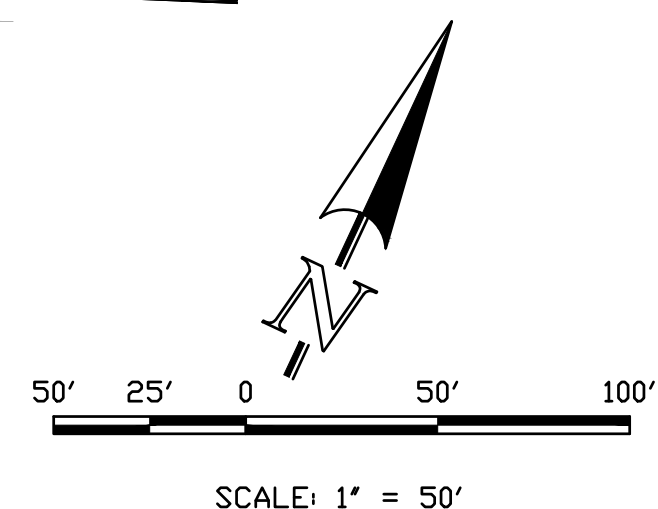


**STORM SEWER RUN-2 (PIPE RUN 5-6)**  
 PROPOSED PUBLIC RCP STORM SEWER  
 1" = 50' HORIZ. 1" = 5' VERT.

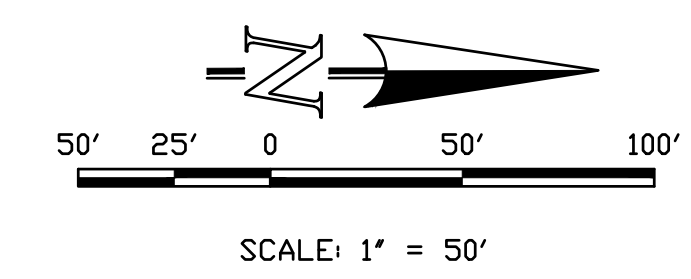

THIS DESIGN WAS PREPARED UNDER MY DIRECT SUPERVISION  
 FOR AND ON BEHALF OF TERRA NOVA ENGINEERING, INC.

QUENTIN N. ARMUJO, PROFESSIONAL ENGINEER  
 COLORADO P.E. NO. 37170

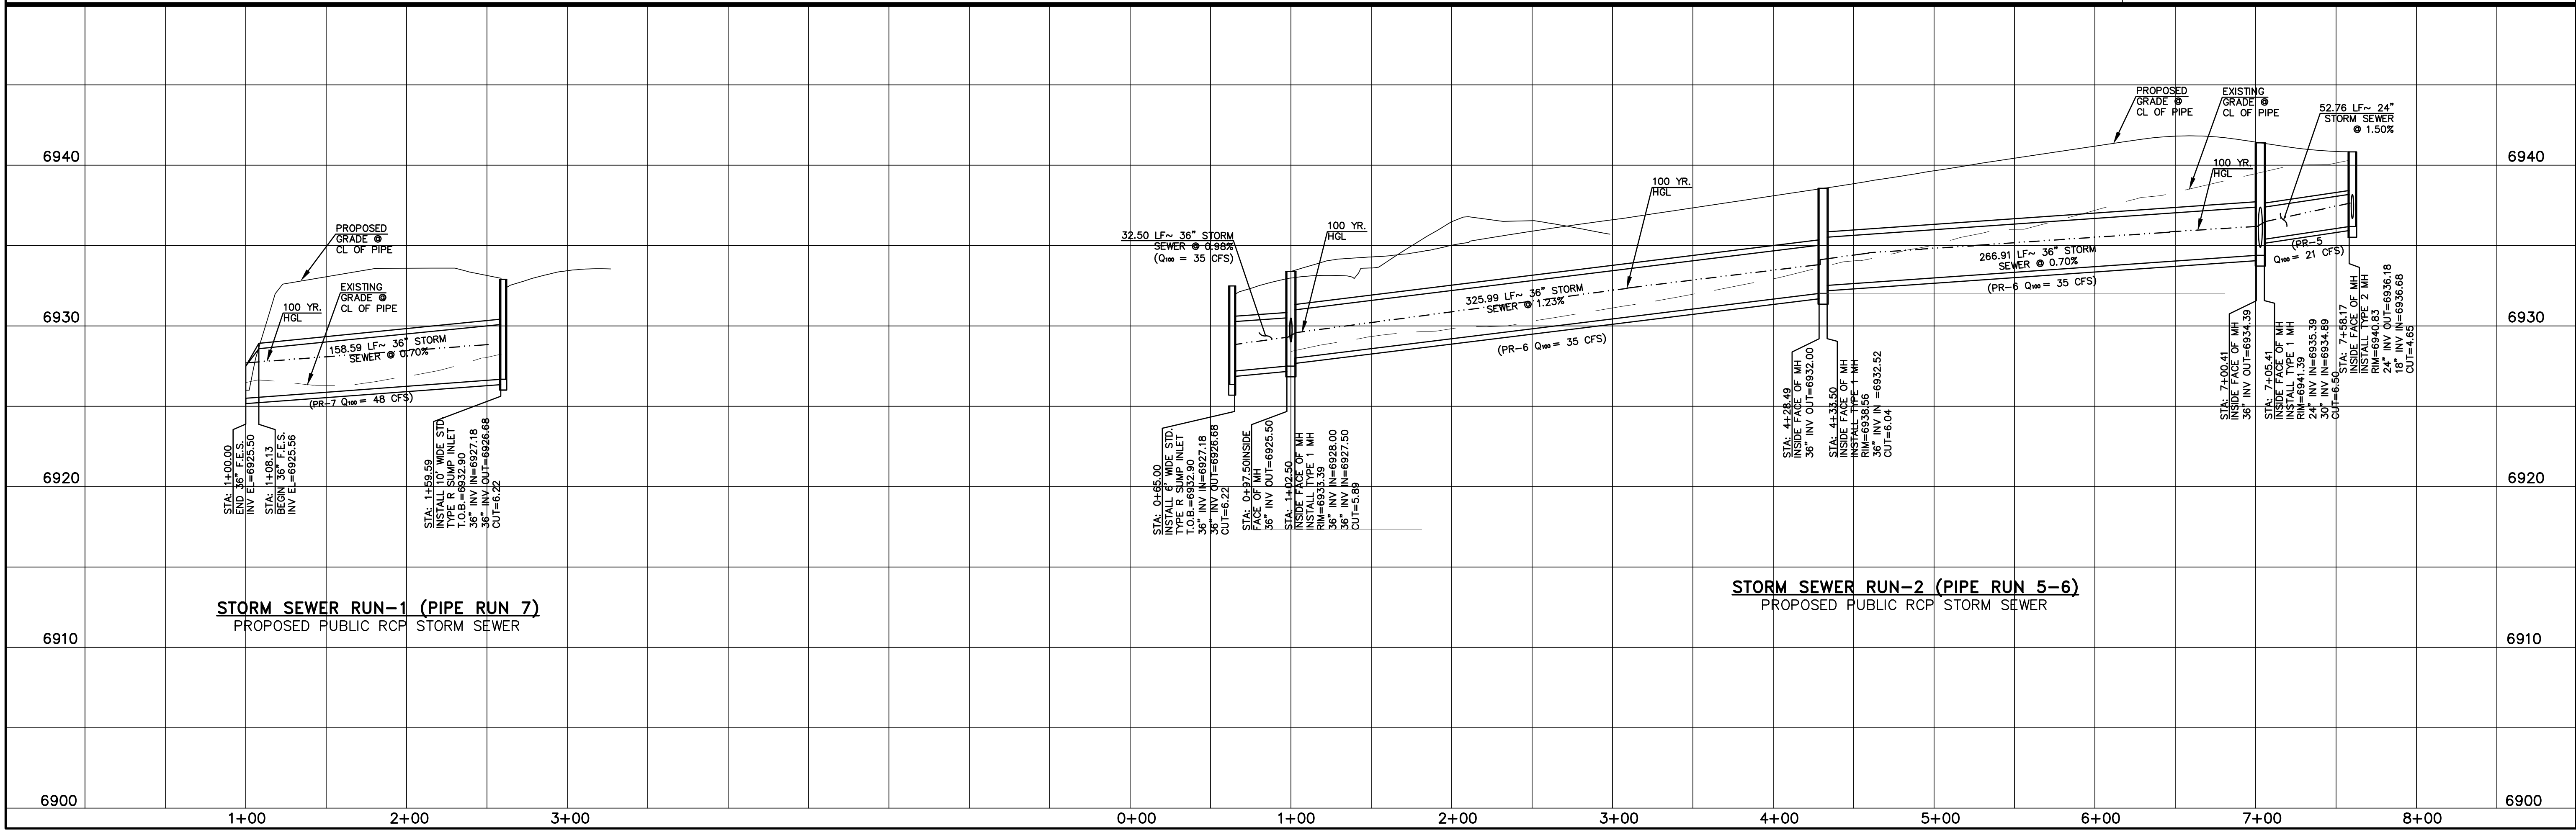


**STORM SEWER RUN-1 (PIPE RUN 7)**  
 PROPOSED PUBLIC RCP STORM SEWER

**STORM SEWER RUN-2 (PIPE RUN 5-6)**  
 PROPOSED PUBLIC RCP STORM SEWER

NO.	DESCRIPTION	DATE

UNTIL SUCH TIME AS THESE  
 DRAWINGS ARE APPROVED  
 BY THE LOCAL AGENCIES OR  
 TERRA NOVA ENGINEERING,  
 AND SURVEYING, INC.  
 APPROVES THEIR USE ONLY  
 AS AUTHORIZED BY WRITTEN  
 AUTHORIZATION.

PREPARED FOR:  
**4-WAY RANCH JOINT VENTURE**  
**PETER RANTZ**  
 P.O. BOX 50223  
 COLORADO SPRINGS, CO 80949  
 719-491-3150

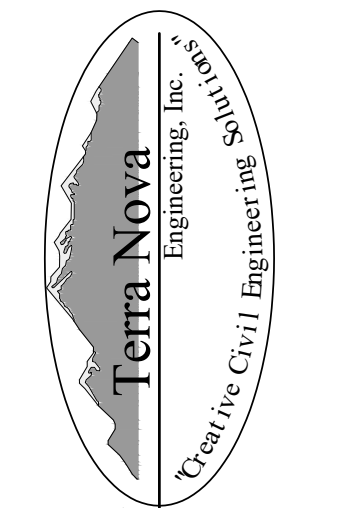

721 S. 2900 STREET  
 COLORADO SPRINGS, CO 80904  
 OFFICE: 719-635-6422  
 FAX: 719-635-6426  
 www.tneshc.com

**WATERBURY FILING NO. 1**  
 CONSTRUCTION SET  
 STORM SEWER PLAN AND PROFILE  
 STORM RUNS 1 & 2

DESIGNED BY QNA  
 DRAWN BY QNA  
 CHECKED BY  
 H-SCALE 1"=50'  
 V-SCALE 1"=5'  
 JOB NO. 1715.00  
 DATE ISSUED 2/6/23  
 SHEET NO. 23 OF 39

REVISIONS	NO.	DESCRIPTION	DATE

UNTIL SUCH TIME AS THESE DRAWINGS ARE APPROVED BY THE RELEVANT AGENCIES (SEE TERRA NOVA ENGINEERING AND SURVEYING, INC. APPROVES THEIR USE ONLY) APPROVED FOR YOUR USE ONLY. DESIGNED BY WRITTEN AUTHORIZATION.

PREPARED FOR:  
**4-WAY RANCH JOINT VENTURE**  
**PETER MARTZ**  
 P.O. BOX 50223  
 COLORADO SPRINGS, CO 80949  
 719-491-3150



Terra Nova  
 Engineering, Inc.  
 P. 12011015  
 Civil Engineer

721 S. 2900 STREET  
 COLORADO SPRINGS, CO 80904  
 OFFICE: 719-635-6422  
 FAX: 719-635-6426  
 www.tneshc.com

**WATERBURY FILING NO. 1**

CONSTRUCTION SET  
 STORM SEWER PLAN AND PROFILE  
 STORM RUNS 3 & 4

DESIGNED BY QNA  
 DRAWN BY QNA  
 CHECKED BY  
 H-SCALE 1"=50'  
 V-SCALE 1"=5'  
 JOB NO. 1715.00  
 DATE ISSUED 2/6/23  
 SHEET NO. 24 OF 37

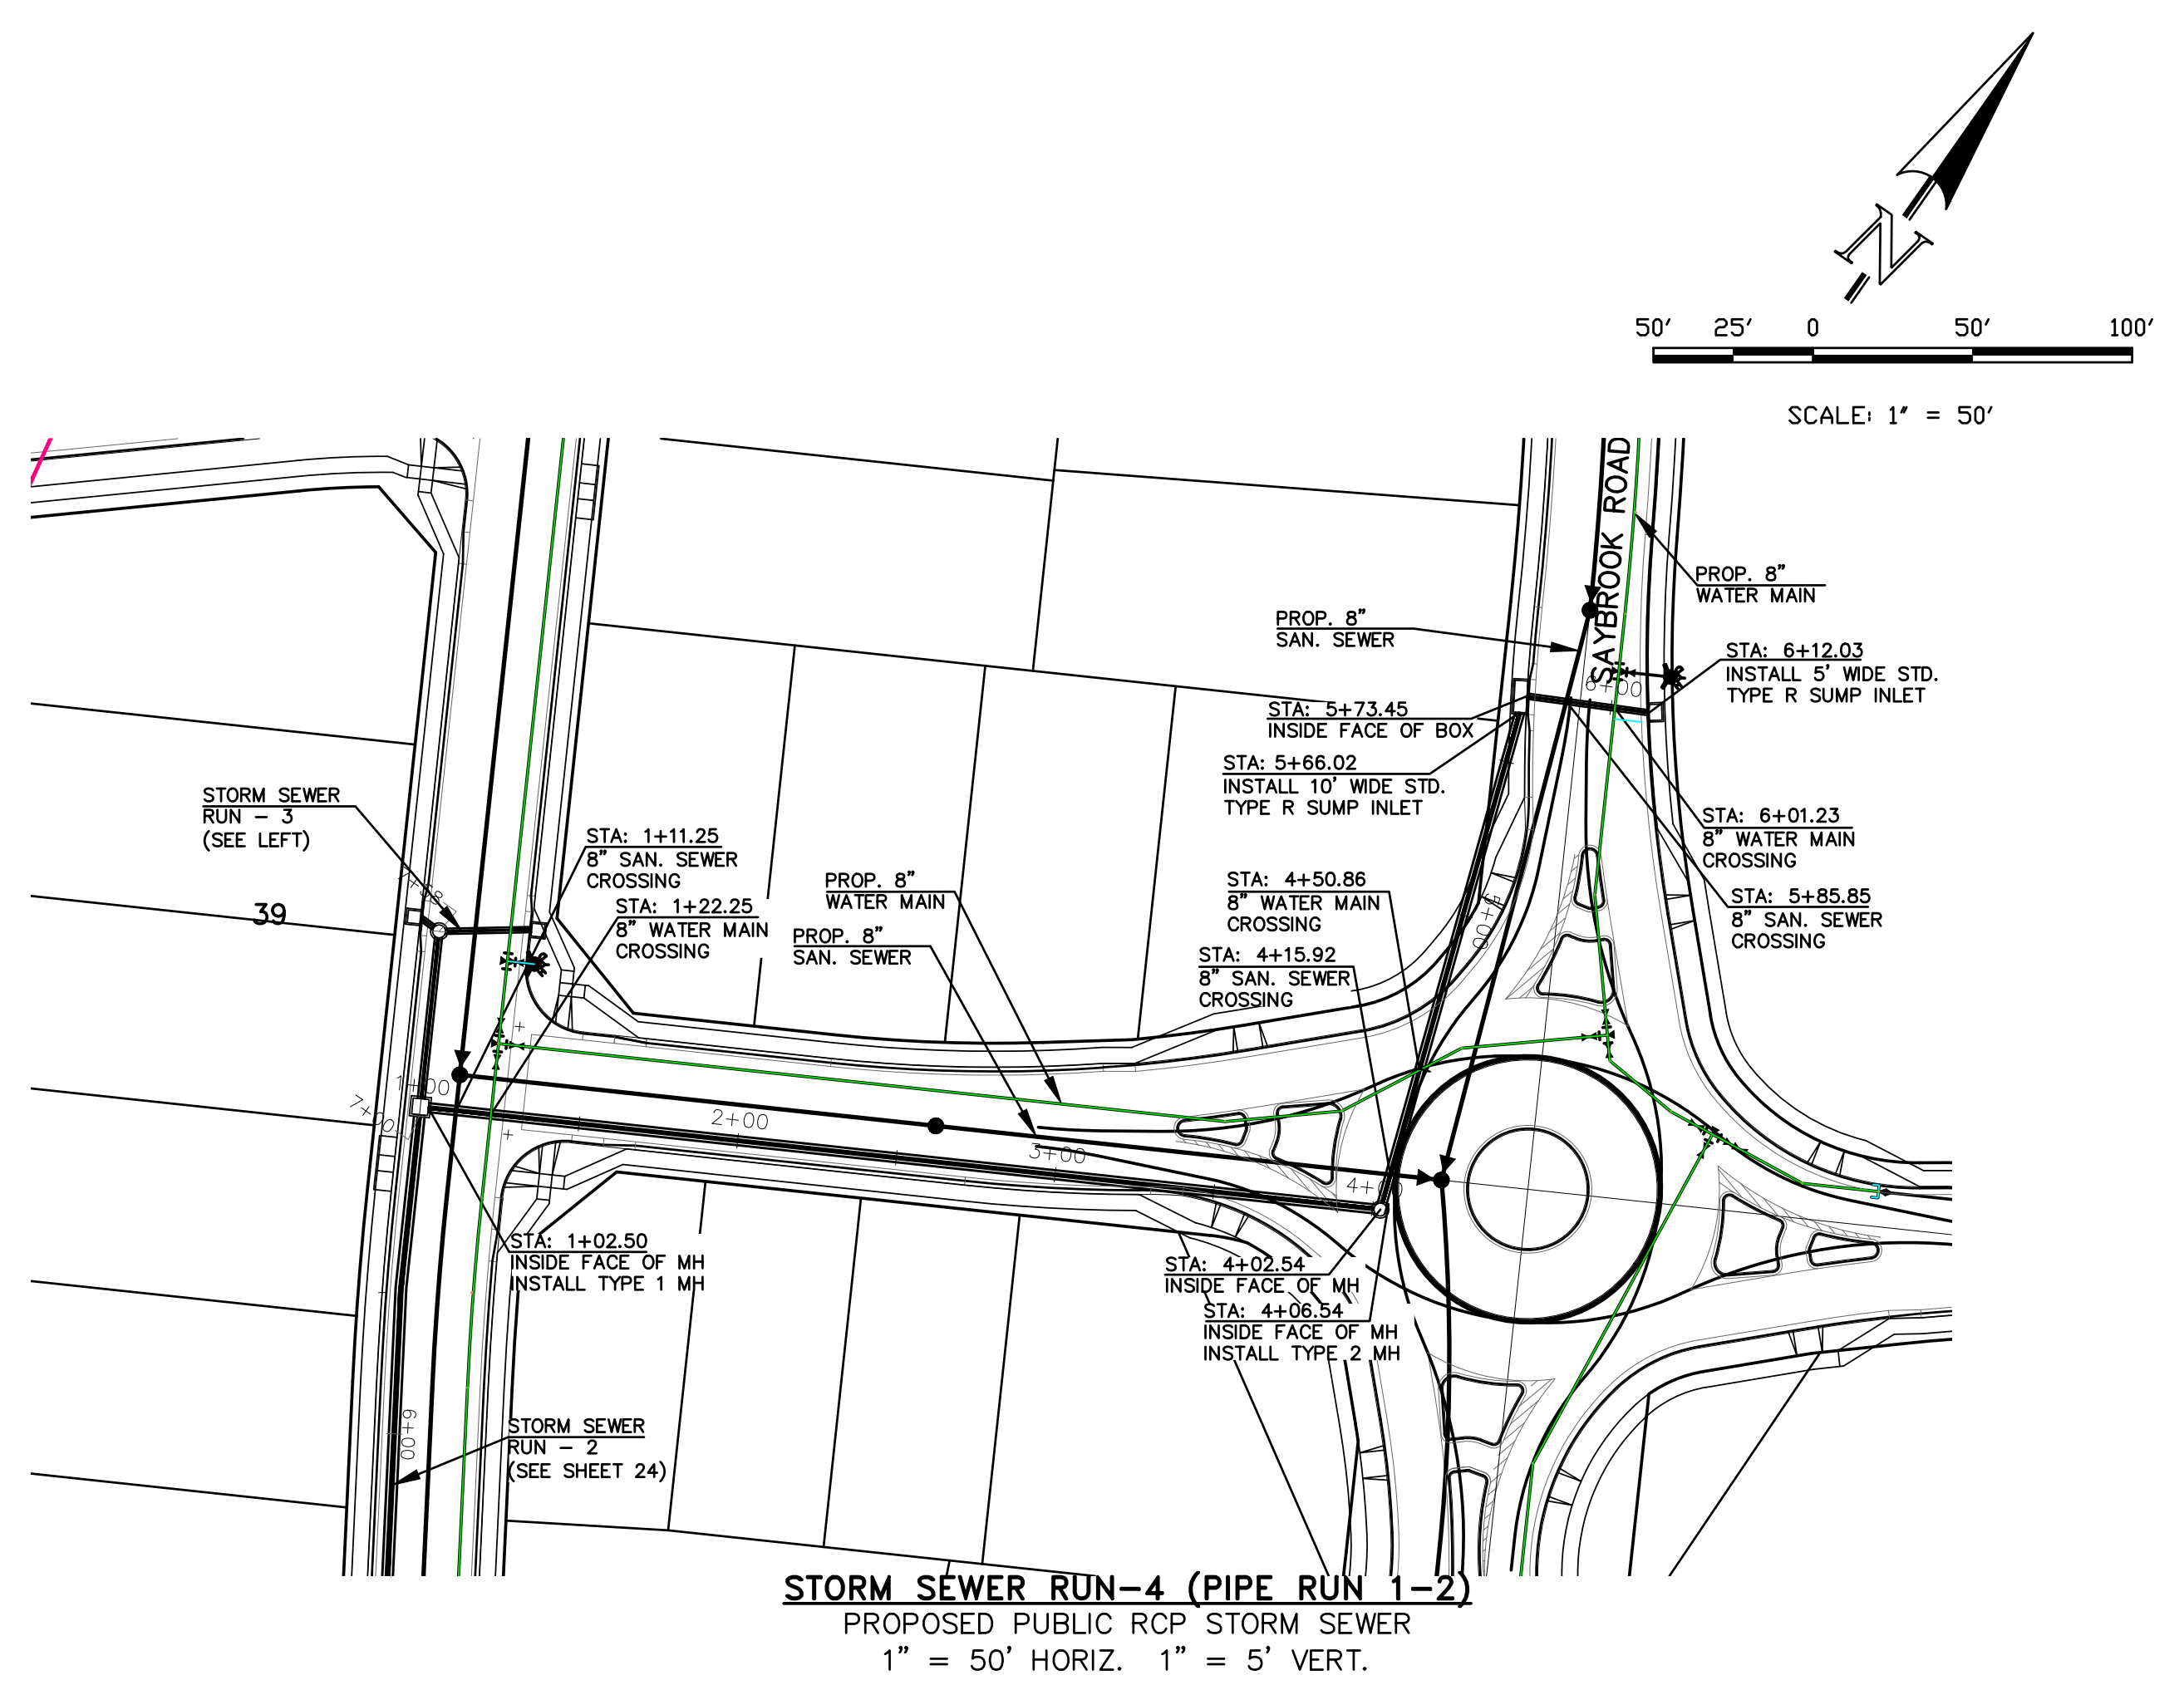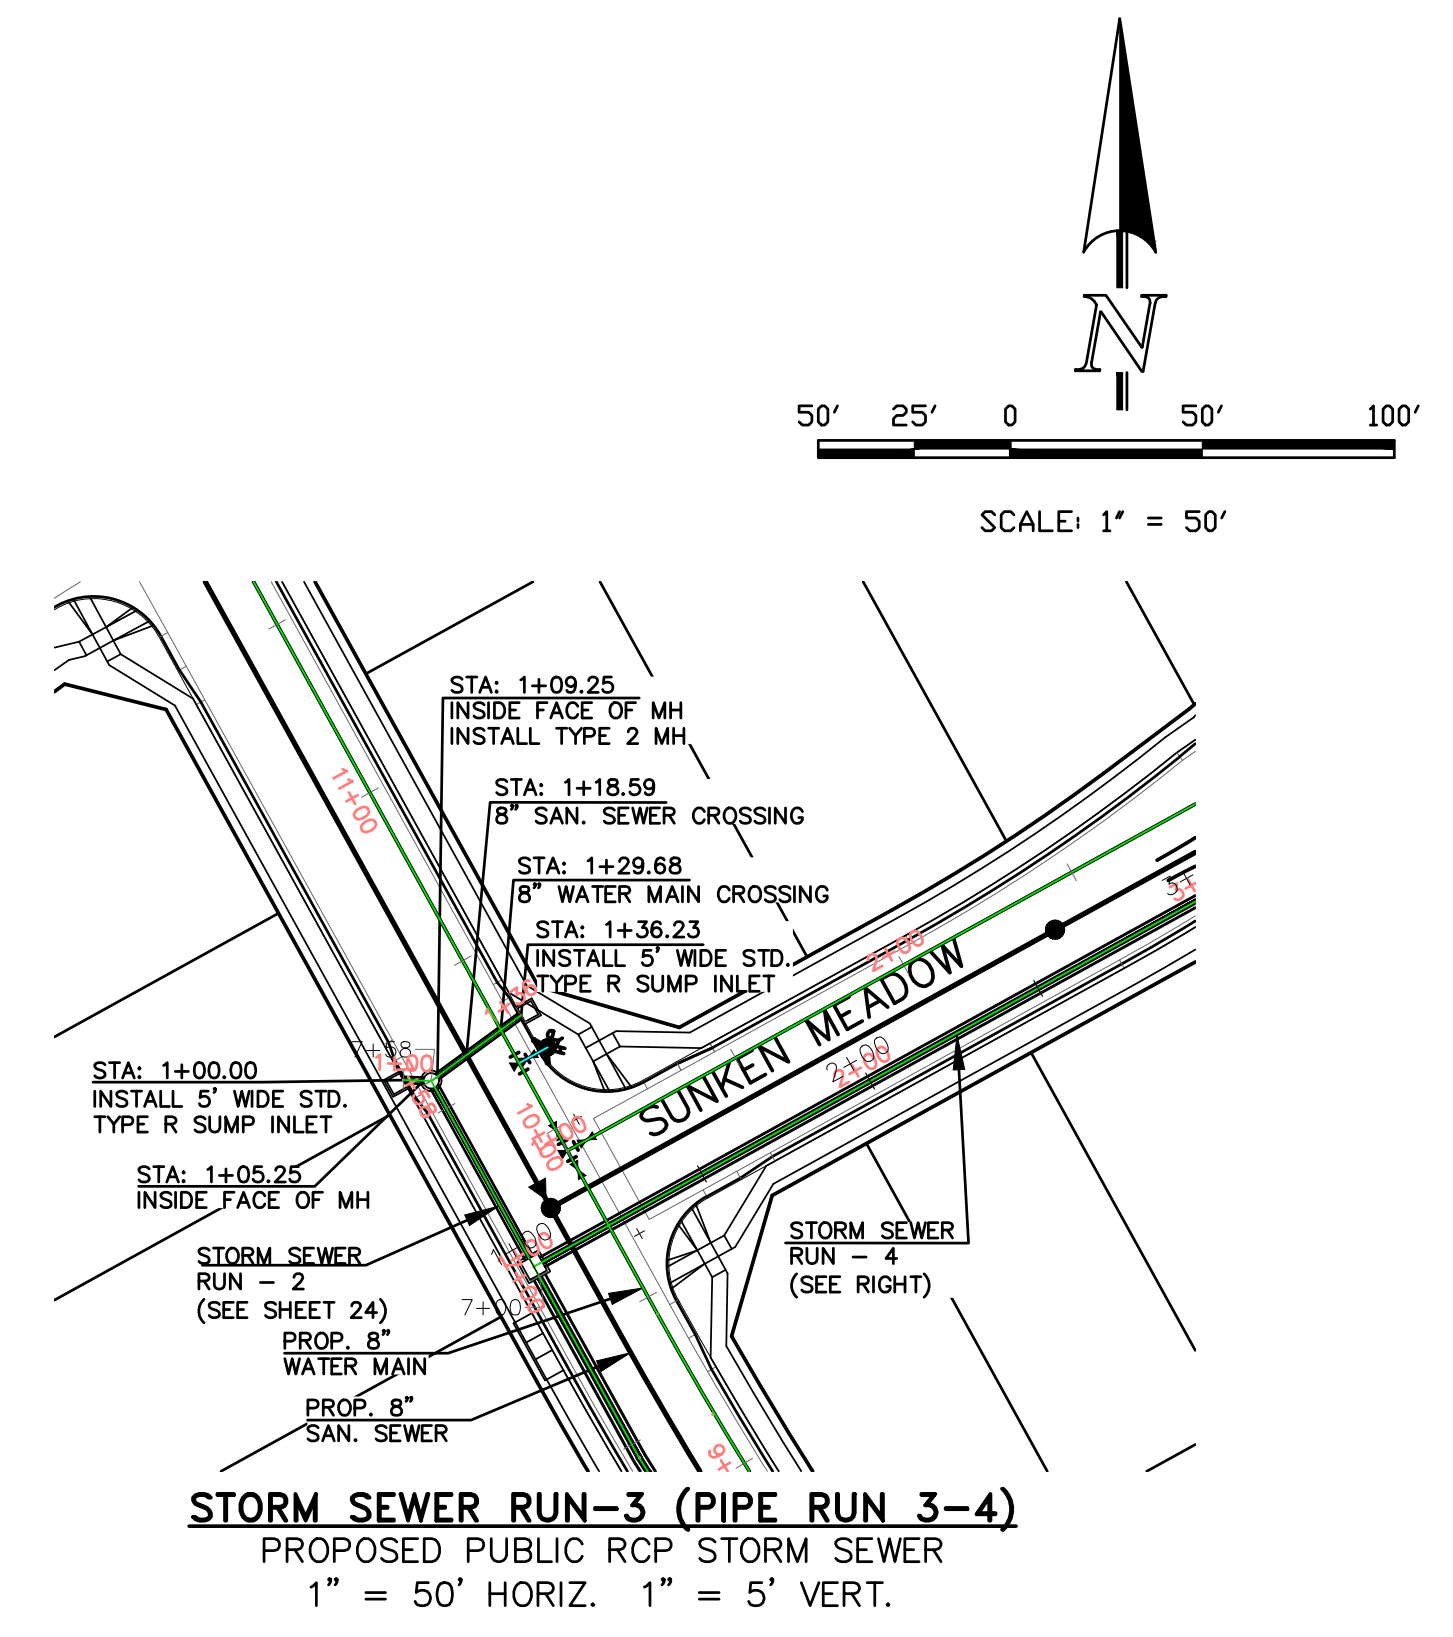

THIS DESIGN WAS PREPARED UNDER MY DIRECT SUPERVISION FOR AND ON BEHALF OF TERRA NOVA ENGINEERING, INC.

QUENTIN N. ARMUO, PROFESSIONAL ENGINEER  
 COLORADO P.E. NO. 37170

ELEVATION	STATION	DESCRIPTION	ELEVATION
6950	1+00	26.98 LF- 18" STORM SEWER @ 2.00% (PR-3 Q <sub>100</sub> = 8 CFS)	6950
6940	1+00	5.25 LF- 18" STORM SEWER @ 1.90% (PR-4 Q <sub>100</sub> = 13 CFS)	6940
6930	1+00	300.04 LF- 30" STORM SEWER @ 0.60% (PR-2 Q <sub>100</sub> = 15 CFS)	6930
6920	1+00	159.48 LF- 30" STORM SEWER @ 1.00% (PR-1 Q <sub>100</sub> = 4 CFS)	6920
6910	1+00	38.58 LF- 18" STORM SEWER @ 1.00% (PR-1 Q <sub>100</sub> = 4 CFS)	6910


**STORM SEWER RUN-3 (PIPE RUN 3-4)**  
 PROPOSED PUBLIC RCP STORM SEWER

**STORM SEWER RUN-4 (PIPE RUN 1-2)**  
 PROPOSED PUBLIC RCP STORM SEWER








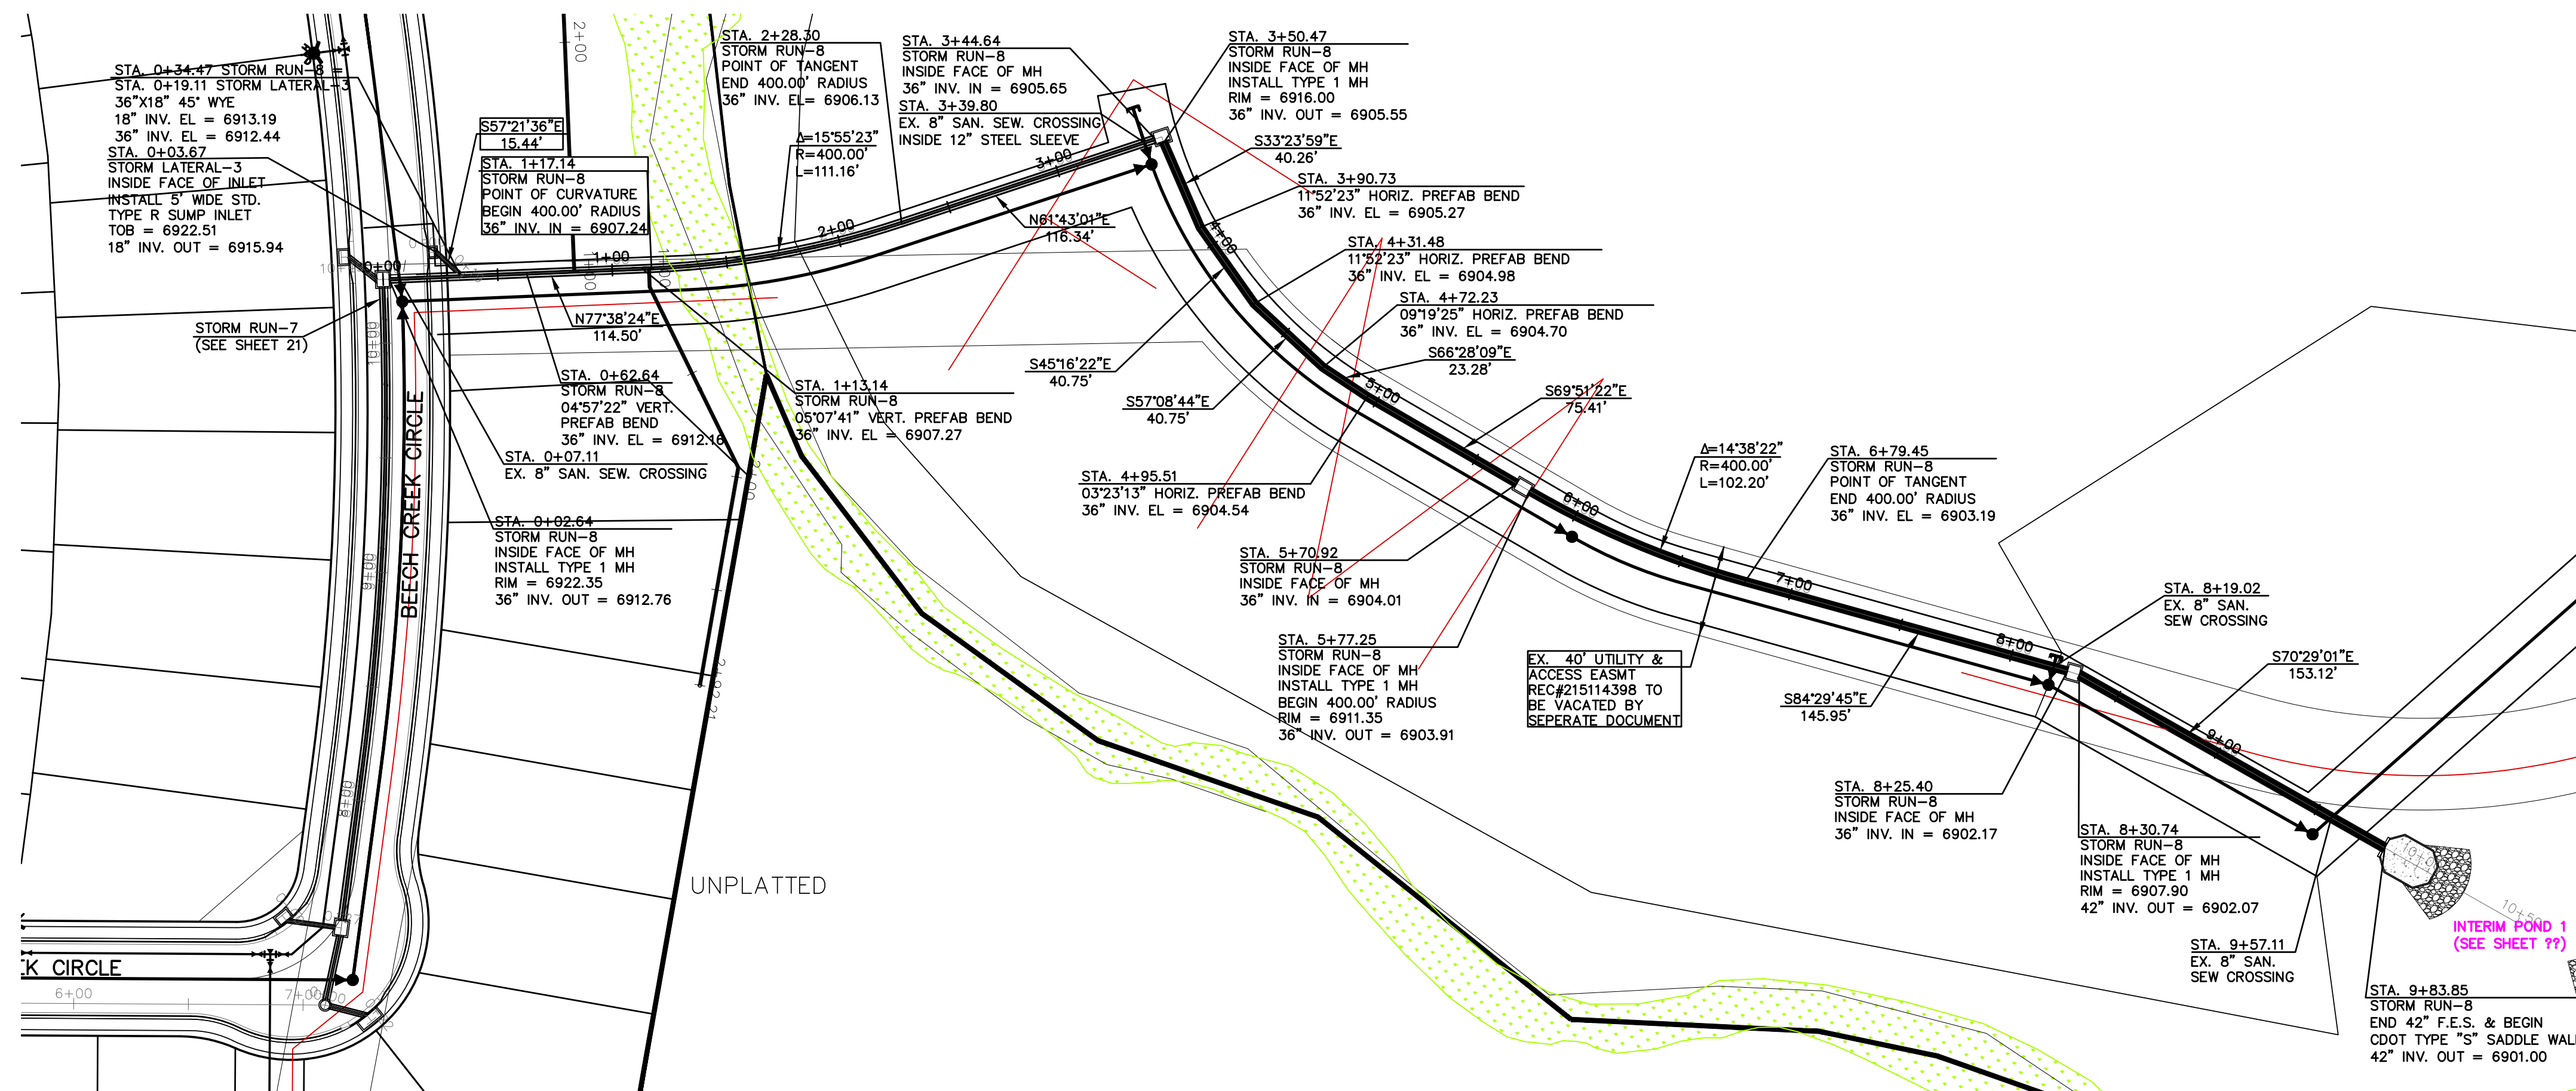

**STORM SEWER LATERAL-3 & RUN-8 (PIPE RUN 16 & 17)**  
 PROPOSED PUBLIC RCP STORM SEWER  
 1" = 50' HORIZ. 1" = 5' VERT.

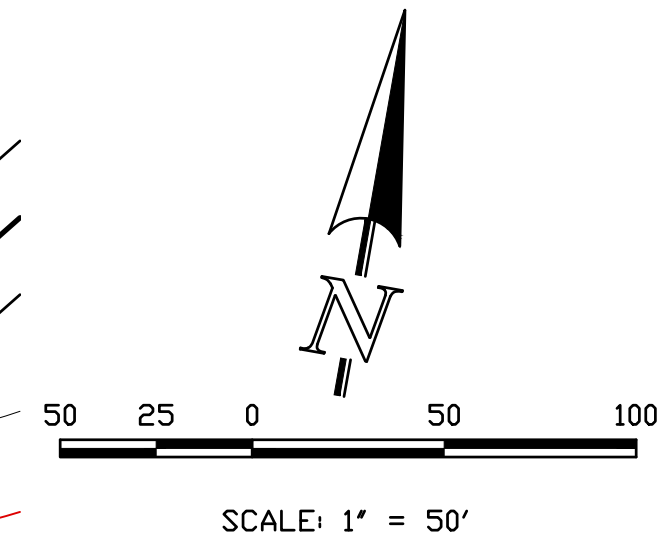


THIS DESIGN WAS PREPARED UNDER MY DIRECT SUPERVISION FOR AND ON BEHALF OF TERRA NOVA ENGINEERING, INC.

QUENTIN N. ARMUO, PROFESSIONAL ENGINEER  
 COLORADO P.E. NO. 37170

NO.	DESCRIPTION	DATE

UNTL SUCH TIME AS THESE DRAWINGS ARE APPROVED BY THE REVIEWING AGENCIES, THE REVIEWING AGENCIES, TERRA NOVA ENGINEERING AND SURVEYING, INC. APPROVES THEIR USE ONLY AS AUTHORIZED BY WRITTEN AUTHORIZATION.


PREPARED FOR:  
**4-WAY RANCH JOINT VENTURE**  
 PETER MARTZ  
 P.O. BOX 50223  
 COLORADO SPRINGS, CO 80949  
 719-491-3150

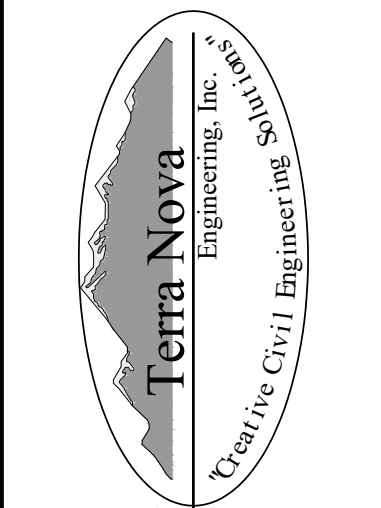

721 S. 2900 STREET  
 COLORADO SPRINGS, CO 80904  
 OFFICE: 719-635-6422  
 FAX: 719-635-6426  
 www.tneshc.com

**WATERBURY FILING NO. 1**  
 CONSTRUCTION SET  
 STORM SEWER PLAN AND PROFILE  
 LATERAL 3 & STORM RUN-8

DESIGNED BY QNA  
 DRAWN BY QNA  
 CHECKED BY  
 H-SCALE 1"=50'  
 V-SCALE 1"=5'  
 JOB NO. 1715.00  
 DATE ISSUED 2/6/23  
 SHEET NO. 27 OF 37

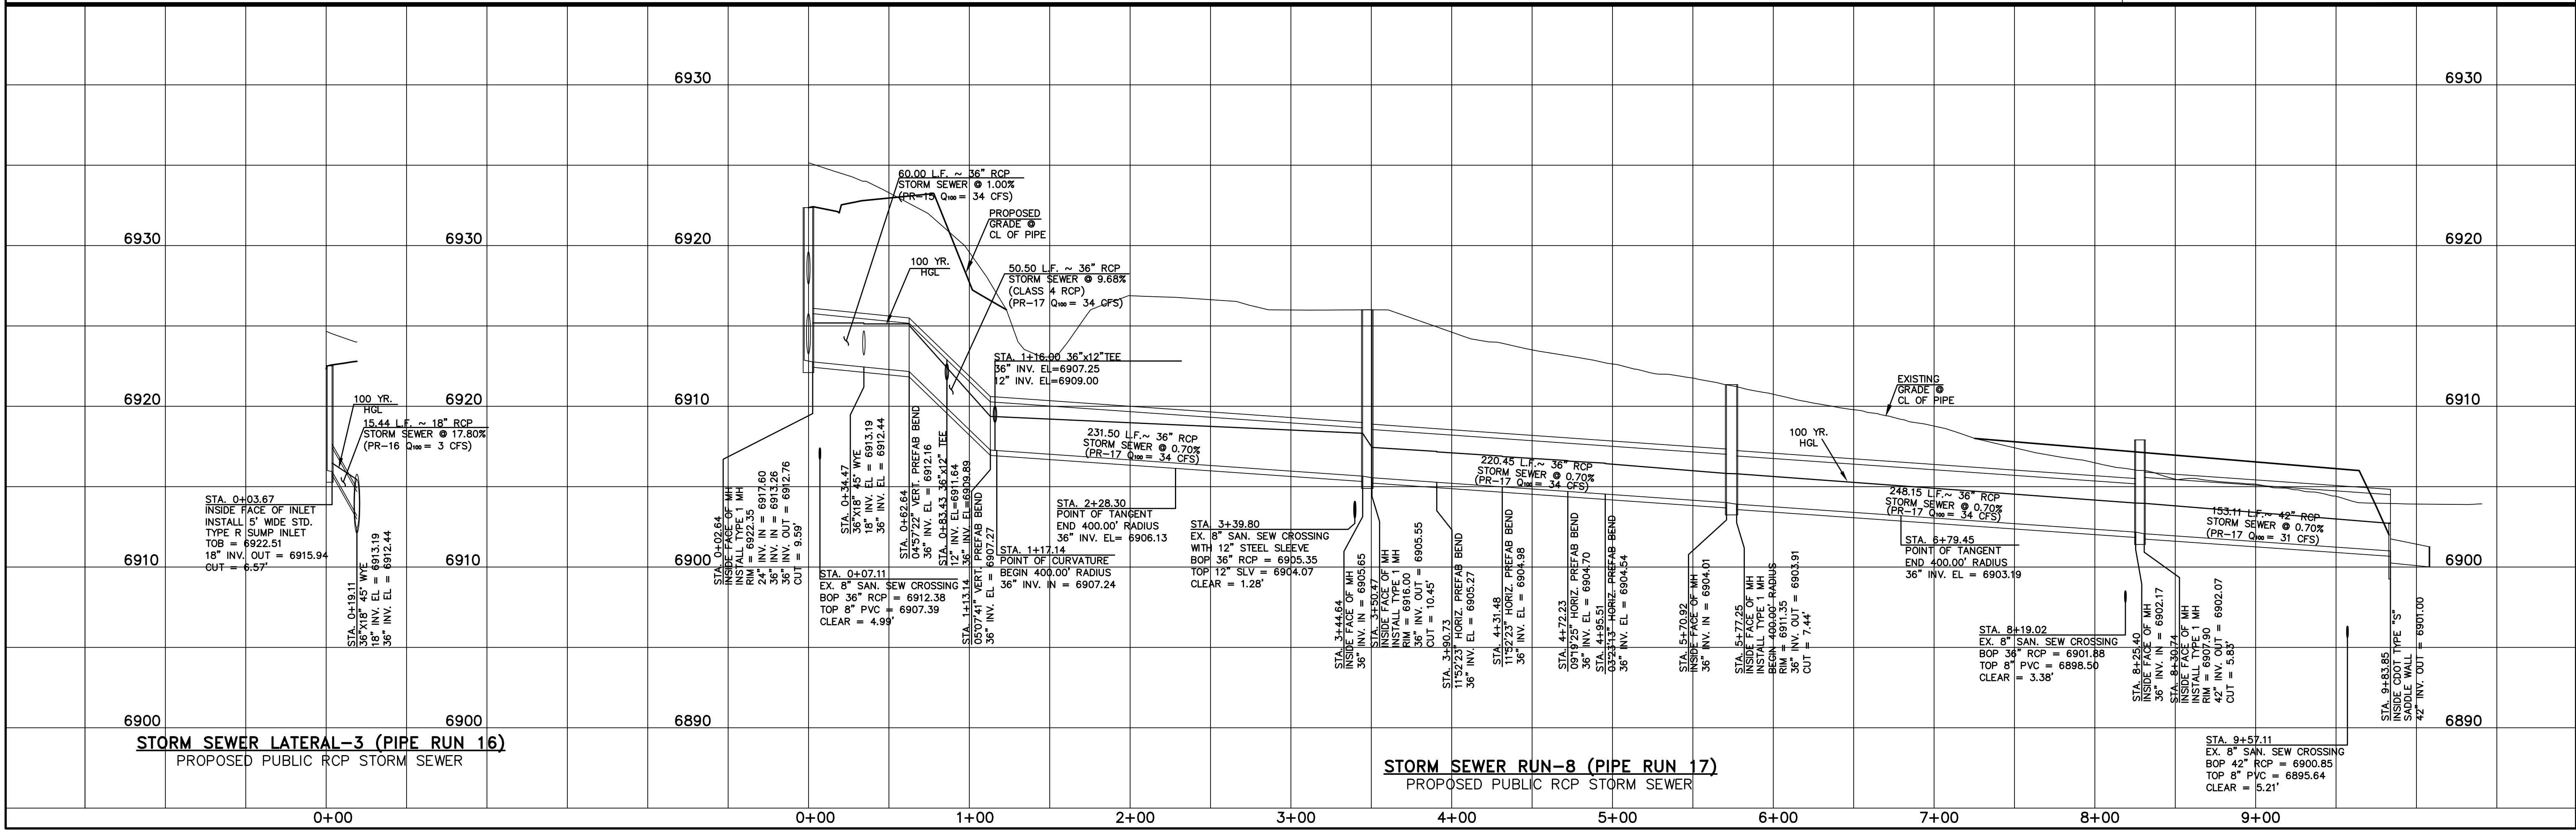


**STORM SEWER LATERAL-3 (PIPE RUN 16)**  
 PROPOSED PUBLIC RCP STORM SEWER



**STORM SEWER RUN-8 (PIPE RUN 17)**  
 PROPOSED PUBLIC RCP STORM SEWER

**STORM SEWER LATERAL-3 (PIPE RUN 16)**  
 PROPOSED PUBLIC RCP STORM SEWER





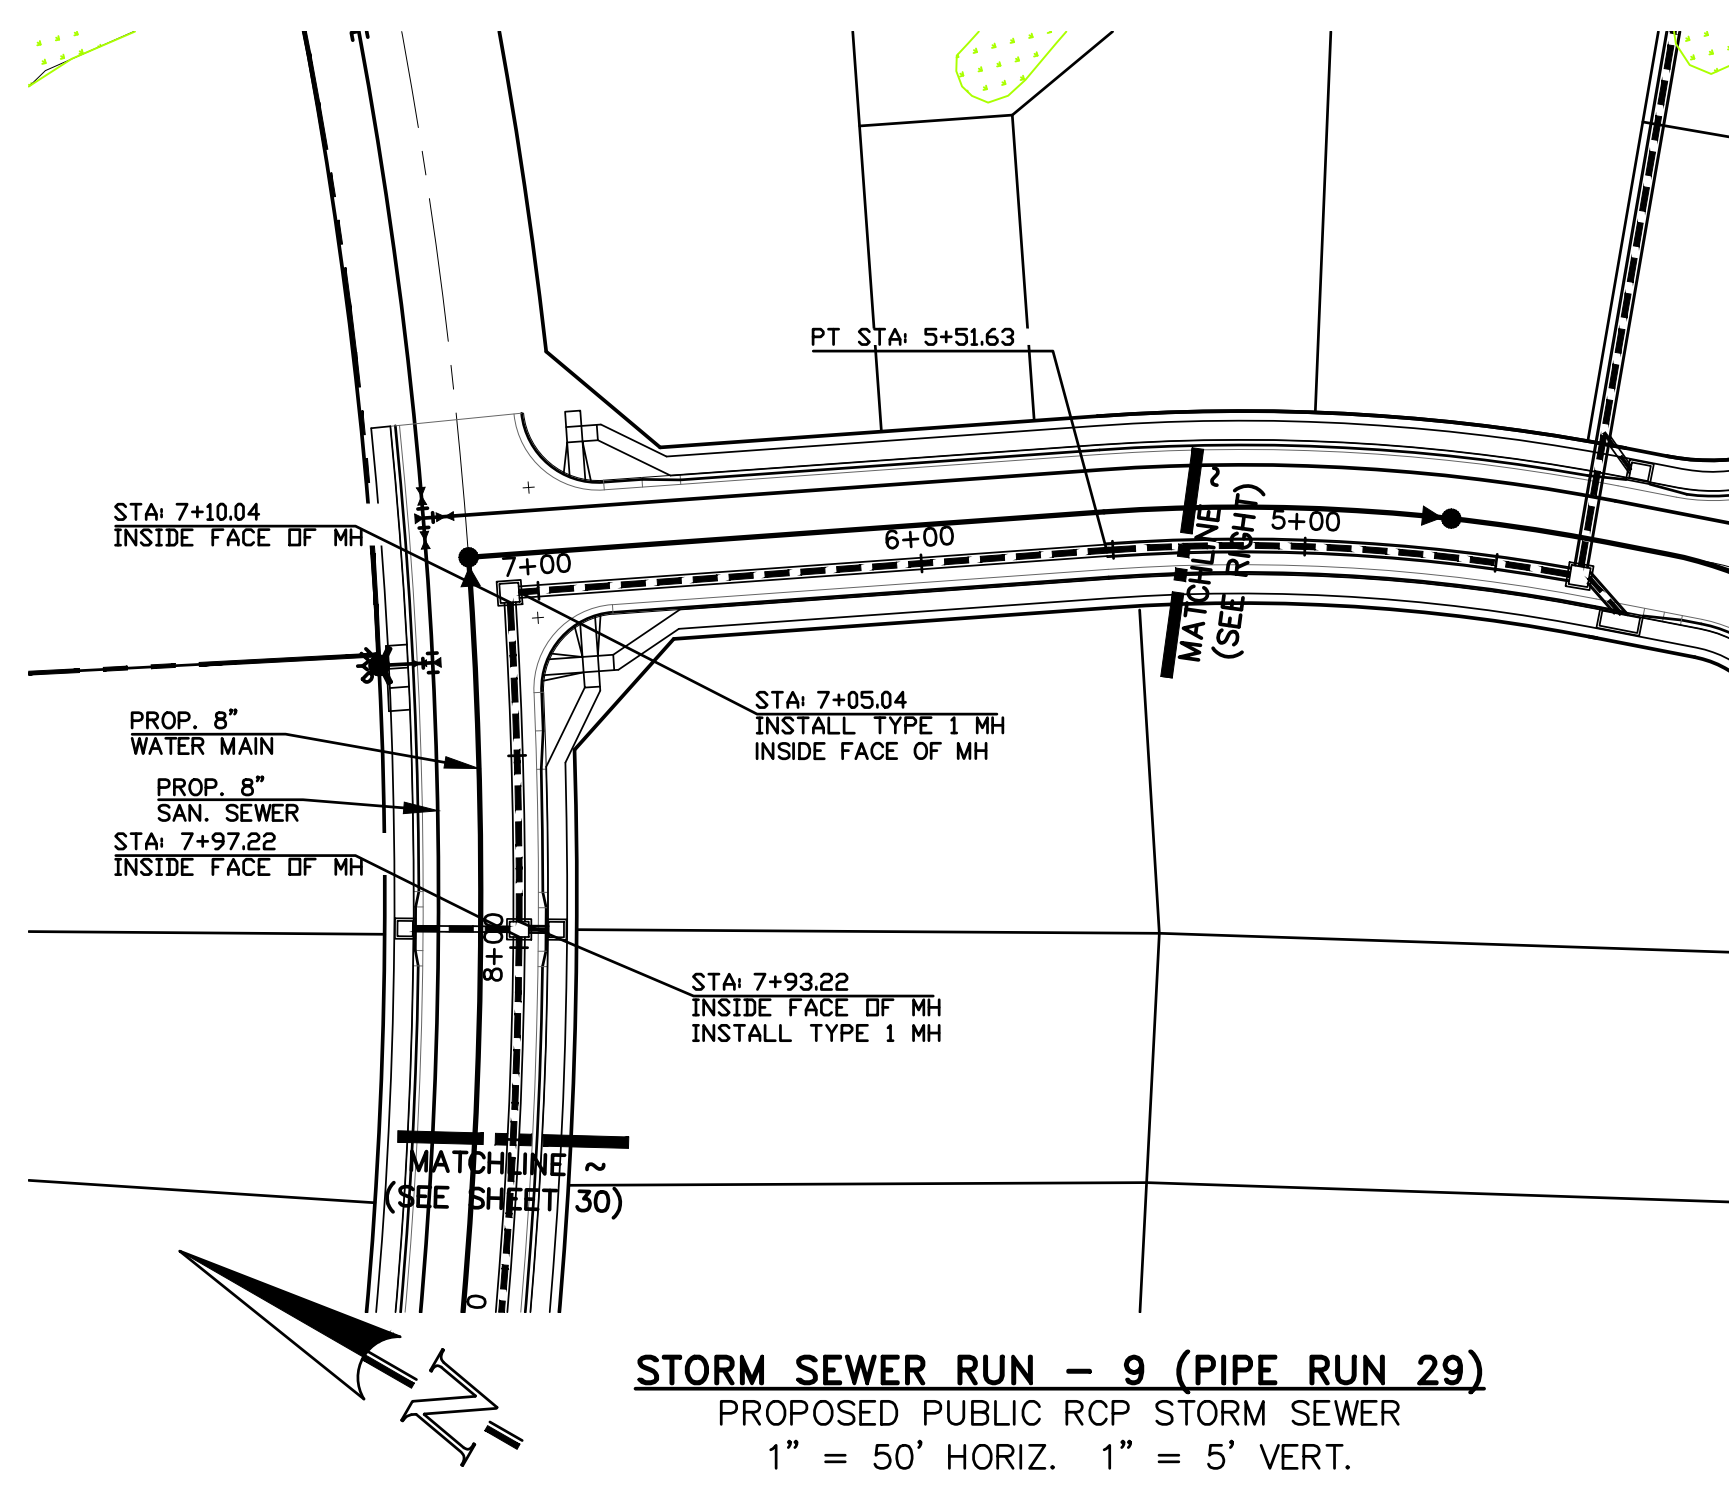

**STORM SEWER RUN - 9 (PIPE RUN 29)**  
 PROPOSED PUBLIC RCP STORM SEWER  
 1" = 50' HORIZ. 1" = 5' VERT.

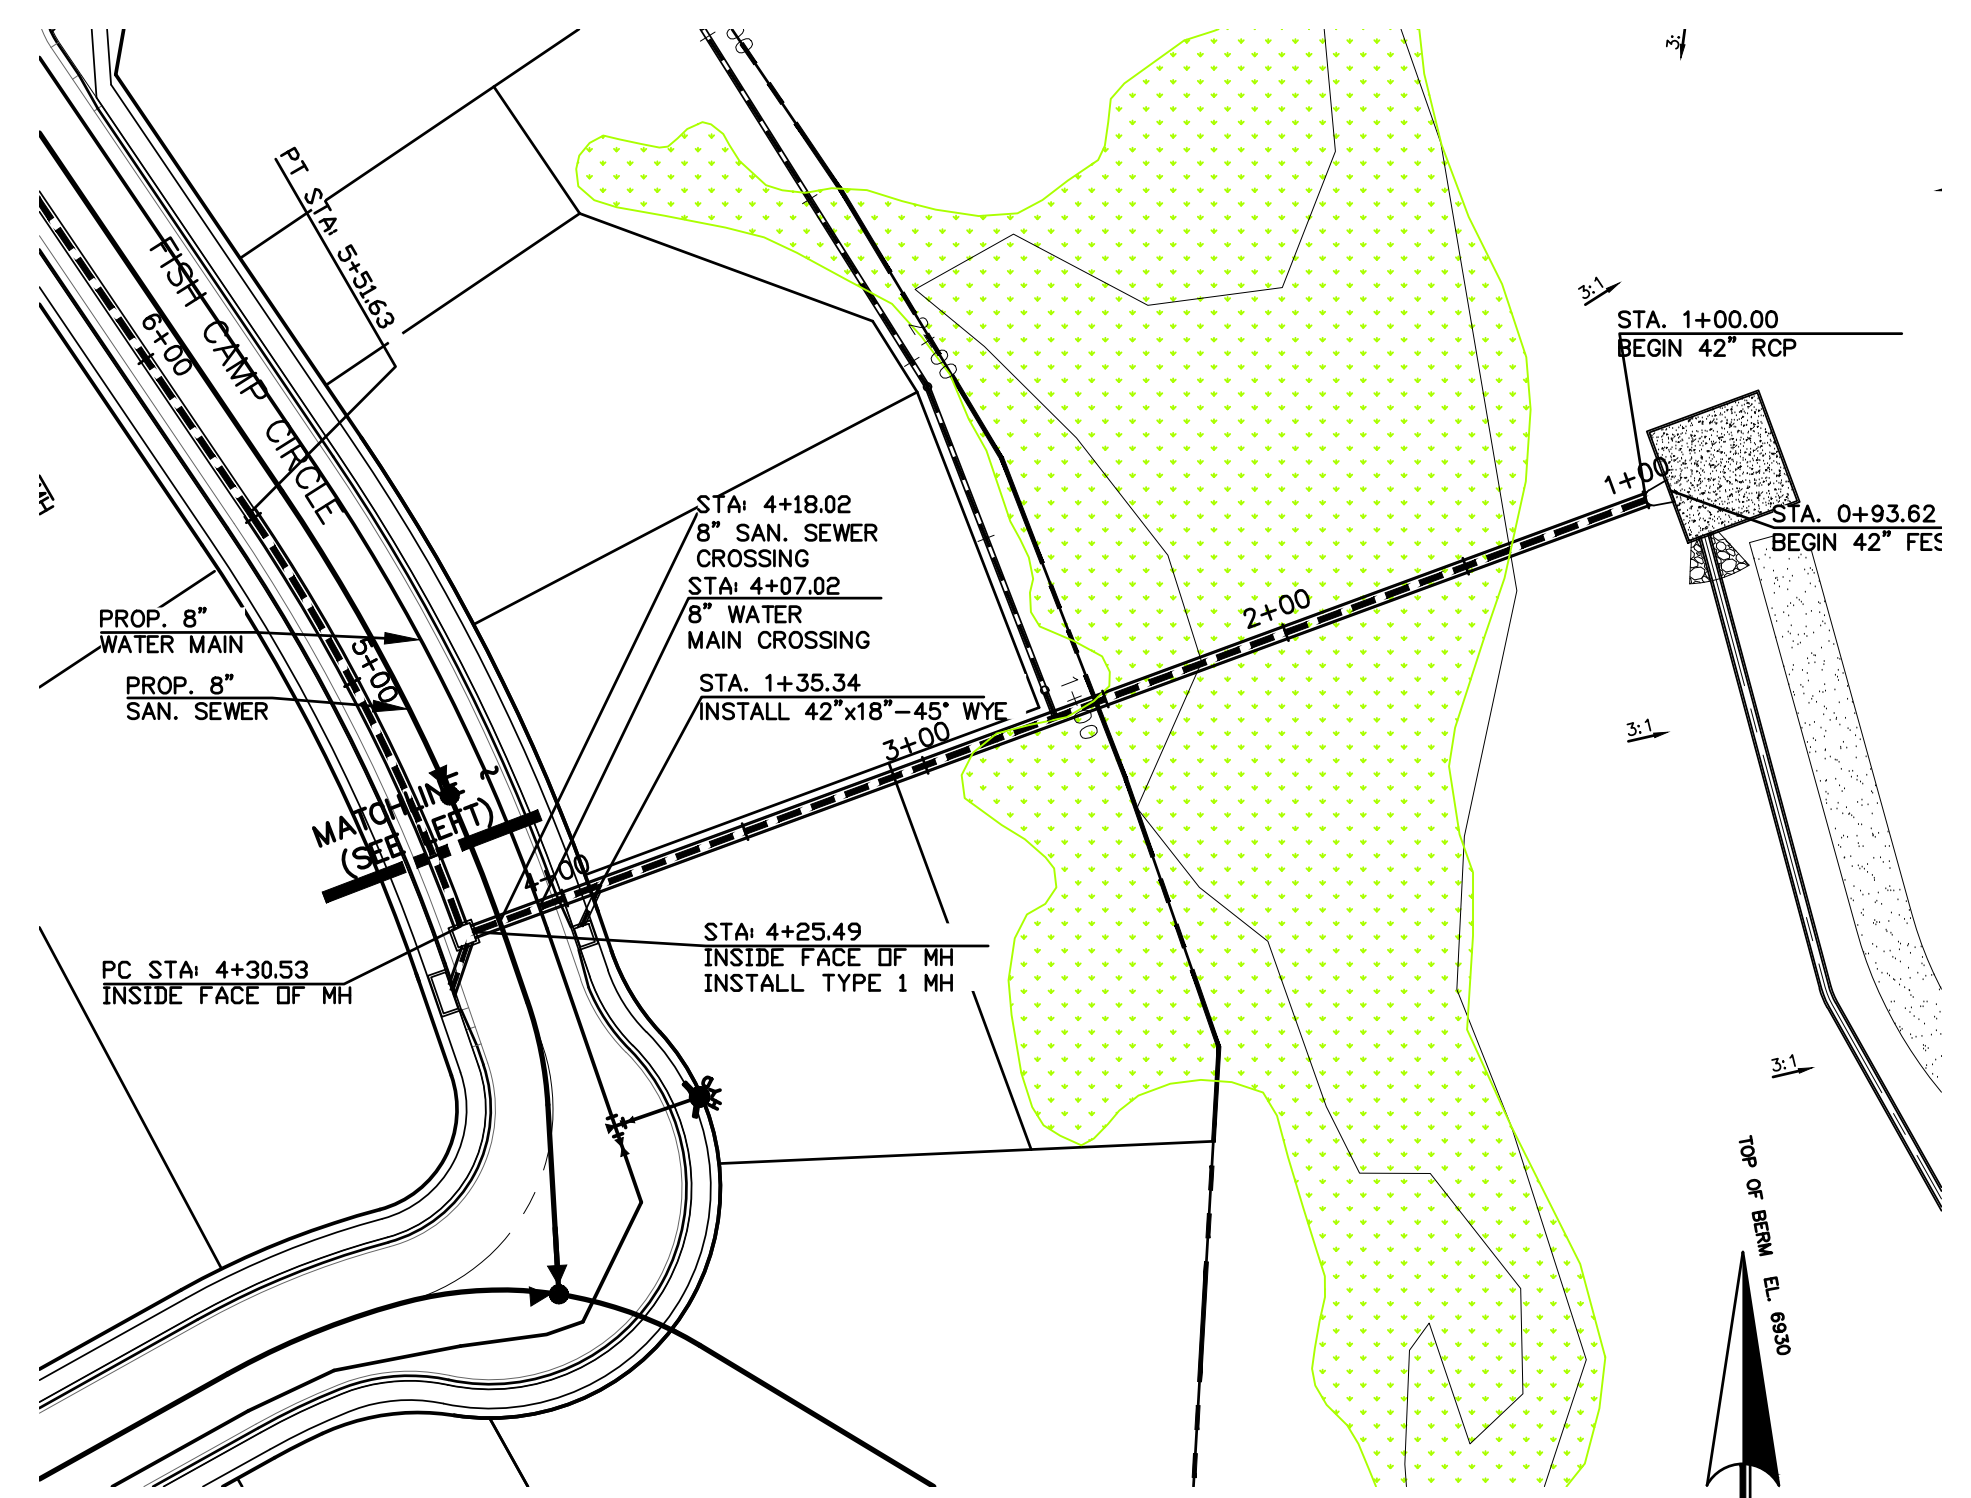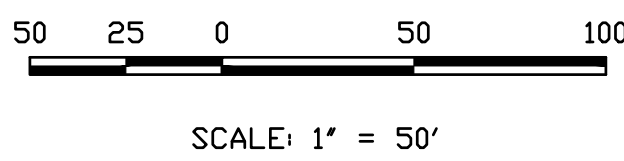


**STORM SEWER RUN - 9 (PIPE RUN 31 & 33)**  
 PROPOSED PUBLIC RCP STORM SEWER  
 1" = 50' HORIZ. 1" = 5' VERT.

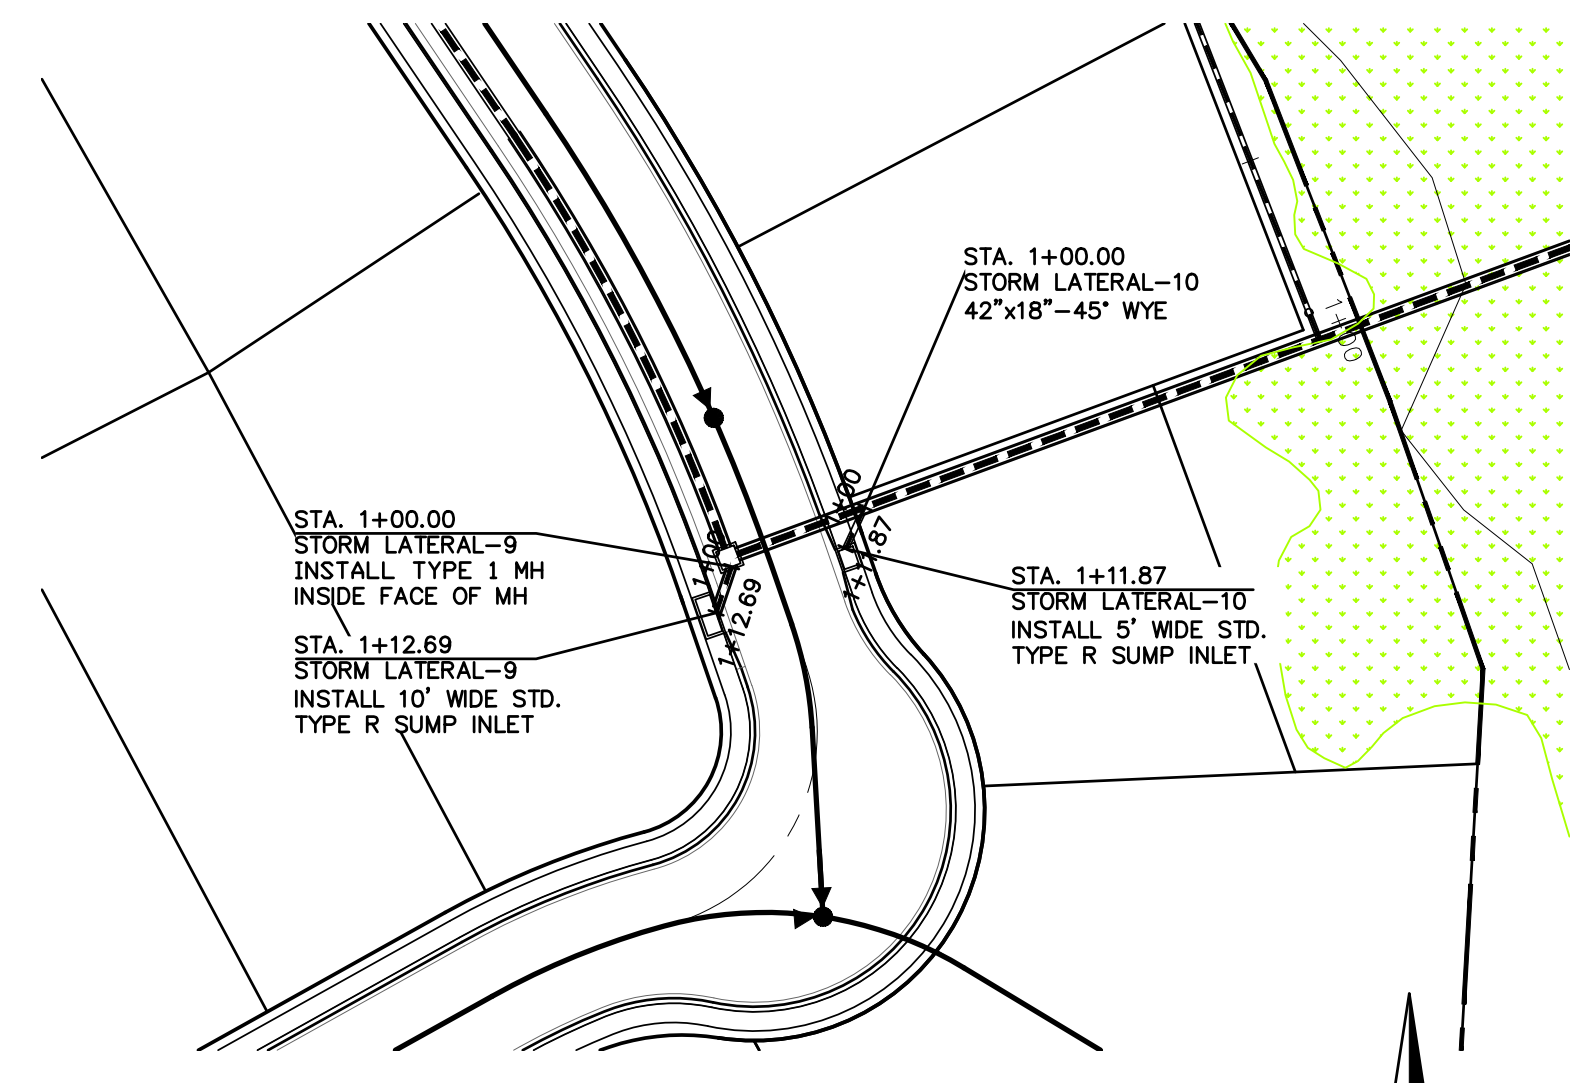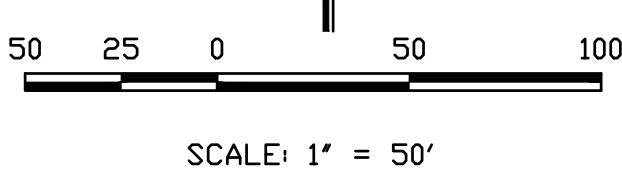

**STORM SEWER LATERAL - 9 & 10 (PIPE RUN 30 & 32)**  
 PROPOSED PUBLIC RCP STORM SEWER  
 1" = 50' HORIZ. 1" = 5' VERT.



SCALE: 1" = 50'  
 THIS DESIGN WAS PREPARED UNDER MY DIRECT SUPERVISION  
 FOR AND ON BEHALF OF TERRA NOVA ENGINEERING, INC.  
 QUENTIN N. ARMJO, PROFESSIONAL ENGINEER  
 COLORADO P.E. NO. 37170

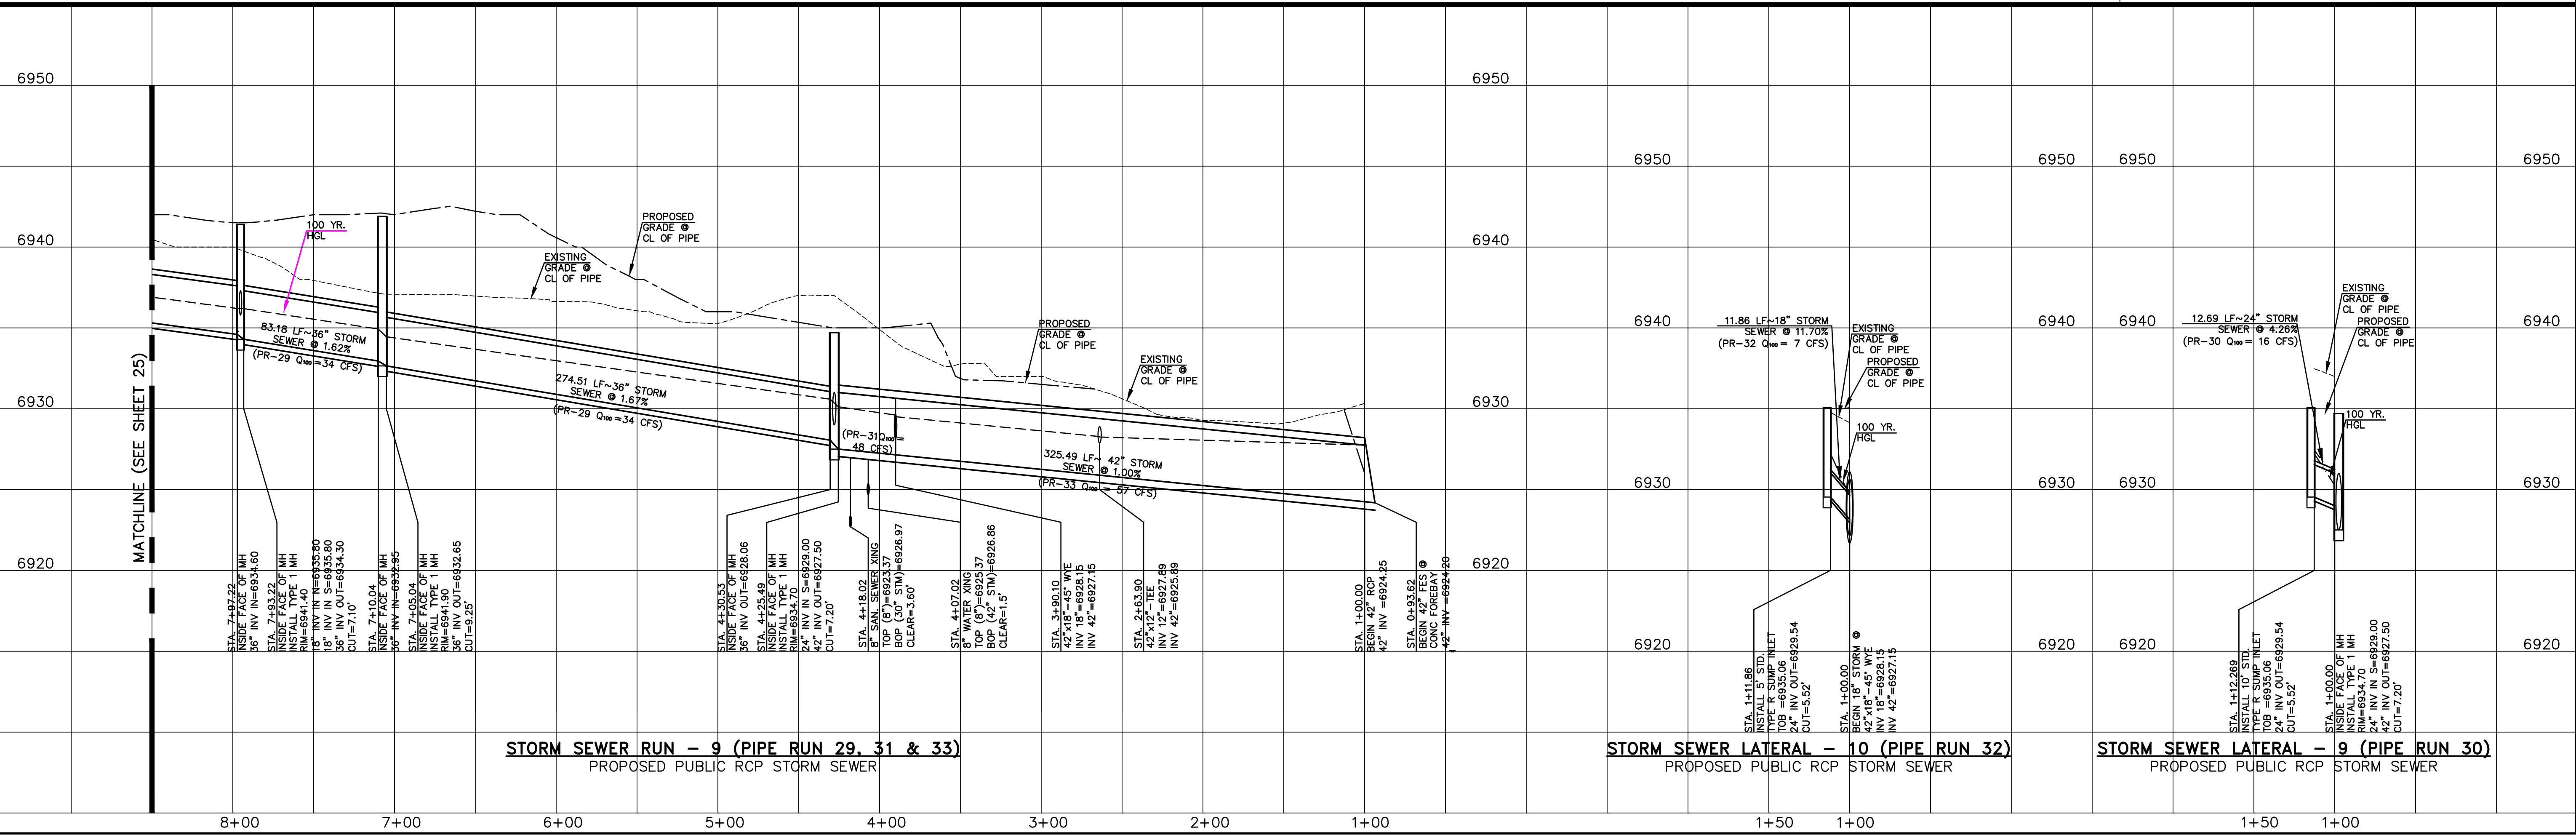

**STORM SEWER RUN - 9 (PIPE RUN 29, 31 & 33)**  
 PROPOSED PUBLIC RCP STORM SEWER

**STORM SEWER LATERAL - 10 (PIPE RUN 32)**  
 PROPOSED PUBLIC RCP STORM SEWER

**STORM SEWER LATERAL - 9 (PIPE RUN 30)**  
 PROPOSED PUBLIC RCP STORM SEWER

DESIGNED BY QNA  
 DRAWN BY QNA  
 CHECKED BY

H-SCALE 1"=50'  
 V-SCALE 1"=5'  
 JOB NO. 1715.00  
 DATE ISSUED 2/6/23  
 SHEET NO. 29 OF 37


WATERBURY FILING NO. 1  
 CONSTRUCTION SET  
 STORM SEWER PLAN AND PROFILE  
 RUNS 9 & 10 AND LATERAL 9 & 10

PREPARED FOR:  
 4-WAY RANCH JOINT VENTURE  
 PETER MARTZ  
 P.O. BOX 50223  
 COLORADO SPRINGS, CO 80949  
 719-491-3150



UNTL SUCH TIME AS THESE  
 DRAWINGS ARE APPROVED  
 FOR REVISIONS BY THE  
 REVIEWING AGENCIES OR  
 TERRA NOVA ENGINEERING,  
 AND SURVEYING, INC.  
 APPROVES THEIR USE ONLY  
 AS INDICATED BY THE  
 AUTHORIZATION.

REVISIONS  
 NO. DESCRIPTION DATE


Terra Nova  
 Engineering, Inc.  
 721 S. 2900 STREET  
 COLORADO SPRINGS, CO 80904  
 OFFICE: 719-635-6422  
 FAX: 719-635-6426  
 www.tneshc.com

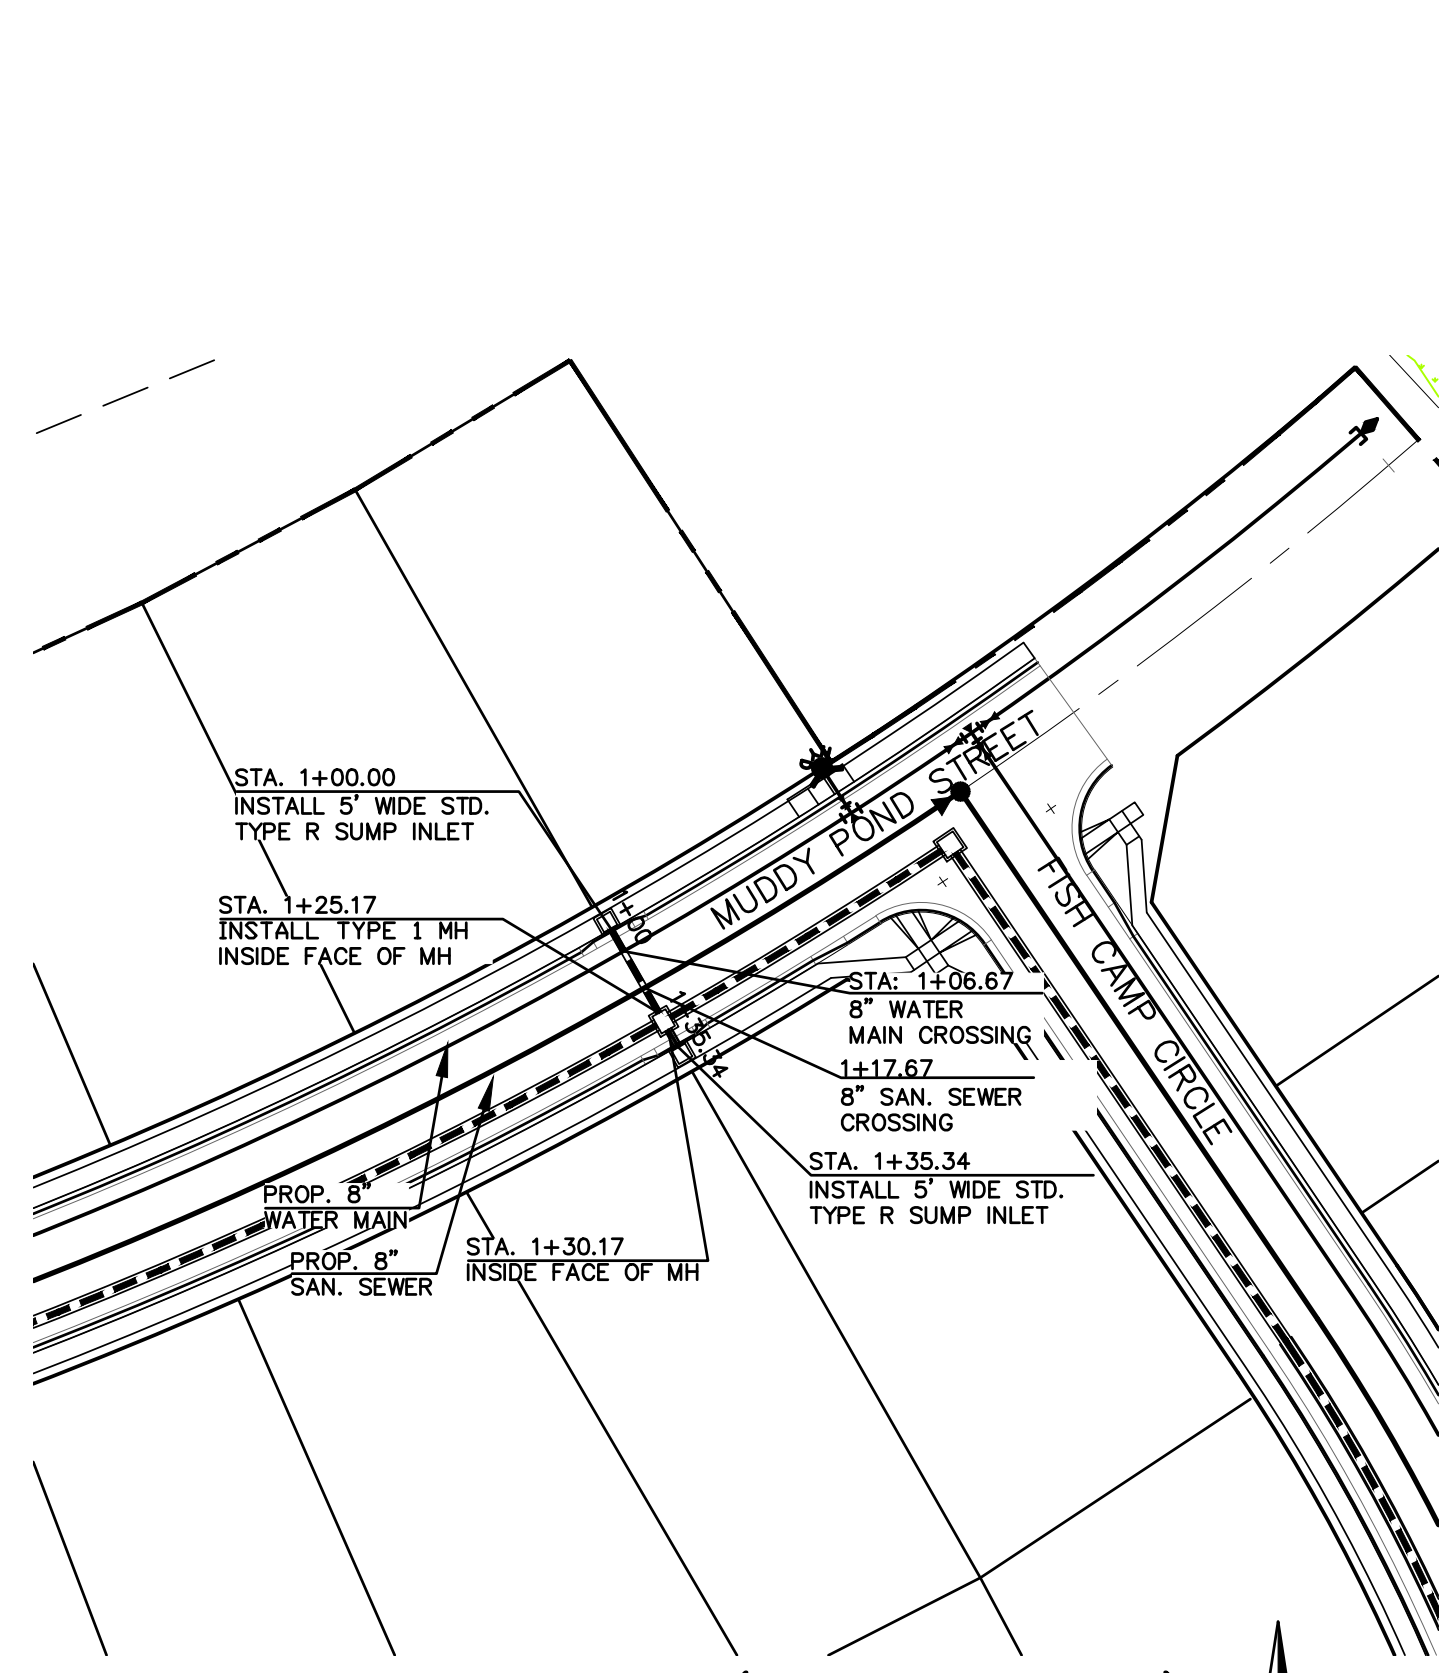

**STORM SEWER LATERAL - 8 (PIPE RUN 27 & 28)**  
 PROPOSED PUBLIC RCP STORM SEWER  
 1" = 50' HORIZ. 1" = 5' VERT.

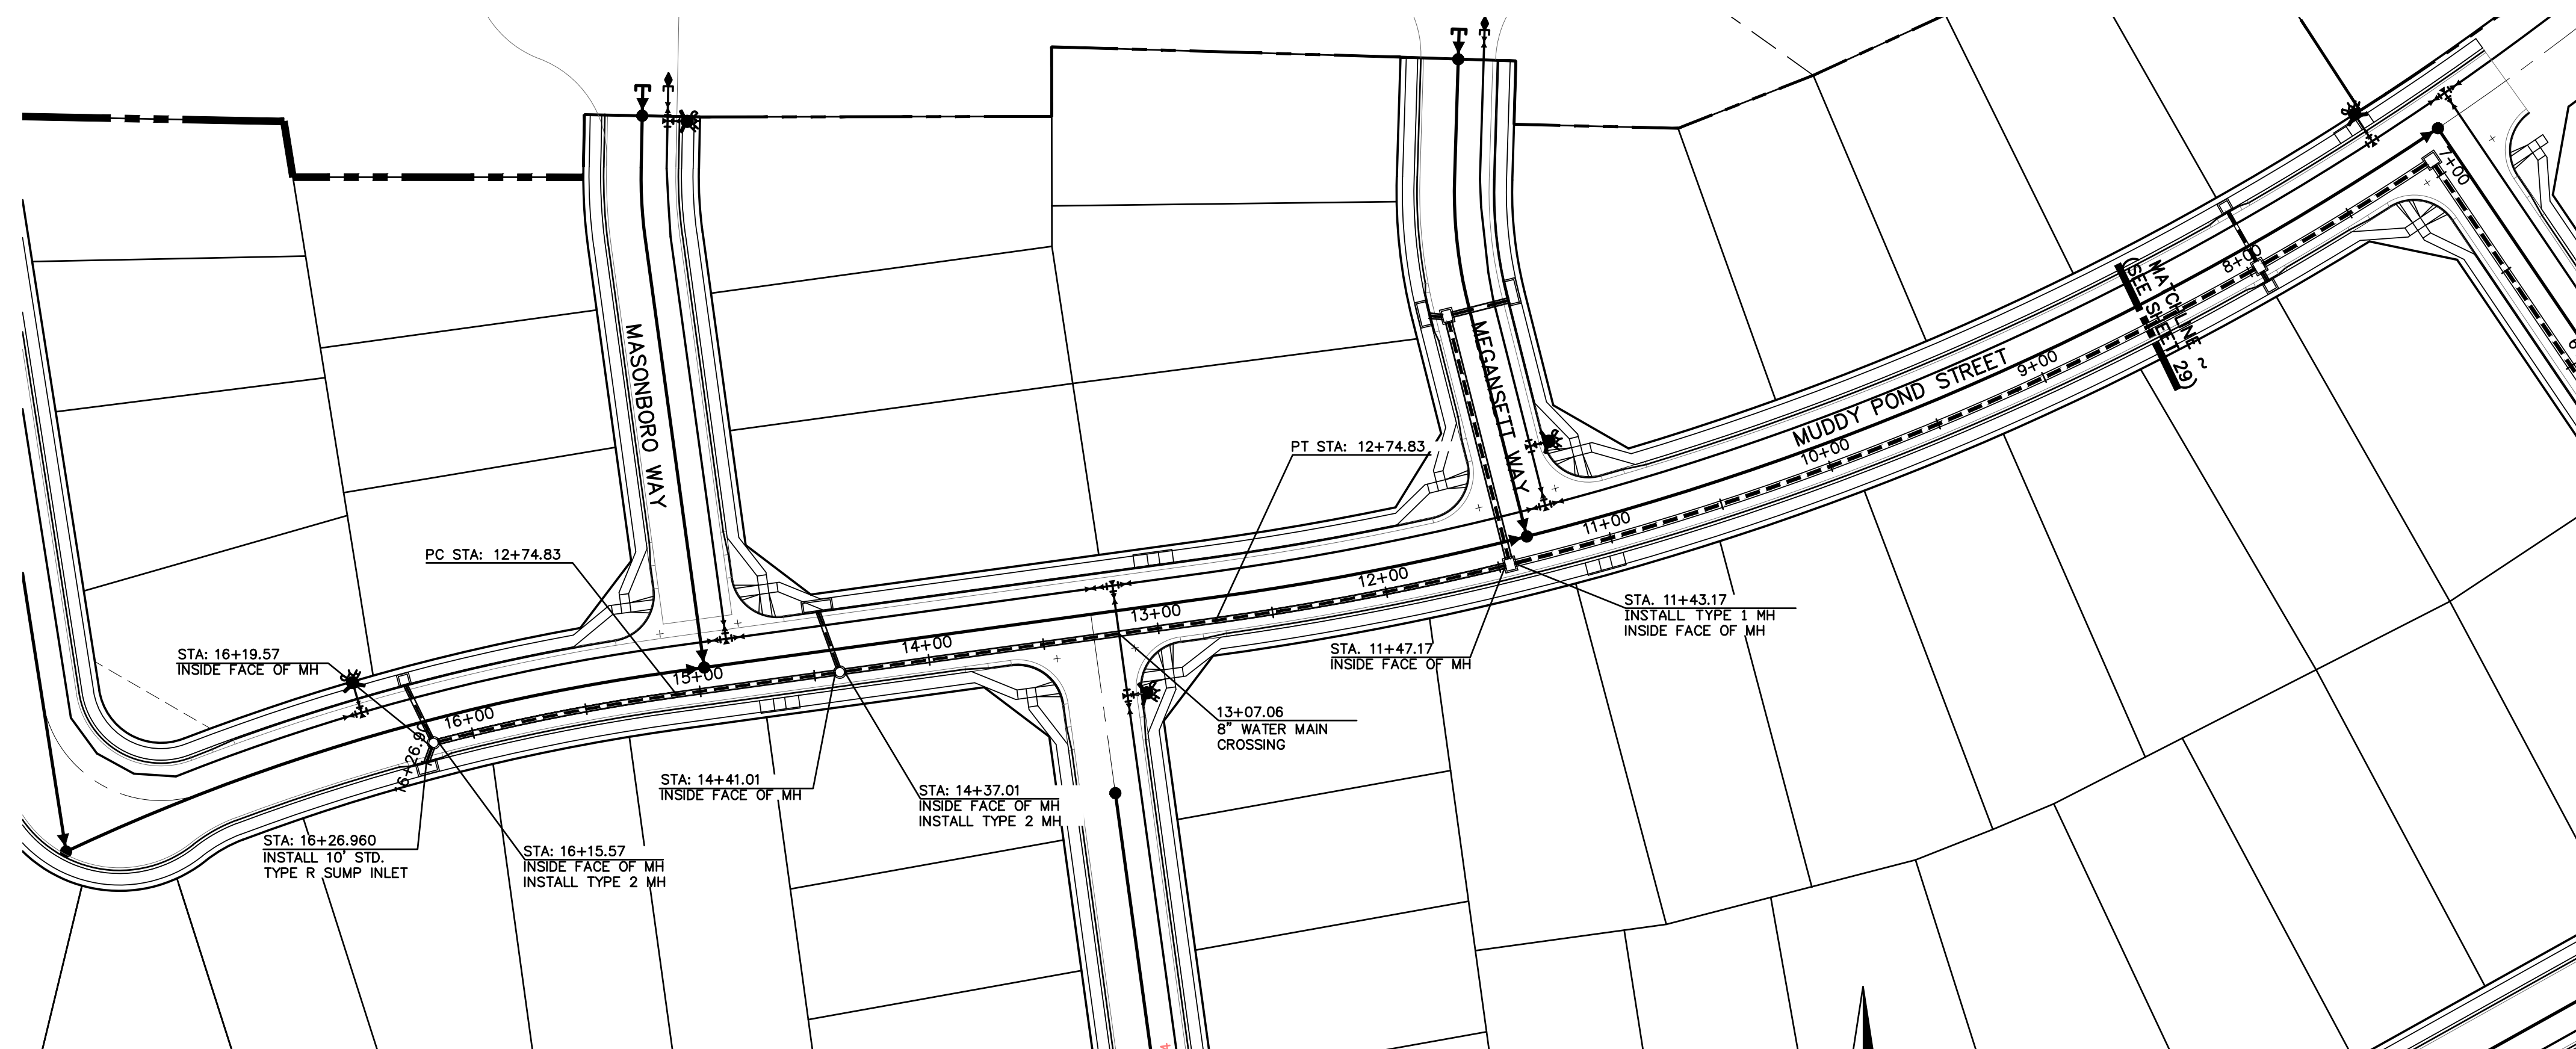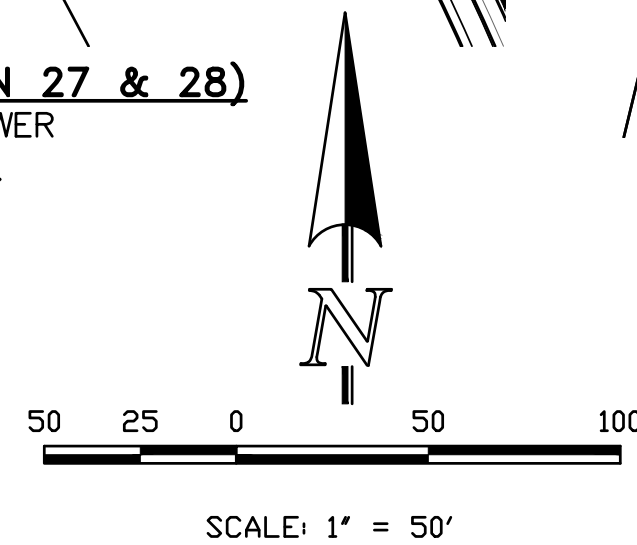


**STORM SEWER RUN - 9 (PIPE RUN 20, 22 & 26)**  
 PROPOSED PUBLIC RCP STORM SEWER  
 1" = 50' HORIZ. 1" = 5' VERT.

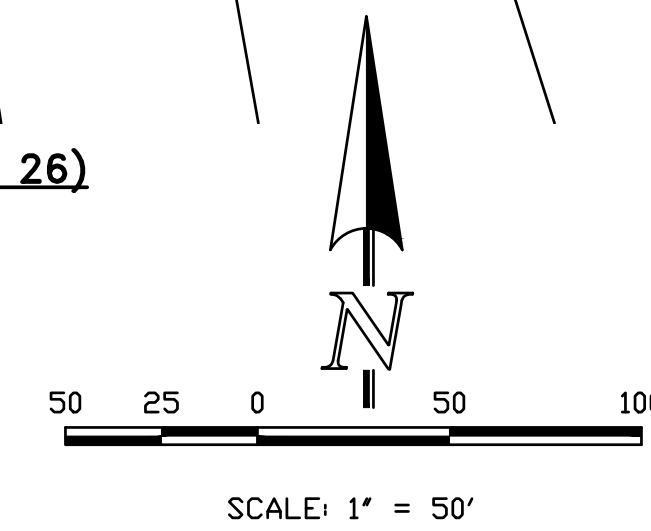

THIS DESIGN WAS PREPARED UNDER MY DIRECT SUPERVISION  
 FOR AND ON BEHALF OF TERRA NOVA ENGINEERING, INC.

QUENTIN N. ARMUO, PROFESSIONAL ENGINEER  
 COLORADO P.E. NO. 31710

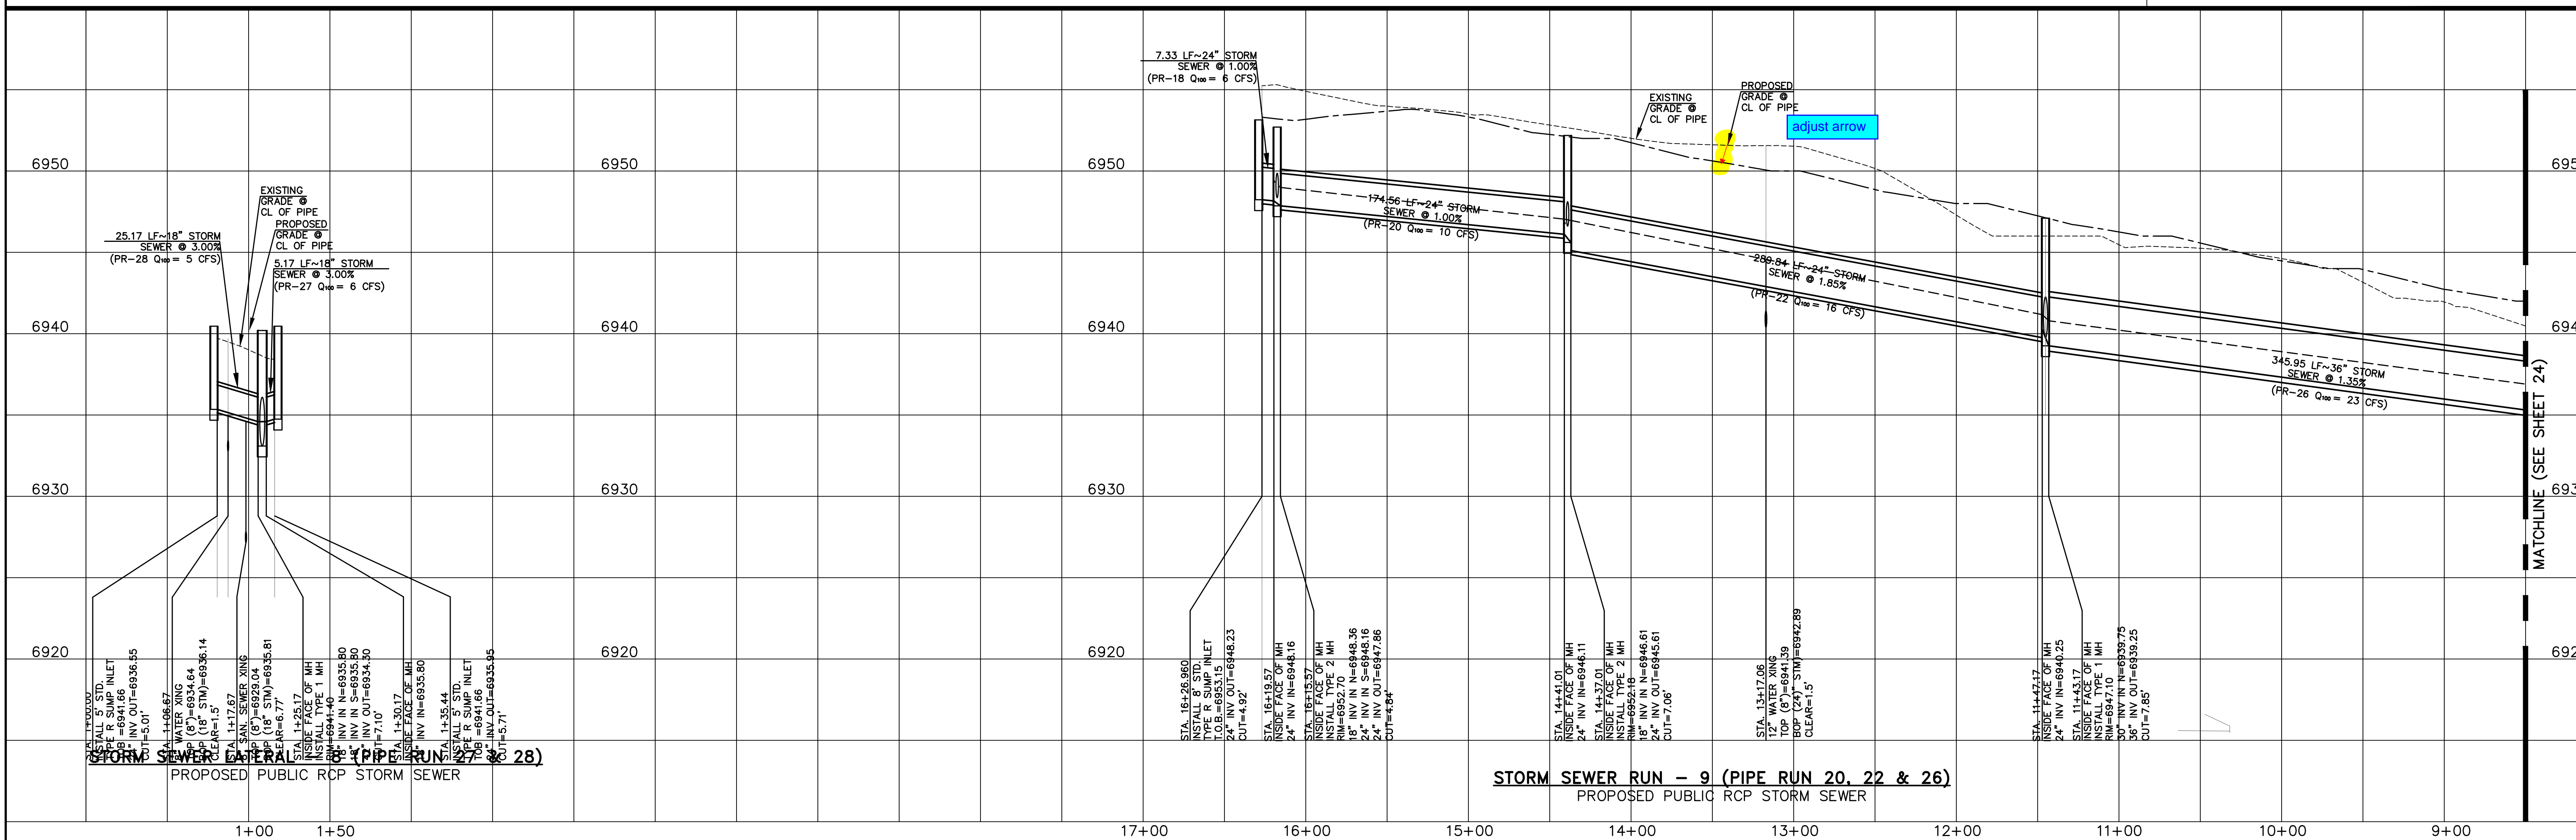


**STORM SEWER RUN - 9 (PIPE RUN 20, 22 & 26)**  
 PROPOSED PUBLIC RCP STORM SEWER

NO.	DESCRIPTION	DATE


UNTIL SUCH TIME AS THESE  
 DRAWINGS ARE APPROVED  
 BY THE LOCAL AGENCIES  
 REVIEWING AGENCIES  
 TERRA NOVA ENGINEERING,  
 AND SURVEYING, INC.  
 APPROVES THEIR USE ONLY  
 AS DESIGNATED BY WRITTEN  
 AUTHORIZATION.

PREPARED FOR:  
**4-WAY RANCH JOINT VENTURE**  
**PETER MARTZ**  
 P.O. BOX 50223  
 COLORADO SPRINGS, CO 80949  
 719-491-3150


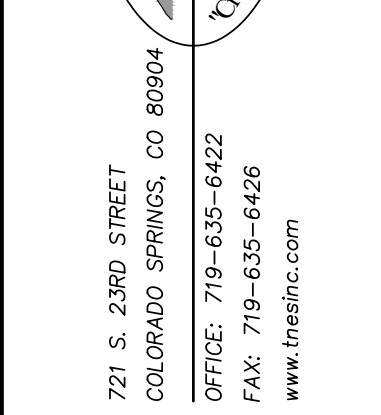


721 S. 2900 STREET  
 COLORADO SPRINGS, CO 80904  
 OFFICE: 719-635-6422  
 FAX: 719-635-6426  
 www.tneshc.com



DESIGNED BY QNA  
 DRAWN BY QNA  
 CHECKED BY  
 H-SCALE 1"=50'  
 V-SCALE 1"=5'  
 JOB NO. 1715.00  
 DATE ISSUED 2/6/23  
 SHEET NO. 30 OF 37

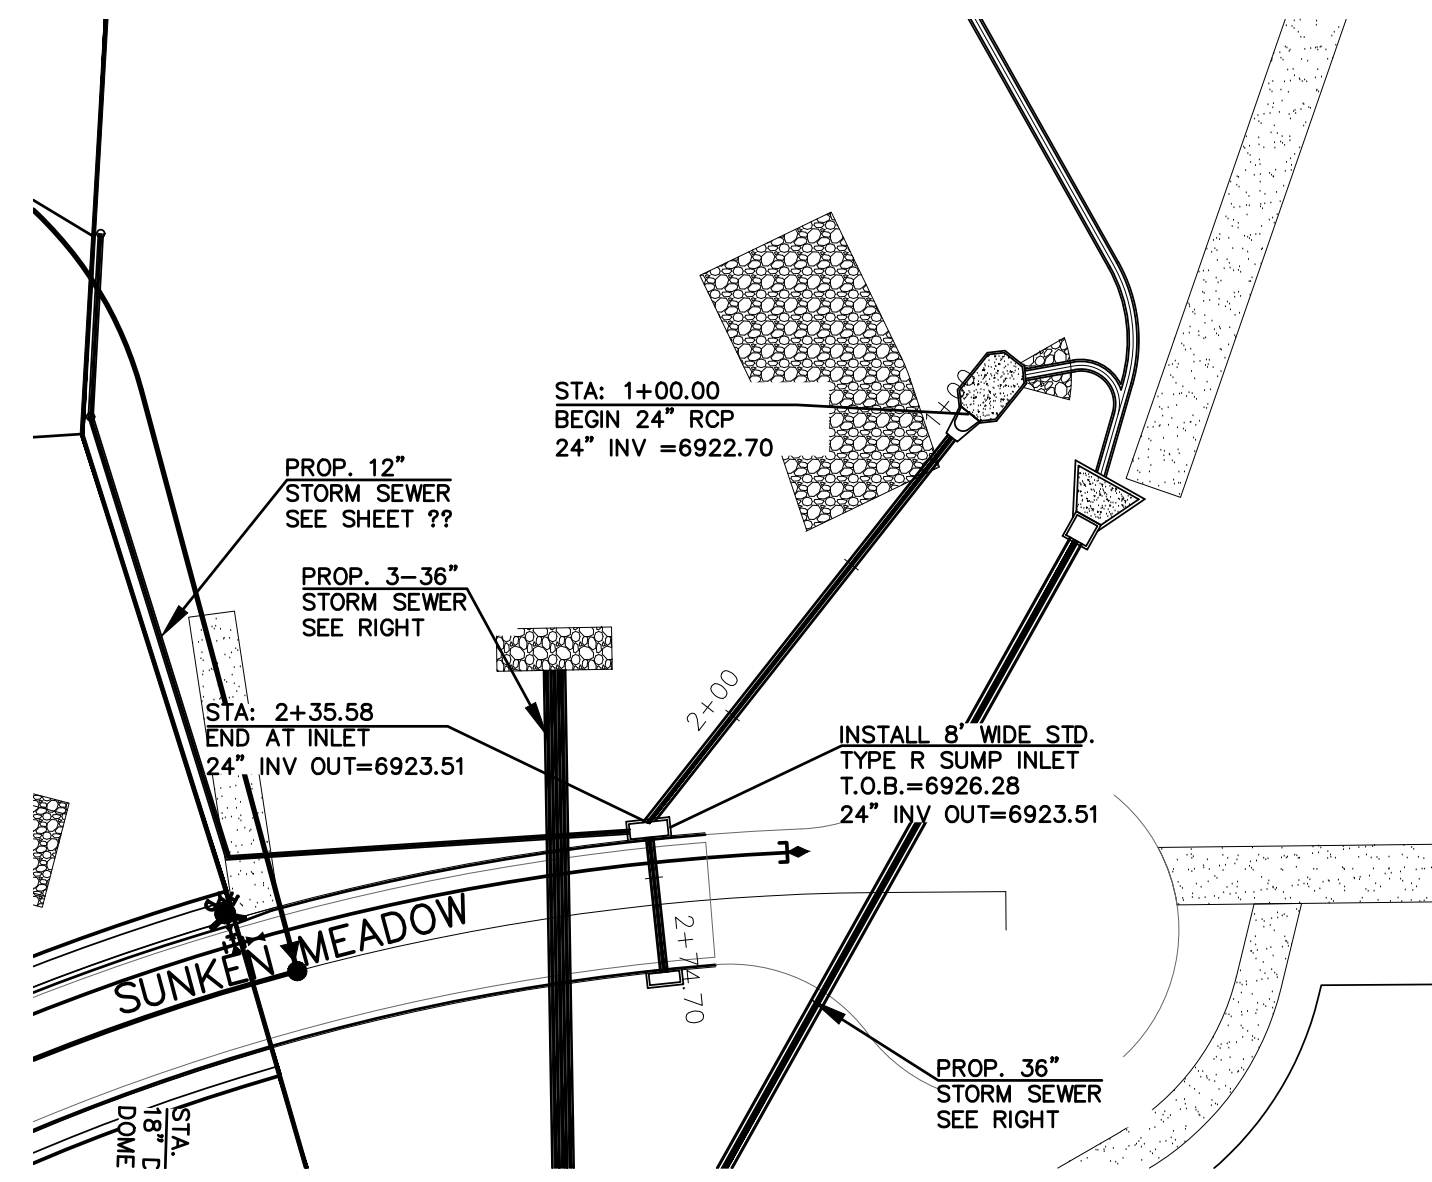


**STORM SEWER LATERAL - 10 (PIPE RUN 34)**  
 PROPOSED PUBLIC RCP STORM SEWER  
 1" = 50' HORIZ. 1" = 5' VERT.

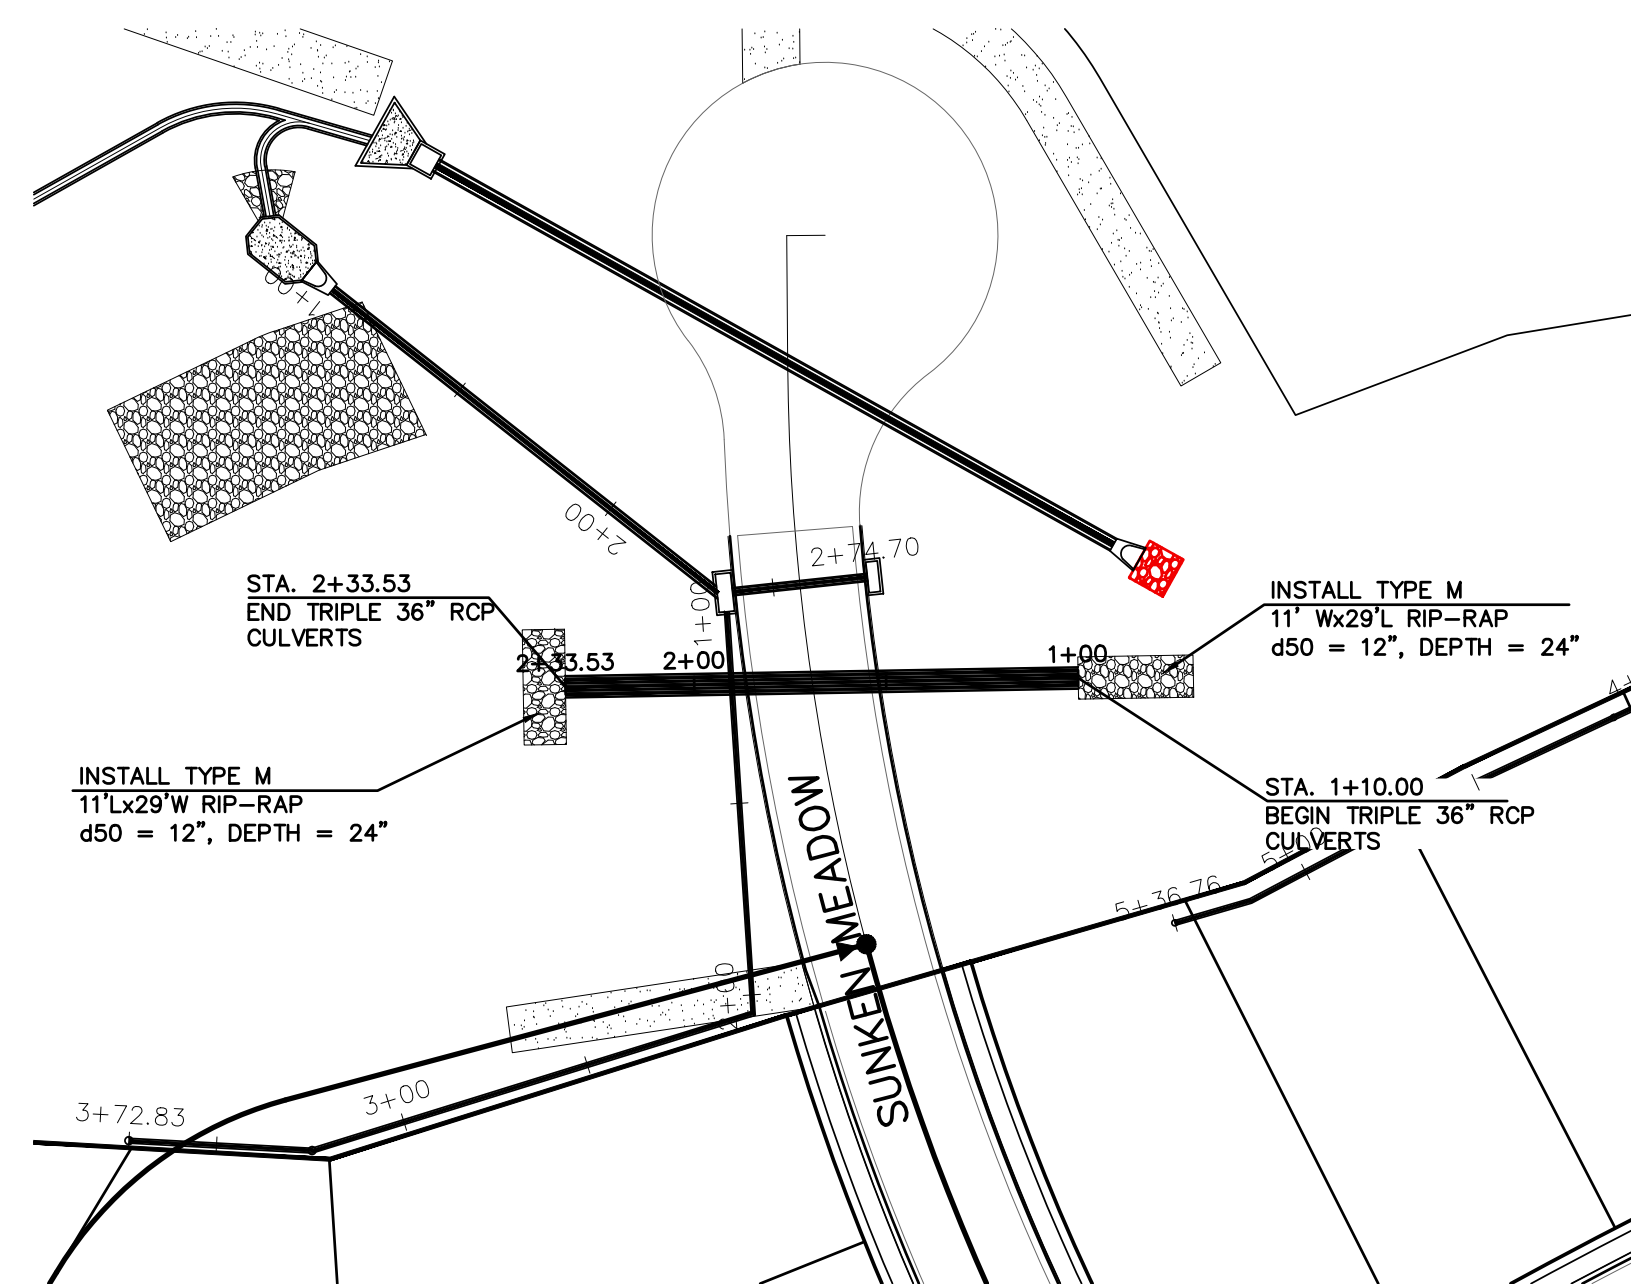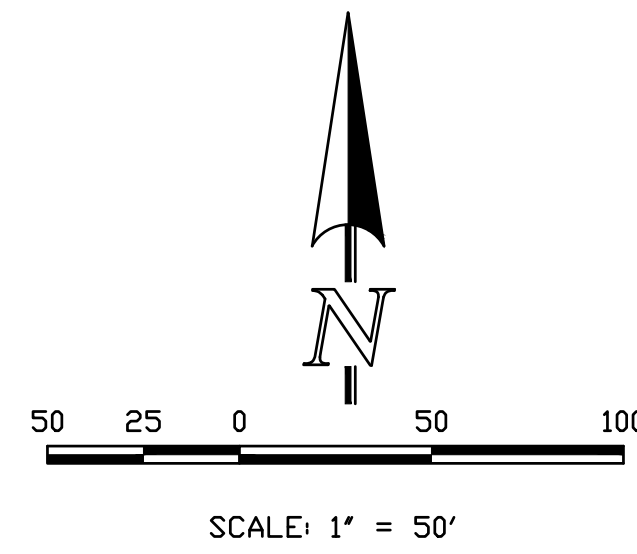

**STORM SEWER RUN - 11 (PIPE RUN 36)**  
 PROPOSED PUBLIC RCP STORM SEWER  
 1" = 50' HORIZ. 1" = 5' VERT.

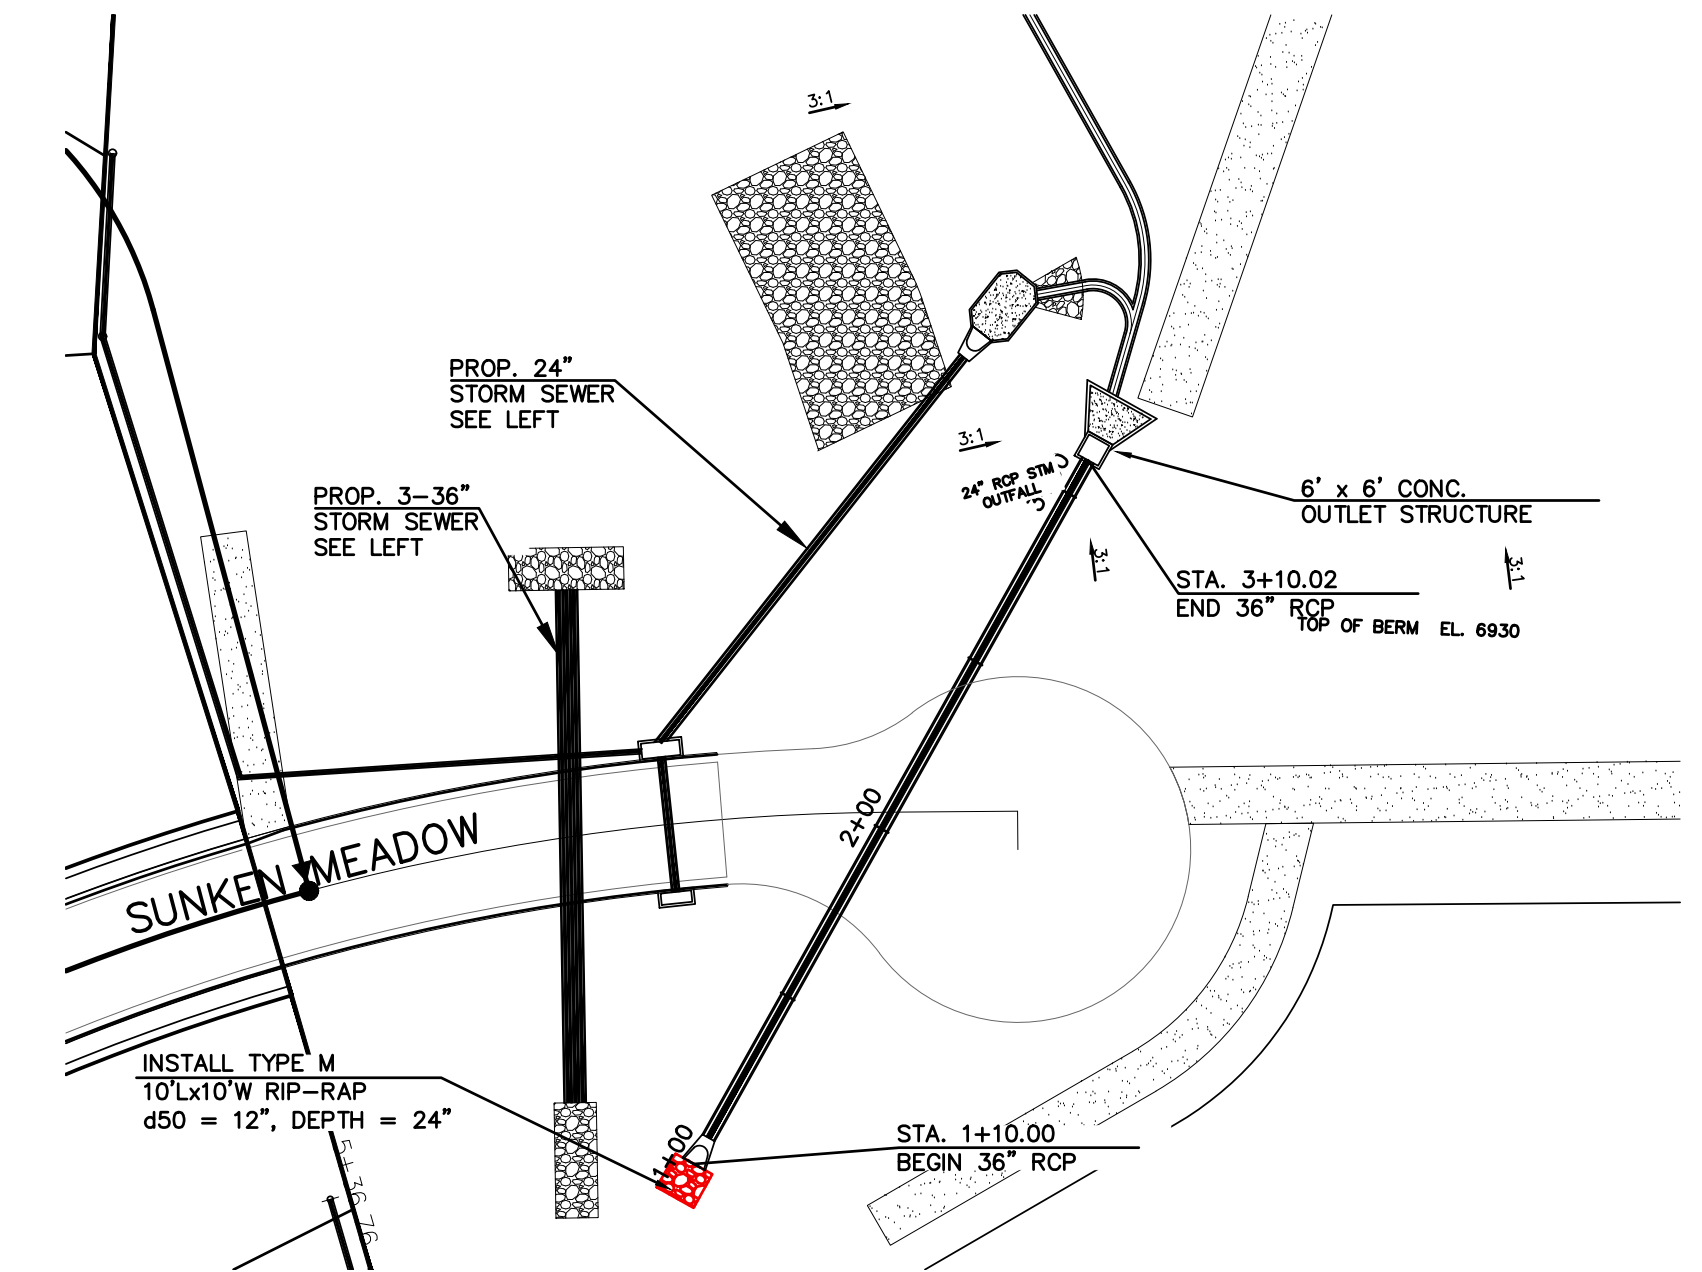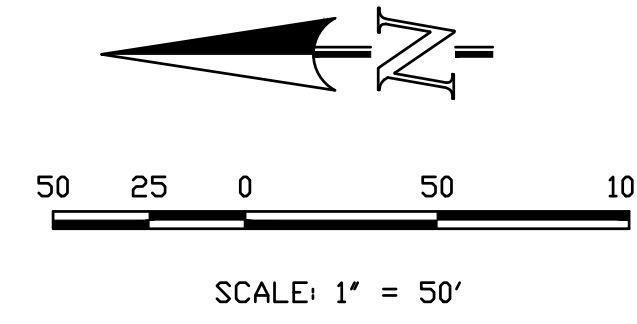

**STORM SEWER RUN - 12 (PIPE RUN 35)**  
 PROPOSED PUBLIC RCP STORM SEWER  
 1" = 50' HORIZ. 1" = 5' VERT.

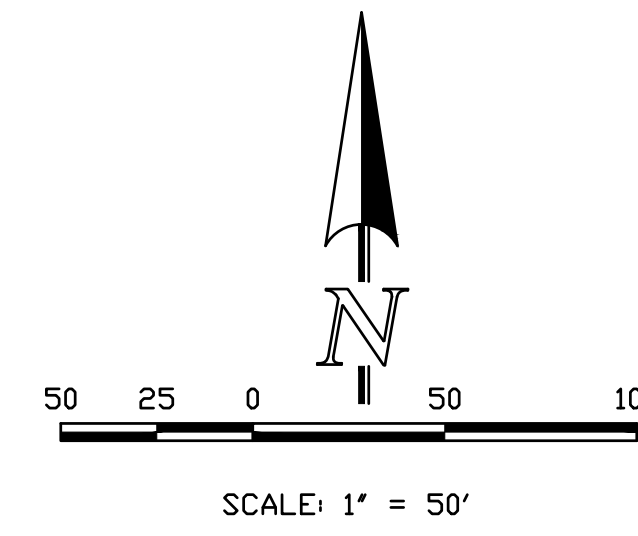

THIS DESIGN WAS PREPARED UNDER MY DIRECT SUPERVISION FOR AND ON BEHALF OF TERRA NOVA ENGINEERING, INC.

QUENTIN N. ARMUO, PROFESSIONAL ENGINEER  
 COLORADO P.E. NO. 37170

6940		6940		6940		6940		6940		6940	
6930		6930		6930		6930		6930		6930	
6920		6920		6920		6920		6920		6920	
6910		6910		6910		6910		6910		6910	
	3+00	2+00	1+00		1+00	2+00	3+00		1+00	2+00	3+00

**STORM SEWER LATERAL - 10 (PIPE RUN 34)**  
 PROPOSED PUBLIC RCP STORM SEWER


**STORM SEWER RUN - 11 (PIPE RUN 36)**  
 PROPOSED PUBLIC RCP STORM SEWER

**STORM SEWER RUN - 12 (PIPE RUN 35)**  
 PROPOSED PUBLIC RCP STORM SEWER

NO.	DESCRIPTION	DATE

UNTIL SUCH TIME AS THESE DRAWINGS ARE APPROVED BY THE REVIEWING AGENCIES, THE REVIEWING AGENCIES, TERRA NOVA ENGINEERING AND SURVEYING, INC. APPROVES THEIR USE ONLY AS DESIGNATED BY WRITTEN AUTHORIZATION.


PREPARED FOR:  
**4-WAY RANCH JOINT VENTURE**  
**PETER MARTZ**  
 P.O. BOX 50223  
 COLORADO SPRINGS, CO 80949  
 719-491-3150

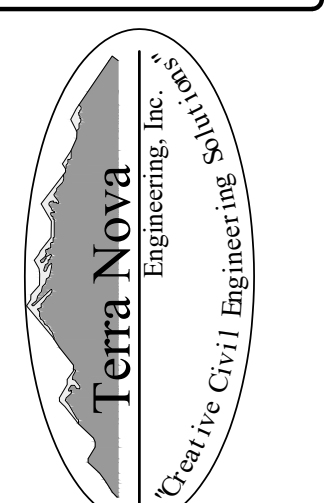



721 S. 2900 STREET  
 COLORADO SPRINGS, CO 80904  
 OFFICE: 719-635-6422  
 FAX: 719-635-6426  
 www.tnec.com

**WATERBURY FILING NO. 1**  
 CONSTRUCTION SET  
 STORM SEWER RUN 10, 11 & 12


DESIGNED BY QNA  
 DRAWN BY QNA  
 CHECKED BY  
 H-SCALE 1"=50'  
 V-SCALE 1"=5'  
 JOB NO. 1715.00  
 DATE ISSUED 2/6/23  
 SHEET NO. 31 OF 37

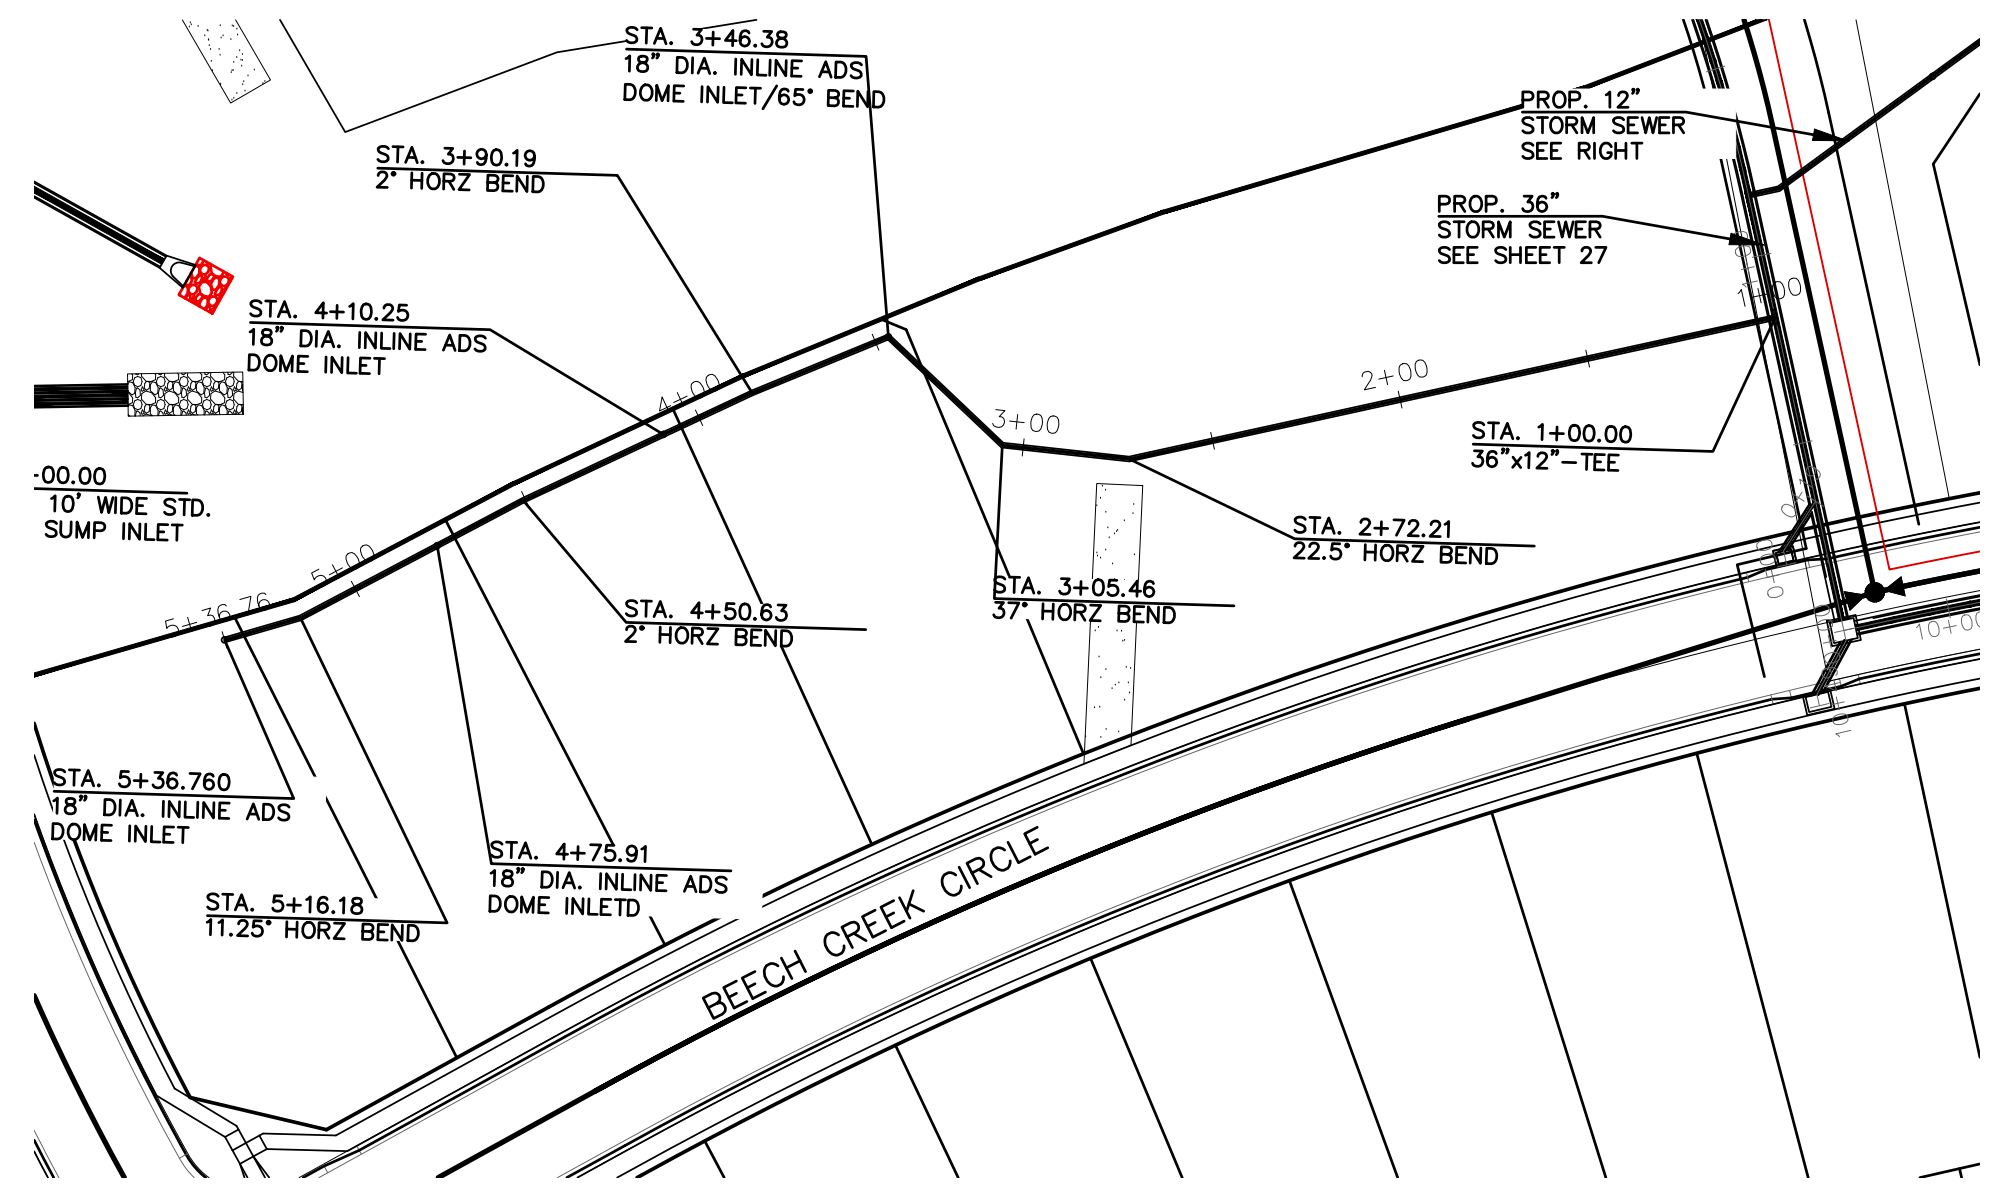

**STORM SEWER LATERAL-11 (PIPE RUN 39)**  
 PROPOSED PRIVATE HDPE STORM SEWER  
 1" = 50' HORIZ. 1" = 5' VERT.

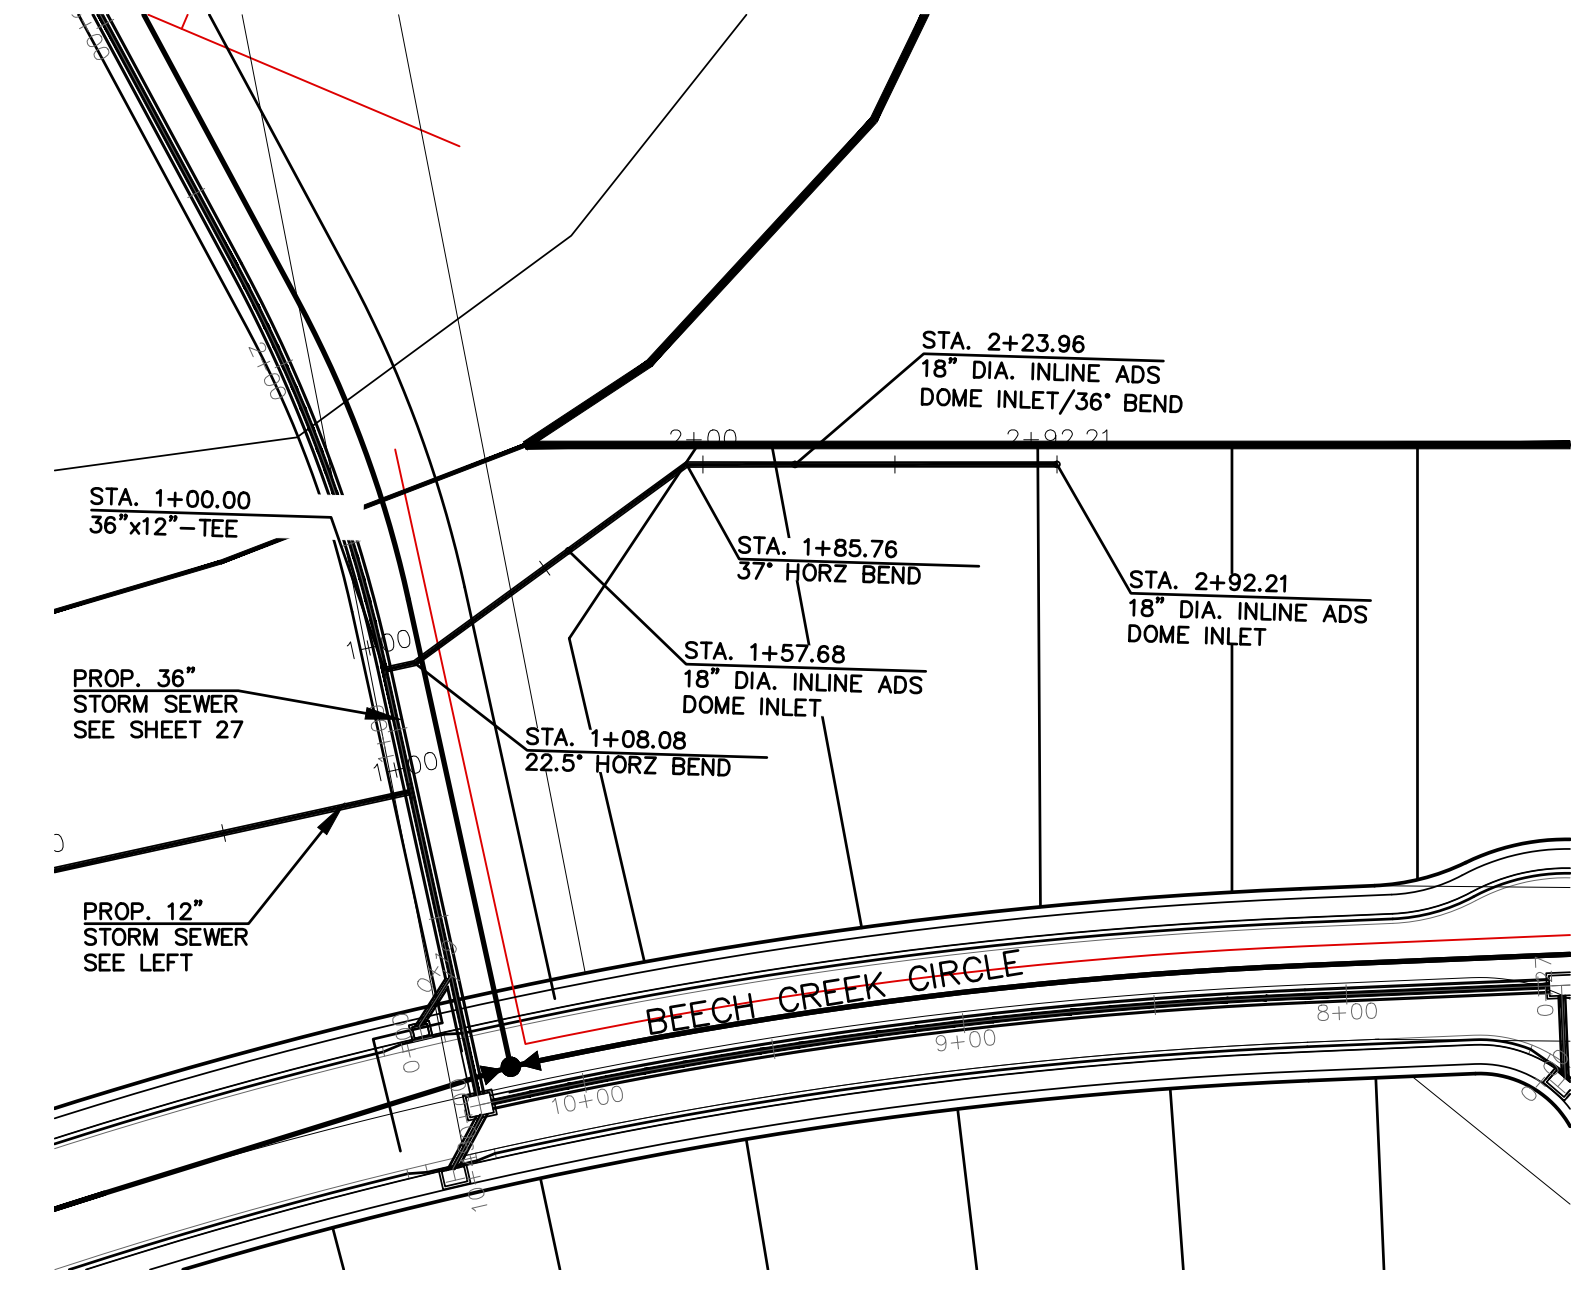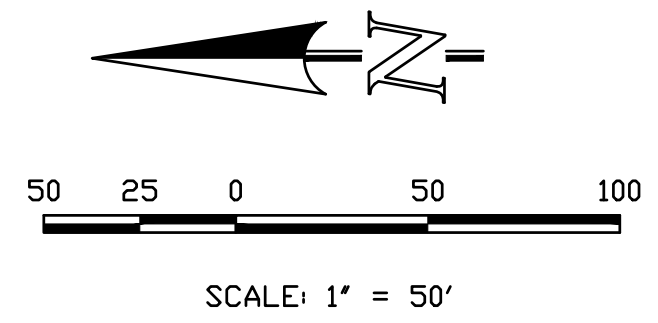


**STORM SEWER LATERAL-12 (PIPE RUN 40)**  
 PROPOSED PRIVATE HDPE STORM SEWER  
 1" = 50' HORIZ. 1" = 5' VERT.

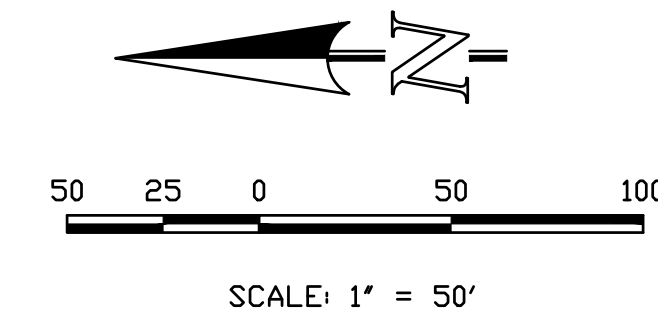


THIS DESIGN WAS PREPARED UNDER MY DIRECT SUPERVISION  
 FOR AND ON BEHALF OF TERRA NOVA ENGINEERING, INC.


QUENTIN N. ARMUO, PROFESSIONAL ENGINEER  
 COLORADO P.E. NO. 37170

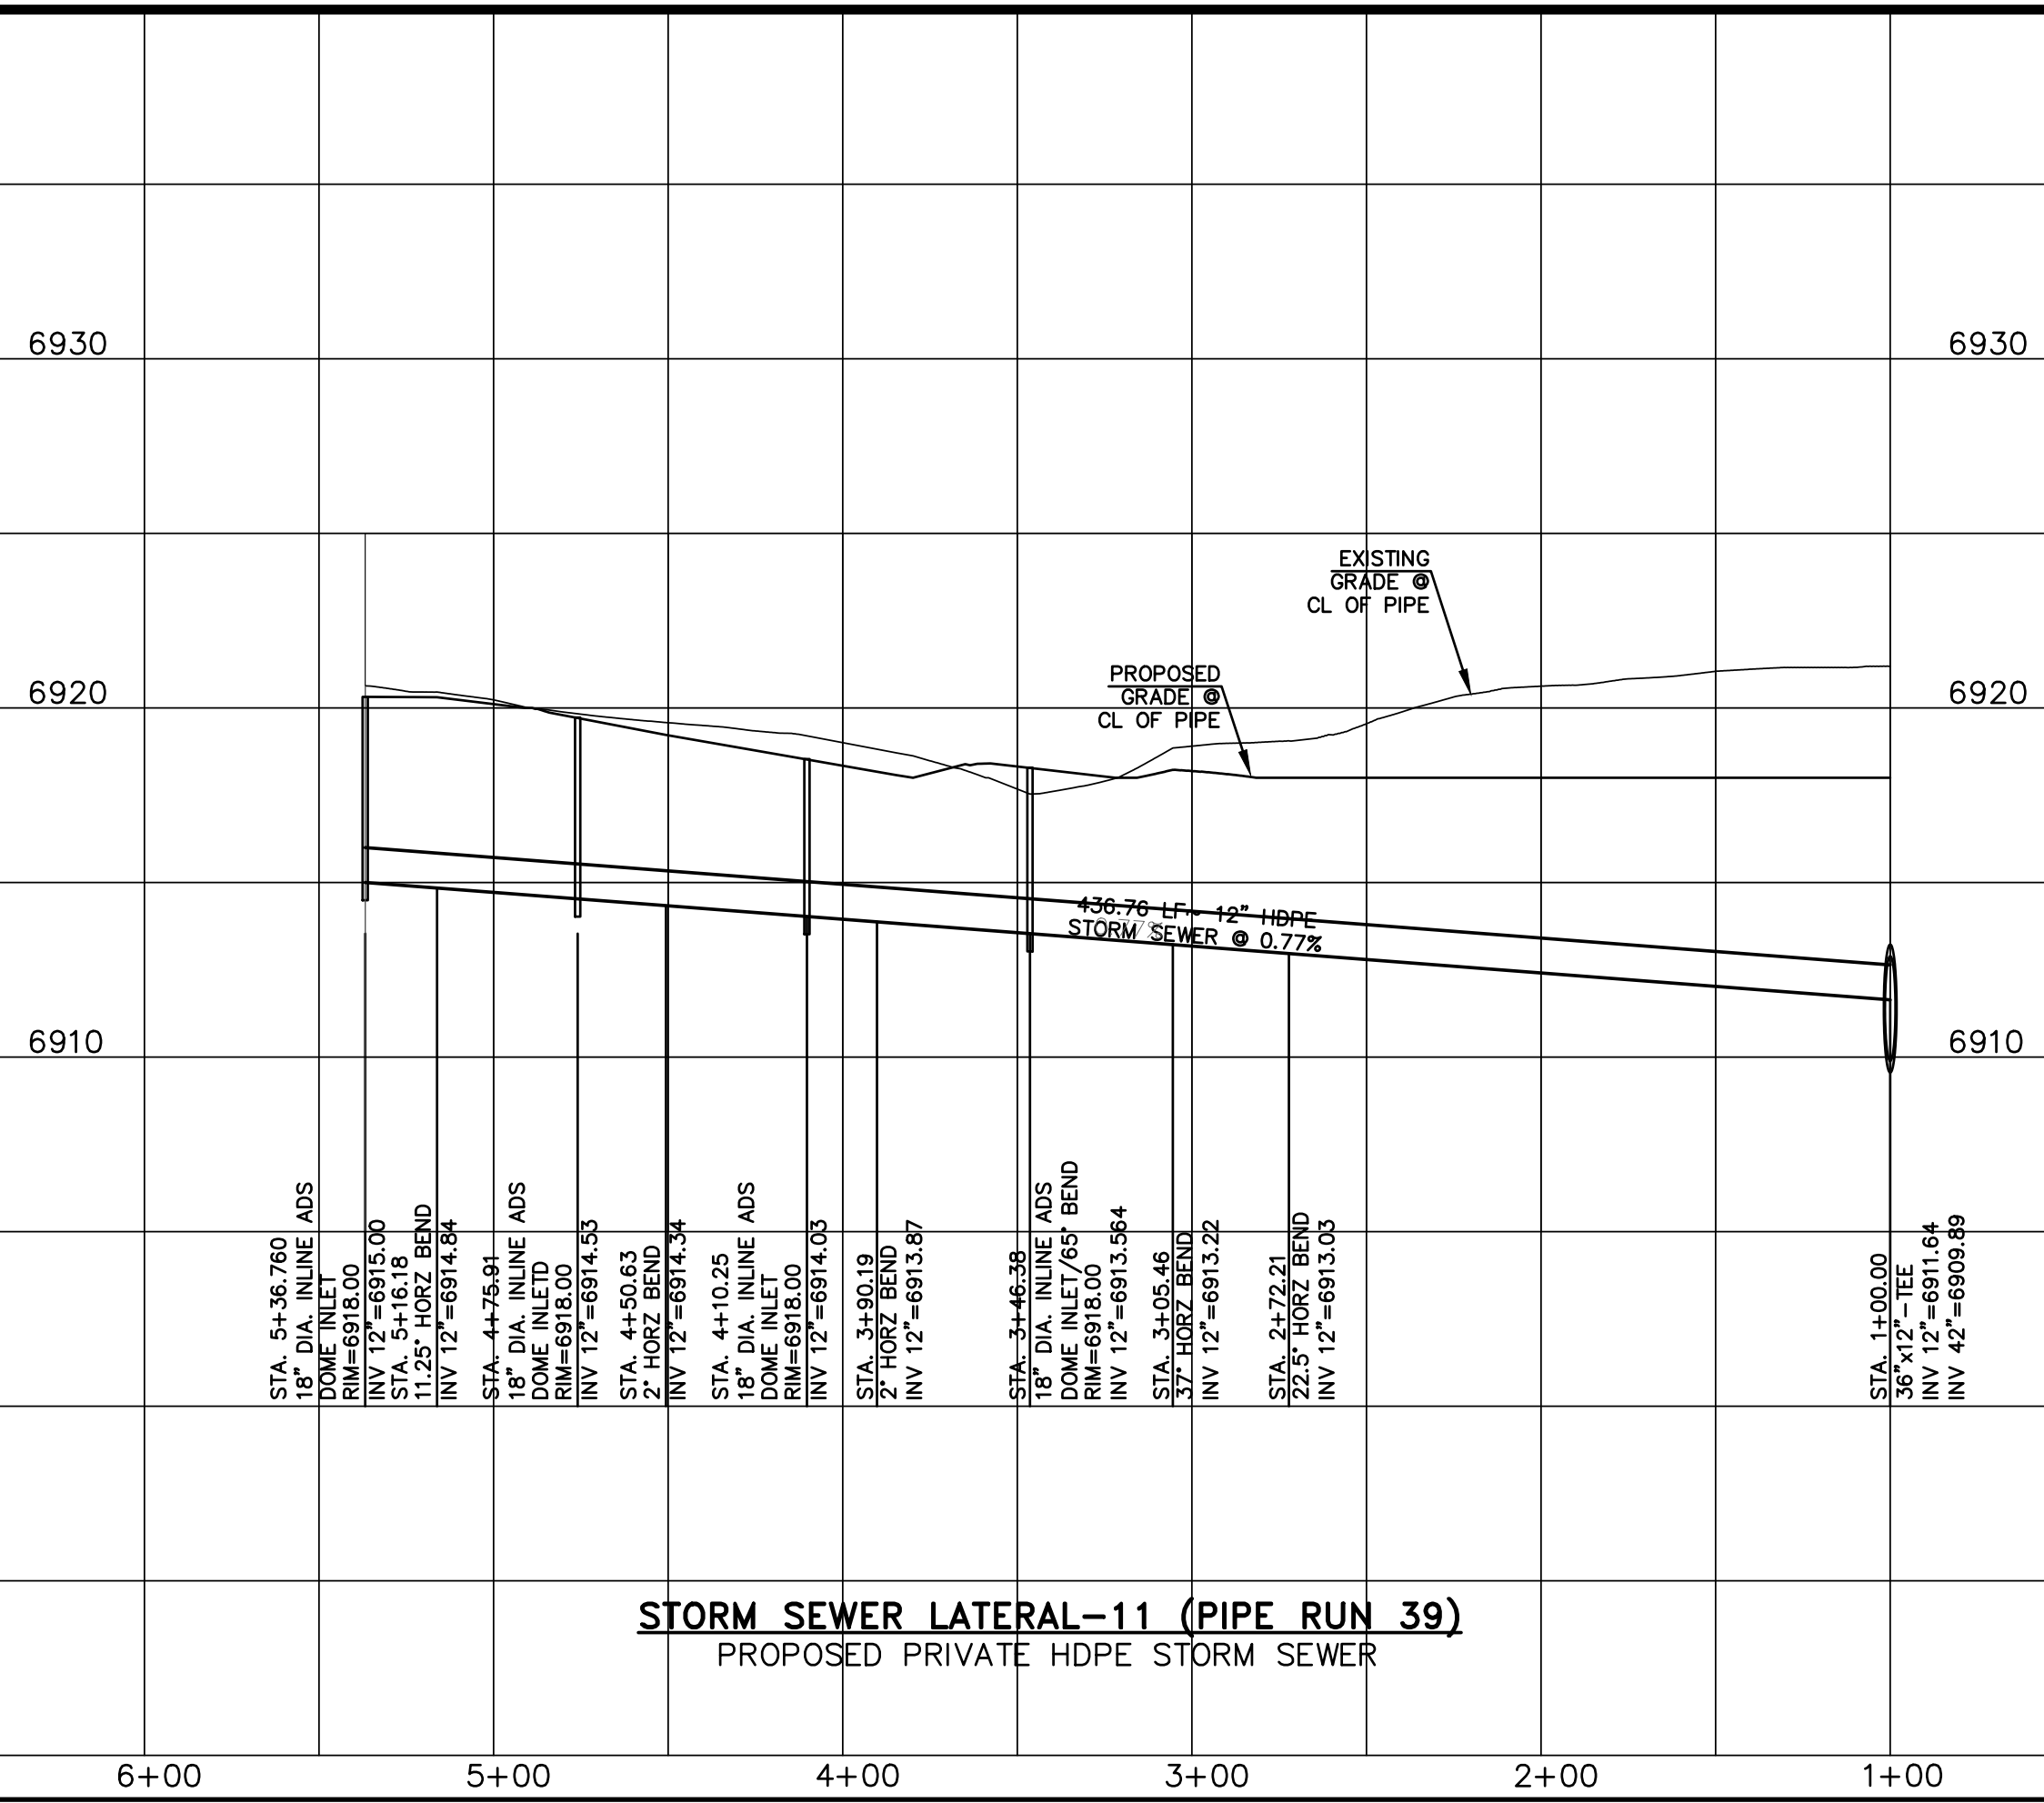


**STORM SEWER LATERAL-11 (PIPE RUN 39)**  
 PROPOSED PRIVATE HDPE STORM SEWER

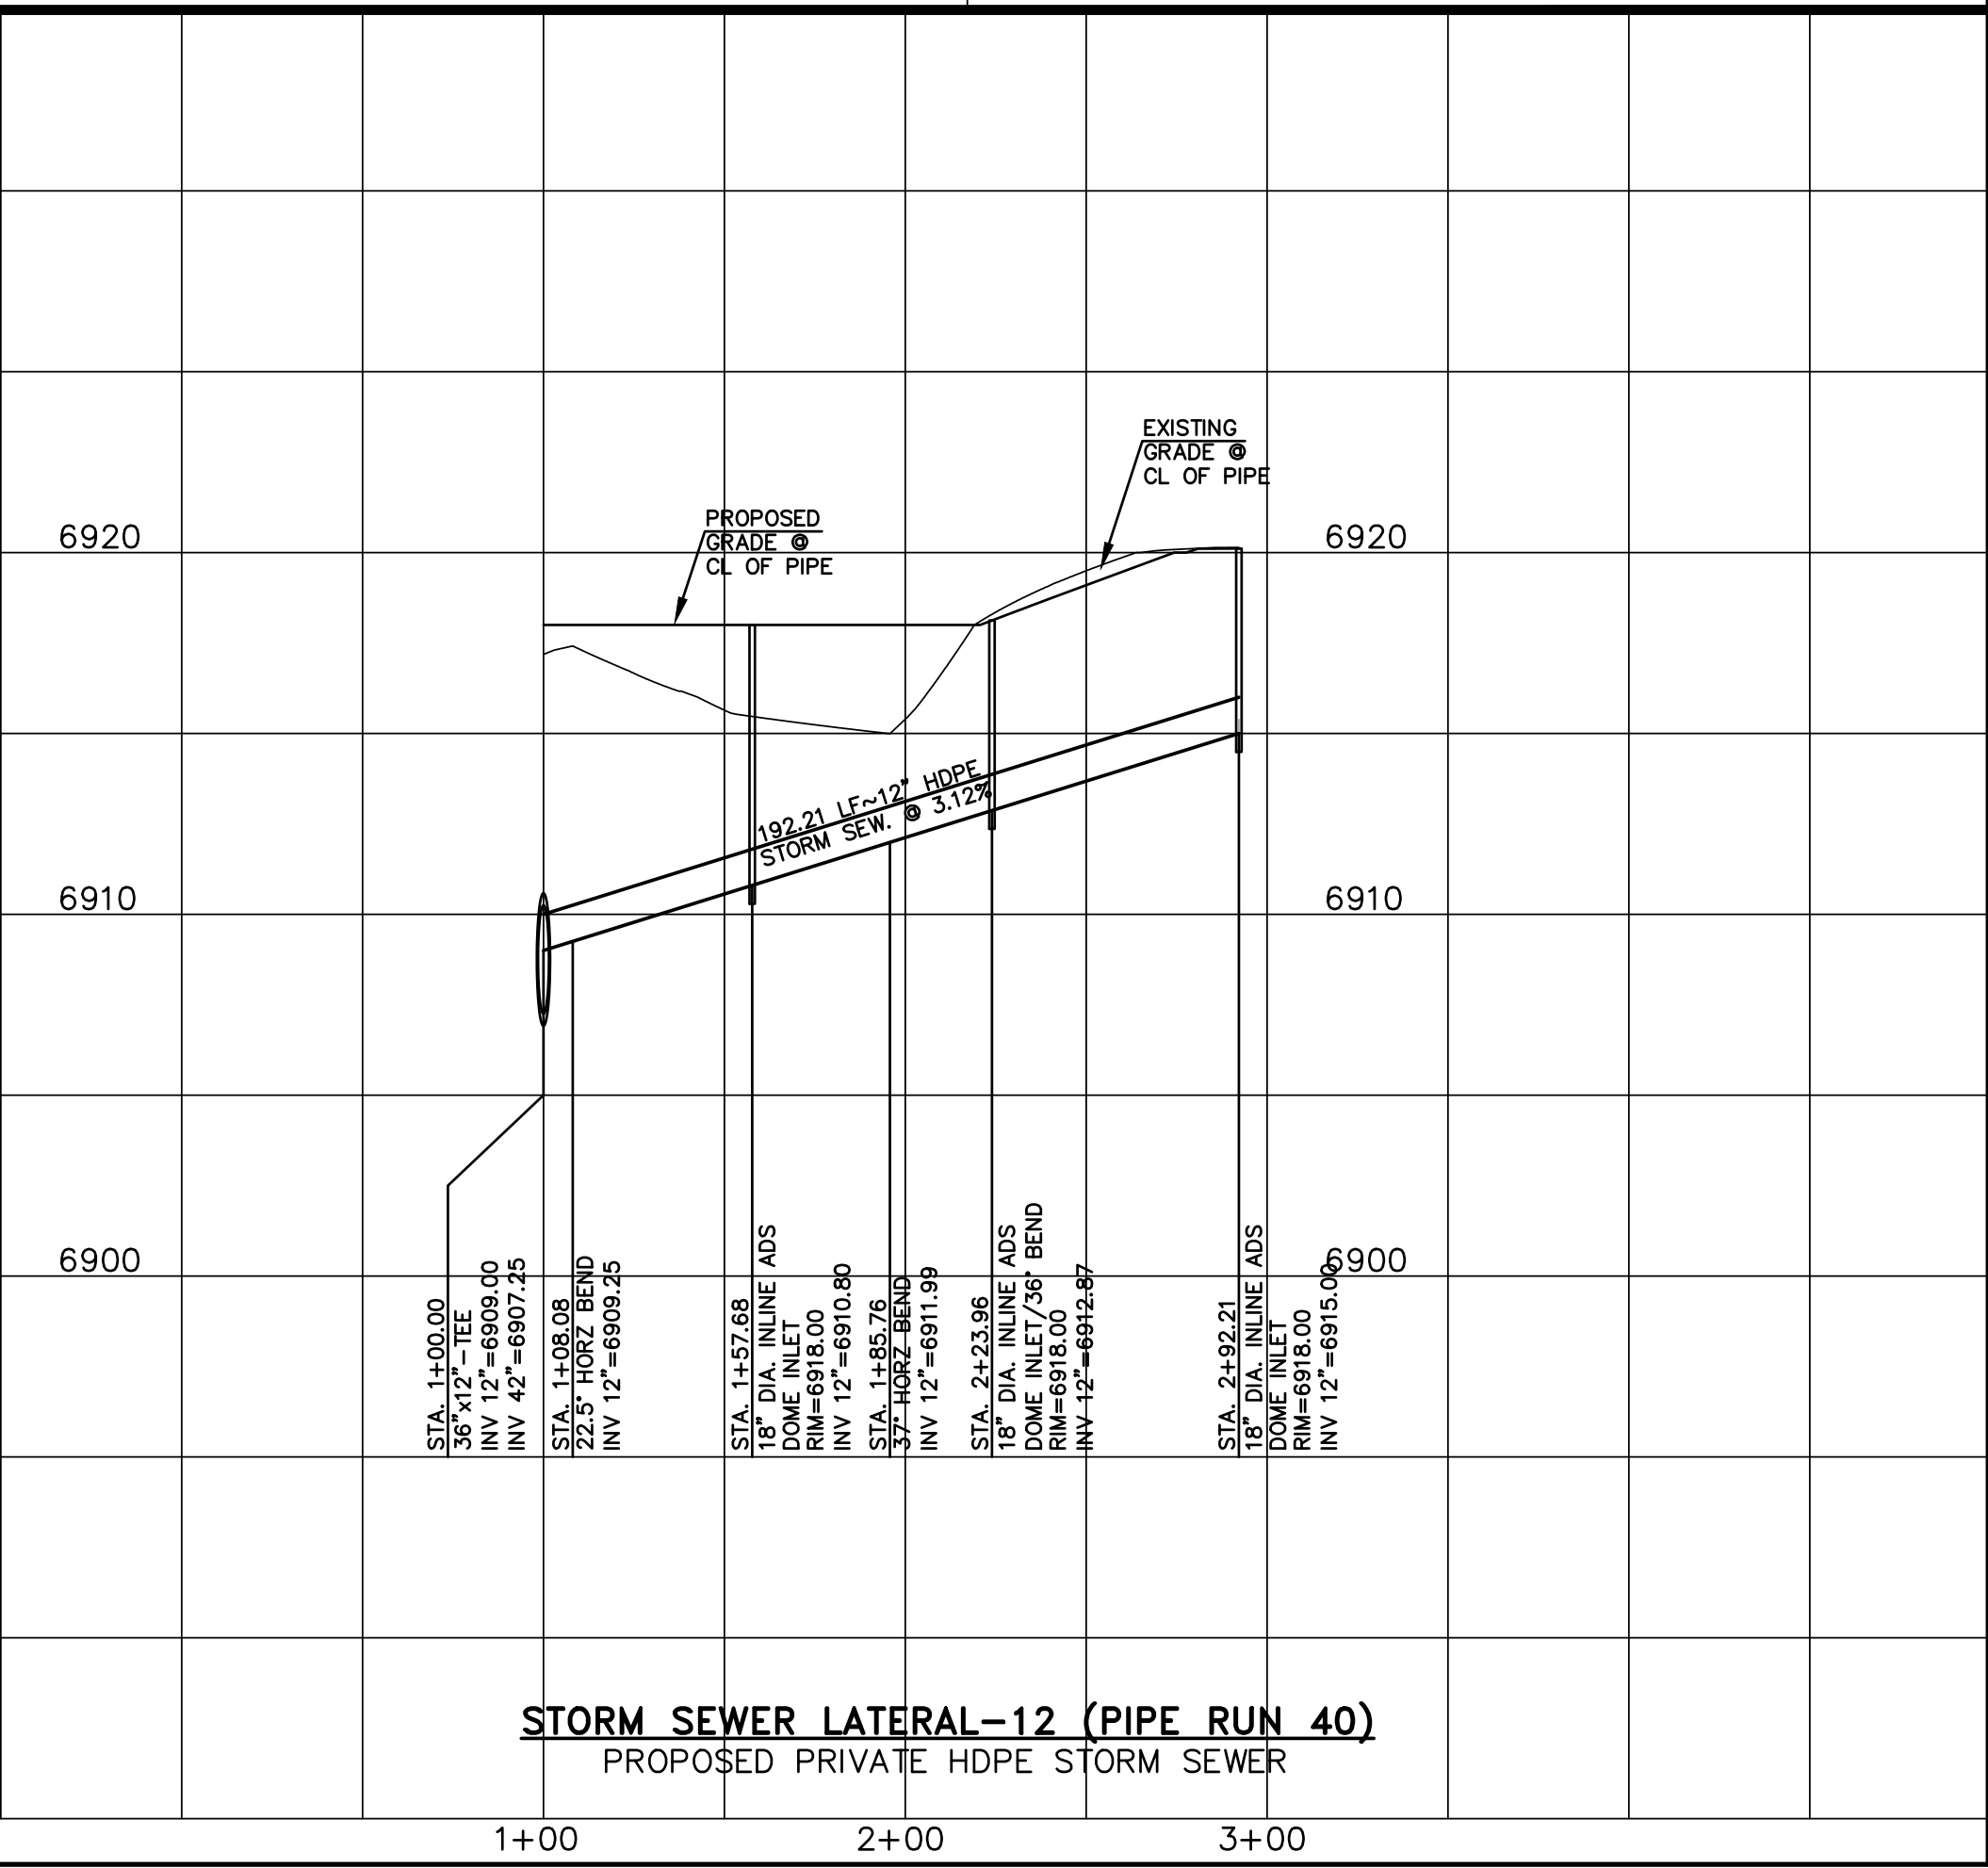

**STORM SEWER LATERAL-12 (PIPE RUN 40)**  
 PROPOSED PRIVATE HDPE STORM SEWER

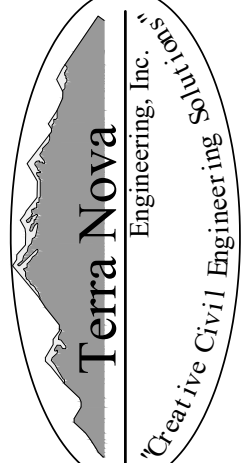UNTIL SUCH TIME AS THESE DRAWINGS ARE APPROVED BY THE REVIEWING AGENCIES FOR THE TERRA NOVA ENGINEERING AND SURVEYING, INC. APPROVED FOR USE ONLY AS DESIGNATED BY WRITTEN AUTHORIZATION.	REVISIONS NO. _____ DESCRIPTION _____ DATE _____
	PREPARED FOR: <b>4-WAY RANCH JOINT VENTURE</b> <b>PETER MARTZ</b> P.O. BOX 50223 COLORADO SPRINGS, CO 80949 719-491-3150
	
721 S. 2900 STREET COLORADO SPRINGS, CO 80904 OFFICE: 719-635-6422 FAX: 719-635-6426 www.tneshc.com	
<b>WATERBURY FILING NO. 1</b> CONSTRUCTION SET STORM SEWER LATERAL 13, 14	
DESIGNED BY QNA DRAWN BY QNA CHECKED BY _____ H-SCALE 1"=50' V-SCALE 1"=5' JOB NO. 1715.00 DATE ISSUED 2/6/23 SHEET NO. 33 OF 39	





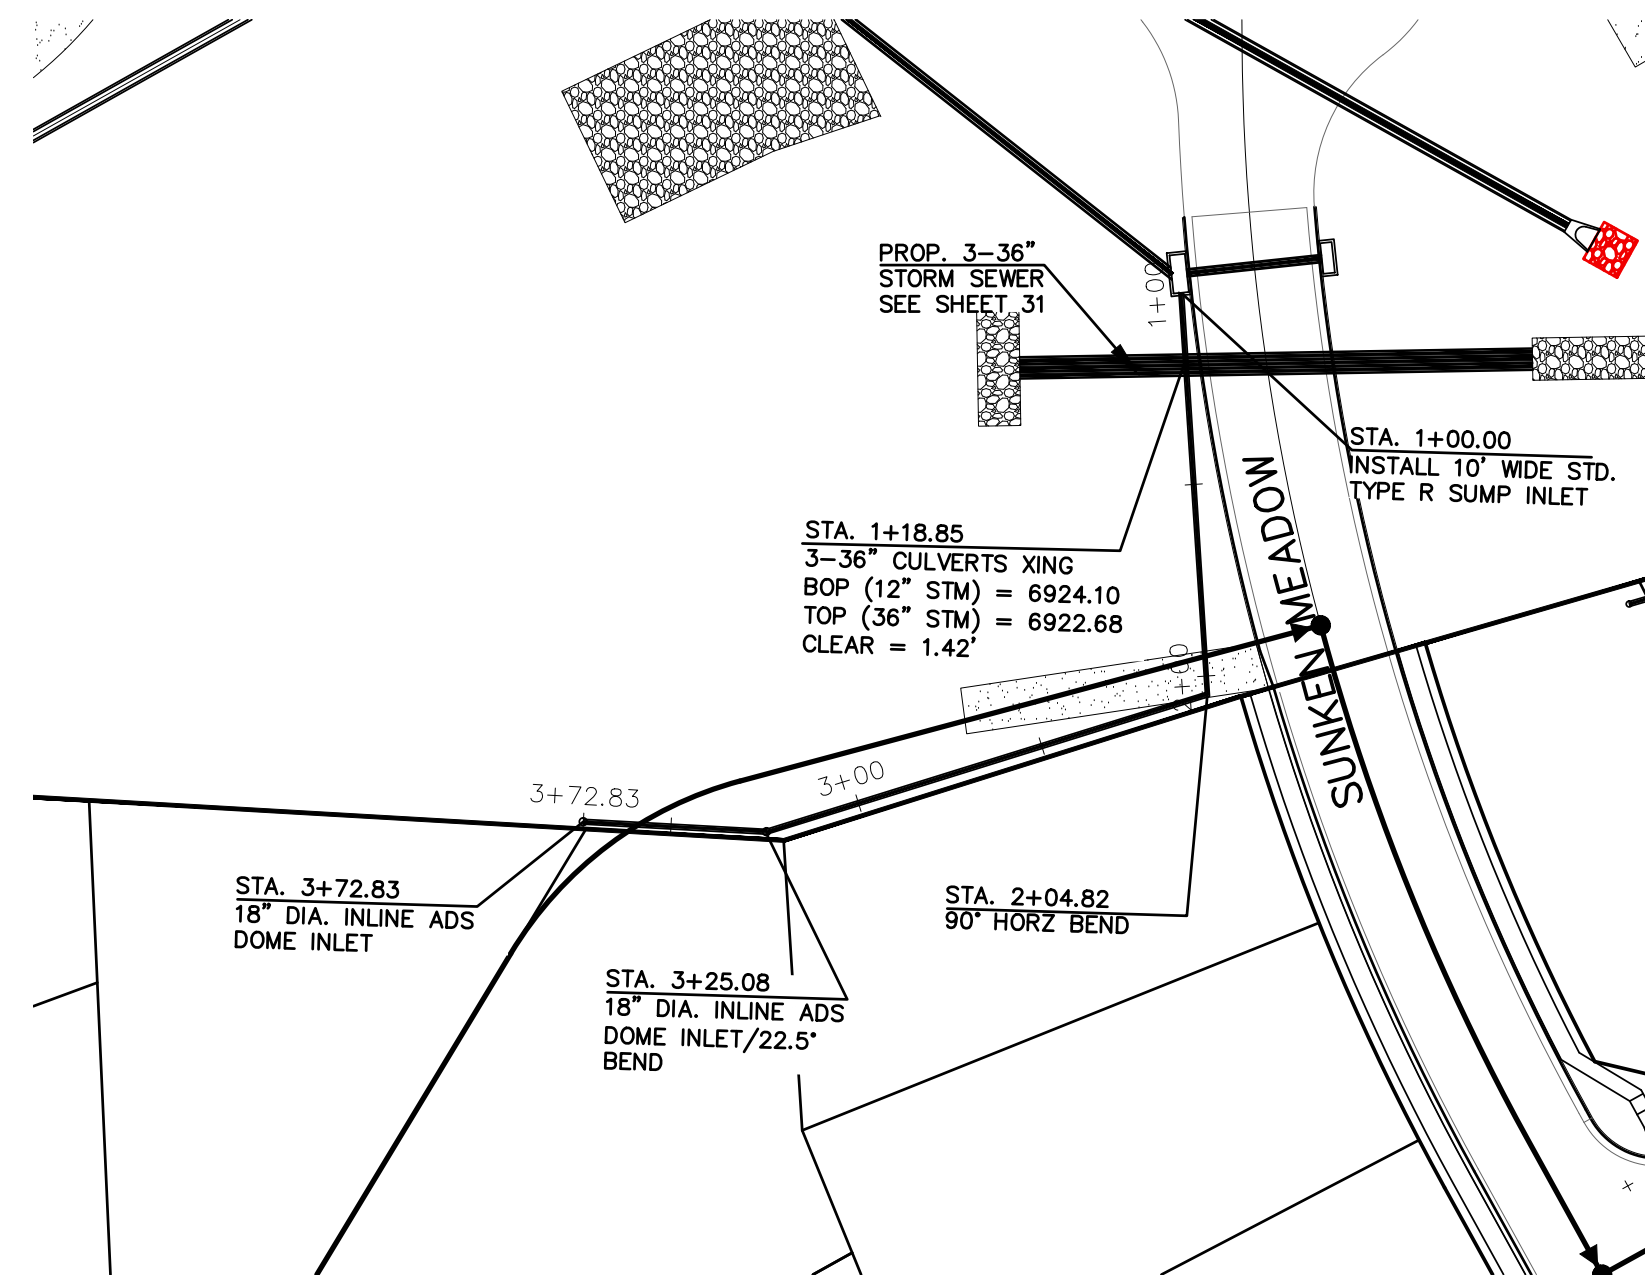

**STORM SEWER LATERAL-13**  
 PROPOSED PRIVATE HDPE STORM SEWER  
 1" = 50' HORIZ. 1" = 5' VERT.




**STORM SEWER LATERAL-14 (PIPE RUN 37)**  
 PROPOSED PRIVATE HDPE STORM SEWER  
 1" = 50' HORIZ. 1" = 5' VERT.

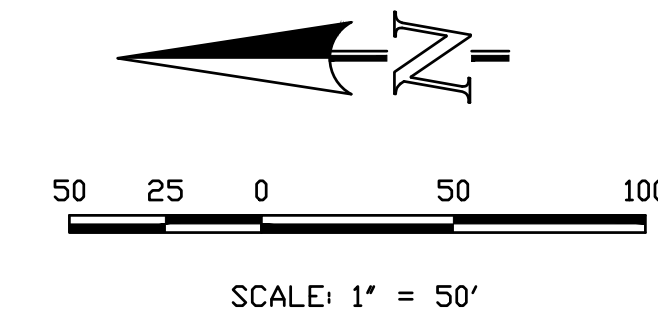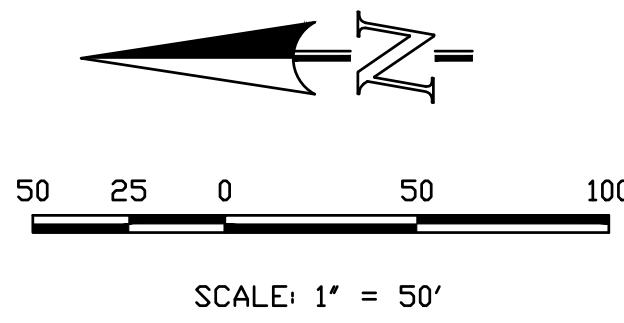


THIS DESIGN WAS PREPARED UNDER MY DIRECT SUPERVISION FOR AND ON BEHALF OF TERRA NOVA ENGINEERING, INC.

QUENTIN N. ARMIJO, PROFESSIONAL ENGINEER  
 COLORADO P.E. NO. 37170

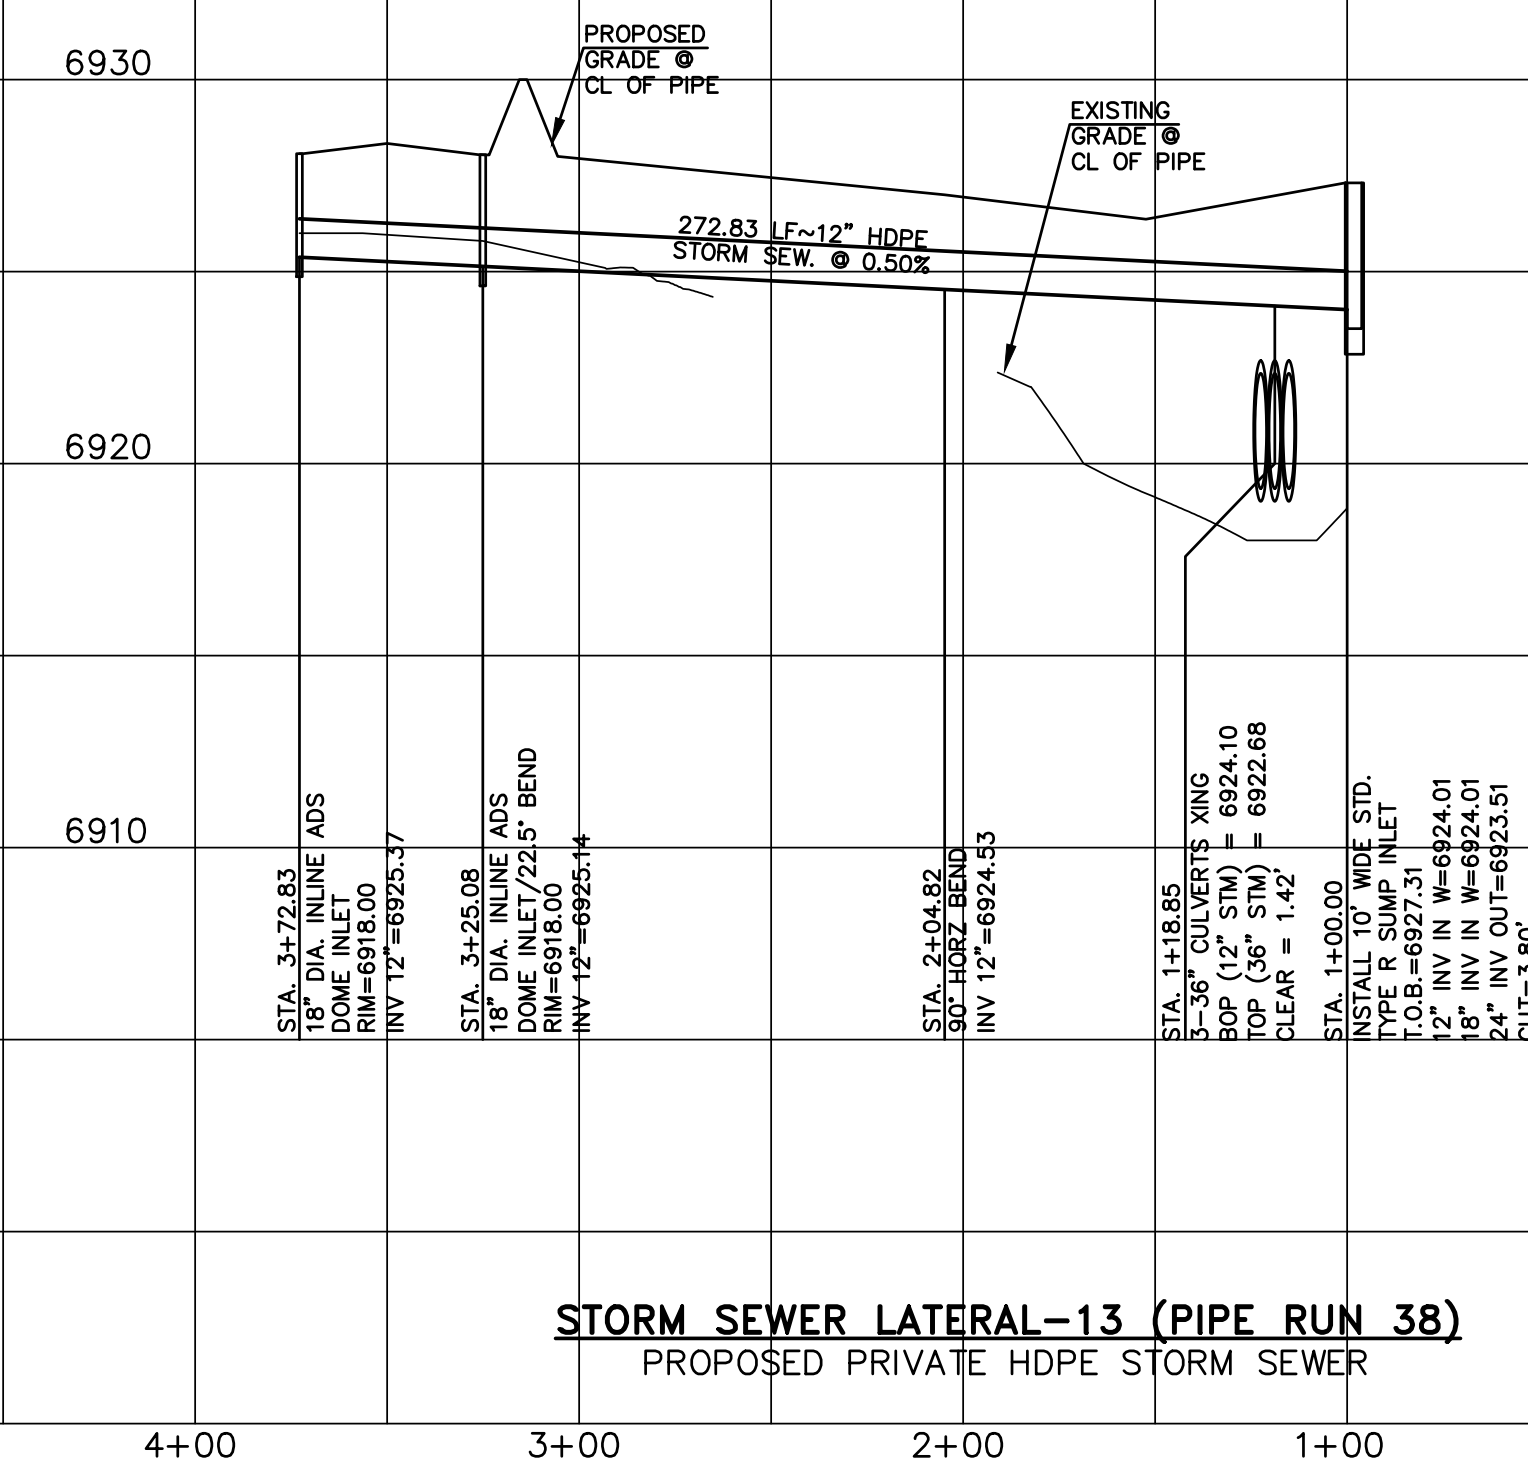

**STORM SEWER LATERAL-13 (PIPE RUN 38)**  
 PROPOSED PRIVATE HDPE STORM SEWER

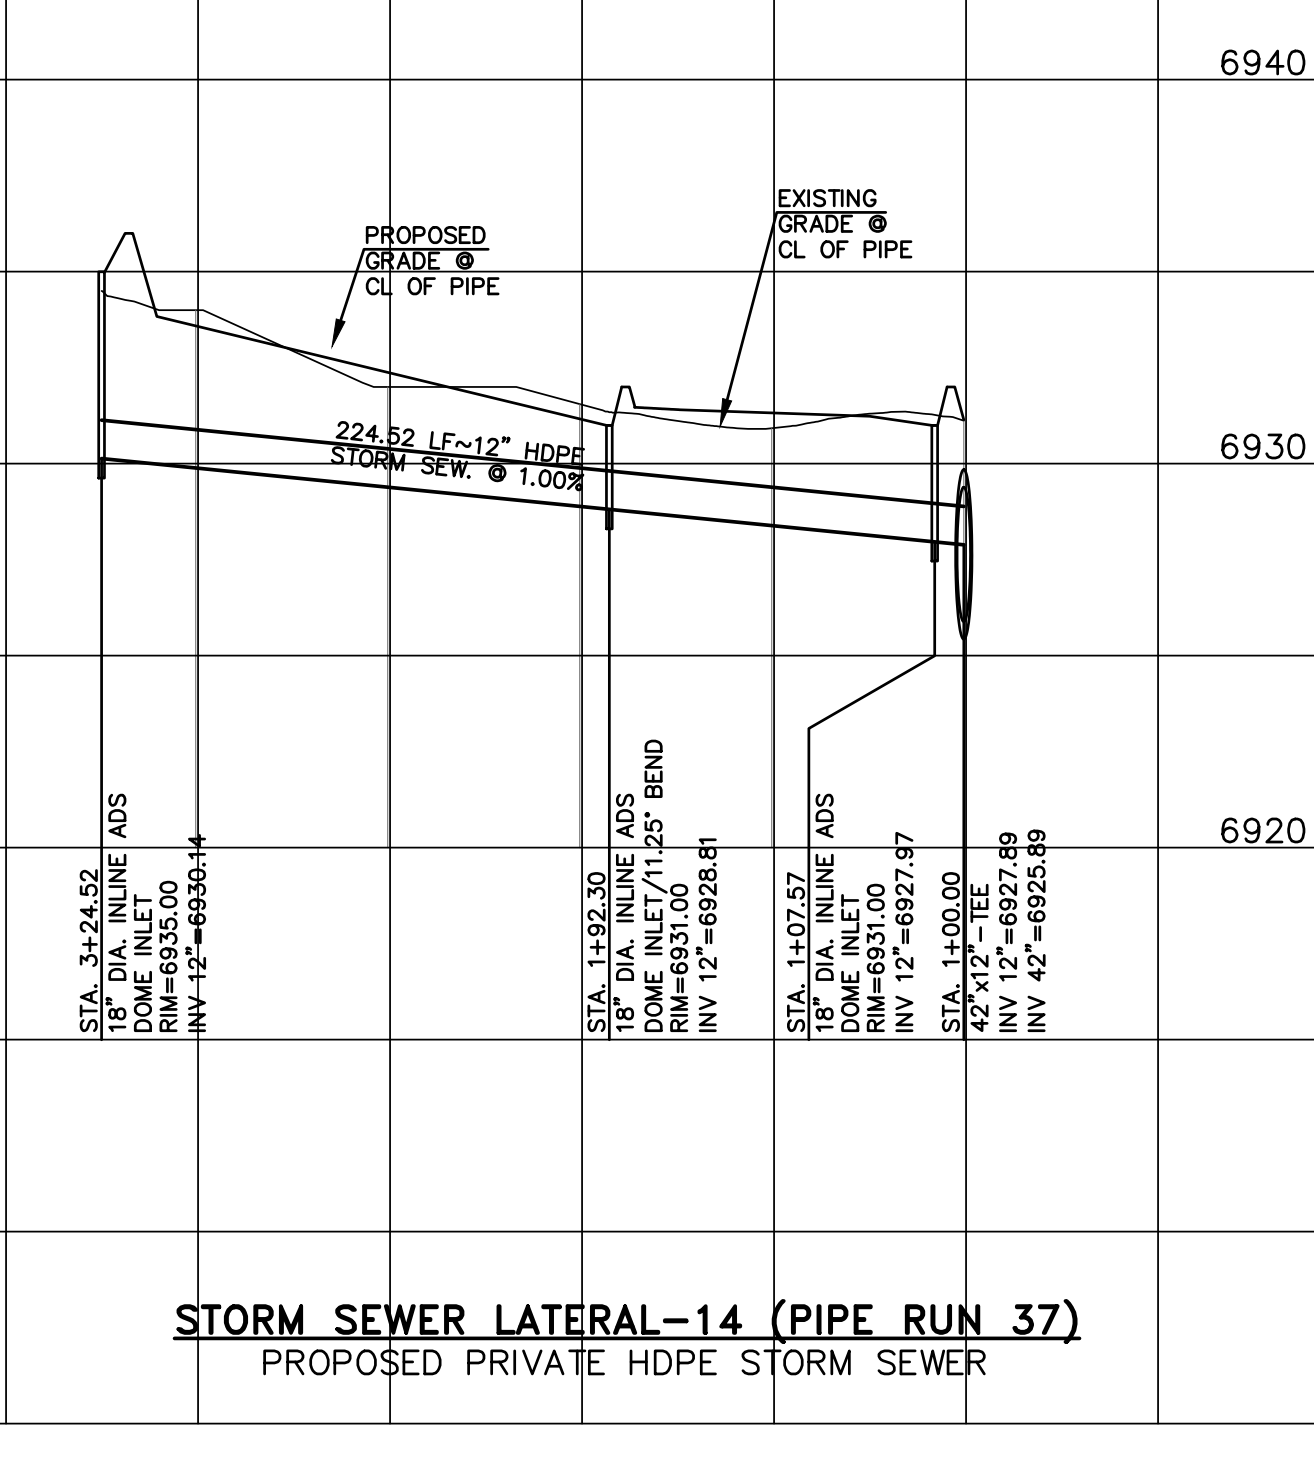

**STORM SEWER LATERAL-14 (PIPE RUN 37)**  
 PROPOSED PRIVATE HDPE STORM SEWER

REVISIONS	NO.	DESCRIPTION	DATE

UNTL SUCH TIME AS THESE DRAWINGS ARE APPROVED BY THE REVIEW AGENCIES TERRA NOVA ENGINEERING AND SURVEYING, INC. APPROVES THEIR USE ONLY DESIGNATED BY WRITTEN AUTHORIZATION.

PREPARED FOR:  
**4-WAY RANCH JOINT VENTURE**  
**PETER MARTZ**  
 P.O. BOX 50223  
 COLORADO SPRINGS, CO 80949  
 719-491-3150

721 S. 2900 STREET  
 COLORADO SPRINGS, CO 80904  
 OFFICE: 719-635-6422  
 FAX: 719-635-6426  
 www.tneshc.com

**WATERBURY FILING NO. 1**  
 CONSTRUCTION SET  
 STORM SEWER LATERAL 11, 12

DESIGNED BY QNA  
 DRAWN BY QNA  
 CHECKED BY  
 H-SCALE 1"=50'  
 V-SCALE 1"=5'  
 JOB NO. 1715.00  
 DATE ISSUED 2/6/23  
 SHEET NO. 32 OF 3



1) overlapping hatching is confusing as what the purpose of each is.  
 2) For detail on next page, spillway is not to have any riprap (just compacted earth), but this hatching is used elsewhere to represent riprap. Clarify to remove discrepancies.

Or is there supposed to be riprap or soil riprap like with the other 2 ponds? No text callout for riprap seen with this pond.

Provide length dimensions for the spillway and thickness of riprap.

Provide dimensions for forebays. This should include the forebay notch width as well, or provide separate forebay detail. Typical for all ponds.

**WEST CONCRETE FOREBAY/MICROPOOL DETAILS**

**EAST CONCRETE FOREBAY DETAILS**

Provide the width as well.








Typical comment for all 3 ponds:  
 Pond bottom should have a minimum slope of 3% to the trickle channel and micropool (USDCM Vol 3, detail T-5). Please adjust to minimize future maintenance needs.


Revise to "Pond 1" for consistency with title block, details, and DR.



What are these station lines for? Update or remove?

Show easement around pond and access for all ponds


move or delete misplaced callouts

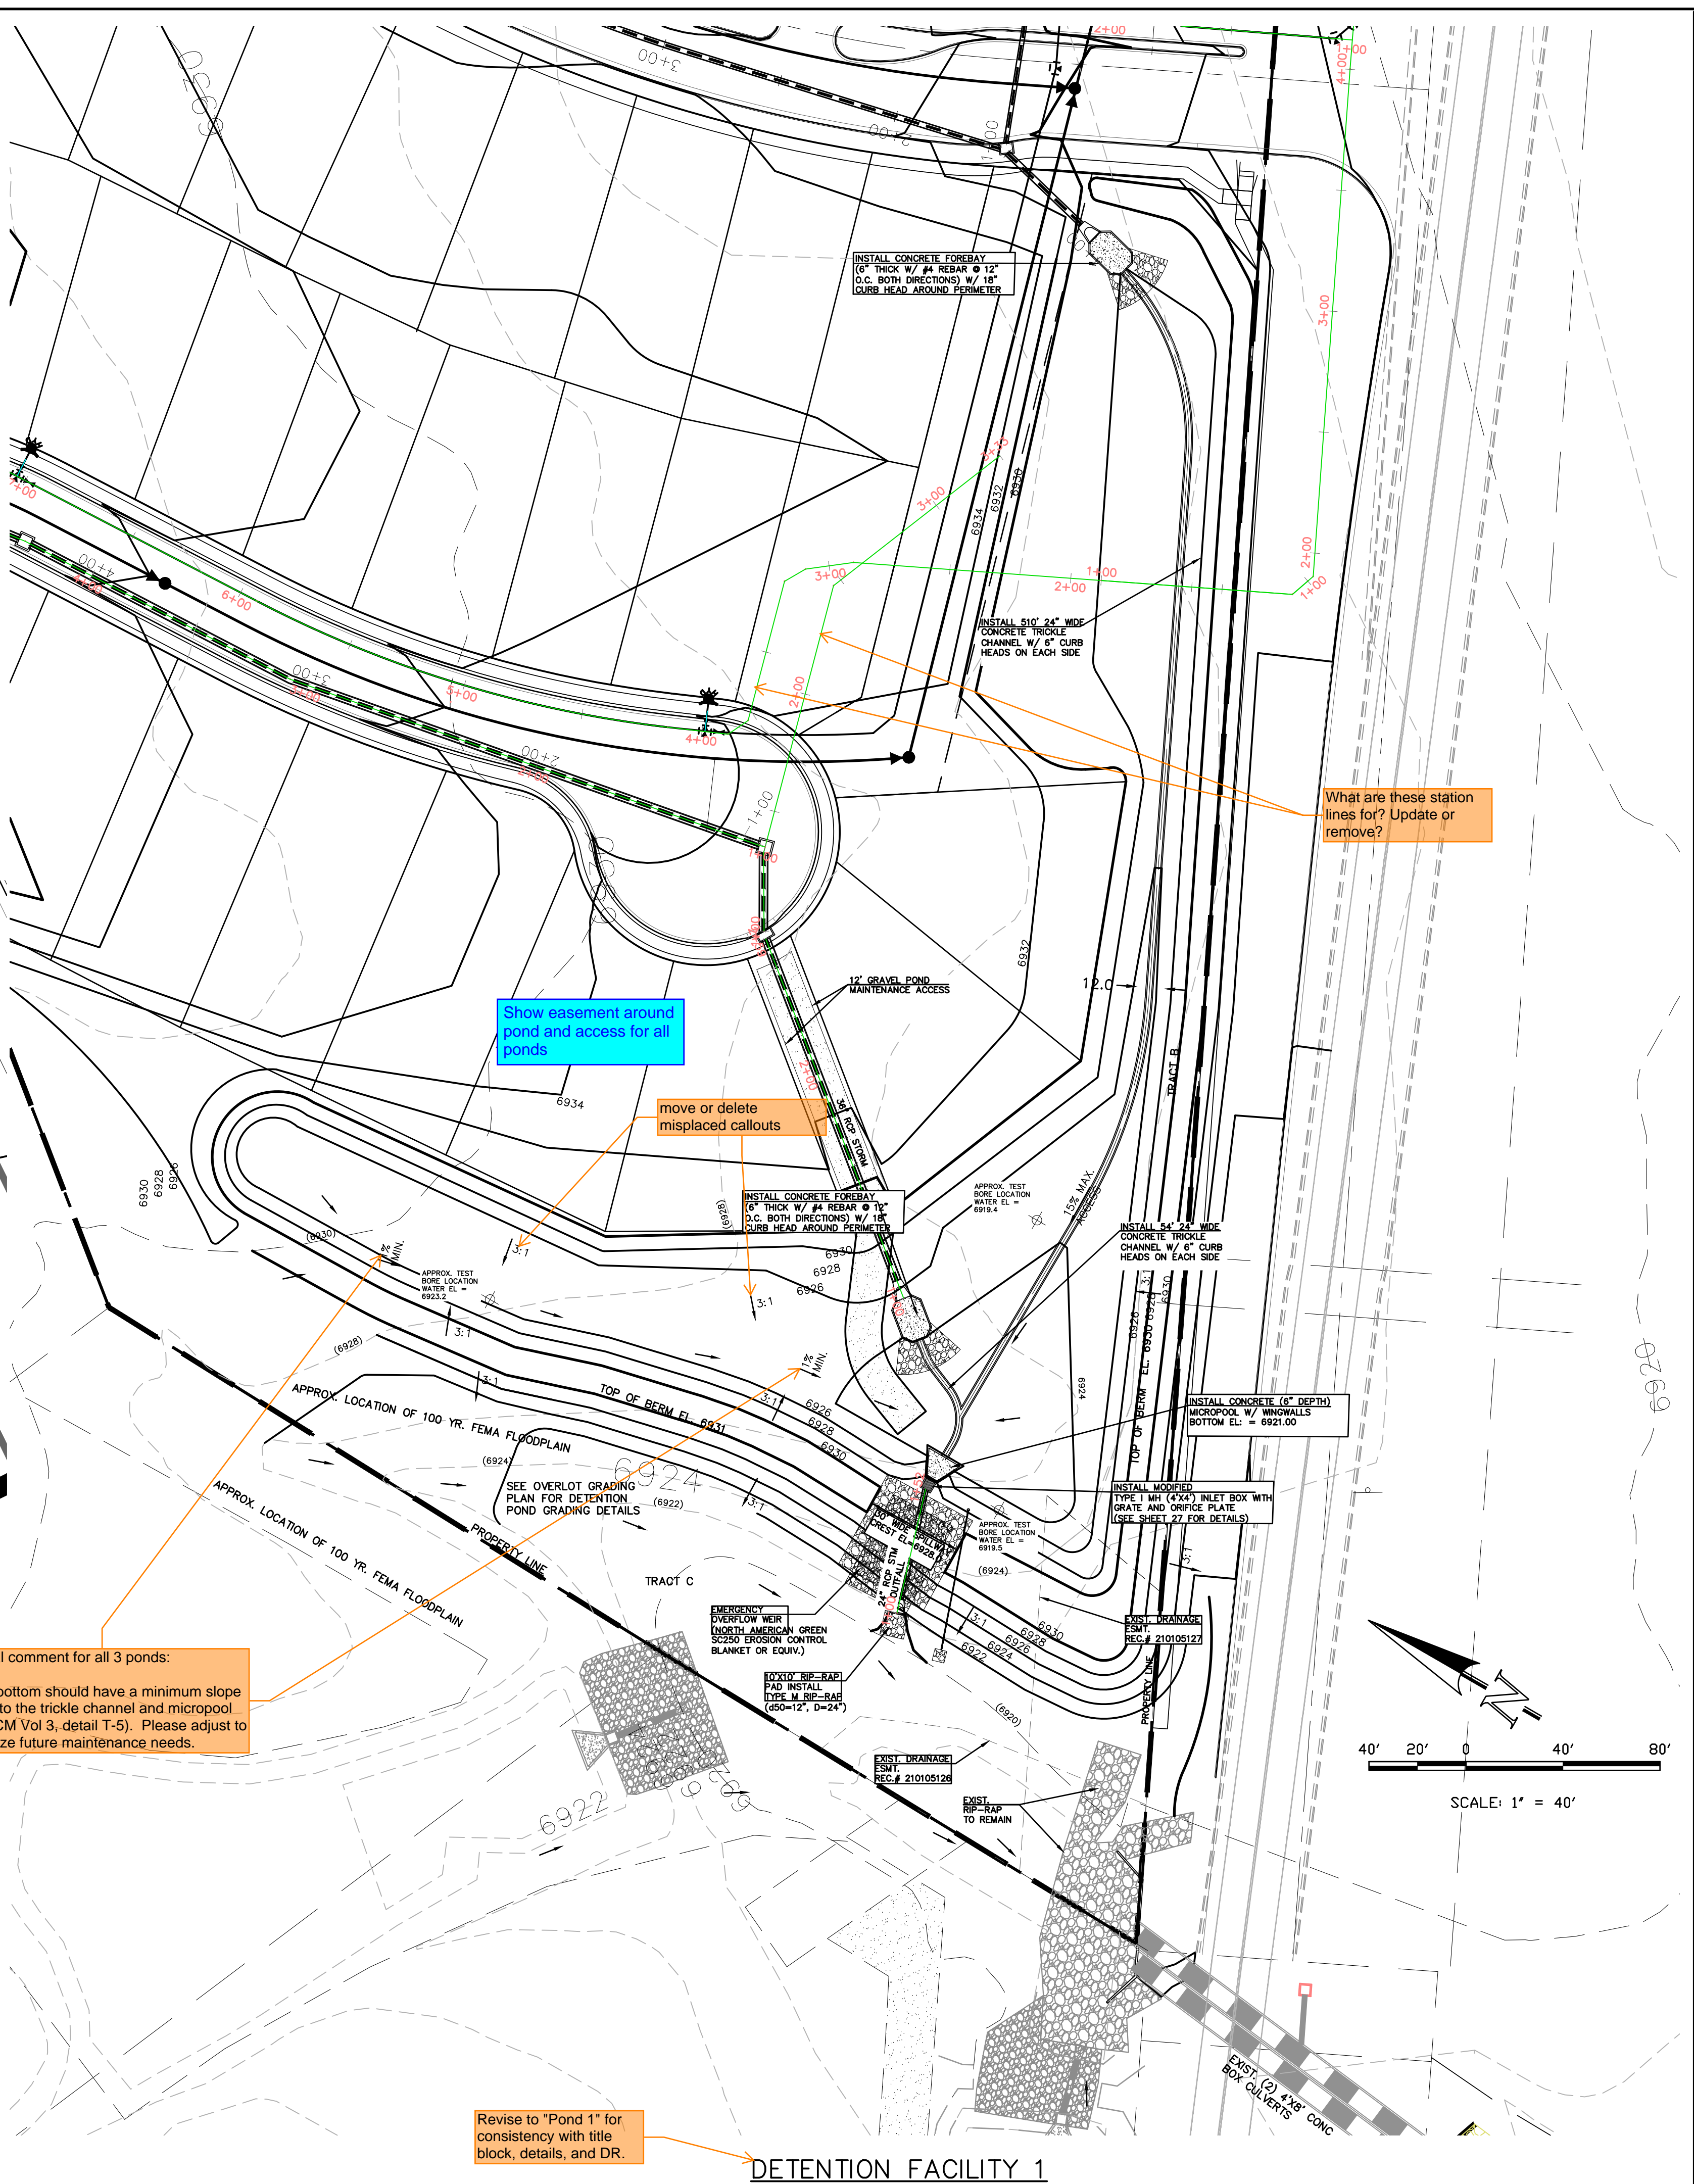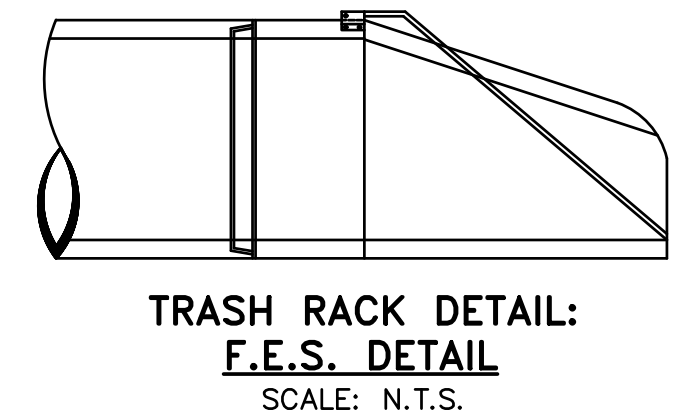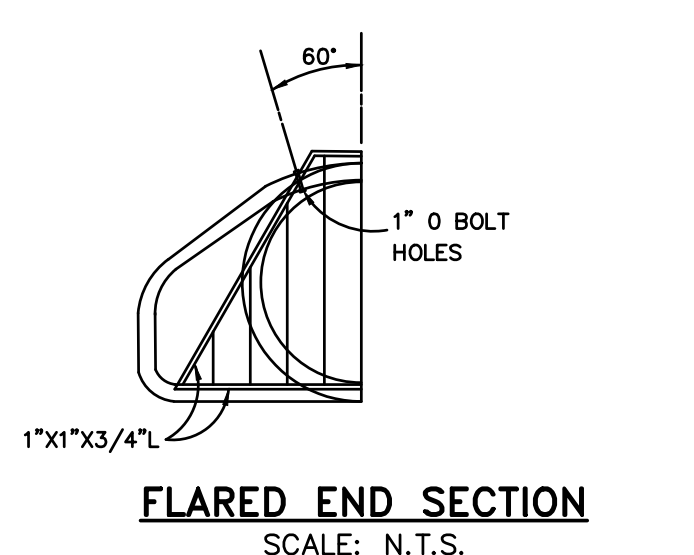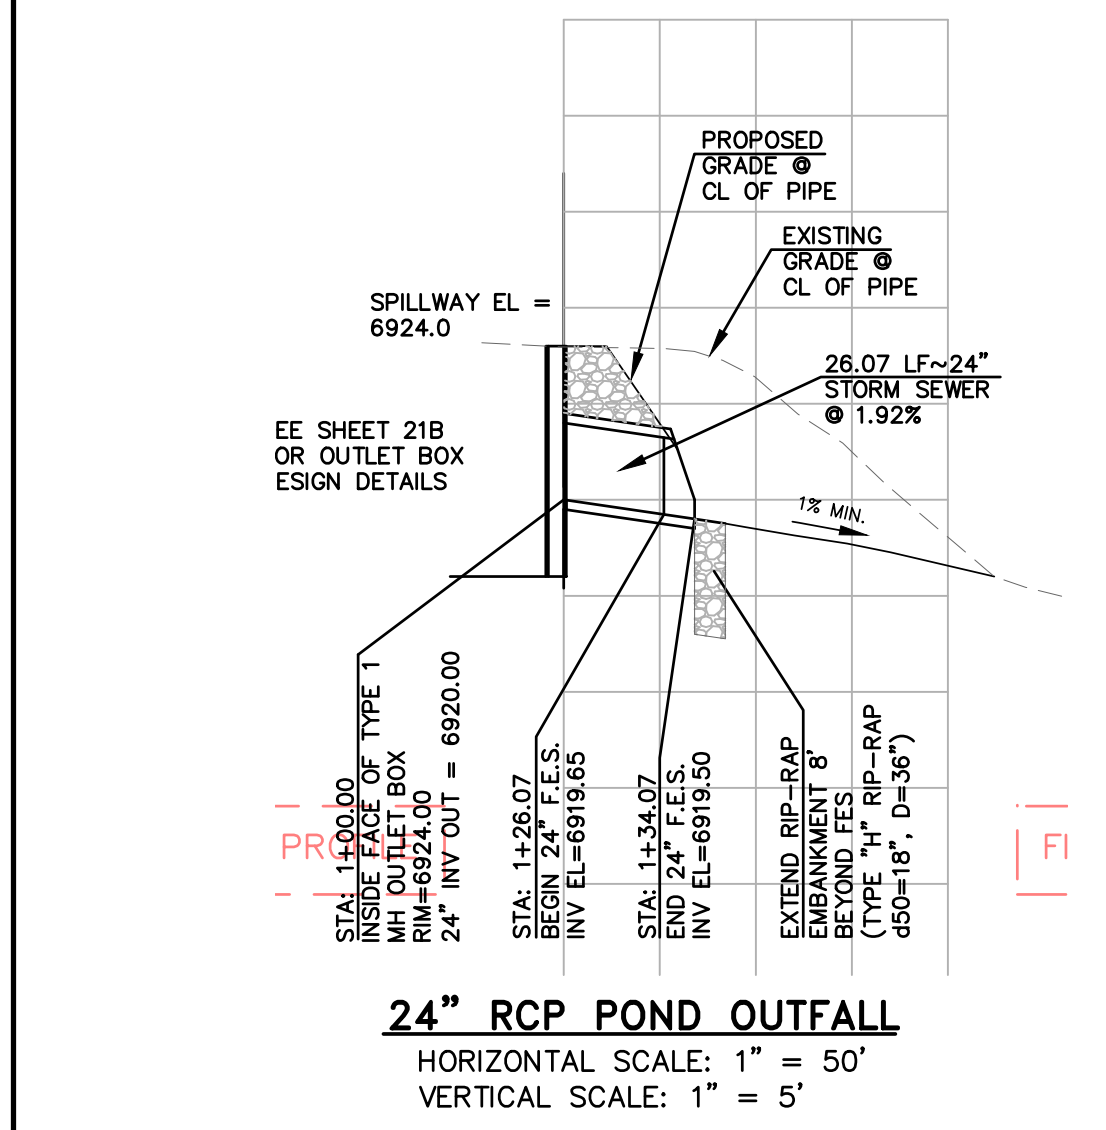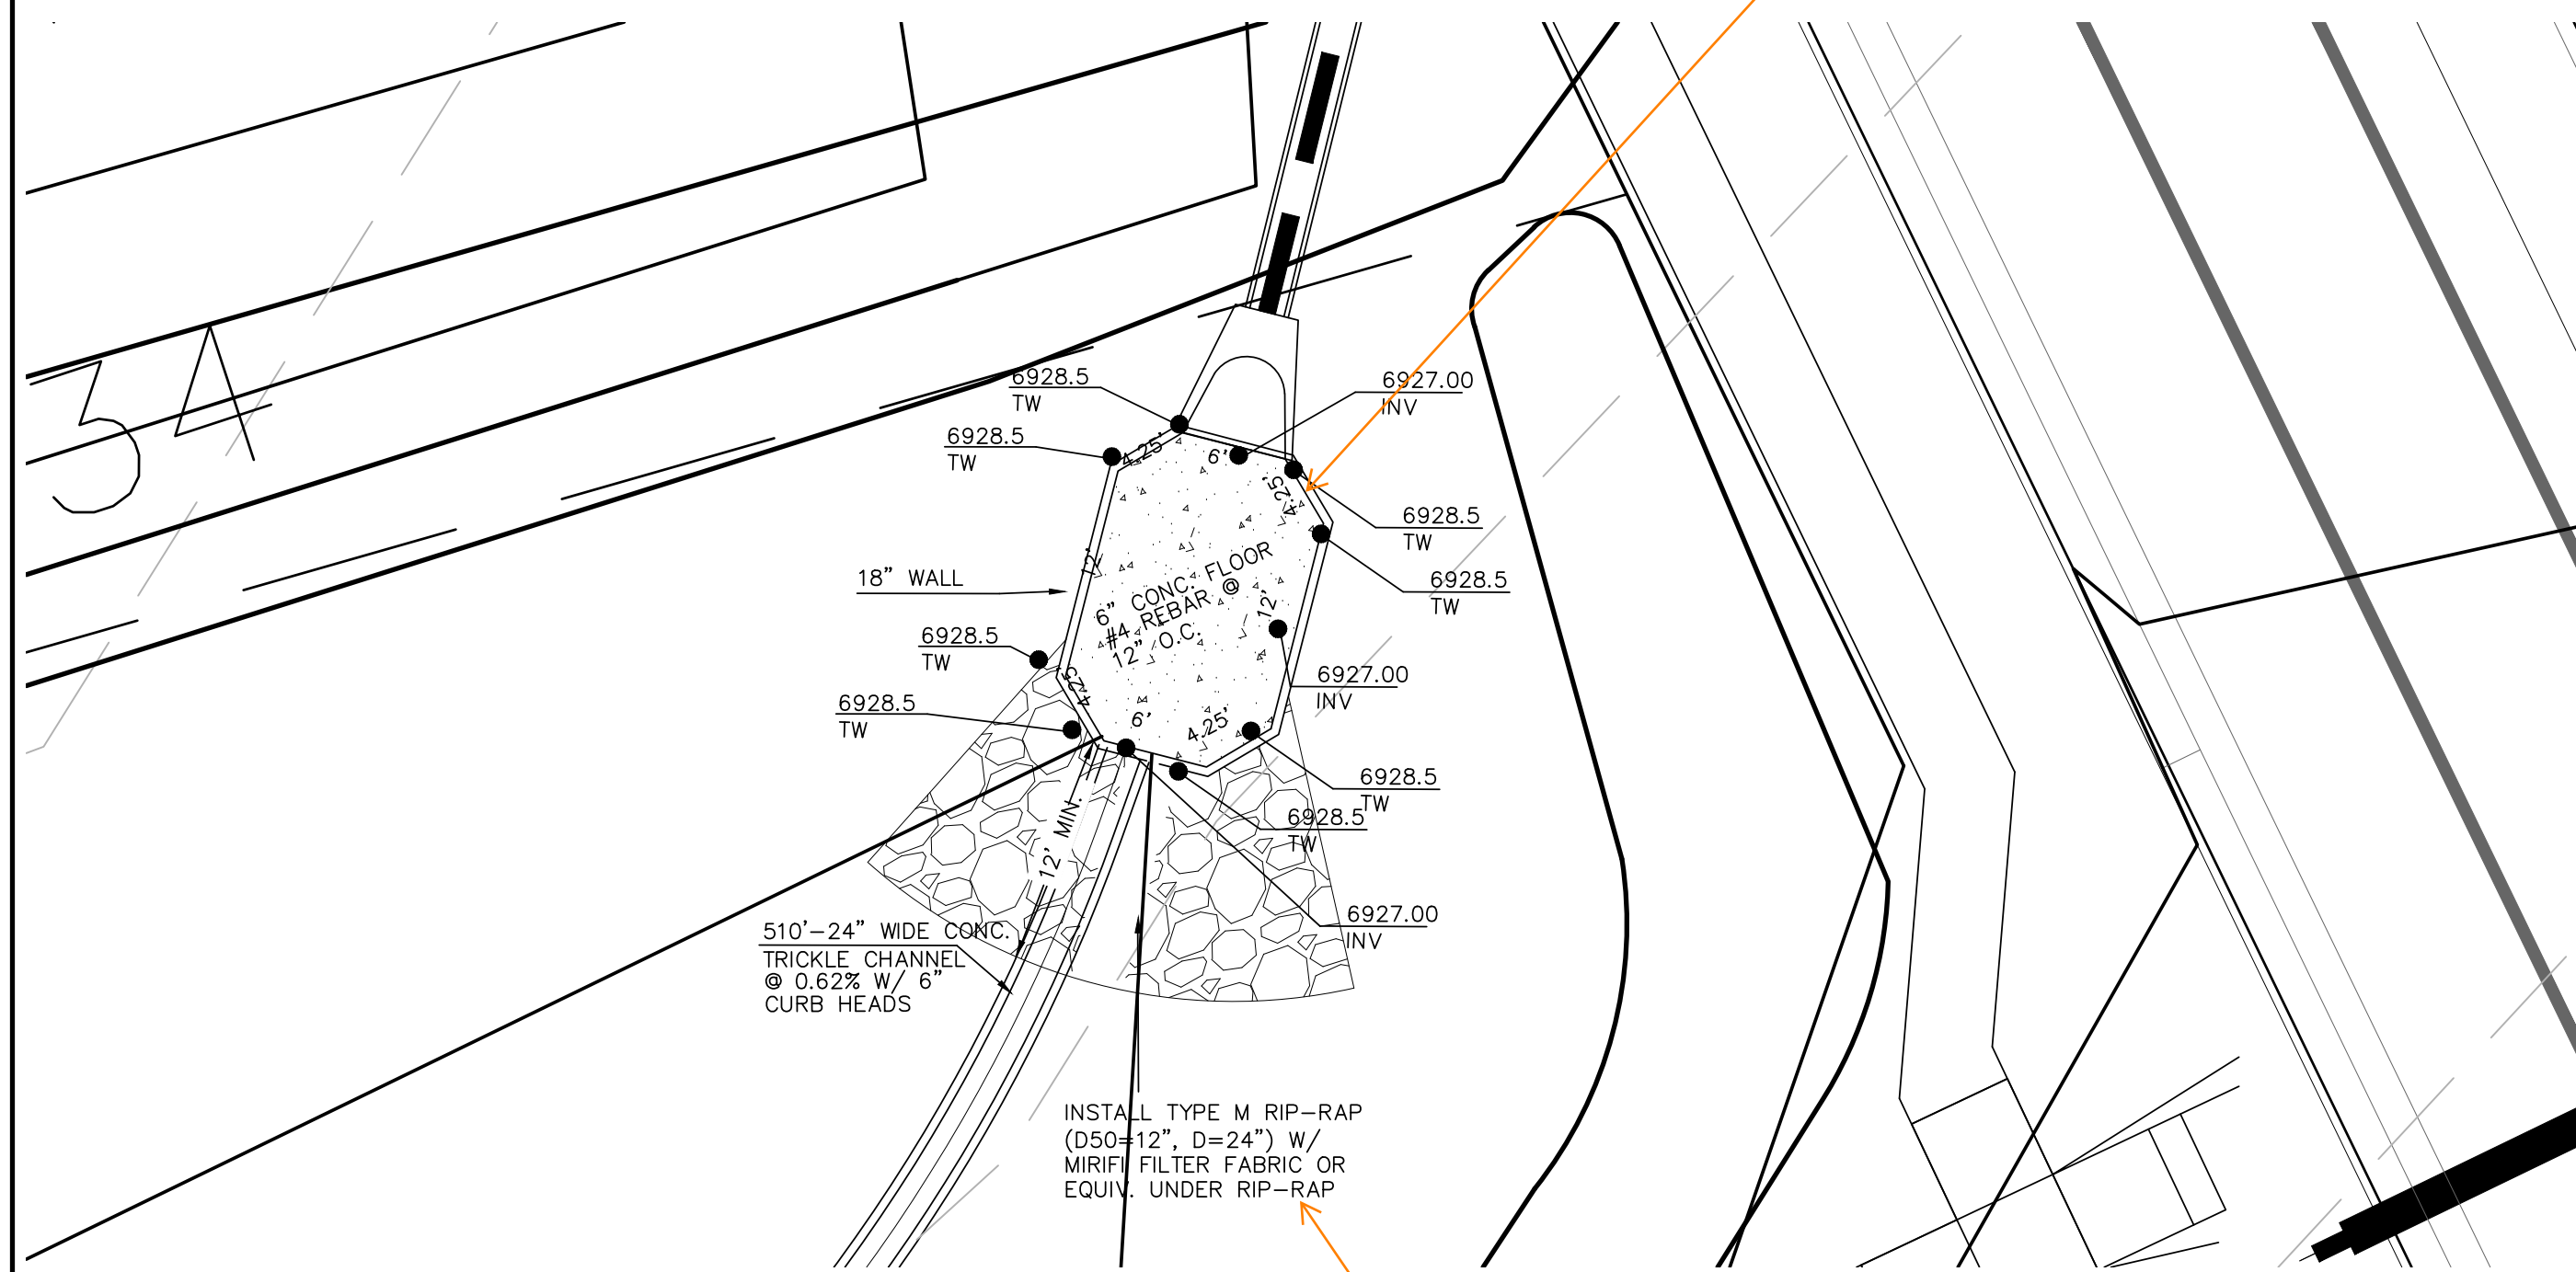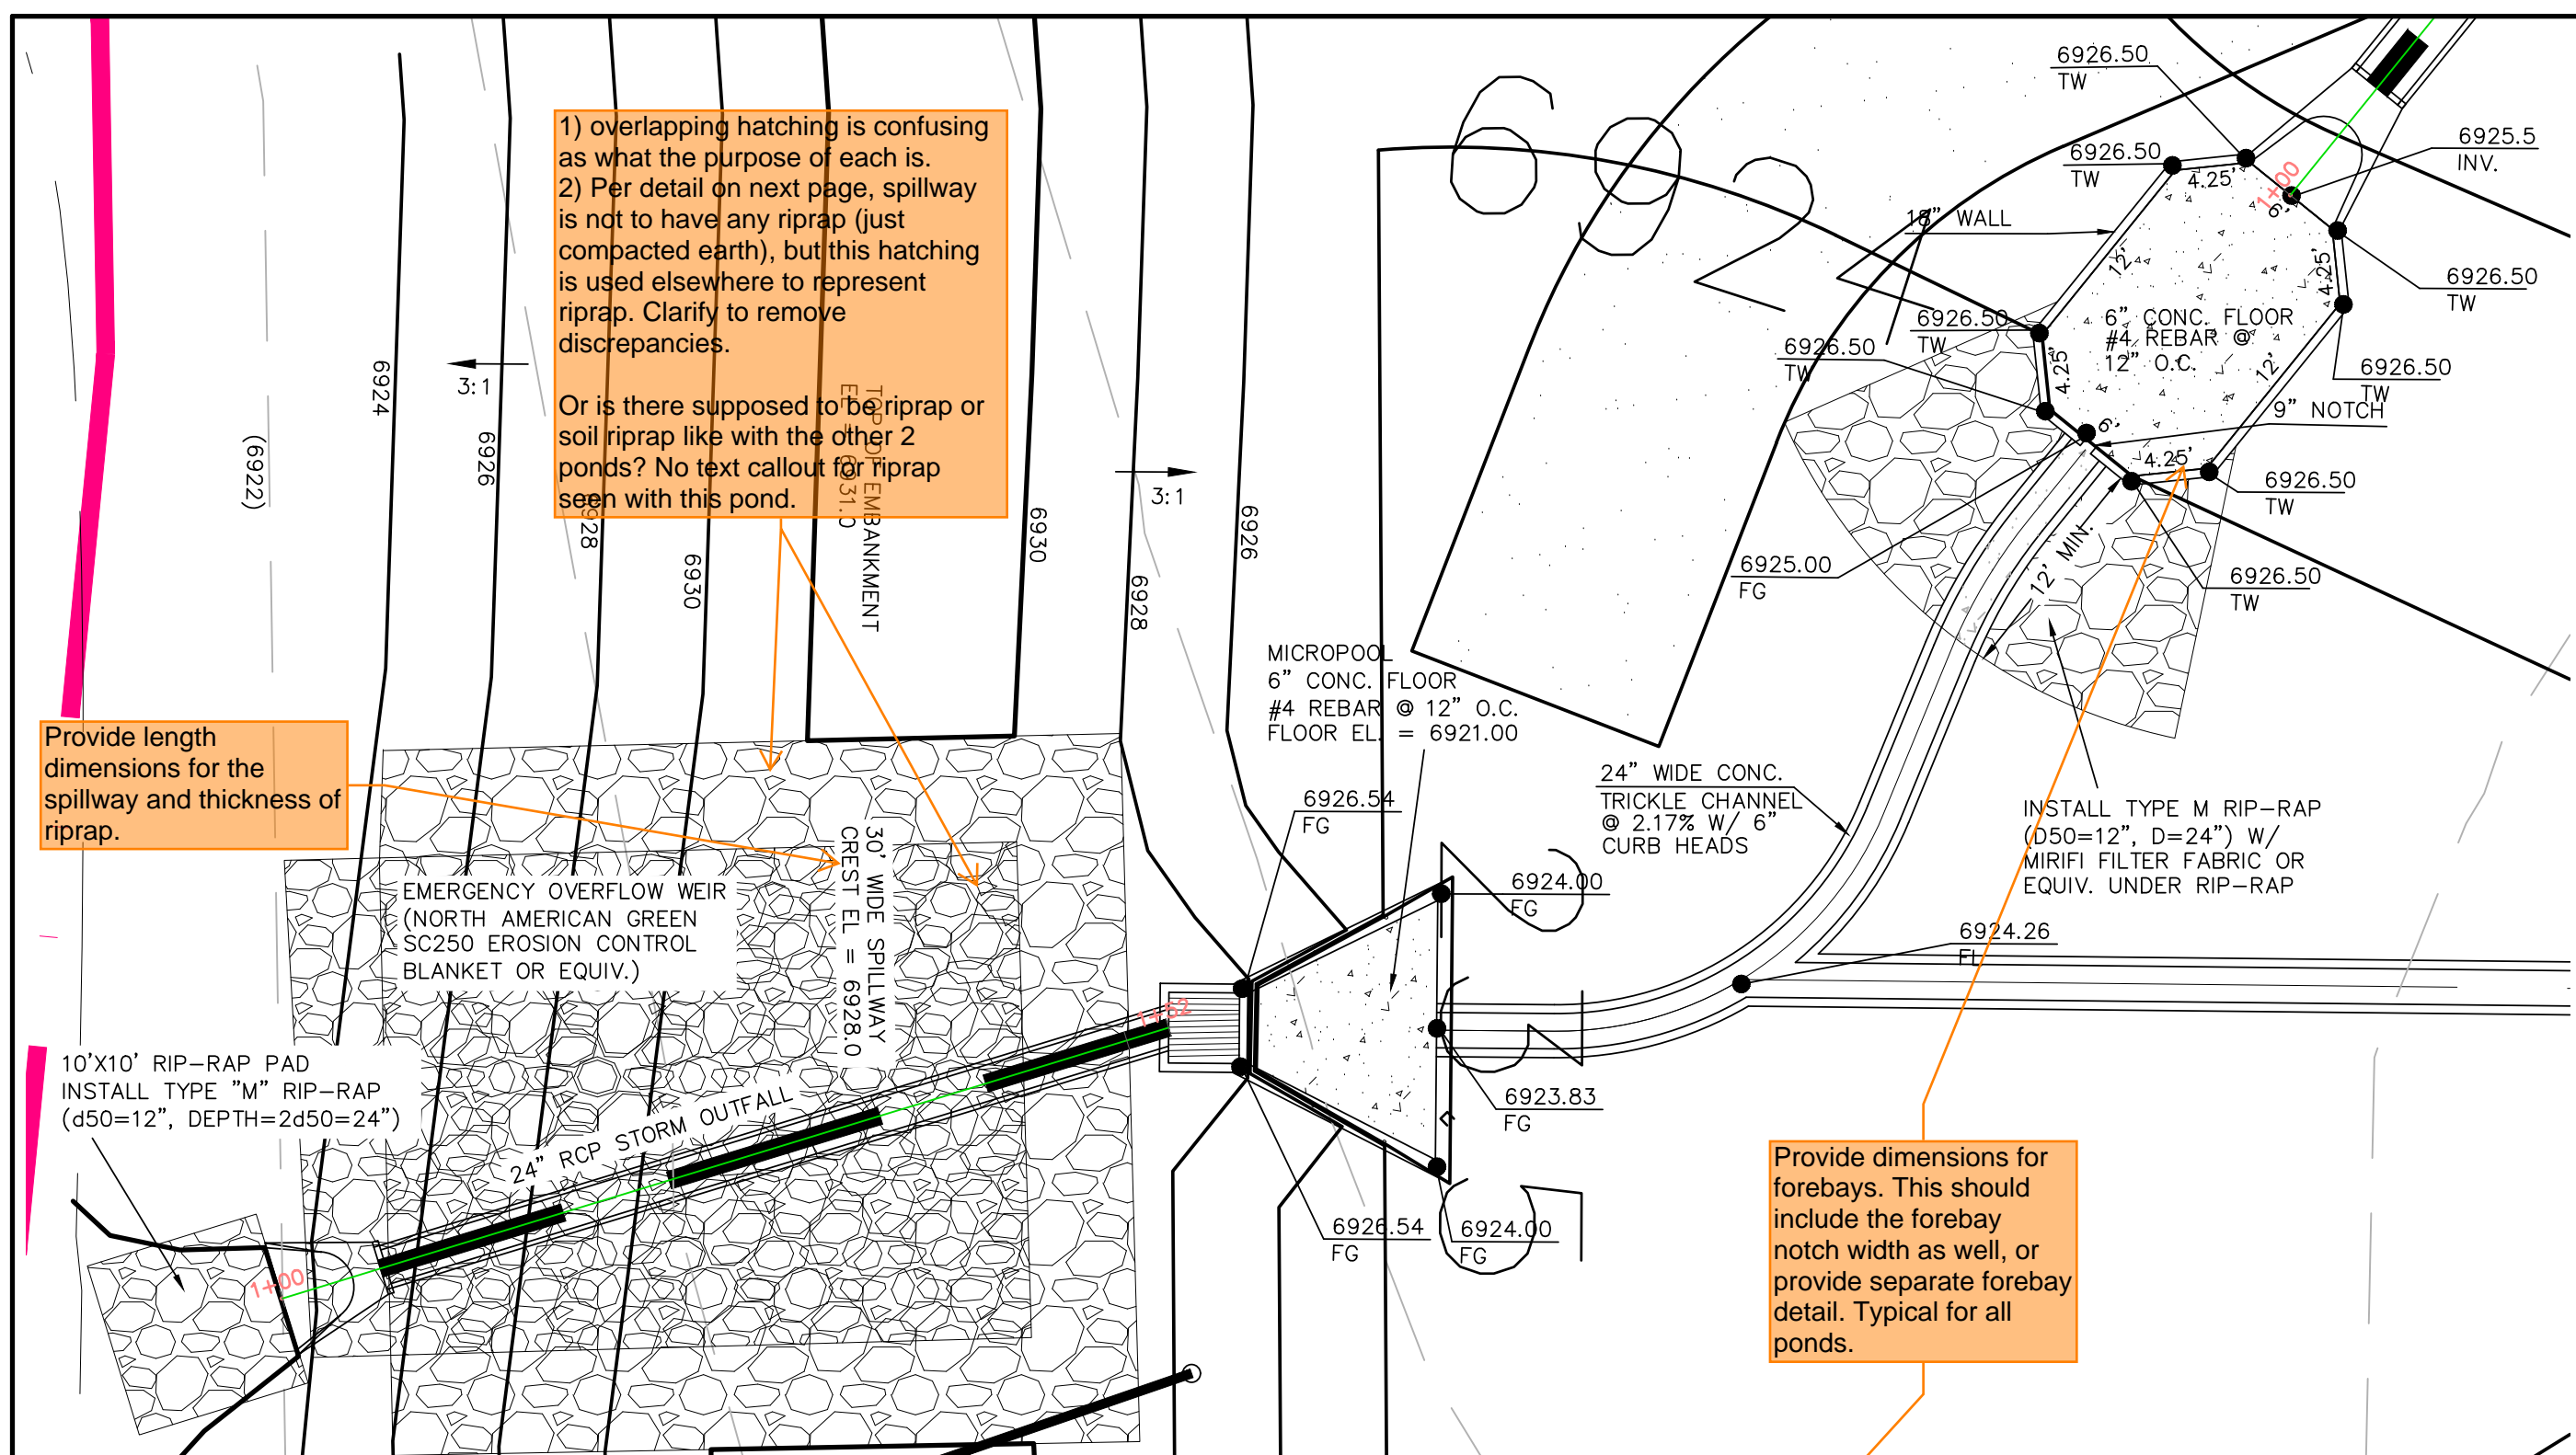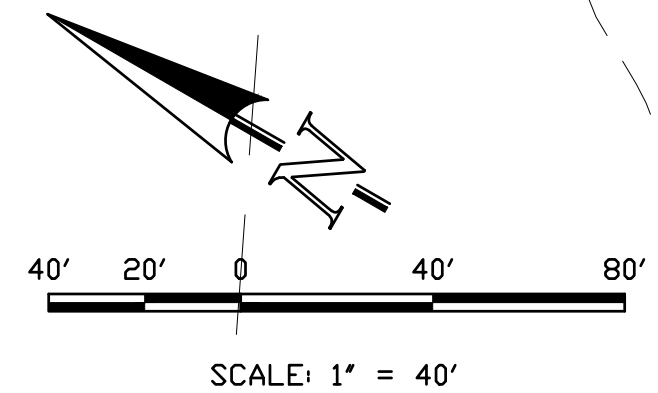

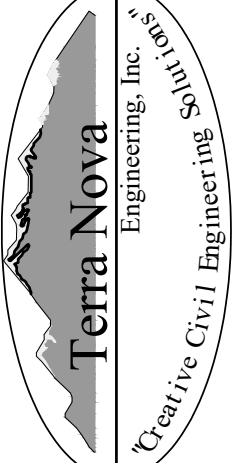
DATE	
DESCRIPTION	
REVISIONS	
NO.	
UNTIL SUCH TIME AS THESE DRAWINGS ARE APPROVED BY THE ENGINEER, THESE DRAWINGS ARE NOT TO BE USED FOR CONSTRUCTION. THE USER ASSUMES ALL LIABILITY FOR ANY DAMAGE OR INJURY CAUSED BY THE USE OF THESE DRAWINGS WITHOUT WRITTEN AUTHORIZATION.	
PREPARED FOR:	4-WAY RANCH, JOINT VENTURE
ATTN:	PETER MARTZ
	P.O. BOX 50223
	COLORADO SPRINGS, CO 80949
	719-491-3150
 Terra Nova Engineering, Inc. Civil Engineering	
721 S. 23RD STREET	COLORADO SPRINGS, CO 80904
OFFICE: 719-635-6422	FAX: 719-635-6426
www.terra-nova.com	
WATERBURY FILING NO. 1	
CONSTRUCTION SET	
POND 1 DETAILS	
DESIGNED BY	DLF
DRAWN BY	QNA
CHECKED BY	QNA
H-SCALE	NA
V-SCALE	N/A
JOB NO.	1715.00
DATE ISSUED	2/6/23
SHEET NO.	35 OF 39

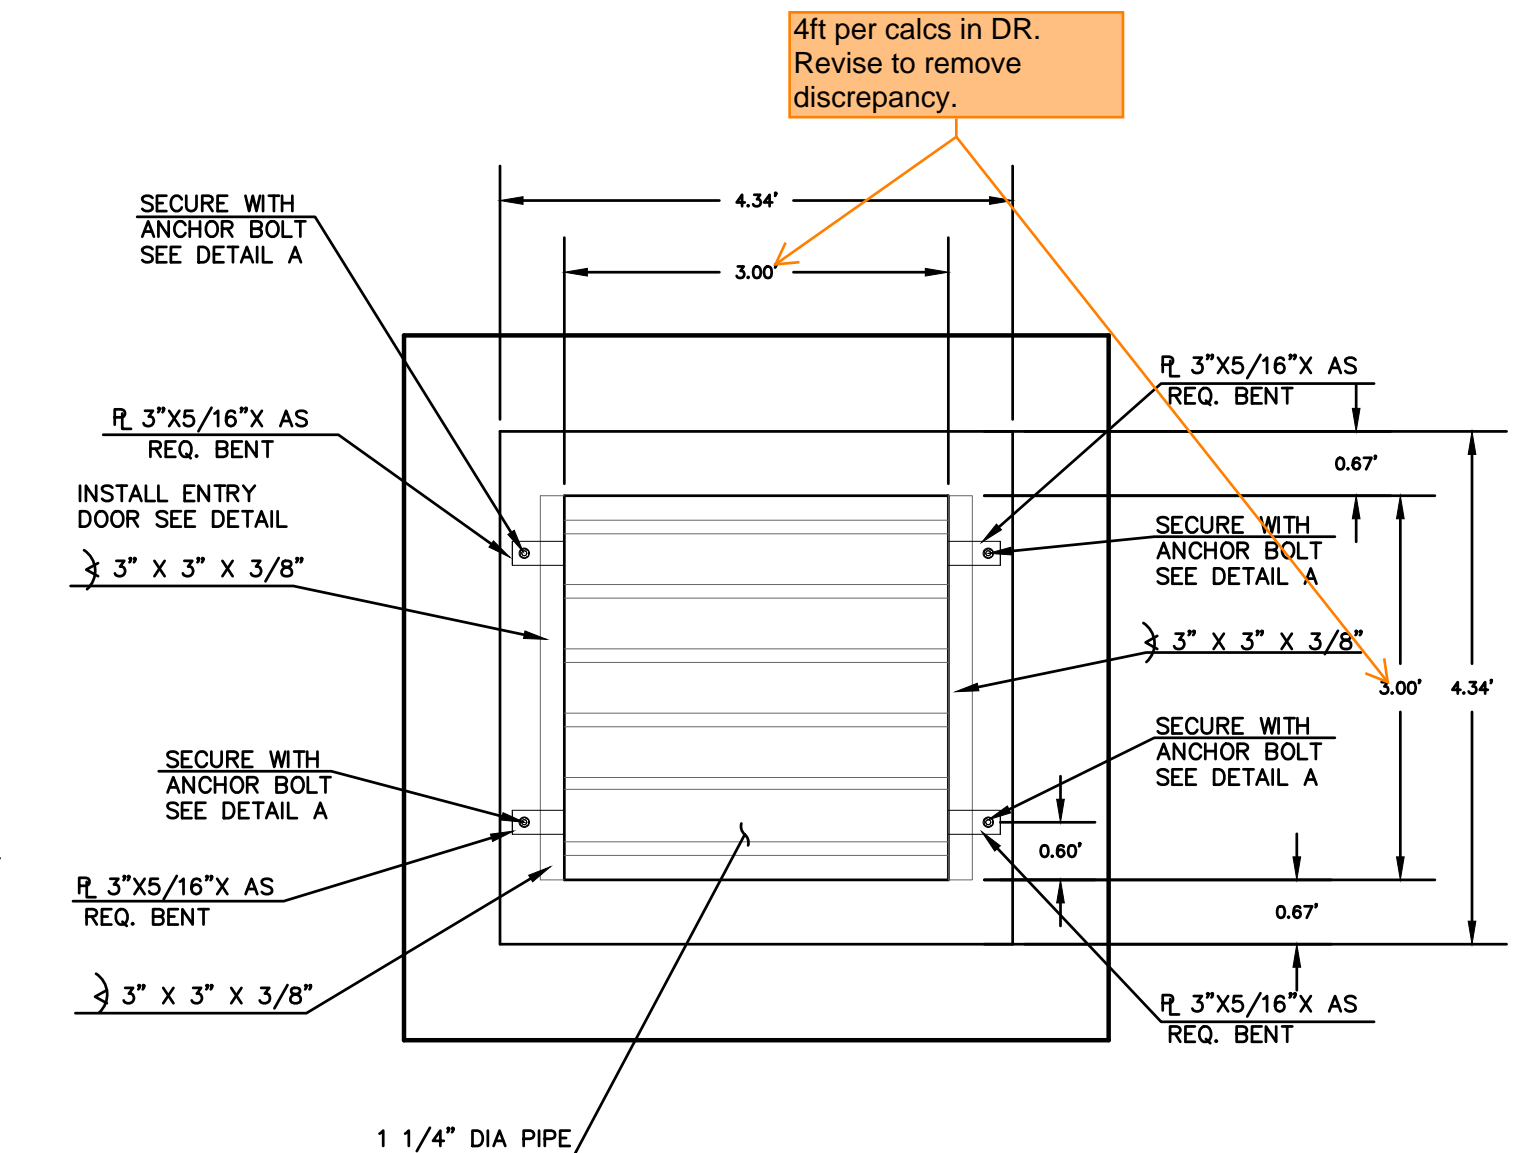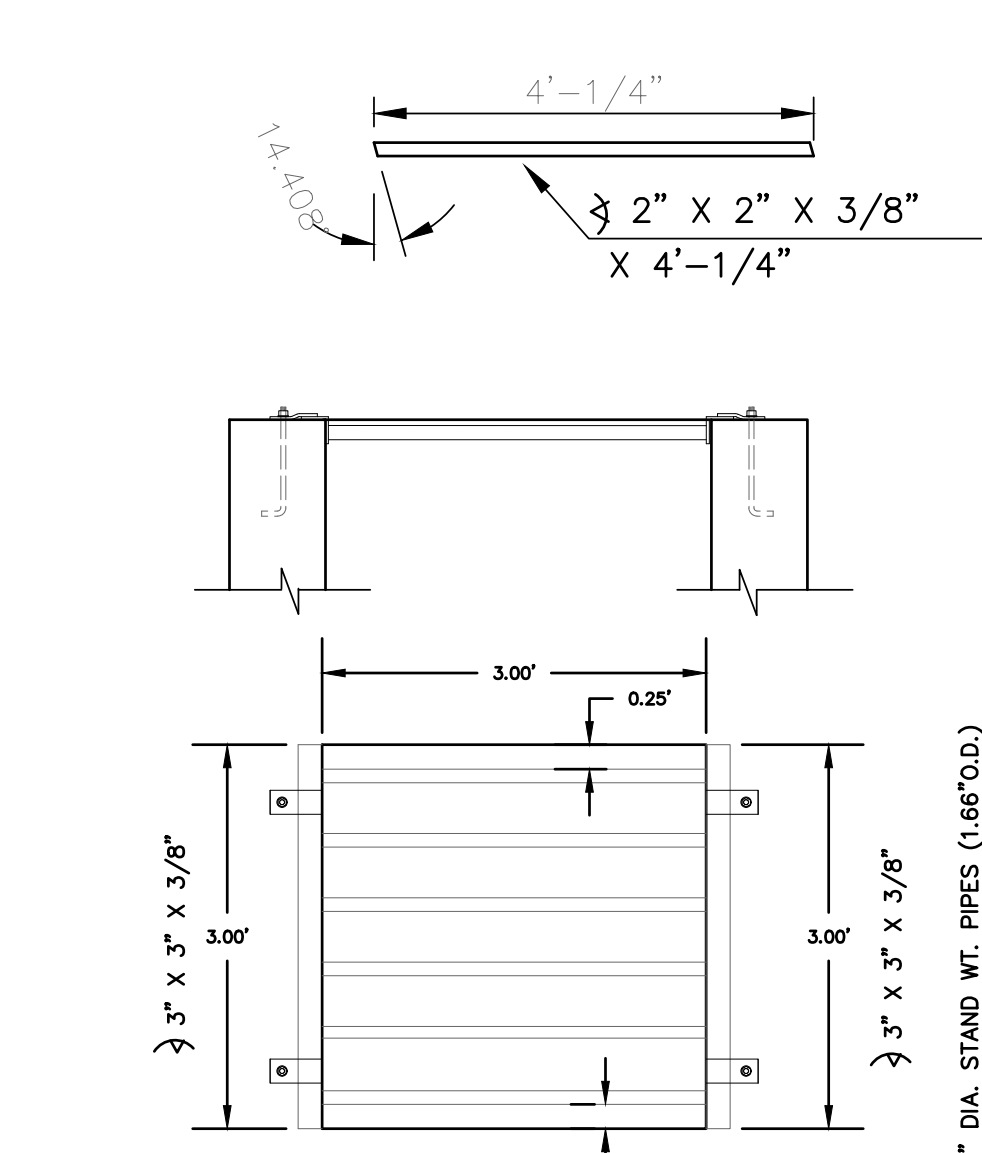

**GRATE CONSTRUCTION**  
 ALL WELDED CONSTRUCTION  
 SCALE: 1"=2'

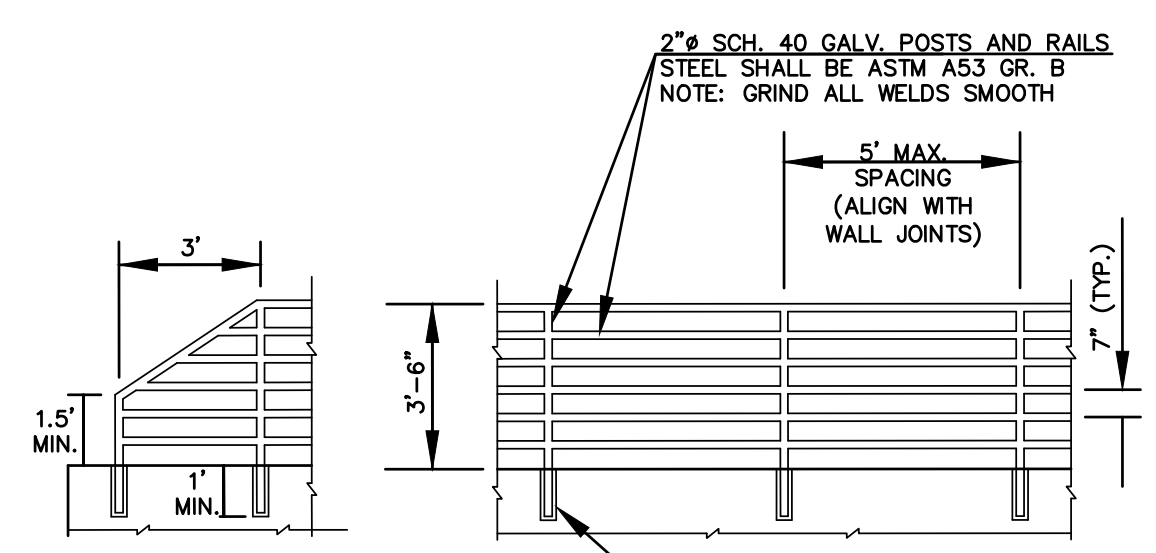

- NOTES:
1. WELD PLATES MAY BE SUBSTITUTED FOR PIPE EMBEDMENT. CONTRACTOR SHALL SUBMIT HANDRAIL SHOP DRAWINGS TO ENGINEER OF RECORD FOR APPROVAL PRIOR TO FABRICATION.
  2. DESIGN CRITERIA SHALL BE IN ACCORDANCE WITH AASHTO STANDARDS. HANDRAIL DESIGN SHALL BE COMPATIBLE WITH THE DESIGN OF THE WINGWALLS AND HEADWALLS.
  3. RAILING POSTS SHALL BE SET TO NORMAL TO GRADE. RAILS SHALL RUN PARALLEL TO THE SLOPES OF TOPS OF THE WALLS.
  4. ALL RAILS SHALL HAVE EXPANSION JOINTS SPACED AT 40'-0" MAX. JOINT ENDS SHALL BE FREE OF ANY SHARP EDGES OR CORNERS.

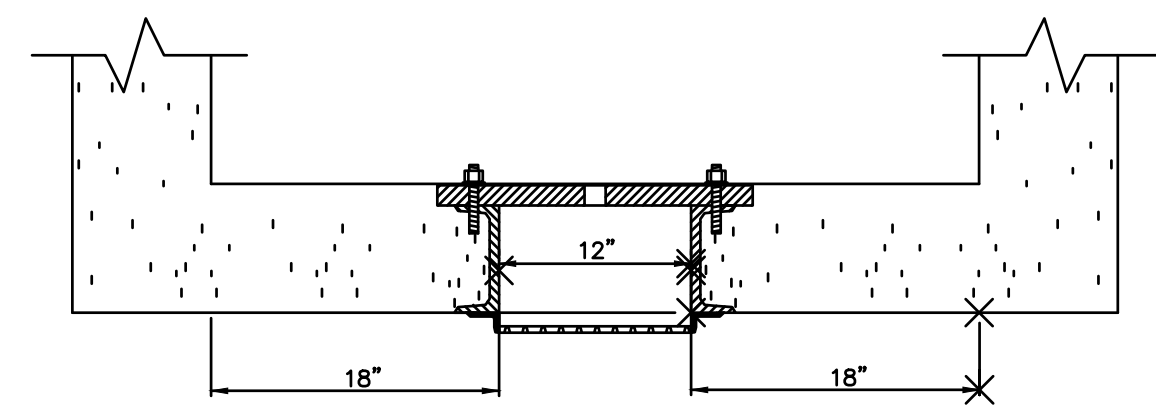

**SECTION B-B**  
 SCALE: 1"=1'

**STEEL FABRICATION NOTES:**

1. FABRICATED STEEL STRUCTURES SHALL BE CONSTRUCTED IN ACCORDANCE WITH AISC AND AWS SPECIFICATIONS.
2. THE OUTLET STRUCTURE BARGRATE IS DESIGNED FOR A VERTICAL LOAD OF 300 LBS./SQ. FT.
3. ALL STRUCTURAL STEEL SHAPES TO INCLUDE: ANGLE, PLATE, AND BAR SHALL MEET ASTM A36 SPECIFICATIONS, FY = 36 KSI MINIMUM. STRUCTURAL TUBING SHALL MEET ASTM A500 GRADE B SPECIFICATIONS, FY = 48 KSI MINIMUM. STEEL PIPE SHALL BE STANDARD WEIGHT PIPE ASTM A53 GRADE B, FY = 35 KSI MINIMUM.
4. WELDS NOT INDICATED SHALL BE 1/8" MINIMUM FILLET OR GROOVE, CONTINUOUS SO FAR AS POSSIBLE, CONSIDER VANDALISM LOADS, WELD ACCORDINGLY AT CRITICAL LOCATIONS.
5. PRIOR TO PAINTING REMOVE ALL OIL, SCALE, AND SLAG, GRIND OFF BURRS AND SHARP EDGES.
6. PAINT WITH ONE SHOP COAT OF ZINC RICH PRIMER AND TWO COATS OF ALUMINUM PAINT, AASHTO M-69

Typical comment for all 3 ponds:  
 Include callout for pet waste station(s) around the pond, with signage stating that pet waste must be picked up.


4ft per calcs in DR. Revise to remove discrepancy.

Trash rack to be Amico Klemp KRP Series aluminum bar grate (Figure 6-b), US Filter or Johnson stainless steel well screen with #93 VEE wire (Figure 6-a), or equivalent (per EPC DCMV2, Chap 4.3 and MHFD Detail T-12).  
 Diamond plate trash racks are not an equivalent replacement to those in our criteria. We have concerns that the diamond plate is going to be a constant maintenance issue with clogging. Diamond plates may have the same percent open area as those shown in our criteria but this isn't the only criteria that decides equivalency with the ones specified in our criteria. The well screen and bar grates in our criteria are designed to be maintenance friendly whereas the diamond plate will clog more often.

Typical comment for all 3 ponds:  
 Wellscreen and concrete channel between wellscreens and orifice plate should extend down to the bottom of the micropool per MHFD Detail T-5, page EDB-5.


does not match what is shown in calcs in DR.

Does not match detail below or what is shown in DR calcs. Revise to remove discrepancy.

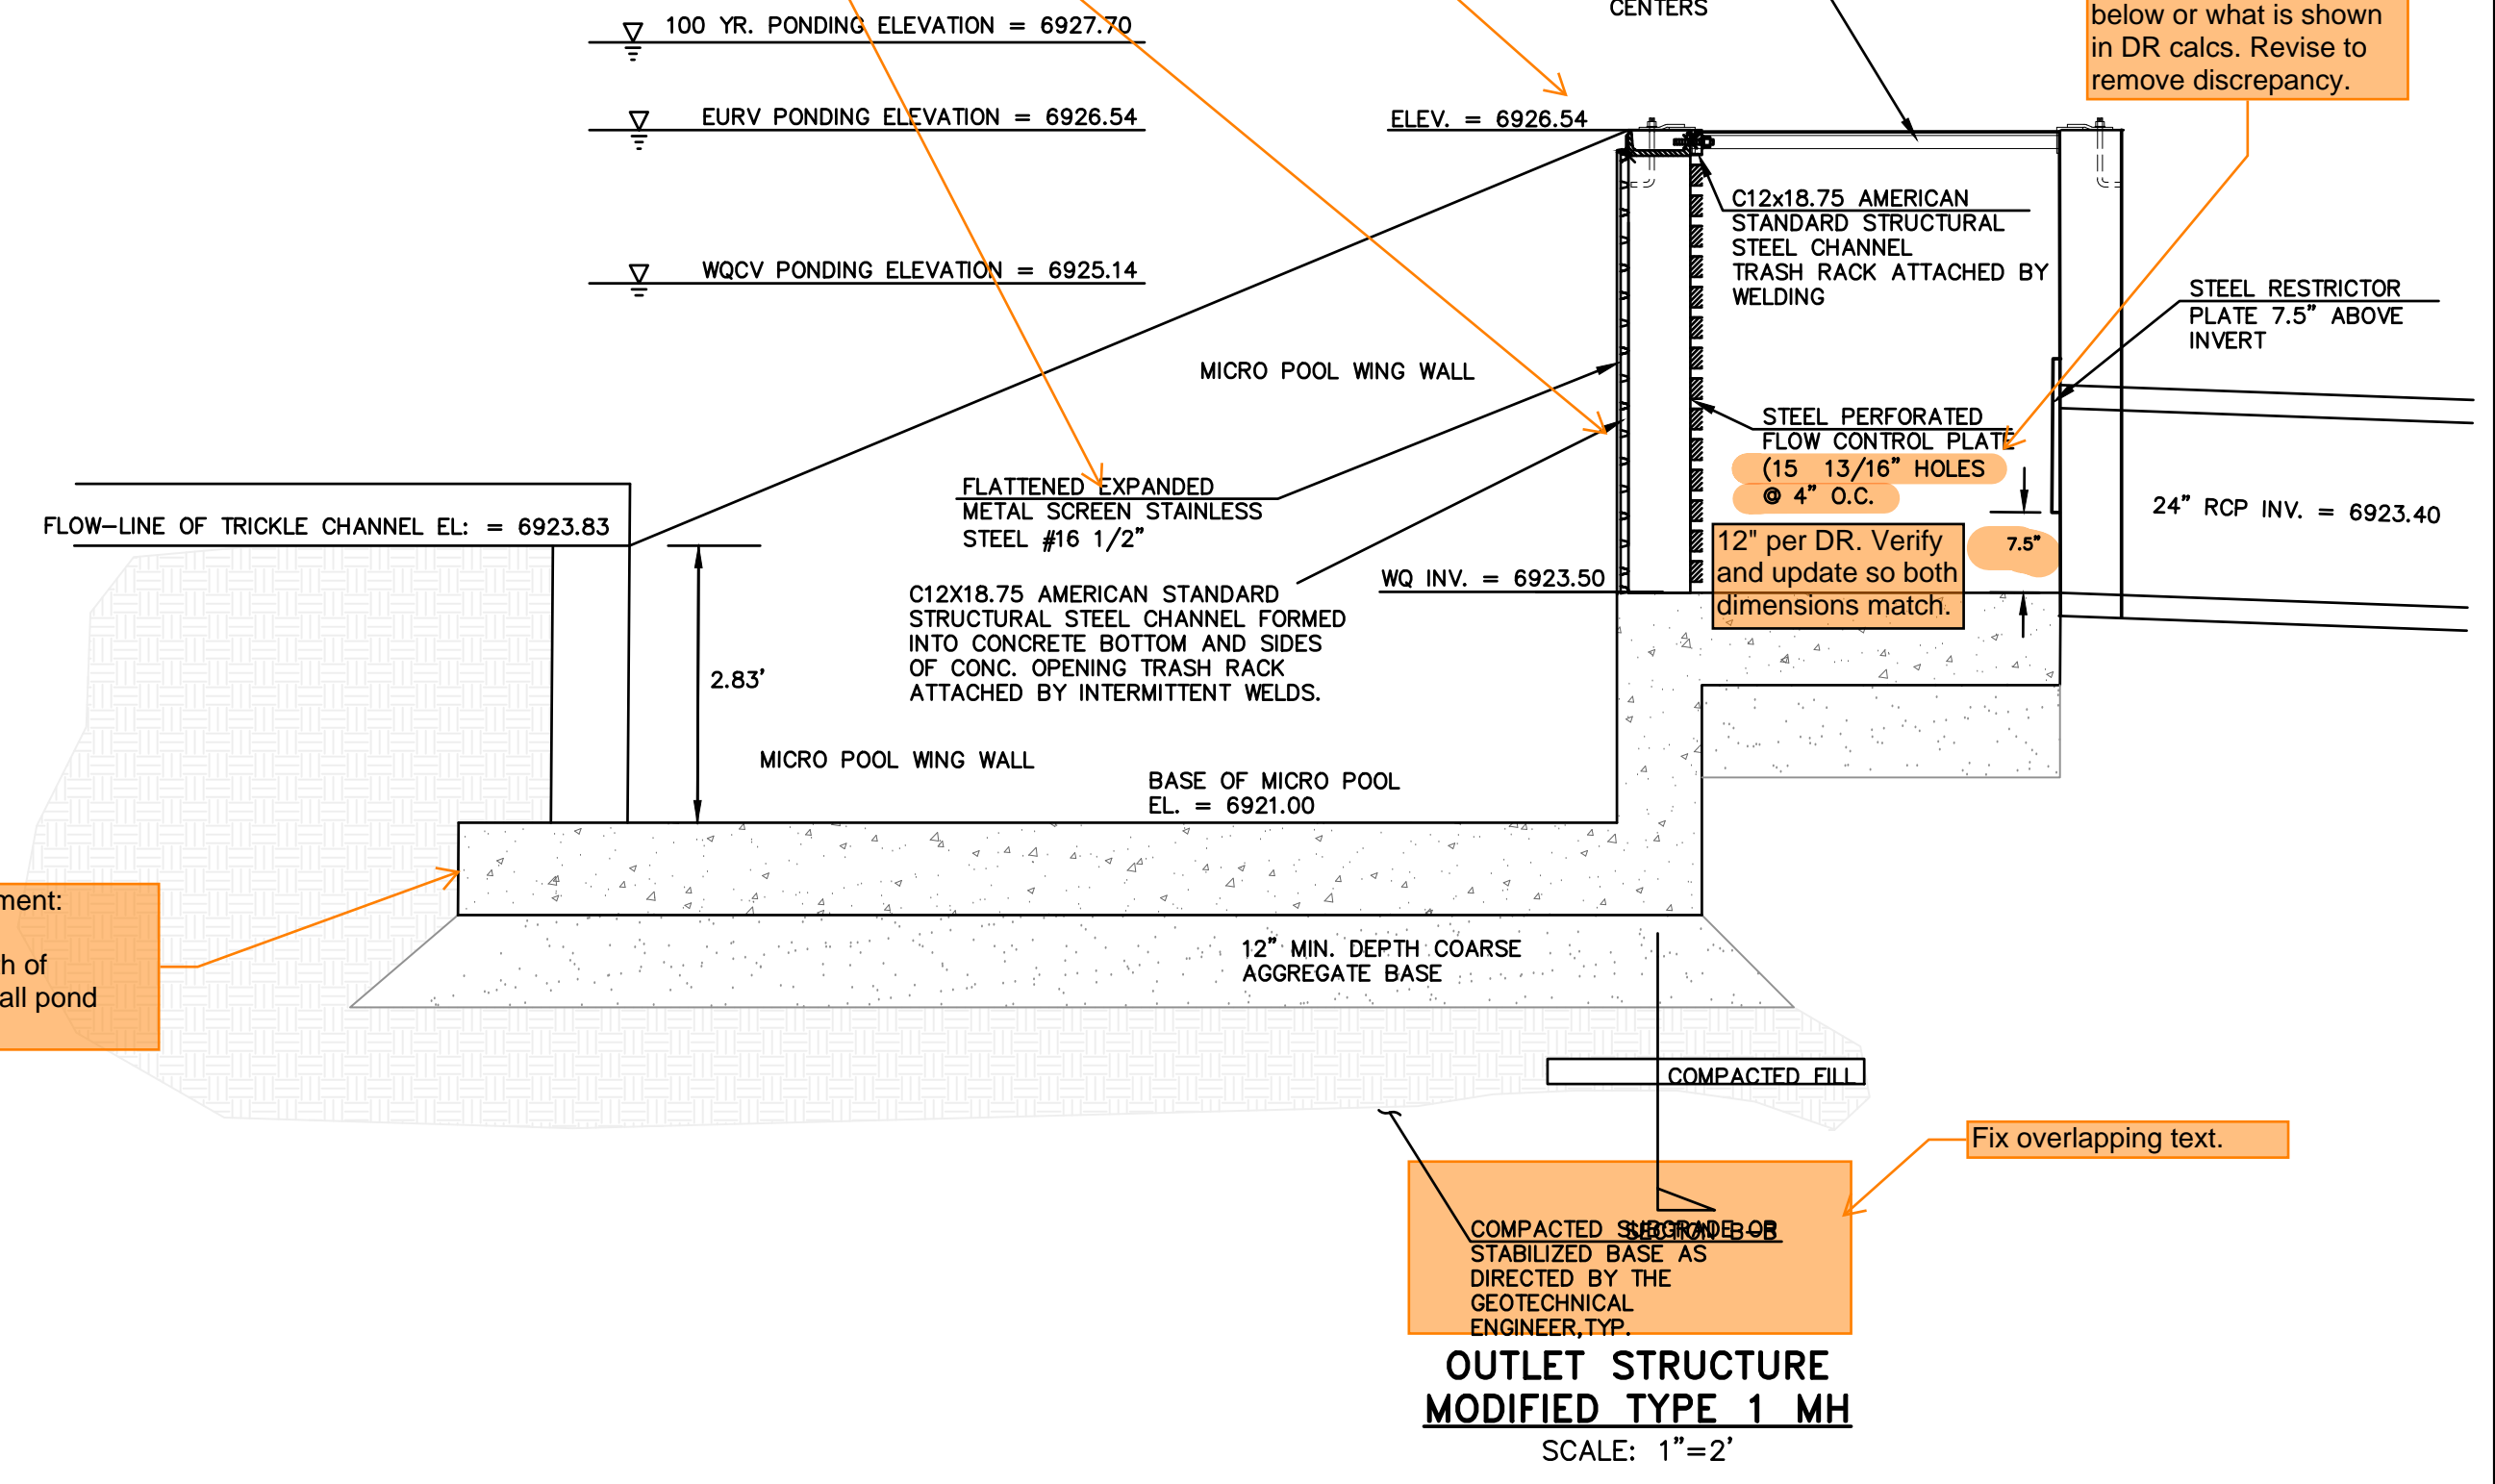


Typical comment:  
 Provide depth of concrete for all pond structures.

**OUTLET STRUCTURE MODIFIED TYPE 1 MH**  
 SCALE: 1"=2'

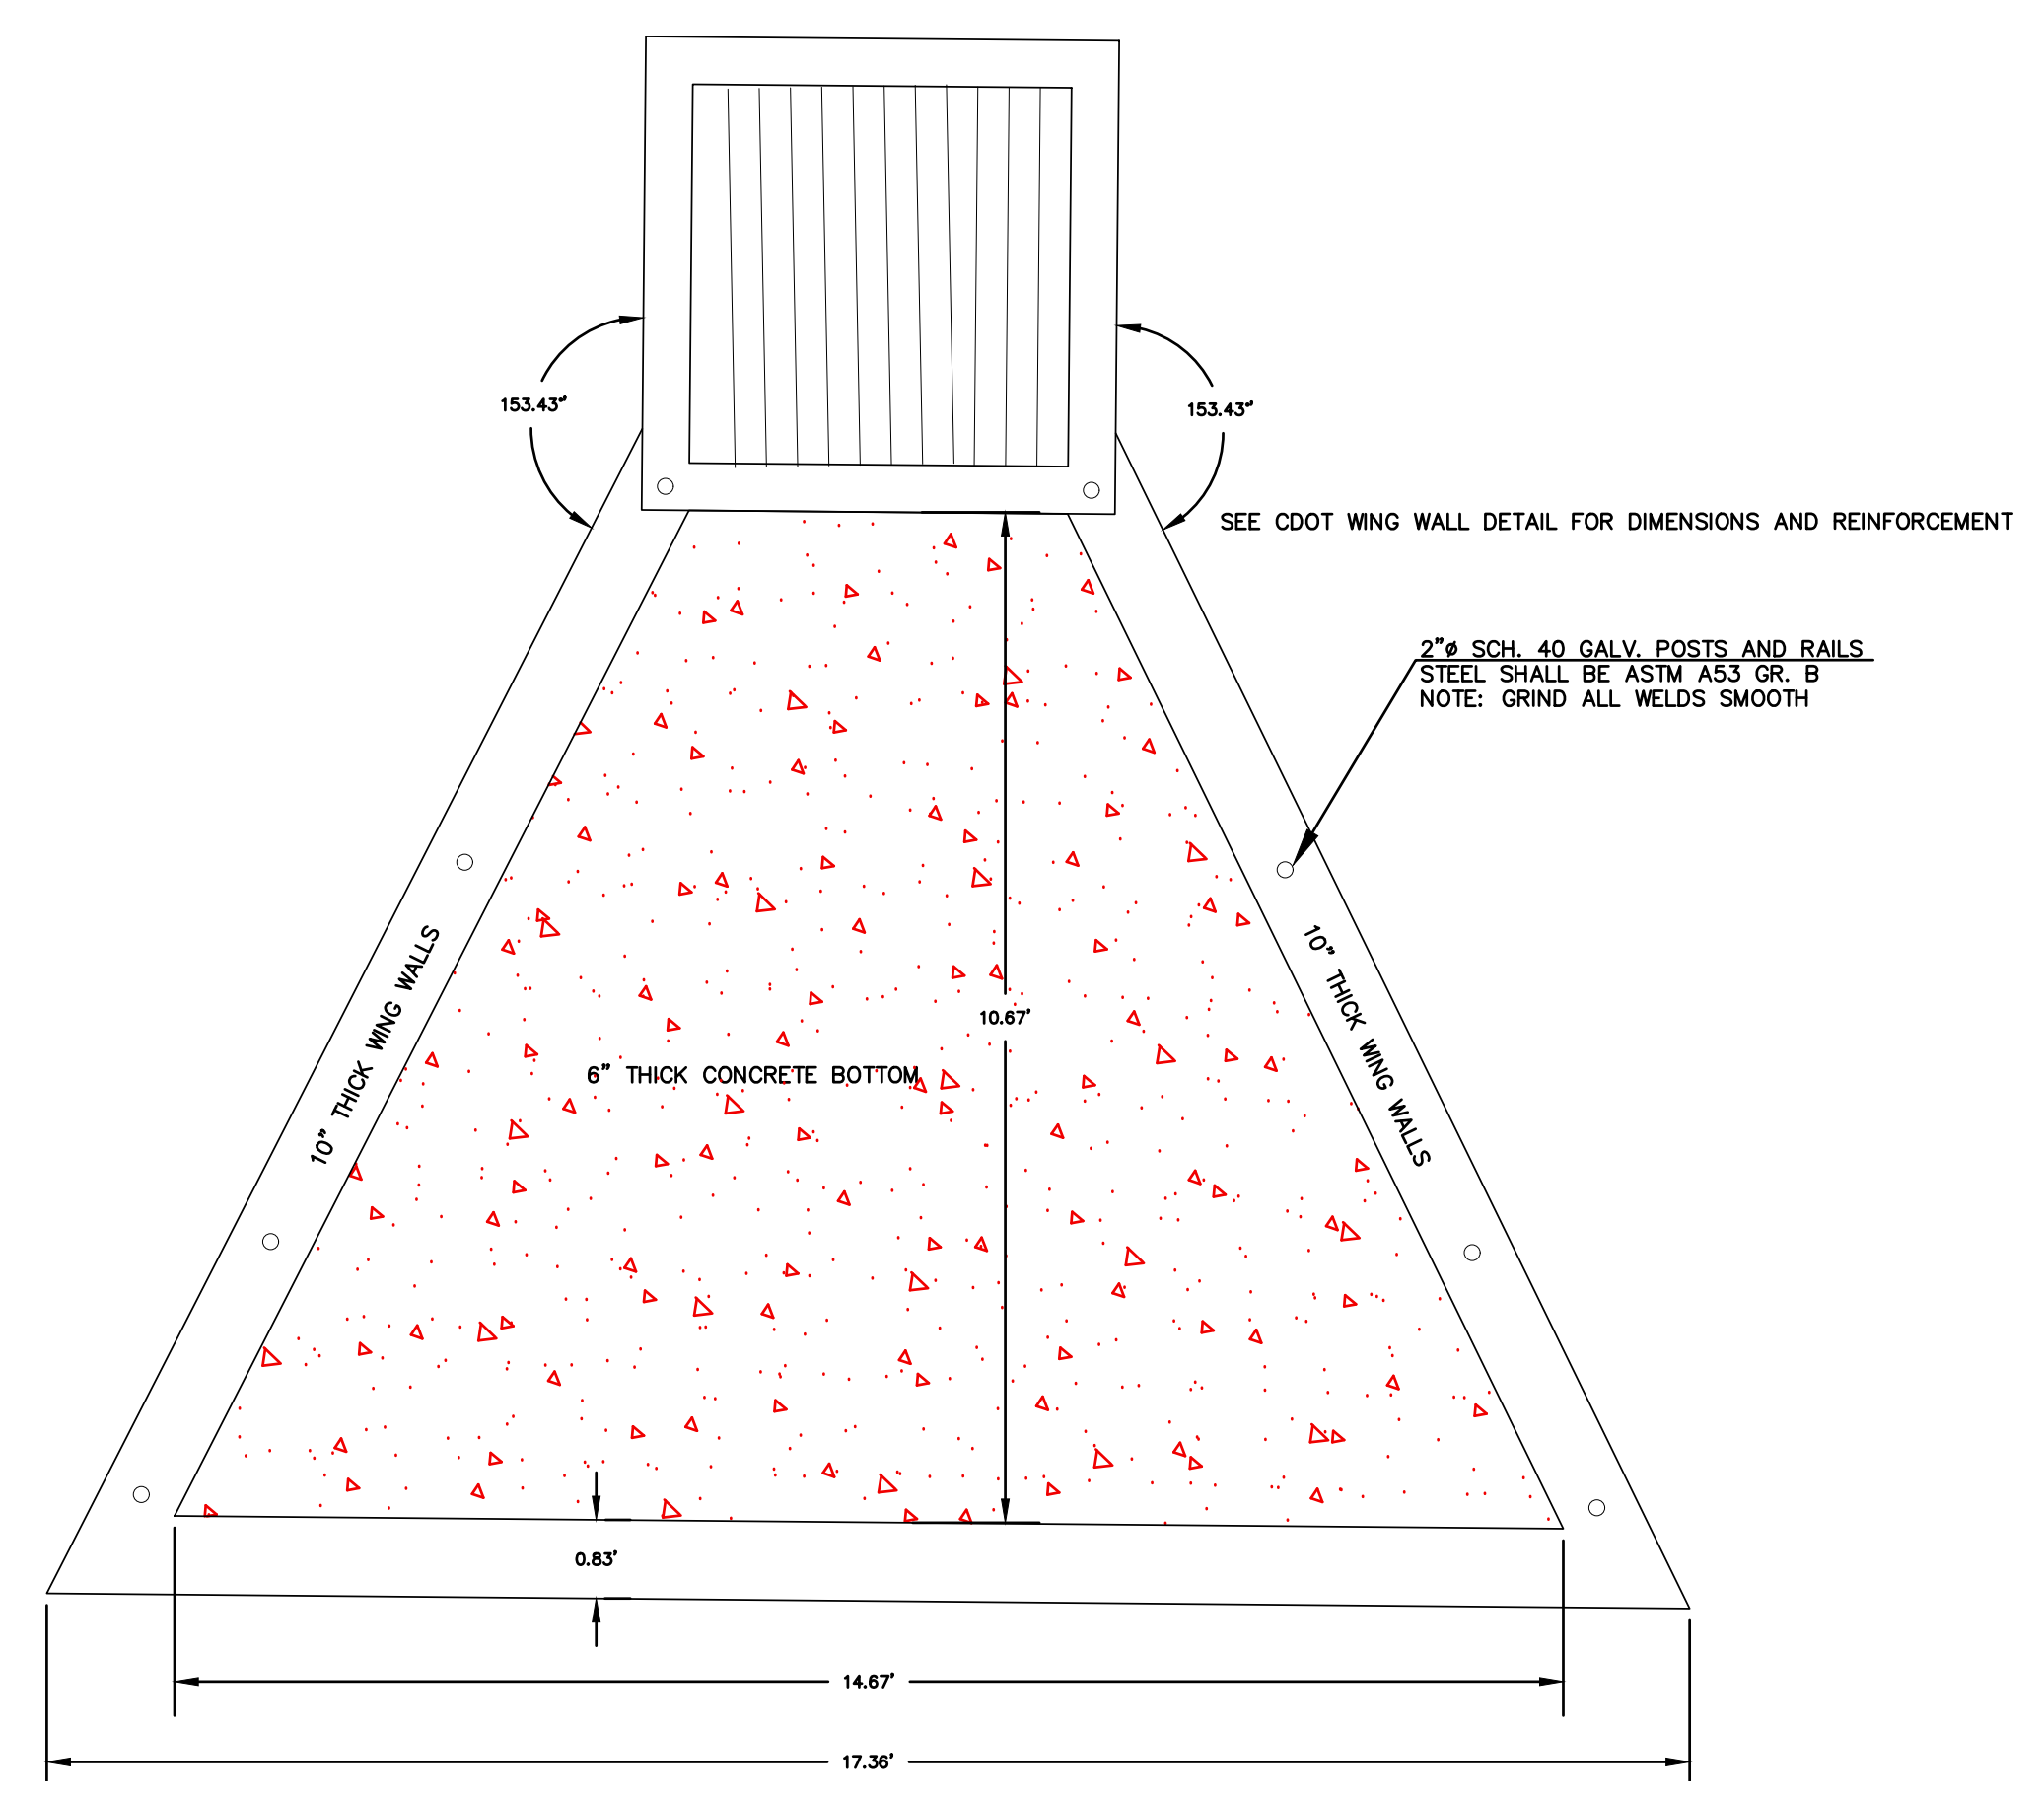

**CONCRETE MICROPOOL**  
 SCALE: 1"=2'

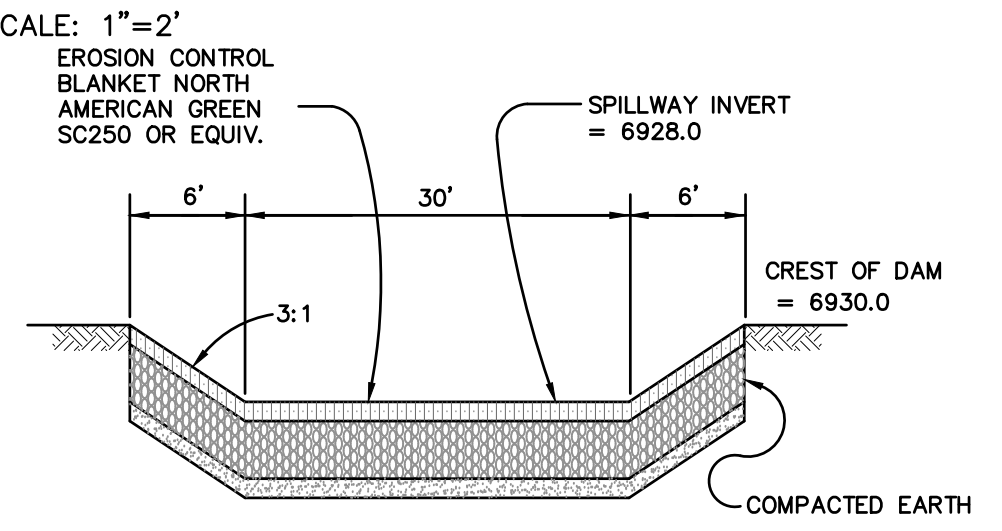

**EMERGENCY SPILLWAY CROSS SECTION**  
 SCALE: N.T.S.


Typical comment for all 3 ponds:  
 Provide maintenance access road detail/cross section, including stone sizing and gradation. Show cross slope at 2%.  
 Stabilized access ramp shall be a minimum of 15ft wide and no greater than 12% slope, in accordance with DCMV1, Chap 11.2.2.  
 Consider using a base course that will minimize migration of fines when the pond is detaining water.

Callout each individual orifice, so it is clear.


The orifice diameter does not match the DR. Verify and update so both plans and spreadsheet match.

Is this an orifice? The orifice hole center is at the invert - this would not be possible to construct the full orifice hole as the bottom half is lower than the structural steel plate.

Typical comment for similar details on all 3 ponds:  
 Pond bottom should have a minimum slope of 3% to the trickle channel and micropool (USDCM Vol 3, detail T-5). Please adjust to minimize future maintenance needs.

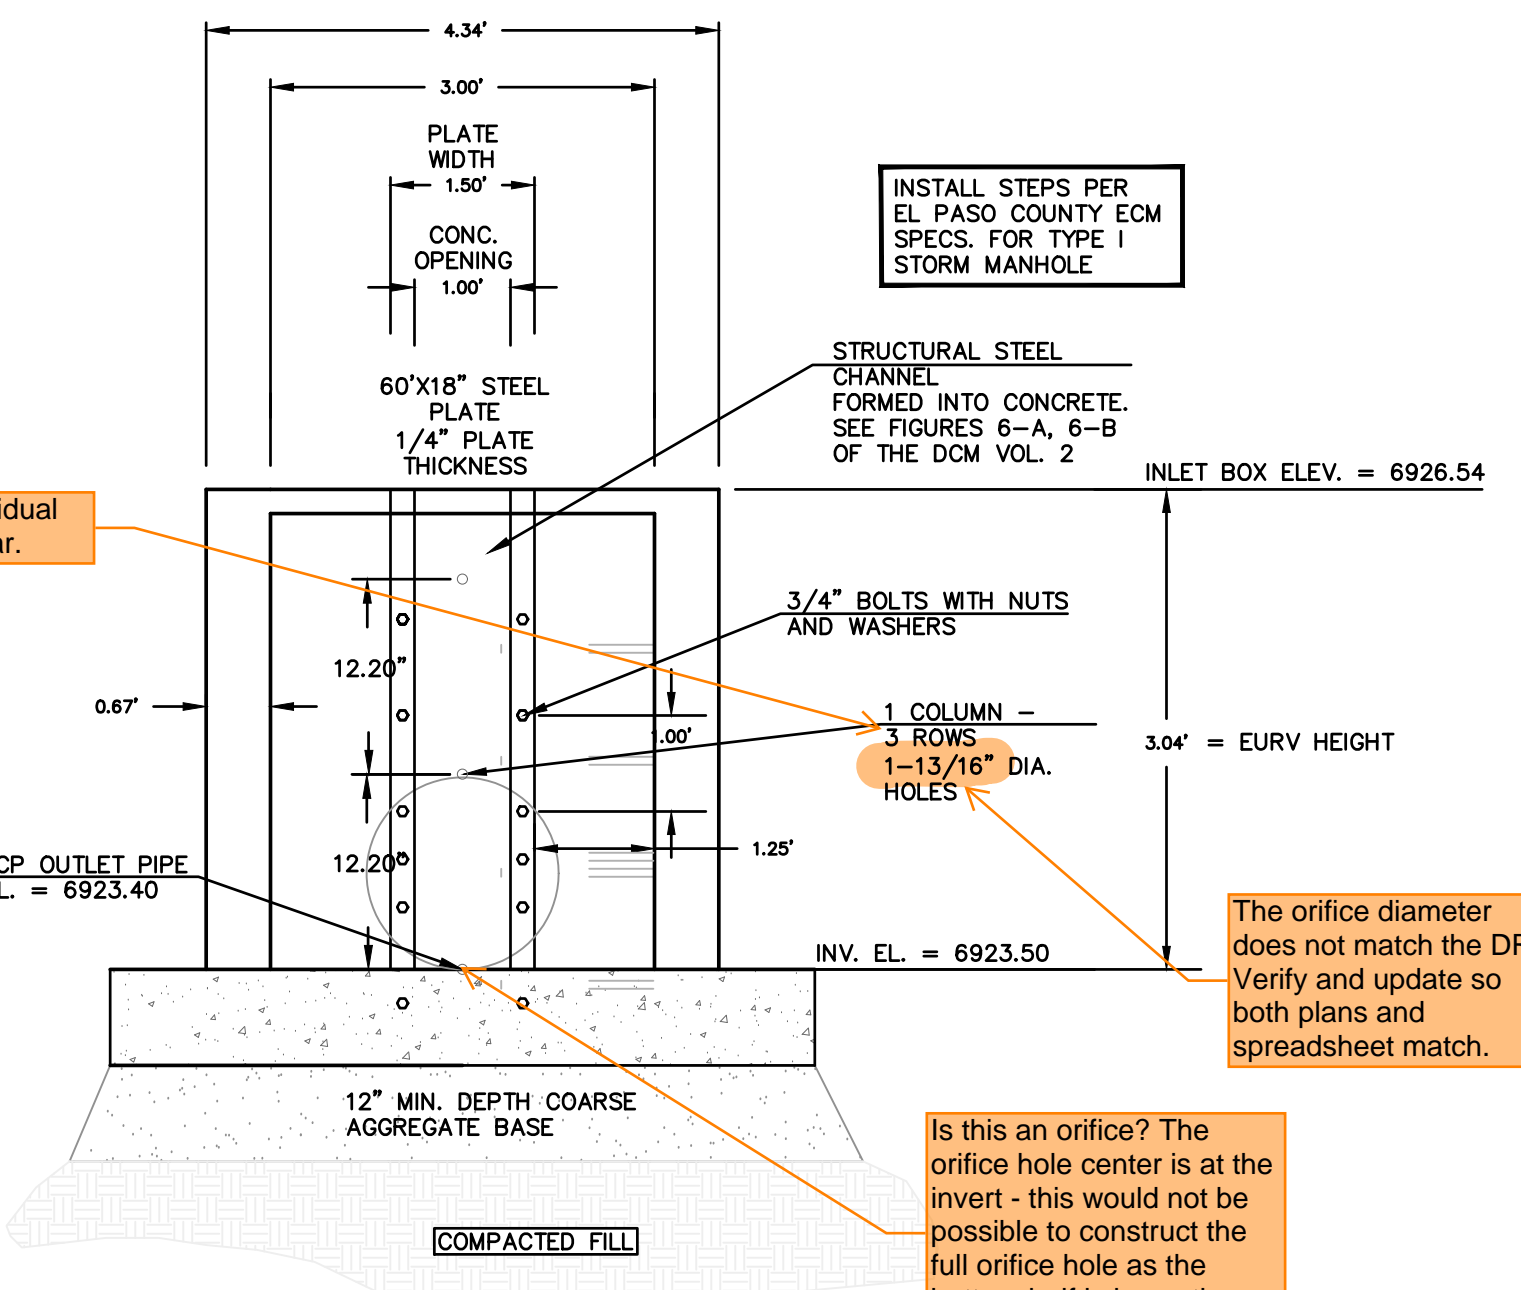


**OUTLET STRUCTURE MODIFIED TYPE 1 MH**  
 SCALE: 1"=2'

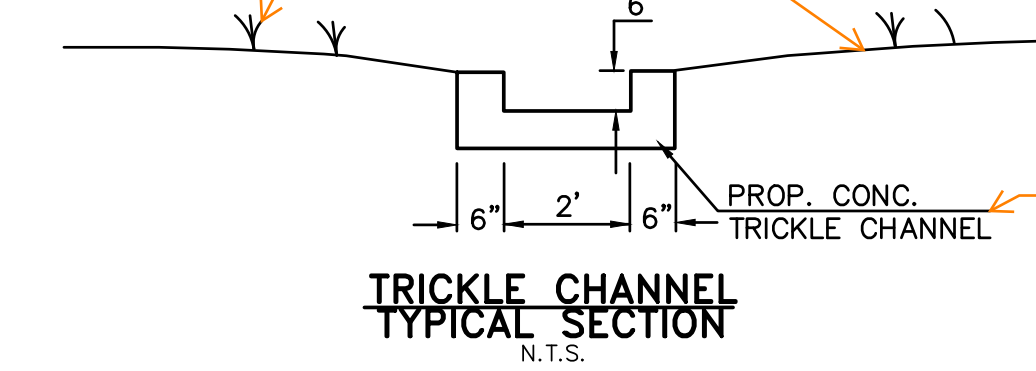


**TRICKLE CHANNEL TYPICAL SECTION**  
 N.T.S.

Typical comment for similar details on all 3 ponds:  
 Consider having control joints every ~10ft.  
 Per MHFD Detail T-5, a longitudinal slope between 0.4-1% is recommended to encourage settling while reducing the potential for low points.


DATE	
DESCRIPTION	
REVISIONS	
NO.	
UNTIL SUCH TIME AS THESE DRAWINGS ARE APPROVED BY THE ENGINEER OF RECORD, TERRA NOVA ENGINEERING, INC. APPROVES THEIR USE ONLY FOR THE PROJECT AND FOR THE PURPOSES AUTHORIZED BY WRITTEN AUTHORIZATION.	
PREPARED FOR:	4-WAY RANCH JOINT VENTURE
ATTN:	PETER MARTZ
P.O. BOX	50223
COLORADO SPRINGS, CO	80949
	719-491-3150
721 S. 23RD STREET, COLORADO SPRINGS, CO 80904	
OFFICE: 719-635-6442	
FAX: 719-635-6426	
www.tneshinc.com	
WATERBURY FILING NO. 1	CONSTRUCTION SET
	POND 1 DETAILS
DESIGNED BY	DLF
DRAWN BY	QNA
CHECKED BY	QNA
H-SCALE	N/A
V-SCALE	N/A
JOB NO.	1715.00
DATE ISSUED	2/6/23
SHEET NO.	36 OF 39

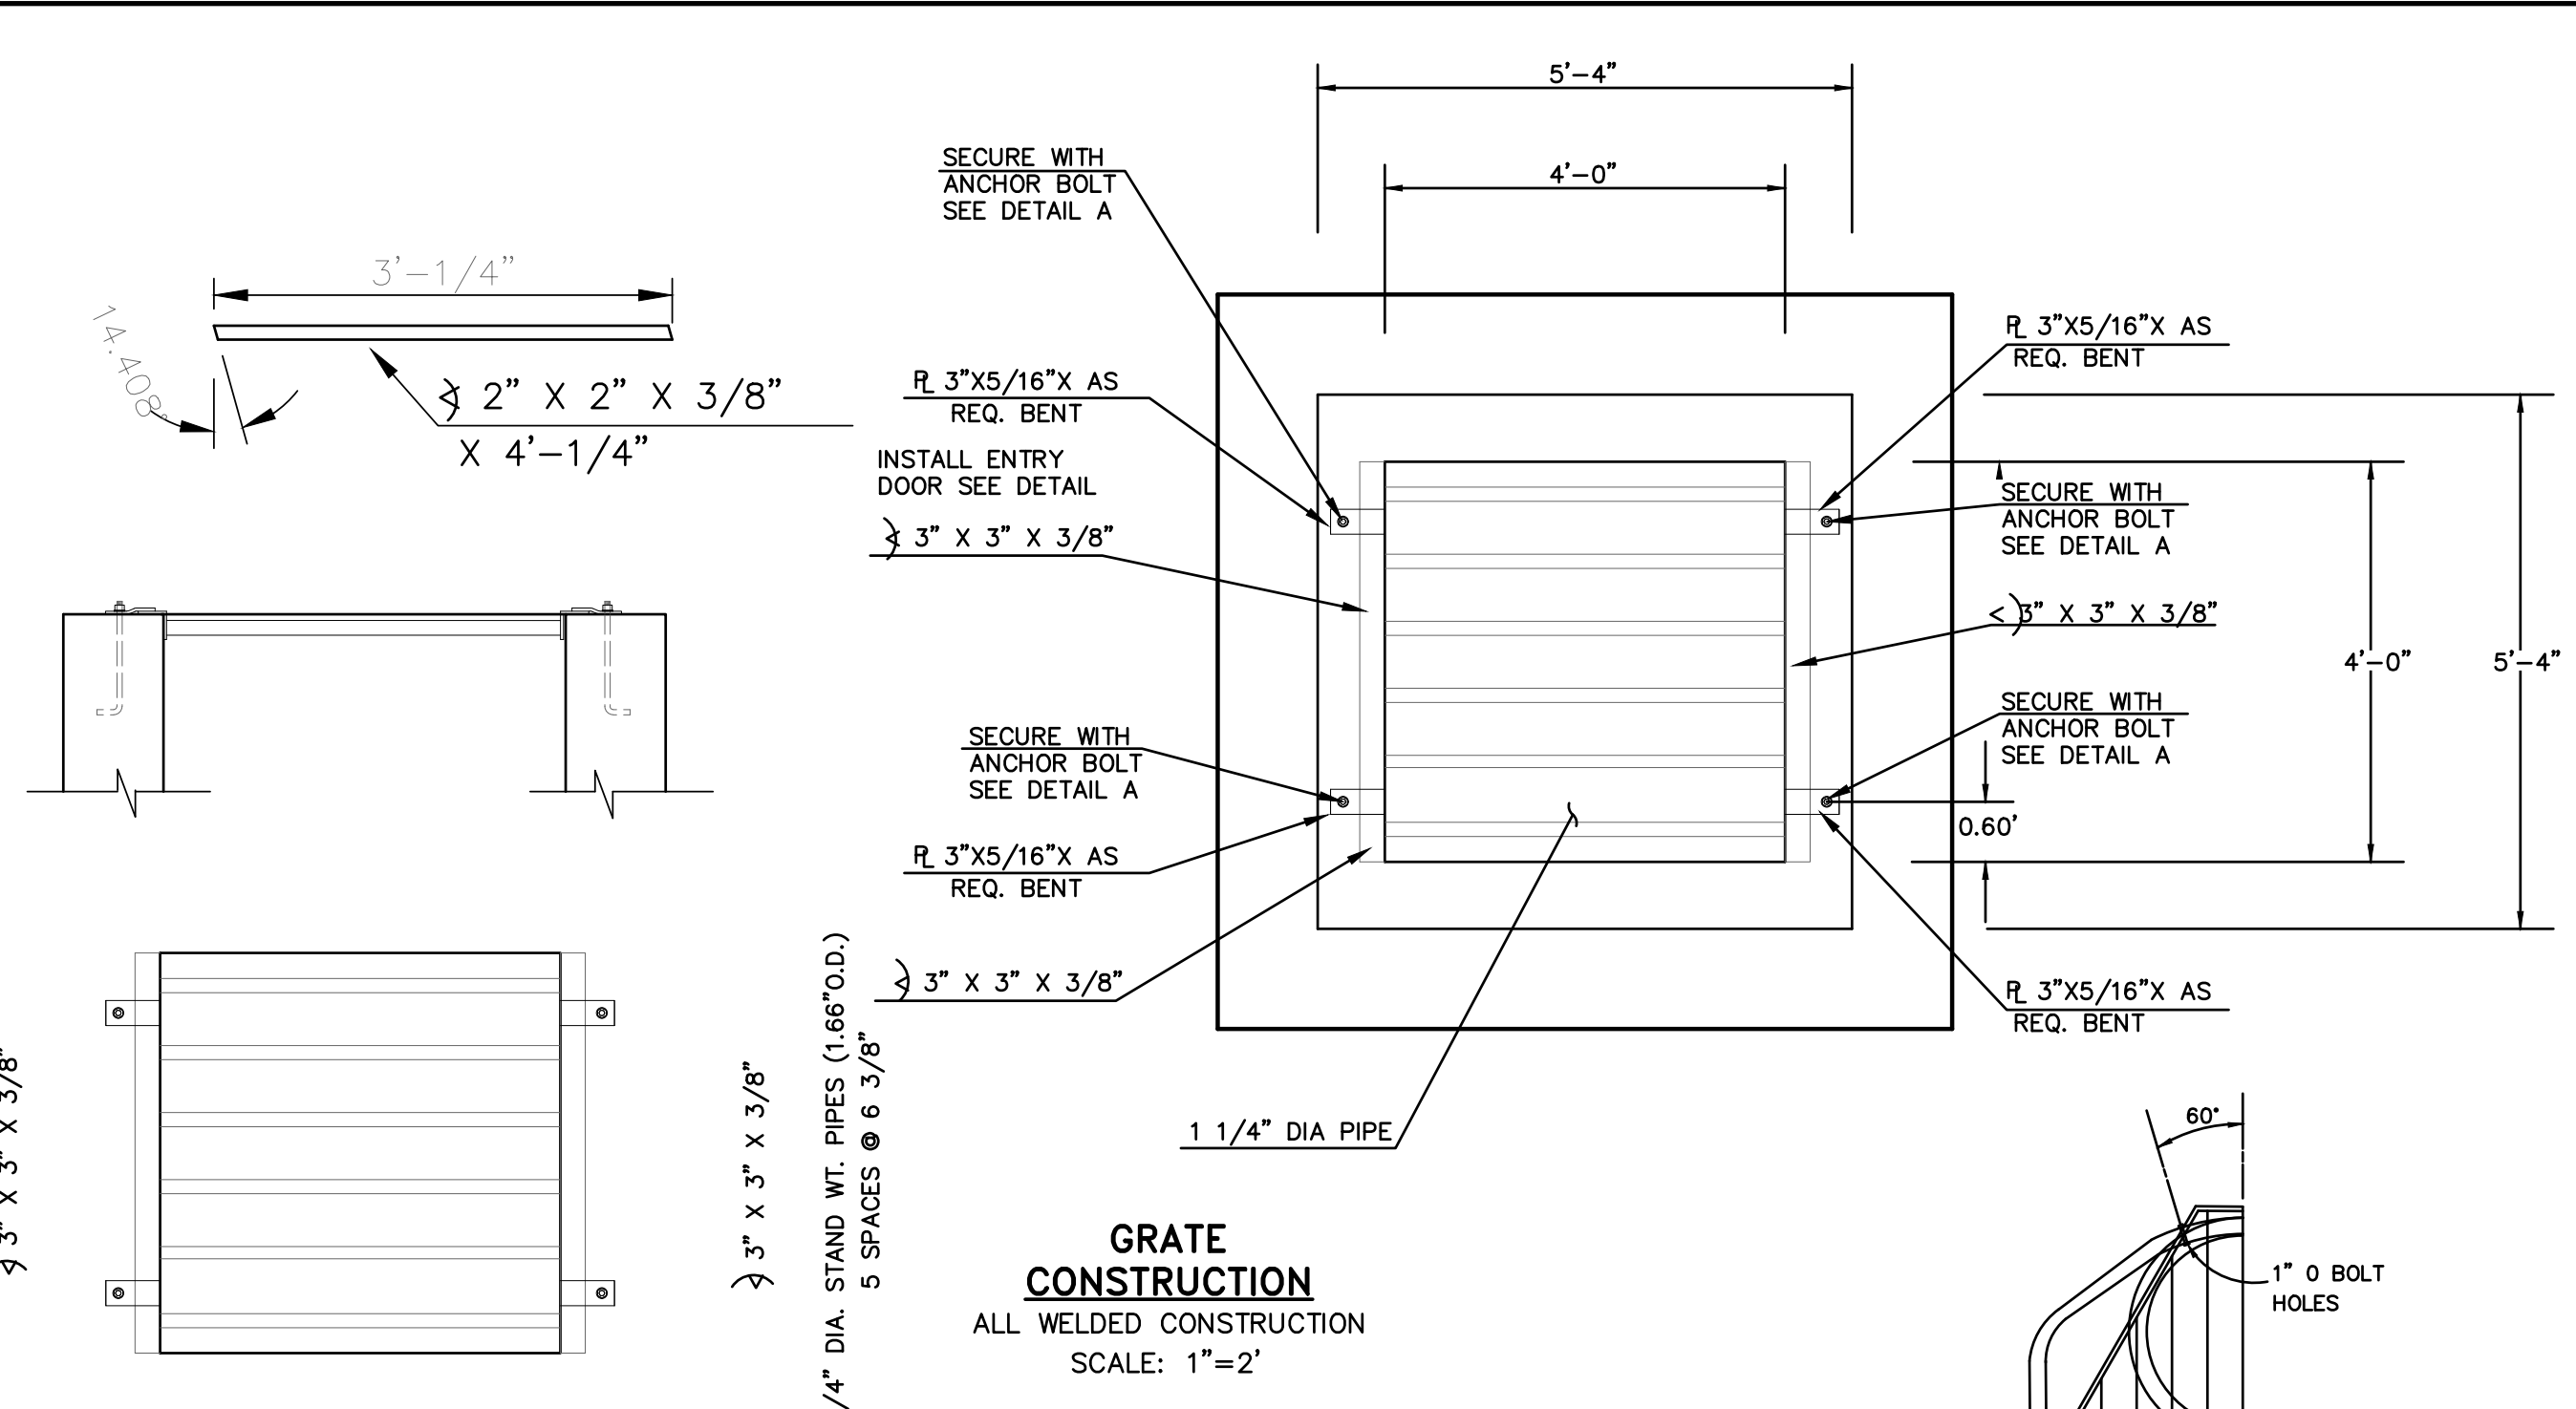


**GRATE CONSTRUCTION**  
ALL WELDED CONSTRUCTION  
SCALE: 1"=2'

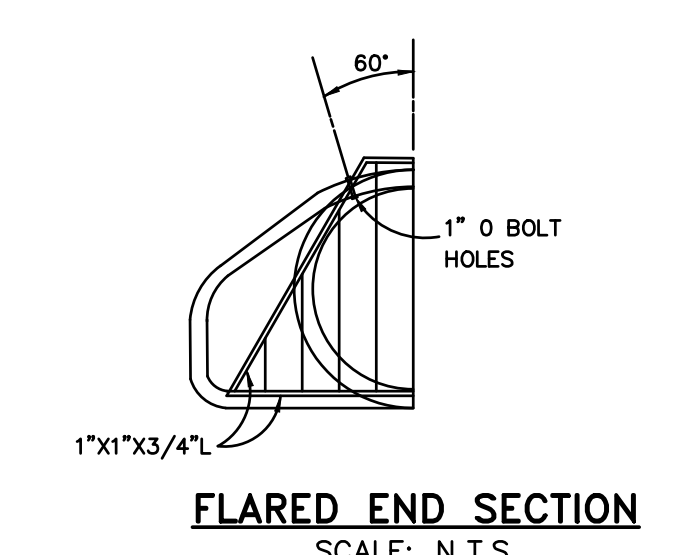


**FLARED END SECTION**  
SCALE: N.T.S.

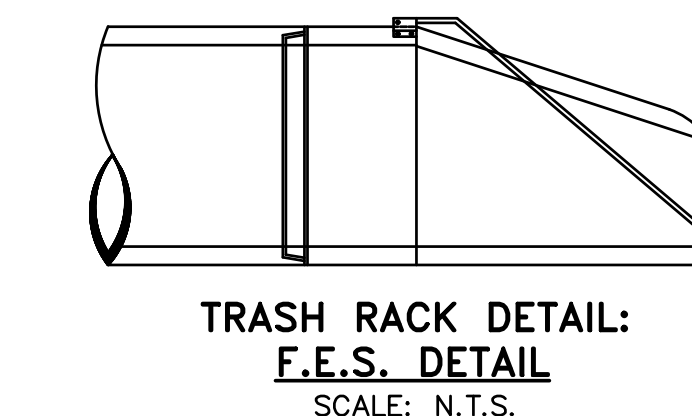


**TRASH RACK DETAIL: F.E.S. DETAIL**  
SCALE: N.T.S.

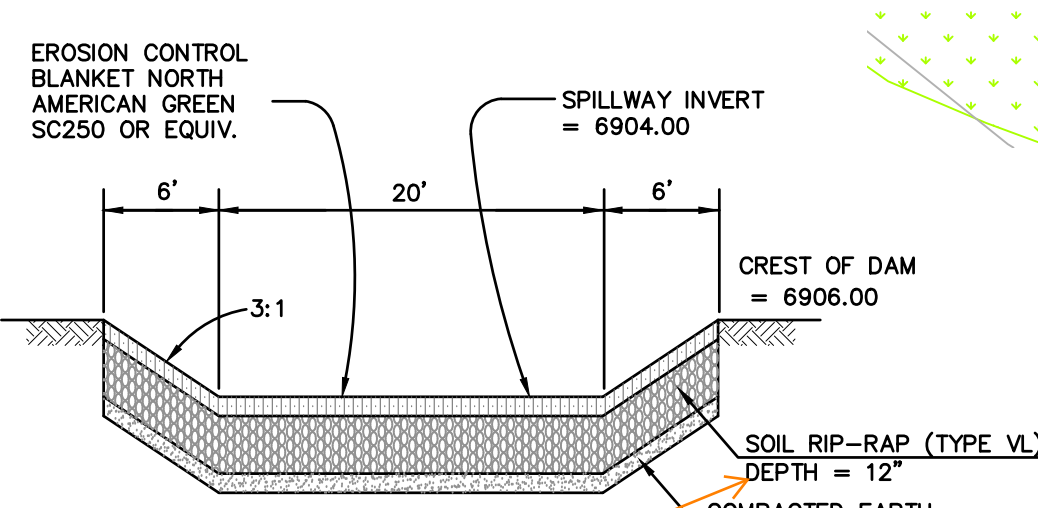


**EMERGENCY SPILLWAY CROSS SECTION**  
SCALE: N.T.S.

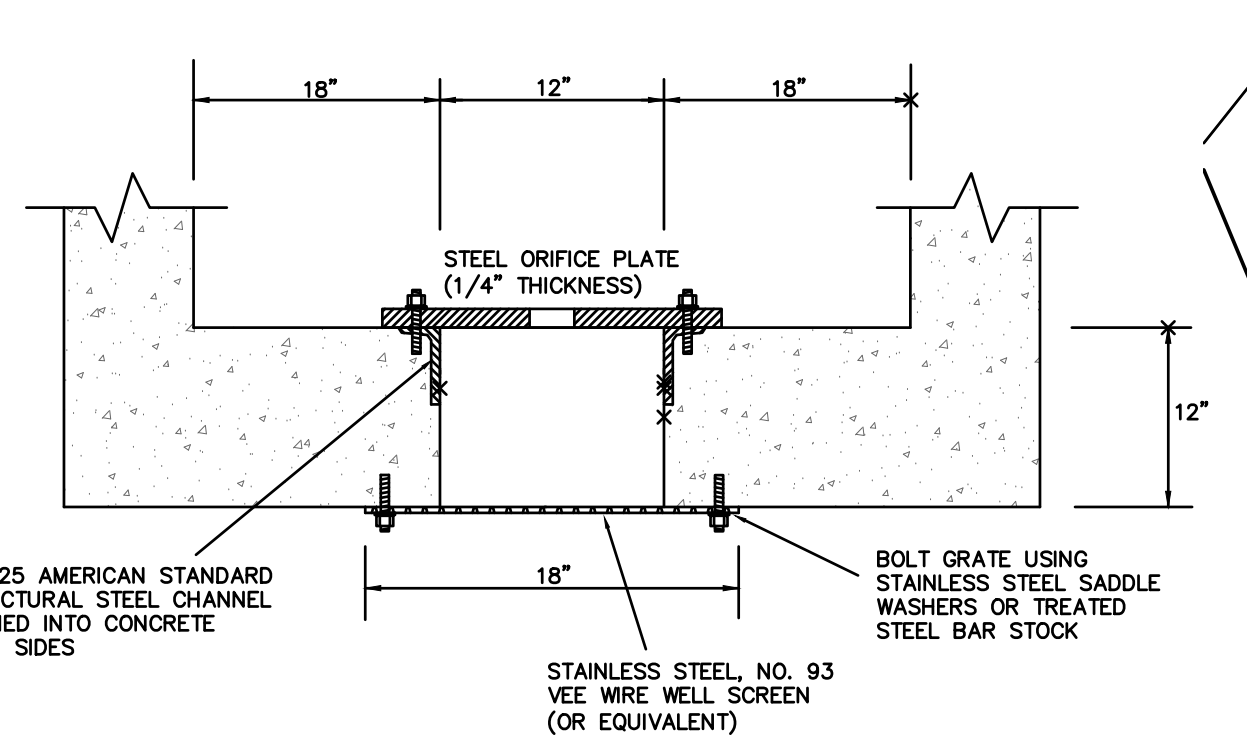


**CONCRETE OUTLET BOX DETAILS**  
SCALE: 1"=10'

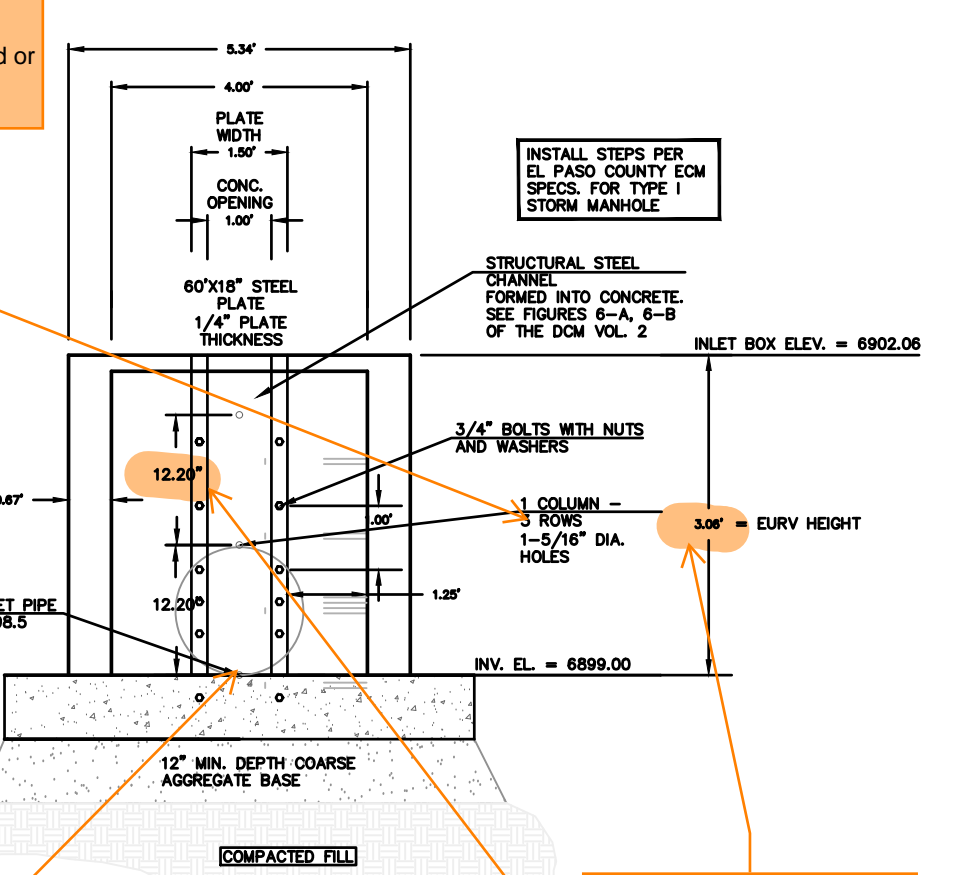

**PERMANENT FOREBAY DETAIL**  
SCALE: 1"=5'

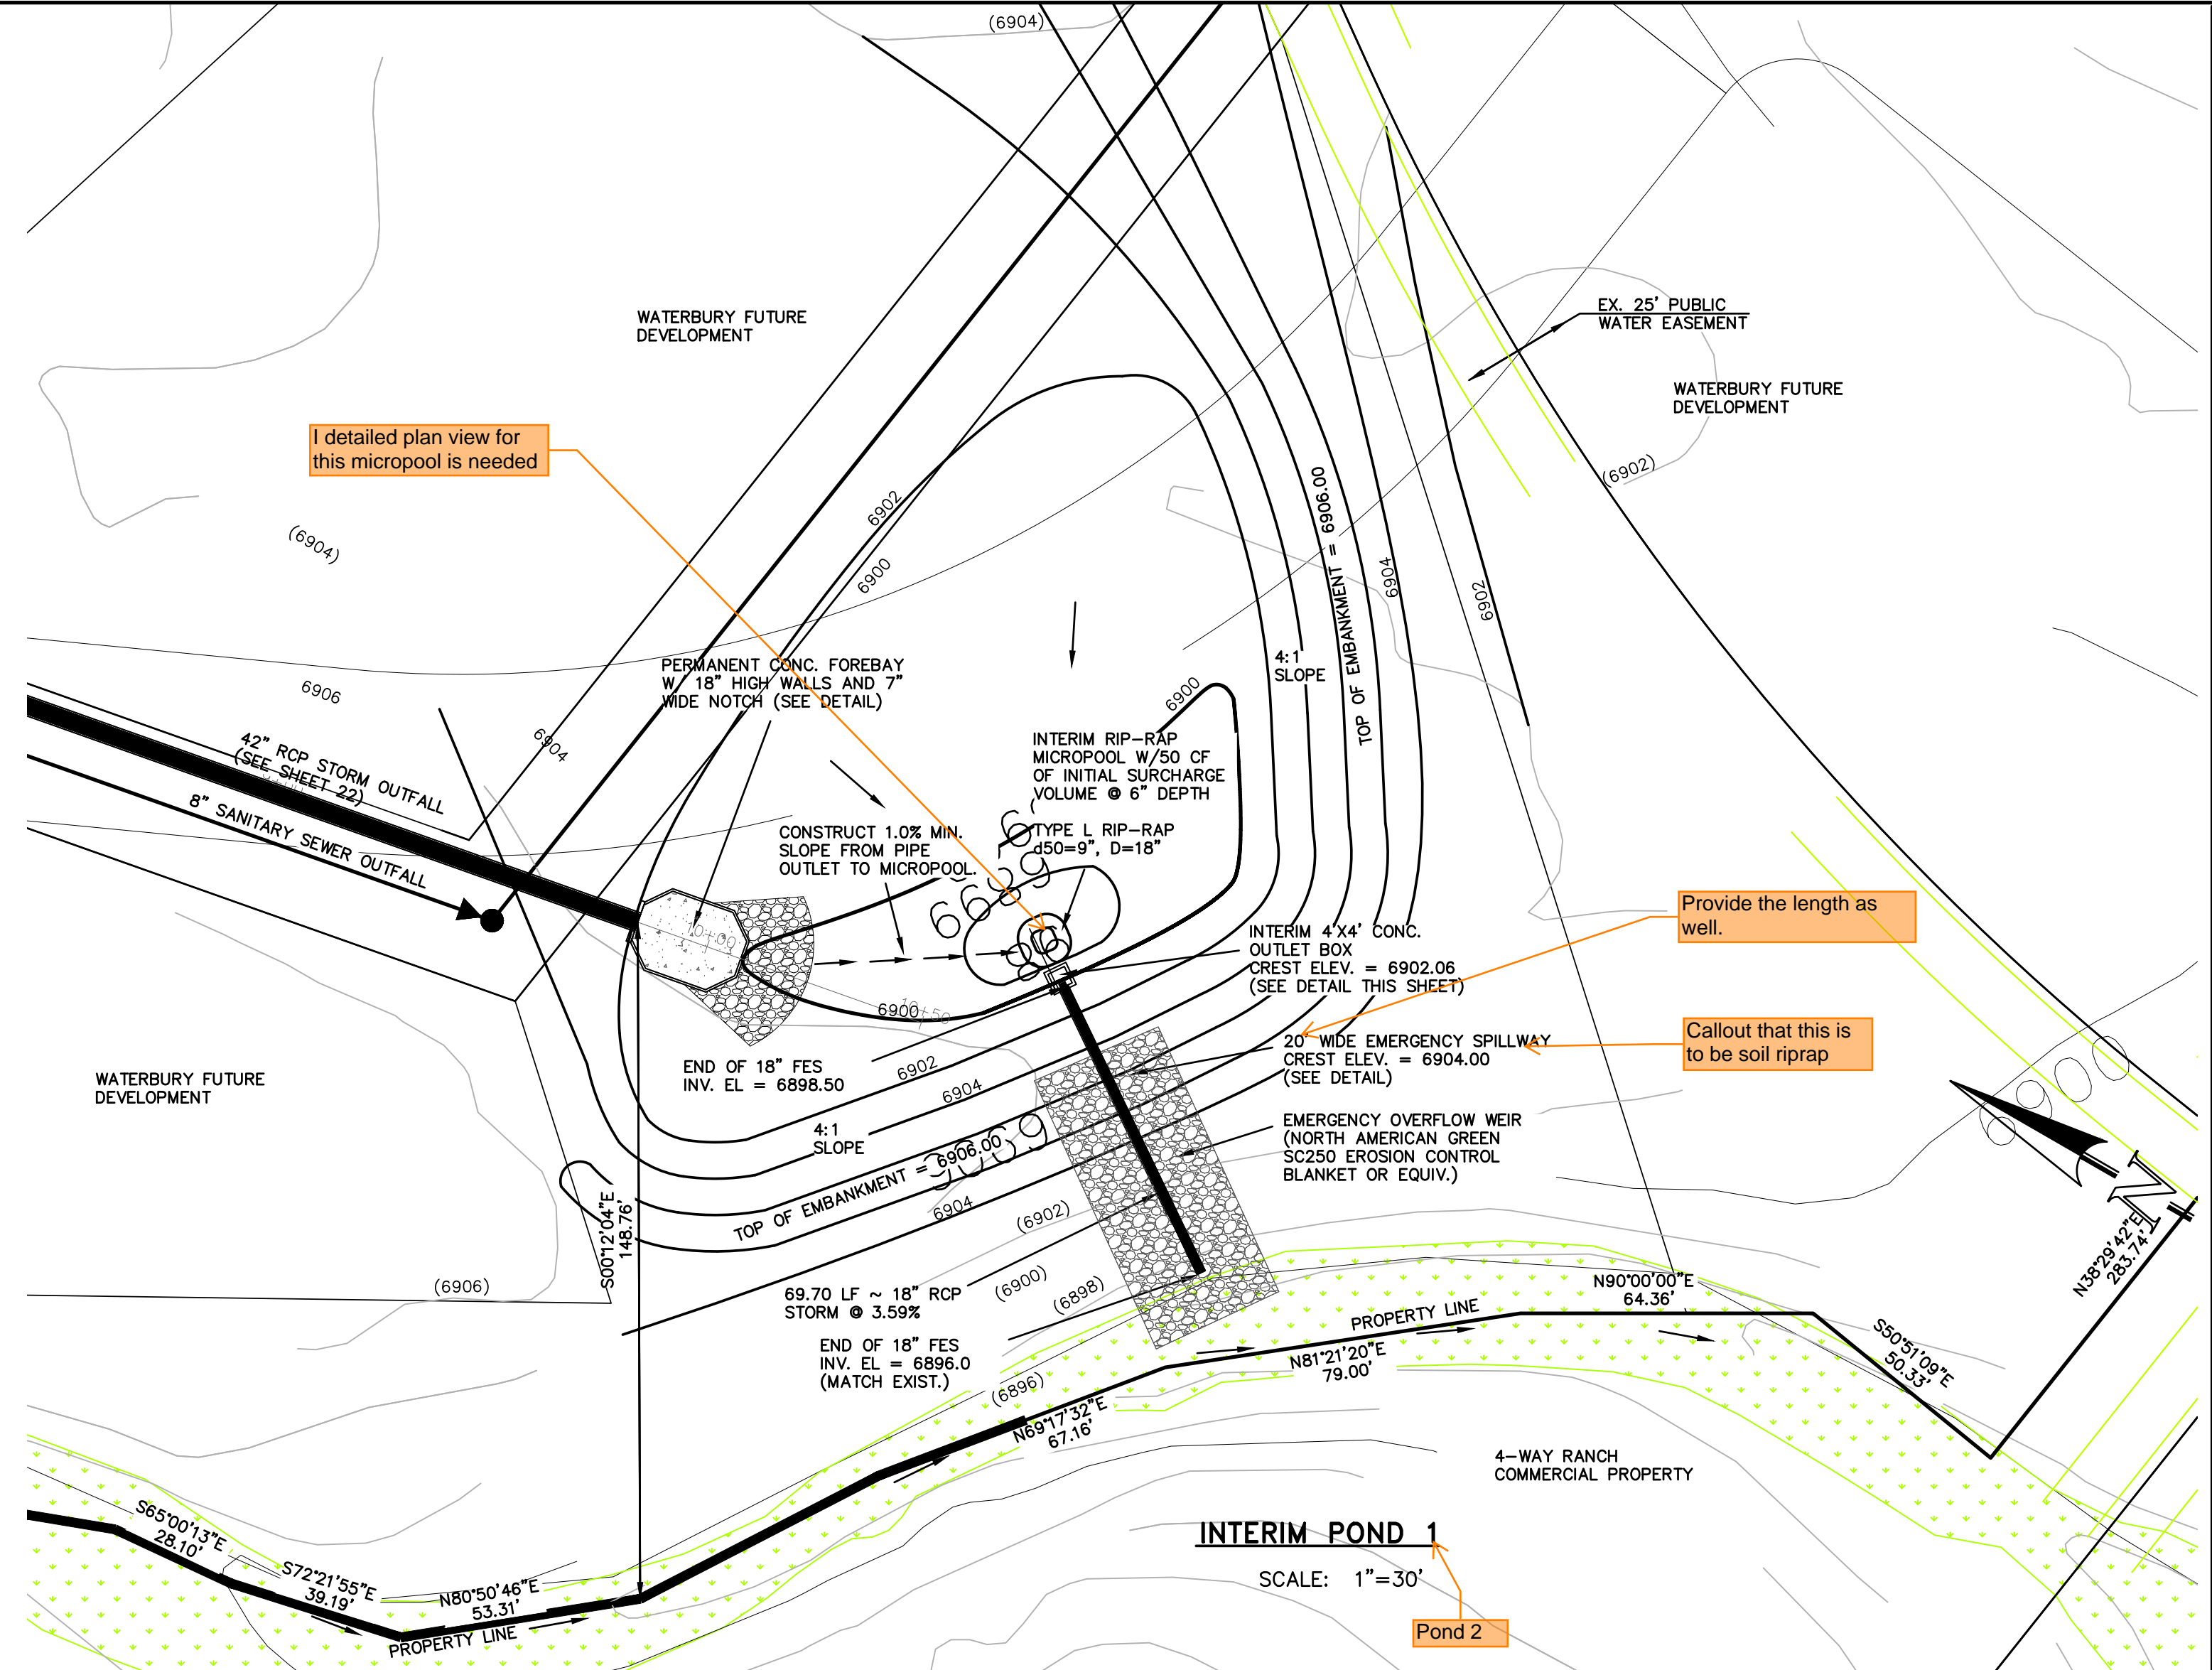

**INTERIM POND 1**  
SCALE: 1"=30'

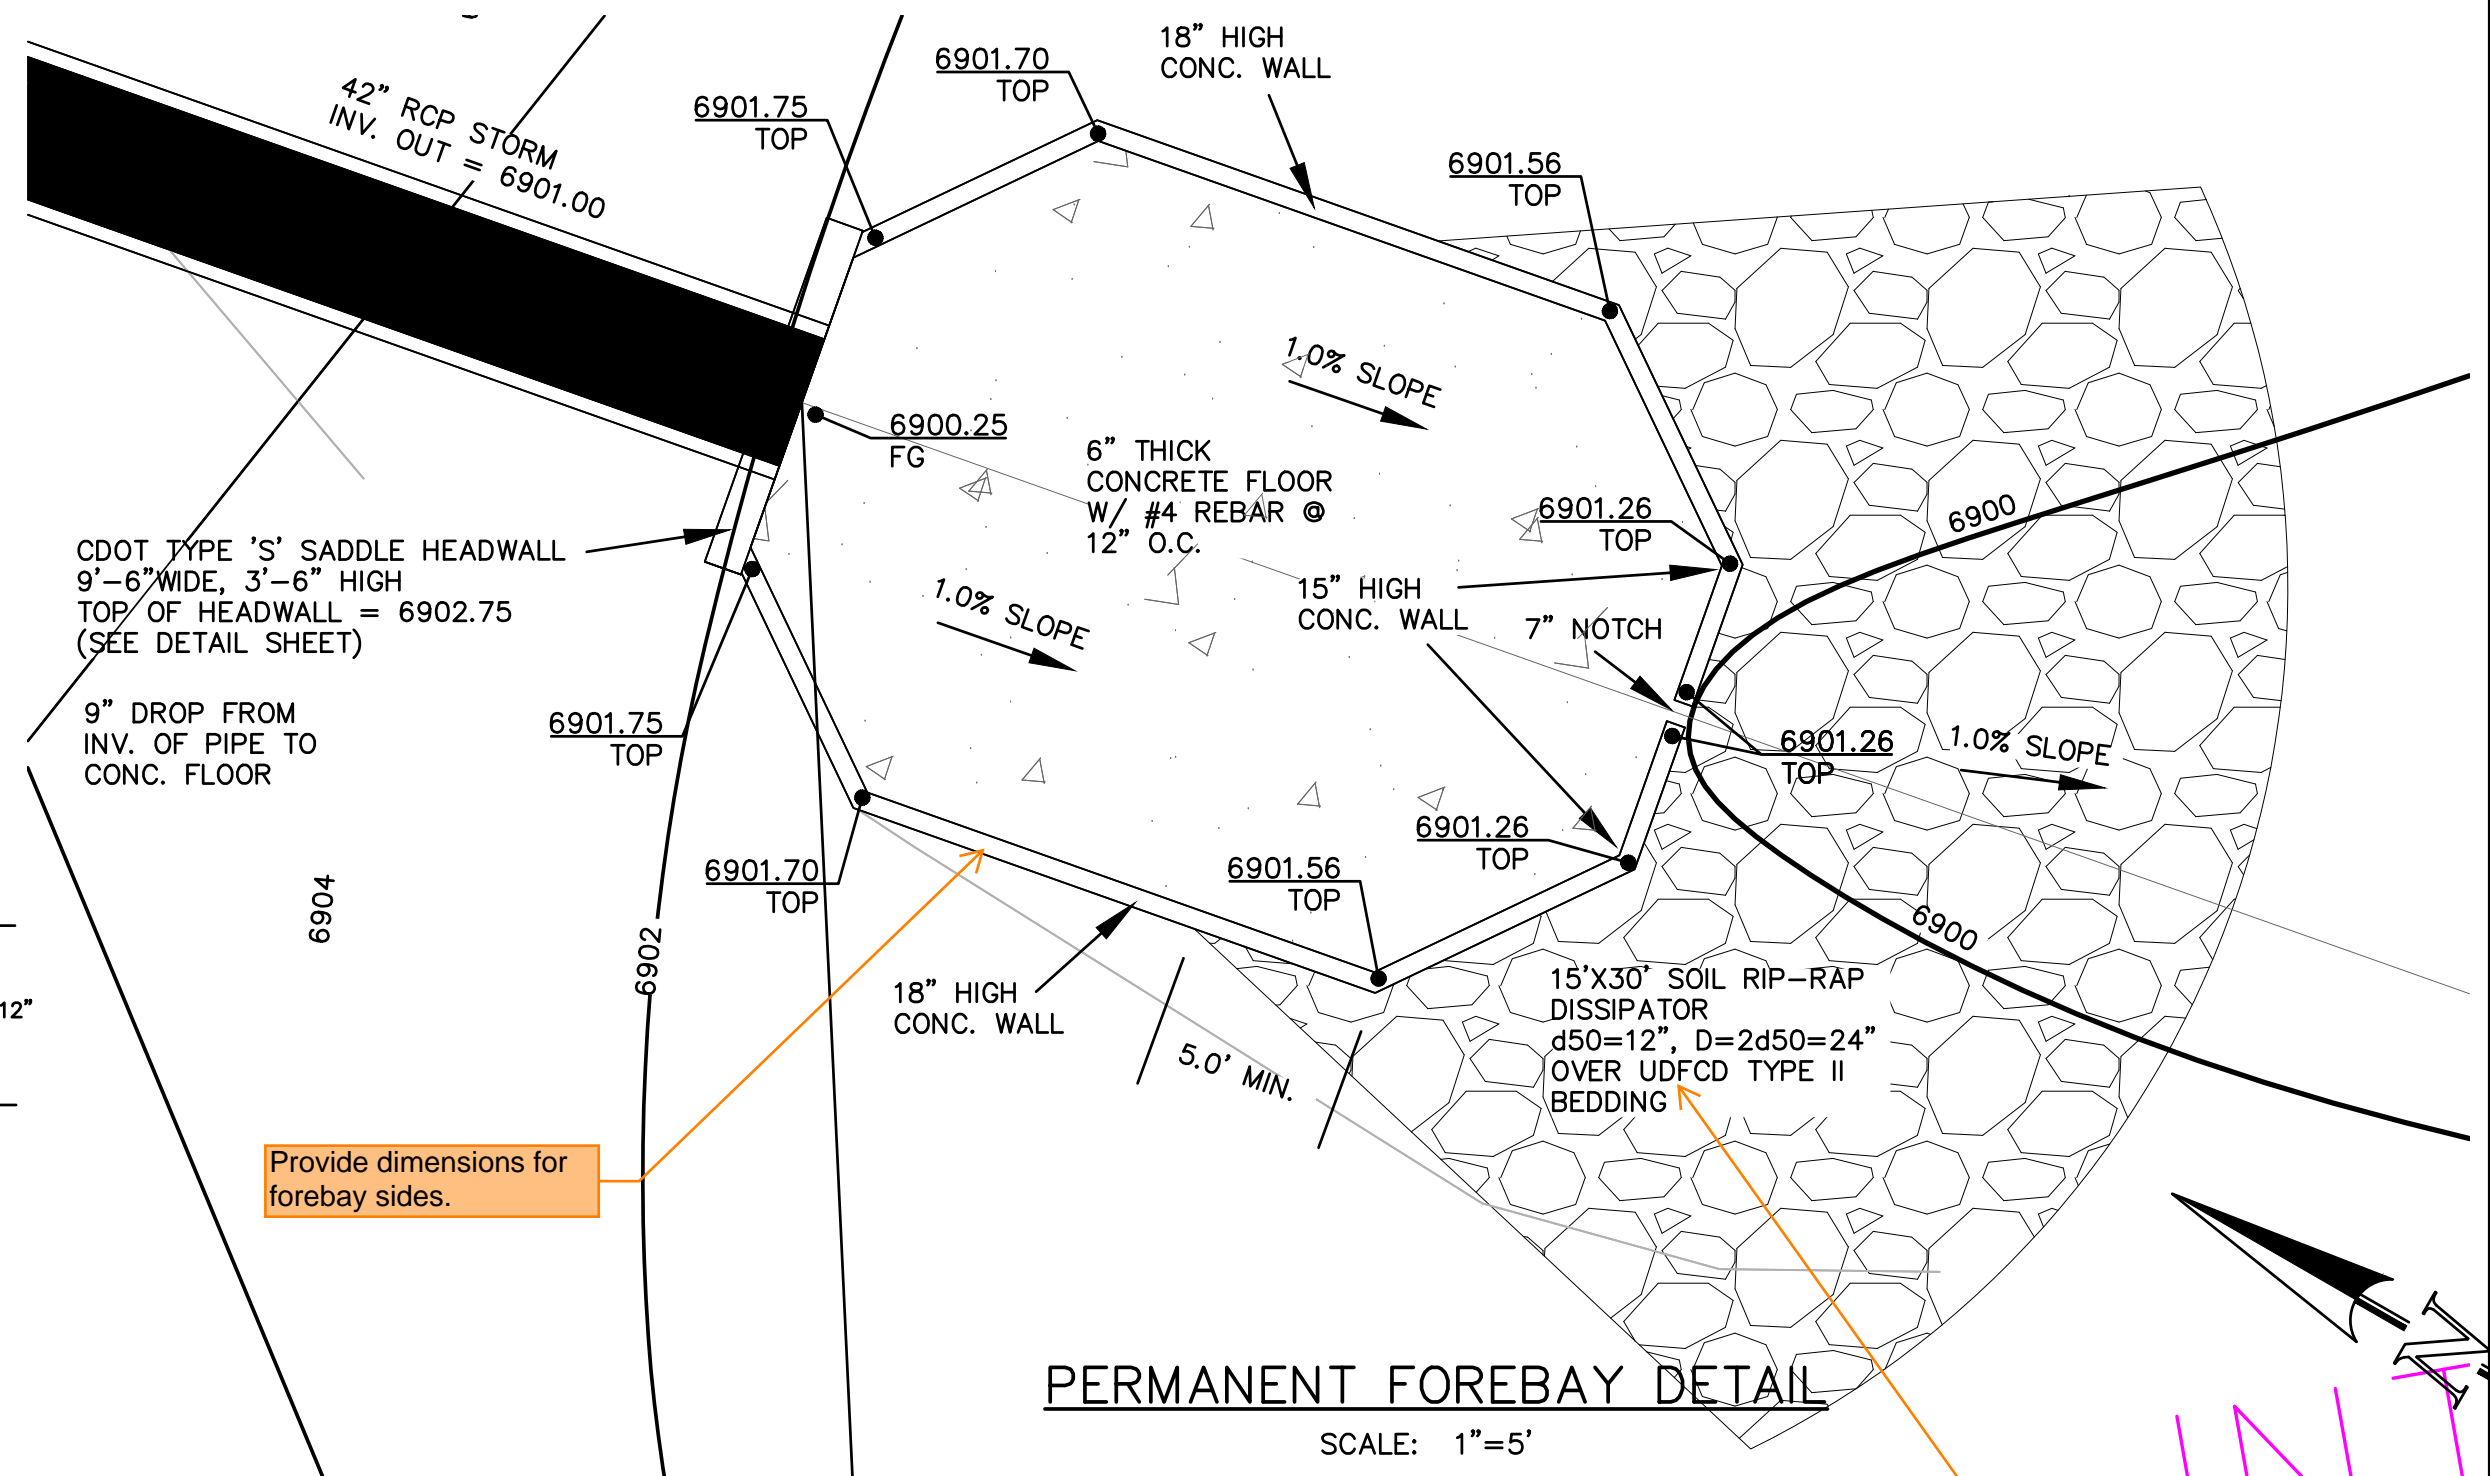

**PERMANENT FOREBAY DETAIL**  
SCALE: 1"=5'

Move text so it is not cutoff.

ENDING ELEVATION = 6902.66  
ENDING ELEVATION = 6902.06  
ENDING ELEVATION = 6901.22

What is this material type and depth?

It doesn't appear that a 4" depth initial surcharge volume is provided on the micropool like it is with Ponds 1 and 3. Is that just because an initial surcharge is not needed with a soft bottomed micropool because infiltration is expected? Depending on material (like soil riprap), infiltration will be limited so an initial surcharge would be needed.

Is the intent that this soft bottomed micropool is an interim condition and that a concrete one will be constructed in the Final buildout?

Just for reference, MHFD detail T-5 states:  
\* The bottom should be concrete unless a baseflow is present or anticipated or if groundwater is anticipated. Riprap is not recommended because it complicates maintenance operations.

Callout each individual orifice, so it is clear.

Is this an orifice? The orifice hole center is at the invert - this would not be possible to construct the full orifice hole as the bottom half is lower than the structural steel plate.


Does not match detail below or what is shown in DR calcs. Revise to remove discrepancy.

Value does not match DR spreadsheet. Verify and update so both match.

Specify installation instructions and mix ratio for soil riprap. As an example, note: Per MHFD Spec Section 31-37-00, the soil material shall be native or topsoil and mixed with 65% riprap and 35% soil by volume. And soil riprap shall consist of uniform mixture of soil and riprap without voids. And specify the riprap type per Table 1 of that spec.


Values do not match DR spreadsheet. Verify and update so both match.

DATE	
REVISIONS	
NO.	
DESCRIPTION	
UNTIL SUCH TIME AS THESE DRAWINGS ARE APPROVED BY THE REVIEWING AGENCIES, THE TERRA NOVA ENGINEERING, INC. APPROVES THEIR USE ONLY FOR THE PROJECT AND FOR THE PURPOSES AUTHORIZED BY WRITTEN AUTHORIZATION.	
PREPARED FOR:	4-WAY RANCH JOINT VENTURE
ATTN:	PETER MARTZ
	P.O. BOX 50223
	COLORADO SPRINGS, CO 80949
	719-491-3150
721 S. 23RD STREET, COLORADO SPRINGS, CO 80904	
OFFICE: 719-635-6422	
FAX: 719-635-6426	
www.terra-nova.com	
<b>WATERBURY FILING NO. 1</b> CONSTRUCTION SET POND 2 DETAILS	
DESIGNED BY	DLF
DRAWN BY	QNA
CHECKED BY	QNA
H-SCALE	NA
V-SCALE	N/A
JOB NO.	1715.00
DATE ISSUED	2/6/23
SHEET NO.	37 OF 39


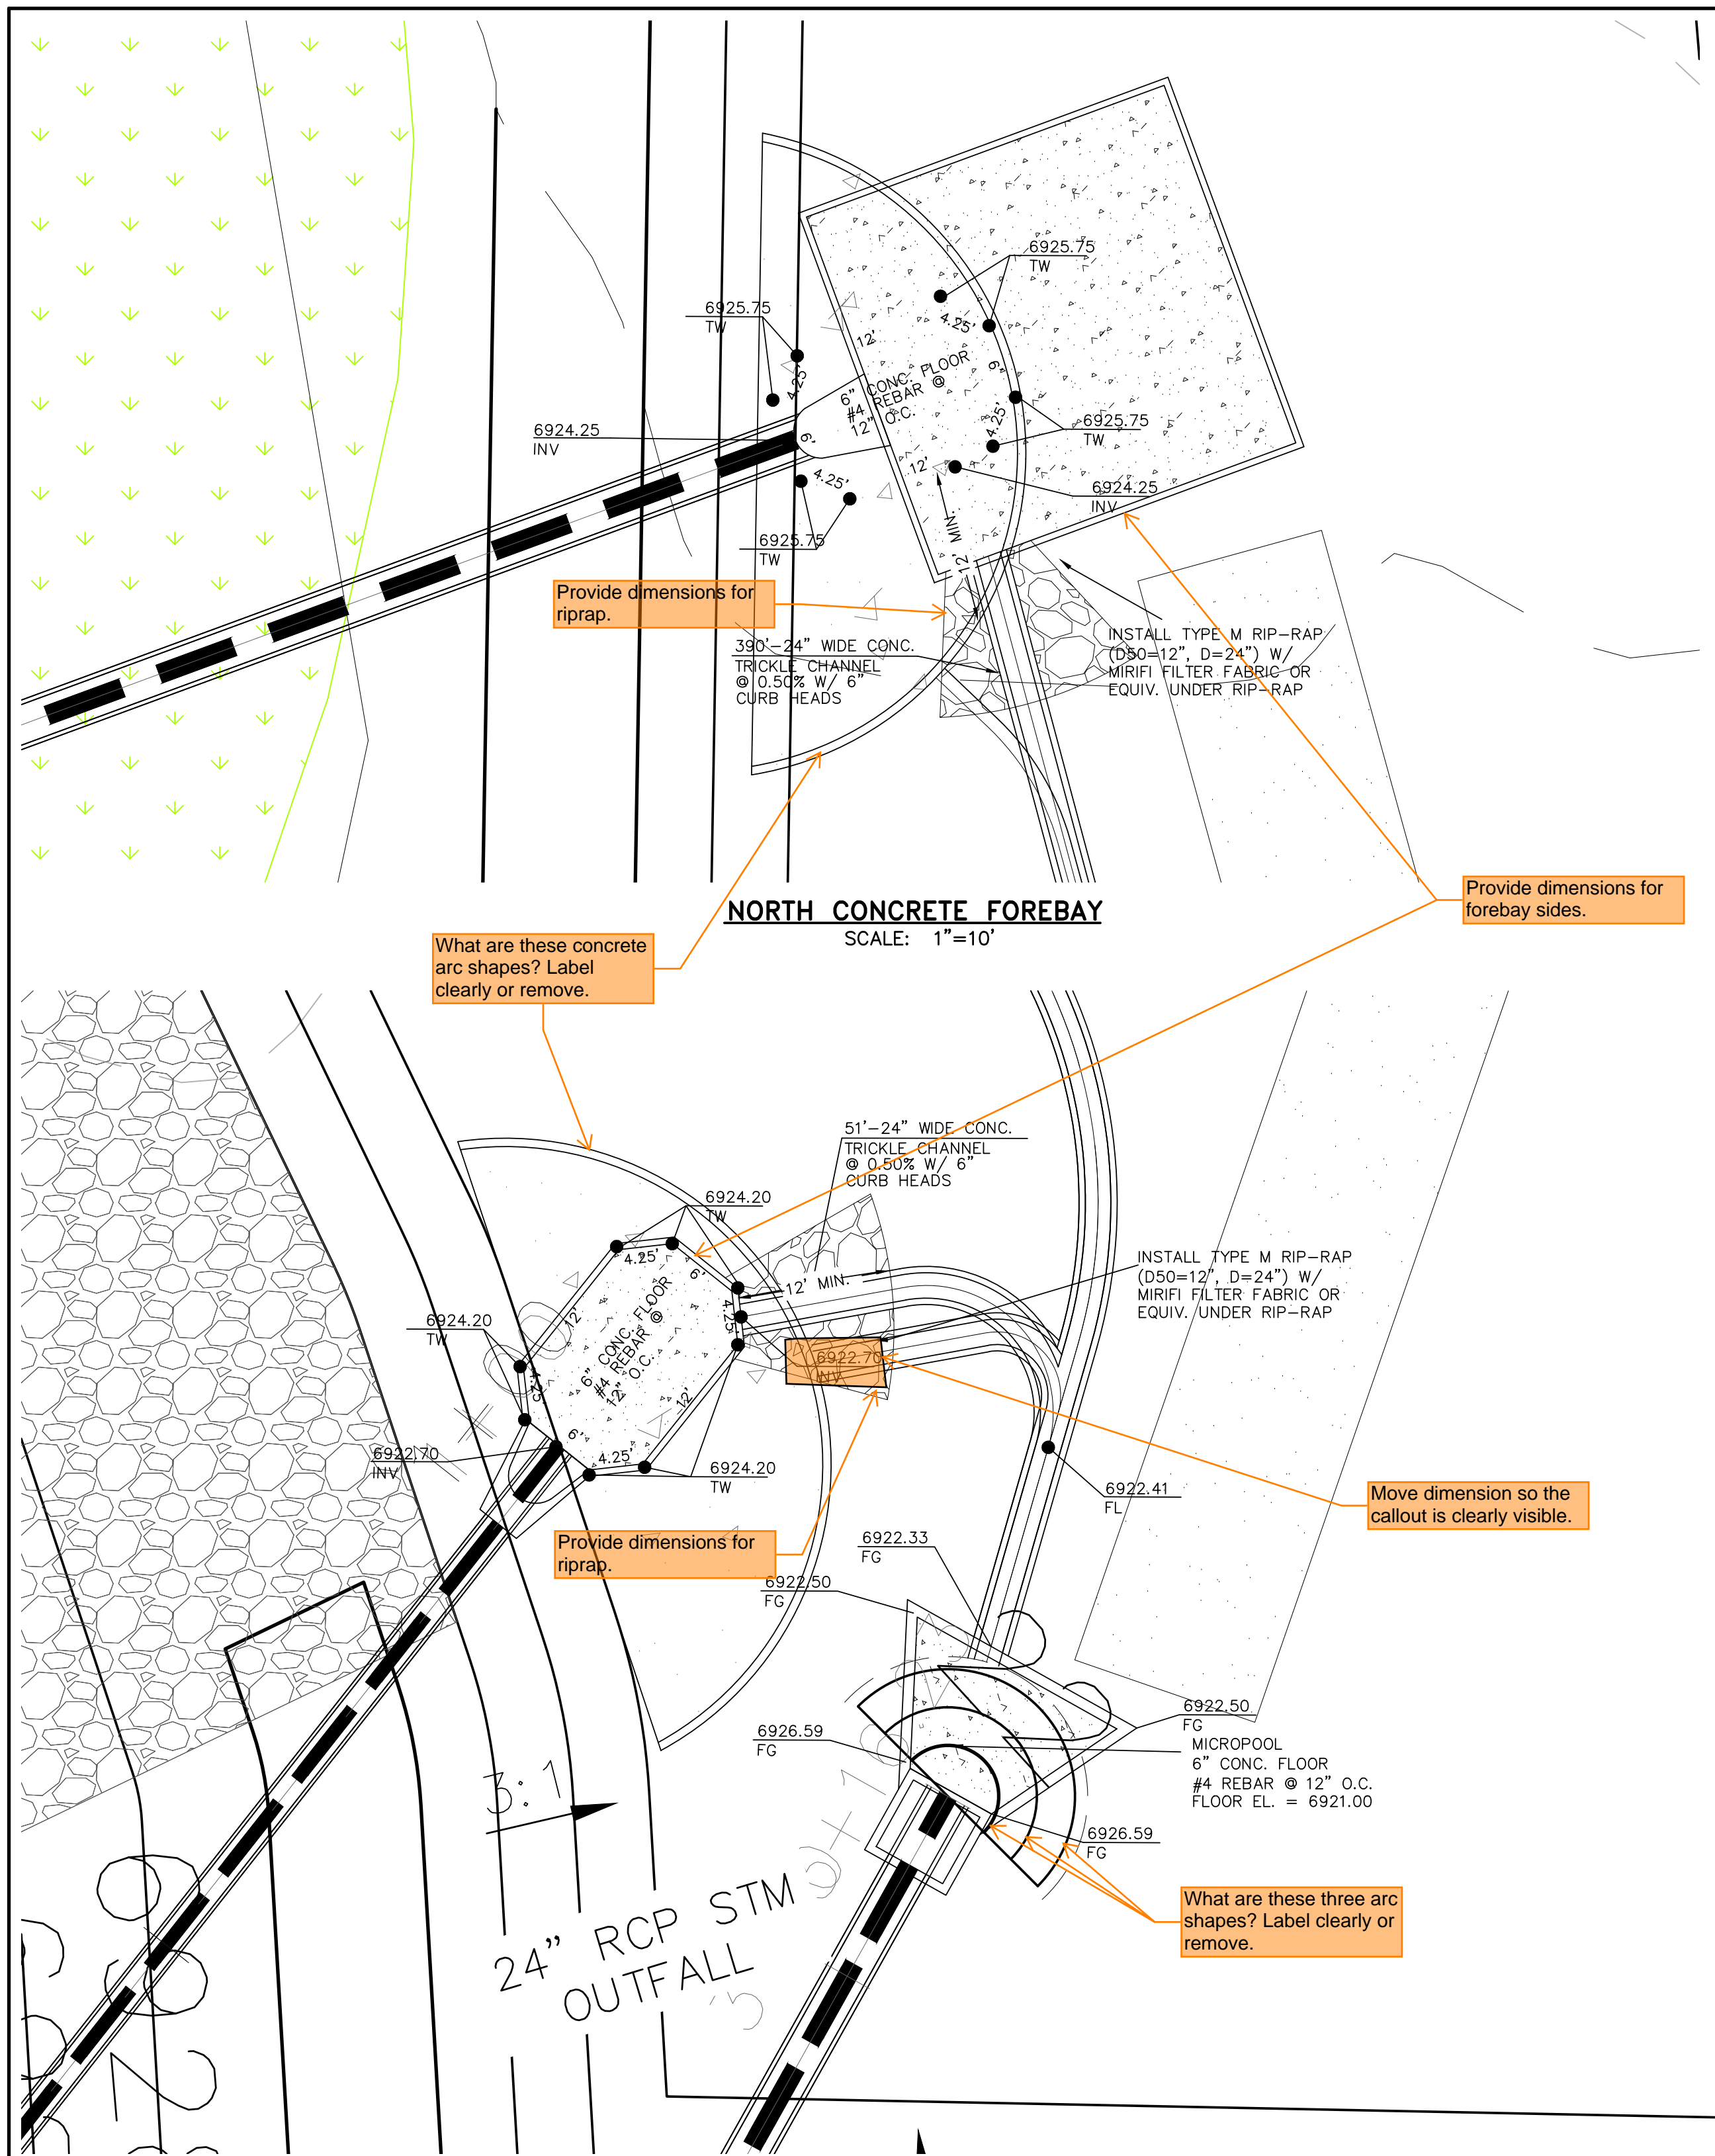


**NORTH CONCRETE FOREBAY**  
SCALE: 1"=10'

**EAST CONCRETE FOREBAY/MICROPOOL DETAILS**  
SCALE: 1"=10'

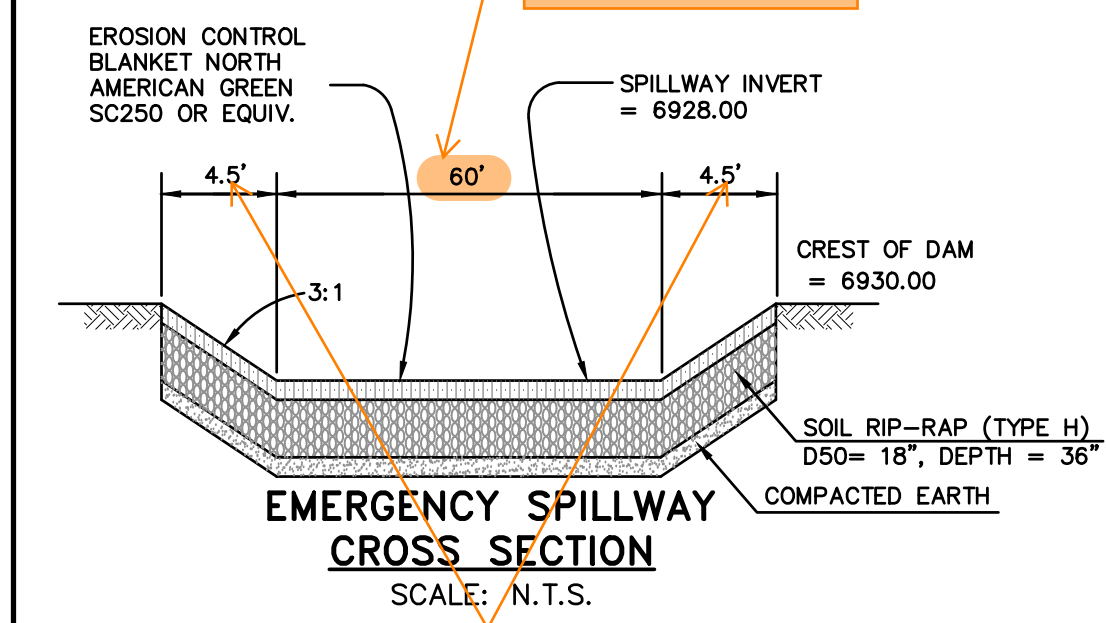

**EMERGENCY SPILLWAY CROSS SECTION**  
SCALE: N.T.S.

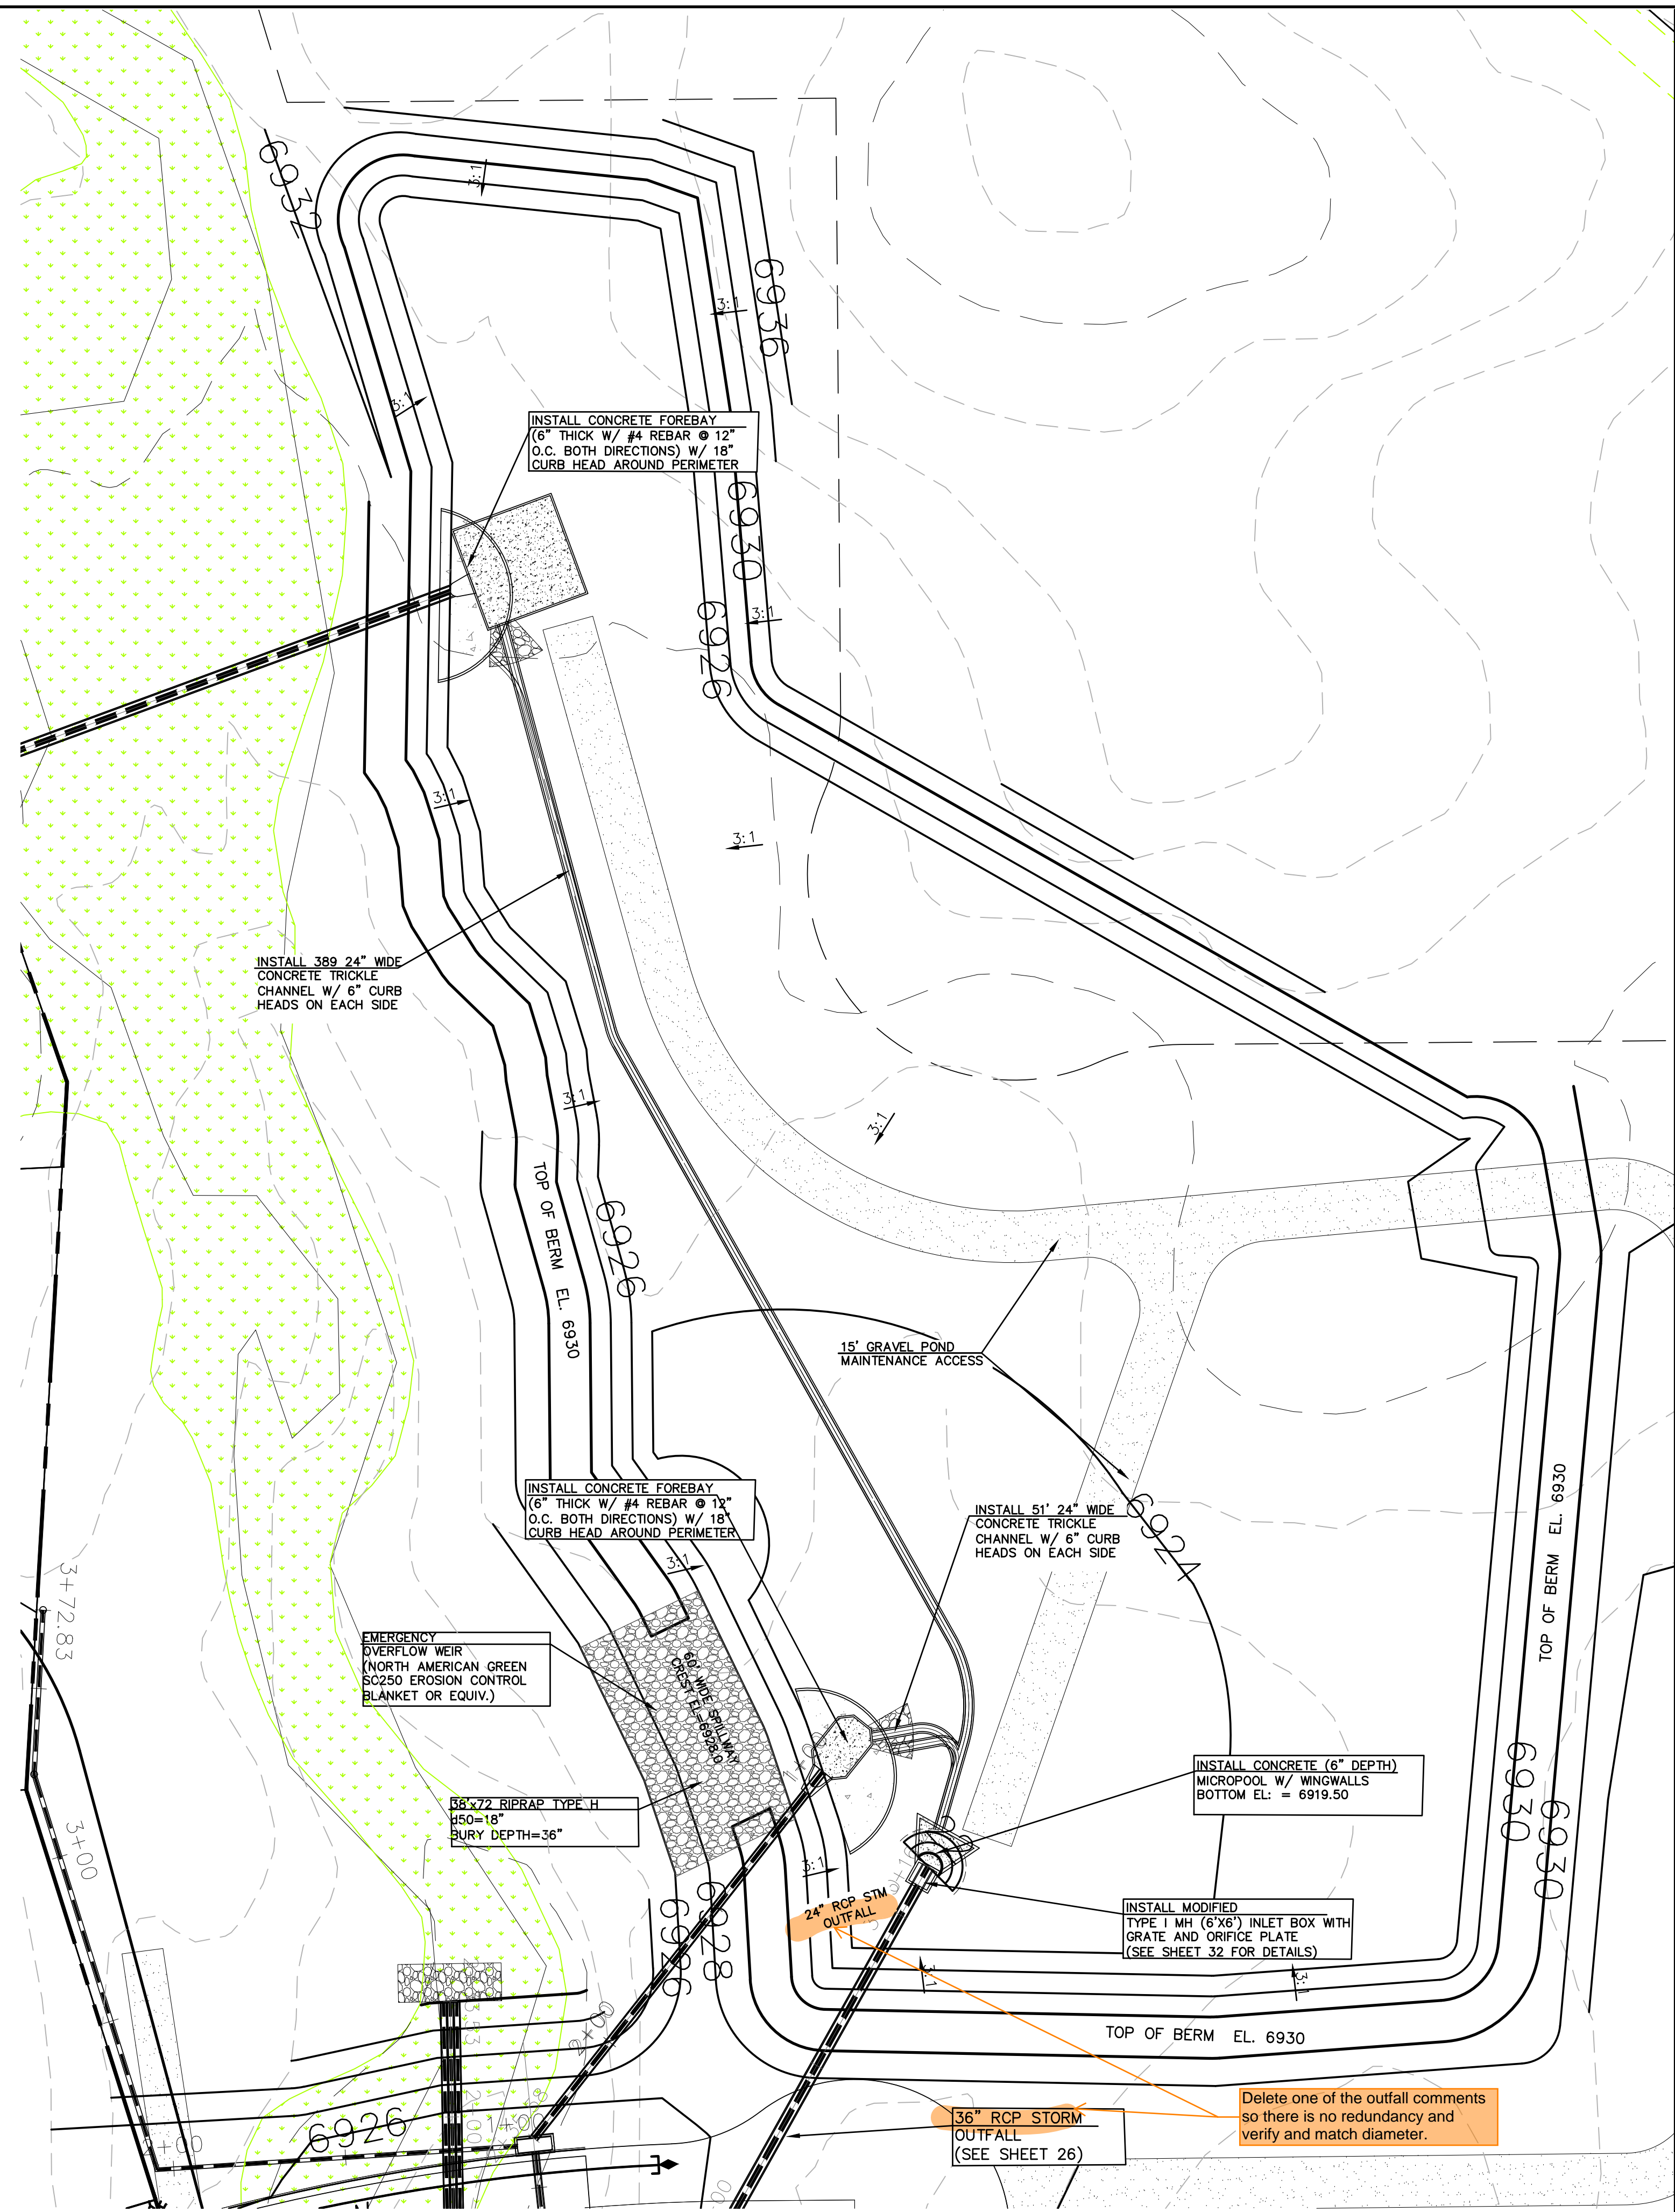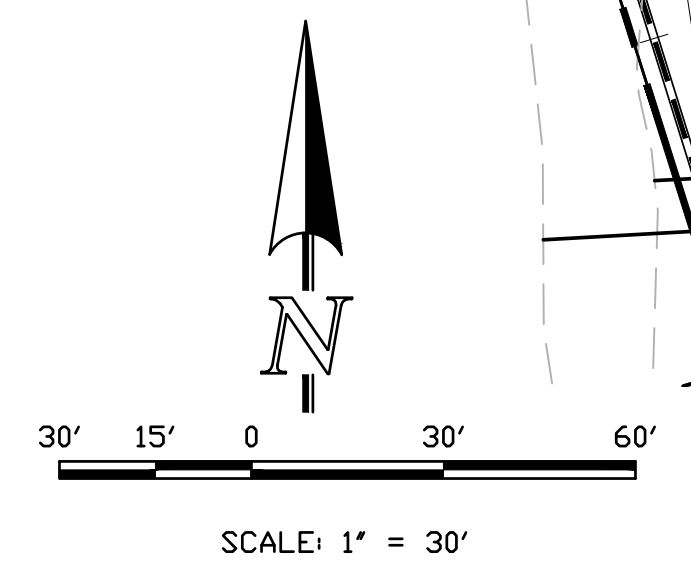

**POND 3**  
SCALE: 1"=30'

Provide dimensions for riprap.

What are these concrete arc shapes? Label clearly or remove.

Provide dimensions for forebay sides.

Provide dimensions for riprap.


Move dimension so the callout is clearly visible.


What are these three arc shapes? Label clearly or remove.

Remove "east." That is a carryover from Pond 1 that doesn't apply to Pond 3



Does not match the DR. Verify and update so both match.

Delete one of the outfall comments so there is no redundancy and verify and match diameter.

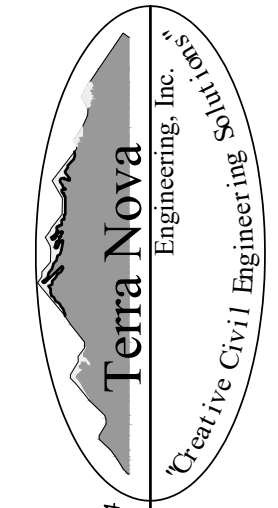REVISIONS	NO.	DESCRIPTION	DATE
UNTIL SUCH TIME AS THESE DRAWINGS ARE APPROVED BY THE REVIEWING AGENCIES, THE REVIEWING AGENCIES ARE NOT RESPONSIBLE FOR THE DESIGN OR CONSTRUCTION OF THE PROJECT. THE USER OF THESE DRAWINGS SHALL BE RESPONSIBLE FOR OBTAINING ALL NECESSARY PERMITS AND AUTHORIZATIONS FROM THE APPROPRIATE AGENCIES.			
PREPARED FOR: <b>4-WAY RANCH JOINT VENTURE</b> ATTN: PETER MARTZ P.O. BOX 50223 COLORADO SPRINGS, CO 80949 719-491-3150			
 Terra Nova Engineering, Inc. Civil Engineering 721 S. 23RD STREET COLORADO SPRINGS, CO 80904 OFFICE: 719-635-6422 FAX: 719-635-6426 www.tnec.com			
<b>WATERBURY FILING NO. 1</b> CONSTRUCTION SET POND 3 DETAILS			
DESIGNED BY DLF DRAWN BY QNA CHECKED BY QNA H-SCALE NA V-SCALE N/A JOB NO. 1715.00 DATE ISSUED 2/6/23 SHEET NO. 38 OF 39			

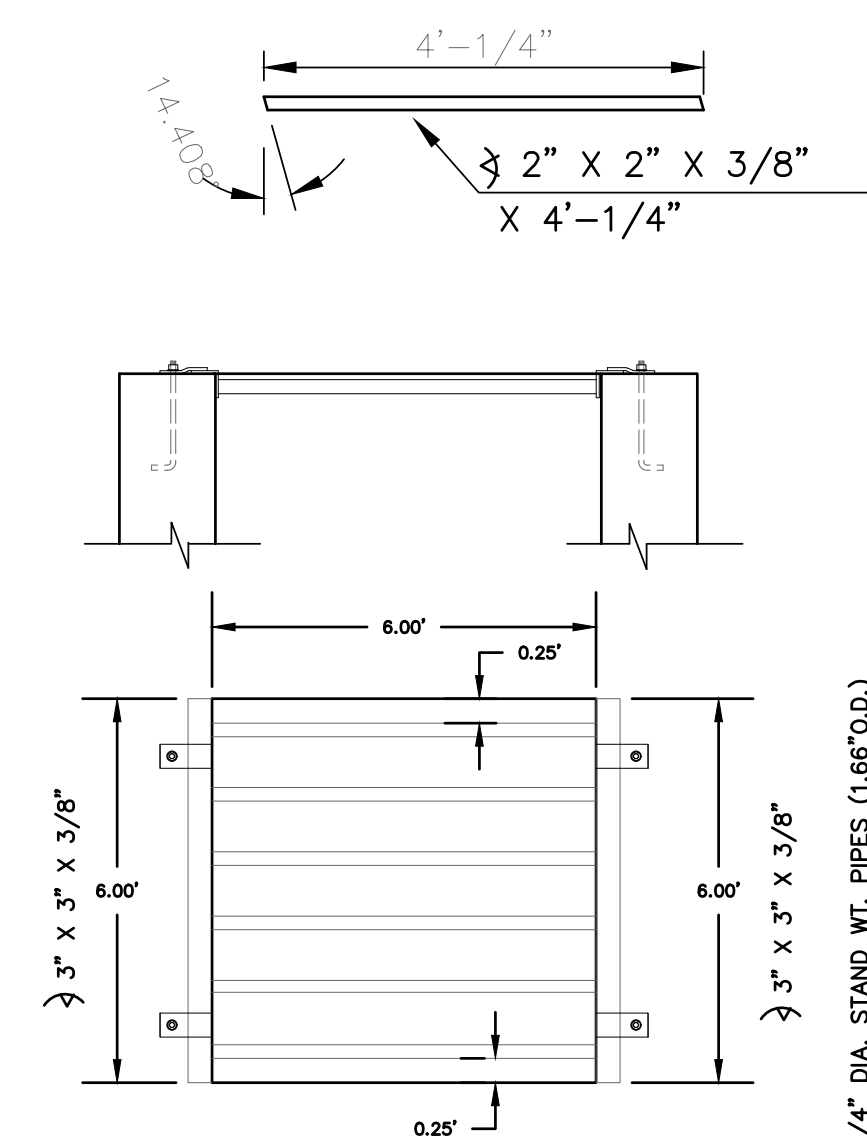


**GRATE CONSTRUCTION**  
ALL WELDED CONSTRUCTION  
SCALE: 1"=2'

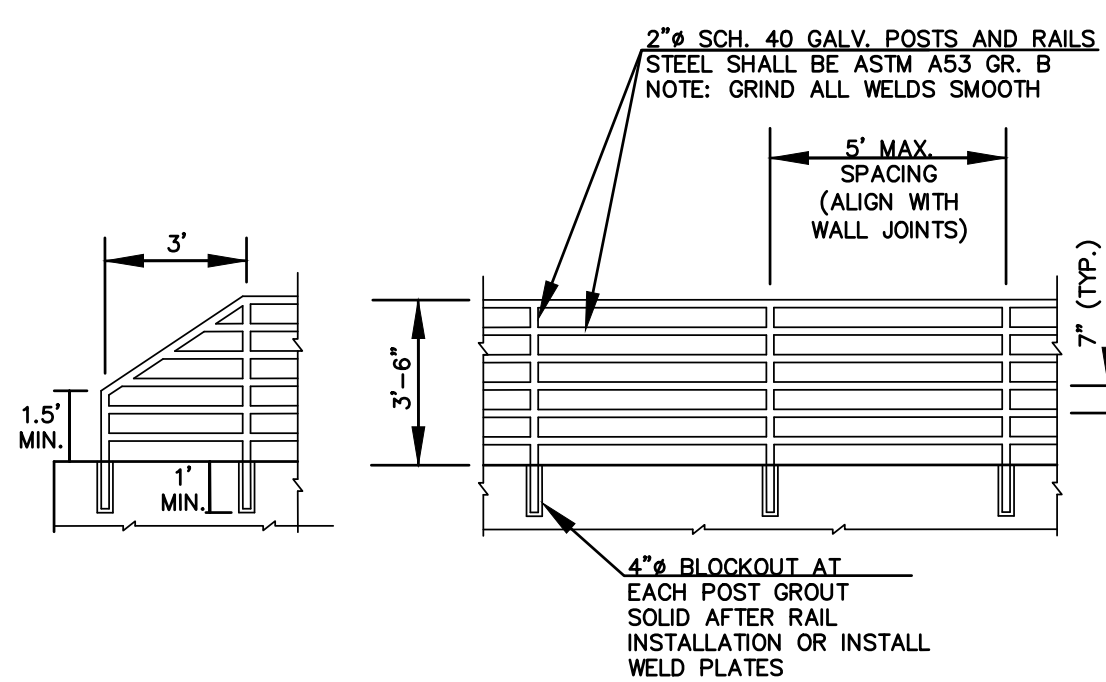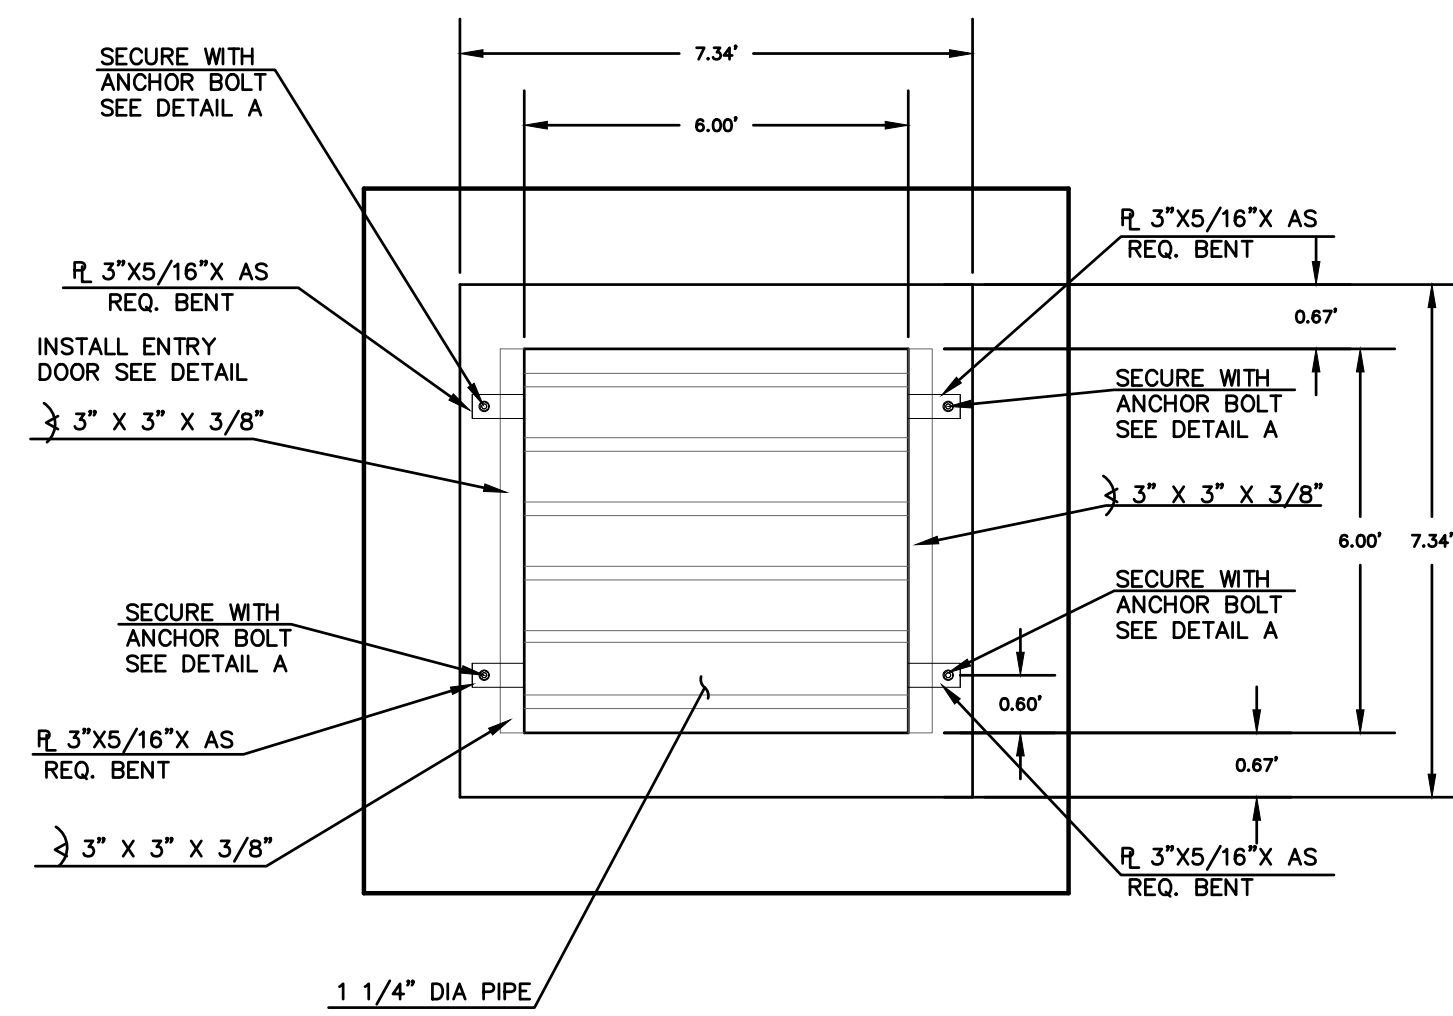

**NOTES:**

1. WELD PLATES MAY BE SUBSTITUTED FOR PIPE EMBEDMENT. CONTRACTOR SHALL SUBMIT HANDRAIL SHOP DRAWINGS TO ENGINEER OF RECORD FOR APPROVAL PRIOR TO FABRICATION DESIGN CRITERIA SHALL BE IN ACCORDANCE WITH AASHTO STANDARDS. HANDRAIL DESIGN SHALL BE COMPATIBLE WITH THE DESIGN OF THE WINGWALLS AND HEADWALLS.
2. RAILING POSTS SHALL BE SET TO NORMAL TO GRADE. RAILS SHALL RUN PARALLEL TO THE SLOPES OF TOPS OF THE WALLS.
3. ALL RAILS SHALL HAVE EXPANSION JOINTS SPACED AT 40'-0" MAX. JOINT ENDS SHALL BE FREE OF ANY SHARP EDGES OR CORNERS.

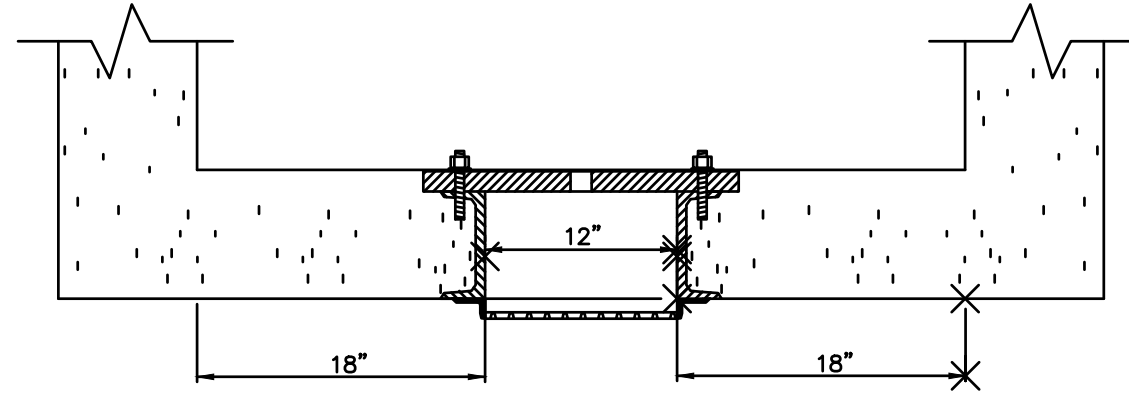

**SECTION B-B**  
SCALE: 1"=1'

**STEEL FABRICATION NOTES:**

FABRICATED STEEL STRUCTURES SHALL BE CONSTRUCTED IN ACCORDANCE WITH AISC AND AWS SPECIFICATIONS.

3. THE OUTLET STRUCTURE BARGRATE IS DESIGNED FOR A VERTICAL LOAD OF 300 LBS./SQ. FT.


ALL STRUCTURAL STEEL SHAPES TO INCLUDE: ANGLE, PLATE, AND BAR SHALL MEET ASTM A36 SPECIFICATIONS, FY = 36 KSI MINIMUM. STRUCTURAL TUBING SHALL MEET ASTM A500 GRADE B SPECIFICATIONS, FY = 48 KSI MINIMUM. STEEL PIPE SHALL BE STANDARD WEIGHT PIPE ASTM A53 GRADE B, FY = 35 KSI MINIMUM.

WELDS NOT INDICATED SHALL BE 1/8" MINIMUM FILLET OR GROOVE, CONTINUOUS SO FAR AS POSSIBLE, CONSIDER VANDALISM LOADS, WELD ACCORDINGLY AT CRITICAL LOCATIONS.


6. PRIOR TO PAINTING REMOVE ALL OIL, SCALE, AND SLAG, GRIND OFF BURRS AND SHARP EDGES.

Trash rack to be Amico Klemp KRP Series aluminum bar grate (Figure 6-b), US Filter or Johnson stainless steel well screen with #93 VEE wire (Figure 6-a), or equivalent (per EPC DCMV2, Chap 4.3 and MHFD Detail T-12).


Diamond plate trash racks are not an equivalent replacement to those in our criteria. We have concerns that the diamond plate is going to be a constant maintenance issue with clogging. Diamonds plates may have the same percent open area as those shown in our criteria but this isn't the only criteria that decides equivalency with the ones specified in our criteria. The well screen and bar grates in our criteria are designed to be maintenance friendly whereas the diamond plate will clog more often.

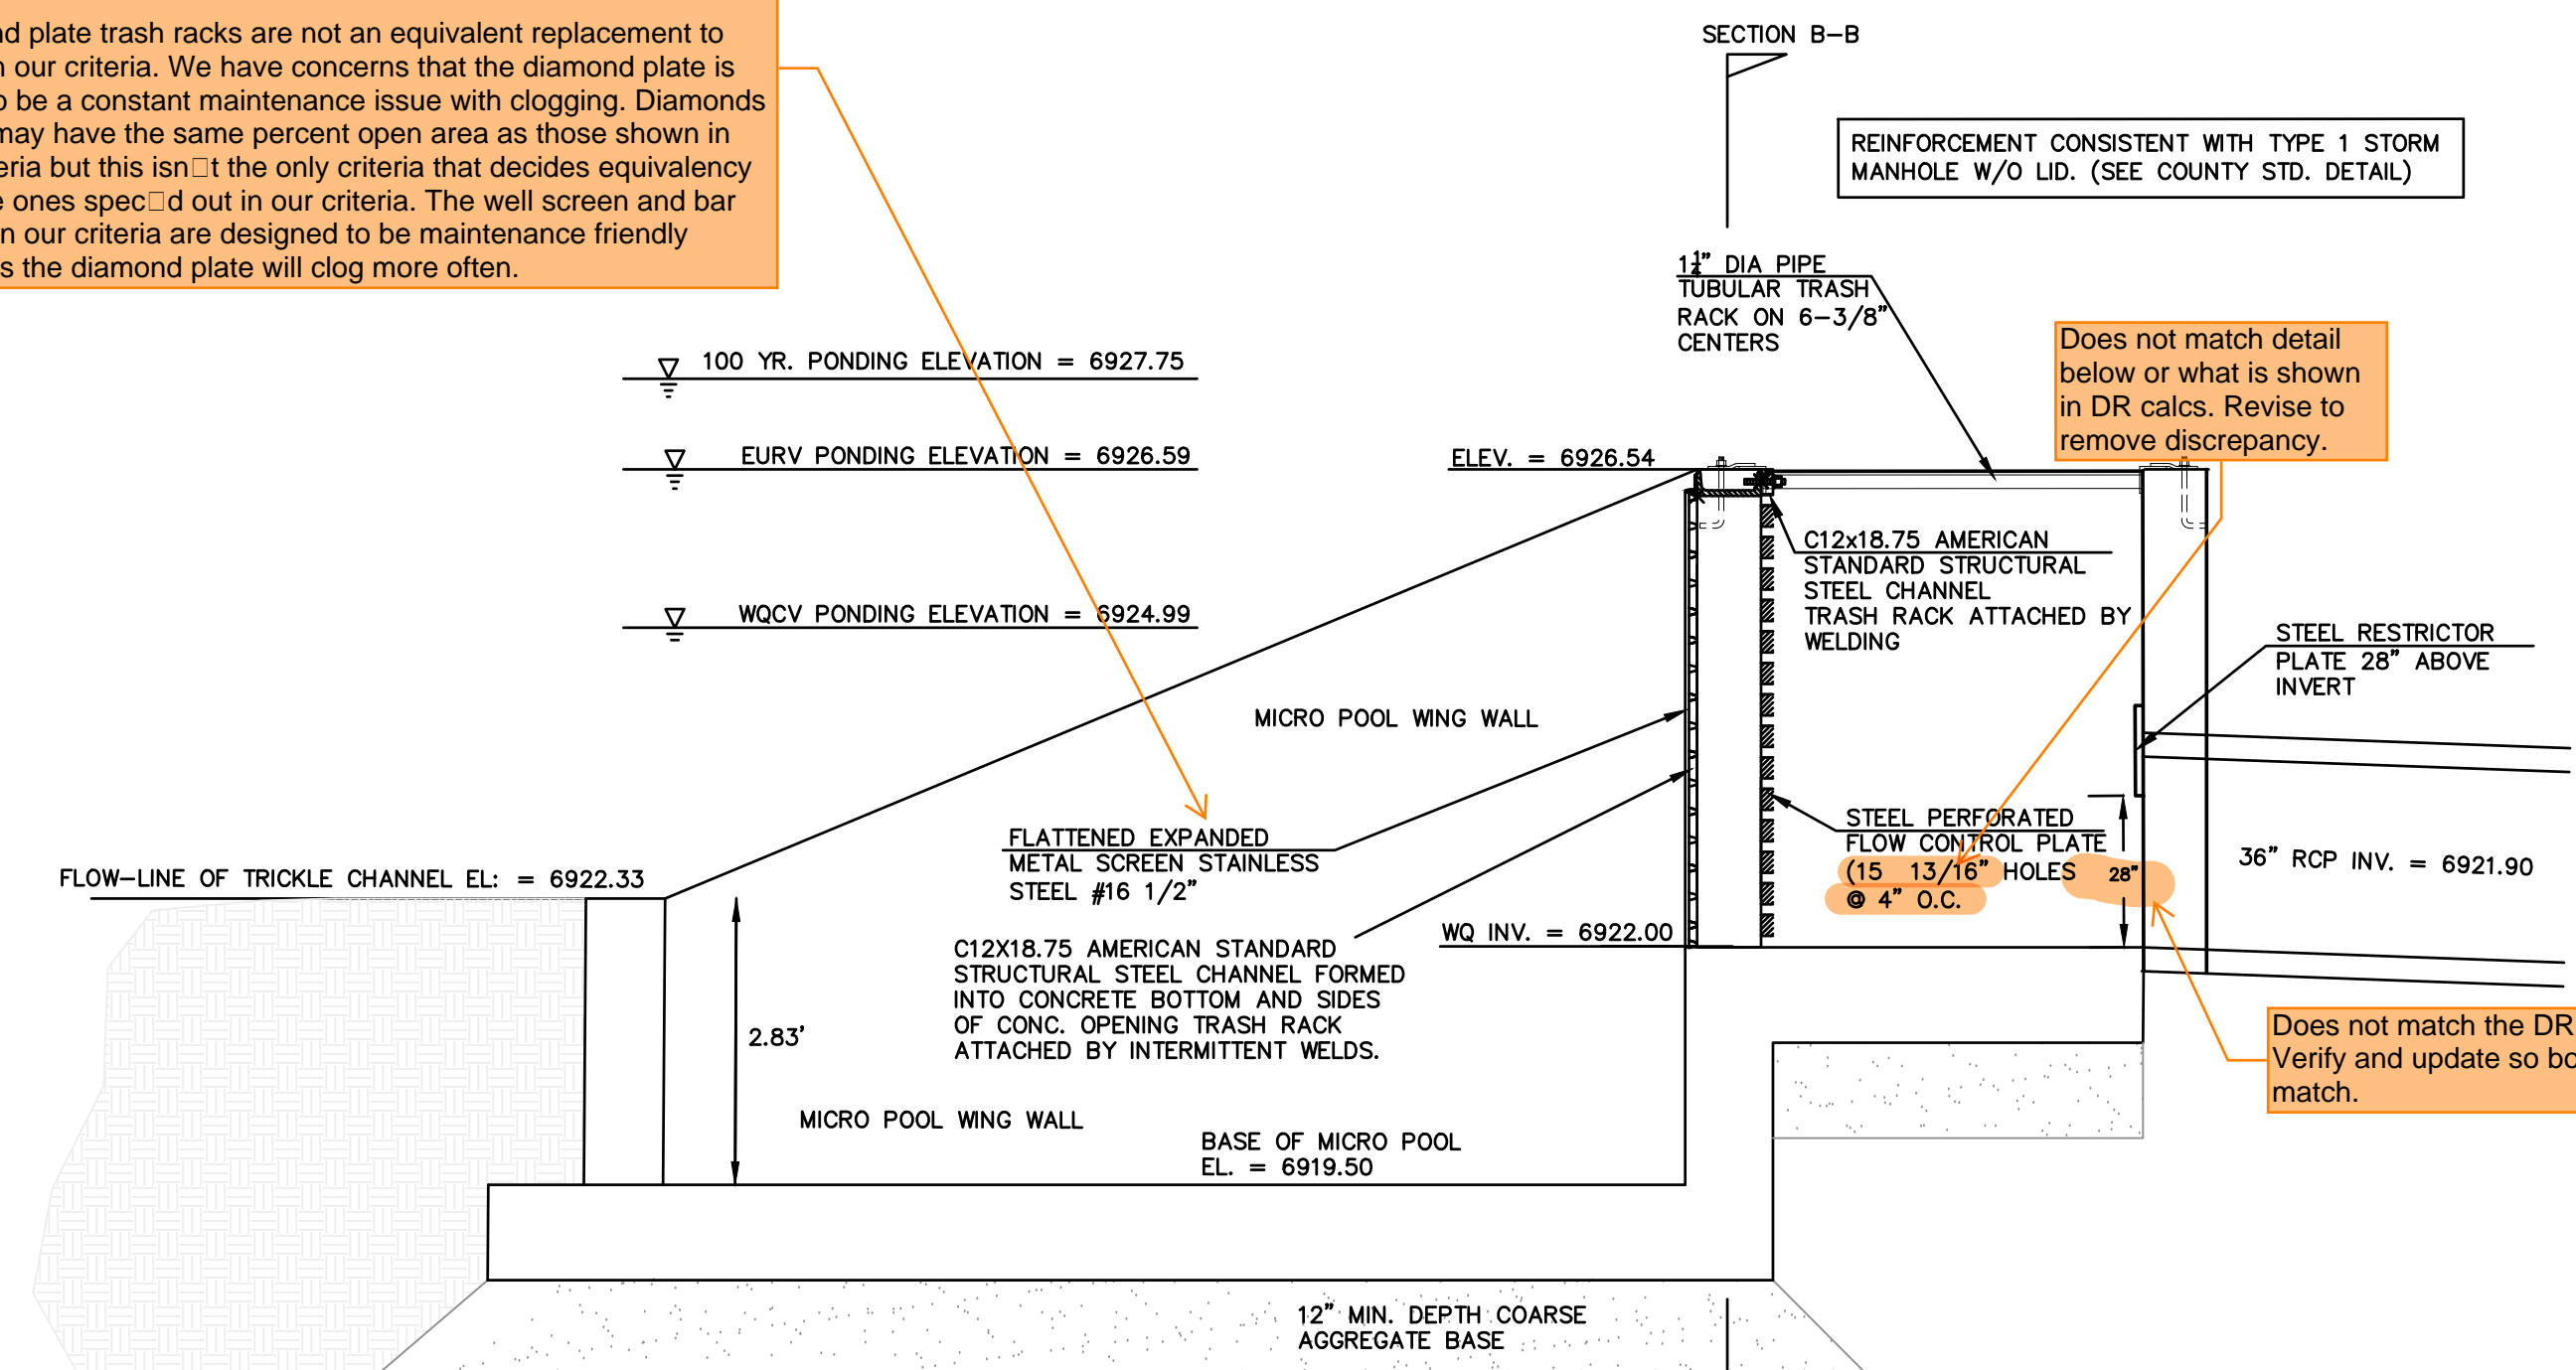

**OUTLET STRUCTURE MODIFIED TYPE 1 MH**  
SCALE: 1"=2'

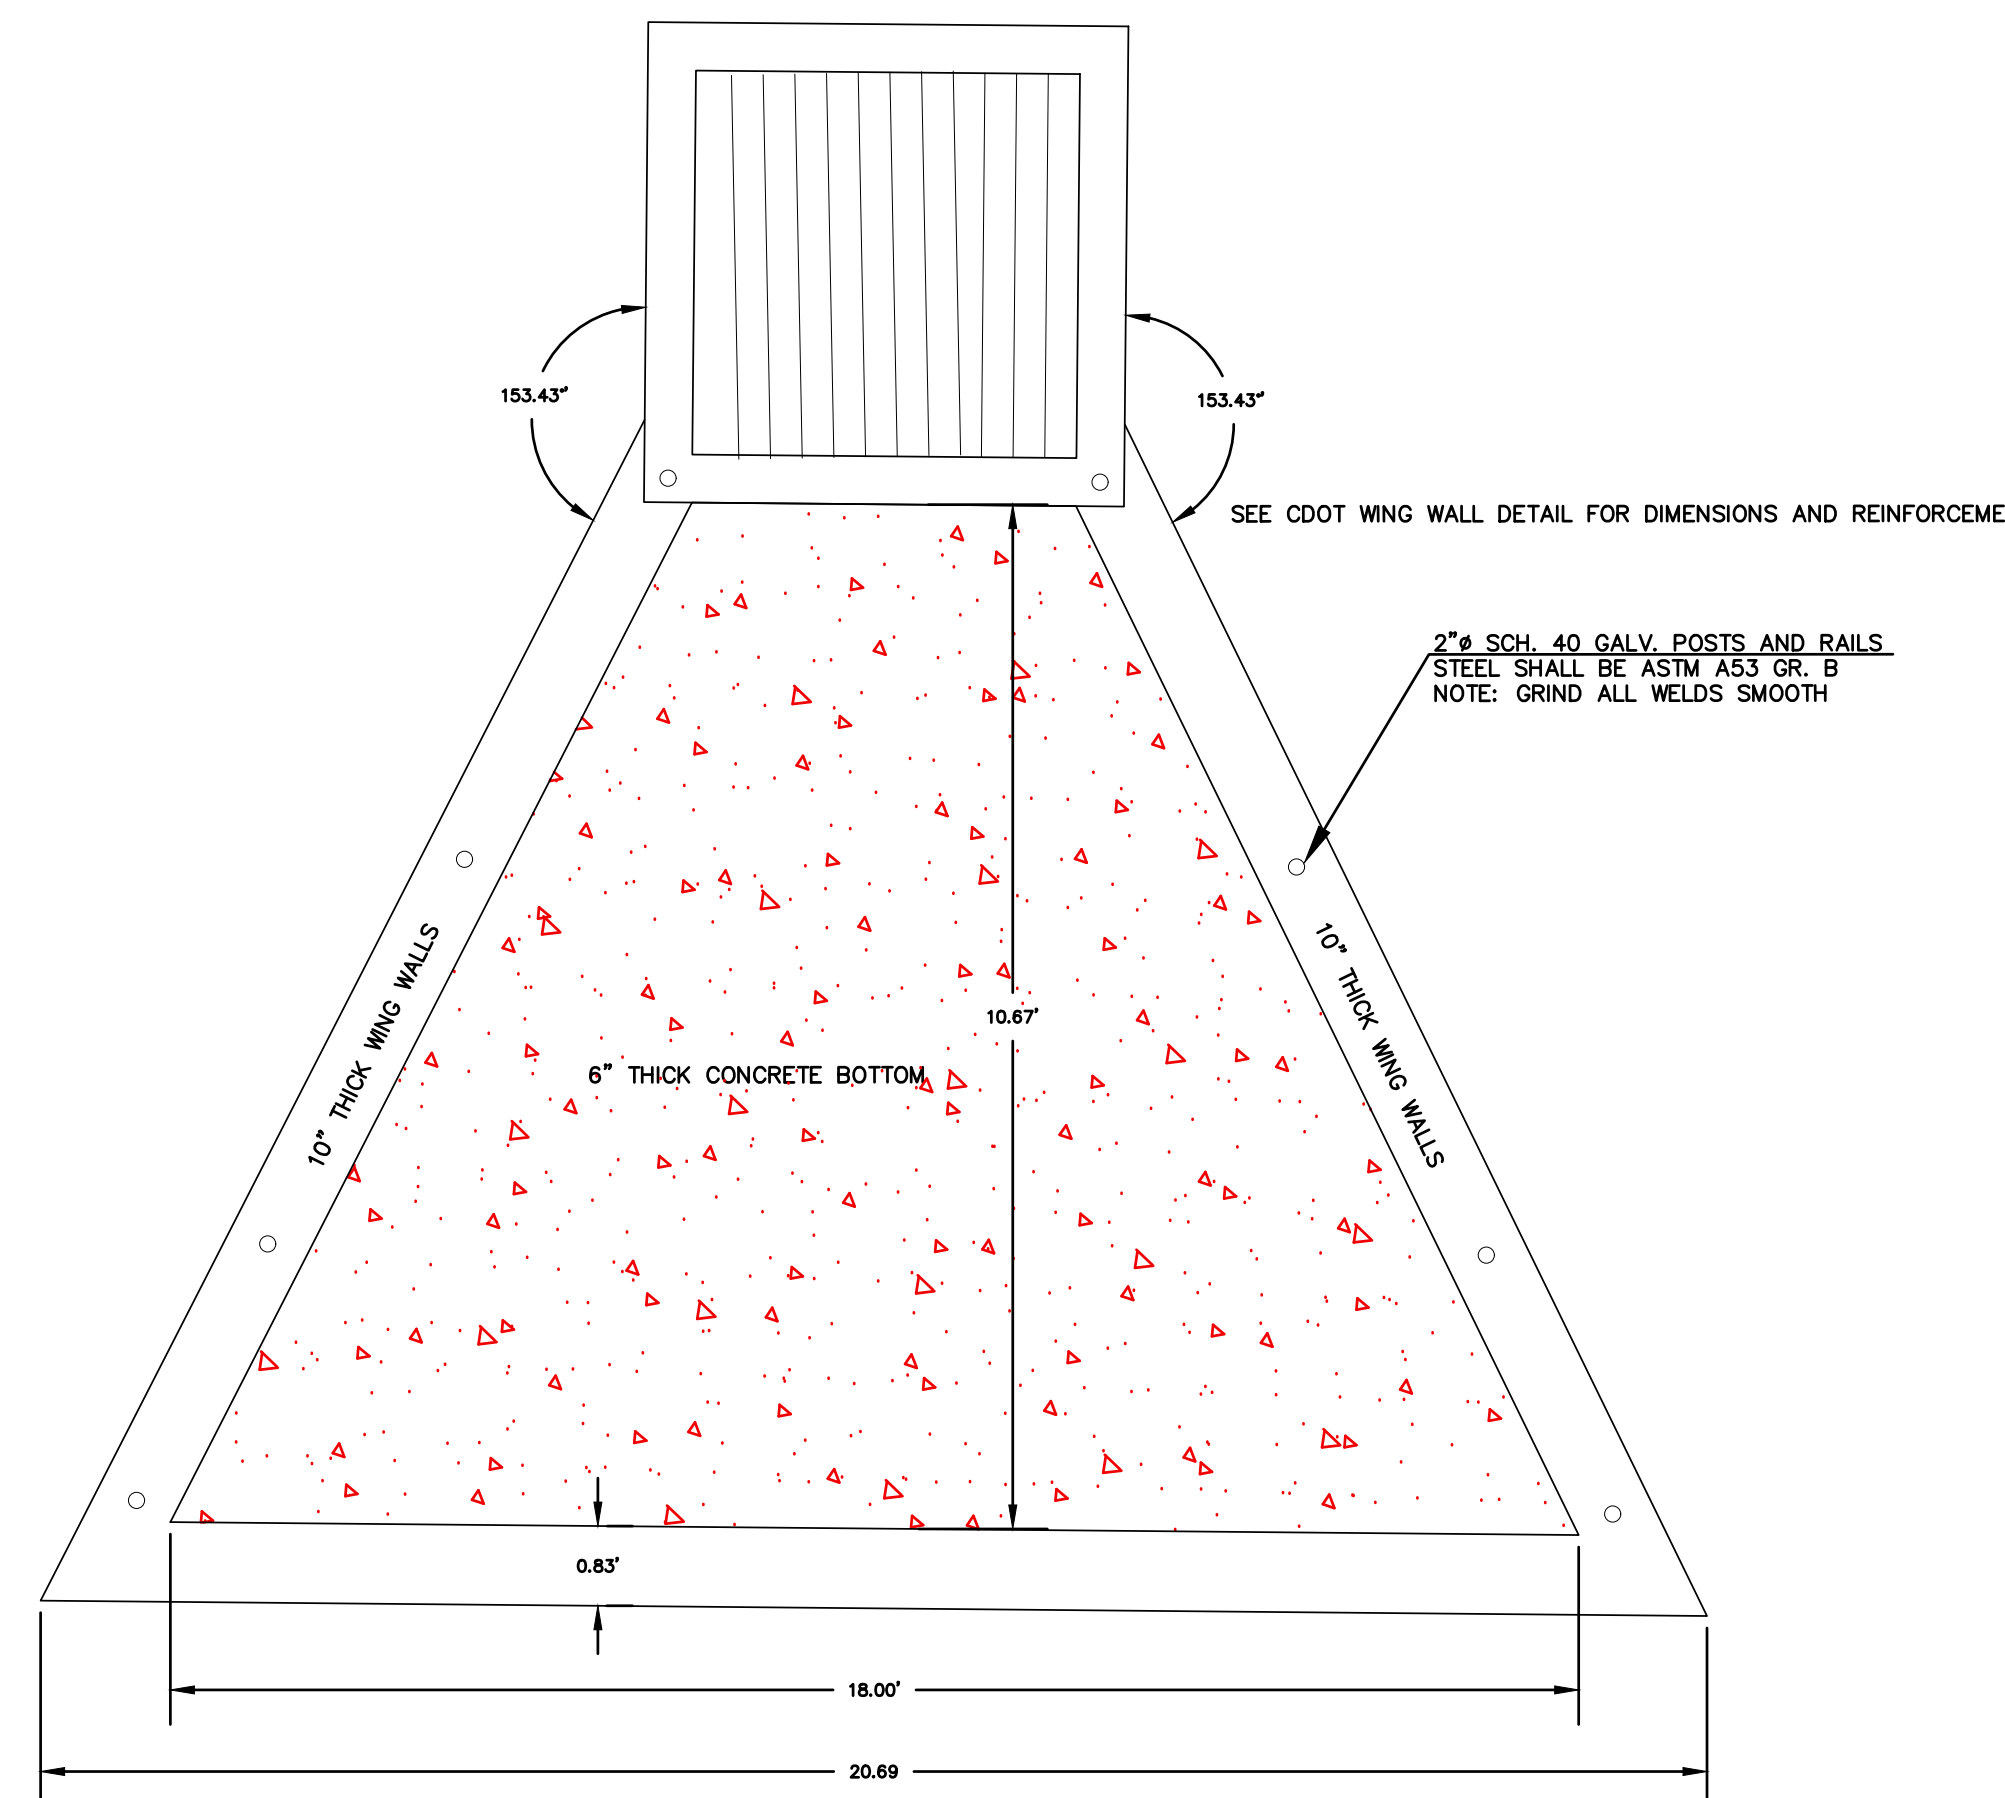

**CONCRETE MICROPOOL**  
SCALE: 1"=2'

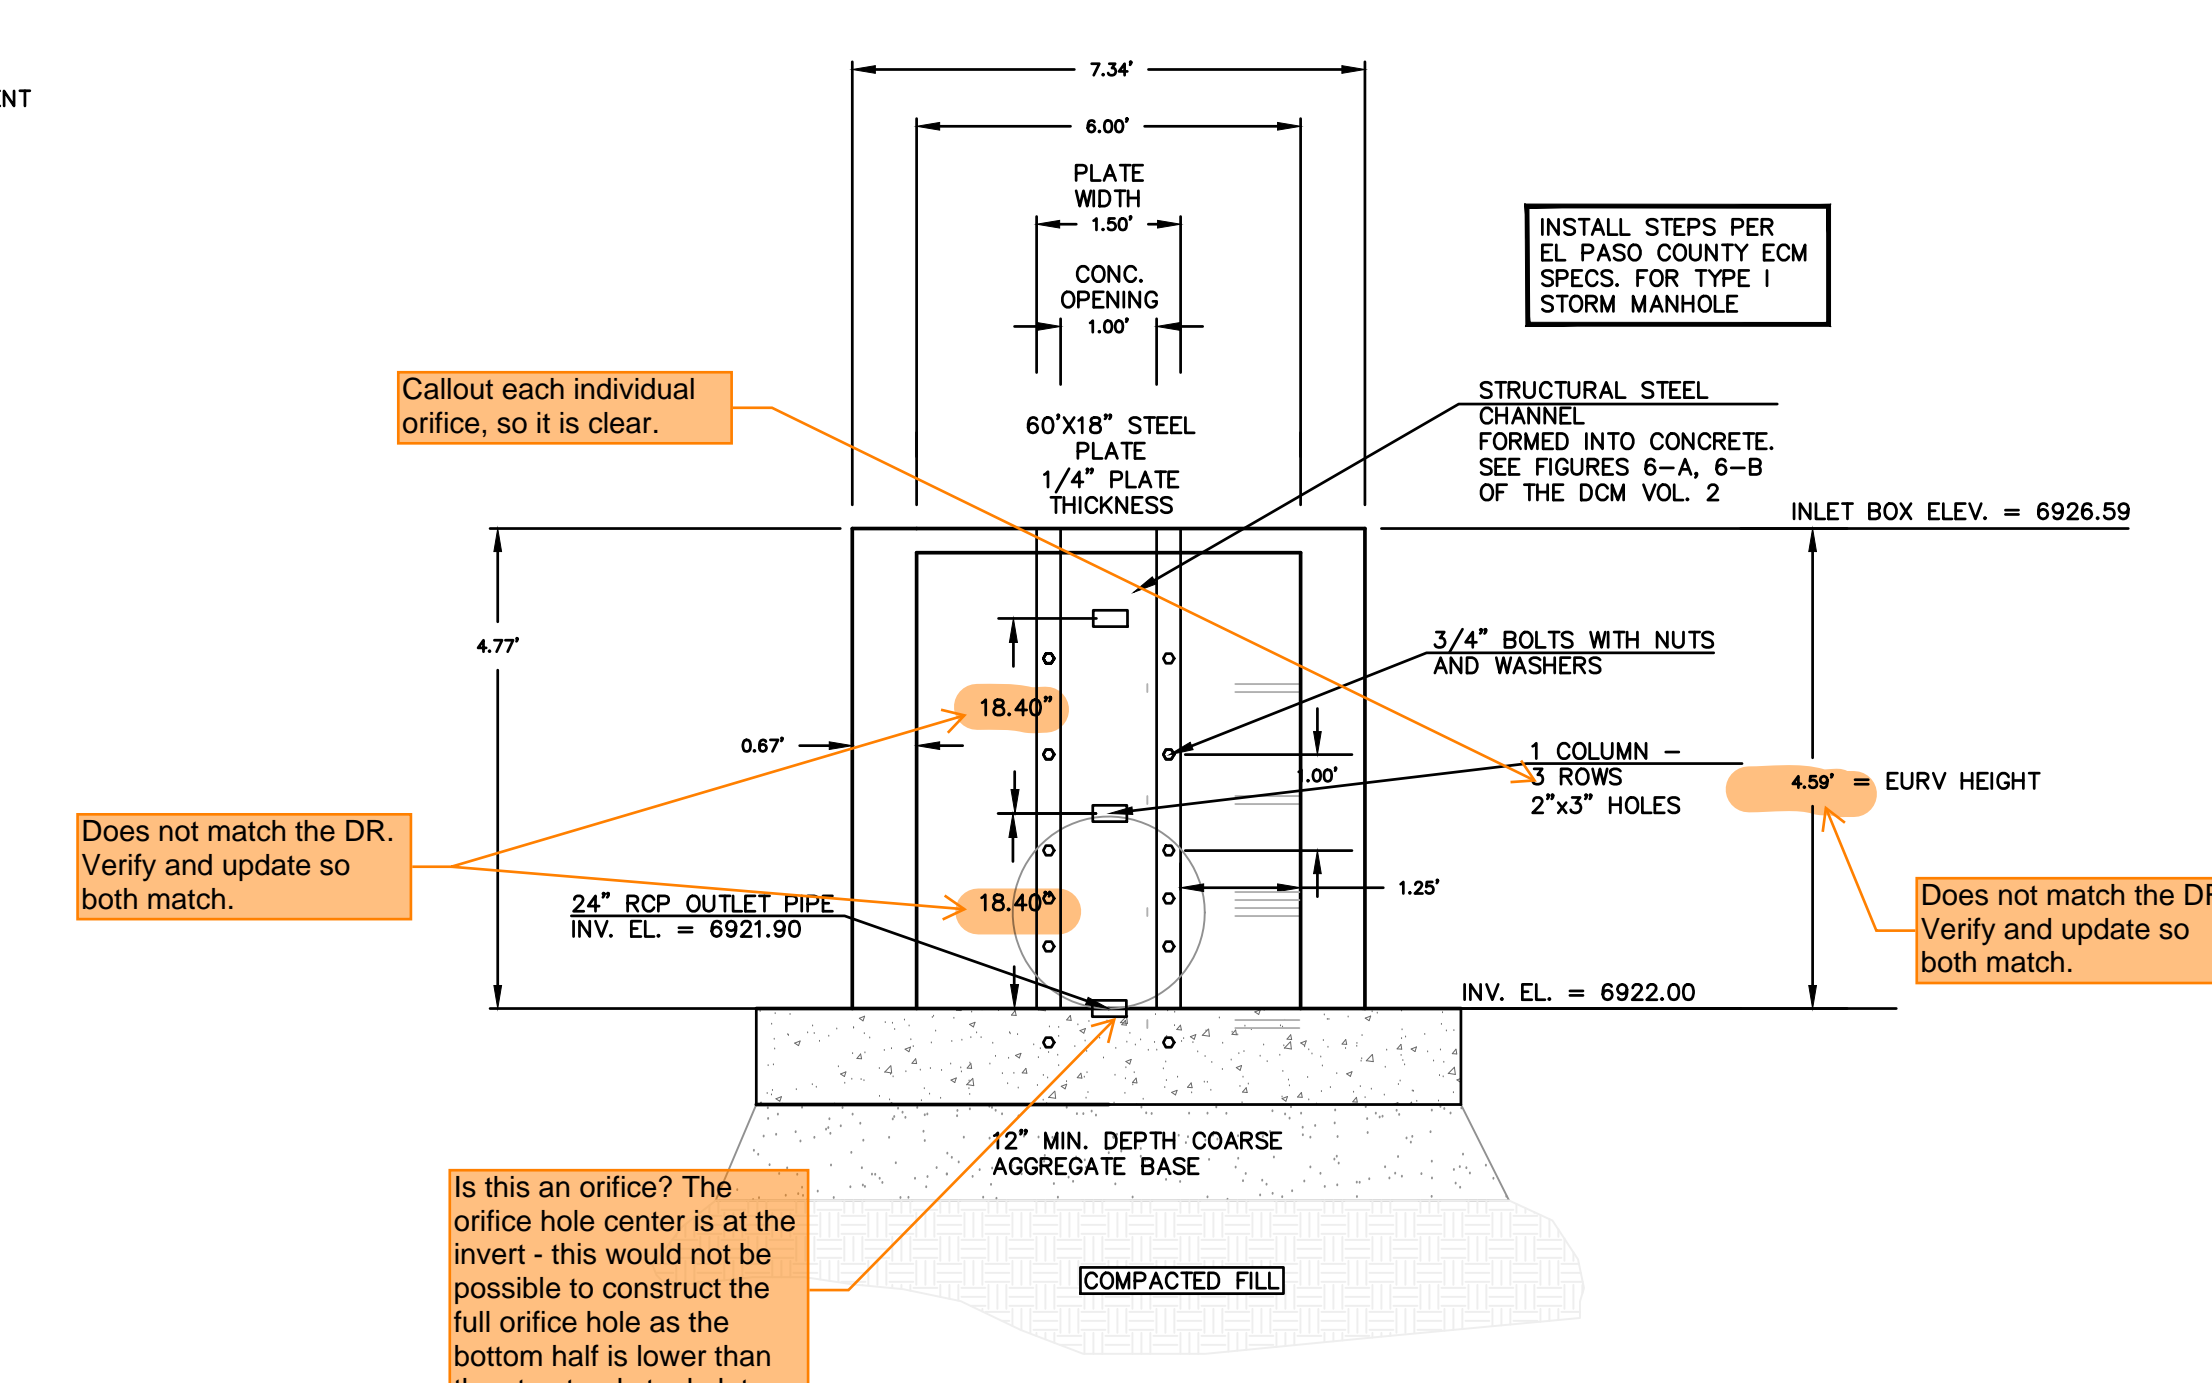

**OUTLET STRUCTURE MODIFIED TYPE 1 MH**  
SCALE: 1"=2'

DATE	
DESCRIPTION	
REVISIONS	
NO.	
UNTIL SUCH TIME AS THESE DRAWINGS ARE APPROVED BY REVIEWING AGENCIES, TERRA NOVA ENGINEERING, INC. APPROVES THEIR USE ONLY FOR THE PROJECT AND FOR THE WRITTEN AUTHORIZATION.	
PREPARED FOR:	4-WAY RANCH JOINT VENTURE
ATTN:	PETER MARTZ
	P.O. BOX 50223
	COLORADO SPRINGS, CO 80949
	719-491-3150
721 S. 23RD STREET COLORADO SPRINGS, CO 80904 OFFICE: 719-635-6422 FAX: 719-635-6426 www.tneshinc.com	
DESIGNED BY	DLF
DRAWN BY	QNA
CHECKED BY	QNA
H-SCALE	NA
V-SCALE	N/A
JOB NO.	1715.00
DATE ISSUED	2/6/23
SHEET NO.	39 OF 39

WATERBURY FILING NO. 1  
CONSTRUCTION SET  
POND 3 DETAILS