

WATERBURY FILING NO. 1

FINAL PLAT

A PORTION OF SW 1/4 SECTION 28, A PORTION OF THE SE 1/4 SECTION 29, A PORTION OF THE NW 1/4 SECTION 33, TOWNSHIP 12 SOUTH, RANGE 64 WEST OF THE SIXTH PRINCIPAL MERIDIAN, EL PASO COUNTY, COLORADO

PLEASE BE AWARE that since 4-Way Ranch Metropolitan District No. 2 has changed its name to Waterbury Metropolitan District No. 1, ALL documents and agreements referencing 4-Way Ranch Metropolitan District No. 2 will need to be updated to Waterbury Metropolitan District No. 1. I made several comments on the plat regarding this, but I recommend that you double-check for all instances to ensure we do not need additional corrections on a subsequent submital.

KNOW ALL MEN BY THESE PRESENTS:

THAT ACM ALF VIII JV SUB II, LLC BEING THE OWNER OF THE FOLLOWING DESCRIBED TRACT OF LAND, TO WIT:

LEGAL DESCRIPTION:

A PARCEL OF LAND BEING A PORTION OF SOUTHWEST QUARTER OF SECTION 28, A PORTION OF THE SOUTHEAST QUARTER OF SECTION 29, AND A PORTION OF THE NORTHWEST QUARTER OF SECTION 33, TOWNSHIP 12 SOUTH, RANGE 64 WEST OF THE SIXTH PRINCIPAL MERIDIAN, EL PASO COUNTY, COLORADO, BEING MORE PARTICULARLY DESCRIBED AS FOLLOWS:

BASIS OF BEARINGS: THE NORTH LINE OF SECTION 28, TOWNSHIP 12 SOUTH, RANGE 64 WEST OF THE SIXTH PRINCIPAL MERIDIAN, EL PASO COUNTY, COLORADO, BEING MONUMENTED AT EACH END BY A 3-1/4" ALUMINUM SURVEYOR'S CAP STAMPED "PSINC LS 30087" AND ASSUMED TO BEAR S89°47'04"E A DISTANCE OF 5,285.07 FEET.

COMMENCING AT THE SOUTHEASTERLY CORNER OF LOT 15 AS PLATTED IN 4 WAY RANCH FILING NO. 1, RECORDED UNDER RECEPTION NO. 206712416, RECORDS OF EL PASO COUNTY, COLORADO, SAID POINT BEING ON THE WESTERLY RIGHT OF WAY LINE OF STAPLETON DRIVE AS DESCRIBED IN THE DOCUMENT RECORDED UNDER RECEPTION NO. 212064630; THENCE N01°31'24"E, ON THE EASTERLY BOUNDARY OF SAID LOT 15 AND THE SAID WESTERLY RIGHT-OF-WAY LINE, A DISTANCE OF 5.63 FEET TO A POINT ON THE NORTHERLY RIGHT OF WAY LINE OF SAID STAPLETON ROAD SAID POINT BEING THE POINT OF BEGINNING;

THENCE ON THE EASTERLY BOUNDARY OF SAID 4 WAY RANCH FILING NO. 1, THE FOLLOWING TWELVE (12) COURSES:

- N01°31'24"E, A DISTANCE OF 230.23 FEET;
- N01°58'45"E, A DISTANCE OF 267.96 FEET;
- N38°56'07"E, A DISTANCE OF 145.18 FEET;
- N28°06'29"W, A DISTANCE OF 415.84 FEET;
- N40°37'02"W, A DISTANCE OF 70.00 FEET TO A POINT ON CURVE;
- ON THE ARC OF CURVE TO THE LEFT WHOSE CENTER BEARS S40°37'02"E, HAVING A DELTA OF 02°07'07", A RADIUS OF 1,135.00 FEET, A DISTANCE OF 41.97 FEET TO A POINT ON CURVE;
- N44°30'10"W, A DISTANCE OF 104.01 FEET TO A POINT OF CURVE;
- ON THE ARC OF CURVE TO THE RIGHT, HAVING A DELTA OF 21°00'17", A RADIUS OF 565.00 FEET, A DISTANCE OF 207.13 FEET TO A POINT OF TANGENT;
- N23°29'53"W, A DISTANCE OF 586.57 FEET TO A POINT OF CURVE;
- ON THE ARC OF A CURVE TO THE RIGHT HAVING A DELTA OF 41°24'35", A RADIUS OF 40.00 FEET AND A DISTANCE OF 28.91 FEET TO A POINT OF REVERSE CURVE;
- ON THE ARC OF A CURVE TO THE LEFT HAVING A DELTA OF 08°17'54", A RADIUS OF 60.00 FEET, A DISTANCE OF 102.94 FEET TO A POINT ON CURVE;
- N09°36'47"E, A DISTANCE OF 181.35 FEET;

THENCE S84°51'41"E, A DISTANCE OF 156.95 FEET, THENCE N81°05'30"E, A DISTANCE OF 114.50 FEET, THENCE N08°54'30"W, A DISTANCE OF 13.30 FEET TO A POINT OF CURVE, THENCE ON THE ARC OF A CURVE TO THE LEFT, HAVING A DELTA OF 00°22'06", A RADIUS OF 475.00 FEET, A DISTANCE OF 3.05 FEET TO A POINT ON CURVE, THENCE N80°43'23"E, A DISTANCE OF 60.00 FEET, THENCE S89°55'20"E, A DISTANCE OF 118.82 FEET, THENCE S09°08'33"E, A DISTANCE OF 24.43 FEET, THENCE N89°59'53"E, A DISTANCE OF 125.65 FEET TO A POINT ON CURVE, THENCE ON THE ARC OF A CURVE TO THE RIGHT WHOSE CENTER BEARS N89°59'53"E, HAVING A DELTA OF 01°10'07", A RADIUS OF 225.00 FEET, A DISTANCE OF 4.59 FEET TO A POINT OF TANGENT, THENCE N01°10'00"E, A DISTANCE OF 22.47 FEET, THENCE S88°50'00"E, A DISTANCE OF 50.00 FEET, THENCE N89°55'04"E, A DISTANCE OF 152.16 FEET, THENCE N00°04'56"W, A DISTANCE OF 30.14 FEET, THENCE S88°19'00"E, A DISTANCE OF 201.01 FEET, THENCE S01°45'00"W, A DISTANCE OF 27.39 FEET, THENCE S88°39'59"E, A DISTANCE OF 70.97 FEET, THENCE N68°36'47"E, A DISTANCE OF 62.85 FEET, THENCE N85°20'20"E, A DISTANCE OF 62.25 FEET, THENCE N62°33'4"E, A DISTANCE OF 62.25 FEET, THENCE N59°57'58"E, A DISTANCE OF 65.50 FEET, THENCE S32°58'22"E, A DISTANCE OF 124.73 FEET TO A POINT ON CURVE, THENCE ON THE ARC OF A CURVE TO THE LEFT WHOSE CENTER BEARS N32°58'22"W, HAVING A DELTA OF 08°00'18", A RADIUS OF 1,225.00 FEET, A DISTANCE OF 171.15 FEET TO A POINT ON CURVE, THENCE S41°02'14"E, A DISTANCE OF 144.45 FEET, THENCE S34°05'25"E, A DISTANCE OF 72.65 FEET, THENCE S30°56'30"E, A DISTANCE OF 81.87 FEET, THENCE S21°08'32"E, A DISTANCE OF 89.56 FEET, THENCE S19°08'47"E, A DISTANCE OF 73.79 FEET, THENCE S03°18'02"W, A DISTANCE OF 205.74 FEET, THENCE S17°29'03"E, A DISTANCE OF 124.83 FEET, THENCE S18°09'50"E, A DISTANCE OF 50.00 FEET, THENCE S16°07'17"E, A DISTANCE OF 73.88 FEET, THENCE S27°50'37"E, A DISTANCE OF 65.16 FEET, THENCE S25°07'25"E, A DISTANCE OF 66.02 FEET, THENCE S22°21'31"E, A DISTANCE OF 66.20 FEET, THENCE S19°54'11"E, A DISTANCE OF 51.22 FEET, THENCE S16°26'35"E, A DISTANCE OF 114.20 FEET, THENCE S21°00'38"E, A DISTANCE OF 85.08 FEET TO A POINT ON THE BOUNDARY LINE OF THE PARCEL DESCRIBED IN THE WARRANTY DEED RECORDED UNDER RECEPTION NUMBER 21400773, RECORDS OF EL PASO COUNTY, COLORADO; THENCE S00°00'00"E ON SAID BOUNDARY LINE, A DISTANCE OF 472.54 FEET TO A POINT ON CURVE, SAID POINT BEING ON THE NORTHERLY RIGHT-OF-WAY LINE OF STAPLETON DRIVE AS DESCRIBED IN THE DOCUMENT RECORDED UNDER RECEPTION NO. 212064630; THENCE ON SAID RIGHT-OF-WAY LINE THE FOLLOWING TWO (2) COURSES:

- ON THE ARC OF A CURVE TO THE LEFT WHOSE CENTER BEARS S00°23'33"W, HAVING A DELTA OF 26°14'01", A RADIUS OF 1,405.00 FEET, A DISTANCE OF 643.30 FEET TO A POINT OF TANGENT;
- S64°09'32"W, A DISTANCE OF 777.32 FEET TO THE POINT OF BEGINNING.

CONTAINING A CALCULATED AREA OF 2,694,934 SQUARE FEET OR 61.867 ACRES.

OWNER'S CERTIFICATE:

THE UNDERSIGNED, BEING ALL THE OWNERS, MORTGAGEES, BENEFICIARIES OF DEEDS OF TRUST AND HOLDERS OF OTHER INTERESTS IN THE LAND DESCRIBED HEREIN, HAVE LAID OUT, SUBDIVIDED, AND PLATTED SAID LANDS INTO LOTS, TRACTS, STREETS, AND EASEMENTS AS SHOWN HEREON UNDER THE NAME AND SUBDIVISION OF WATERBURY FILING NO. 1, ALL PUBLIC IMPROVEMENTS SO PLATTED ARE HEREBY DEDICATED TO PUBLIC USE AND SAID OWNER DOES HEREBY COVENANT AND AGREE THAT THE PUBLIC IMPROVEMENTS WILL BE CONSTRUCTED TO EL PASO COUNTY STANDARDS AND THAT PROPER DRAINAGE AND EROSION CONTROL FOR SAME WILL BE PROVIDED AT SAID OWNER'S EXPENSE, ALL TO THE SATISFACTION OF THE BOARD OF COUNTY COMMISSIONERS OF EL PASO COUNTY, COLORADO, UPON ACCEPTANCE BY RESOLUTION, ALL PUBLIC IMPROVEMENTS SO DEDICATED WILL BECOME MATTERS OF MAINTENANCE BY EL PASO COUNTY, COLORADO. THE UTILITY EASEMENTS SHOWN HEREON ARE HEREBY DEDICATED FOR PUBLIC UTILITIES AND COMMUNICATION SYSTEMS AND OTHER PURPOSES AS SHOWN HEREON. THE ENTITIES RESPONSIBLE FOR PROVIDING THE SERVICES FOR WHICH THE EASEMENTS ARE ESTABLISHED ARE HEREBY GRANTED THE PERPETUAL RIGHT OF INGRESS AND EGRESS FROM AND TO ADJACENT PROPERTIES FOR INSTALLATION, MAINTENANCE, AND REPLACEMENT OF UTILITY LINES AND RELATED FACILITIES.

OWNERS:
BY:
OWNER ACM ALF VIII JV SUB II, LLC

STATE OF COLORADO)
) SS
COUNTY OF EL PASO)
ACKNOWLEDGED BEFORE ME THIS ___ DAY OF ___, 20__ BY ___ AS _____
MY COMMISSION EXPIRES: _____

WITNESS MY HAND AND OFFICIAL SEAL
NOTARY PUBLIC
SIGNATURES OF OFFICERS SIGNING FOR A CORPORATION SHALL BE ACKNOWLEDGED AS FOLLOWS:
____ AS _____ ACM ALF VIII JV SUB II, LLC

ACCEPTANCE CERTIFICATE FOR TRACTS (ACCEPTING ENTITY IN EXISTENCE):


THE DEDICATION OF TRACTS A, B, C, D, E, F, G, H, I, J AND K ARE HEREBY ACCEPTED FOR OWNERSHIP AND MAINTENANCE BY THE 4 WAY RANCH METROPOLITAN DISTRICT NO. 2.

BY: _____

PRESIDENT
STATE OF COLORADO)
) SS
COUNTY OF EL PASO)
ACKNOWLEDGED BEFORE ME THIS ___ DAY OF ___, 20__ A.D., BY ___ AS _____
WITNESS MY HAND AND OFFICIAL SEAL: _____
MY COMMISSION EXPIRES: _____ NOTARY PUBLIC

NOTICE:

ACCORDING TO COLORADO LAW YOU MUST COMMENCE ANY LEGAL ACTION BASED UPON ANY DEFECT IN THIS SURVEY WITHIN THREE YEARS AFTER YOU FIRST DISCOVER SUCH DEFECT. IN NO EVENT MAY ANY ACTION BASED UPON ANY DEFECT IN THIS SURVEY BE COMMENCED MORE THAN TEN YEARS FROM THE DATE OF THE CERTIFICATION SHOWN HEREON.

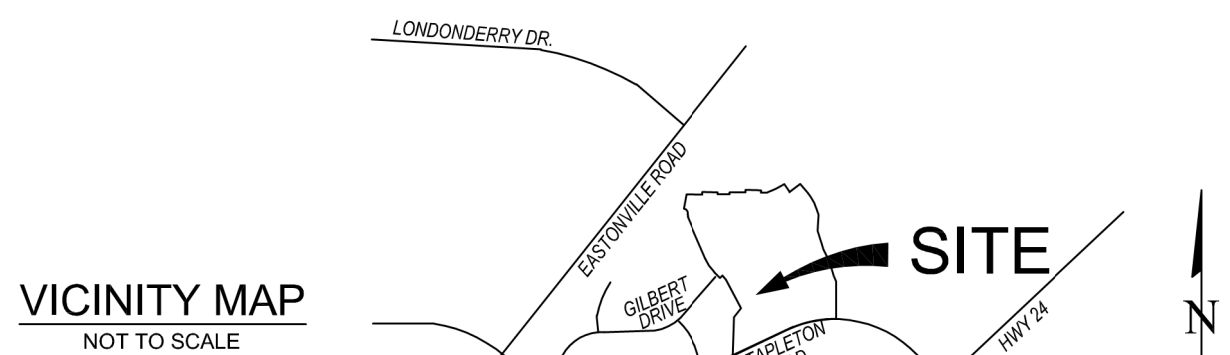

GENERAL NOTES:

- THE DATE OF PREPARATION IS DECEMBER 29, 2022.
- ANY PERSON WHO KNOWINGLY REMOVES, ALTERS OR DEFACTS ANY PUBLIC LAND SURVEY MONUMENT OR LAND MONUMENT OR ACCESSORY, COMMITS A CLASS TWO (2) MISDEMEANOR PURSUANT TO STATE STATUTE 18-4-508, C.R.S.
- THE BASIS OF BEARINGS IS THE NORTH LINE OF SECTION 28, TOWNSHIP 12 SOUTH, RANGE 64 WEST OF THE SIXTH PRINCIPAL MERIDIAN, EL PASO COUNTY, COLORADO, BEING MONUMENTED AT EACH END BY A 3-1/4" ALUMINUM SURVEYOR'S CAP STAMPED "PSINC LS 30087" AND ASSUMED TO BEAR S89°47'04"E A DISTANCE OF 5,285.07 FEET.
- UNLESS OTHERWISE INDICATED, THE FOLLOWING EASEMENTS ARE HEREBY PLATTED:
ALL SIDE, FRONT, AND REAR LOT LINES ARE HEREBY PLATTED ON BOTH SIDES WITH A 5 FOOT PUBLIC UTILITY AND DRAINAGE EASEMENT UNLESS OTHERWISE INDICATED. THE SOLE RESPONSIBILITY FOR MAINTENANCE OF THESE EASEMENTS IS HEREBY VESTED WITH THE INDIVIDUAL PROPERTY OWNERS.
ALL FRONT LOT LINES ARE HEREBY PLATTED WITH A 10 FOOT UTILITY EASEMENT FOR MOUNTAIN VIEW ELECTRIC ASSOCIATION
- THE FOLLOWING REPORTS HAVE BEEN SUBMITTED IN ASSOCIATION WITH THE PRELIMINARY PLAN OR FINAL PLAN FOR THIS SUBDIVISION AND ARE ON FILE AT THE COUNTY PLANNING AND COMMUNITY DEVELOPMENT DEPARTMENT: TRANSPORTATION IMPACT STUDY; DRAINAGE REPORT; WATER RESOURCES REPORT; WASTEWATER DISPOSAL REPORT; GEOLOGY AND SOILS REPORT; FIRE PROTECTION REPORT; WILDFIRE HAZARD REPORT; NATURAL FEATURES REPORT;
- FIRE PROTECTION BY FALCON FIRE PROTECTION DISTRICT.
- TRACT OWNERSHIP MAINTENANCE:
ALL TRACTS A-K ARE TO BE OWNED AND MAINTAINED BY THE 4 WAY RANCH METROPOLITAN DISTRICT NO. 2. TRACTS INCLUDE LANDSCAPE EASEMENTS, DRAINAGE TRACTS, STREETS/SCAPE PLANTINGS, DETENTION PONDS, UTILITIES, FENCES, PARKS AND RECREATIONAL FACILITIES, PEDESTRIAN TRAILS, AND MAIL BOX CLUSTERS.
- NO DRIVEWAY SHALL BE ESTABLISHED UNLESS AN ACCESS PERMIT HAS BEEN GRANTED BY EL PASO COUNTY.
- TOTAL NUMBER OF LOTS PLATTED WITH THIS SUBDIVISION: 198
TOTAL NUMBER OF TRACTS PLATTED WITH THIS SUBDIVISION: 11.
- ADDRESSES EXHIBITED ON THIS PLAT ARE FOR INFORMATIONAL PURPOSES ONLY. THEY ARE NOT THE LEGAL DESCRIPTION AND ARE SUBJECT TO CHANGE.
- ALL PROPERTY WITHIN THIS SUBDIVISION IS INCLUDED IN THE 4-WAY RANCH METROPOLITAN DISTRICT BY INSTRUMENTS RECORDED UNDER RECEPTION NO. 205142010, 205191721, 210038875 AND 212092504.
- CENTRAL WATER SERVICES TO BE SUPPLIED BY WOODMEN HILL METROPOLITAN DISTRICT. ALL FUTURE OWNERS OF LOTS WITHIN THIS FILING SHALL BE ADVISED OF, AND COMPLY WITH, THE CONDITIONS, RULES, REGULATIONS, AND SPECIFICATIONS SET BY THE DISTRICT.
- WASTE WATER COLLECTION SERVICES TO BE PROVIDED BY GRANDVIEW RESERVE METROPOLITAN DISTRICT IN AGREEMENT WITH CHEROKEE METROPOLITAN DISTRICT.
- ALL PROPERTY OWNERS ARE RESPONSIBLE FOR MAINTAINING PROPER STORM WATER DRAINAGE IN AND THROUGH THEIR PROPERTY. PUBLIC DRAINAGE EASEMENTS AS SPECIFICALLY NOTED ON THE PLAT SHALL BE MAINTAINED BY THE INDIVIDUAL LOT OWNERS UNLESS OTHERWISE INDICATED. HOMEBUILDERS ARE RESPONSIBLE TO ENSURE PROPER DRAINAGE AROUND STRUCTURES, INCLUDING ELEVATIONS OF FOUNDATIONS AND WINDOW WELLS IN RELATION TO SIDE-LOT DRAINAGE EASEMENTS AND SWALES. HOMEOWNERS SHALL NOT CHANGE THE GRADE OF THE LOT OR DRAINAGE SWALES WITHIN SAID EASEMENTS, AS CONSTRUCTED BY THE BUILDER, IN A MANNER THAT WOULD CAUSE ADVERSE DRAINAGE IMPACTS TO PROPERTIES, STRUCTURES, FENCES, MATERIALS OR LANDSCAPING THAT COULD IMPEDE THE FLOW OF RUNOFF SHALL NOT BE PLACED IN DRAINAGE EASEMENTS.
- MAILBOXES SHALL BE INSTALLED IN ACCORDANCE WITH ALL EL PASO COUNTY DEPARTMENT OF TRANSPORTATION AND THE UNITED STATE POSTAL SERVICE REGULATIONS.
- NO LOT OR INTEREST THEREIN, SHALL BE SOLD, CONVEYED, OR TRANSFERRED WHETHER BY DEED OR BY CONTRACT, NOR SHALL BUILDING PERMITS BE ISSUED, UNTIL AND UNLESS EITHER THE REQUIRED PUBLIC AND COMMON DEVELOPMENT IMPROVEMENTS HAVE BEEN CONSTRUCTED AND COMPLETED AND PRELIMINARILY ACCEPTED IN ACCORDANCE WITH THE SUBDIVISION IMPROVEMENTS AGREEMENT BETWEEN THE APPLICANT/OWNER AND EL PASO COUNTY AS RECORDED UNDER RECEPTION NUMBER _____ IN THE OFFICE OF THE CLERK AND RECORDER OF EL PASO COUNTY, COLORADO OR, IN THE ALTERNATIVE, OTHER COLLATERAL IS PROVIDED TO MAKE PROVISION FOR THE COMPLETION OF SAID IMPROVEMENTS IN ACCORDANCE WITH THE EL PASO COUNTY LAND DEVELOPMENT CODE AND ENGINEERING CRITERIA MANUAL. ANY SUCH ALTERNATIVE COLLATERAL MUST BE APPROVED BY THE BOARD OF COUNTY COMMISSIONERS OR, IF PERMITTED BY THE SUBDIVISION IMPROVEMENTS AGREEMENT, BY THE PLANNING AND COMMUNITY DEVELOPMENT DEPARTMENT DIRECTOR AND MEET THE POLICY AND PROCEDURE REQUIREMENTS OF EL PASO COUNTY PRIOR TO THE RELEASE BY THE COUNTY OF ANY LOTS FOR SALE, CONVEYANCE OR TRANSFER.
- NO STREET PARKING ALONG FRONTAGE OF LOTS 1, 2, 11, 20, 21 AND 187.
- DRIVEWAYS FOR LOTS 1, 2, 21, 181, 186, AND 187 SHALL BE LOCATED AT THE FARTHEST POINT FROM THE ROUNDABOUT AS SHOWN ON THE APPROVED CONSTRUCTION DRAWINGS EL PASO COUNTY FILE NO. SF 237.
- NO STRUCTURES OR FENCES ARE PERMITTED WITHIN DESIGNATED "FLOODPLAIN" OR "PARK AND OPEN SPACE" AREAS. THIS PROPERTY IS LOCATED WITHIN A DESIGNATED FEMA FLOODPLAIN AS DETERMINED BY THE FLOOD INSURANCE RATE MAP, COMMUNITY MAP NUMBER 080410052G, EFFECTIVE DATE DECEMBER 7, 2018 (MODIFICATION WHEN LOMR IS HIGHLIGHTED AND AS AMENDED BY THE FEMA APPROVED LETTER OF MAP REVISION (LOMR) CASE NUMBER _____ DATED _____. NO STRUCTURES ARE PERMITTED WITHIN THE DESIGNATED FLOODPLAIN AREAS.
- NO STRUCTURES OR FENCES ARE PERMITTED WITHIN DESIGNATED "FLOODPLAIN" OR "PARK AND OPEN SPACE" AREAS. THIS PROPERTY IS LOCATED WITHIN A DESIGNATED FEMA FLOODPLAIN AS DETERMINED BY THE FLOOD INSURANCE RATE MAP, COMMUNITY MAP NUMBER 080410052G, EFFECTIVE DATE DECEMBER 7, 2018. NO STRUCTURES ARE PERMITTED WITHIN THE DESIGNATED FLOODPLAIN AREAS.
THE PARCEL HAS EXPOSURE TO ZONE A FLOODPLAIN. DRAFT MODEL BACKED FLOODPLAIN EXTENTS FOR THIS AREA HAVE BEEN DEVELOPED AS PART OF PHASE 1 FOR THE ONGOING EL PASO COUNTY, CO. RISK MAP PROJECT. THE DATA HAS BEEN REVIEWED AND APPROVED THROUGH FEMA'S OIA/C PROCESS (MAY 11, 2022) AND IS CURRENTLY IN THE MIP (CASE NO. 19-08-0037S). BASE FLOOD ELEVATIONS SHOWN ON THE PLAT HAVE BEEN DEVELOPED FROM THE AFOREMENTIONED FEMA APPROVED STUDY, ALONG WITH SITE SURVEY, USING A "NO-RISE CERTIFICATION" OUTLINED IN THE FEMA TECHNICAL BULLETIN, MANAGING FLOODPLAIN DEVELOPMENT IN ZONE A AREAS. A FEMA SUPPLIED DUPLICATE EFFECTIVE MODEL WAS TAKEN AND REVISED TO A CORRECTED EFFECTIVE MODEL AND SUBSEQUENTLY A PROPOSED/POST PROJECT CONDITIONS MODEL WAS CREATED TO ESTABLISH THE BASE FLOOD ELEVATIONS SHOWN ON THE PLAT. BOTH THE FEMA APPROVED RISK MAP EXTENTS AND THE FEMA APPROVED CURRENT EFFECTIVE EXTENTS ARE SHOWN.

TRACT NO.	AREA	USE/ALLOWED STRUCTURES	OWNER/MAINTENANCE
A	1.009 AC	LANDSCAPE EASEMENTS, DRAINAGE TRACTS, OPEN SPACE TRACTS, STREETS/SCAPE PLANTINGS, UTILITIES, FENCES, PEDESTRIAN TRAILS, AND MAILBOX CLUSTER	4 WAY RANCH METROPOLITAN DISTRICT NO. 2
B	3.464 AC	LANDSCAPE EASEMENTS, DRAINAGE TRACTS, STORMWATER FACILITIES, OPEN SPACE TRACTS, STREETS/SCAPE PLANTINGS, DETENTION POND, UTILITIES, FENCES, PEDESTRIAN TRAILS, AND MAILBOX CLUSTERS, POND	4 WAY RANCH METROPOLITAN DISTRICT NO. 2
C	0.102 AC	LANDSCAPE EASEMENTS, DRAINAGE TRACTS, STORMWATER FACILITIES, OPEN SPACE TRACTS, STREETS/SCAPE PLANTINGS, UTILITIES, FENCES, PARKS AND RECREATIONAL FACILITIES, PEDESTRIAN TRAILS, AND MAILBOX CLUSTERS	4 WAY RANCH METROPOLITAN DISTRICT NO. 2
D	4.510 AC	LANDSCAPE EASEMENTS, DRAINAGE TRACTS, OPEN SPACE TRACTS, STREETS/SCAPE PLANTINGS, UTILITIES, FENCES, PEDESTRIAN TRAILS, AND MAILBOX CLUSTERS	4 WAY RANCH METROPOLITAN DISTRICT NO. 2
E	2.571 AC	LANDSCAPE EASEMENTS, DRAINAGE TRACTS, STORMWATER FACILITIES, OPEN SPACE TRACTS, STREETS/SCAPE PLANTINGS, FENCES, PARKS AND RECREATIONAL FACILITIES, PEDESTRIAN TRAILS, AND MAILBOX CLUSTERS	4 WAY RANCH METROPOLITAN DISTRICT NO. 2
F	0.073 AC	LANDSCAPE EASEMENTS, DRAINAGE TRACTS, STORMWATER FACILITIES, OPEN SPACE TRACTS, STREETS/SCAPE PLANTINGS, FENCES, PARKS AND RECREATIONAL FACILITIES, AND PEDESTRIAN TRAILS	4 WAY RANCH METROPOLITAN DISTRICT NO. 2
G	0.287 AC	LANDSCAPE EASEMENTS, DRAINAGE TRACTS, STORMWATER FACILITIES, OPEN SPACE TRACTS, AND FENCES	4 WAY RANCH METROPOLITAN DISTRICT NO. 2
H	0.175 AC	LANDSCAPE EASEMENTS, DRAINAGE TRACTS, STORMWATER FACILITIES, OPEN SPACE TRACTS, STREETS/SCAPE PLANTINGS, FENCES, PARKS AND RECREATIONAL FACILITIES, AND PEDESTRIAN TRAILS	4 WAY RANCH METROPOLITAN DISTRICT NO. 2
I	0.787 AC	LANDSCAPE EASEMENTS, DRAINAGE TRACTS, STORMWATER FACILITIES, OPEN SPACE TRACTS, STREETS/SCAPE PLANTINGS, UTILITIES, FENCES, PARKS AND RECREATIONAL FACILITIES, PEDESTRIAN TRAILS, AND MAILBOX CLUSTERS	4 WAY RANCH METROPOLITAN DISTRICT NO. 2
J	0.050 AC	LANDSCAPE EASEMENTS, OPEN SPACE TRACTS, STREETS/SCAPE PLANTINGS, AND FENCES	4 WAY RANCH METROPOLITAN DISTRICT NO. 2
K	0.062 AC	LANDSCAPE EASEMENTS, OPEN SPACE TRACTS, STREETS/SCAPE PLANTINGS, AND FENCES	4 WAY RANCH METROPOLITAN DISTRICT NO. 2

SUMMARY:		
198 LOTS	36,987 ACRES	59.785%
11 TRACTS	13,120 ACRES	21.207%
PUBLIC RIGHT-OF-WAY	11,759 ACRES	19.007%
TOTAL	61,867 ACRES	100.000%

GROSS DENSITY: 3.2 D.U. PER ACRE

GENERAL NOTES: (CONTINUED)

- THIS PROPERTY IS SUBJECT TO A PRIVATE DETENTION BASIN/STORMWATER QUALITY BMP MAINTENANCE AGREEMENT AND EASEMENT AS RECORDED AT RECEPTION NO. _____ OF THE RECORDS OF EL PASO COUNTY, WATERBURY METROPOLITAN DISTRICT NO. 1 IS RESPONSIBLE FOR MAINTENANCE OF THE SUBJECT DRAINAGE FACILITIES.
- THIS PROPERTY IS SUBJECT TO A PRIVATE STORMWATER FACILITY MAINTENANCE AGREEMENT AND EASEMENT AS RECORDED AT RECEPTION NO. _____ OF THE RECORDS OF EL PASO COUNTY, WATERBURY METROPOLITAN DISTRICT NO. 1 RESPONSIBLE FOR MAINTENANCE OF THE SUBJECT DRAINAGE FACILITIES.
- ALL STRUCTURAL FOUNDATIONS SHALL BE LOCATED AND DESIGNED BY A PROFESSIONAL ENGINEER CURRENTLY LICENSED IN THE STATE OF COLORADO.
Board of County Commissioners
- PURSUANT TO THE PLATTED RECORD NO. 25-353, APPROVED BY THE BOARD OF DIRECTORS, EL PASO COUNTY PUBLIC IMPROVEMENT DISTRICT 4 AS DESCRIBED IN THE RECORDS OF THE EL PASO COUNTY CLERK AND RECORDER AT RECEPTION NUMBER 225108846, THE PARCELS WITHIN THE RESOLUTION BOUNDARIES OF WATERBURY FILING NO. 1, ARE INCLUDED WITHIN THE BOUNDARIES OF THE EL PASO COUNTY PUBLIC IMPROVEMENT DISTRICT 4 AND AS SUCH IS SUBJECT TO APPLICABLE ROAD IMPACT FEES AND MILL LEVY.
- THERE SHALL BE NO DIRECT LOT ACCESS TO STAPLETON ROAD.
- THIS PLAT DOES NOT CONSTITUTE A TITLE SEARCH BY EDWARD-JAMES SURVEYING, INC. TO DETERMINE OWNERSHIP OF THIS TRACT, VERIFY THE DESCRIPTION SHOWN, VERIFY THE COMPATIBILITY OF THIS DESCRIPTION WITH THAT OF ADJACENT TRACTS, OR VERIFY EASEMENTS OF RECORD. FOR ALL INFORMATION REGARDING EASEMENTS, RIGHT-OF-WAY, OR TITLE OF RECORD, EDWARD-JAMES SURVEYING, INC. RELIED UPON ORDER NUMBER SC550589017-2-2, PREPARED BY LAND TITLE GUARANTEE COMPANY WITH AN EFFECTIVE DATE OF JANUARY 6, 2023 AT 5:00 P.M.
- THE LINEAR UNIT OF MEASURE IS THE U.S. SURVEY FOOT.
- THIS SUBDIVISION IS SURROUNDED BY AGRICULTURAL LAND. PROPERTY OWNERS MAY BE IMPACTED BY SOUNDS, SMELLS AND/OR ACTIVITIES ASSOCIATED WITH ACTIVE AGRICULTURAL PRACTICES. PURSUANT TO ARTICLE 3.5, TITLE 35, C.R.S., IT IS THE DECLARED POLICY OF THE STATE OF COLORADO TO ENCOURAGE THE DEVELOPMENT AND IMPROVEMENT OF ITS AGRICULTURAL LAND FOR THE PRODUCTION OF FOOD AND OTHER AGRICULTURAL PRODUCTS. COLORADO IS A "RIGHT-TO-FARM" STATE PURSUANT TO C.R.S. 35-3.5-101, ET SEQ. LANDOWNERS, RESIDENTS AND VISITORS MUST BE PREPARED TO ACCEPT THE ACTIVITIES, SIGHTS, SOUNDS, AND SMELLS OF AGRICULTURAL OPERATIONS AS A NORMAL AND NECESSARY IMPACT OF LIVING IN A COUNTY WITH A STRONG RURAL CHARACTER AND A HEALTHY AGRICULTURAL SECTOR. STATE LAW PROVIDES THAT RANCHING, FARMING, OR OTHER AGRICULTURAL ACTIVITIES AND OPERATIONS SHALL NOT BE CONSIDERED TO BE NUISANCES SO LONG AS OPERATED IN CONFORMANCE WITH THE LAW AND IN A NON-NEGULIENT MANNER. THEREFORE, ALL MUST BE PREPARED TO ENCOUNTER NOISES, ODORS, LIGHTS, MUD, DUST, SMOKE, CHEMICALS, MACHINERY ON PUBLIC ROADS, LIVESTOCK ON PUBLIC ROADS, STORAGE AND DISPOSAL OF MANURE, AND THE APPLICATION BY SPRAYING OR OTHERWISE OF CHEMICAL FERTILIZERS, SOIL AMENDMENTS, HERBICIDES, AND PESTICIDES, AND ONE OR MORE OF WHICH MAY NATURALLY OCCUR AS A PART OF LEGAL AND NON-NEGULIENT AGRICULTURAL OPERATIONS.
- GEOLOGIC HAZARD NOTE: THE FOLLOWING LOTS MAY HAVE SHALLOW GROUNDWATER CONDITIONS: 12, 13, 32-35, 43-49, 75, 88-90, 93-95, 107-112, AND 115-118. PER THE SOIL, GEOLOGY AND GEOLOGIC HAZARD ADDENDUM PREPARED BY ENTECH ENGINEERS, DATED FEBRUARY 2, 2022, THE DEVELOPER IS REQUIRED TO DISCLOSE THIS INFORMATION TO POTENTIAL LOT PURCHASERS. PRIOR TO CONSTRUCTION THESE LOTS SHALL BE FURTHER TESTED TO DETERMINE THE EXTENT OF THE GEOHAZARD CONDITIONS, AND THE CONSTRAINTS THAT SHALL BE REQUIRED IN CONSTRUCTION. IF FURTHER LONG-RANGE GROUNDWATER TESTING DETERMINES THAT THIS CONSTRAINT IS NOT NECESSARY, THE DEVELOPER MAY CHOOSE TO APPLY FOR AN AMENDED DEVELOPMENT PLAN AT THAT TIME.
4-WAY RANCH METROPOLITAN DISTRICT NO. 2 SHALL MAINTAIN ENGINEERED DRAINAGE SYSTEMS. IF UNDERDRAIN SYSTEMS ARE REQUIRED FOR STRUCTURES LOCATED IN HIGH GROUNDWATER AREAS, THEY SHALL DISCHARGE INTO A GROUNDWATER RECHARGE FACILITY, NOT A STORM DRAIN SYSTEM. SUMP PUMPS ARE PROHIBITED FROM DISCHARGING ONTO A PUBLIC ROAD PER EGM 3.3.6.
- ENVIRONMENTAL NOTE: DEVELOPER SHALL COMPLY WITH FEDERAL AND STATE LAWS, REGULATIONS, ORDINANCES, REVIEW AND PERMIT REQUIREMENTS, AND OTHER AGENCY REQUIREMENTS, IF ANY, OF APPLICABLE AGENCIES INCLUDING, BUT NOT LIMITED TO, THE COLORADO DEPARTMENT OF PARKS AND WILDLIFE, COLORADO DEPARTMENT OF TRANSPORTATION, U.S. ARMY CORPS OF ENGINEERS AND THE U.S. FISH AND WILDLIFE SERVICE REGARDING THE ENDANGERED SPECIES ACT, PARTICULARLY AS IT RELATES TO THE LISTED SPECIES (E.G., PEBBLE'S MEADOW JUMPING MOUSE).
- NOTICE OF POTENTIAL AIRCRAFT OVERFLIGHT AND NOISE IMPACT ASSOCIATED WITH AIRPORT; THIS SERVICE AS NOTICE OF POTENTIAL AIRCRAFT OVERFLIGHT AND NOISE IMPACTS ON THIS PROPERTY DUE TO ITS CLOSE PROXIMITY TO AN AIRPORT, WHICH IS BEING TO DISCLOSED TO ALL PROSPECTIVE PURCHASERS CONSIDERING THE USE OF THIS PROPERTY FOR RESIDENTIAL PURPOSES, THIS PROPERTY IS SUBJECT TO THE OVERFLIGHT AND ASSOCIATED NOISE OF ARRIVING AND DEPARTING AIRCRAFT DURING THE COURSE OF NORMAL OPERATIONS.
- THE NON-REVOCABLE PUBLIC IMPROVEMENT EASEMENT SHOWN AT THE END OF PENCONIC PLACE, MASONBORO WAY, MEGANSETT WAY AND SUNKEN MEADOW ROAD ARE INTENDED FOR TURNAROUND AND EMERGENCY RESPONSE PURPOSES. AT SUCH A TIME THAT PENCONIC PLACE, MASONBORO WAY, MEGANSETT WAY AND SUNKEN MEADOW ROAD ARE EXTENDED BY THE ADJACENT PROPERTY OWNER/DEVELOPER AND ACCEPTED BY THE COUNTY, THE NON-REVOCABLE PUBLIC IMPROVEMENT EASEMENT FOR THE CUL-DE-SAC IMPROVEMENTS WILL BE REMOVED AND REPLACE WITH A STANDARD STREET SECTION. THE EASEMENT VACATION, CUL-DE-SAC REMOVAL AND STANDARD STREET SECTION CONSTRUCTION AND SITE RESTORATION IS THE RESPONSIBILITY OF THE OWNER/DEVELOPER EXTENDING SAID STREETS.
- NO LOTS SHALL HAVE ANY IMPERVIOUS IMPROVEMENTS CONSTRUCTED WITHIN THE REAR SETBACK (I.E. PATIOS, HARDSCAPE, RECREATIONAL FACILITIES, ETC.) FOR LOTS 40-42, 156 & TRACT C.
- WATER EFFICIENCY NOTE: THIS PLAT IS GOVERNED BY THE STANDARDS OF THE PUDSP, FILE NUMBER PUDSP 21-005.
- PERIMETER DRAINS AND SUMP PUMPS SHALL NOT DISCHARGE ONTO PUBLIC RIGHT-OF-WAY. MAINTENANCE FOR PERIMETER DRAINS AND SUMP PUMPS SHALL BE THE RESPONSIBILITY OF THE INDIVIDUAL LOT OWNERS.

SURVEYOR'S STATEMENT:

I, JONATHAN W. TESSIN, A DULY REGISTERED PROFESSIONAL LAND SURVEYOR IN THE STATE OF COLORADO, DO HEREBY CERTIFY THAT THIS PLAT TRULY AND CORRECTLY REPRESENTS THE RESULTS OF A SURVEY MADE ON _____ BY ME OR MY DIRECT SUPERVISION AND THAT ALL MONUMENTS EXIST AND SHOWN HEREON, THAT MATHEMATICAL CLOSURE ERRORS ARE LESS THAN 1:10,000; AND THAT SAID PLAT HAD BEEN PREPARED IN FULL COMPLIANCE WITH ALL LAWS OF THE STATE OF COLORADO DEALING WITH MONUMENTS, SUBDIVISION, OR SURVEYING OF LAND AND ALL APPLICABLE PROVISIONS OF THE EL PASO COUNTY LAND DEVELOPMENT CODE.

I ATTEST THE ABOVE ON THIS ___ DAY OF ___, 20__.

DRAFT

JONATHAN W. TESSIN, PROFESSIONAL LAND SURVEYOR DATE
COLORADO P.L.S. NO. 33196
FOR AND ON BEHALF OF EDWARD-JAMES SURVEYING, INC.

PLANNING AND COMMUNITY DEVELOPMENT:

THIS PLAT FOR WATERBURY FILING NO. 1 WAS APPROVED FOR FILING BY THE EL PASO COUNTY, COLORADO PLANNING AND COMMUNITY DEVELOPMENT DEPARTMENT DIRECTOR ON THE ___ DAY OF ___, 20___, SUBJECT TO ANY NOTES OR CONDITIONS SPECIFIED HEREON.

PLANNING AND COMMUNITY DEVELOPMENT DIRECTOR _____ DATE _____

CLERK AND RECORDER:

STATE OF COLORADO)
) SS
COUNTY OF EL PASO)

I HEREBY CERTIFY THAT THIS INSTRUMENT WAS FILED FOR RECORD IN MY OFFICE AT ___ O'CLOCK ___ M., THIS ___ DAY OF ___ 20__ A.D., AND IS DULY RECORDED UNDER RECEPTION NUMBER _____ OF THE RECORDS OF EL PASO COUNTY, COLORADO.

CHUCK BROERMAN, RECORDER

BY: _____ DEPUTY

FEES:

SCHOOL FEE: _____

PARK FEE: _____

DRAINAGE FEE: _____

OWNERS: NAME _____ ADDRESS _____

PREPARING: NAME _____ ADDRESS _____

DATE ISSUED: _____

SHEET NO. 1 OF 7

NO.	REVISIONS	DESCRIPTION	DATE

EDWARD-JAMES SURVEYING, INC.
926 Elkton Drive
Colorado Springs, CO 80907
Office: (719) 576-1216
Fax: (719) 576-1206
4732 Eagleridge Circle
Pueblo, CO 81008
Office: (719) 545-6240
Fax: (719) 545-6247



WATERBURY FILING NO. 1
FINAL PLAT
A PORTION OF SECTIONS 28, 29 AND 33, TOWNSHIP 12 SOUTH,
RANGE 64 WEST OF THE SIXTH PRINCIPAL MERIDIAN
EL PASO COUNTY, COLORADO

DRAWN BY: JWT
CHECKED BY: ERF

H-SCALE: N/A



JOB NO.: 2117-00
DATE CREATED: 12/29/22
DATE ISSUED: DRAFT
SHEET NO. 1 OF 7

PCD FILE NO. SF23-07

WATERBURY FILING NO. 1

FINAL PLAT

A PORTION OF SW 1/4 SECTION 28, A PORTION OF THE SE 1/4 SECTION 29, A PORTION OF THE NW 1/4 SECTION 33, TOWNSHIP 12 SOUTH, RANGE 64 WEST OF THE SIXTH PRINCIPAL MERIDIAN, EL PASO COUNTY, COLORADO

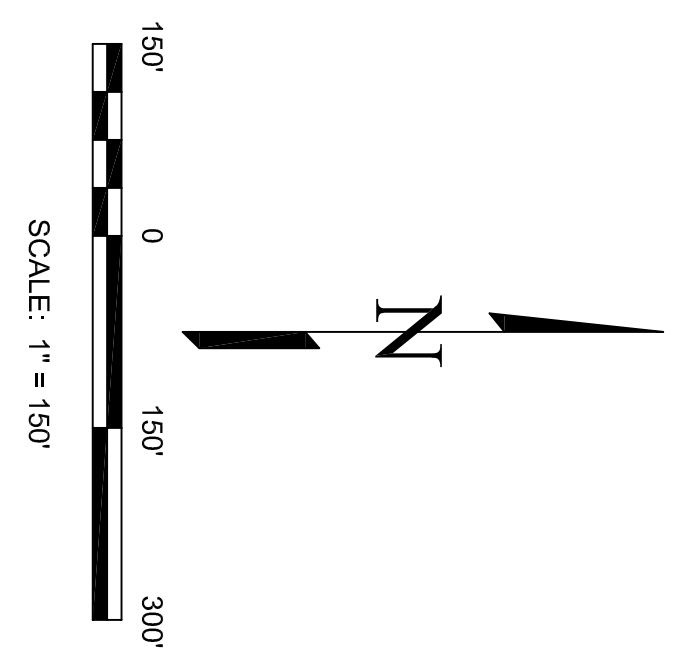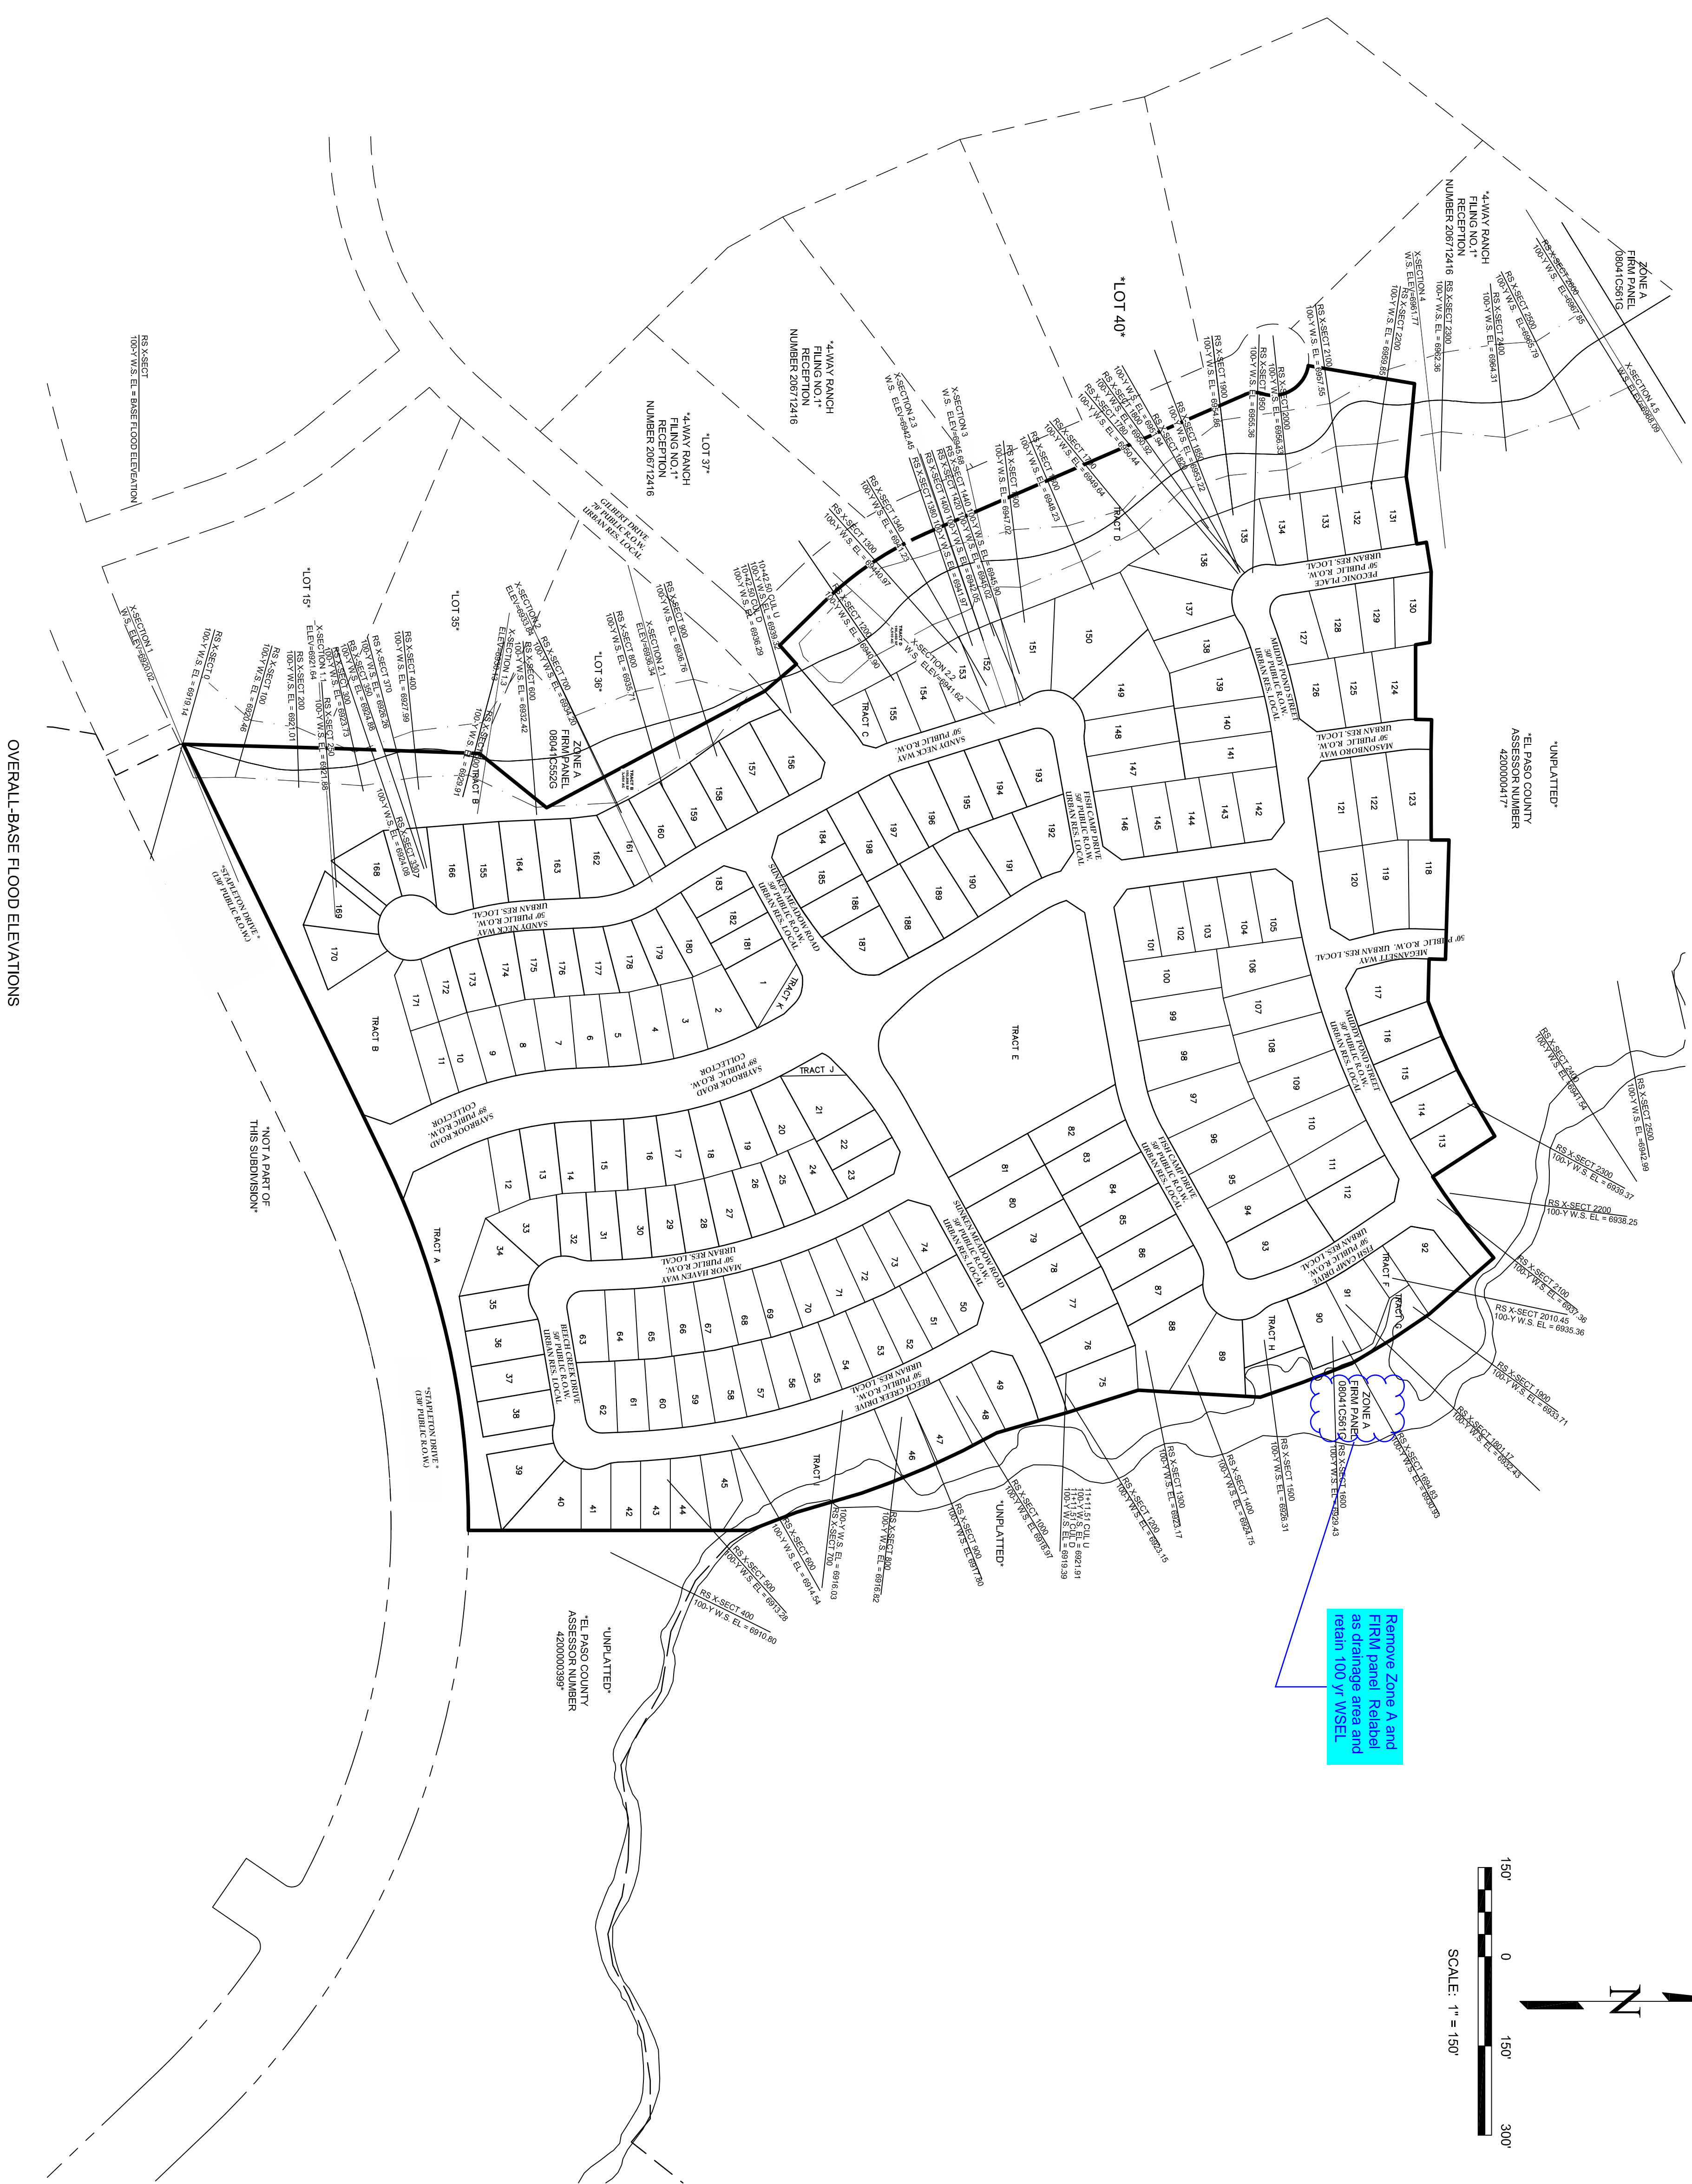

OVERALL-BASE FLOOD ELEVATIONS

NO.	REVISIONS DESCRIPTION	DATE

EDWARD-JAMES SURVEYING, INC.
 926 Elkton Drive
 Colorado Springs, CO 80907
 Office: (719) 576-1216
 Fax: (719) 576-1206

4732 Eagleridge Circle
 Pueblo, CO 81008
 Office: (719) 545-6240
 Fax: (719) 545-6247



WATERBURY FILING NO. 1
FINAL PLAT

A PORTION OF SECTIONS 28, 29 AND 33, TOWNSHIP 12 SOUTH,
 RANGE 64 WEST OF THE SIXTH PRINCIPAL MERIDIAN
 EL PASO COUNTY, COLORADO

DRAWN BY: **JWT**
 CHECKED BY: **ERF**
 H-SCALE: **1" = 150'**



JOB NO.: **2117-00**
 DATE CREATED: **12/29/22**
 DATE ISSUED:
 SHEET NO. **2** OF **7**

POD FILE NO. SF23-07

WATERBURY FILING NO. 1

FINAL PLAT

A PORTION OF SW 1/4 SECTION 28, A PORTION OF THE SE 1/4 SECTION 29, A PORTION OF THE NW 1/4 SECTION 33, TOWNSHIP 12 SOUTH, RANGE 64 WEST OF THE SIXTH PRINCIPAL MERIDIAN, EL PASO COUNTY, COLORADO

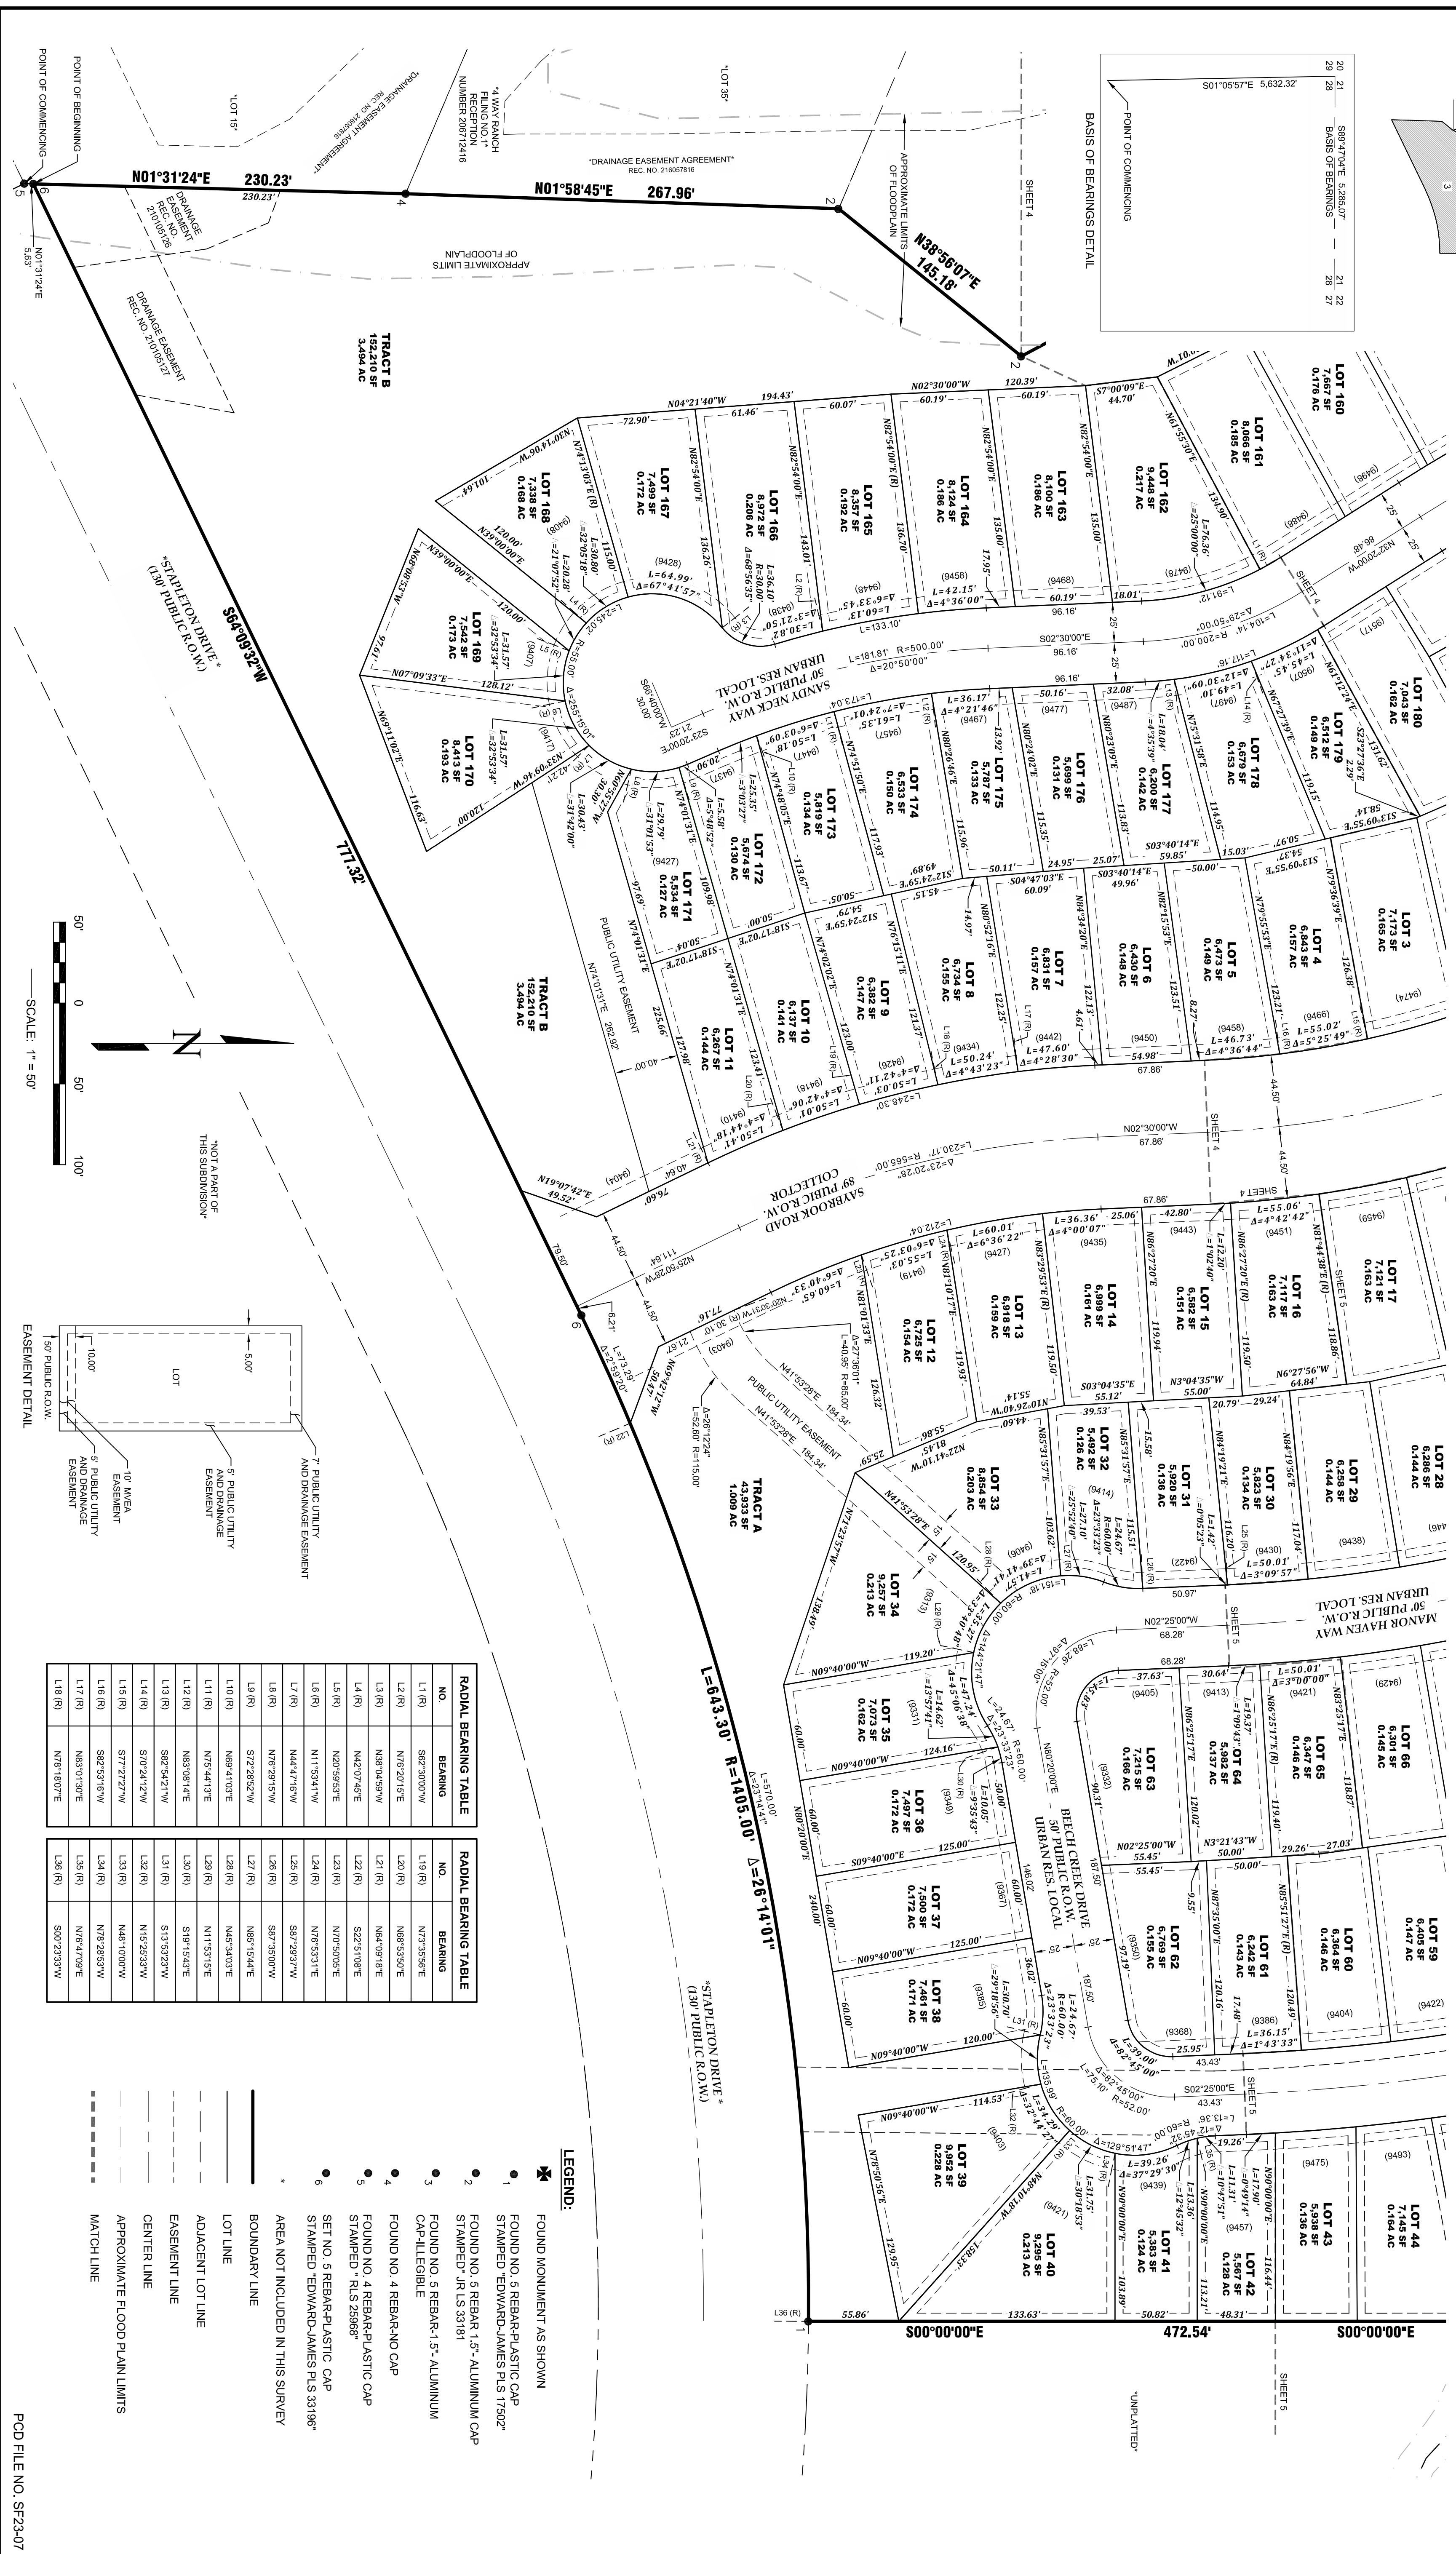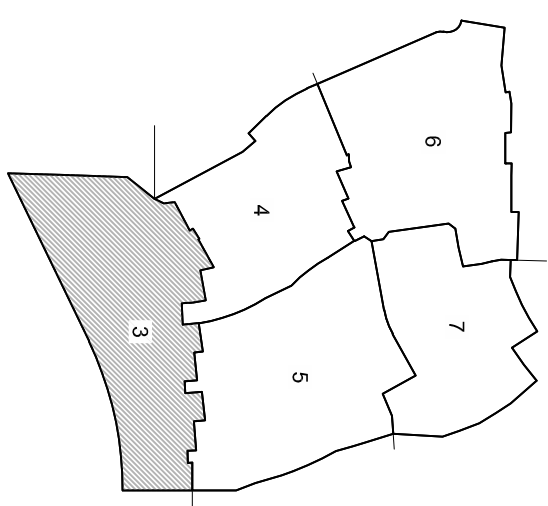


RADIAL BEARING TABLE		RADIAL BEARING TABLE	
NO.	BEARING	NO.	BEARING
L1 (R)	S87°30'00"W	L19 (R)	N73°55'00"E
L2 (R)	N75°20'15"E	L20 (R)	N88°53'50"E
L3 (R)	N38°04'59"W	L21 (R)	N64°09'18"E
L4 (R)	N42°07'49"E	L22 (R)	S22°51'08"E
L5 (R)	N29°59'53"E	L23 (R)	N70°50'05"E
L6 (R)	N11°54'14"W	L24 (R)	N78°53'31"E
L7 (R)	N44°47'16"W	L25 (R)	S87°29'37"W
L8 (R)	N75°28'15"W	L26 (R)	S87°35'00"W
L9 (R)	S72°26'52"W	L27 (R)	N88°15'44"E
L10 (R)	N69°41'03"E	L28 (R)	N45°34'07"E
L11 (R)	N75°54'13"E	L29 (R)	S19°15'43"E
L12 (R)	N80°08'14"E	L30 (R)	N11°53'10"E
L13 (R)	S87°54'21"W	L31 (R)	S13°52'33"W
L14 (R)	S70°24'22"W	L32 (R)	N15°23'53"W
L15 (R)	S77°27'27"W	L33 (R)	N48°10'00"W
L16 (R)	S89°53'18"W	L34 (R)	N78°47'09"E
L17 (R)	N83°01'30"E	L35 (R)	N76°47'09"E
L18 (R)	N81°18'07"E	L36 (R)	S00°23'33"W

LEGEND:

- ✱ FOUND MONUMENT AS SHOWN
- FOUND NO. 5 REBAR-PLASTIC CAP
- STAMPED "EDWARD-JAMES PLS 17502"
- FOUND NO. 3 REBAR 1.5" ALUMINUM CAP
- STAMPED "JRLS 33181"
- FOUND NO. 5 REBAR 1.5" ALUMINUM CAP-PILE-EGIBLE
- FOUND NO. 4 REBAR-NO CAP
- FOUND NO. 4 REBAR-PLASTIC CAP
- STAMPED "PLS 25968"
- SET NO. 5 REBAR-PLASTIC CAP
- STAMPED "EDWARD-JAMES PLS 33196"
- AREA NOT INCLUDED IN THIS SURVEY
- BOUNDARY LINE
- ADJACENT LOT LINE
- CENTER LINE
- APPROXIMATE FLOOD PLAIN LIMITS
- MATCH LINE

**WATERBURY FILING NO. 1
FINAL PLAT**

A PORTION OF SECTIONS 28, 29 AND 33, TOWNSHIP 12 SOUTH,
RANGE 64 WEST OF THE SIXTH PRINCIPAL MERIDIAN
EL PASO COUNTY, COLORADO

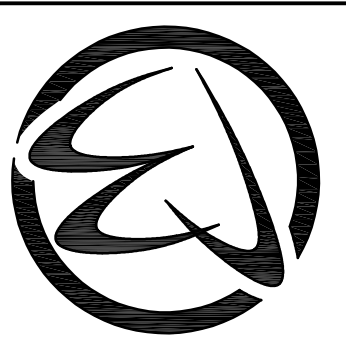

**EDWARD-JAMES
SURVEYING, INC.**

926 Elkon Drive
Colorado Springs, CO 80907
Office: (719) 576-1216
Fax: (719) 576-1206

4732 Eagleridge Circle
Pueblo, CO 81008
Office: (719) 545-6240
Fax: (719) 545-6247

NO.	REVISIONS	DESCRIPTION	DATE


JOB NO.	2117-00
DATE CREATED	12/29/22
DATE ISSUED	DRAFT
SHEET NO.	3 OF 7
SCALE	1" = 50'
DRAWN BY	JWT
CHECKED BY	ERF

POD FILE NO. SF23-07




WATERBURY FILING NO. 1

FINAL PLAT

A PORTION OF SW 1/4 SECTION 28, A PORTION OF THE SE 1/4 SECTION 29, A PORTION OF THE NW 1/4 SECTION 33, TOWNSHIP 12 SOUTH, RANGE 64 WEST OF THE SIXTH PRINCIPAL MERIDIAN, EL PASO COUNTY, COLORADO

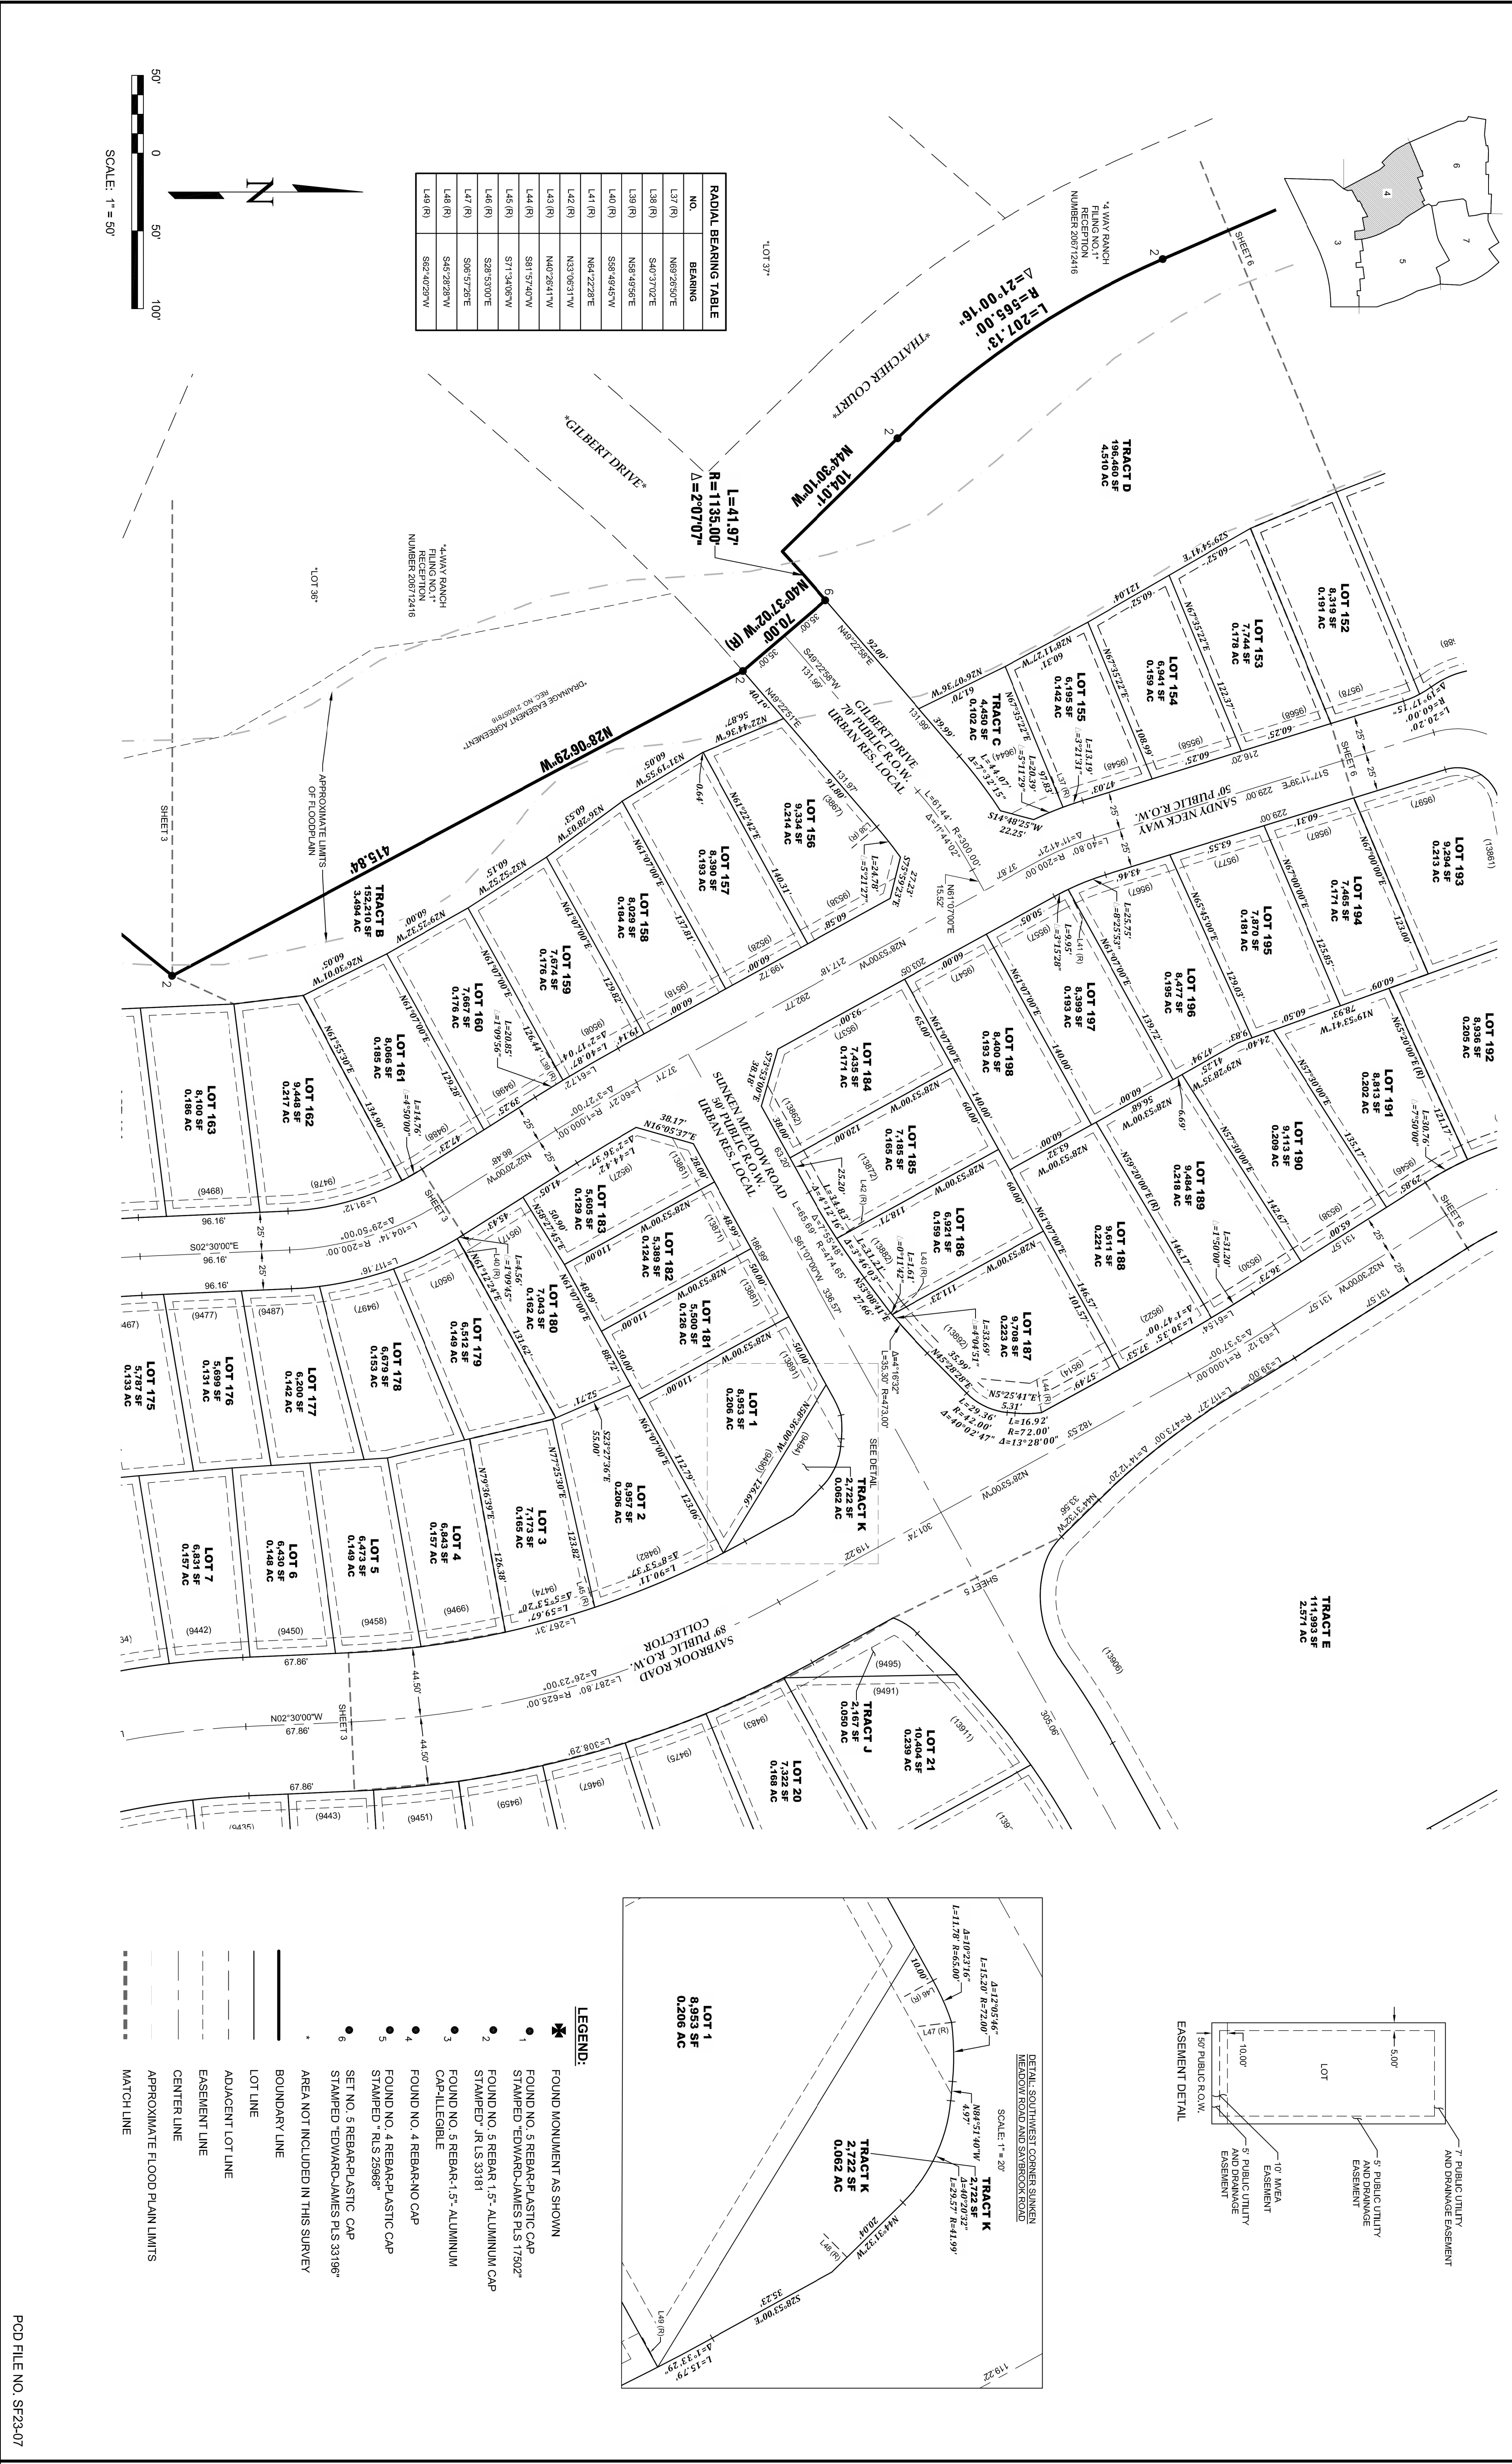

NO.	BEARING	RADIAL BEARING TABLE
L37 (R)	N89°26'50"E	
L38 (R)	S40°37'22"E	
L39 (R)	N88°49'50"E	
L40 (R)	S88°49'50"E	
L41 (R)	N64°22'28"E	
L42 (R)	N33°09'11"W	
L43 (R)	N40°28'11"W	
L44 (R)	S81°57'40"W	
L45 (R)	S71°34'05"W	
L46 (R)	S28°33'30"E	
L47 (R)	S06°57'26"E	
L48 (R)	S46°28'29"W	
L49 (R)	S82°40'25"W	

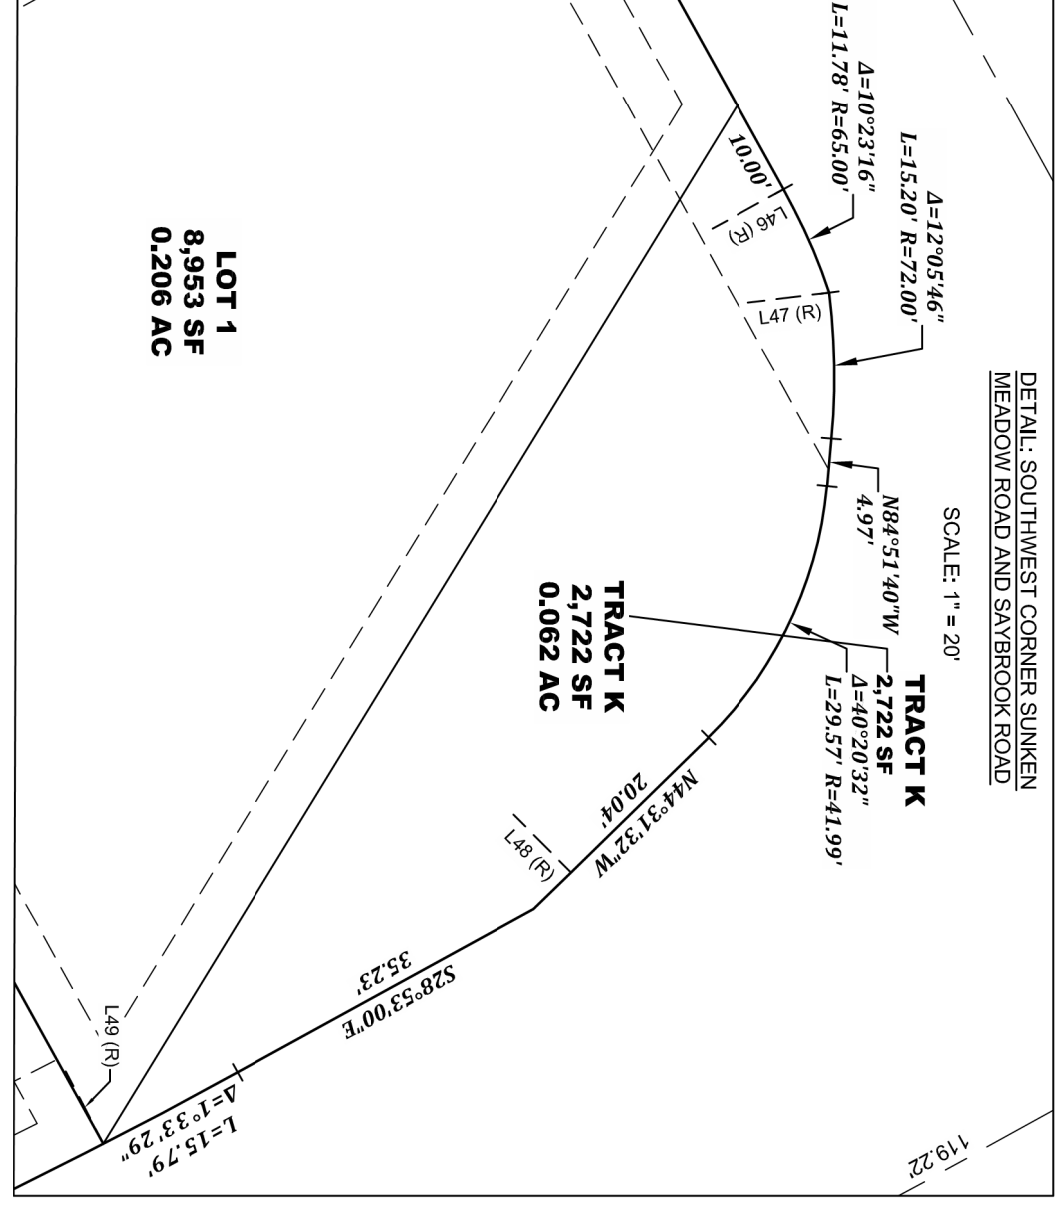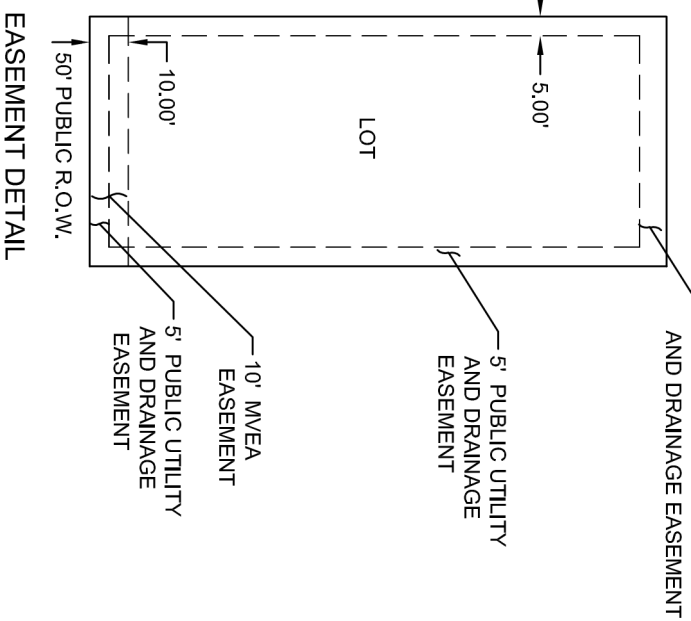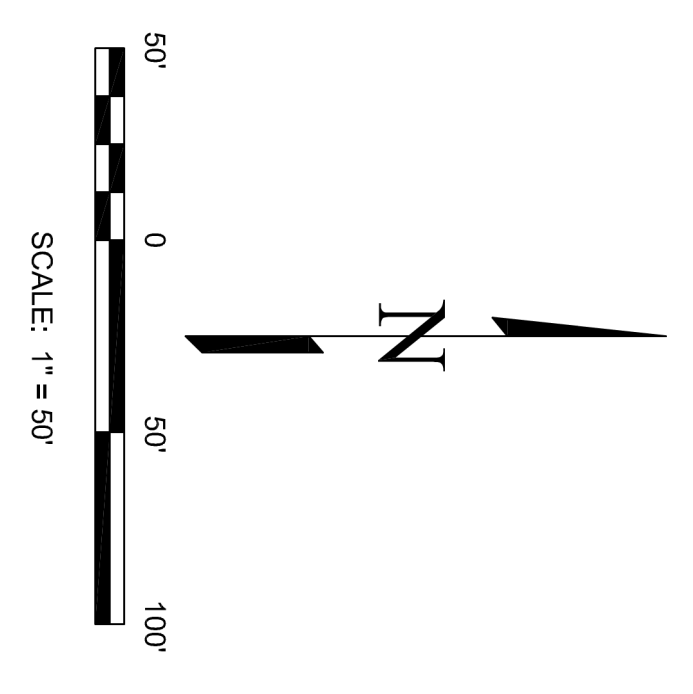

- LEGEND:**
- ✱ FOUND MONUMENT AS SHOWN
 - FOUND NO. 5 REBAR-PLASTIC CAP
 - STAMPED "EDWARD-JAMES PLS 7/9/02"
 - FOUND NO. 5 REBAR 1.5" ALUMINUM CAP
 - STAMPED "J.R.L.S 3/181"
 - FOUND NO. 5 REBAR-1.5" ALUMINUM CAP-ILLEGIBLE
 - FOUND NO. 4 REBAR-NO CAP
 - FOUND NO. 4 REBAR-PLASTIC CAP
 - STAMPED "RIS 2/5/88"
 - SET NO. 5 REBAR-PLASTIC CAP
 - STAMPED "EDWARD-JAMES PLS 3/19/8"
 - AREA NOT INCLUDED IN THIS SURVEY
 - BOUNDARY LINE
 - ADJACENT LOT LINE
 - EASEMENT LINE
 - CENTER LINE
 - - - APPROXIMATE FLOOD PLAIN LIMITS
 - - - MATCH LINE



POD FILE NO. SF23-07

<p>WATERBURY FILING NO. 1 FINAL PLAT</p> <p>A PORTION OF SECTIONS 28, 29 AND 33, TOWNSHIP 12 SOUTH, RANGE 64 WEST OF THE SIXTH PRINCIPAL MERIDIAN EL PASO COUNTY, COLORADO</p>	<p>EDWARD-JAMES SURVEYING, INC.</p> <p>926 Elkon Drive Colorado Springs, CO 80907 Office: (719) 576-1216 Fax: (719) 576-1206</p>	<p>4732 Eagleridge Circle Pueblo, CO 81008 Office: (719) 545-6240 Fax: (719) 545-6247</p>	<table border="1" style="width: 100%; border-collapse: collapse;"> <thead> <tr> <th style="width: 10%;">NO.</th> <th style="width: 70%;">REVISIONS DESCRIPTION</th> <th style="width: 20%;">DATE</th> </tr> </thead> <tbody> <tr><td> </td><td> </td><td> </td></tr> <tr><td> </td><td> </td><td> </td></tr> <tr><td> </td><td> </td><td> </td></tr> <tr><td> </td><td> </td><td> </td></tr> <tr><td> </td><td> </td><td> </td></tr> </tbody> </table>	NO.	REVISIONS DESCRIPTION	DATE															
NO.	REVISIONS DESCRIPTION	DATE																			
<p>JOB NO. 2117-00 DATE CREATED 12/29/22 DATE ISSUED DRAFT SHEET NO. 4 OF 7</p>	<p>H-SCALE 1" = 50' DRAWN BY JMT CHECKED BY ERF</p>																				


WATERBURY FILING NO. 1

FINAL PLAT

A PORTION OF SW 1/4 SECTION 28, A PORTION OF THE SE 1/4 SECTION 29, A PORTION OF THE NW 1/4 SECTION 33, TOWNSHIP 12 SOUTH, RANGE 64 WEST OF THE SIXTH PRINCIPAL MERIDIAN, EL PASO COUNTY, COLORADO

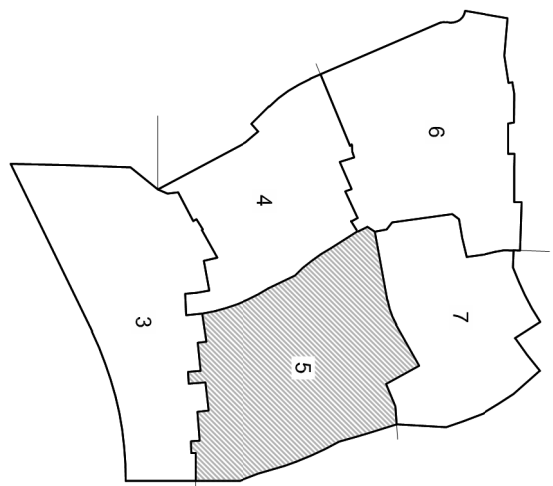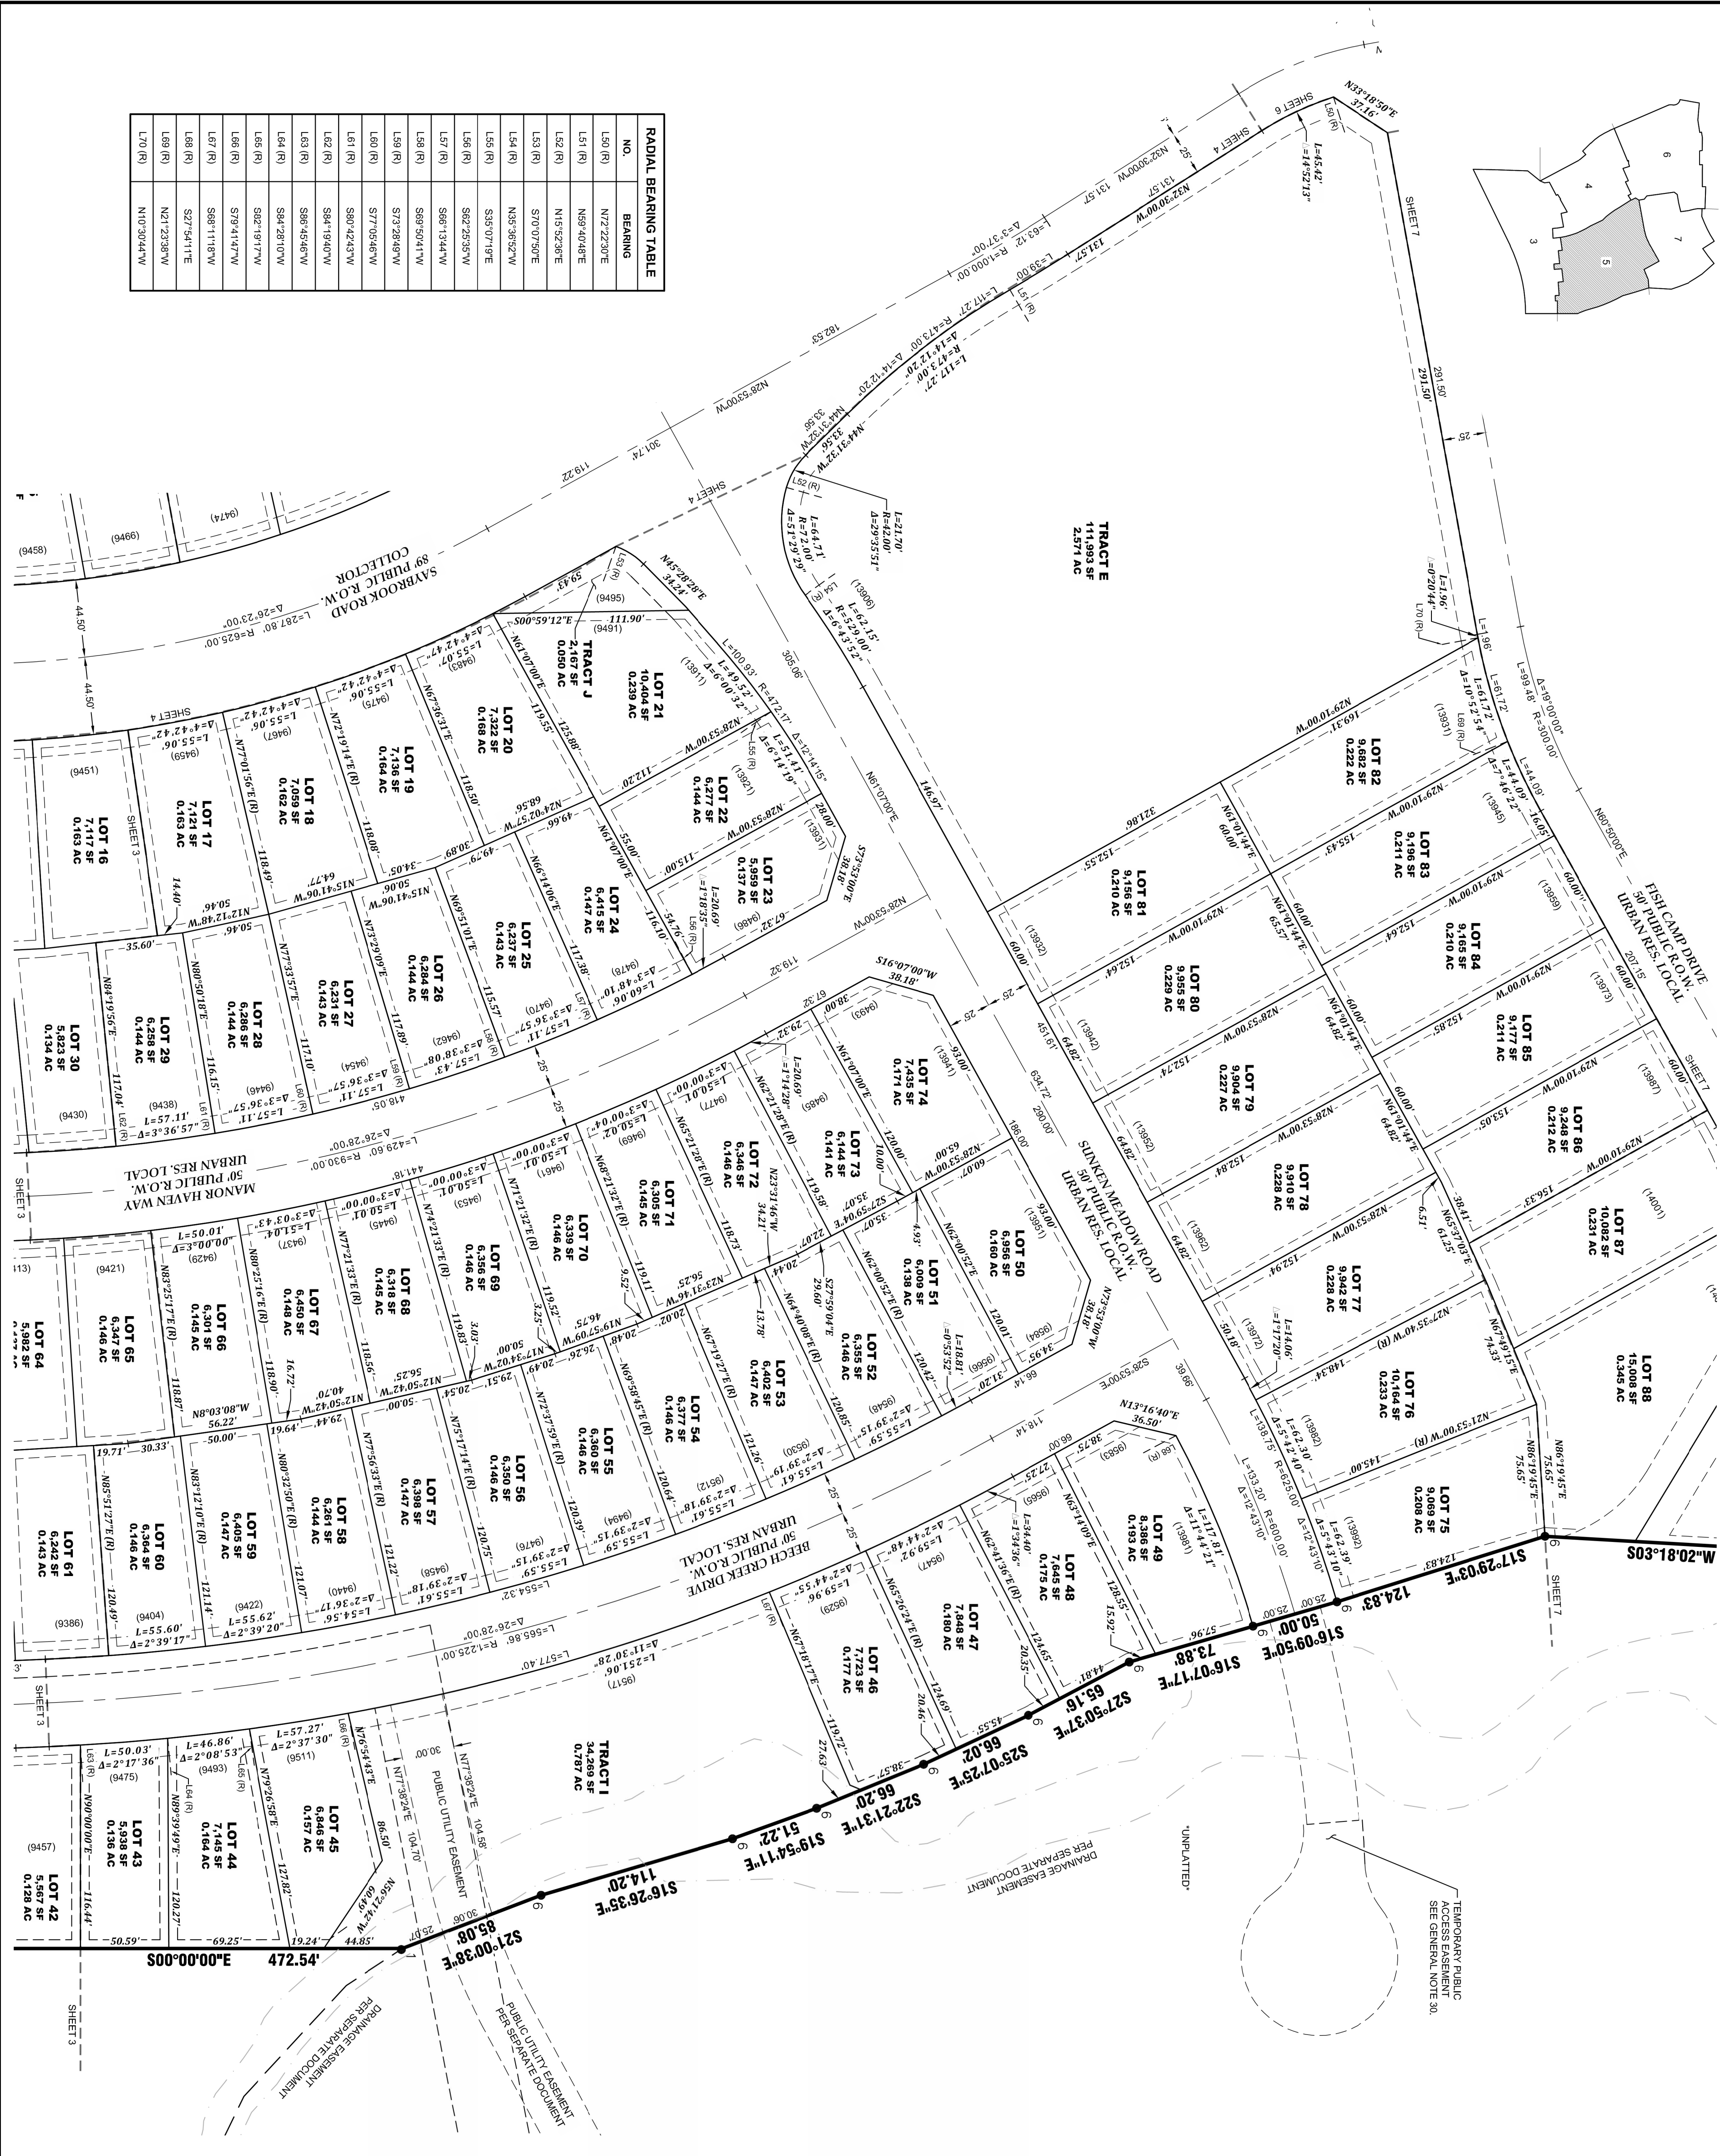


NO.	BEARING
L50 (R)	N77°22'30"E
L51 (R)	N69°40'48"E
L52 (R)	N19°52'36"E
L53 (R)	S70°07'50"E
L54 (R)	N53°56'52"W
L54 (R)	N53°07'19"E
L56 (R)	S82°25'53"W
L57 (R)	S66°13'44"W
L58 (R)	S69°59'11"W
L58 (R)	S73°28'49"W
L59 (R)	S77°05'46"W
L61 (R)	S60°42'43"W
L62 (R)	S84°19'40"W
L63 (R)	S86°45'49"W
L64 (R)	S84°28'10"W
L64 (R)	S82°19'17"W
L66 (R)	S79°41'47"W
L67 (R)	S68°11'18"W
L68 (R)	S27°54'11"E
L68 (R)	N27°23'38"W
L70 (R)	N10°20'41"W

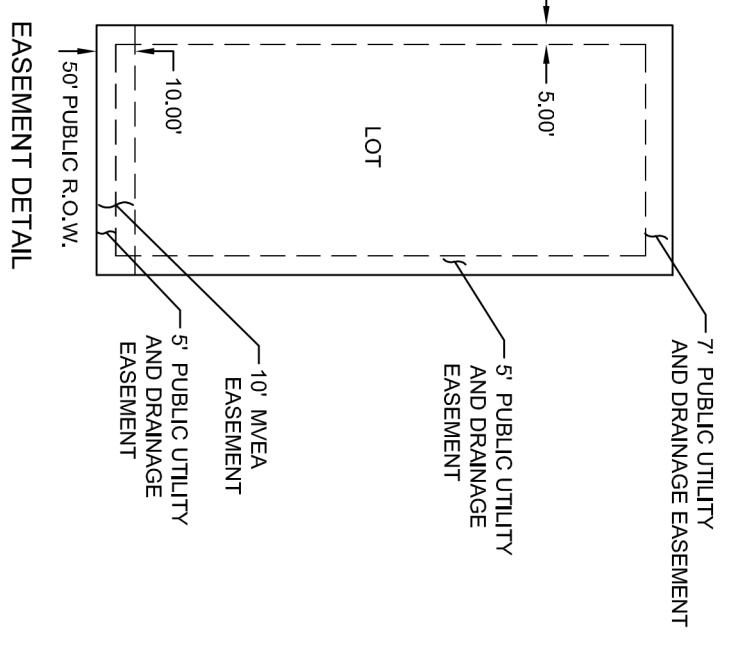

LEGEND:

- ✱ FOUND MONUMENT AS SHOWN
- 1 FOUND NO. 5 REBAR-PLASTIC CAP STAMPED EDWARD-JAMES PLS 17502"
- 2 FOUND NO. 5 REBAR-1.5" ALUMINUM CAP STAMPED JR. L.S. 33191
- 3 FOUND NO. 5 REBAR-1.5" ALUMINUM CAP-ILLEGIBLE
- 4 FOUND NO. 4 REBAR-NO CAP
- 5 FOUND NO. 4 REBAR-PLASTIC CAP STAMPED RLS 23989
- 6 SET NO. 5 REBAR-PLASTIC CAP STAMPED EDWARD-JAMES PLS 33196"
- AREA NOT INCLUDED IN THIS SURVEY
- BOUNDARY LINE
- LOT LINE
- ADJACENT LOT LINE
- EASEMENT LINE
- CENTER LINE
- APPROXIMATE FLOOD PLAIN LIMITS
- - - - MATCH LINE

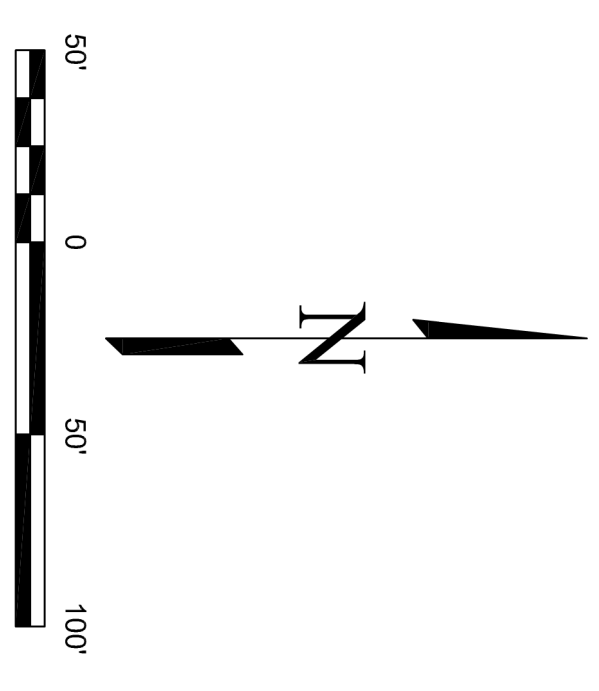

POD FILE NO. SF23-07

DRAWN BY	JWT
CHECKED BY	ERF
DATE CREATED	12/29/22
DATE ISSUED	DRAFT
SHEET NO.	5 OF 7

WATERBURY FILING NO. 1
FINAL PLAT

A PORTION OF SECTIONS 28, 29 AND 33, TOWNSHIP 12 SOUTH,
RANGE 64 WEST OF THE SIXTH PRINCIPAL MERIDIAN
EL PASO COUNTY, COLORADO



EDWARD-JAMES SURVEYING, INC.

926 Elton Drive
Colorado Springs, CO 80907
Office: (719) 576-1216
Fax: (719) 576-1206



4732 Eagleridge Circle
Pueblo, CO 81008
Office: (719) 545-6240
Fax: (719) 545-6247

NO.	REVISIONS	DESCRIPTION	DATE

WATERBURY FILING NO. 1



FINAL PLAT

A PORTION OF SW 1/4 SECTION 28, A PORTION OF THE SE 1/4 SECTION 29, A PORTION OF THE NW 1/4 SECTION 33, TOWNSHIP 12 SOUTH, RANGE 64 WEST OF THE SIXTH PRINCIPAL MERIDIAN, EL PASO COUNTY, COLORADO

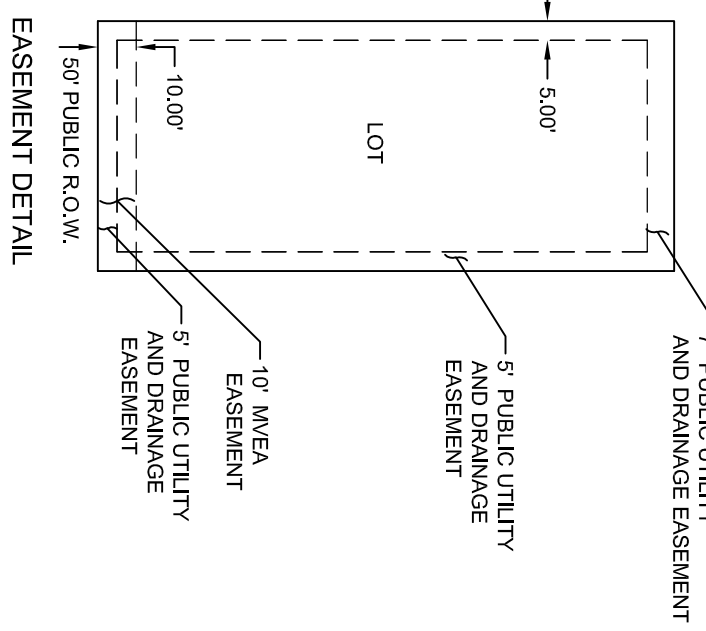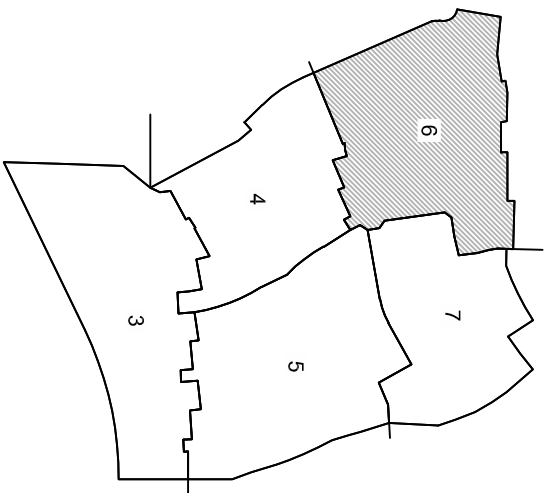

LEGEND:

- ✱ FOUND MONUMENT AS SHOWN
- 1 FOUND NO. 5 REBAR-PLASTIC CAP STAMPED EDWARD-JAMES PLS 17502"
- 2 FOUND NO. 5 REBAR 1.5" ALUMINUM CAP STAMPED JR. S33181
- 3 FOUND NO. 5 REBAR 1.5" ALUMINUM CAP-ILLEGIBLE
- 4 FOUND NO. 4 REBAR-NO CAP
- 5 FOUND NO. 4 REBAR-PLASTIC CAP STAMPED PLS 25988
- 6 SET NO. 5 REBAR-PLASTIC CAP STAMPED EDWARD-JAMES PLS 33196"
- AREA NOT INCLUDED IN THIS SURVEY
- BOUNDARY LINE
- LOT LINE
- ADJACENT LOT LINE
- EASEMENT LINE
- CENTER LINE
- - - APPROXIMATE FLOOD PLAIN LIMITS
- - - MATCH LINE

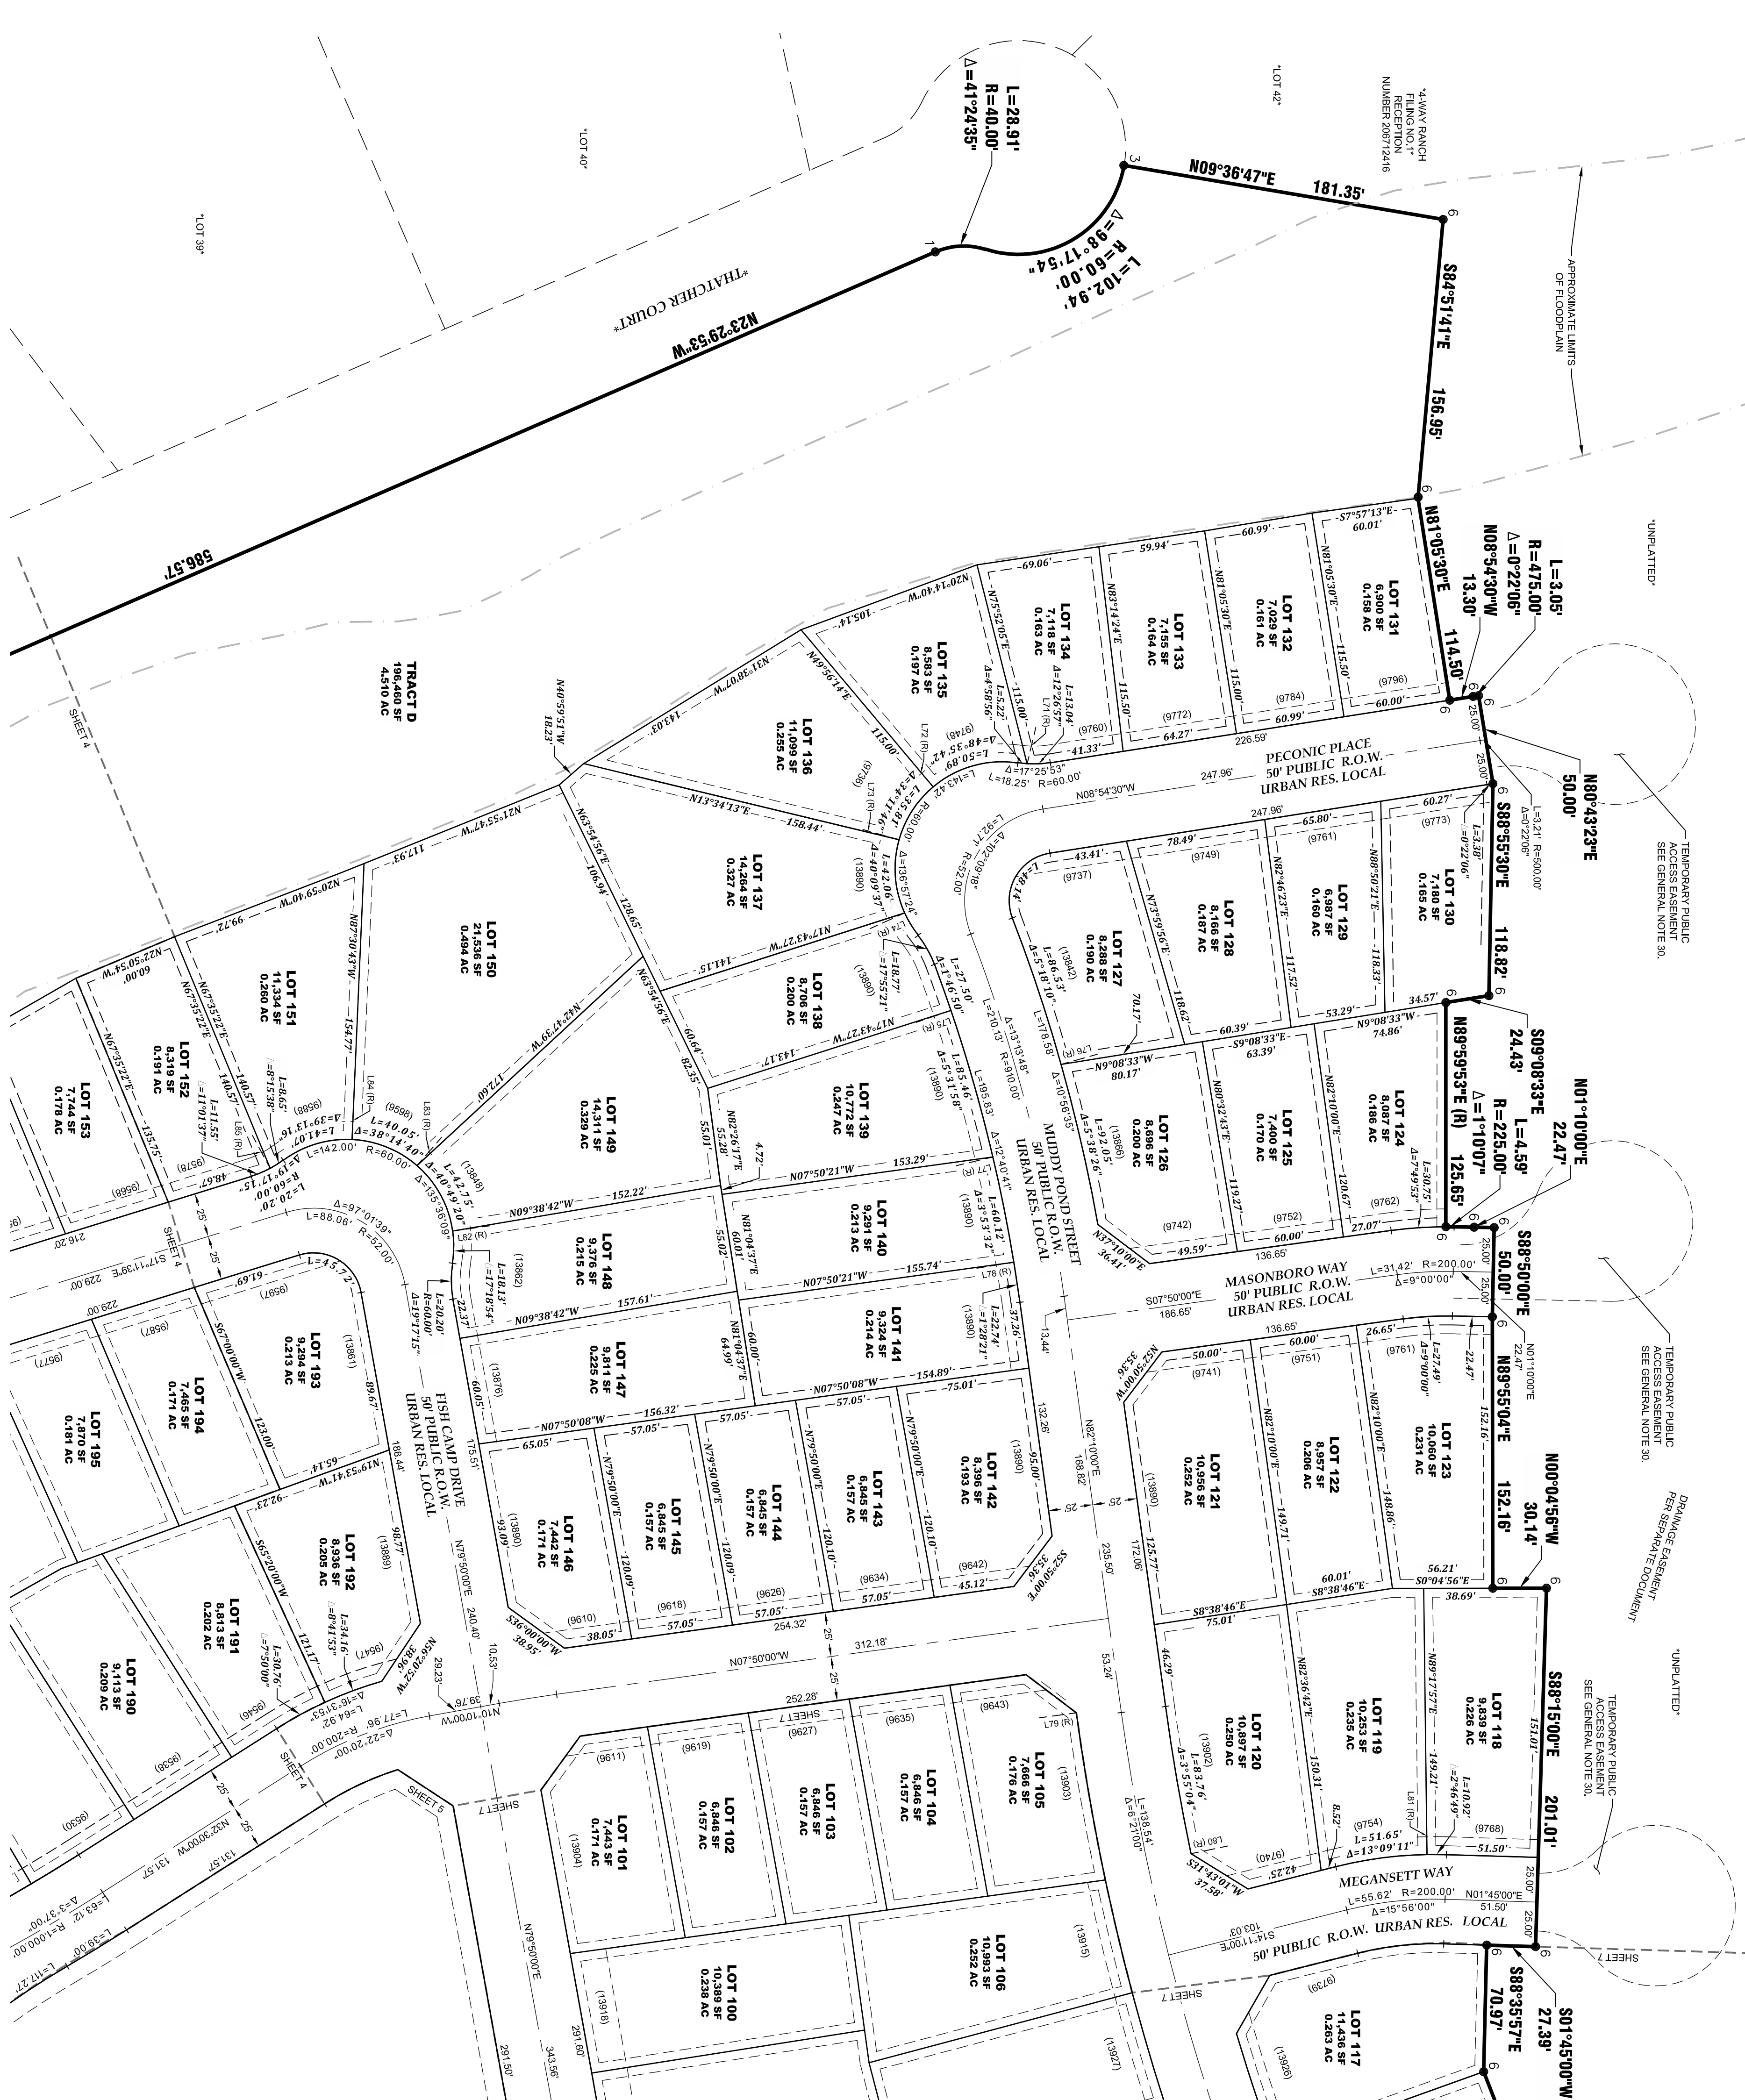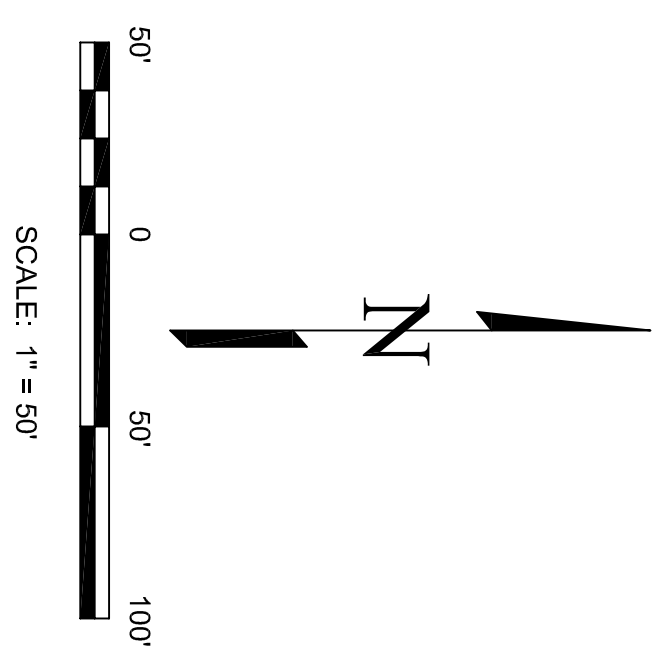

NO.	BEARING
L71 (R)	S76°31'56"E
L72 (R)	N68°54'41"E
L73 (R)	N15°45'56"E
L74 (R)	N24°28'42"W
L75 (R)	S18°51'38"E
L76 (R)	S15°45'39"E
L77 (R)	S13°11'52"E
L78 (R)	S88°18'21"E
L79 (R)	N07°41'17"W
L80 (R)	N17°48'04"W
L81 (R)	N88°58'11"E
L82 (R)	S08°11'38"E
L83 (R)	S49°00'09"E
L84 (R)	S87°15'38"E
L85 (R)	N81°48'44"E

EDWARD-JAMES SURVEYING, INC.
 926 Elkon Drive Colorado Springs, CO 80907
 Office: (719) 576-1216 Fax: (719) 576-1206
 4732 Eagleridge Circle Pueblo, CO 81008
 Office: (719) 545-6240 Fax: (719) 545-6247



WATERBURY FILING NO. 1
FINAL PLAT
 A PORTION OF SECTIONS 28, 29 AND 33, TOWNSHIP 12 SOUTH,
 RANGE 64 WEST OF THE SIXTH PRINCIPAL MERIDIAN
 EL PASO COUNTY, COLORADO

NO.	REVISIONS	DESCRIPTION	DATE


POD FILE NO. SF23-07

DRAWN BY	JWT
CHECKED BY	ERF
H-SCALE	1" = 50'
JOB NO.	2117-00
DATE ORIENTED	12/29/22
DATE ISSUED	DRAFT
SHEET NO.	6 OF 7




WATERBURY FILING NO. 1

FINAL PLAT

A PORTION OF SW 1/4 SECTION 28, A PORTION OF THE SE 1/4 SECTION 29, A PORTION OF THE NW 1/4 SECTION 33, TOWNSHIP 12 SOUTH, RANGE 64 WEST OF THE SIXTH PRINCIPAL MERIDIAN, EL PASO COUNTY, COLORADO

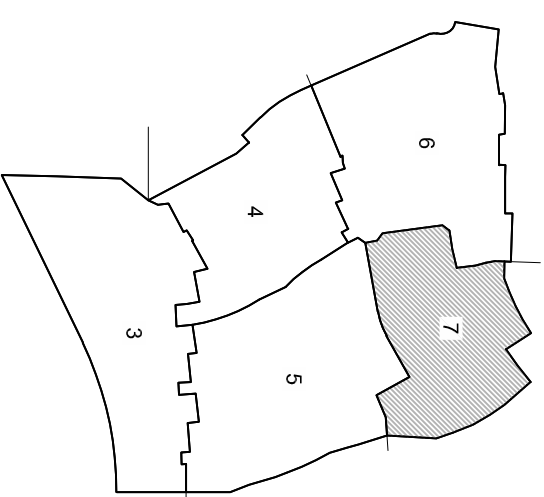

NO.	BEARING
L86 (R)	N11°52'28"W
L87 (R)	N17°48'14"W
L88 (R)	N28°38'54"W
L89 (R)	N28°23'13"W
L90 (R)	S86°48'57"W
L91 (R)	S82°07'07"W
L92 (R)	S86°54'48"W
L93 (R)	S85°59'03"W
L94 (R)	N02°16'18"W
L95 (R)	N00°00'00"E
L96 (R)	S80°02'22"E
L97 (R)	N15°03'17"W

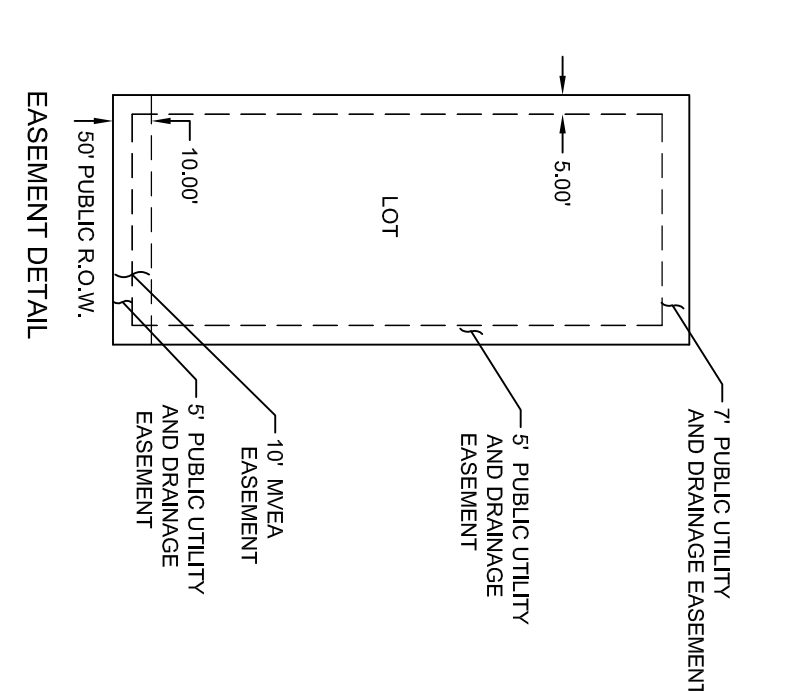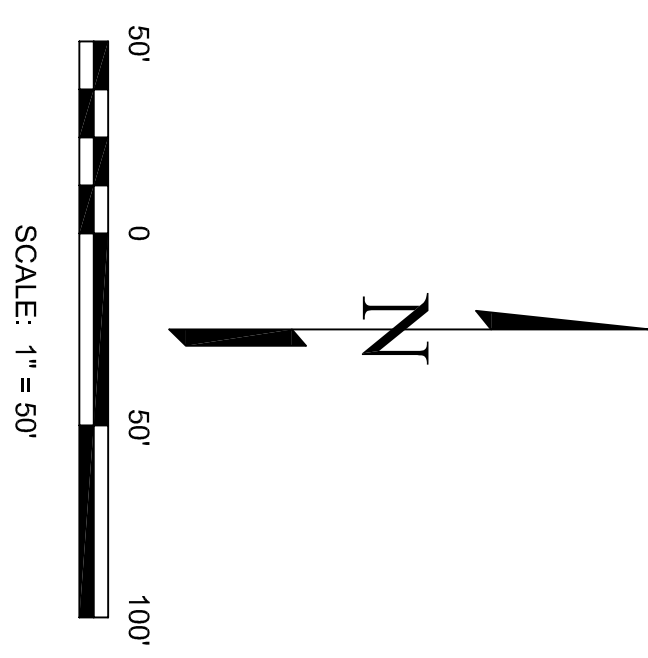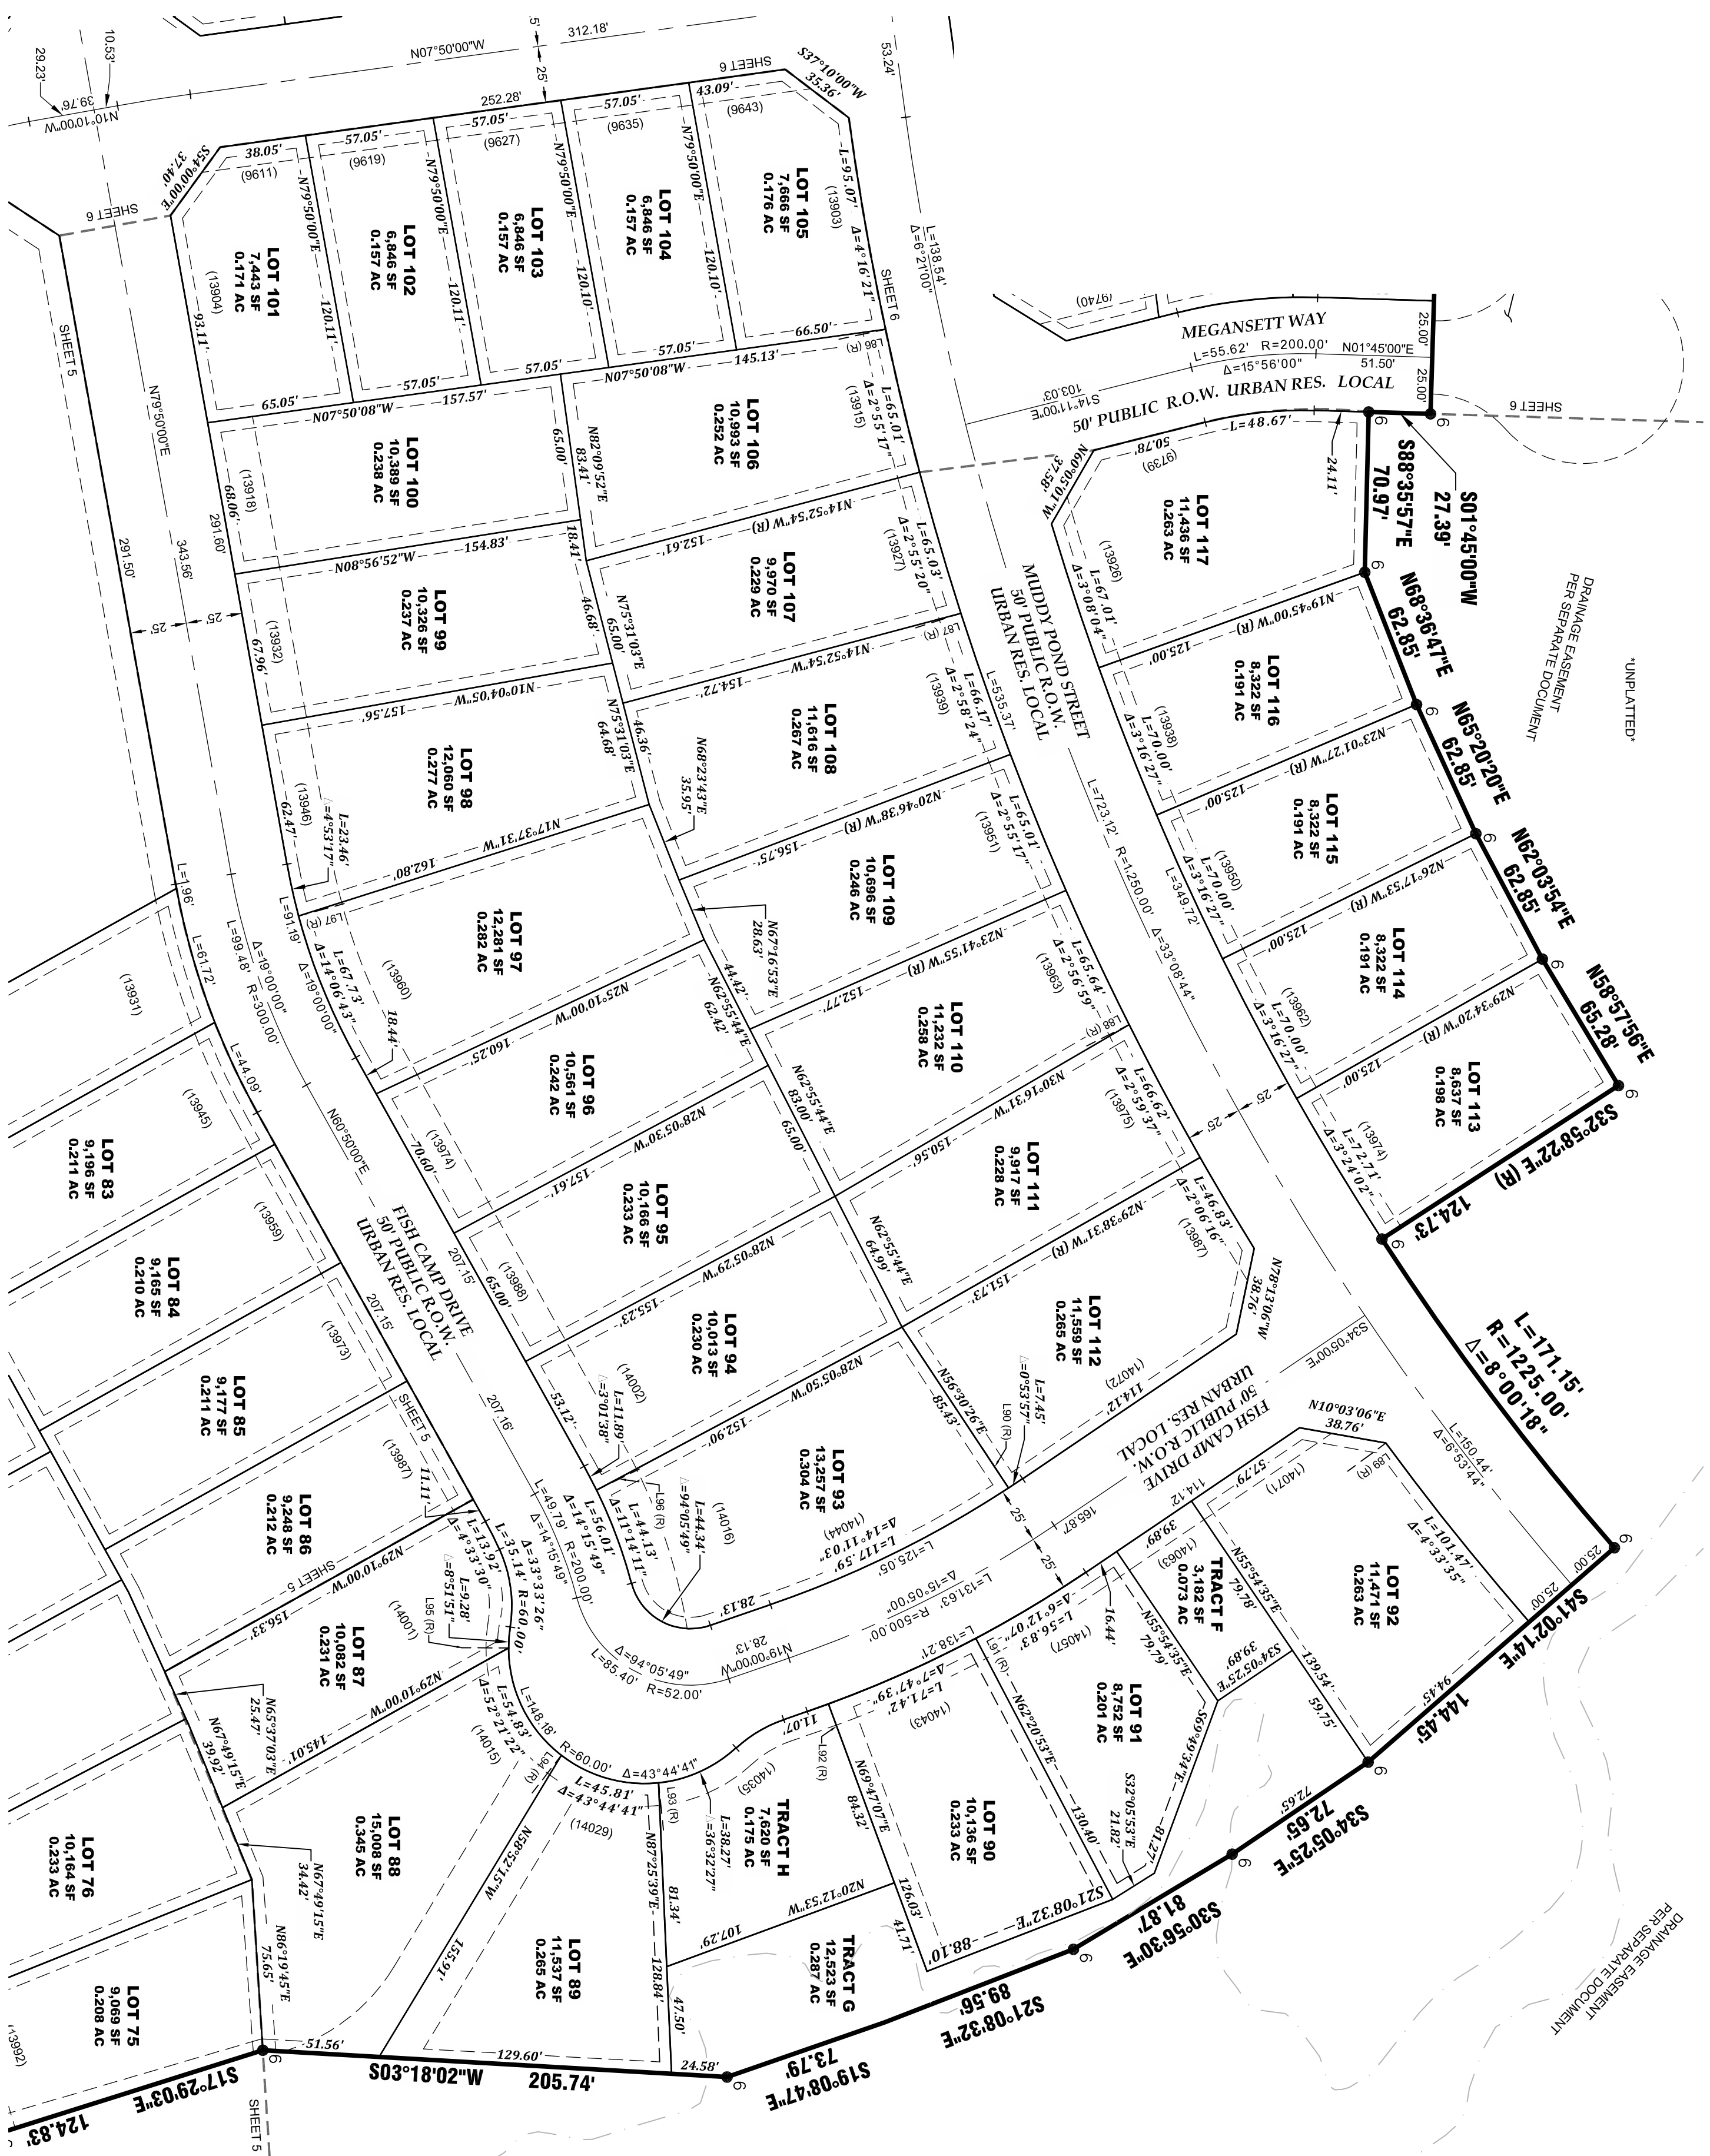

- LEGEND:**
- ✱ FOUND MONUMENT AS SHOWN
 - FOUND NO. 5 REBAR-PLASTIC CAP
 - STAMPED "EDWARD-JAMES PLS 17502"
 - FOUND NO. 5 REBAR 1.5" ALUMINUM CAP
 - STAMPED "JRS LS 33181"
 - FOUND NO. 5 REBAR-1.5" ALUMINUM CAP-ILLEGIBLE
 - FOUND NO. 4 REBAR-NO CAP
 - FOUND NO. 4 REBAR-PLASTIC CAP
 - STAMPED "RIS 25988"
 - SET NO. 5 REBAR-PLASTIC CAP
 - STAMPED "EDWARD-JAMES PLS 33198"
 - AREA NOT INCLUDED IN THIS SURVEY
 - BOUNDARY LINE
 - LOT LINE
 - ADJACENT LOT LINE
 - EASEMENT LINE
 - CENTER LINE
 - - - APPROXIMATE FLOOD PLAIN LIMITS
 - MATCH LINE

POD FILE NO. SF23-07

NO.	REVISIONS	DESCRIPTION	DATE

EDWARD-JAMES SURVEYING, INC.
 926 Elkon Drive
 Colorado Springs, CO 80907
 Office: (719) 576-1216
 Fax: (719) 576-1206

4732 Eagleridge Circle
 Pueblo, CO 81008
 Office: (719) 545-6240
 Fax: (719) 545-6247



WATERBURY FILING NO. 1
FINAL PLAT

A PORTION OF SECTIONS 28, 29 AND 33, TOWNSHIP 12 SOUTH,
 RANGE 64 WEST OF THE SIXTH PRINCIPAL MERIDIAN
 EL PASO COUNTY, COLORADO

JOB NO.	2117-00
DATE CREATED	12/29/22
DATE ISSUED	DRAFT
SHEET NO.	7 OF 7
DRAWN BY	JWT
CHECKED BY	ERF
H-SCALE	1" = 50'