

CONSTRUCTION PLANS for TABLE ROCK HOMESTEADS

A PORTION OF THE SE1/4 OF THE NE1/4 SECTION 6, TOWNSHIP 12 SOUTH, RANGE 65 WEST,
EL PASO COUNTY, COLORADO

STANDARD EL PASO COUNTY GRADING & EROSION CONTROL PLAN NOTES

1. STORMWATER DISCHARGES FROM CONSTRUCTION SITES SHALL NOT CAUSE OR THREATEN TO CAUSE POLLUTION, CONTAMINATION, OR DEGRADATION OF STATE WATERS. ALL WORK AND EARTH DISTURBANCE SHALL BE DONE IN A MANNER THAT MINIMIZES POLLUTION OF ANY ON-SITE OR OFF-SITE WATERS, INCLUDING WETLANDS.

2. NOTWITHSTANDING ANYTHING DEPICTED IN THESE PLANS IN WORDS OR GRAPHIC REPRESENTATION, ALL DESIGN AND CONSTRUCTION RELATED TO ROADS, STORM DRAINAGE AND EROSION CONTROL SHALL CONFORM TO THE STANDARDS AND REQUIREMENTS OF THE MOST RECENT VERSION OF THE RELEVANT ADOPTED EL PASO COUNTY STANDARDS, INCLUDING THE LAND DEVELOPMENT CODE, THE ENGINEERING CRITERIA MANUAL, THE DRAINAGE CRITERIA MANUAL, AND THE DRAINAGE CRITERIA MANUAL VOLUME 2. ANY DEVIATIONS FROM REGULATIONS AND STANDARDS MUST BE REQUESTED, AND APPROVED, IN WRITING.

3. A SEPARATE STORMWATER MANAGEMENT PLAN (SWMP) FOR THIS PROJECT SHALL BE COMPLETED AND AN EROSION AND STORMWATER QUALITY CONTROL PERMIT (ESQCP) ISSUED PRIOR TO COMMENCING CONSTRUCTION. MANAGEMENT OF THE SWMP DURING CONSTRUCTION IS THE RESPONSIBILITY OF THE DESIGNATED QUALIFIED STORMWATER MANAGER OR CERTIFIED EROSION CONTROL INSPECTOR. THE SWMP SHALL BE LOCATED ON SITE AT ALL TIMES DURING CONSTRUCTION AND SHALL BE KEPT UP TO DATE WITH WORK PROGRESS AND CHANGES IN THE FIELD.

4. ONCE THE ESQCP IS APPROVED AND A "NOTICE TO PROCEED" HAS BEEN ISSUED, THE CONTRACTOR MAY INSTALL THE INITIAL STAGE EROSION AND SEDIMENT CONTROL MEASURES AS INDICATED ON THE APPROVED GEC. A PRECONSTRUCTION MEETING BETWEEN THE CONTRACTOR, ENGINEER, AND EL PASO COUNTY WILL BE HELD PRIOR TO ANY CONSTRUCTION. IT IS THE RESPONSIBILITY OF THE APPLICANT TO COORDINATE THE MEETING TIME AND PLACE WITH COUNTY STAFF.

5. CONTROL MEASURES MUST BE INSTALLED PRIOR TO COMMENCEMENT OF ACTIVITIES THAT COULD CONTRIBUTE POLLUTANTS TO STORMWATER CONTROL MEASURES FOR ALL SLOPES, CHANNELS, DITCHES, AND DISTURBED LAND AREAS SHALL BE INSTALLED IMMEDIATELY UPON COMPLETION OF THE DISTURBANCE.

6. ALL TEMPORARY SEDIMENT AND EROSION CONTROL MEASURES SHALL BE MAINTAINED AND REMAIN IN EFFECTIVE OPERATING CONDITION UNTIL PERMANENT SOIL EROSION CONTROL MEASURES ARE IMPLEMENTED AND FINAL STABILIZATION IS ESTABLISHED. ALL PERSONS ENGAGED IN LAND DISTURBANCE ACTIVITIES SHALL ASSESS THE ADEQUACY OF CONTROL MEASURES AT THE SITE AND IDENTIFY IF CHANGES TO THOSE CONTROL MEASURES ARE NEEDED TO ENSURE THE CONTINUED EFFECTIVE PERFORMANCE OF THE CONTROL MEASURES. ALL CHANGES TO TEMPORARY SEDIMENT AND EROSION CONTROL MEASURES MUST BE INCORPORATED INTO THE STORMWATER MANAGEMENT PLAN.

7. TEMPORARY STABILIZATION SHALL BE IMPLEMENTED ON DISTURBED AREAS AND STOCKPILES WHERE GROUND DISTURBING CONSTRUCTION ACTIVITY HAS PERMANENTLY CEASED OR TEMPORARILY CEASED FOR LONGER THAN 14 DAYS.

8. FINAL STABILIZATION MUST BE IMPLEMENTED AT ALL APPLICABLE CONSTRUCTION SITES. FINAL STABILIZATION IS ACHIEVED WHEN ALL GROUND DISTURBING ACTIVITIES ARE COMPLETE AND ALL DISTURBED AREAS EITHER HAVE A UNIFORM VEGETATIVE COVER WITH INDIVIDUAL PLANT DENSITY OF 70 PERCENT OF PRE-DISTURBANCE LEVELS ESTABLISHED OR EQUIVALENT PERMANENT ALTERNATIVE STABILIZATION METHOD IS IMPLEMENTED. ALL TEMPORARY SEDIMENT AND EROSION CONTROL MEASURES SHALL BE REMOVED UPON FINAL STABILIZATION AND BEFORE PERMIT CLOSURE.

9. ALL PERMANENT STORMWATER MANAGEMENT FACILITIES SHALL BE INSTALLED AS DESIGNED IN THE APPROVED PLANS. ANY PROPOSED CHANGES THAT EFFECT THE DESIGN OR FUNCTION OF PERMANENT STORMWATER MANAGEMENT STRUCTURES MUST BE APPROVED BY THE EGM ADMINISTRATOR PRIOR TO IMPLEMENTATION.

10. EARTH DISTURBANCES SHALL BE CONDUCTED IN SUCH A MANNER SO AS TO EFFECTIVELY MINIMIZE ACCELERATED SOIL EROSION AND RESULTING SEDIMENTATION. ALL DISTURBANCES SHALL BE DESIGNED, CONSTRUCTED, AND COMPLETED SO THAT THE EXPOSED AREA OF ANY DISTURBED LAND SHALL BE LIMITED TO THE SHORTEST PRACTICAL PERIOD OF TIME. PRE-EXISTING VEGETATION SHALL BE PROTECTED AND MAINTAINED WITHIN 50 HORIZONTAL FEET OF A WATERS OF THE STATE UNLESS SHOWN TO BE INFEASIBLE AND SPECIFICALLY REQUESTED AND APPROVED.

11. COMPACTION OF SOIL MUST BE PREVENTED IN AREAS DESIGNATED FOR INFILTRATION CONTROL MEASURES OR WHERE FINAL STABILIZATION WILL BE ACHIEVED BY VEGETATIVE COVER. AREAS DESIGNATED FOR INFILTRATION CONTROL MEASURES SHALL ALSO BE PROTECTED FROM SEDIMENTATION DURING CONSTRUCTION UNTIL FINAL STABILIZATION IS ACHIEVED. IF COMPACTION PREVENTION IS NOT FEASIBLE DUE TO SITE CONSTRAINTS, ALL AREAS DESIGNATED FOR INFILTRATION AND VEGETATION CONTROL MEASURES MUST BE LOOSENEED PRIOR TO INSTALLATION OF THE CONTROL MEASURE(S).

12. ANY TEMPORARY OR PERMANENT FACILITY DESIGNED AND CONSTRUCTED FOR THE CONVEYANCE OF STORMWATER AROUND, THROUGH, OR FROM THE EARTH DISTURBANCE AREA SHALL BE A STABILIZED CONVEYANCE DESIGNED TO MINIMIZE EROSION AND THE DISCHARGE OF SEDIMENT OFF SITE.

13. CONCRETE WASH WATER SHALL BE CONTAINED AND DISPOSED OF IN ACCORDANCE WITH THE SWMP. NO WASH WATER SHALL BE DISCHARGED TO OR ALLOWED TO ENTER STATE WATERS, INCLUDING ANY SURFACE OR SUBSURFACE STORM DRAINAGE SYSTEM OR FACILITIES. CONCRETE WASHOUTS SHALL NOT BE LOCATED IN AN AREA WHERE SHALLOW GROUNDWATER MAY BE PRESENT, OR WITHIN 50 FEET OF A SURFACE WATER BODY, CREEK OR STREAM.

14. DURING DEWATERING OPERATIONS OF UNCONTAMINATED GROUND WATER MAY BE DISCHARGED ON SITE, BUT SHALL NOT LEAVE THE SITE IN THE FORM OF SURFACE RUNOFF UNLESS AN APPROVED STATE DEWATERING PERMIT IS IN PLACE.

15. EROSION CONTROL BLANKETING OR OTHER PROTECTIVE COVERING SHALL BE USED ON SLOPES STEEPER THAN 3:1.

16. CONTRACTOR SHALL BE RESPONSIBLE FOR THE REMOVAL OF ALL WASTES FROM THE CONSTRUCTION SITE FOR DISPOSAL IN ACCORDANCE WITH LOCAL AND STATE REGULATORY REQUIREMENTS. NO CONSTRUCTION DEBRIS, TREE SLASH, BUILDING MATERIAL WASTES OR UNUSED BUILDING MATERIALS SHALL BE BURIED, DUMPED, OR DISCHARGED AT THE SITE.

17. WASTE MATERIALS SHALL NOT BE TEMPORARILY PLACED OR STORED IN THE STREET, ALLEY, OR OTHER PUBLIC WAY, UNLESS IN ACCORDANCE WITH AN APPROVED TRAFFIC CONTROL PLAN. CONTROL MEASURES MAY BE REQUIRED BY EL PASO COUNTY ENGINEERING IF DEEMED NECESSARY, BASED ON SPECIFIC CONDITIONS AND CIRCUMSTANCES.

18. TRACKING OF SOILS AND CONSTRUCTION DEBRIS OFF-SITE SHALL BE MINIMIZED. MATERIALS TRACKED OFF-SITE SHALL BE CLEANED UP AND PROPERLY DISPOSED OF IMMEDIATELY.

19. THE OWNER/DEVELOPER SHALL BE RESPONSIBLE FOR THE REMOVAL OF ALL CONSTRUCTION DEBRIS, DIRT, TRASH, ROCK, SEDIMENT, SOIL, AND SAND THAT MAY ACCUMULATE IN ROADS, STORM DRAINS AND OTHER DRAINAGE CONVEYANCE SYSTEMS AND STAKEANCES AS A RESULT OF SITE DEVELOPMENT.

20. THE QUANTITY OF MATERIALS STORED ON THE PROJECT SITE SHALL BE LIMITED, AS MUCH AS PRACTICAL, TO THAT QUANTITY REQUIRED TO PERFORM THE WORK IN AN ORDERLY MANNER. ALL MATERIALS STORED ON-SITE SHALL BE STORED IN A NEAT, ORDERLY MANNER, IN THEIR ORIGINAL CONTAINERS, WITH ORIGINAL MANUFACTURER'S LABELS.

21. NO CHEMICAL(S) HAVING THE POTENTIAL TO BE RELEASED IN STORMWATER ARE TO BE STORED OR USED ON-SITE UNLESS PERMISSION FOR THE USE OF SUCH CHEMICAL(S) IS GRANTED IN WRITING BY THE EGM ADMINISTRATOR. IN GRANTING APPROVAL FOR THE USE OF SUCH CHEMICAL(S), SPECIAL CONDITIONS AND MONITORING MAY BE REQUIRED.

22. BULK STORAGE OF ALLOWED PETROLEUM PRODUCTS OR OTHER ALLOWED LIQUID CHEMICALS IN EXCESS OF 55 GALLONS SHALL REQUIRE ADEQUATE SECONDARY CONTAINMENT PROTECTION TO CONTAIN ALL SPILLS ON-SITE AND TO PREVENT ANY SPILLED MATERIALS FROM ENTERING STATE WATERS. ANY SURFACE OR SUBSURFACE STORM DRAINAGE SYSTEM OR OTHER FACILITIES.

23. NO PERSON SHALL CAUSE THE IMPEDIMENT OF STORMWATER FLOW IN THE CURB AND GUTTER OR DITCH EXCEPT WITH APPROVED SEDIMENT CONTROL MEASURES.

24. OWNER/DEVELOPER AND THEIR AGENTS SHALL COMPLY WITH THE "COLORADO WATER QUALITY CONTROL ACT" (TITLE 25, ARTICLE 8, CRS), AND THE "CLEAN WATER ACT" (33 USC 1344), IN ADDITION TO THE REQUIREMENTS OF THE LAND DEVELOPMENT CODE, DCM VOLUME II, AND THE EGM APPENDIX I. ALL APPROPRIATE PERMITS MUST BE OBTAINED BY THE CONTRACTOR PRIOR TO CONSTRUCTION (1041, NPDES, FLOODPLAIN, 404, FUGITIVE DUST, ETC.). IN THE EVENT OF CONFLICTS BETWEEN THESE REQUIREMENTS AND OTHER LAWS, RULES, OR REGULATIONS OF OTHER FEDERAL, STATE, LOCAL, OR COUNTY AGENCIES, THE MOST RESTRICTIVE LAWS, RULES, OR REGULATIONS SHALL APPLY.

25. ALL CONSTRUCTION TRAFFIC MUST ENTER/EXIT THE SITE ONLY AT APPROVED CONSTRUCTION ACCESS POINTS.

26. PRIOR TO CONSTRUCTION THE PERMITTEE SHALL VERIFY THE LOCATION OF EXISTING UTILITIES.

27. A WATER SOURCE SHALL BE AVAILABLE ON SITE DURING EARTHWORK OPERATIONS AND SHALL BE UTILIZED AS REQUIRED TO MINIMIZE DUST FROM EARTHWORK EQUIPMENT AND WIND.

28. THE SOILS REPORT FOR THIS SITE HAS BEEN PREPARED BY ENTECH ENGINEERING INC JOB NO. 241 483 DATED DECEMBER 23, 2024 AND SHALL BE CONSIDERED A PART OF THESE PLANS.

29. AT LEAST TEN (10) DAYS PRIOR TO THE ANTICIPATED START OF CONSTRUCTION, FOR PROJECTS THAT WILL DISTURB ONE (1) ACRE OR MORE, THE OWNER OR OPERATOR OF CONSTRUCTION ACTIVITY SHALL SUBMIT A PERMIT APPLICATION FOR STORMWATER DISCHARGE TO THE COLORADO DEPARTMENT OF PUBLIC HEALTH AND ENVIRONMENT, WATER QUALITY DIVISION. THE APPLICATION CONTAINS CERTIFICATION OF COMPLETION OF A STORMWATER MANAGEMENT PLAN (SWMP), OF WHICH THIS GRADING AND EROSION CONTROL PLAN MAY BE A PART. FOR INFORMATION OR APPLICATION MATERIALS CONTACT:

COLORADO DEPARTMENT OF PUBLIC HEALTH AND ENVIRONMENT
WATER QUALITY CONTROL DIVISION
WQCD - PERMITS
4300 CHERRY CREEK DRIVE SOUTH
DENVER, CO 80246-1530
ATTN: PERMITS UNIT

GENERAL NOTES

1. UNDERGROUND FACILITIES, STRUCTURES AND UTILITIES HAVE BEEN DRAWN FROM AVAILABLE RECORDS AND/OR SURFACE EVIDENCE. THE LOCATION OF ALL UTILITIES MAY NOT BE SHOWN OR MAY NOT HAVE BEEN LOCATED. BELOW GROUND LOCATIONS HAVE NOT BEEN PERFORMED. THEREFORE, THE RELATIONSHIP BETWEEN PROPOSED WORK AND EXISTING FACILITIES, STRUCTURES AND UTILITIES MUST BE CONSIDERED APPROXIMATE. CONTRACTOR SHALL BE RESPONSIBLE FOR CONTACTING ALL SUBSURFACE UTILITY OWNERS PRIOR TO BEGINNING WORK TO DETERMINE LOCATION OF UTILITY FACILITIES. ALL UTILITIES SHALL BE LOCATED PRIOR TO ANY EARTH WORK OR DIGGING (1-800-922-1987). THE CONTRACTOR SHALL BE FULLY RESPONSIBLE FOR ANY AND ALL DAMAGES WHICH MAY BE OCCASIONED BY THE CONTRACTOR'S FAILURE TO EXACTLY LOCATE AND PRESERVE ANY AND ALL UTILITIES.

2. EXISTING CONDITIONS SHALL BE VERIFIED BY THE GENERAL CONTRACTOR. DISCREPANCIES ARE TO BE REPORTED TO THE ENGINEER PRIOR TO CONSTRUCTION.

3. SOIL PREPARATION, SEEDING, AND MULCHING FOR AN ESTIMATED _____ ACRES WILL BE REQUIRED ON ALL DISTURBED AREAS NOT SURFACED. THE FOLLOWING TYPES AND RATES SHALL BE USED PER THE EL PASO COUNTY CONSERVATION DISTRICT "LOW GROW GRASS SEED MIX":

GRASS	AMOUNT IN % OF MIX
WESTERN WHEATGRASS	24%
BLUE GRAMA, NATIVE	20%
BUFFALOGRASS	18%
SIDEOTS GRAMA	13%
GREEN NEEDLEGRASS	6%
SAND DROSEED	1.5%

4. SEEDING APPLICATION: DRILLED TO A DEPTH OF .25" TO .50" INTO SOIL WHERE POSSIBLE. BROADCAST AND RAKED TO COVER ON STEEPER THAN 3:1 SLOPES WHERE ACCESS IS LIMITED OR UNSAFE FOR EQUIPMENT.

5. MULCHING REQUIREMENT AND APPLICATION: 2.0 TONS PER ACRE NATIVE HAY MECHANICALLY CRIMPED INTO SOIL.


6. ALL STORM DRAIN SHALL BE REINFORCED CONCRETE PIPE. ALL CULVERTS SHALL BE PLACED COMPLETE WITH FLARED END SECTIONS. ALL STORM DRAIN FITTINGS AND BENDS SHALL BE PRE-CAST. STORM DRAIN PIPE MAY ALSO BE CORRUGATED METAL OR HDPE, PLACED IN ACCORDANCE WITH EL PASO COUNTY SPECIFICATIONS.

7. CONTRACTOR WILL BE RESPONSIBLE FOR SCHEDULING A PRE-CONSTRUCTION MEETING HELD PRIOR TO CONSTRUCTION WITH EPC-PCD, ENGINEER, AND CONTRACTOR IN ATTENDANCE.

8. CONTRACTOR IS RESPONSIBLE FOR ALL OF HIS OPERATIONS ON THE SITE. CONTRACTOR SHALL OBSERVE ALL SAFETY AND OSHA REGULATIONS DURING CONSTRUCTION OPERATIONS. TRENCH WIDTHS AND SLOPE ANGLES SHALL BE DETERMINED BY THE CONTRACTOR IN THE FIELD AND ACCORDING TO SAFETY AND OSHA REGULATIONS.

9. ALL NECESSARY PERMITS, SUCH AS SWMP, FUGITIVE DUST, ACCESS, C.O.E. 404, ESQCP PERMIT, ETC. SHALL BE OBTAINED PRIOR TO CONSTRUCTION.

10. CONTRACTOR TO ADHERE TO THE APPROVED GRADING AND EROSION CONTROL (GEC) PLAN AND STORM WATER MANAGEMENT PLAN (SWMP), EPC PCD FILE NO. _____

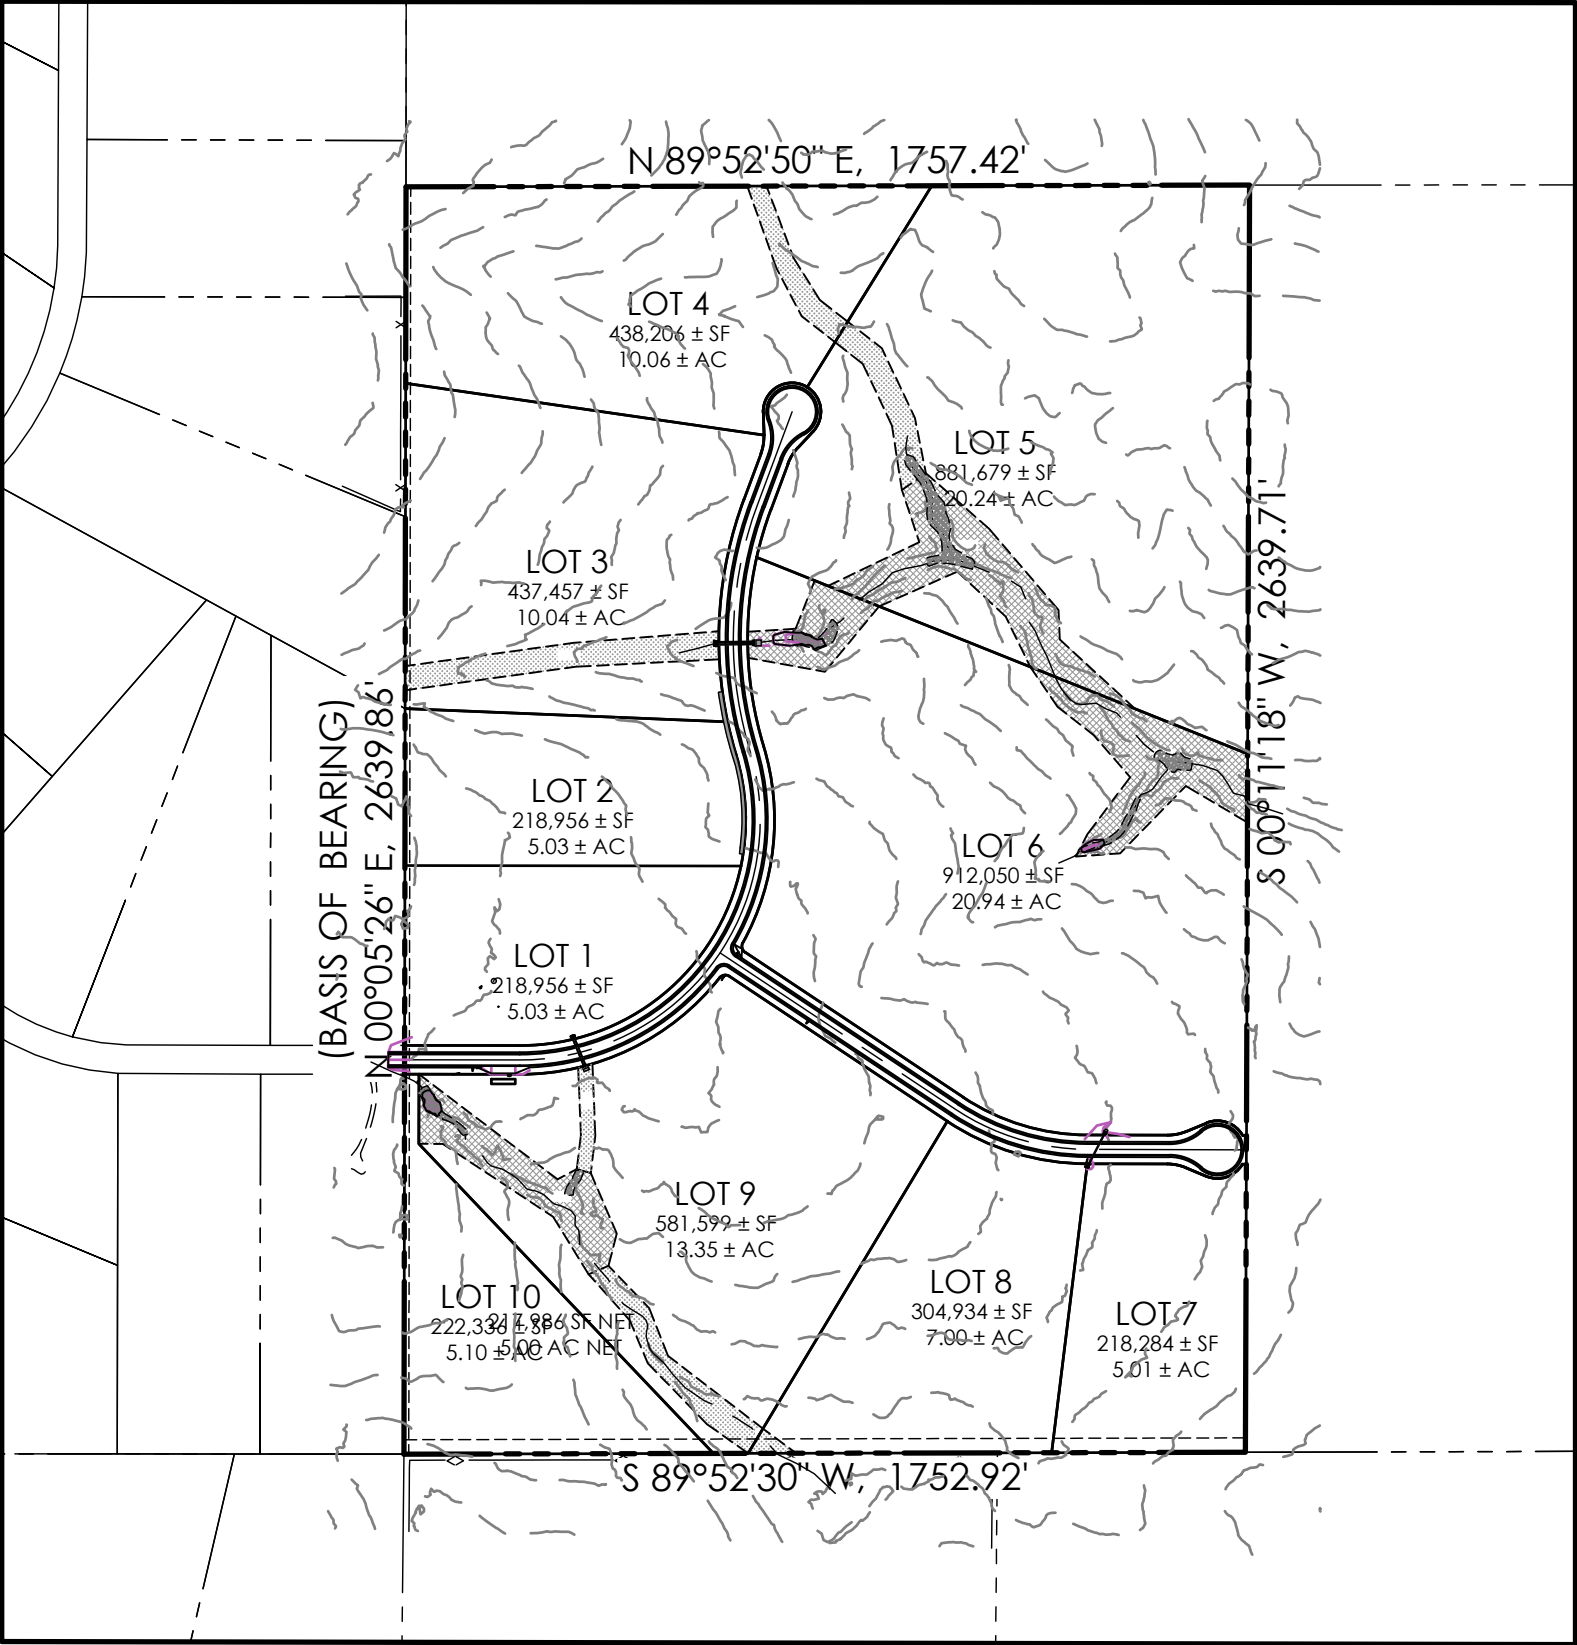

STANDARD EL PASO COUNTY CONSTRUCTION PLAN NOTES

1. ALL DRAINAGE AND ROADWAY CONSTRUCTION SHALL MEET THE STANDARDS AND SPECIFICATIONS OF THE CITY OF COLORADO SPRINGS/EL PASO COUNTY DRAINAGE CRITERIA MANUAL, VOLUMES 1 AND 2, AND THE EL PASO COUNTY ENGINEERING CRITERIA MANUAL.

2. CONTRACTOR SHALL BE RESPONSIBLE FOR THE NOTIFICATION AND FIELD NOTIFICATION OF ALL EXISTING UTILITIES, WHETHER SHOWN ON THE PLANS OR NOT, BEFORE BEGINNING CONSTRUCTION. LOCATION OF EXISTING UTILITIES SHALL BE VERIFIED BY THE CONTRACTOR PRIOR TO CONSTRUCTION. CALL 811 TO CONTACT THE UTILITY NOTIFICATION CENTER OF COLORADO (UNCC).

3. CONTRACTOR SHALL KEEP A COPY OF THESE APPROVED PLANS, THE GRADING AND EROSION CONTROL PLAN, THE STORMWATER MANAGEMENT PLAN (SWMP), THE SOILS AND GEOTECHNICAL REPORT, AND THE APPROPRIATE DESIGN AND CONSTRUCTION STANDARDS AND SPECIFICATIONS AT THE JOB SITE AT ALL TIMES, INCLUDING THE FOLLOWING:
a. EL PASO COUNTY ENGINEERING CRITERIA MANUAL (ECM)
b. CITY OF COLORADO SPRINGS/EL PASO COUNTY DRAINAGE CRITERIA MANUAL, VOLUMES 1 AND 2
c. COLORADO DEPARTMENT OF TRANSPORTATION (CDOT) STANDARD SPECIFICATIONS FOR ROAD AND BRIDGE CONSTRUCTION
d. CDOT M & S STANDARDS

4. NOTWITHSTANDING ANYTHING DEPICTED IN THESE PLANS IN WORDS OR GRAPHIC REPRESENTATION, ALL DESIGN AND CONSTRUCTION RELATED TO ROADS, STORM DRAINAGE AND EROSION CONTROL SHALL CONFORM TO THE STANDARDS AND REQUIREMENTS OF THE MOST RECENT VERSION OF THE RELEVANT ADOPTED EL PASO COUNTY STANDARDS, INCLUDING THE LAND DEVELOPMENT CODE, THE ENGINEERING CRITERIA MANUAL, THE DRAINAGE CRITERIA MANUAL, AND THE DRAINAGE CRITERIA MANUAL VOLUME 2. ANY DEVIATIONS FROM REGULATIONS AND STANDARDS MUST BE REQUESTED, AND APPROVED, IN WRITING. ANY MODIFICATIONS NECESSARY TO MEET CRITERIA AFTER-THE-FACT WILL BE ENTIRELY THE DEVELOPER'S RESPONSIBILITY TO RECTIFY.

5. IT IS THE DESIGN ENGINEER'S RESPONSIBILITY TO ACCURATELY SHOW EXISTING CONDITIONS, BOTH ON-SITE AND OFF-SITE, ON THE CONSTRUCTION PLANS. ANY MODIFICATIONS NECESSARY DUE TO CONFLICTS, OMISSIONS, OR CHANGED CONDITIONS WILL BE ENTIRELY THE DEVELOPER'S RESPONSIBILITY TO RECTIFY.

6. CONTRACTOR SHALL SCHEDULE A PRE-CONSTRUCTION MEETING WITH EL PASO COUNTY PLANNING AND COMMUNITY DEVELOPMENT DEPARTMENT (PCD) - INSPECTIONS, PRIOR TO STARTING CONSTRUCTION.

7. IT IS THE CONTRACTOR'S RESPONSIBILITY TO UNDERSTAND THE REQUIREMENTS OF ALL JURISDICTIONAL AGENCIES AND TO OBTAIN ALL REQUIRED PERMITS, INCLUDING BUT NOT LIMITED TO EL PASO COUNTY EROSION AND STORMWATER QUALITY CONTROL PERMIT (ESQCP), REGIONAL BUILDING FLOODPLAIN DEVELOPMENT PERMIT, U.S. ARMY CORPS OF ENGINEERS-ISSUED 401 AND/OR 404 PERMITS, AND COUNTY AND STATE FUGITIVE DUST PERMITS.

8. CONTRACTOR SHALL NOT DEVIATE FROM THE PLANS WITHOUT FIRST OBTAINING WRITTEN APPROVAL FROM THE DESIGN ENGINEER AND PCD. CONTRACTOR SHALL NOTIFY THE DESIGN ENGINEER IMMEDIATELY UPON DISCOVERY OF ANY ERRORS OR INCONSISTENCIES.

9. ALL STORM DRAIN PIPE SHALL BE CLASS III RCP UNLESS OTHERWISE NOTED AND APPROVED BY DSD.

10. CONTRACTOR SHALL COORDINATE GEOTECHNICAL TESTING PER EGM STANDARDS. PAVEMENT DESIGN SHALL BE APPROVED BY EL PASO COUNTY PCD PRIOR TO PLACEMENT OF CURB AND GUTTER AND PAVEMENT.

11. ALL CONSTRUCTION TRAFFIC MUST ENTER/EXIT THE SITE AT APPROVED CONSTRUCTION ACCESS POINTS.

12. SIGHT VISIBILITY TRIANGLES AS IDENTIFIED IN THE PLANS SHALL BE PROVIDED AT ALL INTERSECTIONS. OBSTRUCTIONS GREATER THAN 18 INCHES ABOVE FLOWLINE ARE NOT ALLOWED WITHIN SIGHT TRIANGLES.

13. SIGNING AND STRIPING SHALL COMPLY WITH EL PASO COUNTY DOT AND MUTCD CRITERIA. (IF APPLICABLE, ADDITIONAL SIGNING AND STRIPING NOTES WILL BE PROVIDED.)

14. CONTRACTOR SHALL OBTAIN ANY PERMITS REQUIRED BY EL PASO COUNTY DOT, INCLUDING WORK WITHIN THE RIGHT-OF-WAY AND SPECIAL TRANSPORT PERMITS.

15. THE LIMITS OF CONSTRUCTION SHALL REMAIN WITHIN THE PROPERTY LINE UNLESS OTHERWISE NOTED. THE OWNER/DEVELOPER SHALL OBTAIN WRITTEN PERMISSION AND EASEMENTS, WHERE REQUIRED, FROM ADJOINING PROPERTY OWNER(S) PRIOR TO ANY OFF-SITE DISTURBANCE, GRADING, OR CONSTRUCTION.

SHEET INDEX

PLAN SET SHEET NO.	SHEET INDEX	M.V.E. DRAWING NO.
C1.1 (1 OF 5)	COVER SHEET	61223-CON-CS
C1.2 (2 OF 5)	PLAN/PROFILE SHEET	61223-CON-PP
C1.3 (3 OF 5)	PLAN/PROFILE SHEET	61223-CON-PP
C1.4 (4 OF 5)	PLAN/PROFILE SHEET	61223-CON-PP
C1.5 (5 OF 5)	CULVERT & DETAILS SHEET	61223-CON-PP

COMPANIES AND AGENCIES

OWNER/DEVELOPER

THADDEUS J. JAROSZ
8550 KENOSHA DRIVE
COLORADO SPRINGS, CO 80908

ENGINEER

M.V.E., INC.
1903 LELARAY STREET, STE 200
COLORADO SPRINGS, CO 80909
(719) 635-5736

EL PASO COUNTY PLANNING

EPC PLANNING AND COMMUNITY DEVELOPMENT
2880 INTERNATIONAL CIRCLE, SUITE 110
COLORADO SPRINGS, CO 80910
(719) 520-4300

STREETS AND RIGHTS-OF-WAY

EPC DEPARTMENT OF PUBLIC WORKS
3275 AKERS DRIVE
COLORADO SPRINGS, CO 80922
(719) 520-4460

ELECTRIC

MOUNTAIN VIEW ELECTRIC ASSOCIATION
11140 EAST WOODMEN ROAD
FALCON, CO 80831
(719) 495-2283

TELEPHONE

CENTURYLINK
555 TECH CENTER DRIVE SUITE 110
COLORADO SPRINGS, CO 80919
(866) 301-9889

NATURAL GAS

BLACK HILLS ENERGY
18965 BASE CAMP RD, A-7
MONUMENT, CO 80132
(719) 488-0739

OWNERS STATEMENT

I, THADDEUS J. JAROSZ, THE OWNER/DEVELOPER HAVE READ AND WILL COMPLY WITH ALL OF THE REQUIREMENTS SPECIFIED IN THESE DETAILED PLANS AND SPECIFICATIONS.

THADDEUS J. JAROSZ
OWNER

DATE

DESIGN ENGINEER'S STATEMENT

THESE DETAILED PLANS AND SPECIFICATIONS WERE PREPARED UNDER MY DIRECTION AND SUPERVISION. SAID PLANS AND SPECIFICATIONS HAVE BEEN PREPARED ACCORDING TO THE CRITERIA ESTABLISHED BY THE COUNTY FOR DETAILED ROADWAY, DRAINAGE, GRADING AND EROSION CONTROL PLANS AND SPECIFICATIONS, AND SAID PLANS AND SPECIFICATIONS ARE IN CONFORMITY WITH APPLICABLE MASTER DRAINAGE PLANS AND MASTER TRANSPORTATION PLANS. SAID PLANS AND SPECIFICATIONS MEET THE PURPOSES FOR WHICH THE PARTICULAR ROADWAY AND DRAINAGE FACILITIES ARE DESIGNED AND ARE CORRECT TO THE BEST OF MY KNOWLEDGE AND BELIEF. I ACCEPT RESPONSIBILITY FOR ANY LIABILITY CAUSED BY ANY NEGLIGENT ACTS, ERRORS OR OMISSIONS ON MY PART IN PREPARATION OF THESE DETAILED PLANS AND SPECIFICATIONS

DAVID R. GORMAN, P.E.
COLORADO NO. 31672
FOR AND ON BEHALF OF M.V.E., INC.

EL PASO COUNTY

COUNTY PLAN REVIEW IS PROVIDED ONLY FOR GENERAL CONFORMANCE WITH COUNTY DESIGN CRITERIA. THE COUNTY IS NOT RESPONSIBLE FOR THE ACCURACY AND ADEQUACY OF THE DESIGN, DIMENSIONS, AND/OR ELEVATIONS WHICH SHALL BE CONFIRMED AT THE JOB SITE. THE COUNTY THROUGH THE APPROVAL OF THIS DOCUMENT ASSUMES NO RESPONSIBILITY FOR COMPLETENESS AND/OR ACCURACY OF THIS DOCUMENT.

FILED IN ACCORDANCE WITH THE REQUIREMENTS OF THE EL PASO COUNTY LAND DEVELOPMENT CODE, DRAINAGE CRITERIA MANUAL, AND ENGINEERING CRITERIA MANUAL AS AMENDED.

JOSHUA PALMER, P.E.
COUNTY ENGINEER / EGM ADMINISTRATOR

DATE

PCD PROJ. NO. SF254

AS-BUILT RECORD SET



M.V.E., INC.


ABBREVIATIONS

EL	ELEVATION	ROW	RIGHT-OF-WAY
PC	POINT OF CURVATURE	R	RADIUS
PI	POINT OF INTERSECTION	T	TANGENT
PT	POINT OF TANGENCY	L	LENGTH
PCR	POINT OF CURVE RETURN	LF	LINEAR FEET
PRC	POINT OF REVERSE CURVATURE	CL	CENTERLINE
PVC	POINT OF VERTICAL CURVATURE	X.XX' R	DIMENSION RIGHT OF CL
PVI	POINT OF VERTICAL INTERSECTION	X.XX' L	DIMENSION LEFT OF CL
PVT	POINT OF VERTICAL TANGENCY	PL	PROPERTY LINE
G8	GRADE BREAK	PVRC	POINT OF VERT REVERSE CURVATURE
CSP	CORRUGATED STEEL PIPE	VC	VERTICAL CURVE
RCP	REINFORCED CONCRETE PIPE	AP	ANGLE POINT
CBC	CONCRETE BOX CULVERT	STA	STATION
TBC	TOP BACK CURB	INV	INVERT
TC	TOP OF CURB	RG	RAIN GARDEN
BT	BEGIN TAPER	SFB	SAND FILTER BASIN
ET	END TAPER		
EC	EDGE OF CONCRETE		

LEGEND

EXISTING	PROPOSED
BOUNDARY LINE	BOUNDARY LINE
ADJACENT BOUNDARY LINE ..	LOT LINE
ADJACENT LOT LINE	EASEMENT LINE
EASEMENT LINE	CENTER LINE
INDEX CONTOUR	INDEX CONTOUR
INTERMEDIATE CONTOUR	INTERMEDIATE CONTOUR
TEST HOLE LOCATION	SLOPE / GRADE
CURB AND GUTTER	SPOT ELEVATION
SIGN	
FENCE	
LIGHT POLE	
MANHOLE	
UTILITY POLE	
MISC OBJECT	
PILE	
CULVERT	
ROCK	
MAILBOX	
TREE	
RIPRAP	
POLE-ANCHOR	


CALL BEFORE YOU DIG...
1-800-922-1987
48 HOURS BEFORE YOU DIG, CALL UTILITY LOCATORS FOR LOCATING GAS, ELECTRIC, WATER, AND WASTEWATER

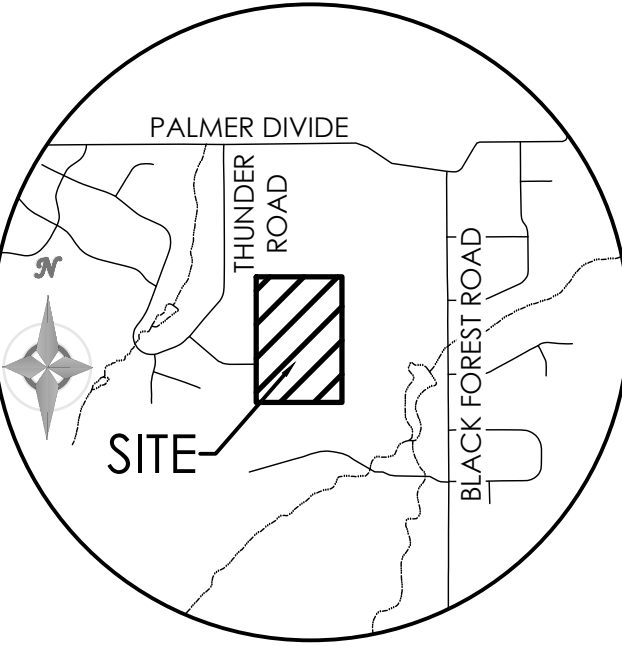

VICINITY MAP

NOT TO SCALE

BENCHMARK
THE BENCHMARK FOR THESE PLANS IS THE SOUTHWEST PROPERTY CORNER, A REBAR & CAP, ALESSI, PLS 30130.
ELEVATION = 7385.63' (NAV88).

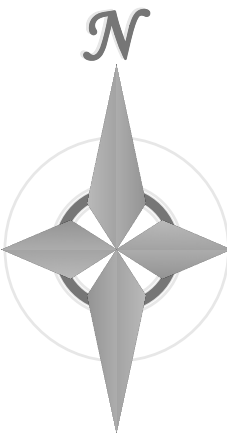

100 0 200 400 800
1" = 400' 1:4,800



REVISIONS

DESIGNED BY
DRAWN BY
CHECKED BY
AS-BUILTS BY
CHECKED BY

TABLE ROCK HOMESTEADS



CONSTRUCTION PLANS

COVER SHEET

C1.1
MVE PROJECT
MVE DRAWING
61223
CON-CS

APRIL 16, 2025
SHEET 1 OF 5

MATCHLINE
STA 11+00.00
N: 1468948.72
E: 3225197.80

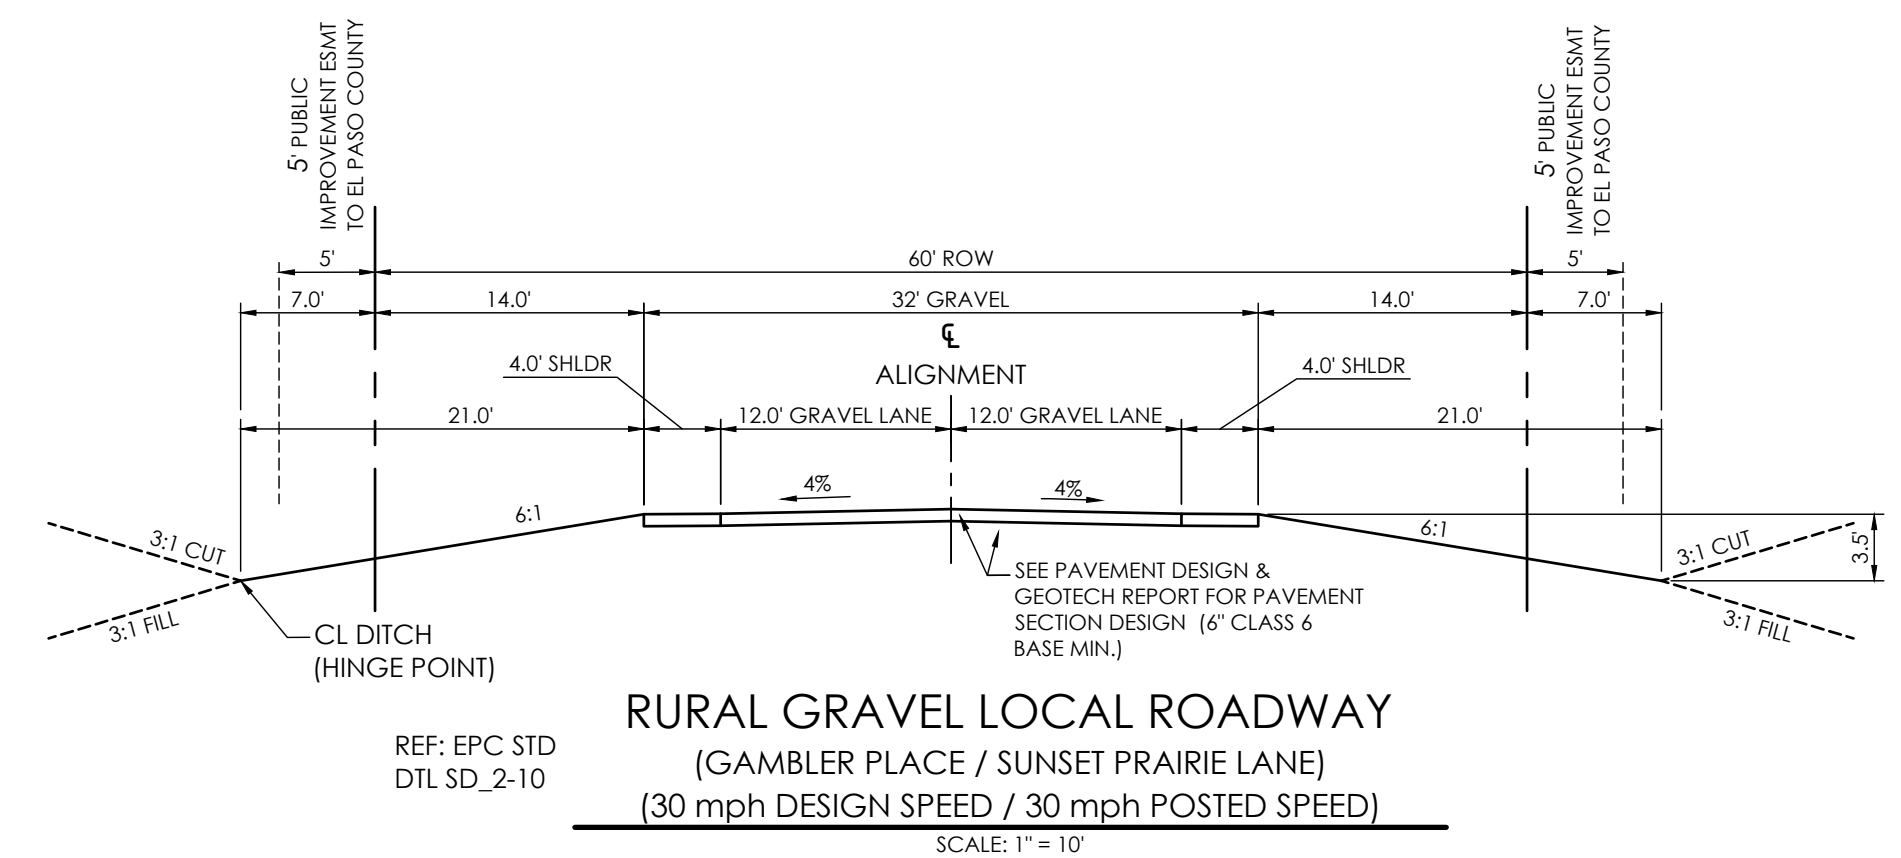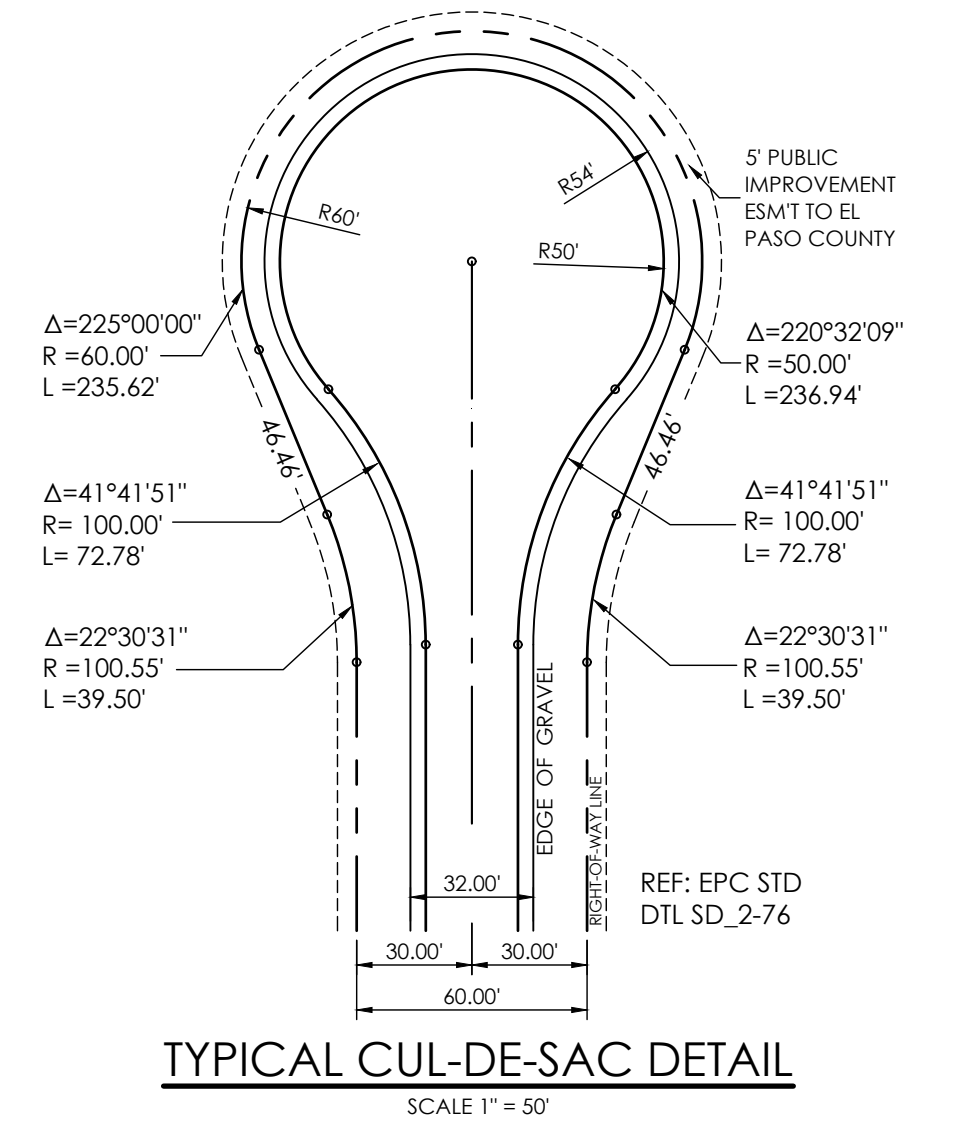

A circular professional engineer seal for David Raymond Gorman, Colorado License 31672, dated 9/30/26. The seal includes the text "COLORADO LICENSED", "DAVID RAYMOND GORMAN", "9/30/26", "31672", and "PROFESSIONAL ENGINEER". A signature is written across the seal.

GAMBLER PLACE
FROM STA 00+00.00
TO STA 11+00.00
TABLE ROCK HOMESTEADS
C1.2
SHEET 2 OF 5

STREET NAME
CENTERLINE DATA:

MATCHLINE
STA 11+00.00
N: 1468948.72
E: 3225197.80

PRC = 12+73.51
PT = 17+94.66
L = 521.15'
Δ = 37°19'30"
R = 800'




PT 17+94.66
N: 1469631.84
E: 3225192.85

③
S 20°26'35" W
206.43'


PI 20+01.09
N: 1469825.26
E: 3225264.94

④
S 20°26'35" W
100.00'

END
STA 21+01.09
N: 1469918.96
E: 3225299.87

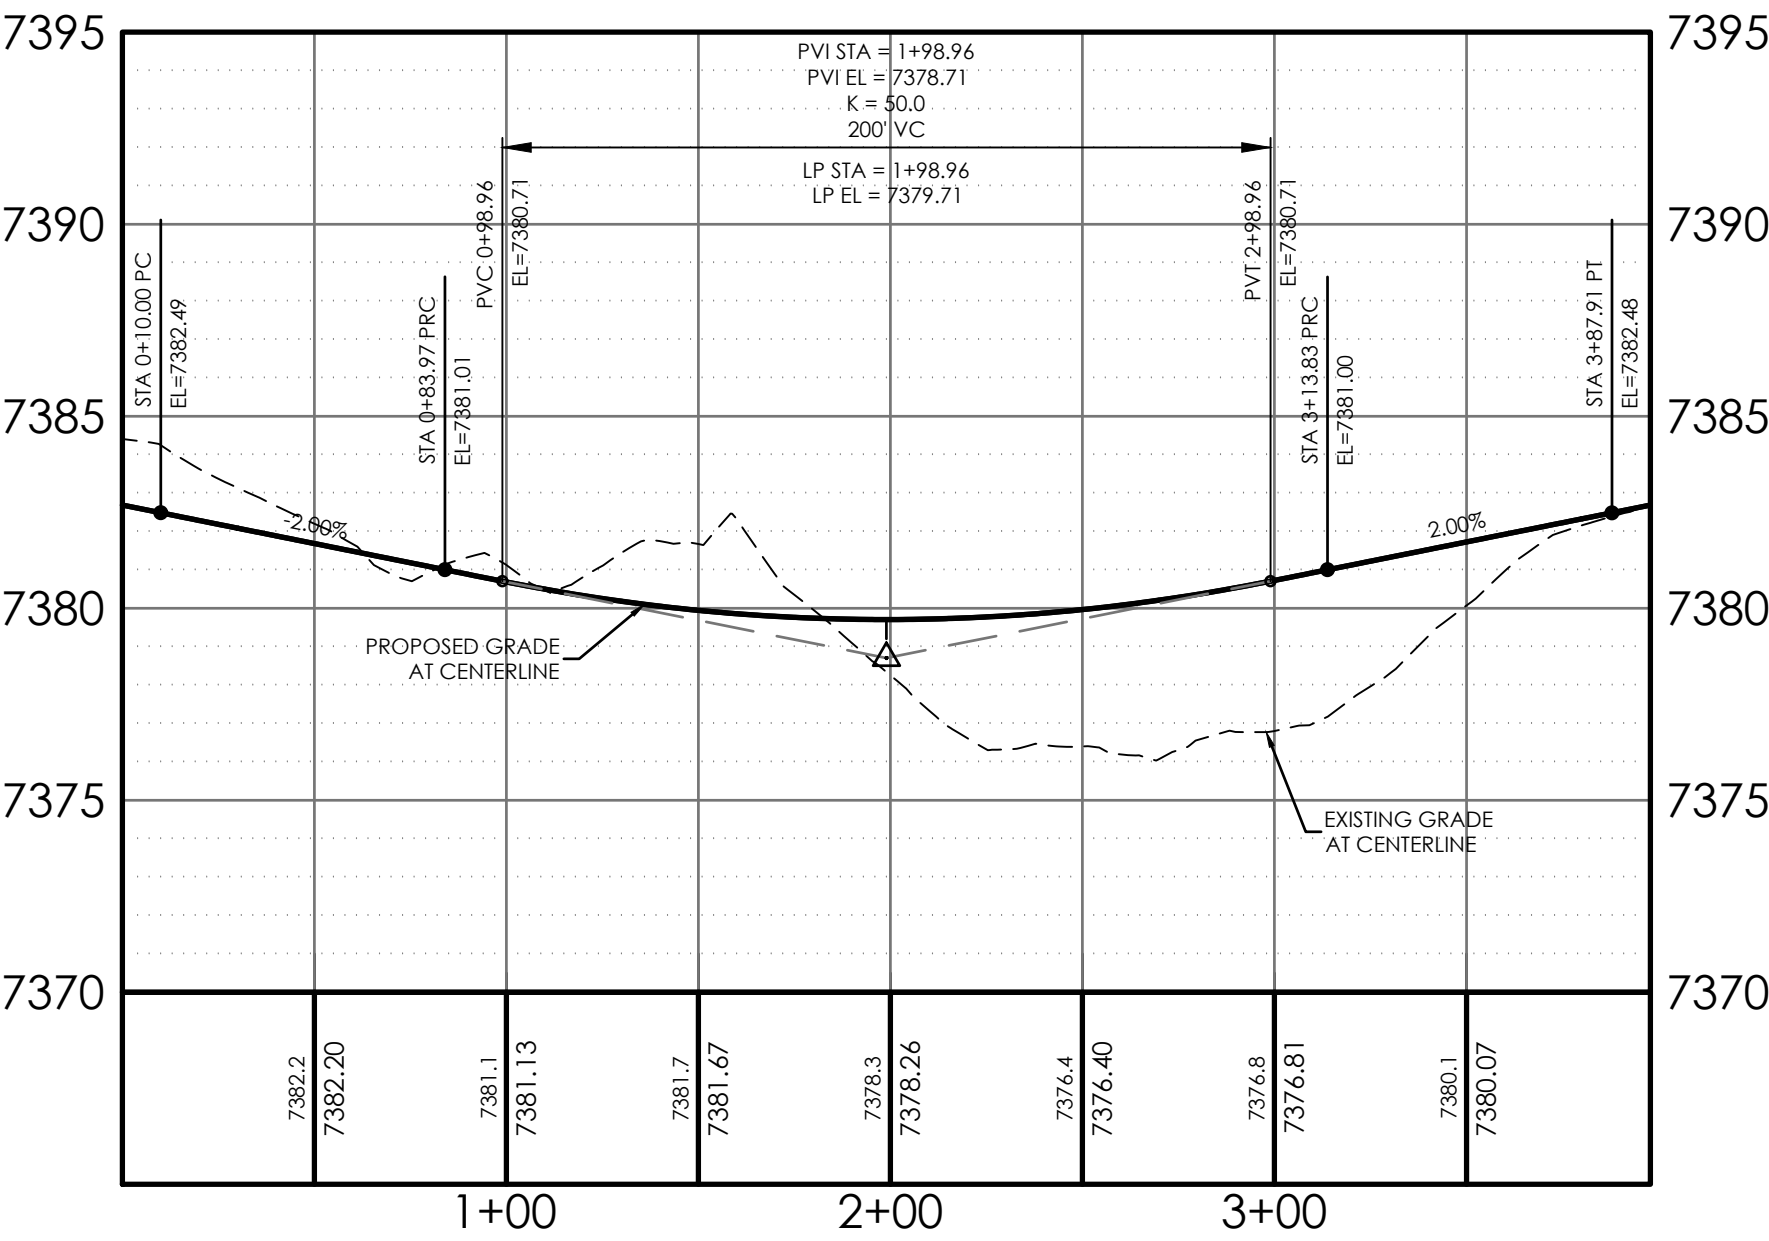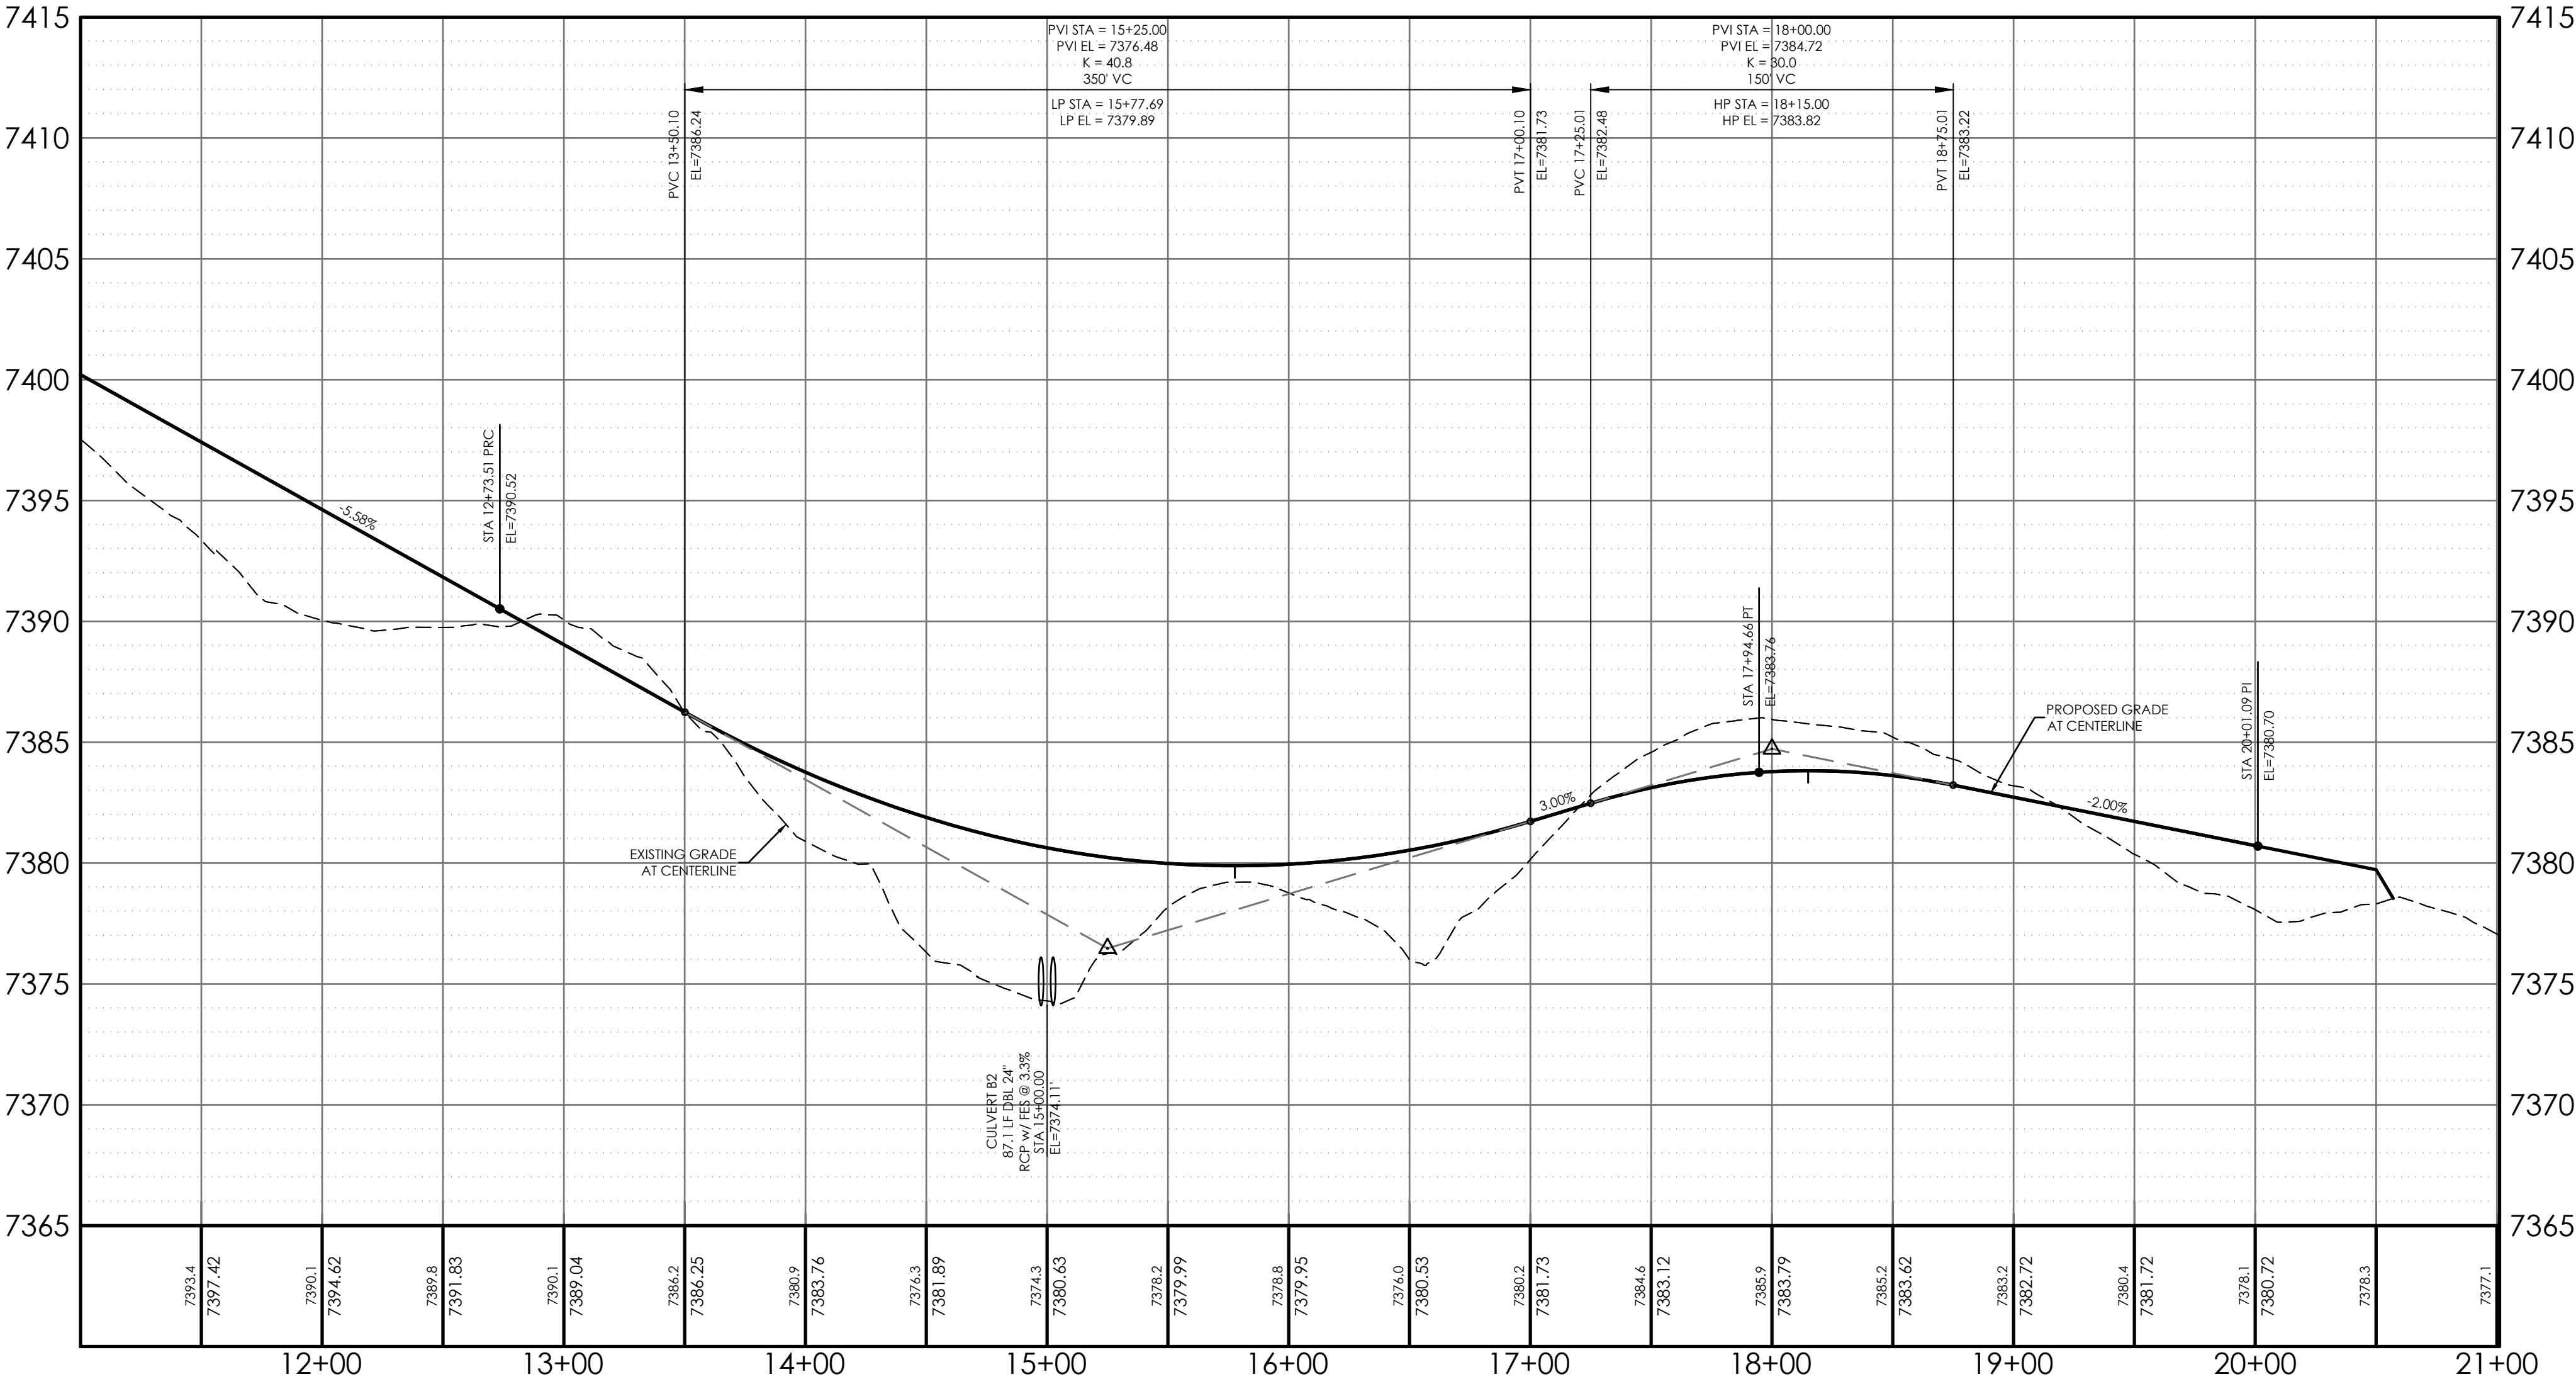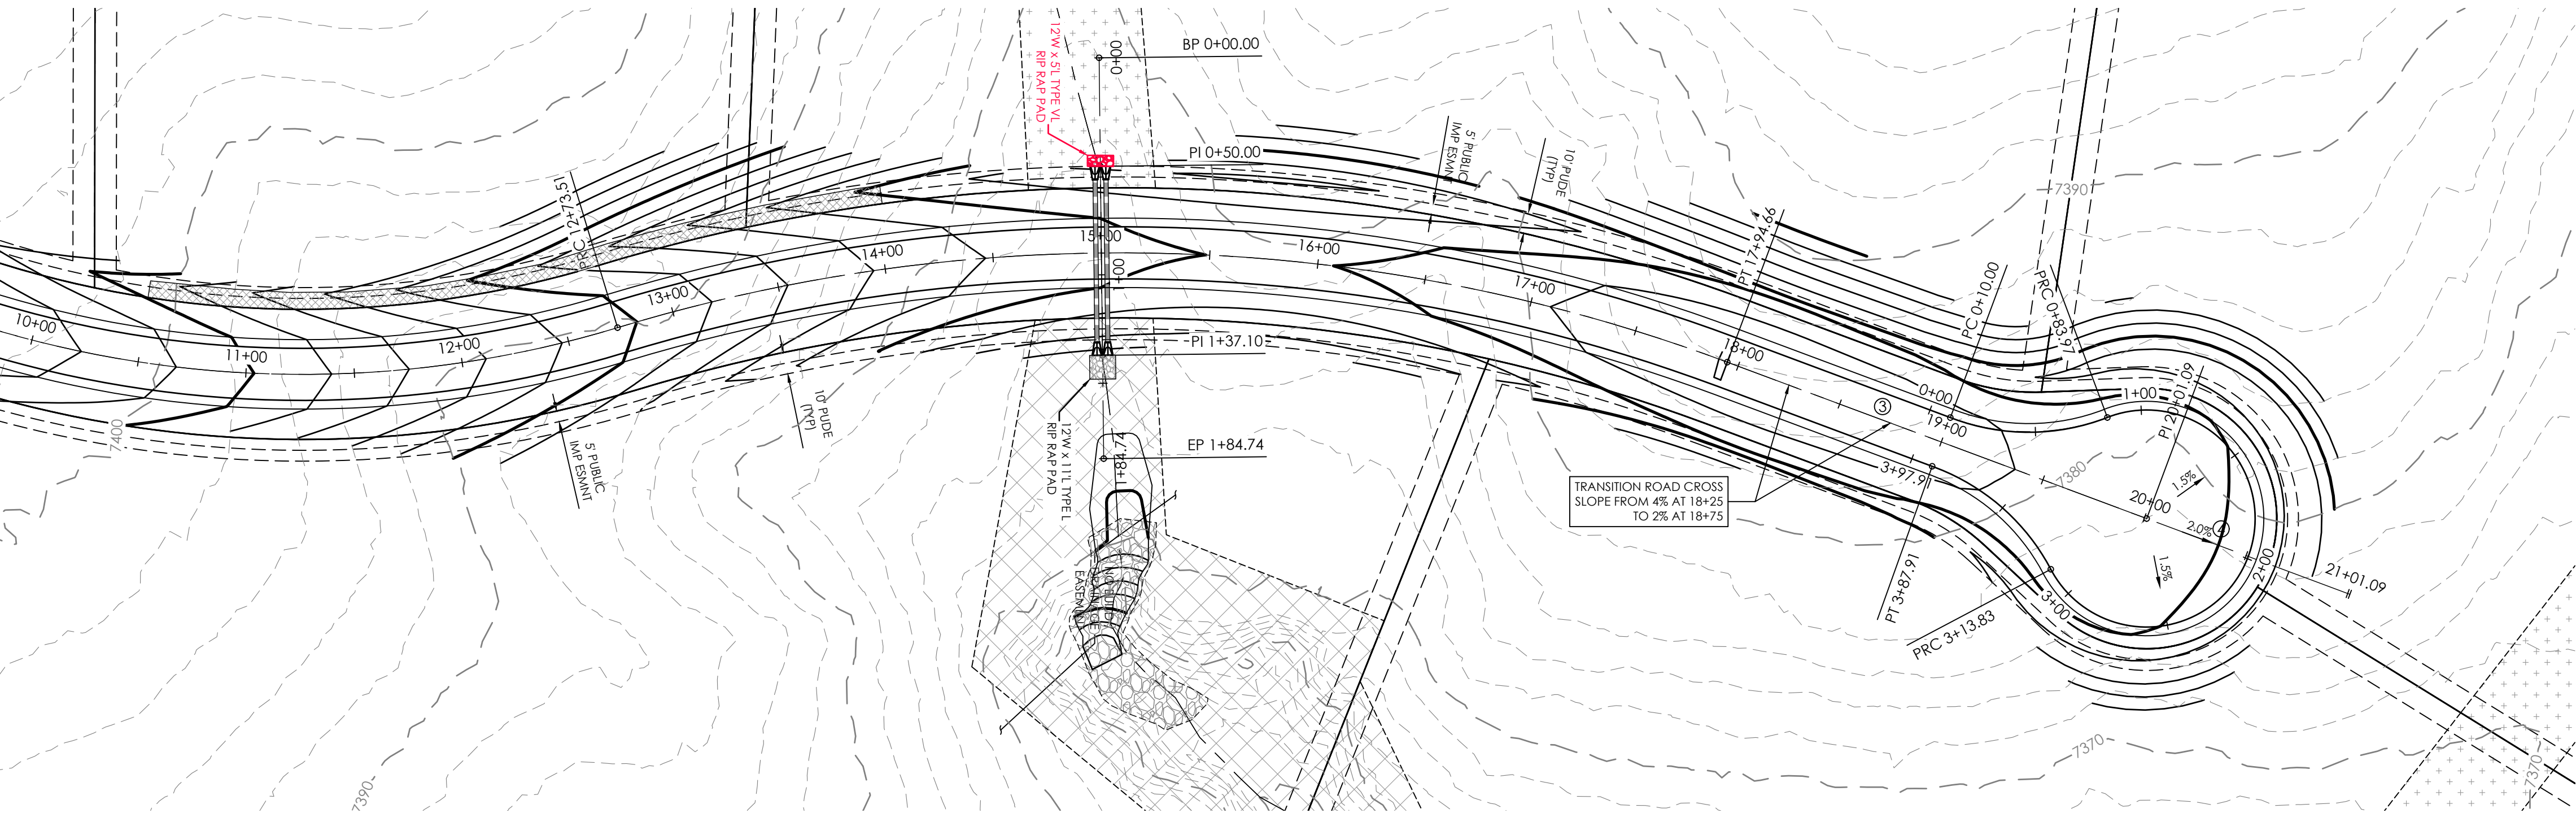

CUL-DE-SAC BULB PROFILE
SCALE 1" = 50'

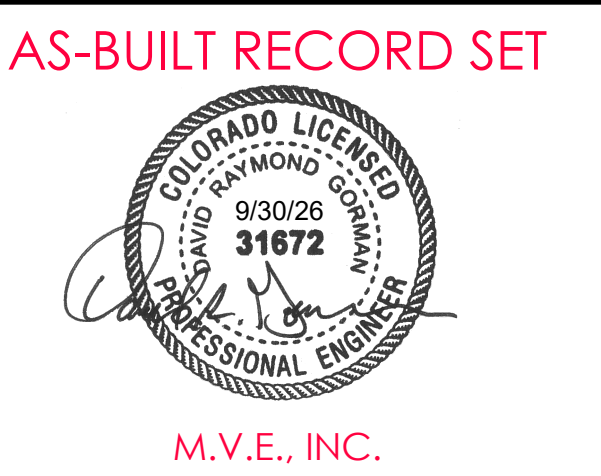

BENCHMARK: THE BENCHMARK FOR THESE PLANS IS THE NO. 4 REBAR, LOCATED APPROX. 40' EAST OF THE PROPOSED ROADWAY & 10' NORTH OF EXISTING OLD RANCH ROAD EDGE OF GRAVEL. ELEVATION = 7273.40' (NAVD88).

BASIS OF BEARINGS: THE SOUTH PROPERTY LINE OF LOT 4 WITH BEARING N89°58'40"E AND A DISTANCE OF 609.76'.

DESIGN DATA:

SIDEWALKS: WIDTH N/A

LOCATION: Attached ☐ Detached ☐

DESIGN SPEED 20 MPH

CURB TYPE: A ☐ B ☐ C ☐ D ☐

ROW WIDTH: N/A FL-FL N/A

STREET TYPE: RURAL GRAVEL LOCAL

PAVEMENT:

TYPE: HMA ☐ PCC ☐



THICKNESS: _____

COMPOSITE SECTION:

HMA _____ BASE _____

SUBGRADE STABILIZATION:

CHEMICAL TYPE _____ MECHANICAL THICKNESS _____

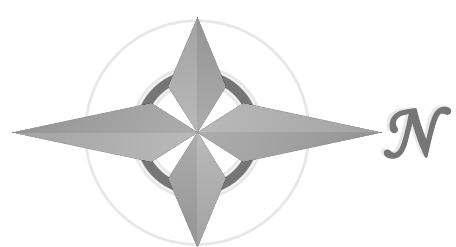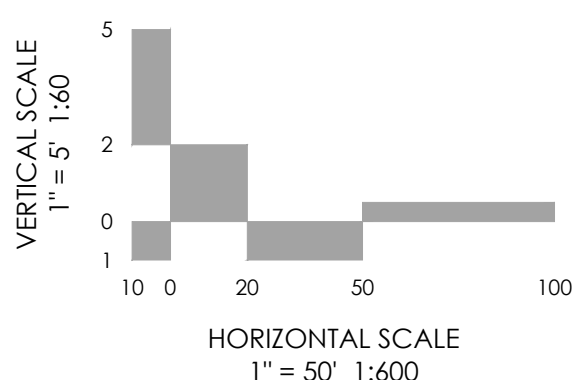

REVISIONS

MVE PROJECT **61223**
MVE DRAWING **-CON-PP**
APRIL 16, 2025
DESIGNED BY _____
DRAWN BY _____
CHECKED BY _____
AS-BUILT BY _____
CHECKED BY _____

GAMBLER PLACE
FROM STA 11+00.00
TO STA 21+01.09
TABLE ROCK HOMESTEADS
C1.3
SHEET 3 OF 5

SUNSET PRAIRIE LANE BEGIN
CENTERLINE DATA: STATION 0+00.00
N: 1468753.47
E: 3225031.61'

⑤
S 53°23'16" E
100.00'

STATION EQUATION
STA 1+00.00, STA 8+32.87
N: 1468698.11'
E: 3225114.89'

⑥
S 53°23'16" E
588.43'



PC = 6+88.43
PT = 9+80.11
L = 291.68'
Δ = 33°25'26"
R = 500'

⑦
S 89°48'42" E
271.31'


PI 12+51.42
N: 1468287.88'
E: 3226151.38'

⑧
S 89°48'42" E
160.00'

END
STA 14+11.42
N: 1468287.36'
E: 3226311.38'

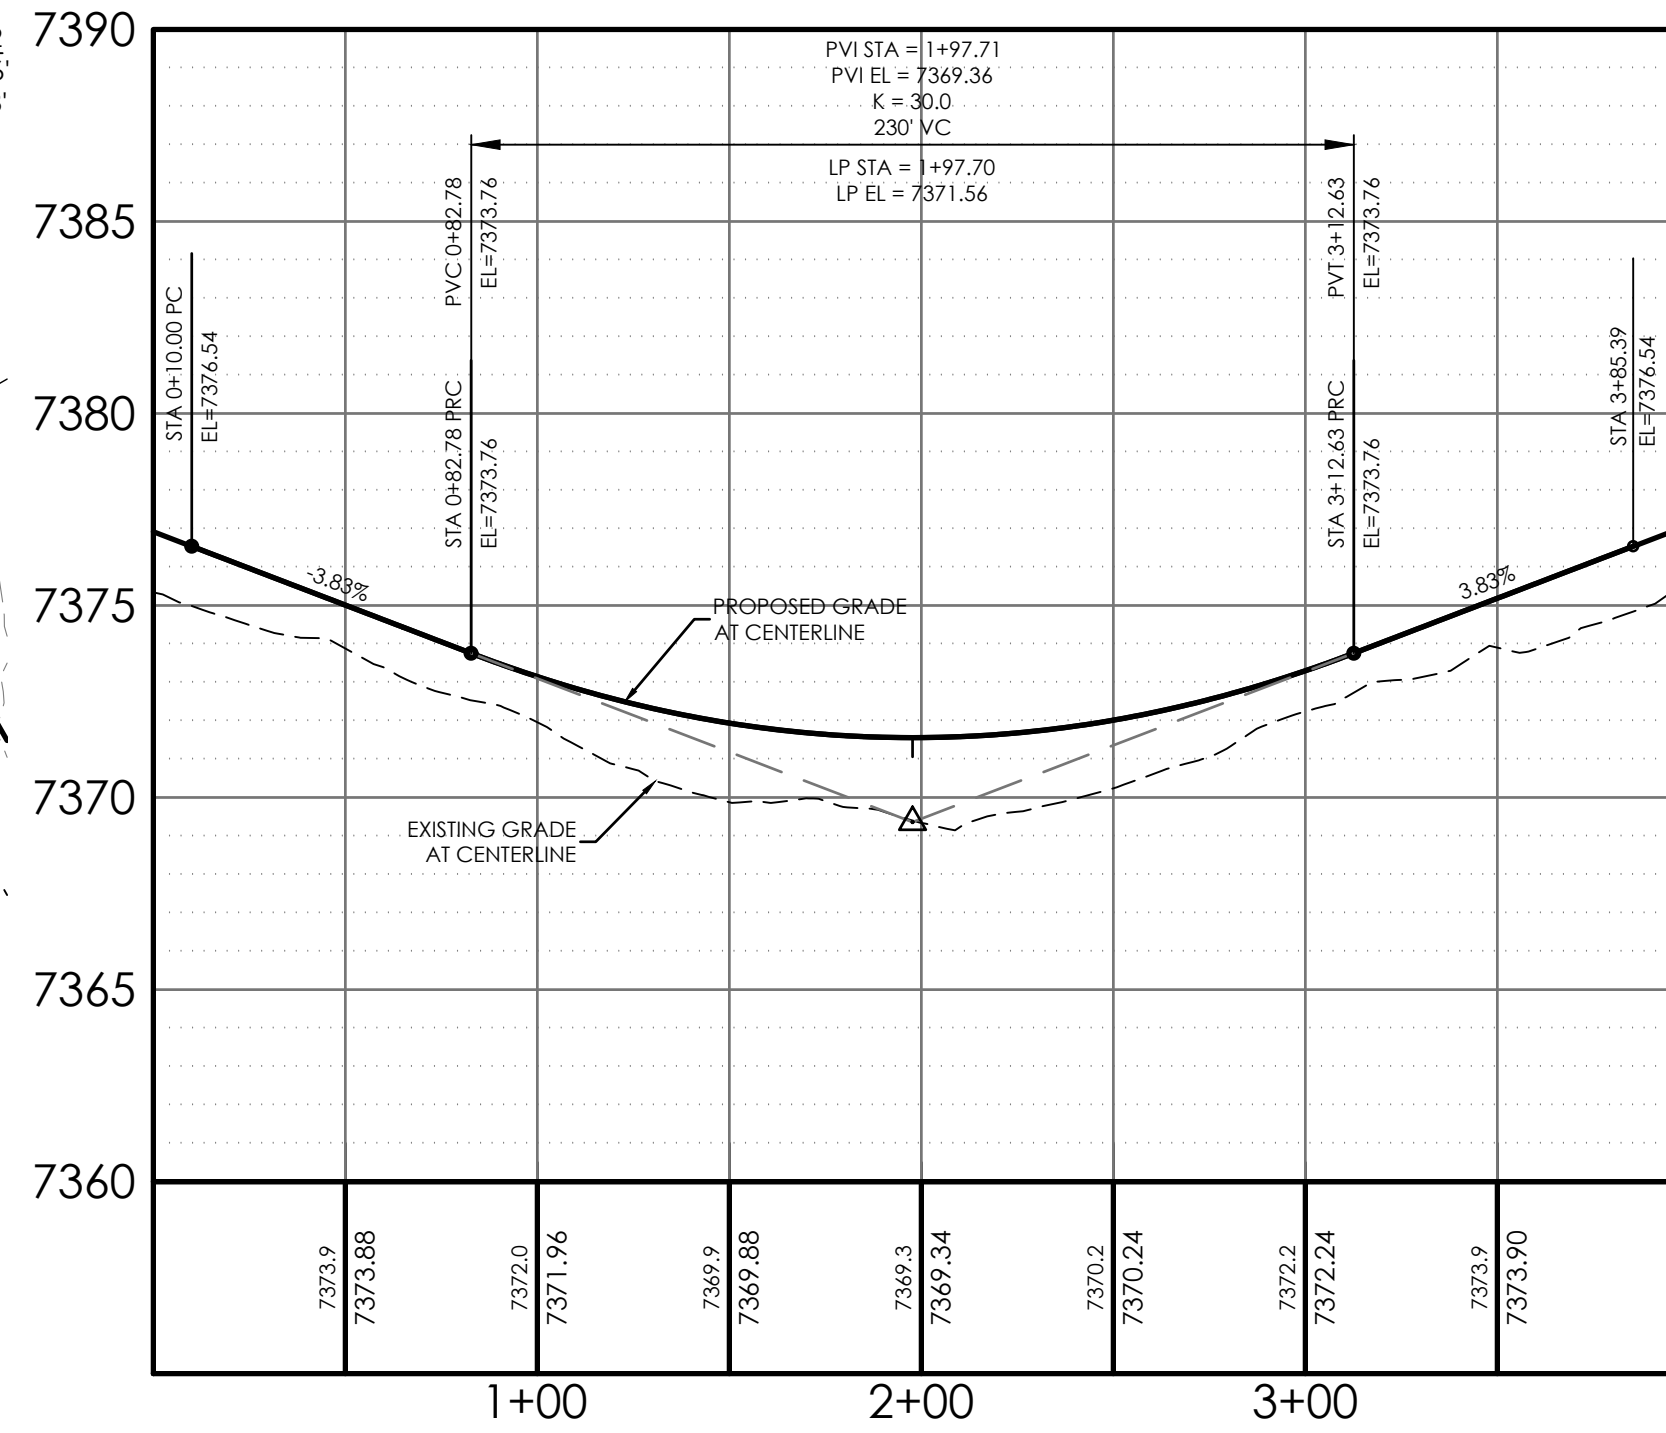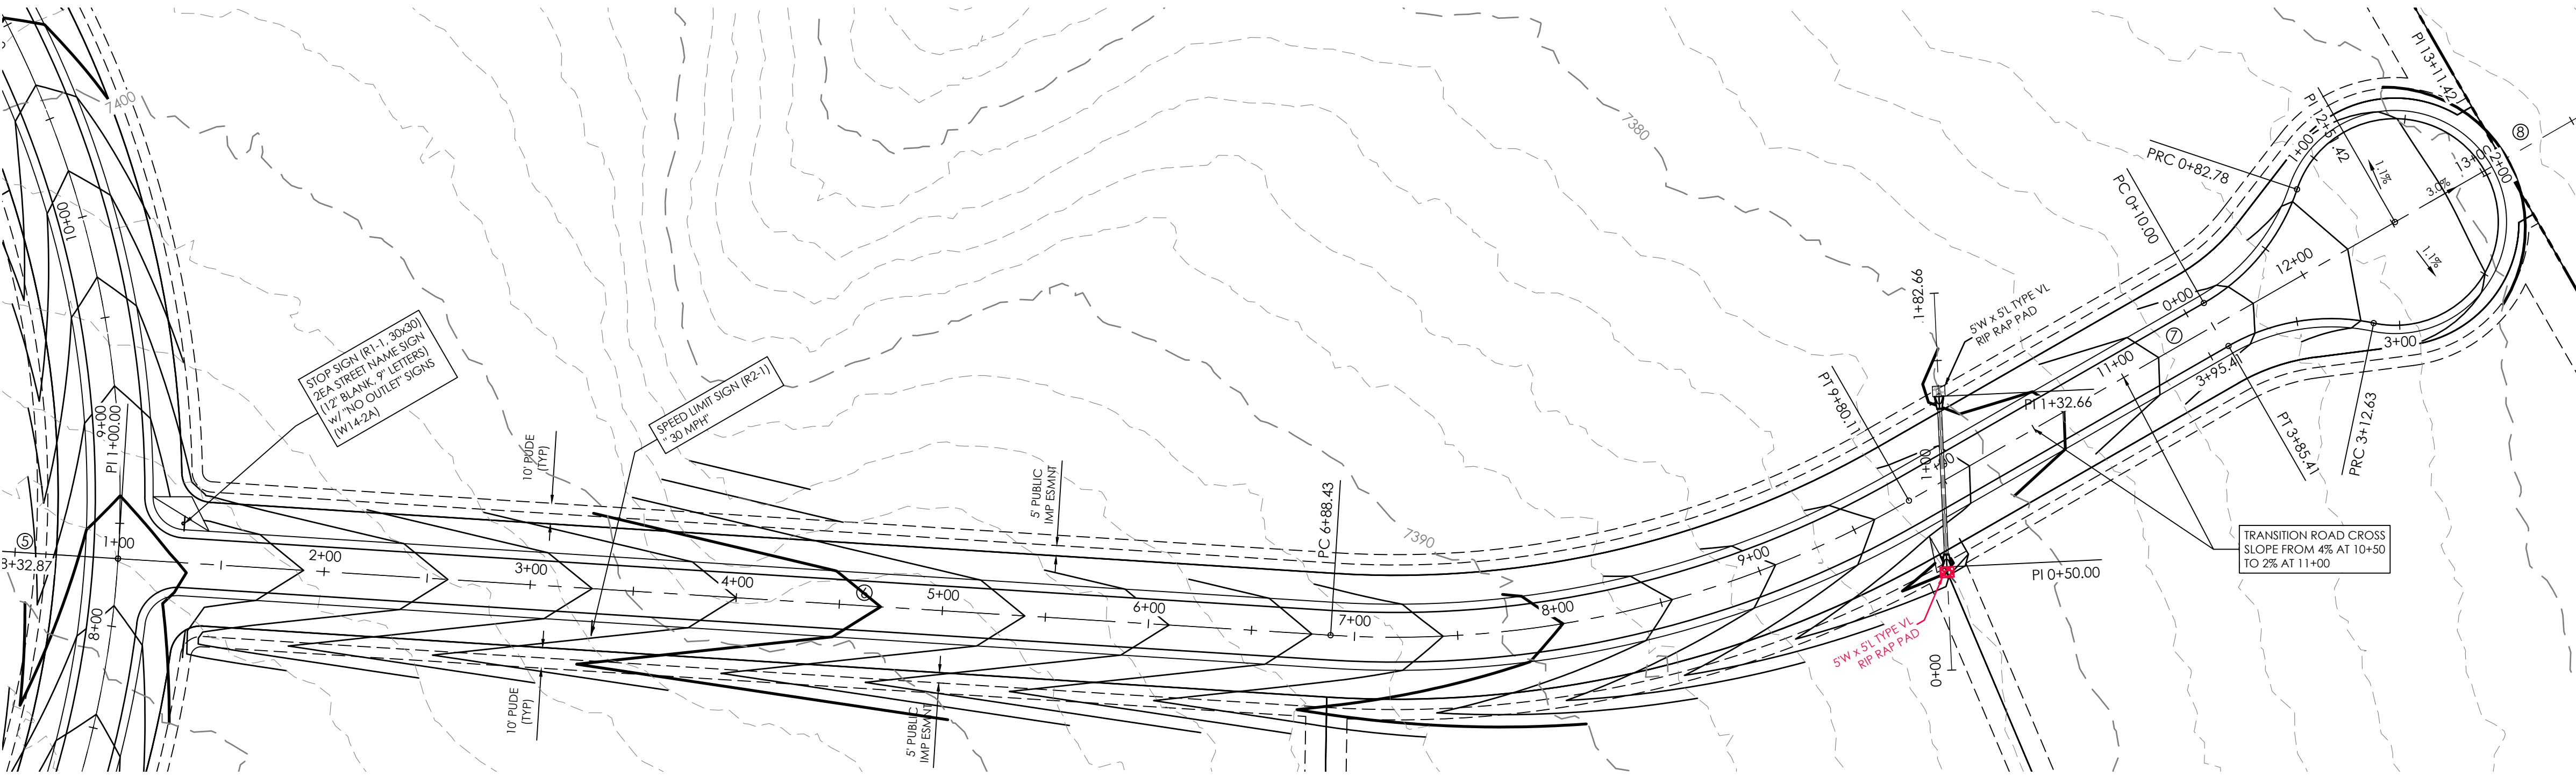

CUL-DE-SAC BULB PROFILE
SCALE 1" = 50'


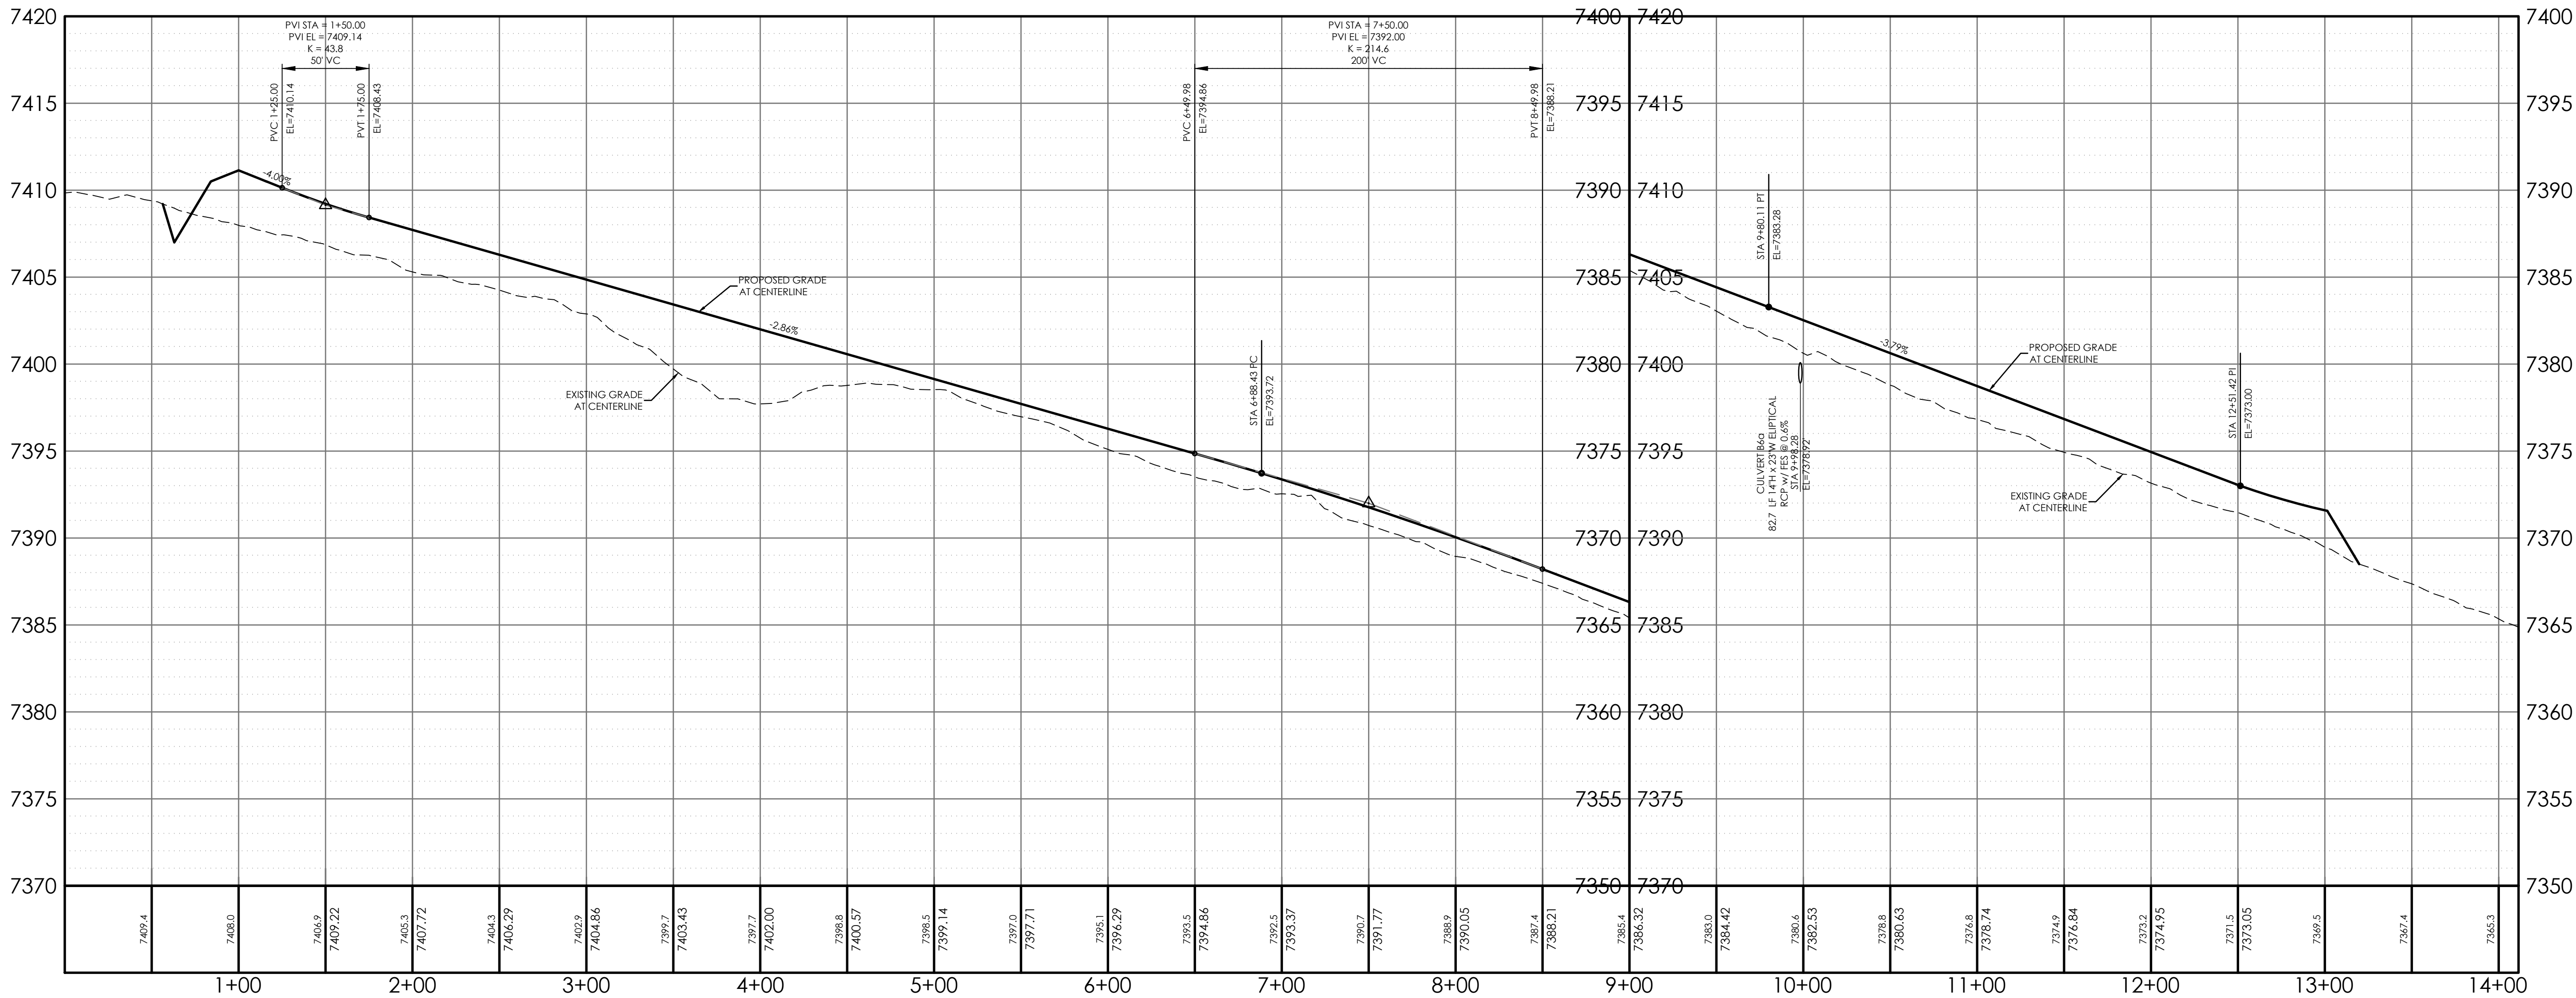


BENCHMARK: THE BENCHMARK FOR THESE PLANS IS THE NO. 4 REBAR, LOCATED APPROX. 40' EAST OF THE PROPOSED ROADWAY & 10' NORTH OF EXISTING OLD RANCH ROAD EDGE OF GRAVEL. ELEVATION = 7273.40' (NAVD88).

BASIS OF BEARINGS: THE SOUTH PROPERTY LINE OF LOT 4 WITH BEARING N89°58'40"E AND A DISTANCE OF 609.76'.

DESIGN DATA:
SIDEWALKS: WIDTH N/A
LOCATION: Attached ☐ Detached ☐
DESIGN SPEED 20 MPH
CURB TYPE: ☐ ☐ ☐ ☐ ☐
ROW WIDTH: N/A FL-FL N/A
STREET TYPE: RURAL GRAVEL LOCAL

PAVEMENT:
TYPE: HMA ☐ PCC ☐
THICKNESS: _____
COMPOSITE SECTION:
HMA _____ BASE _____
SUBGRADE STABILIZATION:
CHEMICAL TYPE _____ MECHANICAL THICKNESS _____

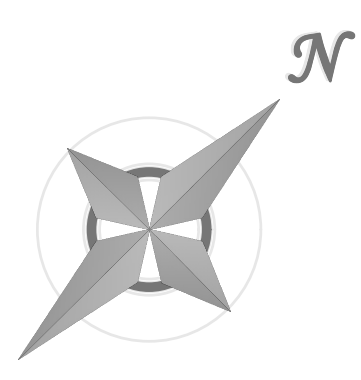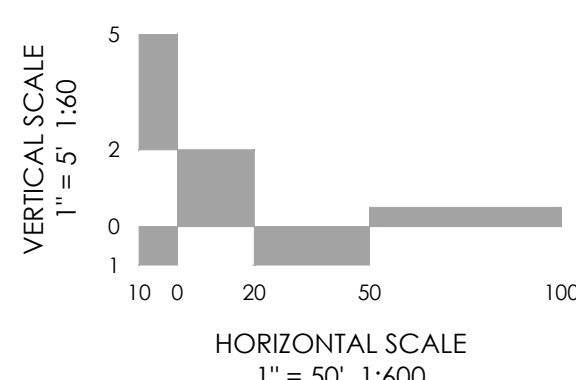


MVE, INC.
ENGINEERS SURVEYORS
1903 Irlary street
colorado springs
719.635.5736
suite 200
co 80909
www.mvecivil.com

REVISIONS

MVE PROJECT **61223**
MVE DRAWING **-CON-PP**

APRIL 16, 2025

DESIGNED BY _____
DRAWN BY _____
CHECKED BY _____
AS-BUILT BY _____
CHECKED BY _____

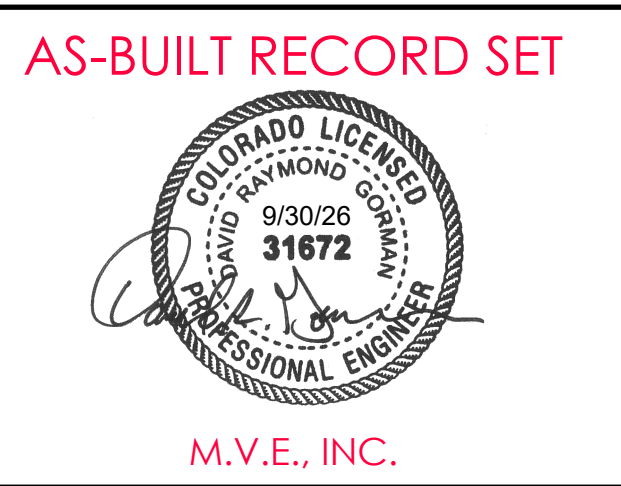


SUNSET PRAIRIE LANE
FROM STA 00+00.00

TO STA 14+11.42


TABLE ROCK HOMESTEADS

C1.4


SHEET 4 OF 5

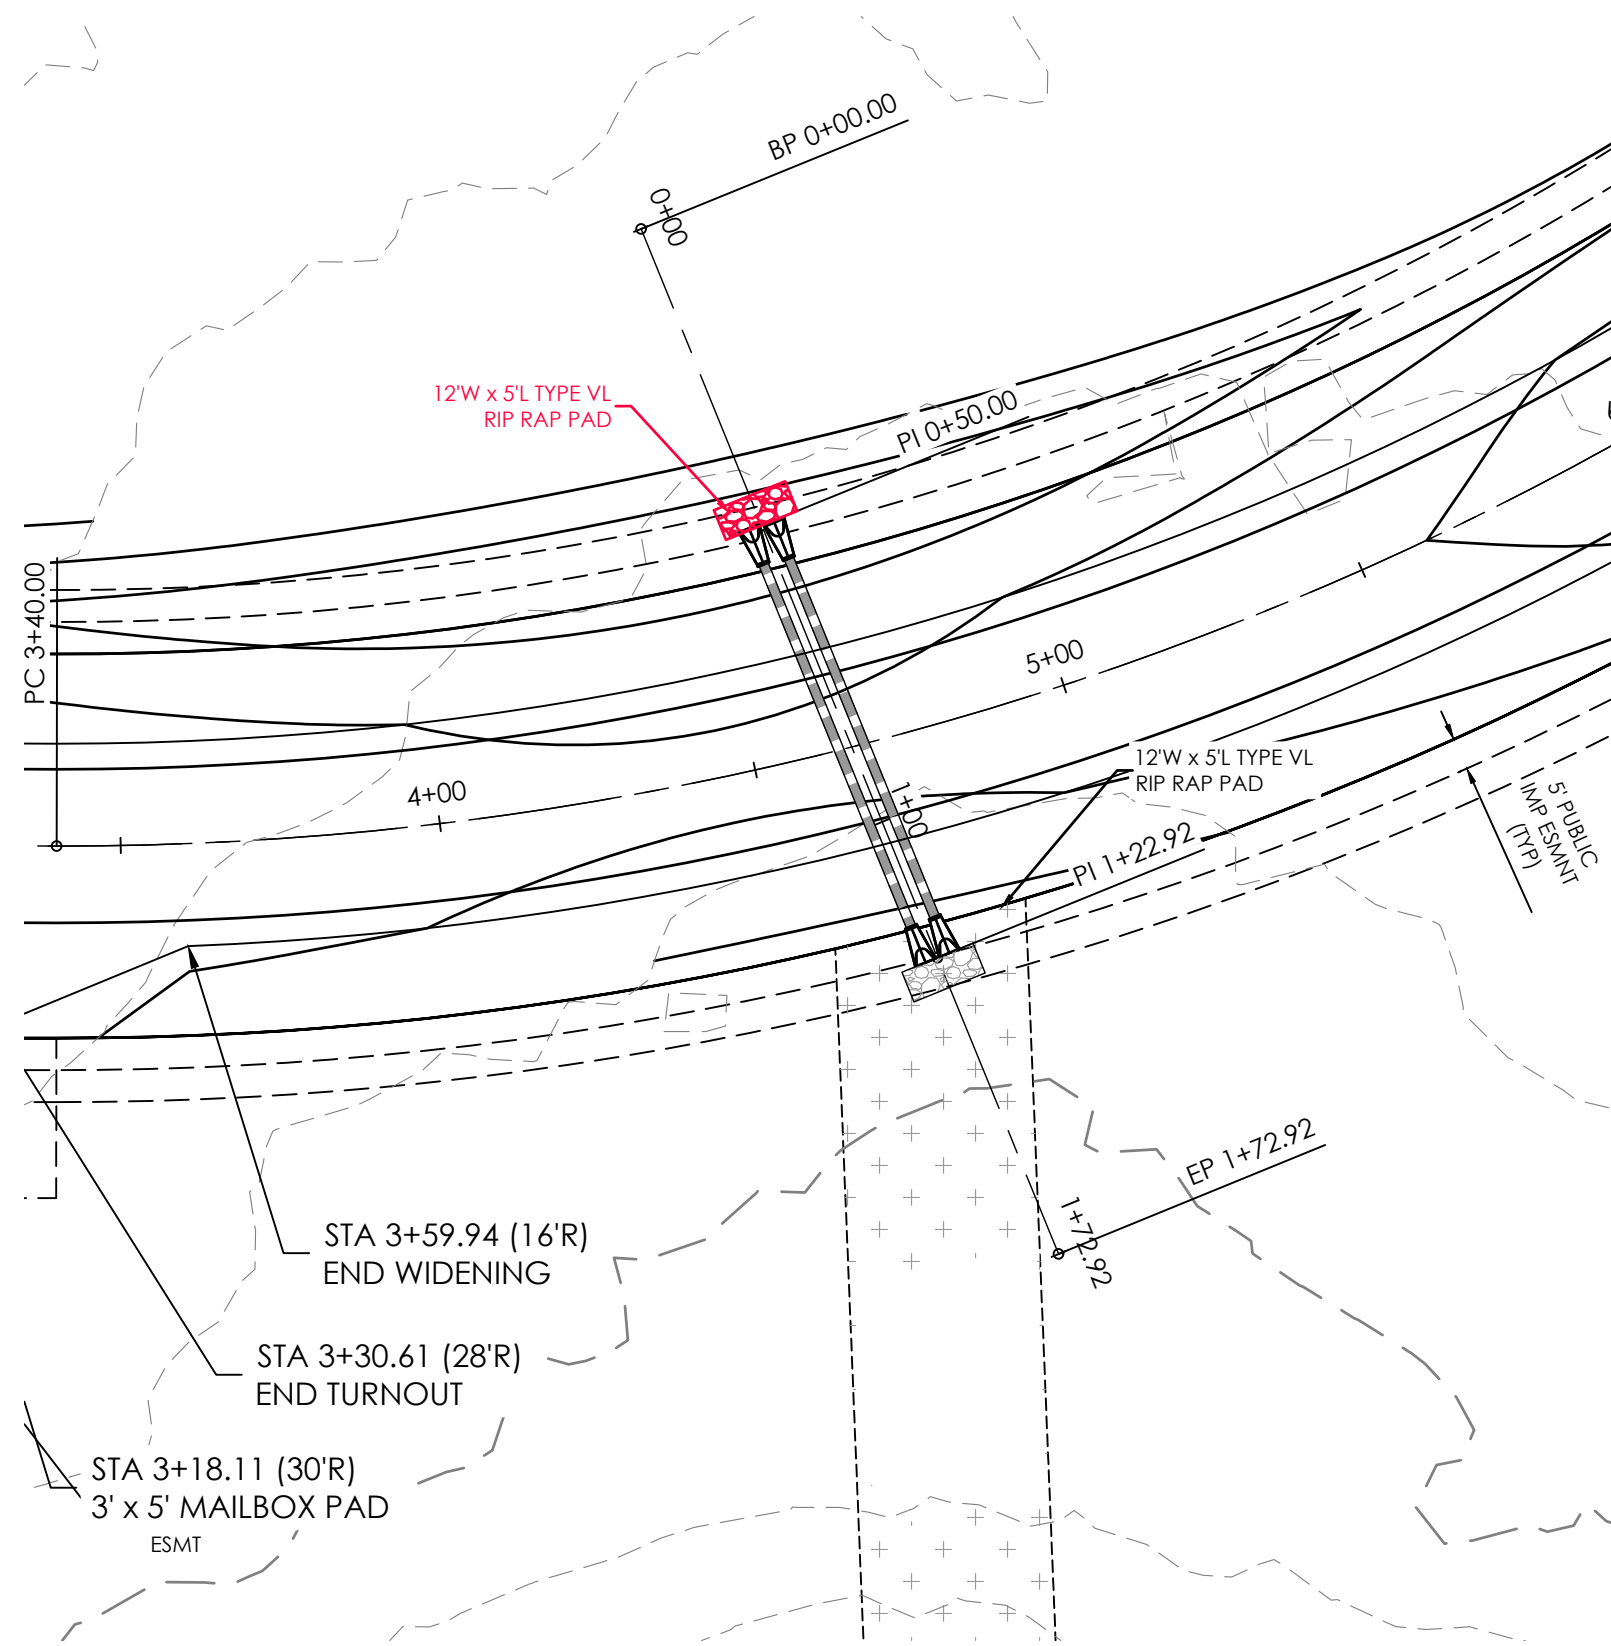


CULVERT D1 PLAN
SCALE 1" = 30'

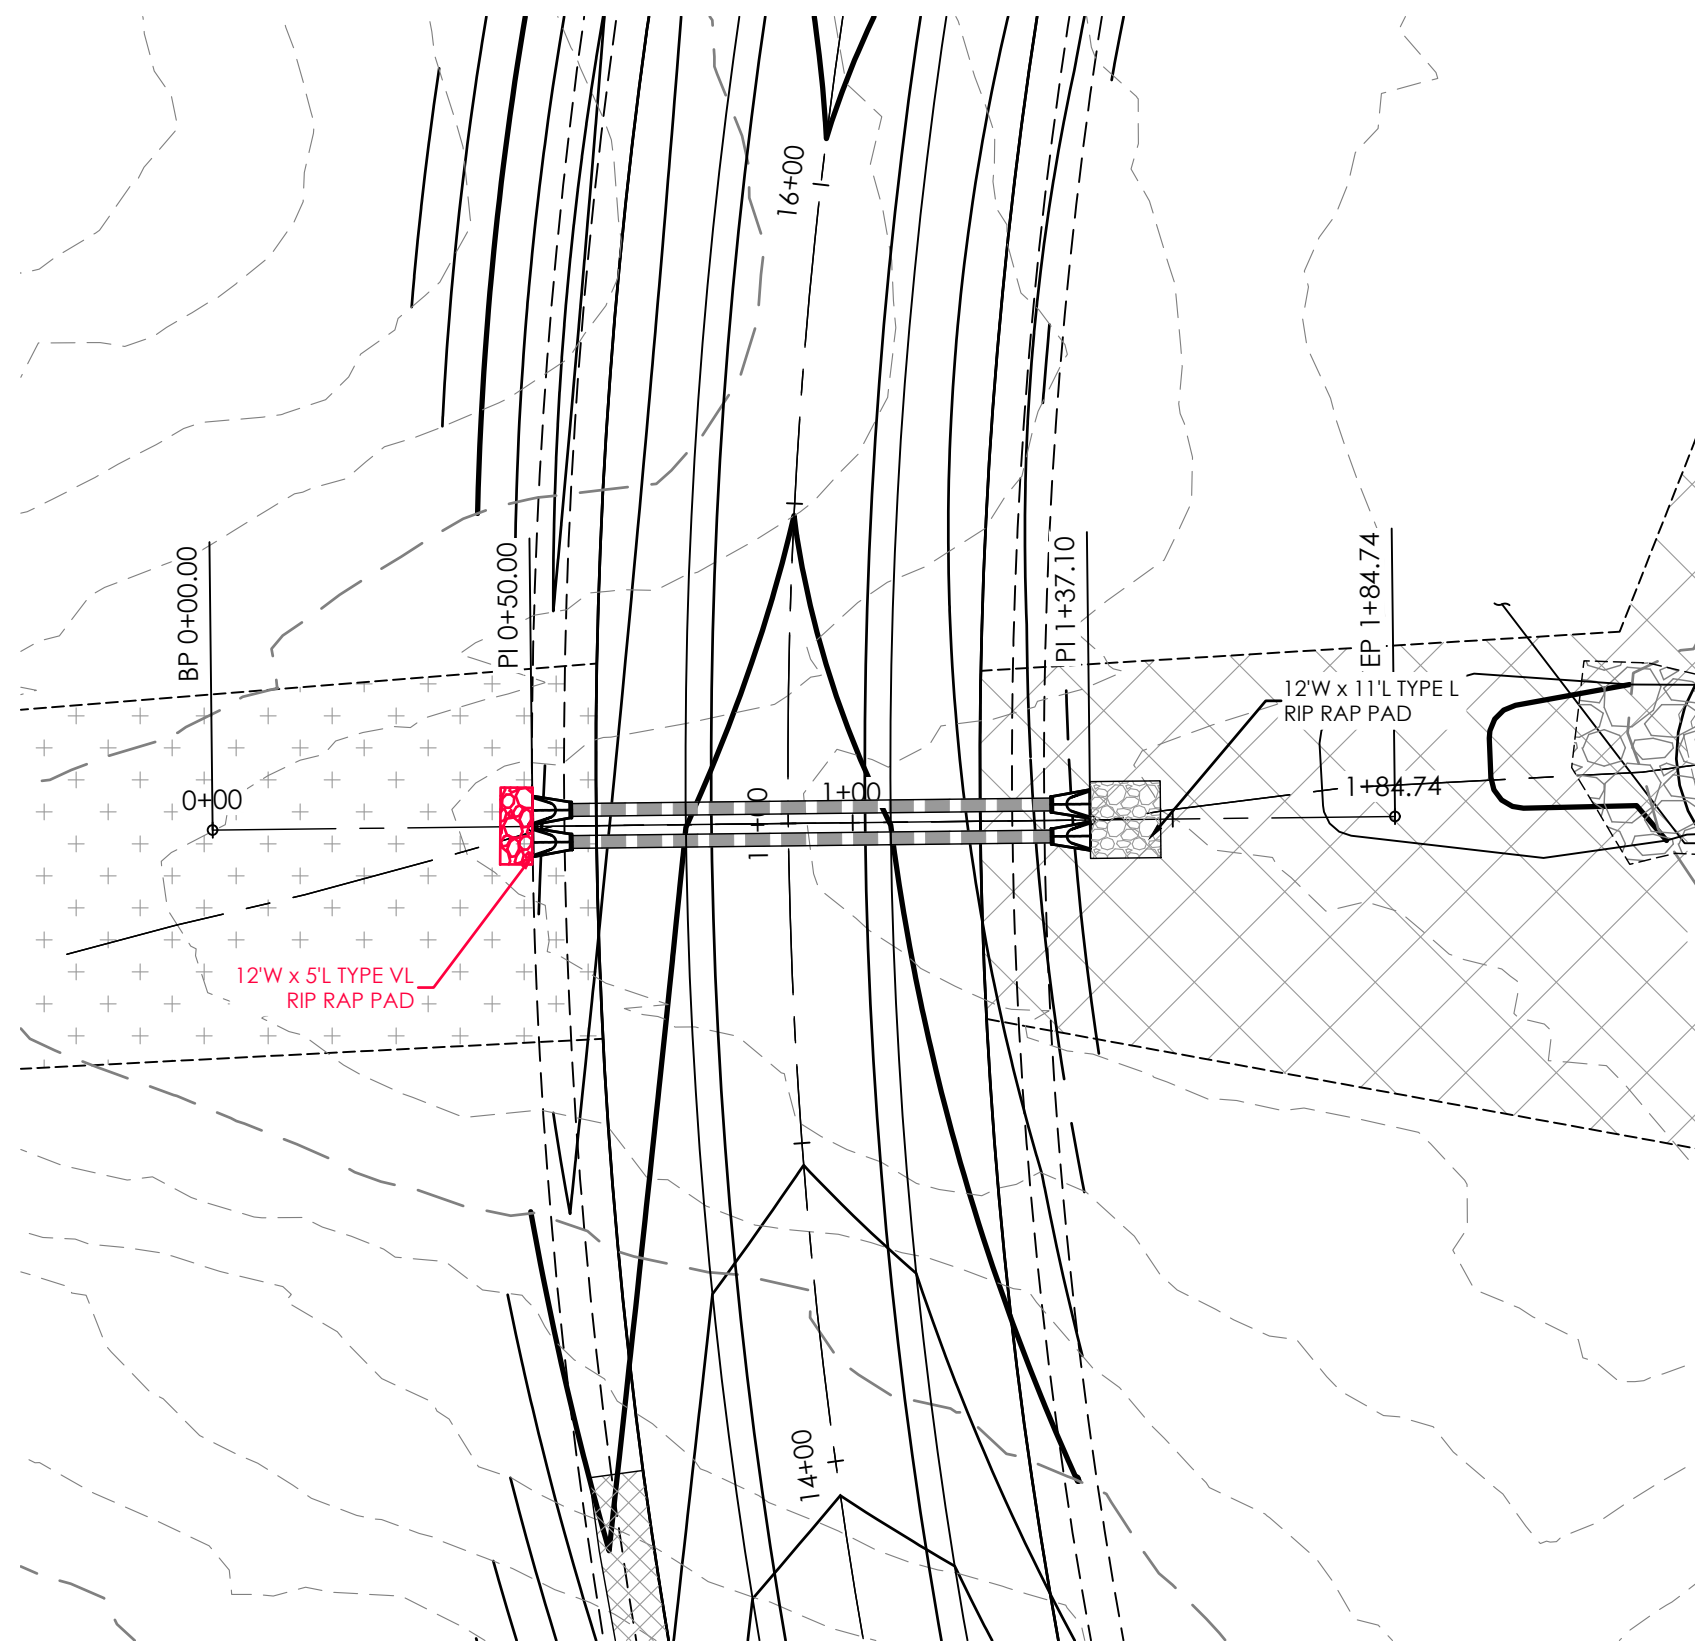


CULVERT B2 PLAN
SCALE 1" = 30'

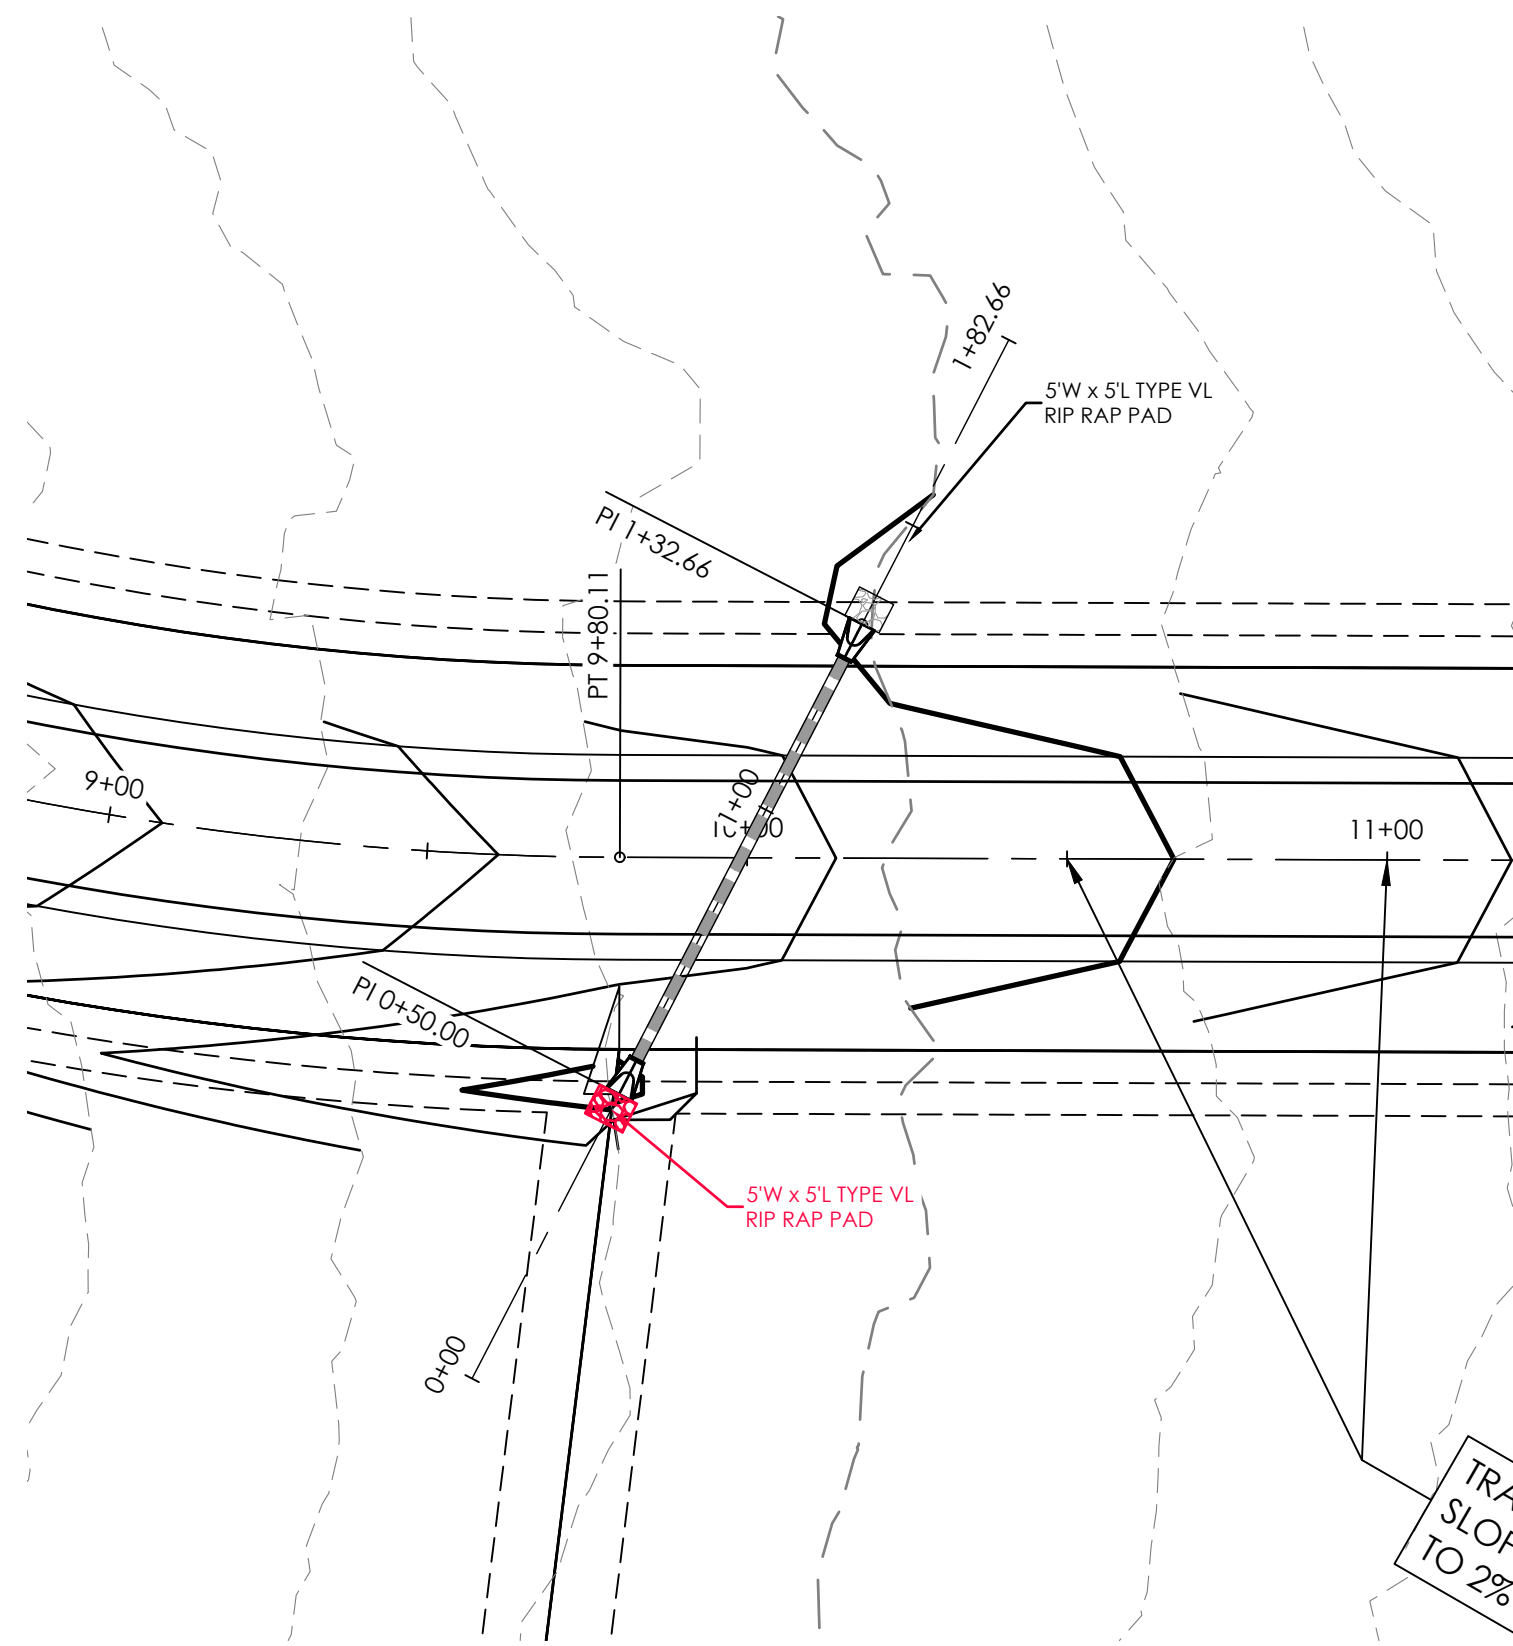


CULVERT B6a PLAN
SCALE 1" = 30'

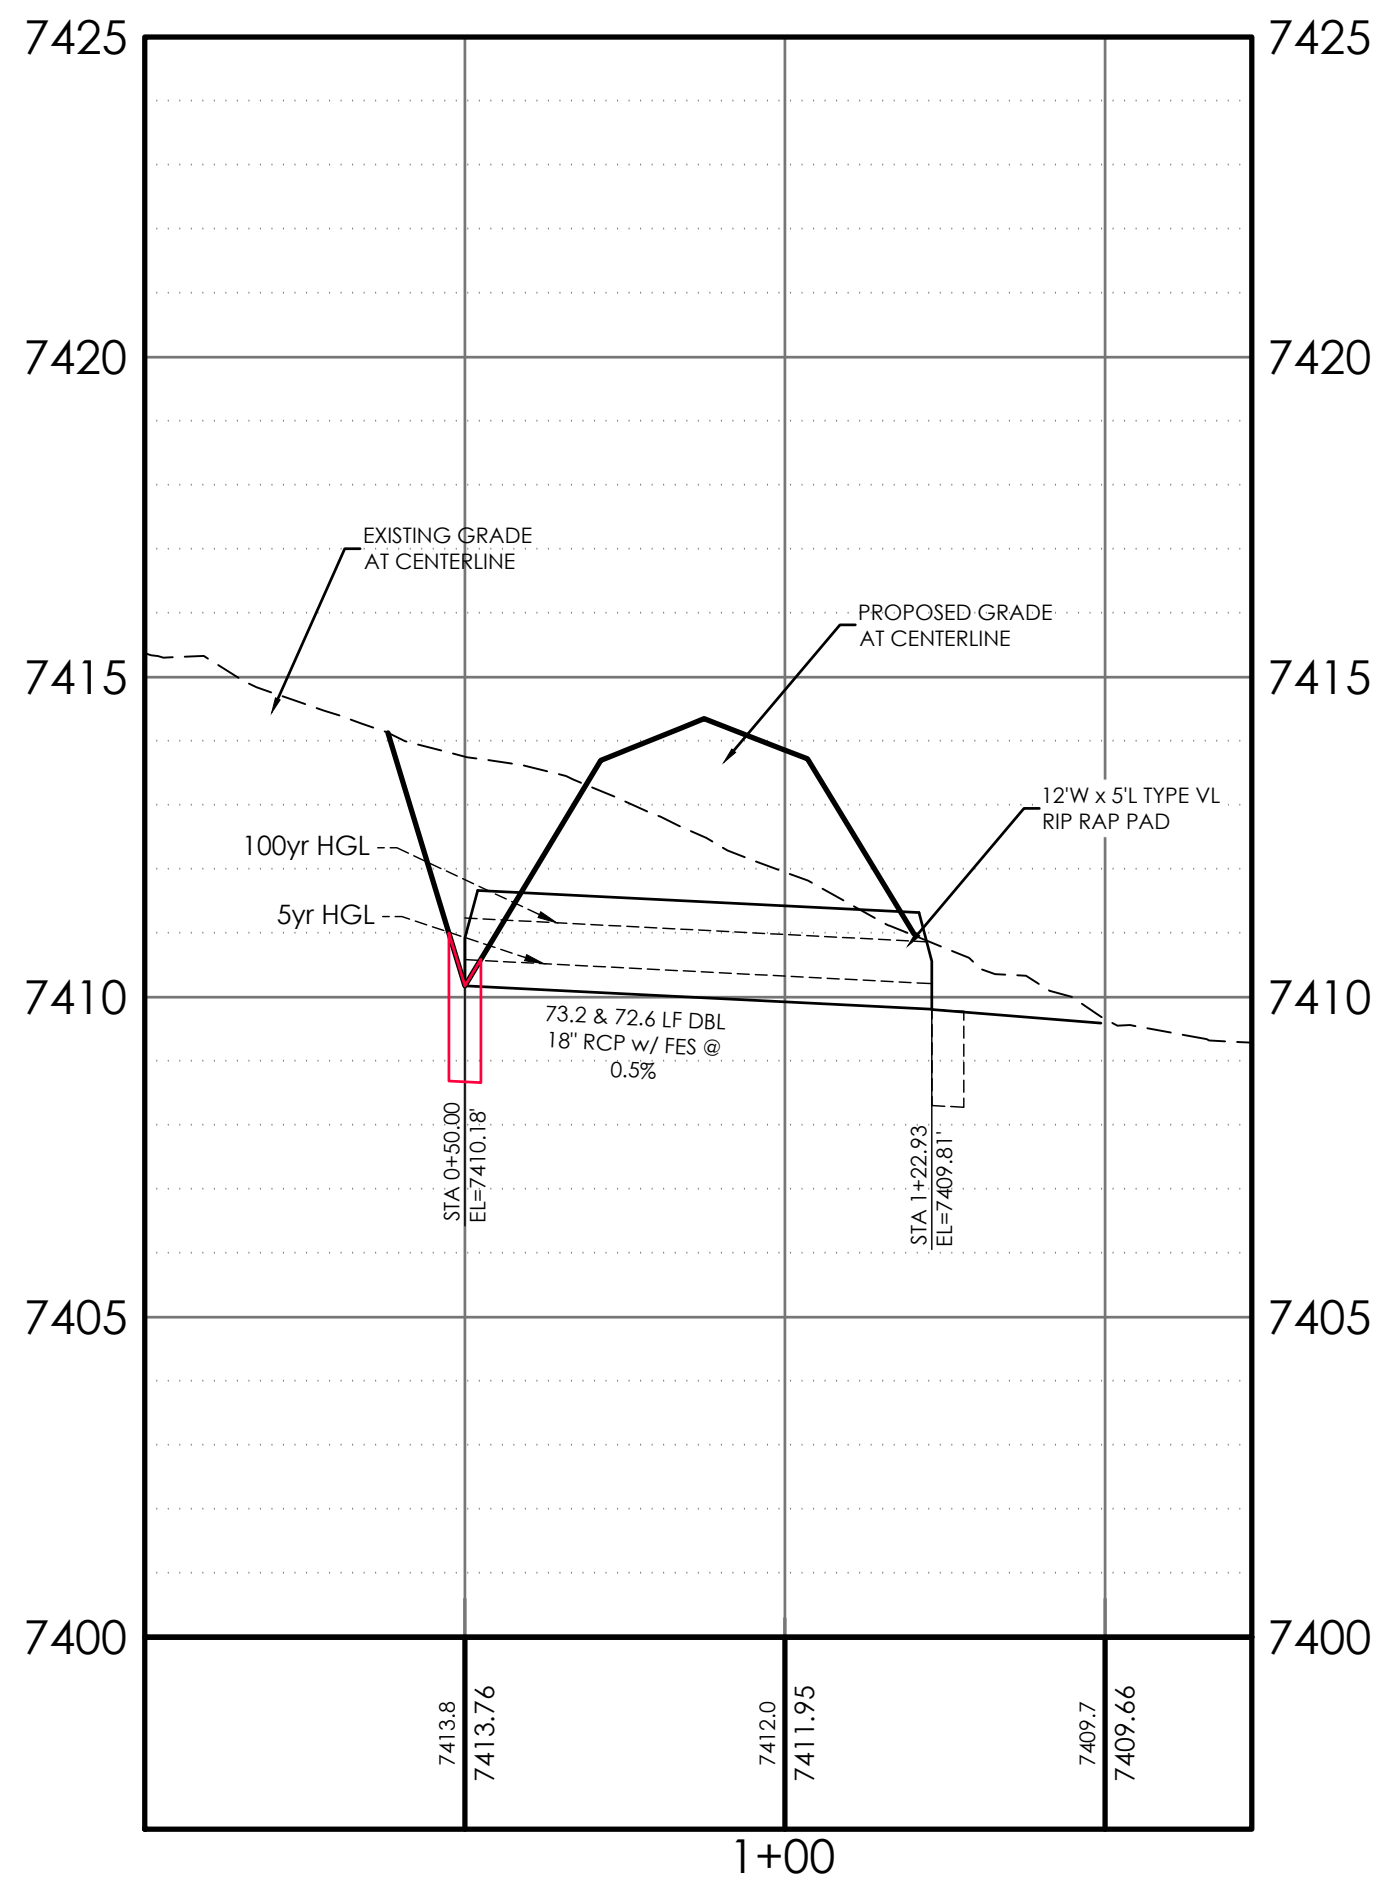

CULVERT D1 SECTION
SCALE 1" = 30' HORIZ. - 1" = 3' VERT

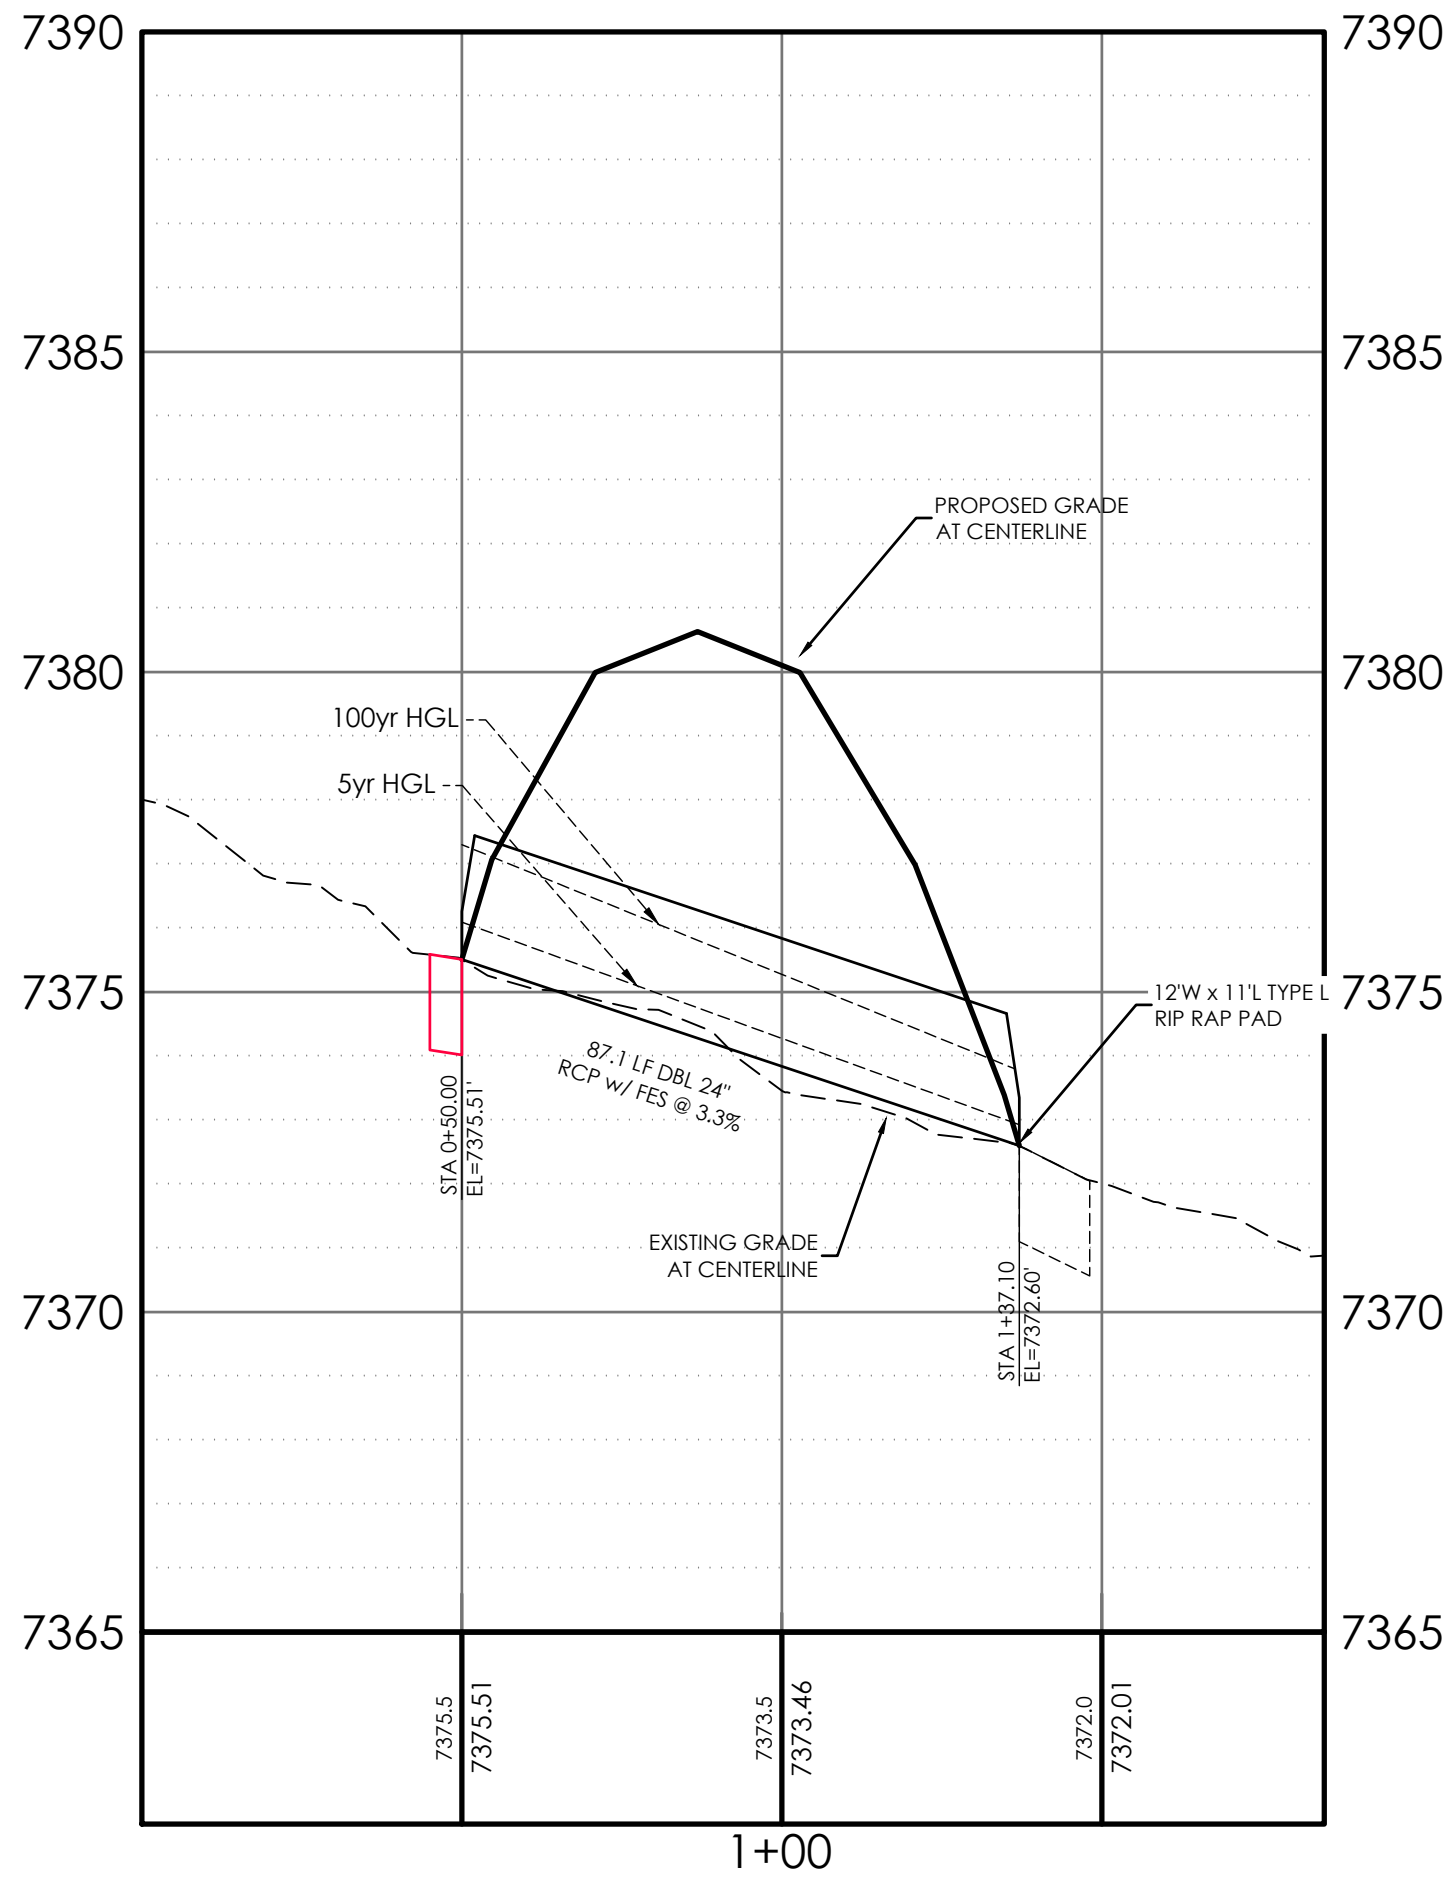

CULVERT B2 SECTION
SCALE 1" = 30' HORIZ. - 1" = 3' VERT



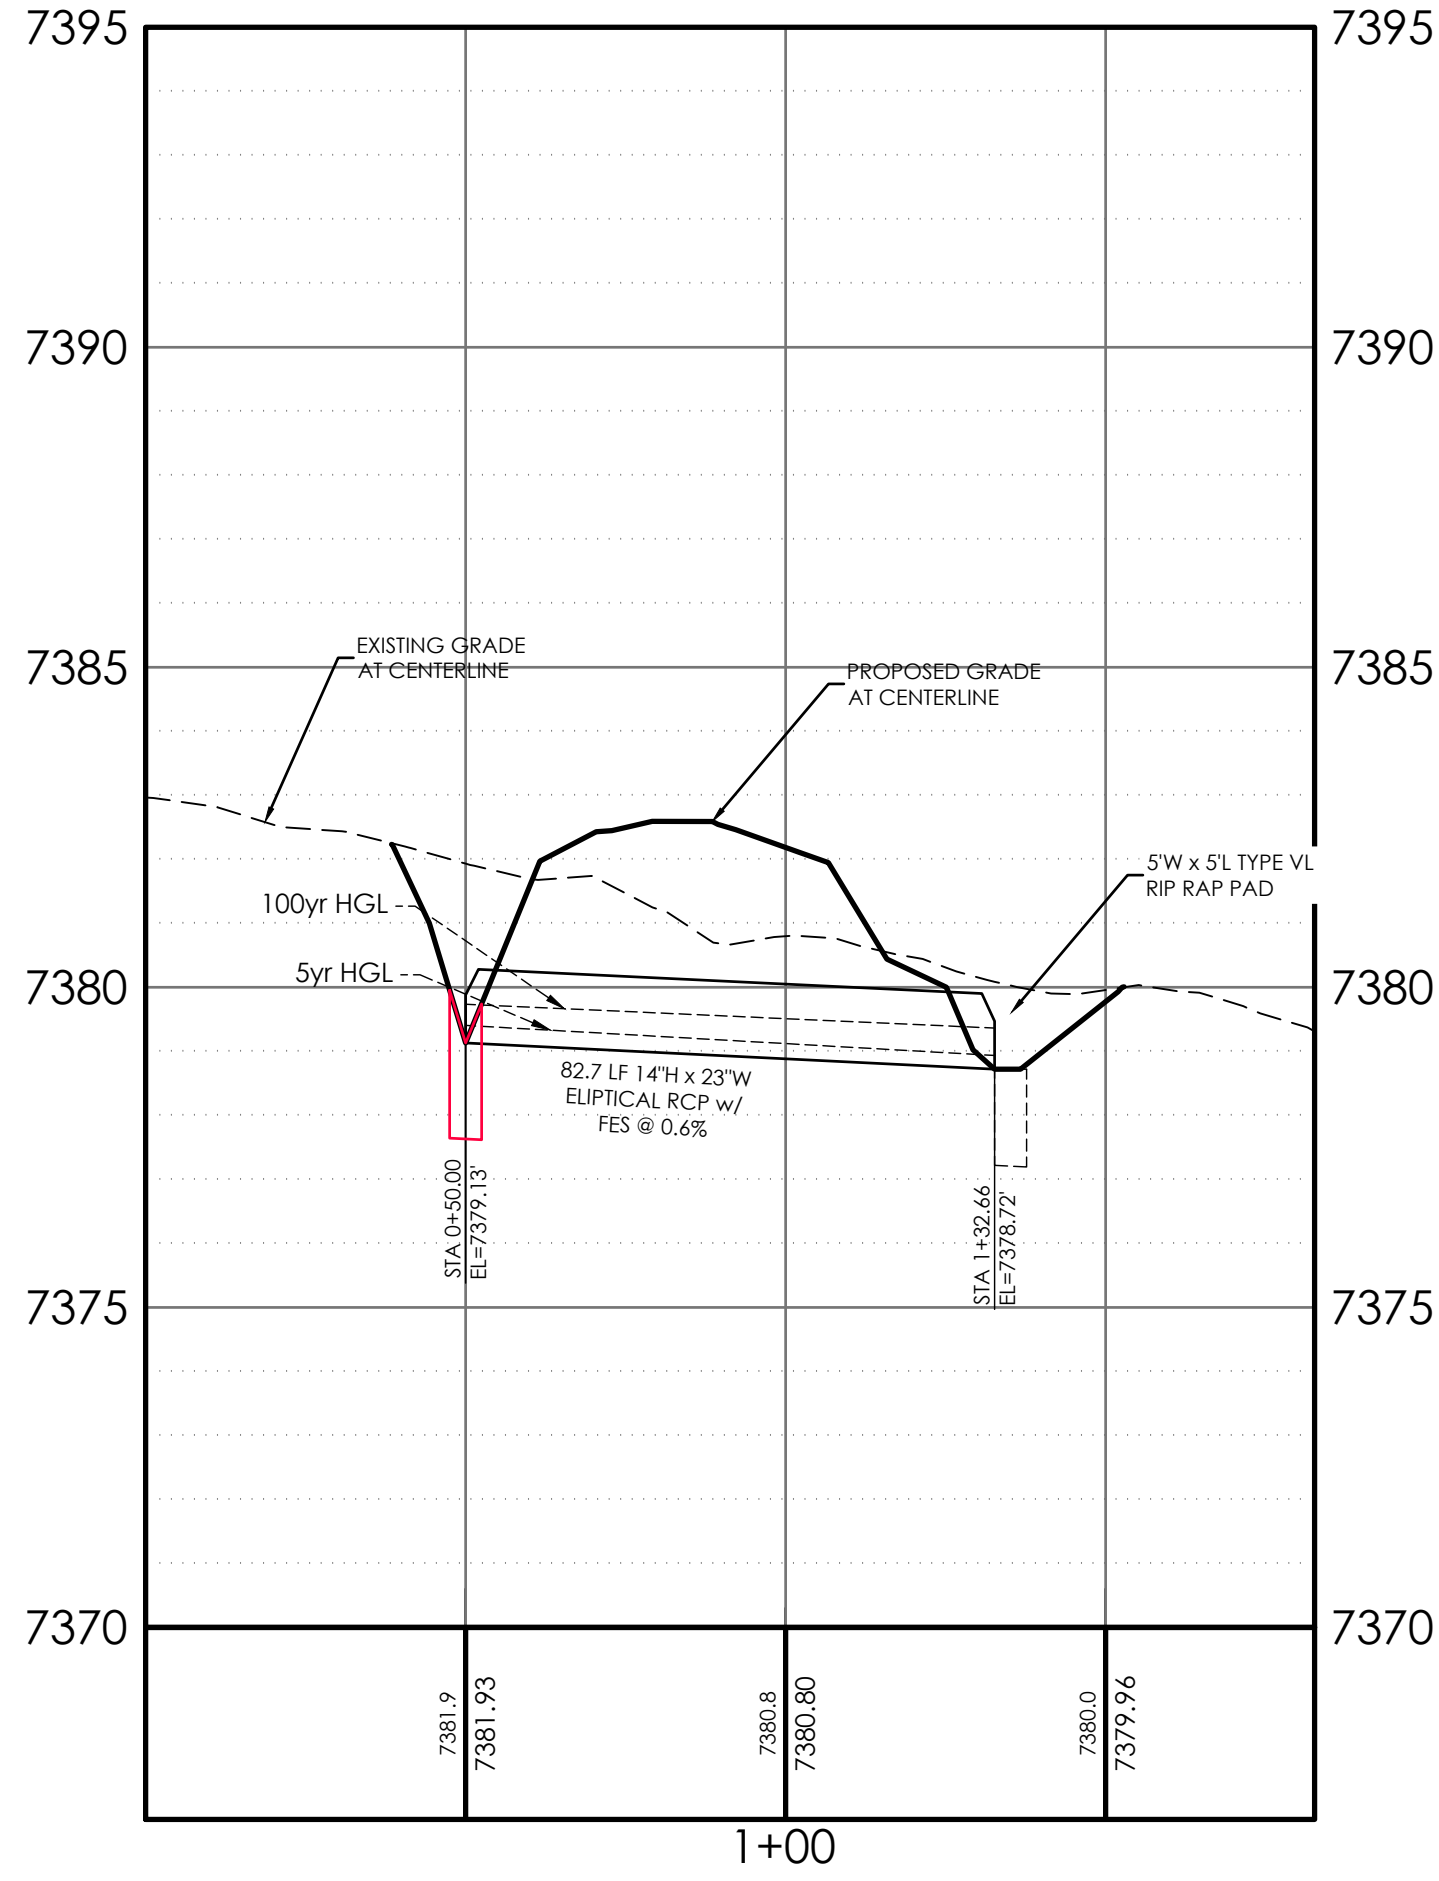


CULVERT B6a SECTION
SCALE 1" = 30' HORIZ. - 1" = 3' VERT

BENCHMARK: THE BENCHMARK FOR THESE PLANS IS THE NO. 4 REBAR LOCATED APPROX. 40' EAST OF THE PROPOSED ROADWAY & 10' NORTH OF EXISTING OLD RANCH ROAD EDGE OF GRAVEL. ELEVATION = 7273.40' (NAVD88).

BASIS OF BEARINGS: THE SOUTH PROPERTY LINE OF LOT 4 WITH BEARING N89°58'40"E AND A DISTANCE OF 609.76'.

DESIGN DATA:
SIDEWALKS: WIDTH N/A
LOCATION: Attached ☐ Detached ☐
DESIGN SPEED 20 MPH
CURB TYPE: ☐ A ☐ B ☐ C ☐ D ☐ E ☐ F ☐ G ☐ H ☐ I ☐ J ☐ K ☐ L ☐ M ☐ N ☐ O ☐ P ☐ Q ☐ R ☐ S ☐ T ☐ U ☐ V ☐ W ☐ X ☐ Y ☐ Z ☐ AA ☐ AB ☐ AC ☐ AD ☐ AE ☐ AF ☐ AG ☐ AH ☐ AI ☐ AJ ☐ AK ☐ AL ☐ AM ☐ AN ☐ AO ☐ AP ☐ AQ ☐ AR ☐ AS ☐ AT ☐ AU ☐ AV ☐ AW ☐ AX ☐ AY ☐ AZ ☐ BA ☐ BB ☐ BC ☐ BD ☐ BE ☐ BF ☐ BG ☐ BH ☐ BI ☐ BJ ☐ BK ☐ BL ☐ BM ☐ BN ☐ BO ☐ BP ☐ BQ ☐ BR ☐ BS ☐ BT ☐ BU ☐ BV ☐ BW ☐ BX ☐ BY ☐ BZ ☐ CA ☐ CB ☐ CC ☐ CD ☐ CE ☐ CF ☐ CG ☐ CH ☐ CI ☐ CJ ☐ CK ☐ CL ☐ CM ☐ CN ☐ CO ☐ CP ☐ CQ ☐ CR ☐ CS ☐ CT ☐ CU ☐ CV ☐ CW ☐ CX ☐ CY ☐ CZ ☐ DA ☐ DB ☐ DC ☐ DD ☐ DE ☐ DF ☐ DG ☐ DH ☐ DI ☐ DJ ☐ DK ☐ DL ☐ DM ☐ DN ☐ DO ☐ DP ☐ DQ ☐ DR ☐ DS ☐ DT ☐ DU ☐ DV ☐ DW ☐ DX ☐ DY ☐ DZ ☐ EA ☐ EB ☐ EC ☐ ED ☐ EE ☐ EF ☐ EG ☐ EH ☐ EI ☐ EJ ☐ EK ☐ EL ☐ EM ☐ EN ☐ EO ☐ EP ☐ EQ ☐ ER ☐ ES ☐ ET ☐ EU ☐ EV ☐ EW ☐ EX ☐ EY ☐ EZ ☐ FA ☐ FB ☐ FC ☐ FD ☐ FE ☐ FF ☐ FG ☐ FH ☐ FI ☐ FJ ☐ FK ☐ FL ☐ FM ☐ FN ☐ FO ☐ FP ☐ FQ ☐ FR ☐ FS ☐ FT ☐ FU ☐ FV ☐ FW ☐ FX ☐ FY ☐ FZ ☐ GA ☐ GB ☐ GC ☐ GD ☐ GE ☐ GF ☐ GG ☐ GH ☐ GI ☐ GJ ☐ GK ☐ GL ☐ GM ☐ GN ☐ GO ☐ GP ☐ GQ ☐ GR ☐ GS ☐ GT ☐ GU ☐ GV ☐ GW ☐ GX ☐ GY ☐ GZ ☐ HA ☐ HB ☐ HC ☐ HD ☐ HE ☐ HF ☐ HG ☐ HH ☐ HI ☐ HJ ☐ HK ☐ HL ☐ HM ☐ HN ☐ HO ☐ HP ☐ HQ ☐ HR ☐ HS ☐ HT ☐ HU ☐ HV ☐ HW ☐ HX ☐ HY ☐ HZ ☐ IA ☐ IB ☐ IC ☐ ID ☐ IE ☐ IF ☐ IG ☐ IH ☐ II ☐ IJ ☐ IK ☐ IL ☐ IM ☐ IN ☐ IO ☐ IP ☐ IQ ☐ IR ☐ IS ☐ IT ☐ IU ☐ IV ☐ IW ☐ IX ☐ IY ☐ IZ ☐ JA ☐ JB ☐ JC ☐ JD ☐ JE ☐ JF ☐ JG ☐ JH ☐ JI ☐ JJ ☐ JK ☐ JL ☐ JM ☐ JN ☐ JO ☐ JP ☐ JQ ☐ JR ☐ JS ☐ JT ☐ JU ☐ JV ☐ JW ☐ JX ☐ JY ☐ JZ ☐ KA ☐ KB ☐ KC ☐ KD ☐ KE ☐ KF ☐ KG ☐ KH ☐ KI ☐ KJ ☐ KK ☐ KL ☐ KM ☐ KN ☐ KO ☐ KP ☐ KQ ☐ KR ☐ KS ☐ KT ☐ KU ☐ KV ☐ KW ☐ KX ☐ KY ☐ KZ ☐ LA ☐ LB ☐ LC ☐ LD ☐ LE ☐ LF ☐ LG ☐ LH ☐ LI ☐ LJ ☐ LK ☐ LL ☐ LM ☐ LN ☐ LO ☐ LP ☐ LQ ☐ LR ☐ LS ☐ LT ☐ LU ☐ LV ☐ LW ☐ LX ☐ LY ☐ LZ ☐ MA ☐ MB ☐ MC ☐ MD ☐ ME ☐ MF ☐ MG ☐ MH ☐ MI ☐ MJ ☐ MK ☐ ML ☐ MN ☐ MO ☐ MP ☐ MQ ☐ MR ☐ MS ☐ MT ☐ MU ☐ MV ☐ MW ☐ MX ☐ MY ☐ MZ ☐ NA ☐ NB ☐ NC ☐ ND ☐ NE ☐ NF ☐ NG ☐ NH ☐ NI ☐ NJ ☐ NK ☐ NL ☐ NM ☐ NO ☐ NP ☐ NQ ☐ NR ☐ NS ☐ NT ☐ NU ☐ NV ☐ NW ☐ NX ☐ NY ☐ NZ ☐ OA ☐ OB ☐ OC ☐ OD ☐ OE ☐ OF ☐ OG ☐ OH ☐ OI ☐ OJ ☐ OK ☐ OL ☐ OM ☐ ON ☐ OO ☐ OP ☐ OQ ☐ OR ☐ OS ☐ OT ☐ OU ☐ OV ☐ OW ☐ OX ☐ OY ☐ OZ ☐ PA ☐ PB ☐ PC ☐ PD ☐ PE ☐ PF ☐ PG ☐ PH ☐ PI ☐ PJ ☐ PK ☐ PL ☐ PM ☐ PN ☐ PO ☐ PP ☐ PQ ☐ PR ☐ PS ☐ PT ☐ PU ☐ PV ☐ PW ☐ PX ☐ PY ☐ PZ ☐ QA ☐ QB ☐ QC ☐ QD ☐ QE ☐ QF ☐ QG ☐ QH ☐ QI ☐ QJ ☐ QK ☐ QL ☐ QM ☐ QN ☐ QO ☐ QP ☐ QQ ☐ QR ☐ QS ☐ QT ☐ QU ☐ QV ☐ QW ☐ QX ☐ QY ☐ QZ ☐ RA ☐ RB ☐ RC ☐ RD ☐ RE ☐ RF ☐ RG ☐ RH ☐ RI ☐ RJ ☐ RK ☐ RL ☐ RM ☐ RN ☐ RO ☐ RP ☐ RQ ☐ RR ☐ RS ☐ RT ☐ RU ☐ RV ☐ RW ☐ RX ☐ RY ☐ RZ ☐ SA ☐ SB ☐ SC ☐ SD ☐ SE ☐ SF ☐ SG ☐ SH ☐ SI ☐ SJ ☐ SK ☐ SL ☐ SM ☐ SN ☐ SO ☐ SP ☐ SQ ☐ SR ☐ SS ☐ ST ☐ SU ☐ SV ☐ SW ☐ SX ☐ SY ☐ SZ ☐ TA ☐ TB ☐ TC ☐ TD ☐ TE ☐ TF ☐ TG ☐ TH ☐ TI ☐ TJ ☐ TK ☐ TL ☐ TM ☐ TN ☐ TO ☐ TP ☐ TQ ☐ TR ☐ TS ☐ TU ☐ TV ☐ TW ☐ TX ☐ TY ☐ TZ ☐ UA ☐ UB ☐ UC ☐ UD ☐ UE ☐ UF ☐ UG ☐ UH ☐ UI ☐ UJ ☐ UK ☐ UL ☐ UM ☐ UN ☐ UO ☐ UP ☐ UQ ☐ UR ☐ US ☐ UT ☐ UY ☐ UZ ☐ VA ☐ VB ☐ VC ☐ VD ☐ VE ☐ VF ☐ VG ☐ VH ☐ VI ☐ VJ ☐ VK ☐ VL ☐ VM ☐ VN ☐ VO ☐ VP ☐ VQ ☐ VR ☐ VS ☐ VT ☐ VU ☐ VV ☐ VW ☐ VX ☐ VY ☐ VZ ☐ WA ☐ WB ☐ WC ☐ WD ☐ WE ☐ WF ☐ WG ☐ WH ☐ WI ☐ WJ ☐ WK ☐ WL ☐ WM ☐ WN ☐ WO ☐ WP ☐ WQ ☐ WR ☐ WS ☐ WT ☐ WY ☐ WZ ☐ XA ☐ XB ☐ XC ☐ XD ☐ XE ☐ XF ☐ XG ☐ XH ☐ XI ☐ XJ ☐ XK ☐ XL ☐ XM ☐ XN ☐ XO ☐ XP ☐ XQ ☐ XR ☐ XS ☐ XT ☐ XU ☐ XV ☐ XW ☐ XX ☐ XY ☐ XZ ☐ YA ☐ YB ☐ YC ☐ YD ☐ YE ☐ YF ☐ YG ☐ YH ☐ YI ☐ YJ ☐ YK ☐ YL ☐ YM ☐ YN ☐ YO ☐ YP ☐ YQ ☐ YR ☐ YS ☐ YT ☐ YU ☐ YV ☐ YW ☐ YX ☐ YZ ☐ ZA ☐ ZB ☐ ZC ☐ ZD ☐ ZE ☐ ZF ☐ ZG ☐ ZH ☐ ZI ☐ ZJ ☐ ZK ☐ ZL ☐ ZM ☐ ZN ☐ ZO ☐ ZP ☐ ZQ ☐ ZR ☐ ZS ☐ ZT ☐ ZU ☐ ZV ☐ ZW ☐ ZX ☐ ZY ☐ ZZ

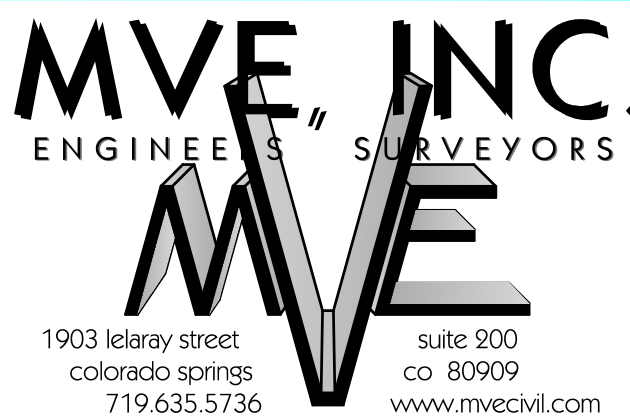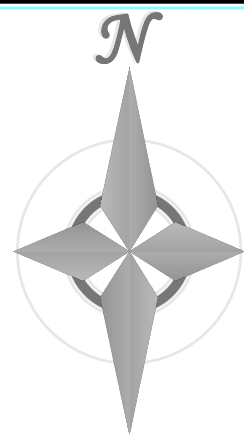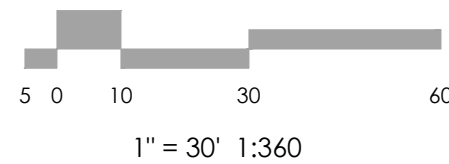

REVISIONS

MVE PROJECT **61223**
MVE DRAWING **-CON-PP**

APRIL 16, 2025

DESIGNED BY _____
DRAWN BY _____
CHECKED BY _____
AS-BUILT BY _____
CHECKED BY _____

CULVERTS & DETAILS

TABLE ROCK HOMESTEADS
C1.5
SHEET **5** OF **5**

